

# CITY OF ALBUQUERQUE

*Planning Department*  
Brennon Williams, Director



*Mayor Timothy M. Keller*

May 14, 2021

Yolanda Padilla Moyer, PE  
Bohannon-Huston  
7500 Jefferson St NE Courtyard I  
Albuquerque, NM 87109

**RE: Valle Prado Unit 4**  
**Request for Partial Release of Financial Guarantee Lots 7, 10, 15-19, 44-45-**  
**Approved**  
**Grading Plan Stamp Date: 8/20/19**  
**Certification Dated: 1/26/21**  
**Drainage File: C09D011**

Dear Ms. Padilla Moyer:

PO Box 1293

Based on the submittal received on 2/1/21, this certification is approved for Release of Financial Guarantee for the lots listed above.

Albuquerque

If you have any questions, please contact me at 924-3986 or [earmijo@cabq.gov](mailto:earmijo@cabq.gov).

NM 87103

Sincerely,

[www.cabq.gov](http://www.cabq.gov)

Ernest Armijo, P.E.  
Principal Engineer, Hydrology  
Planning Department  
Development Review Services



# City of Albuquerque

Planning Department

Development & Building Services Division

## DRAINAGE AND TRANSPORTATION INFORMATION SHEET (REV 11/2018)

**Project Title:** Valle Prado Unit 4 **Building Permit #:** \_\_\_\_\_ **Hydrology File #:** C09D011  
**DRB#:** \_\_\_\_\_ **EPC#:** \_\_\_\_\_ **Work Order#:** \_\_\_\_\_  
**Legal Description:** Tract 6, The Trails Unit 3A  
**City Address:** \_\_\_\_\_

**Applicant:** Bohannon Huston Inc. **Contact:** Yolanda Moyer  
**Address:** 7500 Jefferson St NE CY2 Albuquerque, NM, 87109  
**Phone#:** 505-798-7945 **Fax#:** \_\_\_\_\_ **E-mail:** ypadilla@bhinc.com  
**Owner:** PV Trails Albuquerque LCC **Contact:** Scott Steffen  
**Address:** 4350 La Jolla Village Dr, Suite 110 San Diego CA 92122  
**Phone#:** 505 243-3949 **Fax#:** \_\_\_\_\_ **E-mail:** ssteffen@pricedg.com

**TYPE OF SUBMITTAL:** ☒ PLAT (1 # OF LOTS) \_\_\_\_\_ RESIDENCE \_\_\_\_\_ DRB SITE \_\_\_\_\_ ADMIN SITE

IS THIS A RESUBMITTAL?: ☒ Yes \_\_\_\_\_ No

**DEPARTMENT:** \_\_\_\_\_ TRAFFIC/ TRANSPORTATION ☒ HYDROLOGY/ DRAINAGE

Check all that Apply:

### TYPE OF SUBMITTAL:

☒ ENGINEER/ARCHITECT CERTIFICATION  
☐ PAD CERTIFICATION  
☐ CONCEPTUAL G & D PLAN  
☐ GRADING PLAN  
☐ DRAINAGE MASTER PLAN  
☐ DRAINAGE REPORT  
☐ FLOODPLAIN DEVELOPMENT PERMIT APPLIC  
☐ ELEVATION CERTIFICATE  
☐ CLOMR/LOMR  
☐ TRAFFIC CIRCULATION LAYOUT (TCL)  
☐ TRAFFIC IMPACT STUDY (TIS)  
☐ OTHER (SPECIFY) \_\_\_\_\_  
☐ PRE-DESIGN MEETING?

### TYPE OF APPROVAL/ACCEPTANCE SOUGHT:

☐ BUILDING PERMIT APPROVAL  
☐ CERTIFICATE OF OCCUPANCY  
☐ PRELIMINARY PLAT APPROVAL  
☐ SITE PLAN FOR SUB'D APPROVAL  
☐ SITE PLAN FOR BLDG. PERMIT APPROVAL  
☐ FINAL PLAT APPROVAL  
☒ SIA/ RELEASE OF FINANCIAL GUARANTEE  
☐ FOUNDATION PERMIT APPROVAL  
☐ GRADING PERMIT APPROVAL  
☐ SO-19 APPROVAL  
☐ PAVING PERMIT APPROVAL  
☒ GRADING/ PAD CERTIFICATION  
☐ WORK ORDER APPROVAL  
☐ CLOMR/LOMR  
☐ FLOODPLAIN DEVELOPMENT PERMIT  
☐ OTHER (SPECIFY) \_\_\_\_\_

**DATE SUBMITTED:** 01-26-2021 **By:** Yolanda Padilla Moyer, P.E.

COA STAFF:

ELECTRONIC SUBMITTAL RECEIVED: \_\_\_\_\_

FEE PAID: \_\_\_\_\_

January 26, 2021

Mr. Ernest Armijo, P.E.  
Hydrology Section  
City of Albuquerque  
600 2<sup>nd</sup> Street NW  
Albuquerque, NM 87102

Re: Partial Grading and Drainage Certification (Lots 7, 10, 15-19, 44-45) Valle Prado Unit 4  
Subdivision; DRB Case No. PR- 2018-001991; Hydrology File C09D011

Dear Ernest,

We are submitting a final grading and drainage certification for Valle Prado Unit 4 Subdivision. Enclosed for your review is the approved grading and drainage plan dated 08/20/19. These lots have been graded; retaining walls and curb and gutter have been constructed.

After reviewing these as-built elevations and visiting the site on 12-17-2020 it is my belief that the above lots have been graded in substantial compliance with the approved grading and drainage plan and that the interim drainage improvements allow runoff to be managed in the interim condition.

Your review and approval is requested for Building Permit Approval for the above listed buildings. I appreciate your time and consideration. If you have questions or require additional information, please contact me at 823-1000.

Sincerely,



Yolanda Padilla Moyer, P.E.  
Senior Project Manager  
Community Development & Planning

Enclosure

cc: Scott Steffen, PLDG







GRADING AND DRAINAGE CERTIFICATION

I, YOLANDA PADILLA MOYER, NMPE 16035, OF THE FIRM BOHANNAN HUSTON, HEREBY CERTIFY THAT THE GRADING AND DRAINAGE INFORMATION PRESENTED HEREON IS NOT NECESSARILY COMPLETE AND INTENDED ONLY TO VERIFY SUBSTANTIAL COMPLIANCE OF THE GRADING ASPECTS OF THIS PROJECT. THOSE RELYING ON THE RECORD DOCUMENT ARE ADVISED TO OBTAIN INDEPENDENT VERIFICATION OF ITS ACCURACY BEFORE USING IT FOR ANY OTHER PURPOSE.

Yolanda Padilla Moyer  
YOLANDA PADILLA MOYER, NMPE 16035

01-26-2021  
DATE

NEW MEXICO  
16035  
REGISTERED PROFESSIONAL ENGINEER

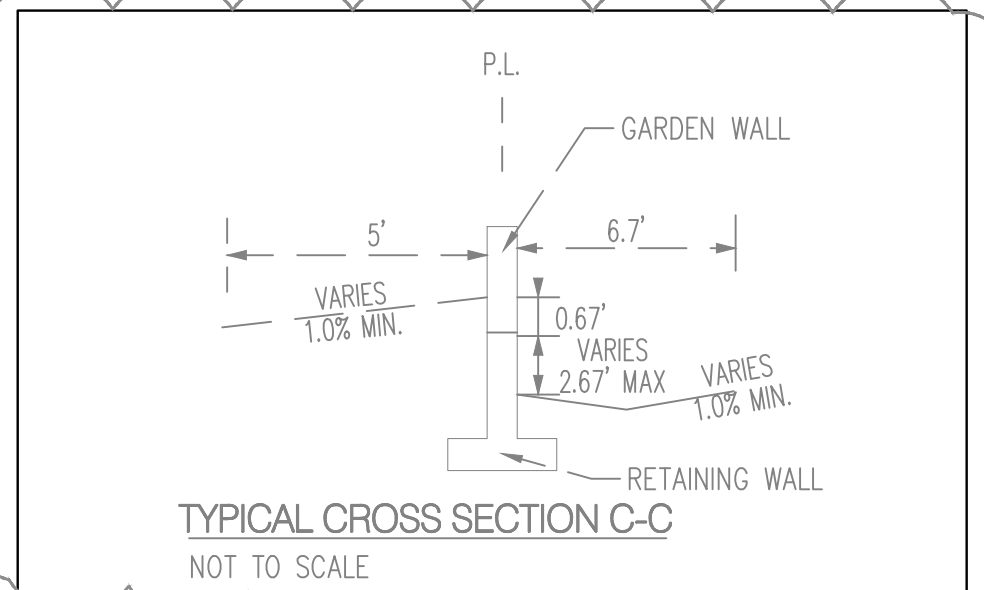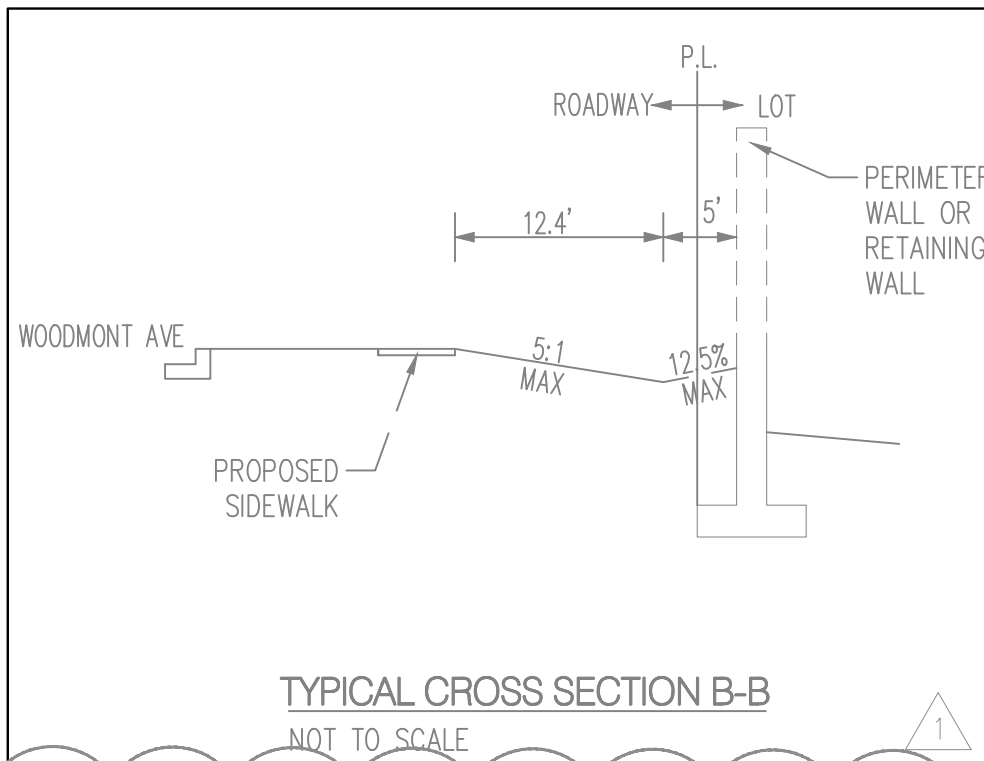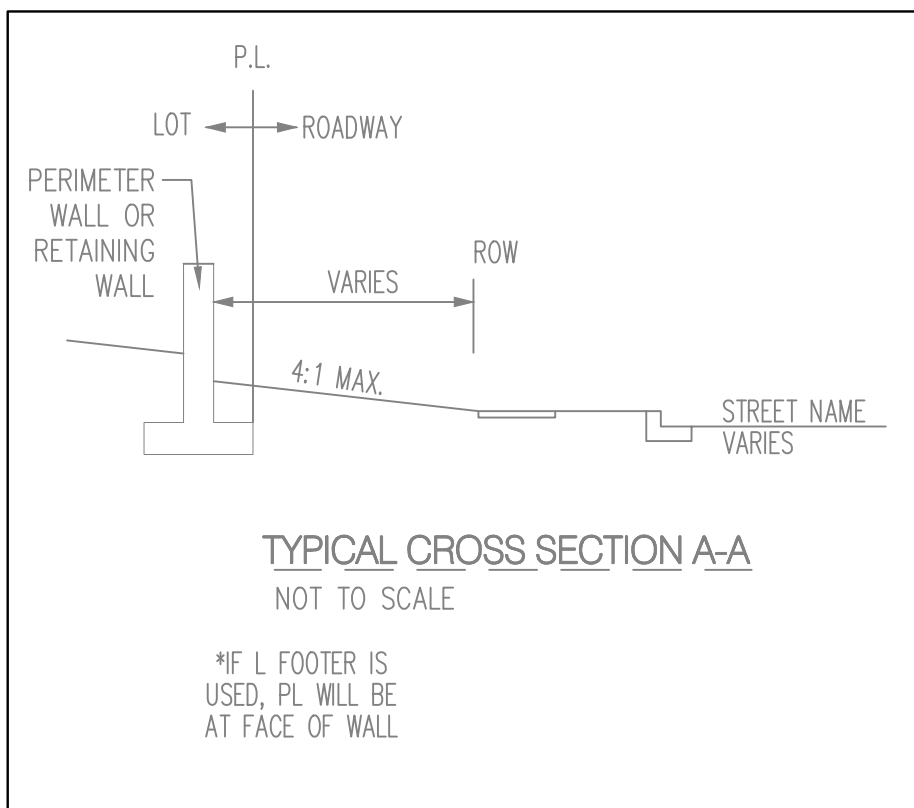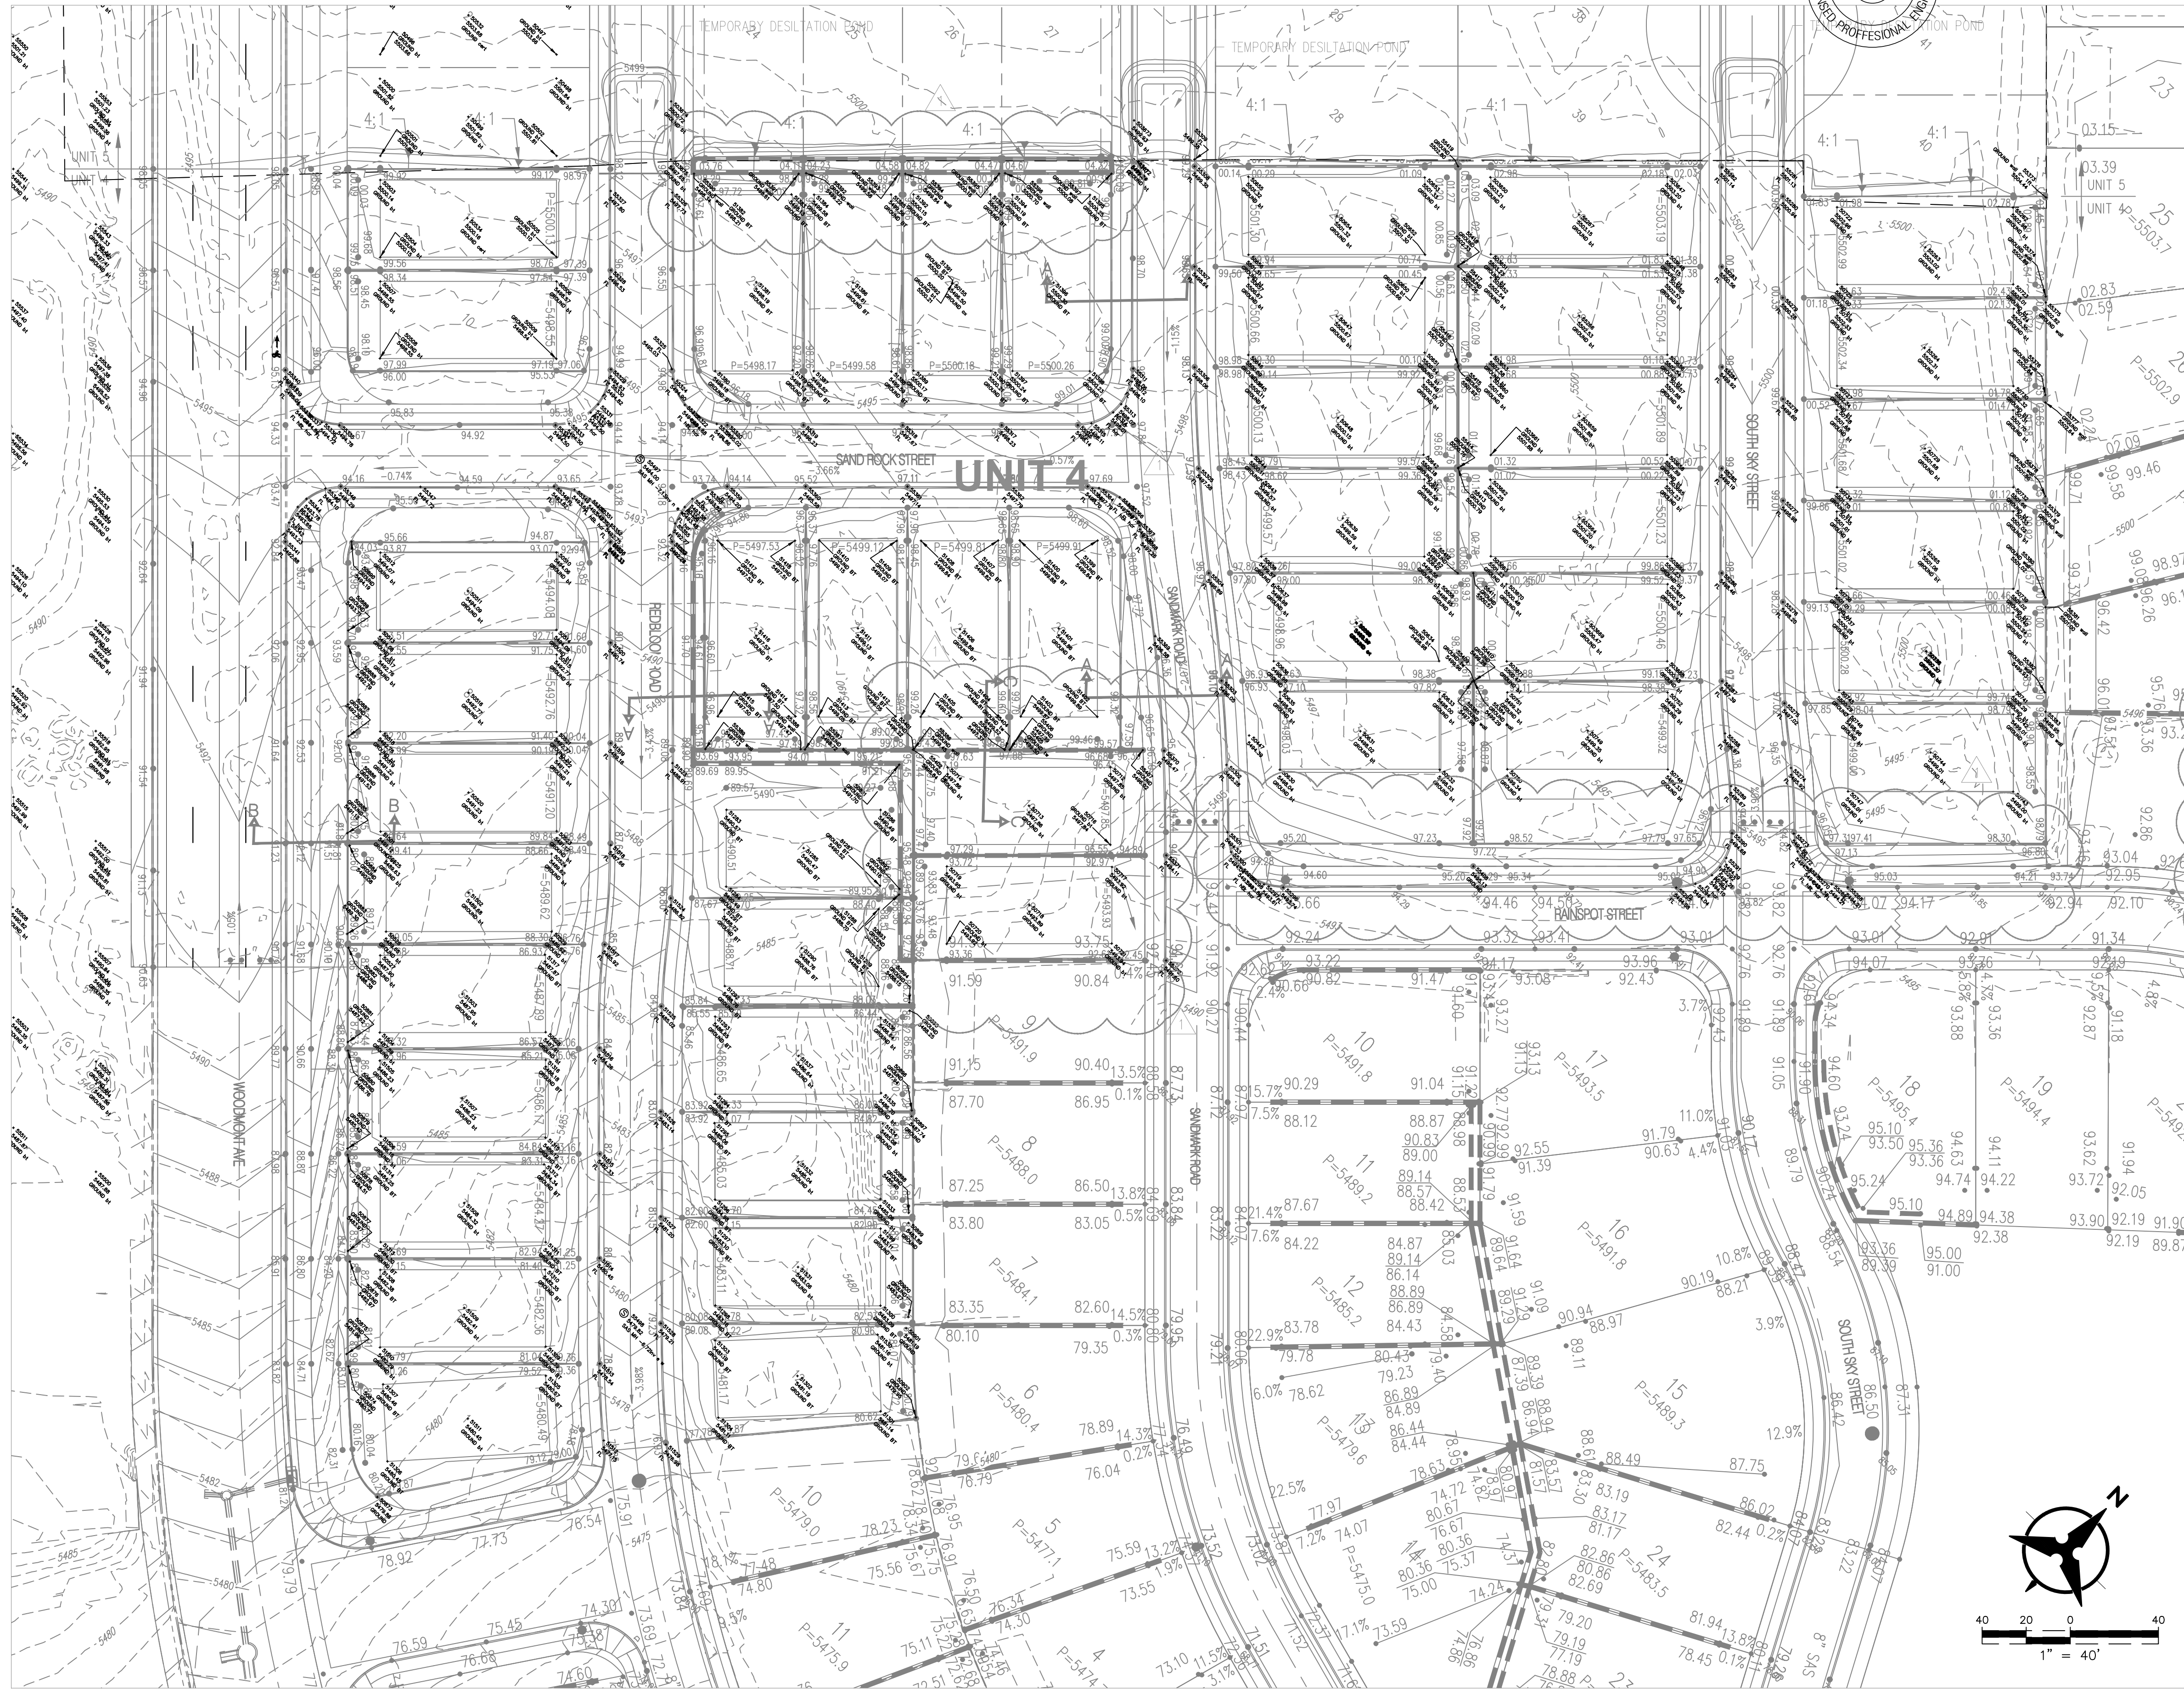

- LEGEND**
- PROPOSED SPOT ELEVATION: 5235.25
  - EXISTING SPOT ELEVATION: EX 5235.25
  - PROPOSED CONTOUR: 5205
  - EXISTING STORM DRAIN LINE: - - - - -
  - PROPOSED STORM DRAIN INLET: [Symbol]
  - PROPOSED STORM DRAIN LINE: [Symbol]
  - PROPOSED STORM DRAIN MANHOLE: [Symbol]
  - PROPOSED WATER BLOCK: [Symbol]
  - RETAINING WALL: [Symbol]
  - PAD: [Symbol]
  - TURNED BLOCK: [Symbol]
  - STREET SLOPE: [Symbol]
  - PHASE BOUNDARY: [Symbol]

**Bohannon & Huston**  
www.bhinc.com 800.877.5332

**CITY OF ALBUQUERQUE  
PUBLIC WORKS DEPARTMENT**

VALLE PRADO			
UNIT 4			
GRADING AND DRAINAGE PLAN			
Design Review Committee	City Engineer Approval	Mo./Day/Yr.	Mo./Day/Yr.
City Project No.	Zone Map No.	Sheet	Of
		C-09-Z	1
		1	2
		1	2