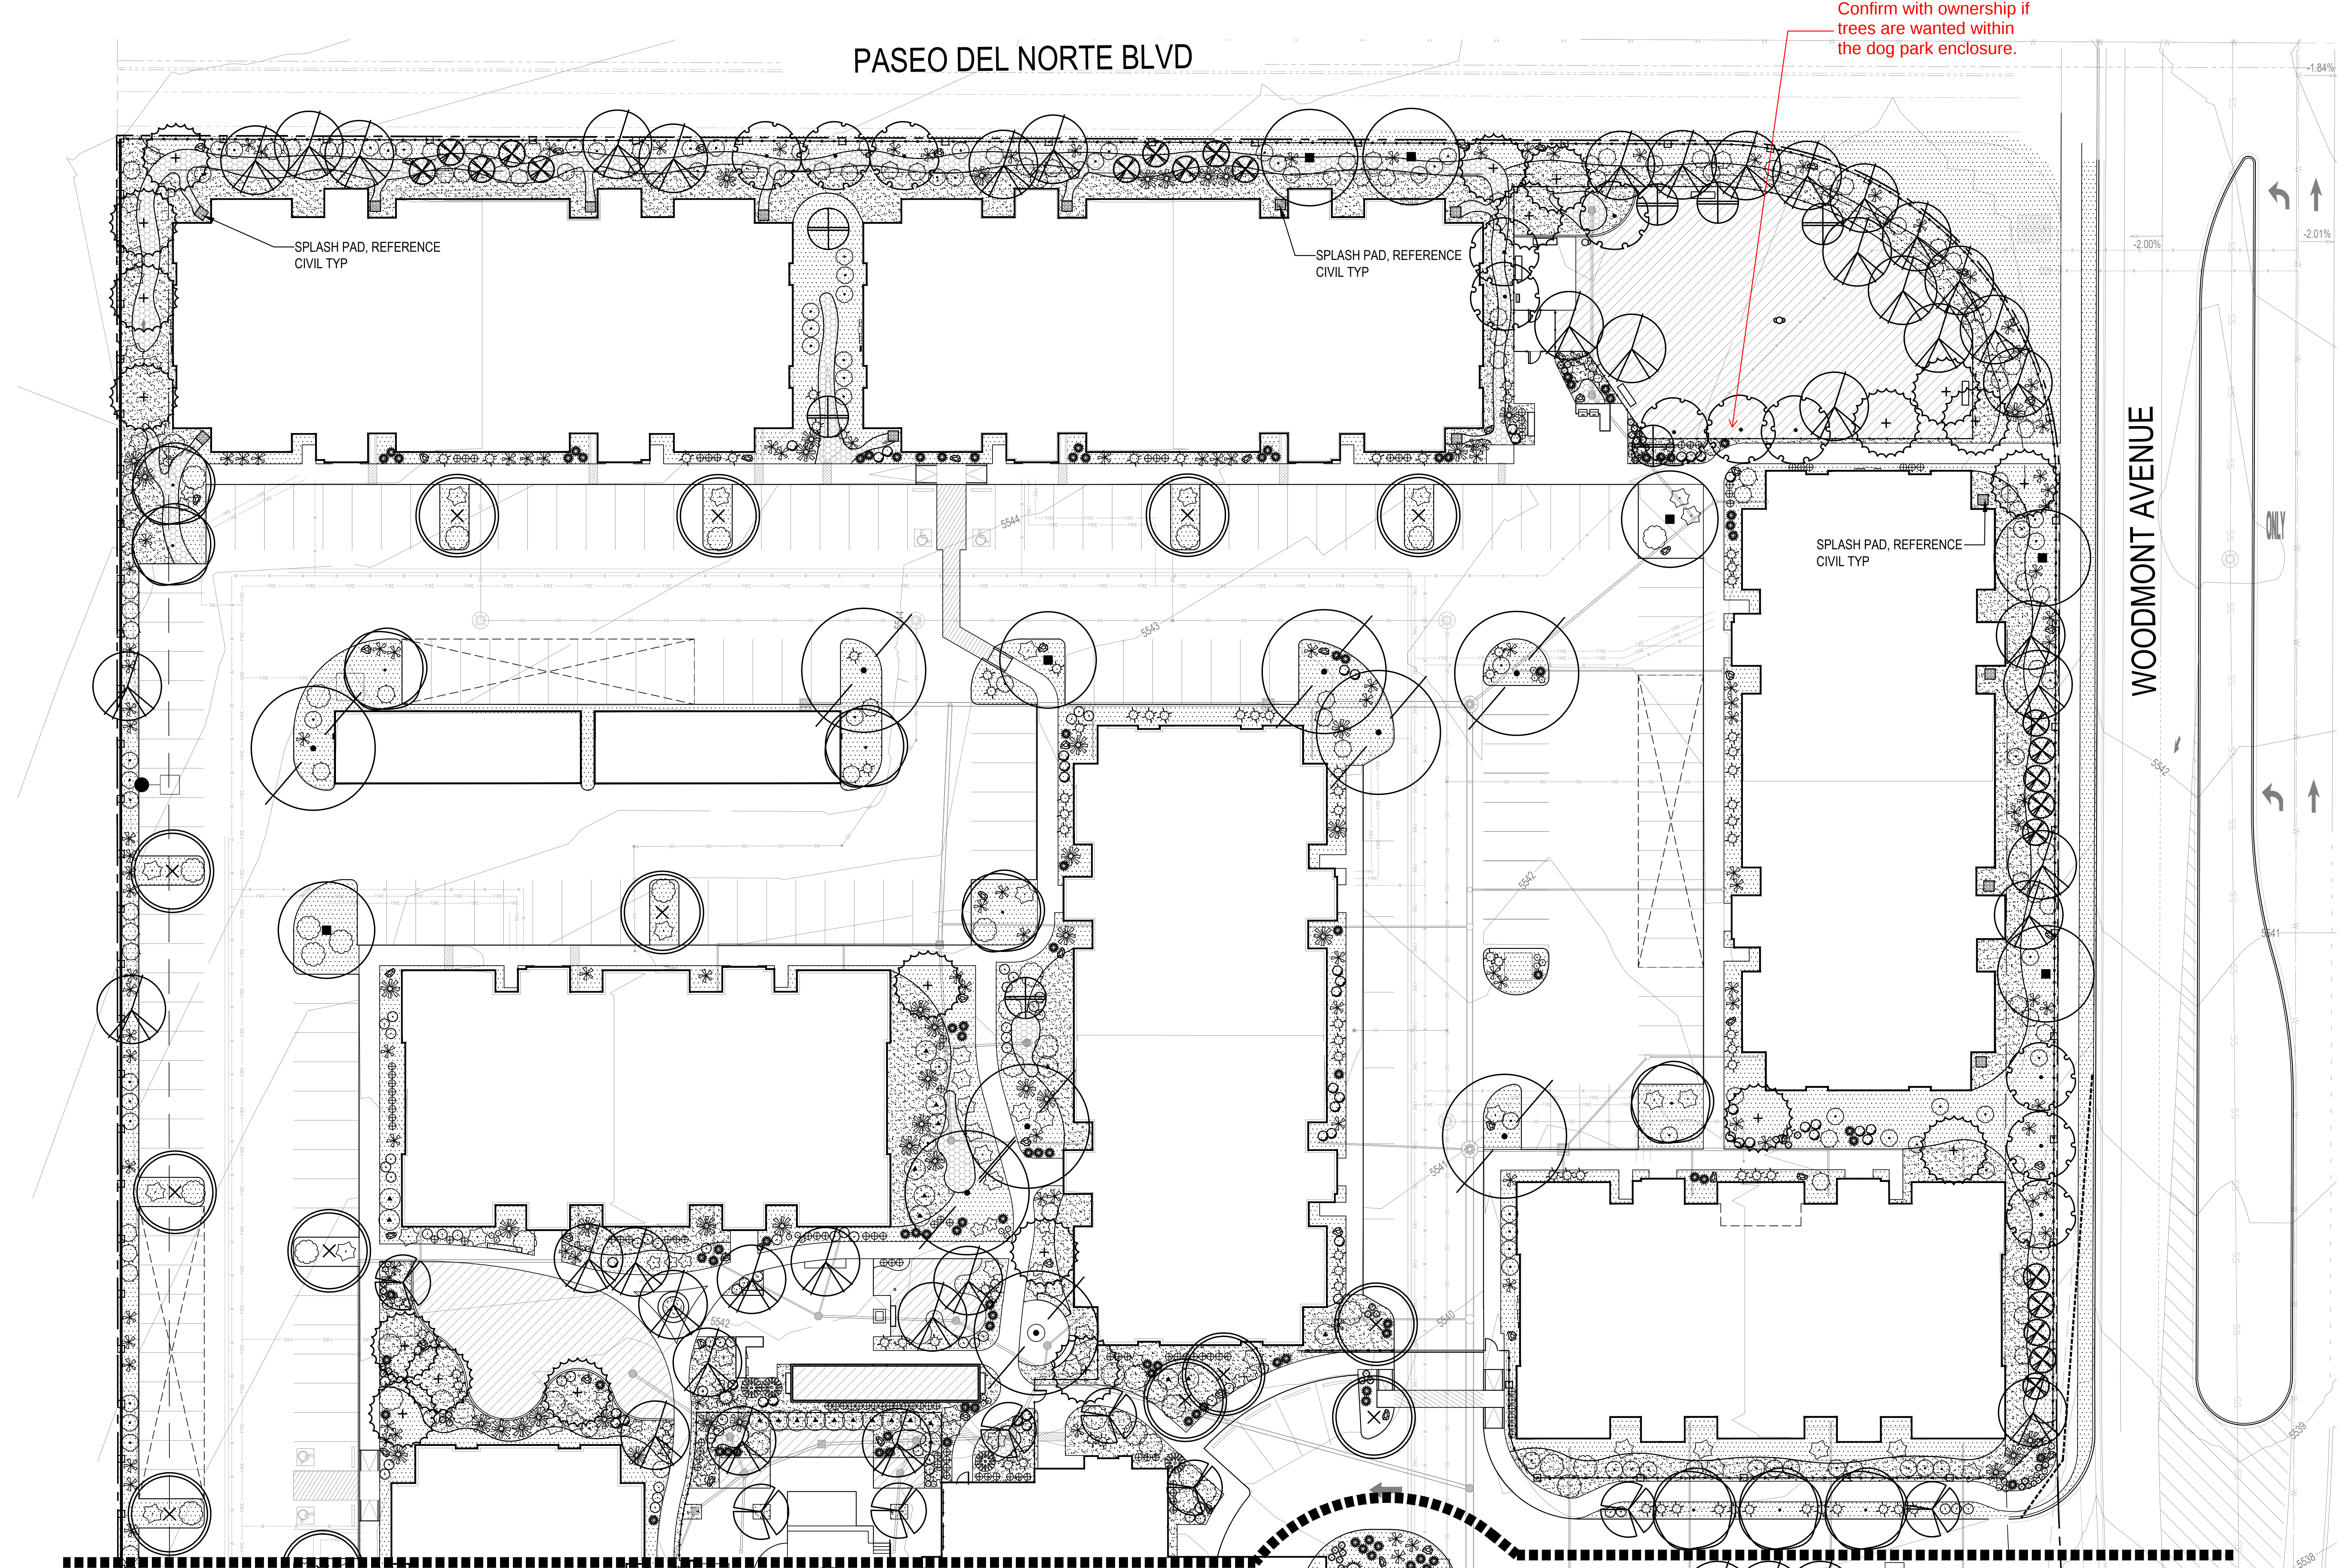




PLANT LEGEND

SYMBOL BOTANICAL NAME COMMON NAME

TREES - REFERENCE DETAIL 1-2/L502

	<i>Gleditsia triacanthos</i> var. <i>inermis</i> 'Imperial'	IMPERIAL HONEY LOCUST
	<i>Acer x freemanii</i> 'Autumn Blaze'	AUTUMN BLAZE MAPLE
	<i>Ulmus</i> 'Frontier'	FRONTIER ELM
	<i>Robinia ambigua</i> 'Purple Robe'	PURPLE ROBE LOCUST
	<i>Forestiera neomexicana</i>	NEW MEXICO OLIVE
	<i>Chilopsis linearis</i> 'Bubba'	DESERT WILLOW
	<i>Celtis reticulata</i>	NETLEAF HACKBERRY
	<i>Vitex agnus-castus</i>	CHASTE TREE
	<i>Pinus nigra</i>	AUSTRIAN PINE
	<i>Juniperus virginiana</i> 'Skyrocket' (FEMALE ONLY)	SKYROCKET JUNIPER (FEMALE ONLY)

SHRUBS - REFERENCE DETAIL 3-4/L502

	<i>Lagerstroemia indica</i> sp.	CRAPE MYRTLE SHRUB
	<i>Chrysothamnus nauseosus</i>	CHAMISA
	<i>Caryopteris x clandonensis</i>	BLUE MIST SPIREA
	<i>Pinus mugo</i>	MUGO PINE

SYMBOL BOTANICAL NAME COMMON NAME

	<i>Fallugia paradoxa</i>	APACHE PLUME
	<i>Buddleja davidii</i>	BLACK KNIGHT BUTTERFLY BUSH
	<i>Hesperaloe parviflora</i>	RED/YELLOW YUCCA
	<i>Dasyliiron wheeleri</i>	DESERT SPOON
	<i>Rhus trilobata</i> 'Autumn Amber'	AUTUMN AMBER SUMAC
	<i>Cytisus scoparius</i> 'Lena'	SCOTCH BROOM
	<i>Juniperus horizontalis</i> 'Blue Chip'	BLUE CHIP JUNIPER
	<i>Ericameria laricifolia</i> 'Aquirre'	TURPENTINE BUSH
	<i>Lavandula angustifolia</i> 'Hidcote'	HIDCOTE LAVENDER
	<i>Salvia greggii</i>	CHERRY SAGE
	<i>Achillea</i> 'Moonshine'	MOONSHINE YARROW
	<i>Sphaeralcea coccinea</i>	SCARLET GLOBEMALLOW
	<i>Muhlenburgia capillaris</i>	PINK MUHLY
	<i>Calamagrostis x acutiflora</i> 'Karl Foerster'	FEATHER REED GRASS

LANDSCAPE MATERIALS

QTY	SYMBOL	DESCRIPTION
		3' DEPTH 3/8" 1" AMARETTO BROWN OVER FILTER FABRIC
		3' DEPTH 1" CANYON GOLD GRAVEL OVER FILTER FABRIC
		4' DEPTH 2" 4" SANGRIA COBBLE OVER FILTER FABRIC
		NOTE: SHREDDED BARK MULCH WILL BE PROVIDED BENEATH THE ENTIRE TREE CANOPY FOR ALL NEW TREES IN LANDSCAPE AREAS. EXCEPT WHERE TREES ARE LOCATED IN COBBLE. PUEBLO ROSE LANDSCAPE BOULDERS (3 MIN. DIMENSION), REFERENCE DETAIL 5/L502
		REVEGETATIVE SEEDING AREAS SHALL BE RE-VEGETATED BY HYDROMULCH APPLICATION PER NATIVE SEEDING SPECIFICATION SECTION 92 3200. LIMITS OF RE-VEGETATED SEEDING SHOWN ON PLANS IS SCHEMATIC. CONTRACTOR SHALL APPLY RE-VEGETATED SEED TO LIMIT OF DISTURBANCE. SANDY SOILS MIX (20 LBS. PLS PER ACRE TOTAL) OR EQUAL.

	RE-VEGETATIVE SEEDING WITH 1" 4" GRAY ANGULAR ROCK OVER DIRT
	NOTE: POND TREATMENT TO COMPLY WITH EPA CGP 2.2.14b. SYNTHETIC GRASS, REFERENCE ARCHITECTURE PLANS

A1 LANDSCAPE PLAN
SCALE: 1"=20'-0"
0 20' 40' NORTH

See comments on irrigation sheets

Designed by:	GJ	
Drawn by:		
Architect of Record:	RM	
Date Plotted:		
Issue for Pricing / Bidding:	XX/XX/XX	
Issue for Permit Application:	XX/XX/XX	
Issue for Construction:	XX/XX/XX	
Revisions:		
#	DATE	COMMENTS

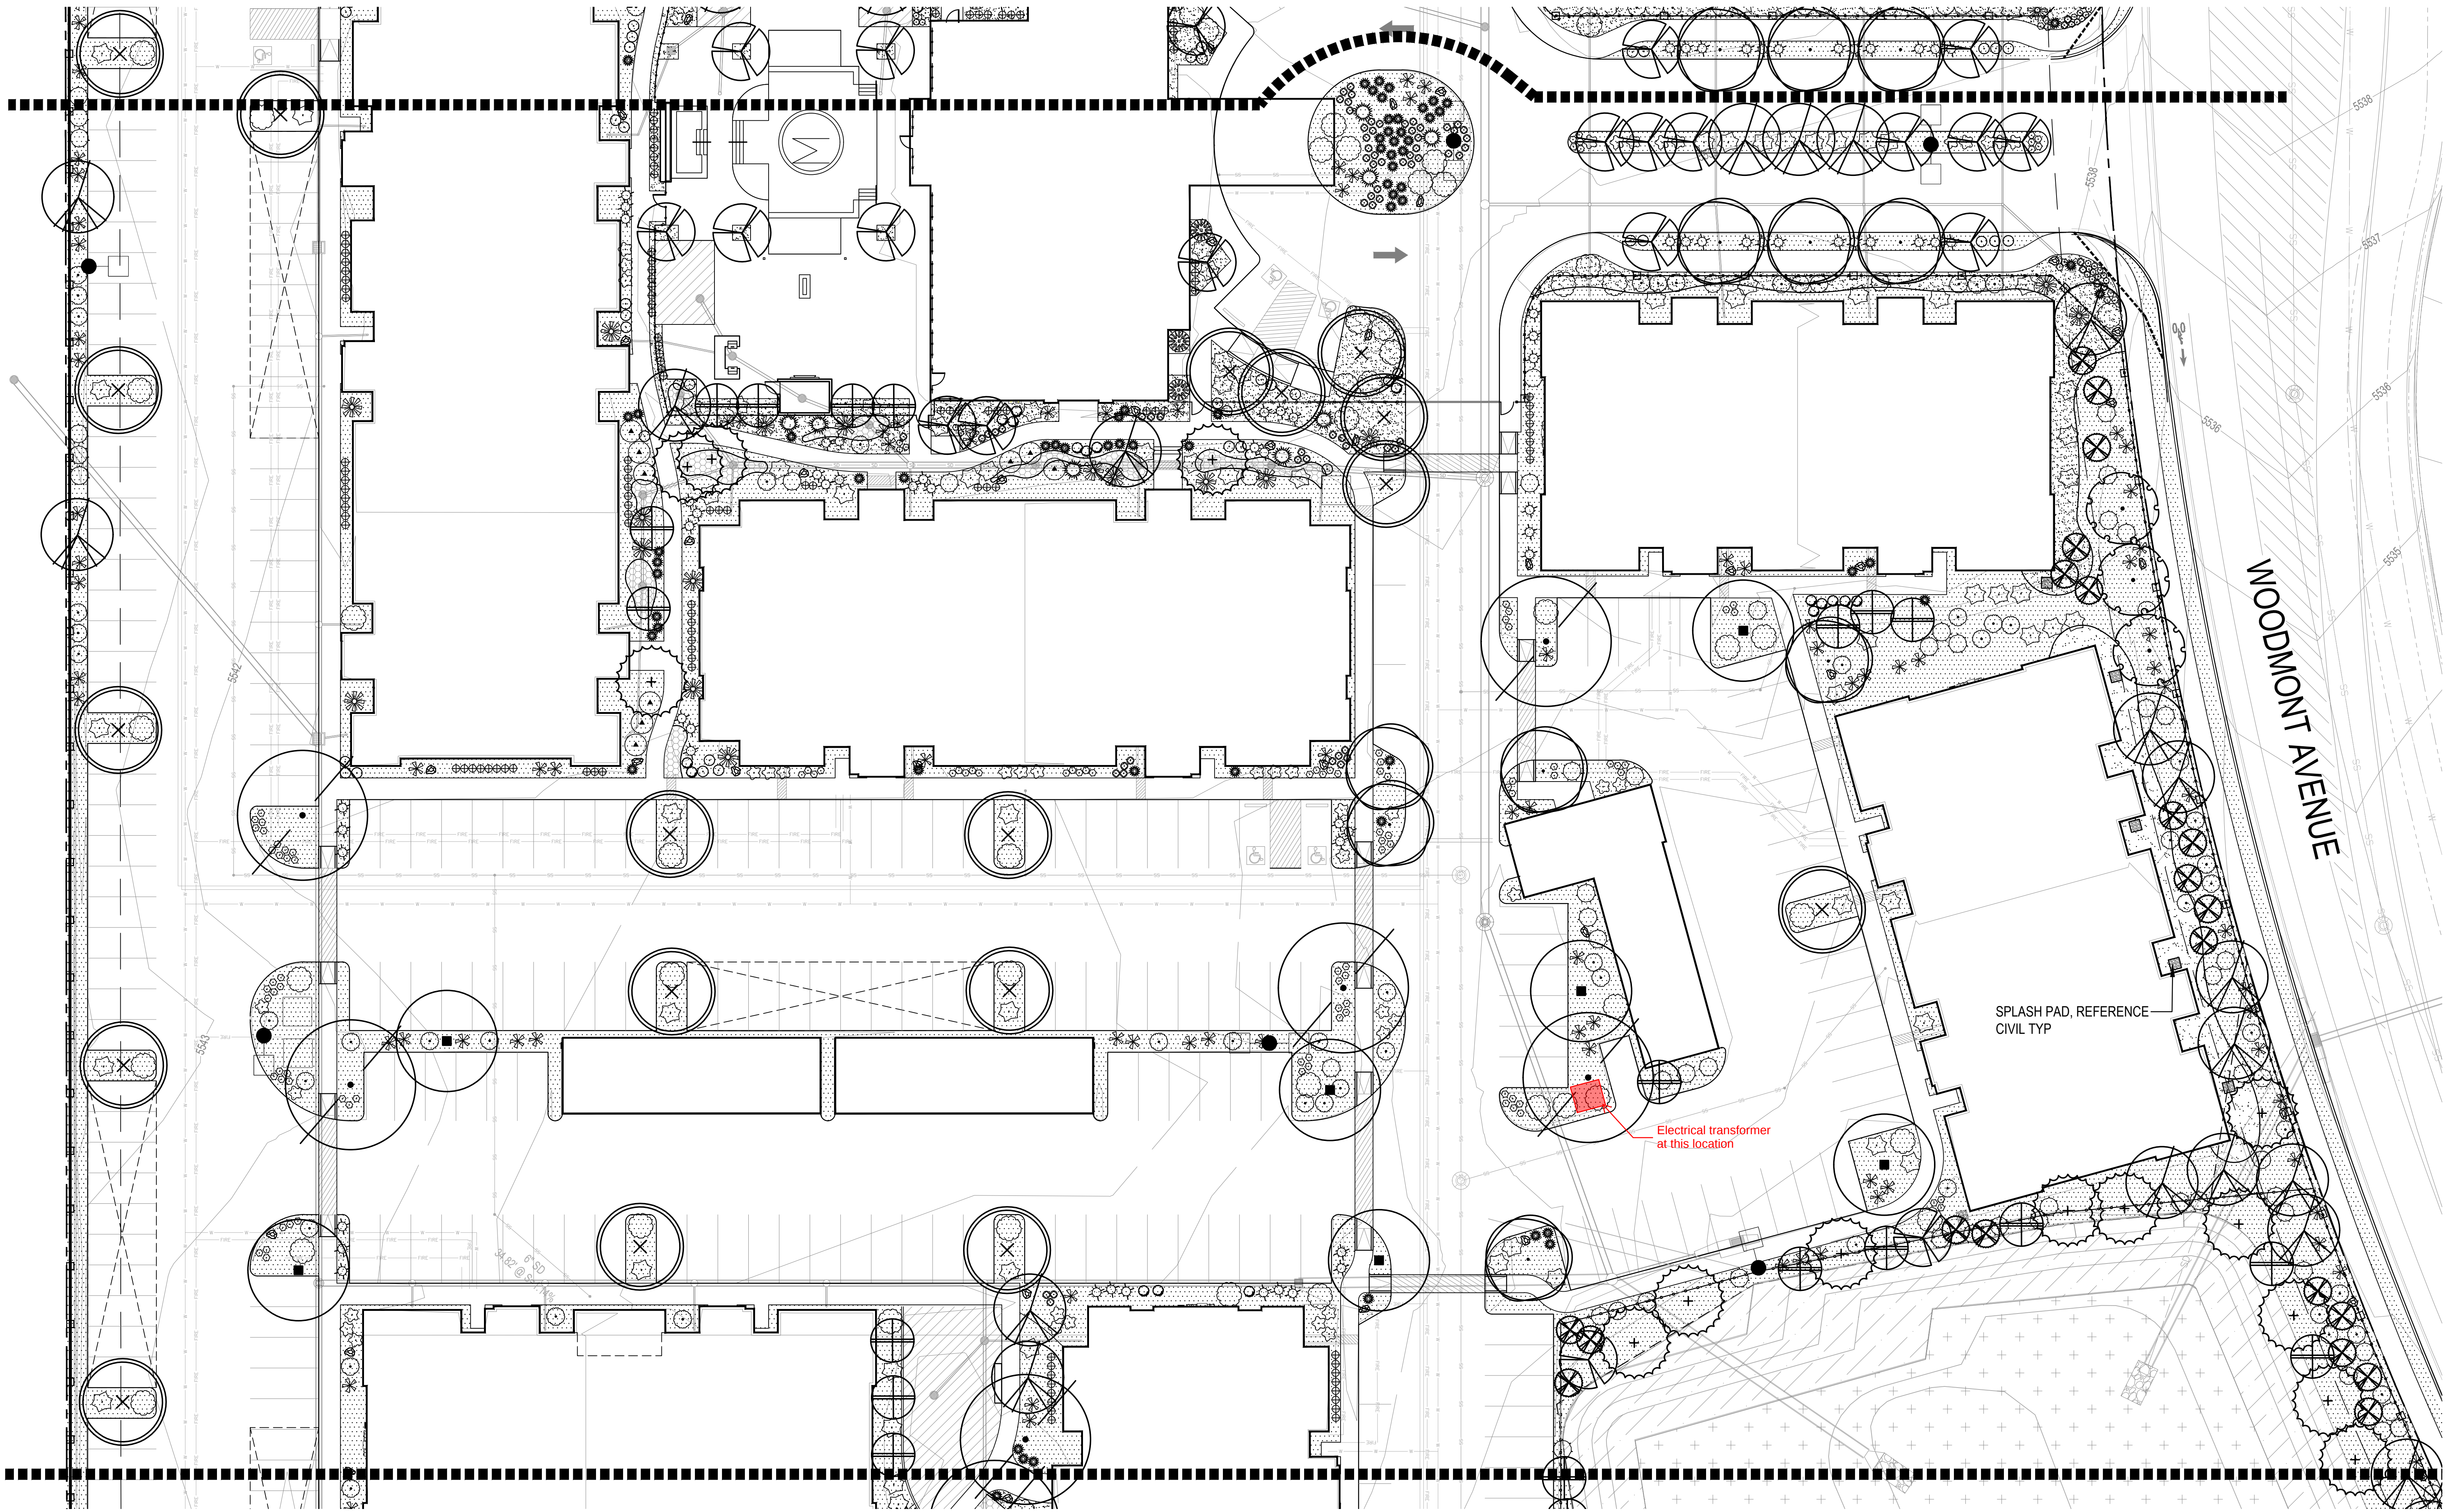
CONSENSUS PLANNING, INC.
Planning / Landscape Architecture
300 South Street NW
Albuquerque, NM 87102
(505) 764-9801 Fax 842-5495
e-mail: cpl@consensusplanning.com

PAC VENTURES
CORPORATION

The Preserve at Woodmont
ALBUQUERQUE, NEW MEXICO
PAC VENTURES INC

STATE OF NEW MEXICO
CHRISTOPHER J. GREEN
#234
REGISTERED
LANDSCAPE ARCHITECT
07/08/21

PERMIT SET: 07-08-2021
SHEET CONTENTS:
LANDSCAPE PLAN
SHEET NO.
L202
18666



PLANT LEGEND

SYMBOL	BOTANICAL NAME	COMMON NAME	SYMBOL	BOTANICAL NAME	COMMON NAME
TREES - REFERENCE DETAIL 1-2/L502					
	Gleditsia triacanthos var. inermis 'Imperial'	IMPERIAL HONEY LOCUST		Fallugia paradoxa	APACHE PLUME
	Acer x freemanii 'Autumn Blaze'	AUTUMN BLAZE MAPLE		Buddleja davidii	BLACK KNIGHT
	Ulmus 'Frontier'	FRONTIER ELM		Hesperaloe parviflora	BUTTERFLY BUSH
	Robinia ambigua 'Purple Robe'	PURPLE ROBE LOCUST		Dasylirotrion wheeleri	RED/YELLOW YUCCA
	Forestiera neomexicana	NEW MEXICO OLIVE		Rhus trilobata 'Autumn Amber'	DESERT SPOON
	Chilopsis linearis 'Bubba'	DESERT WILLOW		Cytisus scoparius 'Lena'	AUTUMN AMBER SUMAC
	Celtis reticulata	NETLEAF HACKBERRY		Juniperus horizontalis	SCOTCH BROOM
	Vitex agnus-castus	CHASTE TREE		Juniperus horizontalis 'Blue Chip'	BLUE CHIP JUNIPER
	Pinus nigra	AUSTRIAN PINE		Ericameria laricifolia 'Aquirre'	TURPENTINE BUSH
	Juniperus virginiana 'Skyrocket'	SKYROCKET JUNIPER (FEMALE ONLY)		Lavandula angustifolia 'Hidcote'	HIDCOTE LAVENDER
SHRUBS - REFERENCE DETAIL 3-4/L502					
	Lagerstroemia indica sp.	GRAPE MYRTLE SHRUB		Salvia greggii	CHAMAISA
	Chrysothamnus nauseosus	BLUE MIST SPIREA		Achillea 'Moonshine'	MOONSHINE YARROW
	Caryopteris x clandonensis	MUGO PINE		Sphaeralcea coccinea	PINK MUHLY
	Pinus mugo			Muhlenbergia capillaris	FEATHER REED GRASS

LANDSCAPE MATERIALS

QTY	SYMBOL	DESCRIPTION
		3' DEPTH 3/8-1\"/>
		3' DEPTH 1\"/>
		4' DEPTH 2-4\"/>
		PUEBLO ROSE LANDSCAPE BOULDERS (3' MIN. DIMENSION), REFERENCE DETAIL S/L502
		RE-VEGETATIVE SEEDING WITH 1\"/>
		SYNTHETIC GRASS, REFERENCE ARCHITECTURE PLANS

A1

LANDSCAPE PLAN

SCALE: 1"=20'-0"

0 20' 40'

NORTH

Designed by:	GJ	
Drawn by:		
Architect of Record:	RM	
Date Plotted:		
Issue for Pricing / Bidding:	XX/XX/XX	
Issue for Permit Application:	XX/XX/XX	
Issue for Construction:	XX/XX/XX	
Revisions:		
#	DATE	COMMENTS

CONSENSUS PLANNING, INC.
Planning / Landscape Architecture
302 Fourth Street NW
Albuquerque, NM 87102
(505) 764-9801 • Fax 842-5495
e-mail: cpl@consensusplanning.com

PAC VENTURES
INCORPORATED

The Preserve at Woodmont
ALBUQUERQUE, NEW MEXICO
PAC VENTURES INC

STATE OF NEW MEXICO
CHRISTOPHER J. GREEN
#234
REGISTERED
LANDSCAPE ARCHITECT
07/08/21

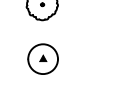
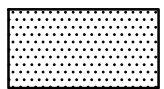
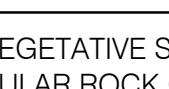
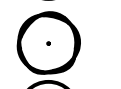
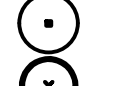
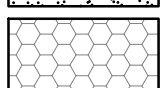
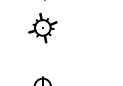
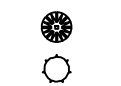
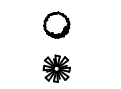
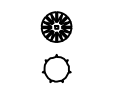
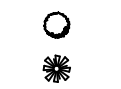
SHEET CONTENTS:
PLANTING
PLAN
SHEET NO.


L203
18666

See comments on irrigation sheets

PERMIT SET: 07-08-2021

PLANT LEGEND

SYMBOL	BOTANICAL NAME	COMMON NAME	SYMBOL	BOTANICAL NAME	COMMON NAME	LANDSCAPE MATERIALS		
						QTY	SYMBOL	DESCRIPTION
TREES - REFERENCE DETAIL 1-2/L502								
	Glodistia triacanthos var. inermis 'Imperial'	IMPERIAL HONEY LOCUST		Fallugia paradoxa	APACHE PLUME		3' DEPTH 3/8"-1" AMARETTO BROWN OVER FILTER FABRIC	 RE-VEGETATIVE SEEDING WITH 1'-4" GRAY ANGULAR ROCK OVER DIRT
	Acer x freemanii 'Autumn Blaze'	AUTUMN BLAZE MAPLE		Buddleja davidii 'Black Knight'	BLACK KNIGHT BUTTERFLY BUSH		3' DEPTH 1" CANYON GOLD GRAVEL OVER FILTER FABRIC	
	Ulmus 'Frontier'	FRONTIER ELM		Hesperaloe parviflora	RED/YELLOW YUCCA		4' DEPTH 2'-4" SANGRIA COBBLE OVER FILTER FABRIC	NOTE: POND TREATMENT TO COMPLY WITH EPA CGP 2.2.14b
	Robinia ambigua 'Purple Robe'	PURPLE ROBE LOCUST		Dasyliroton wheeleri	DESERT SPOON			
	Forestiera neomexicana	NEW MEXICO OLIVE		Rhus trilobata 'Autumn Amber'	AUTUMN AMBER SUMAC			NOTE: SYNTHETIC GRASS, REFERENCE ARCHITECTURE PLANS
	Chilopsis linearis 'Bubba'	DESERT WILLOW		Cytisus scoparius 'Lena'	SCOTCH BROOM			
	Celtis reticulata	NETLEAF HACKBERRY		Juniperus horizontalis	BLUE CHIP JUNIPER			NOTE: SHREDDED BARK MULCH WILL BE PROVIDED BENEATH THE ENTIRE TREE CANOPY FOR ALL NEW TREES IN LANDSCAPE AREAS, EXCEPT WHERE TREES ARE LOCATED IN COBBLE.
	Vitex agnus-castus	CHASTE TREE		Ericameria laricifolia 'Aquirre'	TURPENTINE BUSH			
	Pinus nigra	AUSTRIAN PINE		Lavandula angustifolia 'Hidcote'	HIDCOTE LAVENDER			PUEBLO ROSE LANDSCAPE BOULDERS (3' MIN. DIMENSION), REFERENCE DETAIL 5/L502
	Juniperus virginiana 'Skyrocket' (FEMALE ONLY)	SKYROCKET JUNIPER (FEMALE ONLY)		Salvia greggii	CHERRY SAGE			
SHRUBS - REFERENCE DETAIL 3-4/L502								
	Lagerstroemia indica sp.	CRAPE MYRTLE SHRUB		Mulhenburgia capillaris	PINK MUHLY			REVEGETATIVE SEEDING AREAS SHALL BE RE-VEGETATED BY HYDROMULCH APPLICATION PER NATIVE SEEDING SPECIFICATION SECTION 92.3200. LIMITS OF RE-VEGETATED SEEDING SHOWN ON PLANS IS SCHEMATIC. CONTRACTOR SHALL APPLY RE-VEGETATED SEED TO LIMIT OF DISTURBANCE. SANDY SOILS MIX (20 LBS. PLS PER ACRE TOTAL) OR EQUAL.
	Chrysothamnus nauseosus	CHAMISA		Calamagrostis x acutiflora 'Karl Foerster'	FEATHER REED GRASS			
	Caryopteris x clandonensis	BLUE MIST SPIREA						
	Pinus mugo	MUGO PINE						

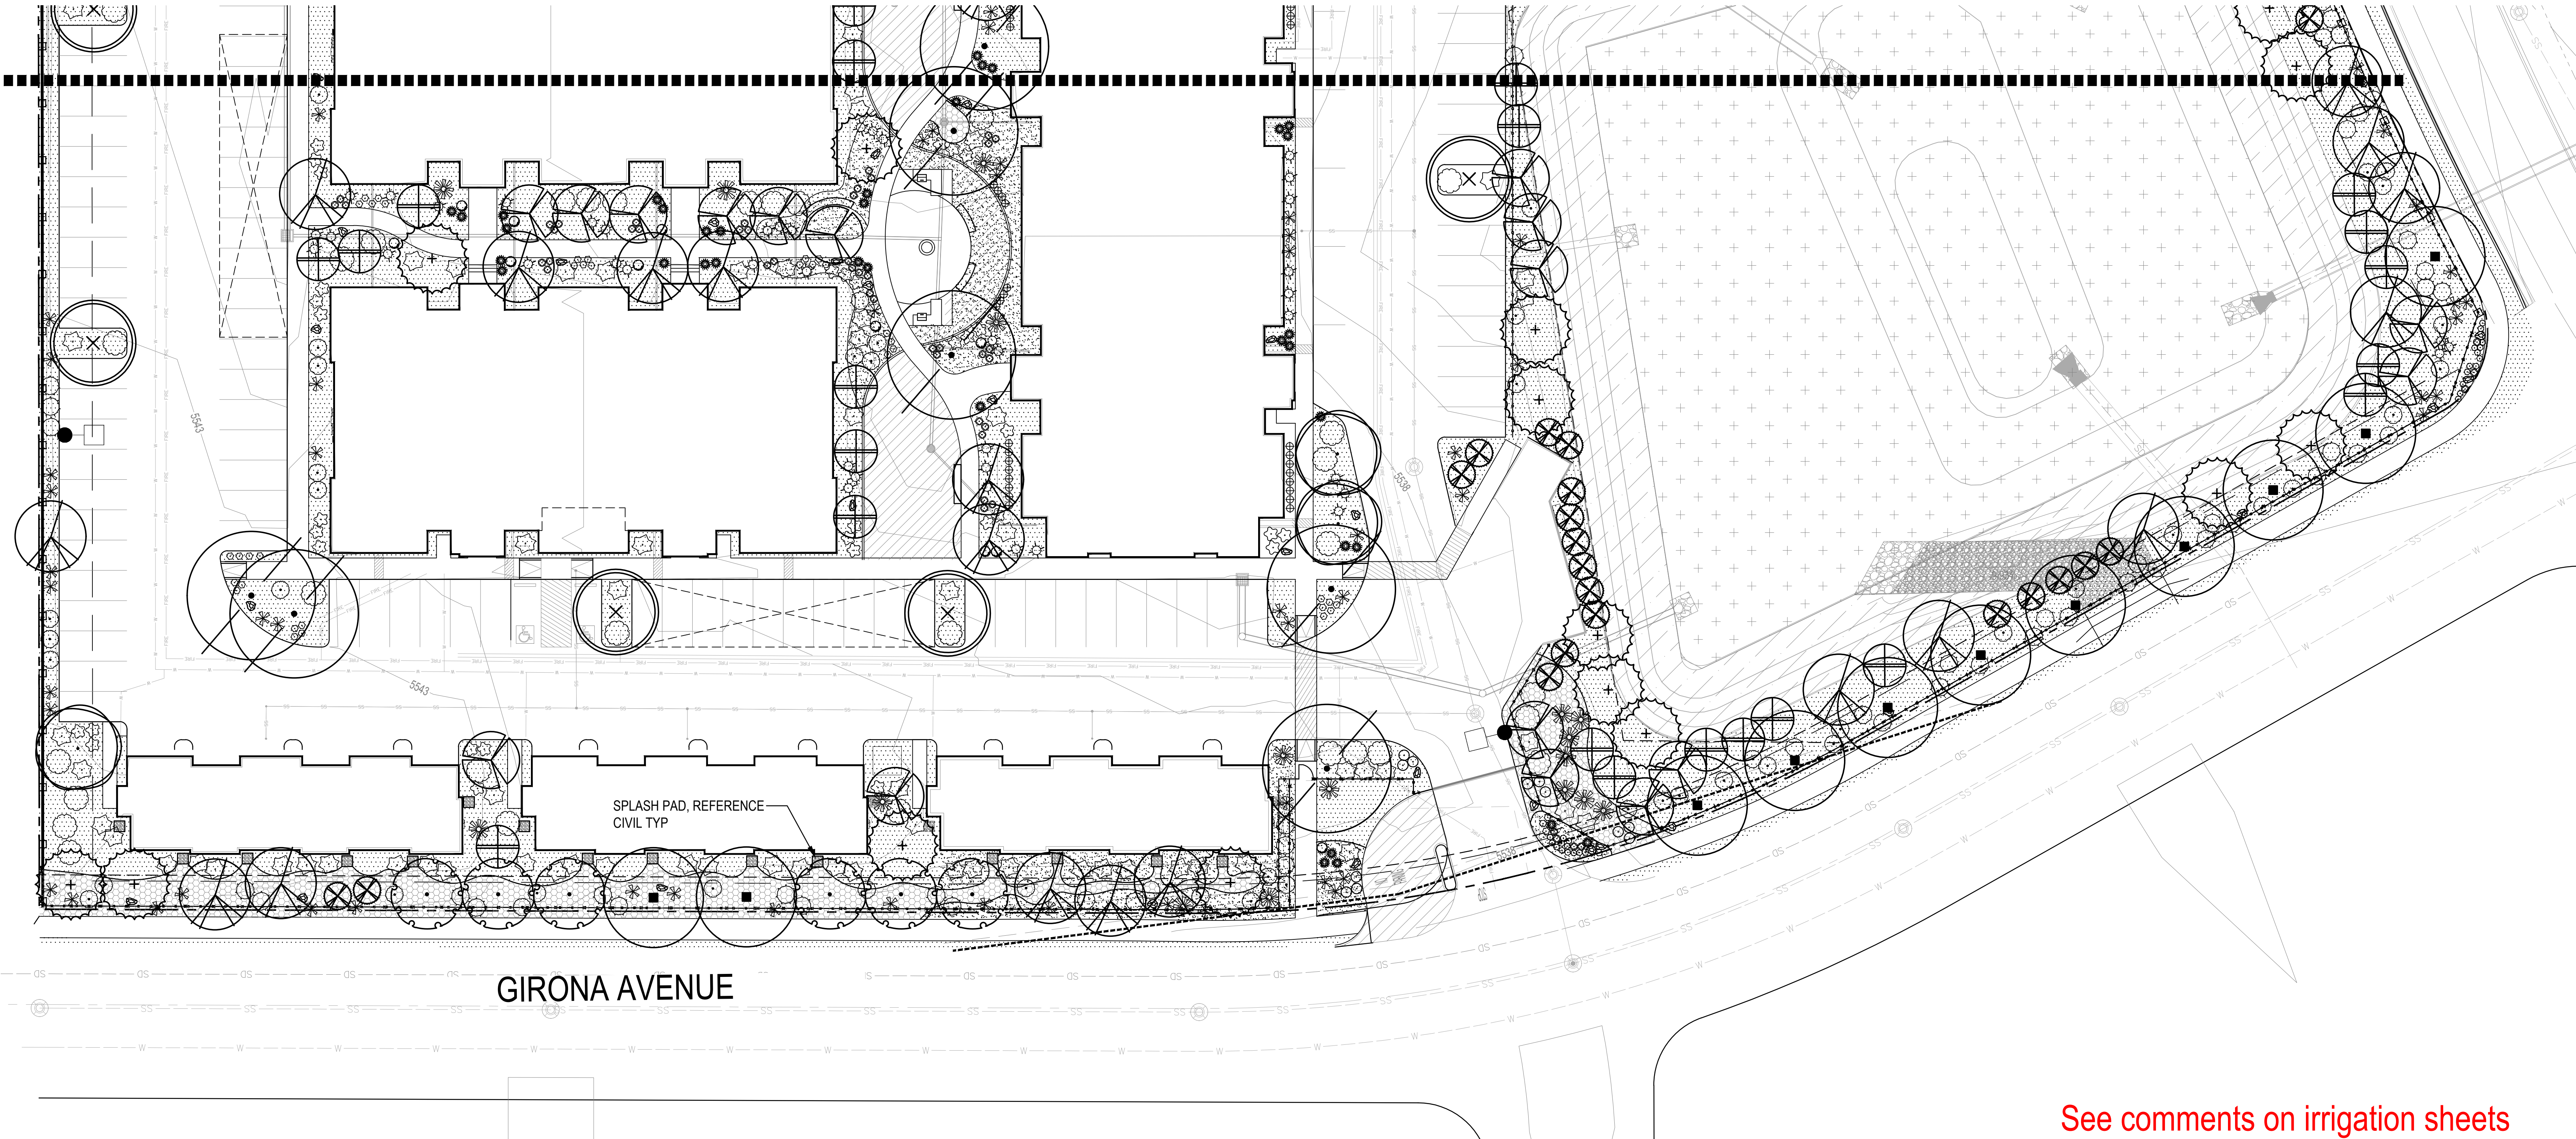

See comments on irrigation sheets