

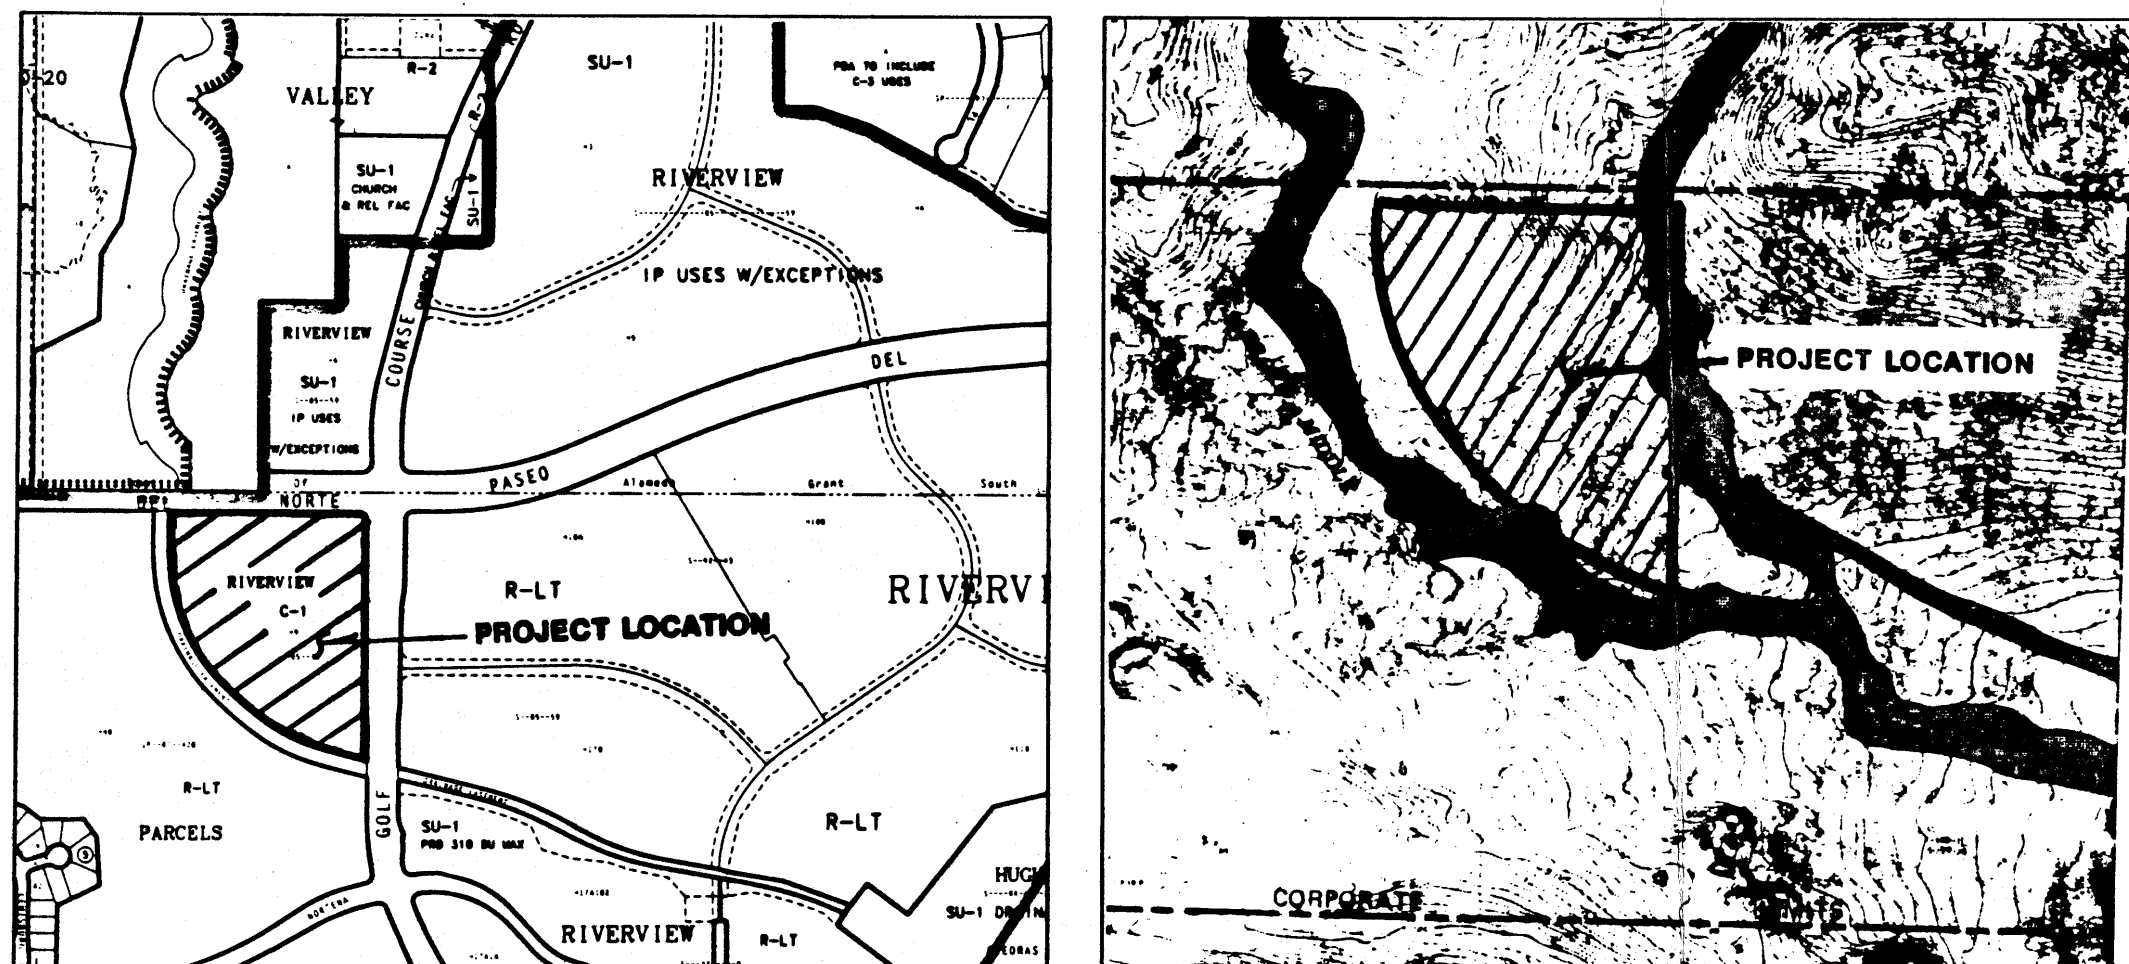
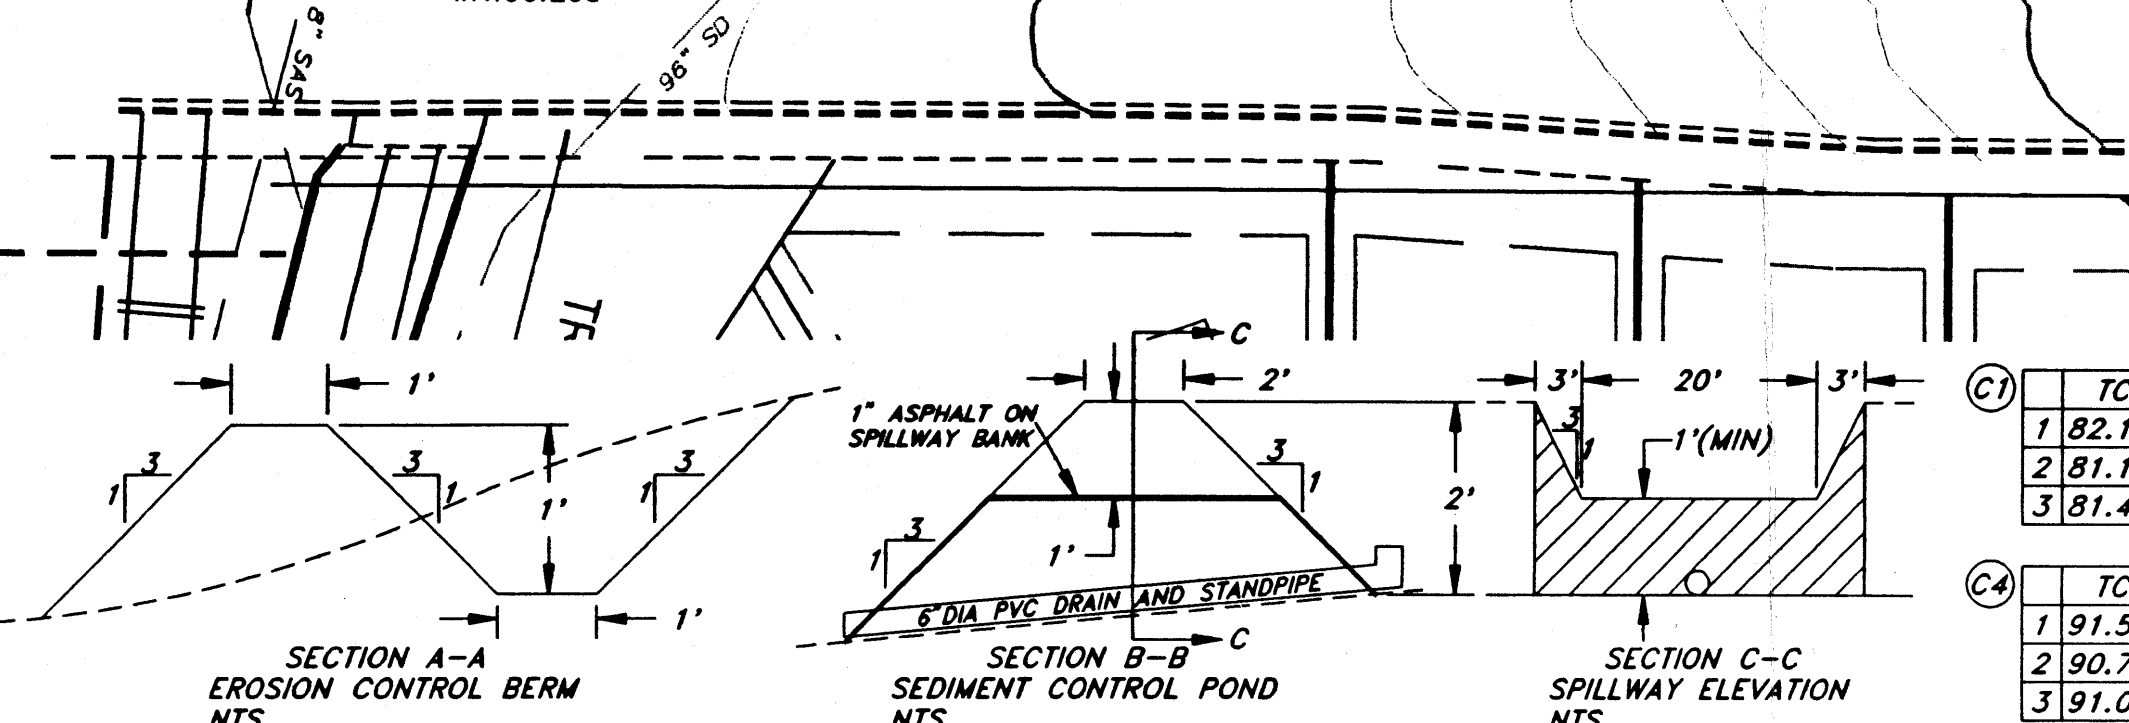


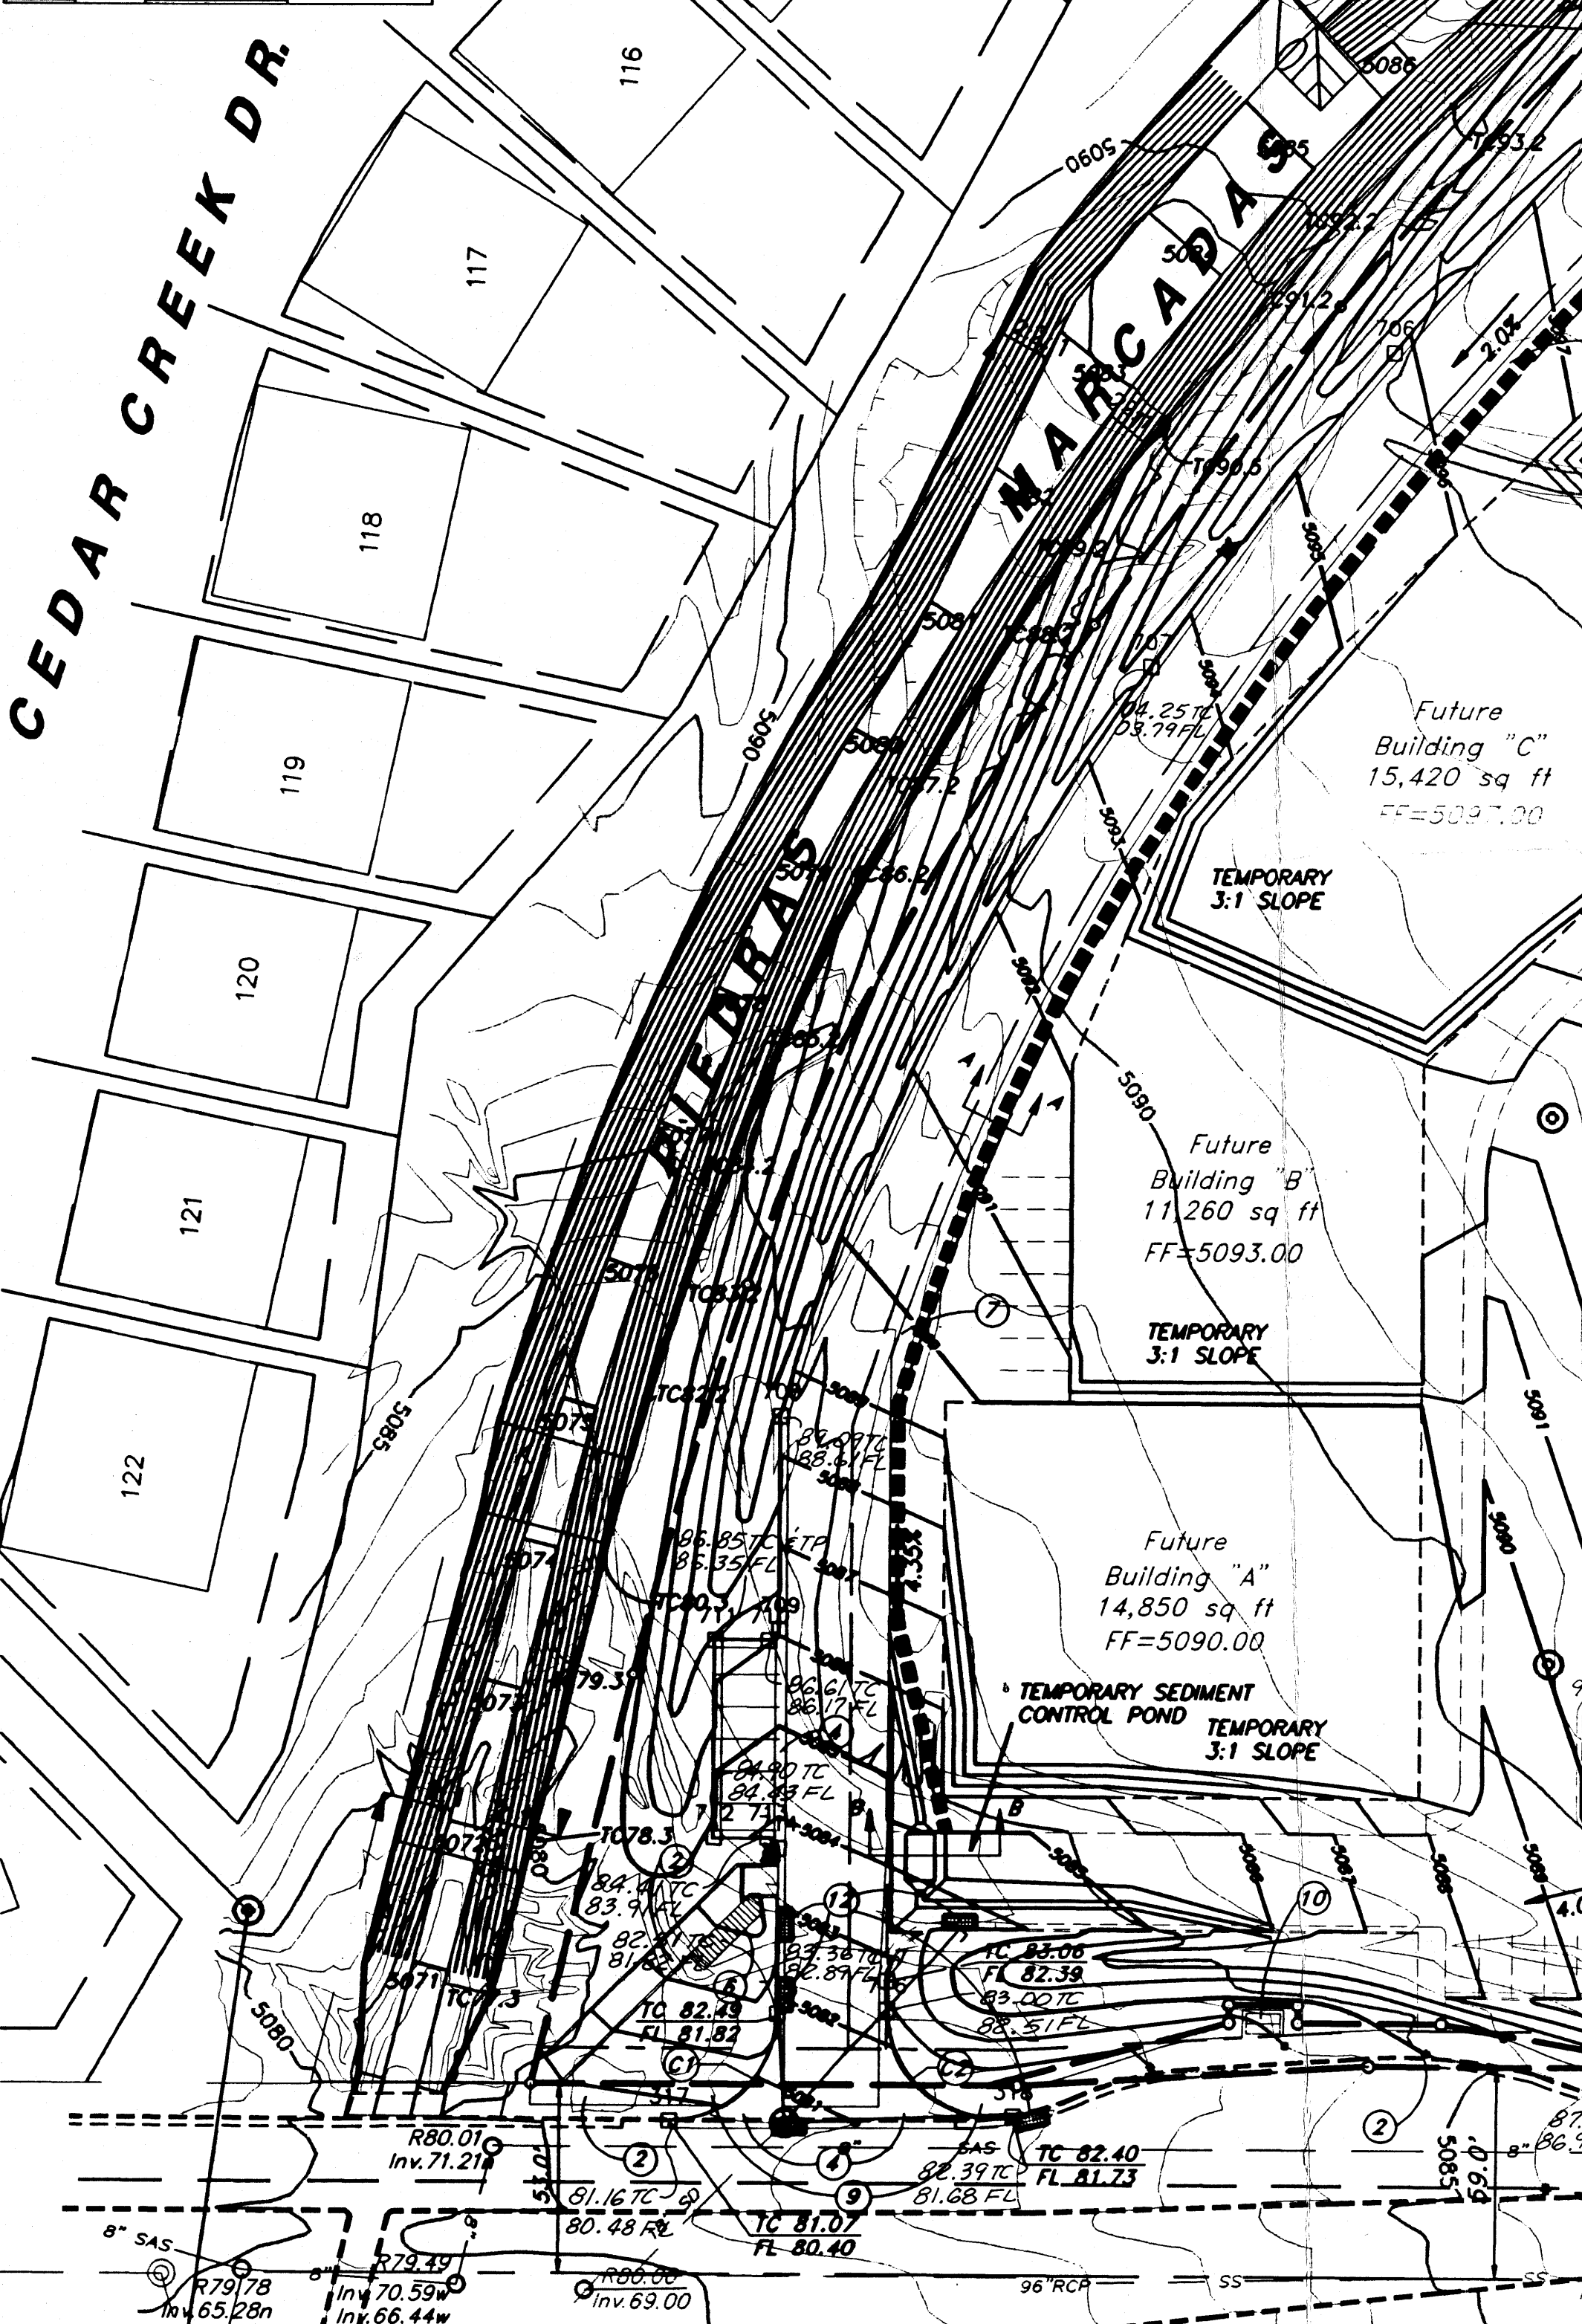



VICINITY MAP
ZONE ATLAS MAP NO. C-12-Z

FLOOD HAZARD MAP
COMMUNITY PANEL #

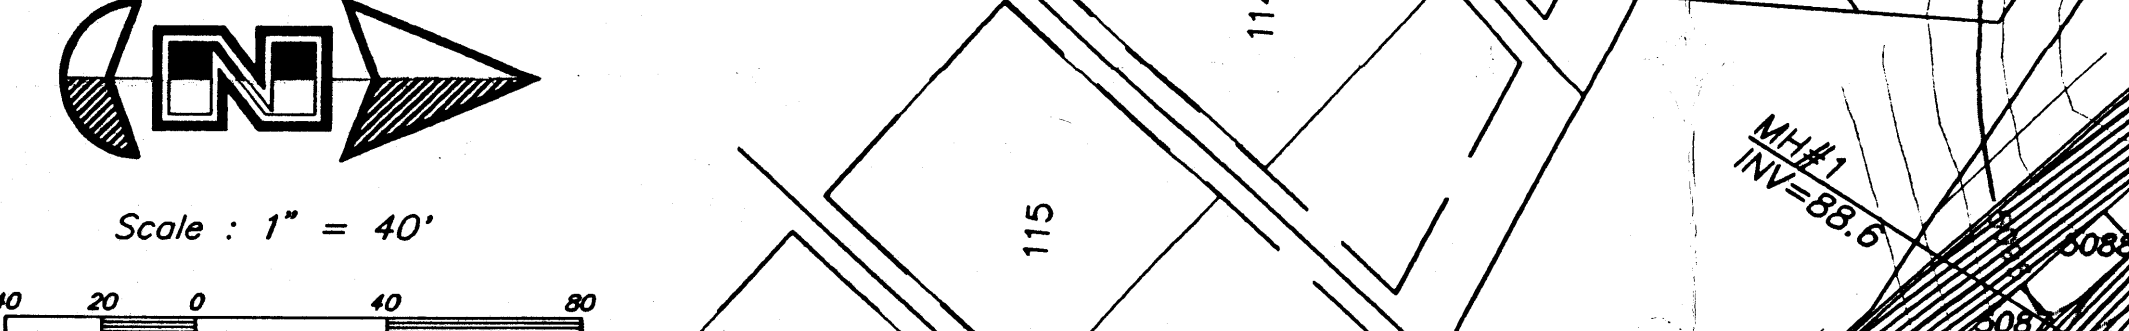

GRADING AND DRAINAGE CERTIFICATION

I, KERRY L. DAVIS, P.E. #9884, HAVE PERSONALLY VISITED THE SITE, AND HEREBY CERTIFY THAT THE SITE GRADING, PAVING, STORM DRAINAGE, AND OTHER IMPROVEMENTS ARE CONSTRUCTED IN SUBSTANTIAL COMPLIANCE WITH THIS APPROVED GRADING AND DRAINAGE PLAN, TO ALLOW THE IMPLEMENTATION OF THE DRAINAGE PATTERNS AND REQUIREMENTS IDENTIFIED HEREIN. AS-BUILT ELEVATIONS WERE VERIFIED BY FIELD SURVEY PERFORMED BY BASELINE FIELD SERVICES, INC. DURING SEPTEMBER, 1995. THIS STATEMENT DOES NOT REPRESENT CERTIFICATION OF CONTRACTORS CONSTRUCTION METHODS OR MATERIALS.

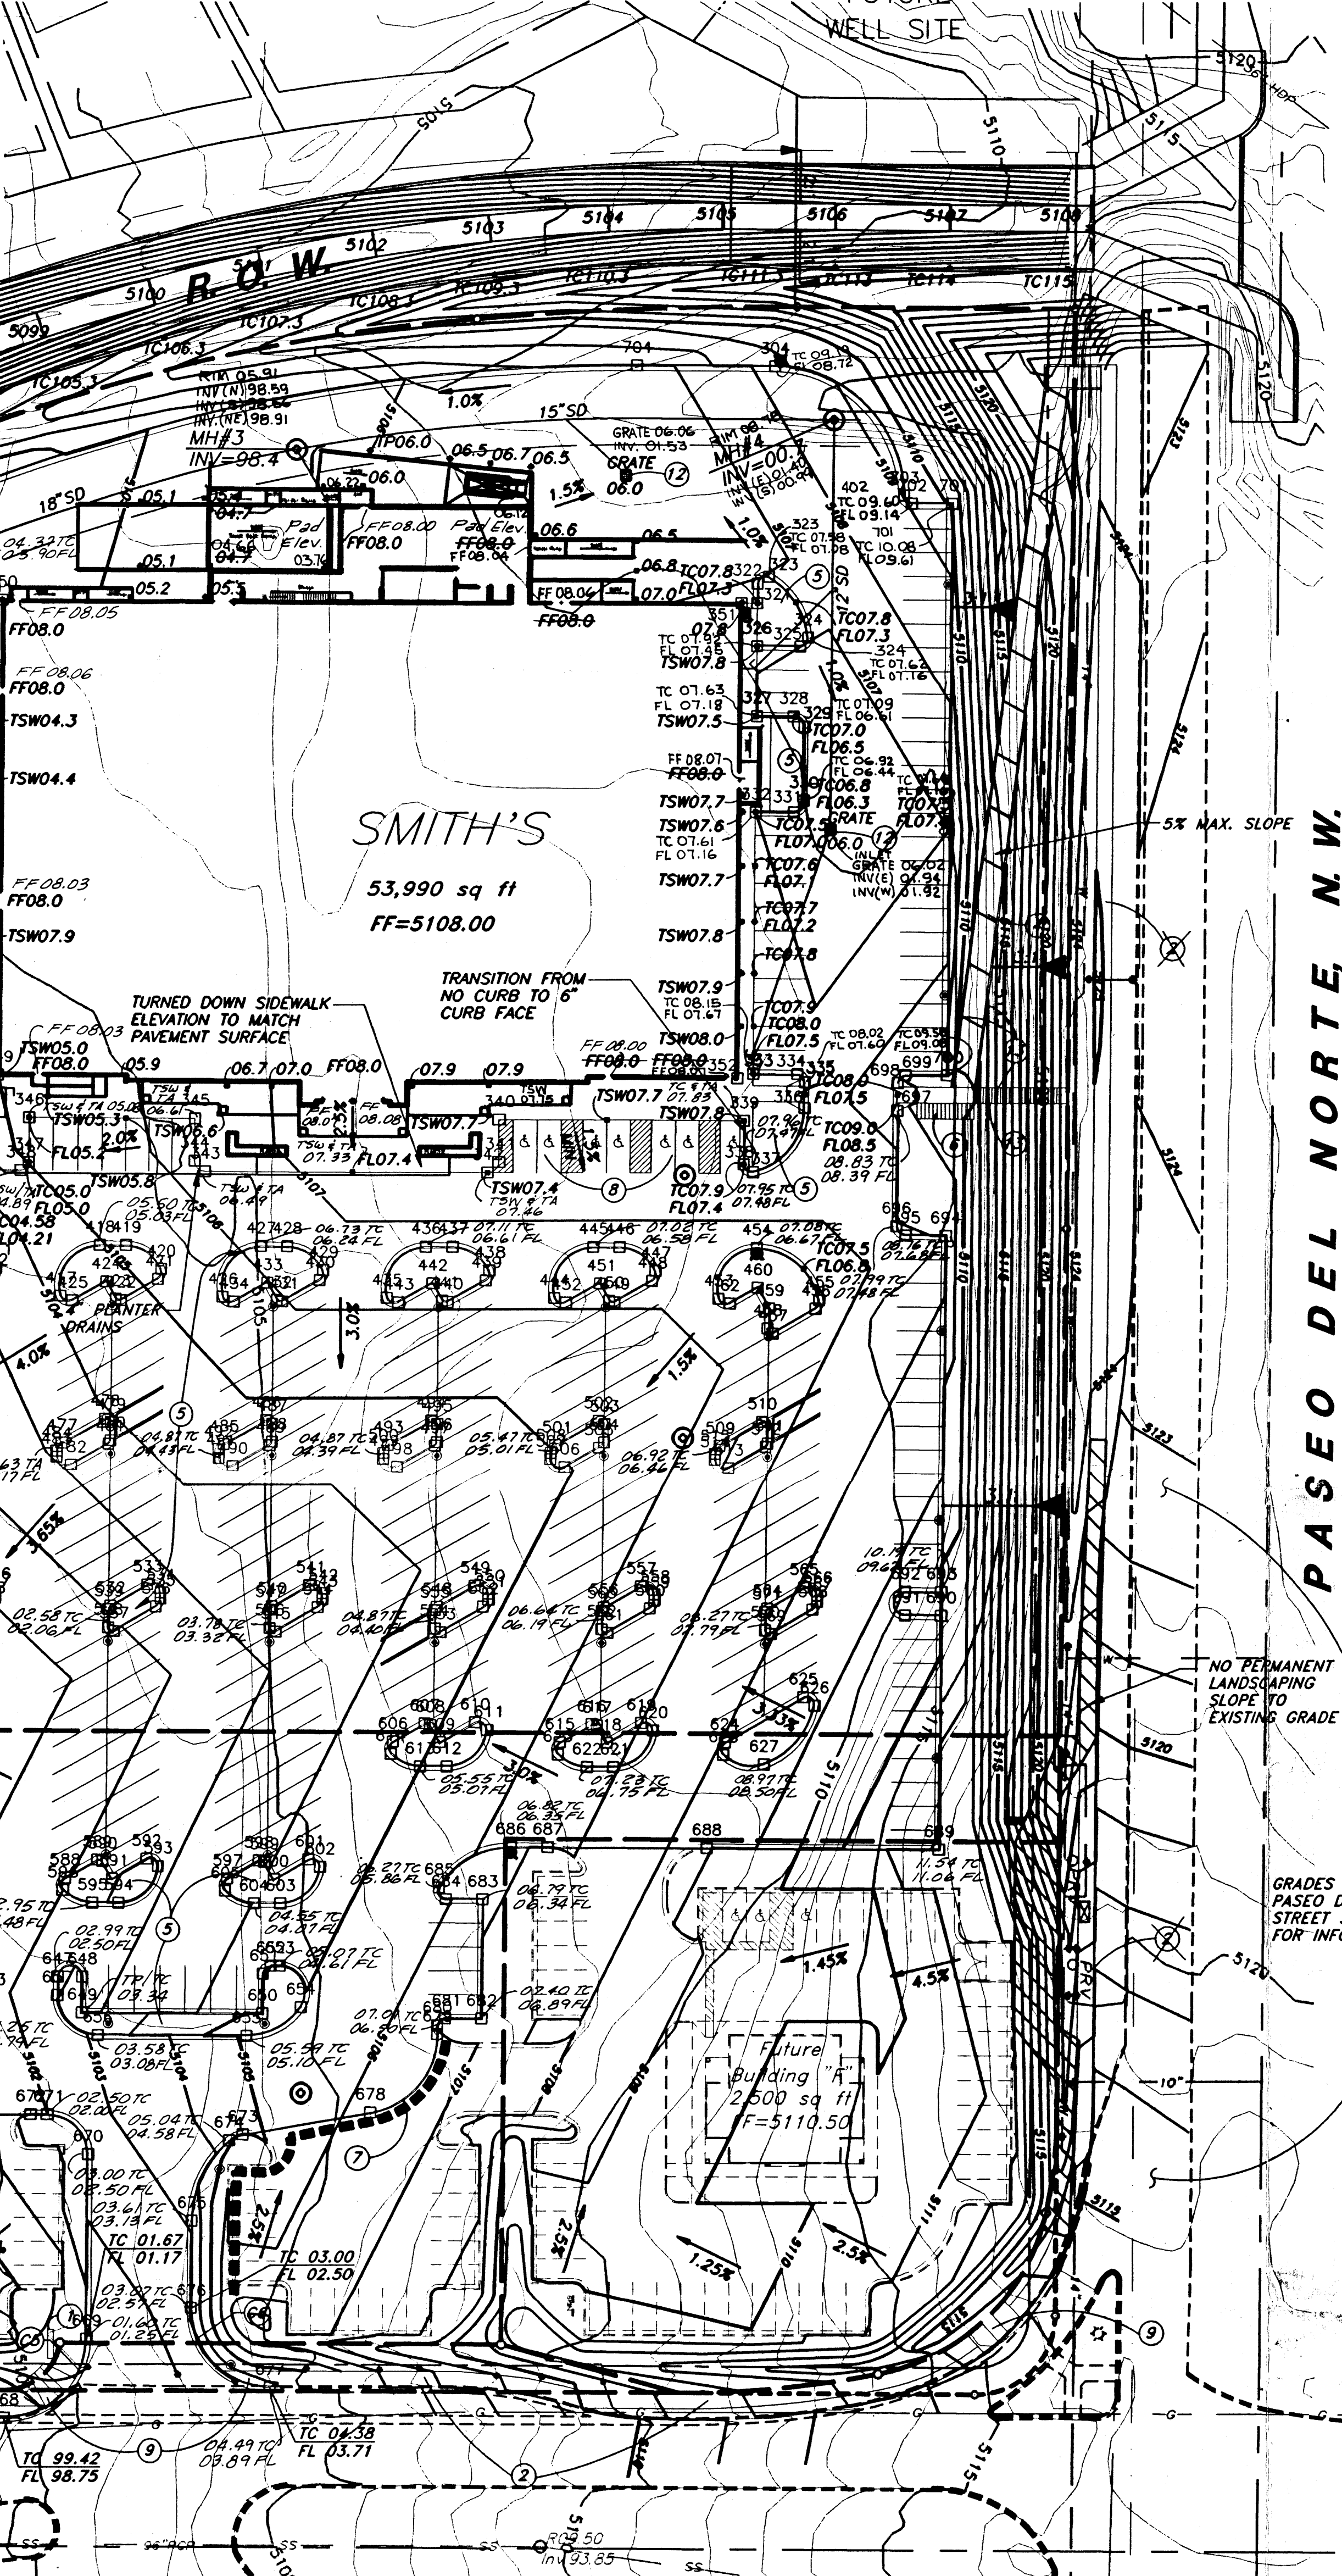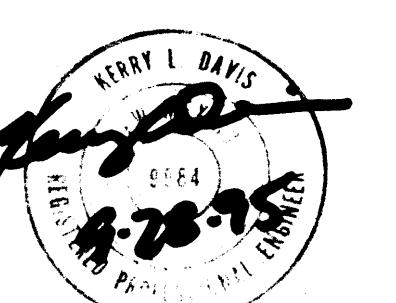

PT	FL	TC	PT	FL	TC	PT	FL	TC	PT	FL	TC	PT	FL	TC	PT	FL	TC
629	5087.37	5088.07	644	5100.81	5101.31	659	5091.83	5092.33	674	5104.32	5104.82	689	5111.02	5111.52	704	5106.85	5107.35
630	5088.33	5089.03	645	5100.84	5101.34	660	5092.02	5092.52	675	5103.08	5103.58	690	5109.77	5110.27	705	5098.24	5098.74
631	5088.35	5089.05	646	5100.82	5101.32	661	5089.59	5090.09	676	5102.50	5103.00	691	5109.39	5109.89	706	5098.87	5099.37
632	5088.44	5089.14	647	5100.86	5101.36	662	5089.62	5090.12	677	5103.71	5104.21	692	5109.28	5109.78	707	5098.94	5099.44
633	5088.52	5089.22	648	5100.83	5101.33	663	5094.41	5094.91	678	5106.27	5106.77	693	5109.65	5110.15	708	5098.55	5099.05
634	5088.60	5089.30	649	5100.85	5101.35	664	5106.53	5107.03	679	5106.53	5107.03	694	5109.12	5109.62	709	5098.16	5098.66
635	5089.00	5089.50	650	5104.67	5105.17	665	5093.00	5093.50	680	5106.49	5106.99	695	5107.45	5107.95	710	5098.14	5098.64
636	5089.06	5089.56	651	5104.67	5105.17	666	5106.52	5107.02	681	5106.52	5107.02	696	5107.45	5107.95	711	5098.14	5098.64
637	5097.44	5097.94	652	5104.51	5105.01	667	5091.00	5091.50	682	5106.48	5106.98	697	5106.48	5106.98	712	5098.14	5098.64
638	5100.12	5100.62	653	5104.60	5105.10	668	5106.32	5106.82	683	5106.30	5106.80	698	5106.48	5106.98	713	5098.14	5098.64
639	5102.09	5102.59	654	5105.20	5105.70	669	5102.17	5102.67	684	5105.30	5105.80	699	5106.50	5107.00	714	5098.14	5098.64
640	5100.77	5101.27	655	5105.02	5105.52	670	5102.47	5102.97	685	5105.76	5106.26	700	5109.00	5109.50	715	5098.14	5098.64
641	5100.88	5101.38	656	5105.05	5105.55	671	5101.99	5102.49	686	5106.30	5106.80	701	5109.27	5109.77	716	5098.14	5098.64
642	5101.52	5102.02	657	5102.48	5102.98	672	5101.71	5102.21	687	5106.61	5107.11	702	5109.00	5109.50	717	5098.14	5098.64
643	5101.65	5102.15	658	5091.58	5092.08	673	5106.60	5107.10	688	5106.44	5106.94	703	5109.00	5109.50	718	5106.27	5106.77

PT	FL	TC	PT	FL	TC	PT	FL	TC	PT	FL	TC	PT	FL	TC
304	5108.31	5108.81	431	5105.96	5106.46	487	5104.56	5105.06	563	5106.09	5106.59	630	5107.12	5107.62
305	5108.31	5108.81	432	5105.96	5106.46	488	5104.56	5105.06	564	5106.09	5106.59	631	5107.12	5107.62
306	5108.31	5108.81	433	5105.96	5106.46	489	5104.56	5105.06	565	5106.09	5106.59	632	5107.12	5107.62
334	5108.31	5108.81	461	5105.96	5106.46	517	5104.56	5105.06	593	5106.09	5106.59	660	5107.12	5107.62
335	5107.50	5108.00	462	5106.24	5106.74	518	5106.38	5106.88	594	5106.38	5106.88	594	5106.38	5106.88
336	5107.50	5108.00	463	5106.24	5106.74	519	5106.38	5106.88	595	5106.38	5106.88	595	5106.38	5106.88
337	5107.50	5108.00	464	5106.24	5106.74	520	5106.38	5106.88	596	5106.38	5106.88	596	5106.38	5106.88
338	5107.40	5107.90	465	5106.21	5106.71	521	5106.35	5106.85	597	5106.35	5106.85	597	5106.35	5106.85
339	5107.40	5107.90	466	5106.21	5106.71	522	5106.35	5106.85	598	5106.35	5106.85	598	5106.35	5106.85
340	5107.40	5107.90	467	5106.21	5106.71	523	5106.35	5106.85	599	5106.35	5106.85	599	5106.35	5106.85
350	BLOC FF=5108.00	463	5106.17	5106.67	533	5104.61	5105.11	609	5104.61	5105.11	609	5104.61	5105.11	
351	BLOC FF=5108.00	464	5106.04	5106.54	534	5104.61	5105.11	610	5104.61	5105.11	610	5104.61	5105.11	
352	BLOC FF=5108.00	465	5106.17	5106.67	535	5104.61	5105.11	611	5104.61	5105.11	611	5104.61	5105.11	
353	BLOC FF=5108.00	466	5106.30	5106.80	536	5104.61	5105.11	612	5104.61	5105.11	612	5104.61	5105.11	
354	BLOC FF=5108.00	467	5106.43	5106.93	537	5104.61	5105.11	613	5104.61	5105.11	613	5104.61	5105.11	
355	BLOC FF=5108.00	468	5106.56	5107.06	538	5104.61	5105.11	614	5104.61	5105.11	614	5104.61	5105.11	
356	BLOC FF=5108.00	469	5106.69	5107.19	539	5104.61	5105.11	615	5104.61	5105.11	615	5104.61	5105.11	
357	BLOC FF=5108.00	470	5106.82	5107.32	540	5104.61	5105.11	616	5104.61	5105.11	616	5104.61	5105.11	
358	BLOC FF=5108.00	471	5106.95	5107.45	541	5104.61	5105.11	617	5104.61	5105.11	617	5104.61	5105.11	
359	BLOC FF=5108.00	472	5107.08	5107.58	542	5104.61	5105.11	618	5104.61	5105.11	618	5104.61	5105.11	
360	BLOC FF=5108.00	473	5107.21	5107.71	543	5104.61	5105.11	619	5104.61	5105.11	619	5104.61	5105.11	
361	BLOC FF=5108.00	474	5107.34	5107.84	544	5104.61	5105.11	620	5104.61	5105.11	620	5104.61	5105.11	
362	BLOC FF=5108.00	475	5107.47	5107.97	545	5104.61	5105.11	621	5104.61	5105.11	621	5104.61	5105.11	
363	BLOC FF=5108.00	476	5107.60	5108.10	546	5104.61	5105.11	622	5104.61	5105.11	622	5104.61	5105.11	
364	BLOC FF=5108.00	477	5107.73	5108.23	547	5104.61	5105.11	623	5104.61	5105.11	623	5104.61	5105.11	
365	BLOC FF=5108.00	478	5107.86	5108.36	548	5104.61	5105.11	624	5104.61	5105.11	624	5104.61	5105.11	
366	BLOC FF=5108.00	479	5107.99	5108.49	549	5104.61	5105.11	625	5104.61	5105.11	625	5104.61	5105.11	
367	BLOC FF=5108.00	480	5108.12	5108.59	550	5104.61	5105.11	626	5104.61	5105.11	626	5104.61	5105.11	
368	BLOC FF=5108.00	481	5108.25	5108.72	551	5104.61	5105.11	627	5104.61	5105.11	627	5104.61	5105.11	
369	BLOC FF=5108.00	482	5108.38	5108.85	552	5104.61	5105.11	628	5104.61	5105.11	628	5104.61	5105.11	
370	BLOC FF=5108.00	483	5108.51	5109.05	553	5104.61	5105.11	629	5104.61	5105.11	629	5104.61	5105.11	
371	BLOC FF=5108.00	484	5108.64	5109.18	554	5104.61	5105.11	630	5104.61	5105.11	630	5104.61	5105.11	
372	BLOC FF=5108.00	485	5108.77	5109.31	555	5104.61	5105.11	631	5104.61	5105.11	631	5104.61	5105.11	
373	BLOC FF=5108.00	486	5108.90	5109.44	556	5104.61	5105.11	632	5104.61	5105.11	632	5104.61	5105.11	
374	BLOC FF=5108.00	487	5109.03	5109.57	557	5104.61	5105.11	633	5104.61	5105.11	633	5104.61	5105.11	
375	BLOC FF=5108.00	488	5109.16	5109.70	558	5104.61	5105.11	634	5104.61	5105.11	634	5104.61	5105.11	
376	BLOC FF=5108.00	489	5109.29	5109.83	559	5104.61	5105.11	635	5104.61	5105.11	635	5104.61	5105.11	
377	BLOC FF=5108.00	490	5109.42	5110.00	560	5104.61	5105.11	636	5104.61	5105.11	636	5104.61	5105.11	
378	BLOC FF=5108.00	491	5109.55	5110.13	561	5104.61	5105.11	637	5104.61	5105.11	637	5104.61	5105.11	
379	BLOC FF=5108.00	492	5109.68	5110.26	562	5104.61	5105.11	638	5104.61	5105.11	638	5104.61	5105.11	
380	BLOC FF=5108.00	493	5109.81	5110.39	563	5104.61	5105.11	639	5104					