


GRADING AND DRAINAGE CERTIFICATION

I, KERRY L. DAVIS, P.E. #9984, HAVE PERSONALLY VISITED THE SITE, AND HEREBY CERTIFY THAT THE SITE GRADING, PAVING, STORM DRAINAGE, AND OTHER IMPROVEMENTS ARE CONSTRUCTED IN SUBSTANTIAL COMPLIANCE WITH THIS APPROVED GRADING AND DRAINAGE PLAN, TO ALLOW THE IMPLEMENTATION OF THE DRAINAGE PATTERNS AND REQUIREMENTS IDENTIFIED HEREIN. AS-BUILT ELEVATIONS WERE VERIFIED BY FIELD SURVEYS PERFORMED BY BOHANNAN-HUSTON INC. DURING MAY, 1995. THIS STATEMENT DOES NOT REPRESENT CERTIFICATION OF CONTRACTORS CONSTRUCTION METHODS OR MATERIALS.

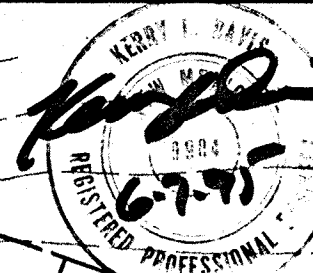

EXISTING FEMA 100 YEAR FLOODPLAIN

STA 7+65.60
END WALL D-3
BEGIN FLOODWALL

STA 1+00.00
BEGIN WALL H

STA 1+00.00
BEGIN WALL D-3

STA 12+73.17
END WALL D-2

STA 1+00.00
BEGIN WALL C

SCALE: 1" = 50'

LEGEND

PROJECT BOUNDARY	---
EXISTING CONTOUR	---
EXISTING SPOT ELEVATION	019.25
PROPOSED SPOT ELEVATION	005.70
DIRECTION OF FLOW	S=2.564%
BASIN BOUNDARY	---
EROSION CONTROL BERM	---
PROPOSED RETAINING WALL	---
EXISTING STORM DRAIN LINE	SD
EXISTING STORM DRAIN MANHOLE	⊙
EXISTING STORM DRAIN INLET	⊙
PROPOSED STORM DRAIN LINE	SD
PROPOSED STORM DRAIN MANHOLE	⊙
PROPOSED STORM DRAIN INLET	⊙
STREET FLOW	0.5-0.0CFS
PIPE FLOW	0.5-0.0CFS
SHEET FLOW	0.5-0.0CFS


*ALL FLOWS SHOWN ARE 100 YEAR EVENT

GENERAL GRADING NOTES:

1. THE CONTRACTOR MUST OBTAIN A TOPSOIL DISTURBANCE PERMIT FROM THE CITY OF ALBUQUERQUE, ENVIRONMENTAL HEALTH DIV., PRIOR TO CONSTRUCTION.
2. THE CONTRACTOR IS TO REFER TO THE EARTHWORK SPECIFICATIONS NOTED IN THE GEOTECHNICAL INVESTIGATION REPORT PREPARED BY VINEYARD AND ASSOCIATES, DATED JUNE 16, 1993 AND SUPPLIED BY THE OWNER.
3. THE CONTRACTOR SHALL CONFORM TO ALL CITY, COUNTY, STATE AND FEDERAL DUST CONTROL MEASURES AND REQUIREMENTS AND WILL BE RESPONSIBLE FOR PREPARING AND OBTAINING ALL NECESSARY APPLICATIONS, PERMITS AND APPROVALS.

EROSION CONTROL PLAN:

THE CONTRACTOR SHALL ENSURE THAT NO SOIL ERODES FROM THE LOTS INTO PUBLIC RIGHT-OF-WAY. THIS CAN BE ACHIEVED BY CONSTRUCTING TEMPORARY EROSION CONTROL BERMS AS PER DETAIL THIS SHEET AND WETTING THE SOIL REGULARLY TO KEEP IT FROM BLOWING.

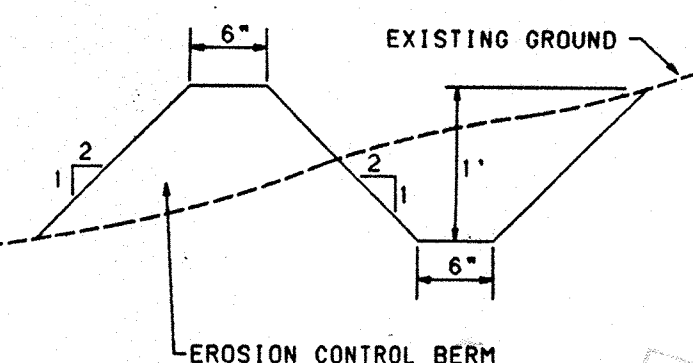

EROSION CONTROL PLAN

NO SCALE
A BERM WITH THE DIMENSIONS SHOWN SHALL BE MAINTAINED DURING CONSTRUCTION UNTIL COMPLETION OF INDIVIDUAL HOMES WITHIN THE PROJECT.



RECORD DRAWING

DATE: 5/18/95


CITY OF ALBUQUERQUE
PUBLIC WORKS DEPARTMENT
ENGINEERING GROUP

RANCHO SERENO SUBDIVISION - UNIT III
FINAL GRADING & DRAINAGE PLAN

APPROVALS	ENGINEER	DATE	APPROVALS	ENGINEER	DATE
DRG CHAIRMAN	B. J. Bohannon	7-14-94	WATER	N/A RWK	6-17-94
TRANSPORTATION	K. L. Davis	6-7-94	WASTE WATER	N/A RWK	6-17-94
HYDROLOGY	R. L. Davis	6-17-94	A.M.A.F.C.A.	J. L. Bohannon	

DRAWING NO.	4569.95	MAP NO.	C-12	SHEET	4 OF 51
-------------	---------	---------	------	-------	---------

Copyright Bohannon-Huston, Inc. 1994

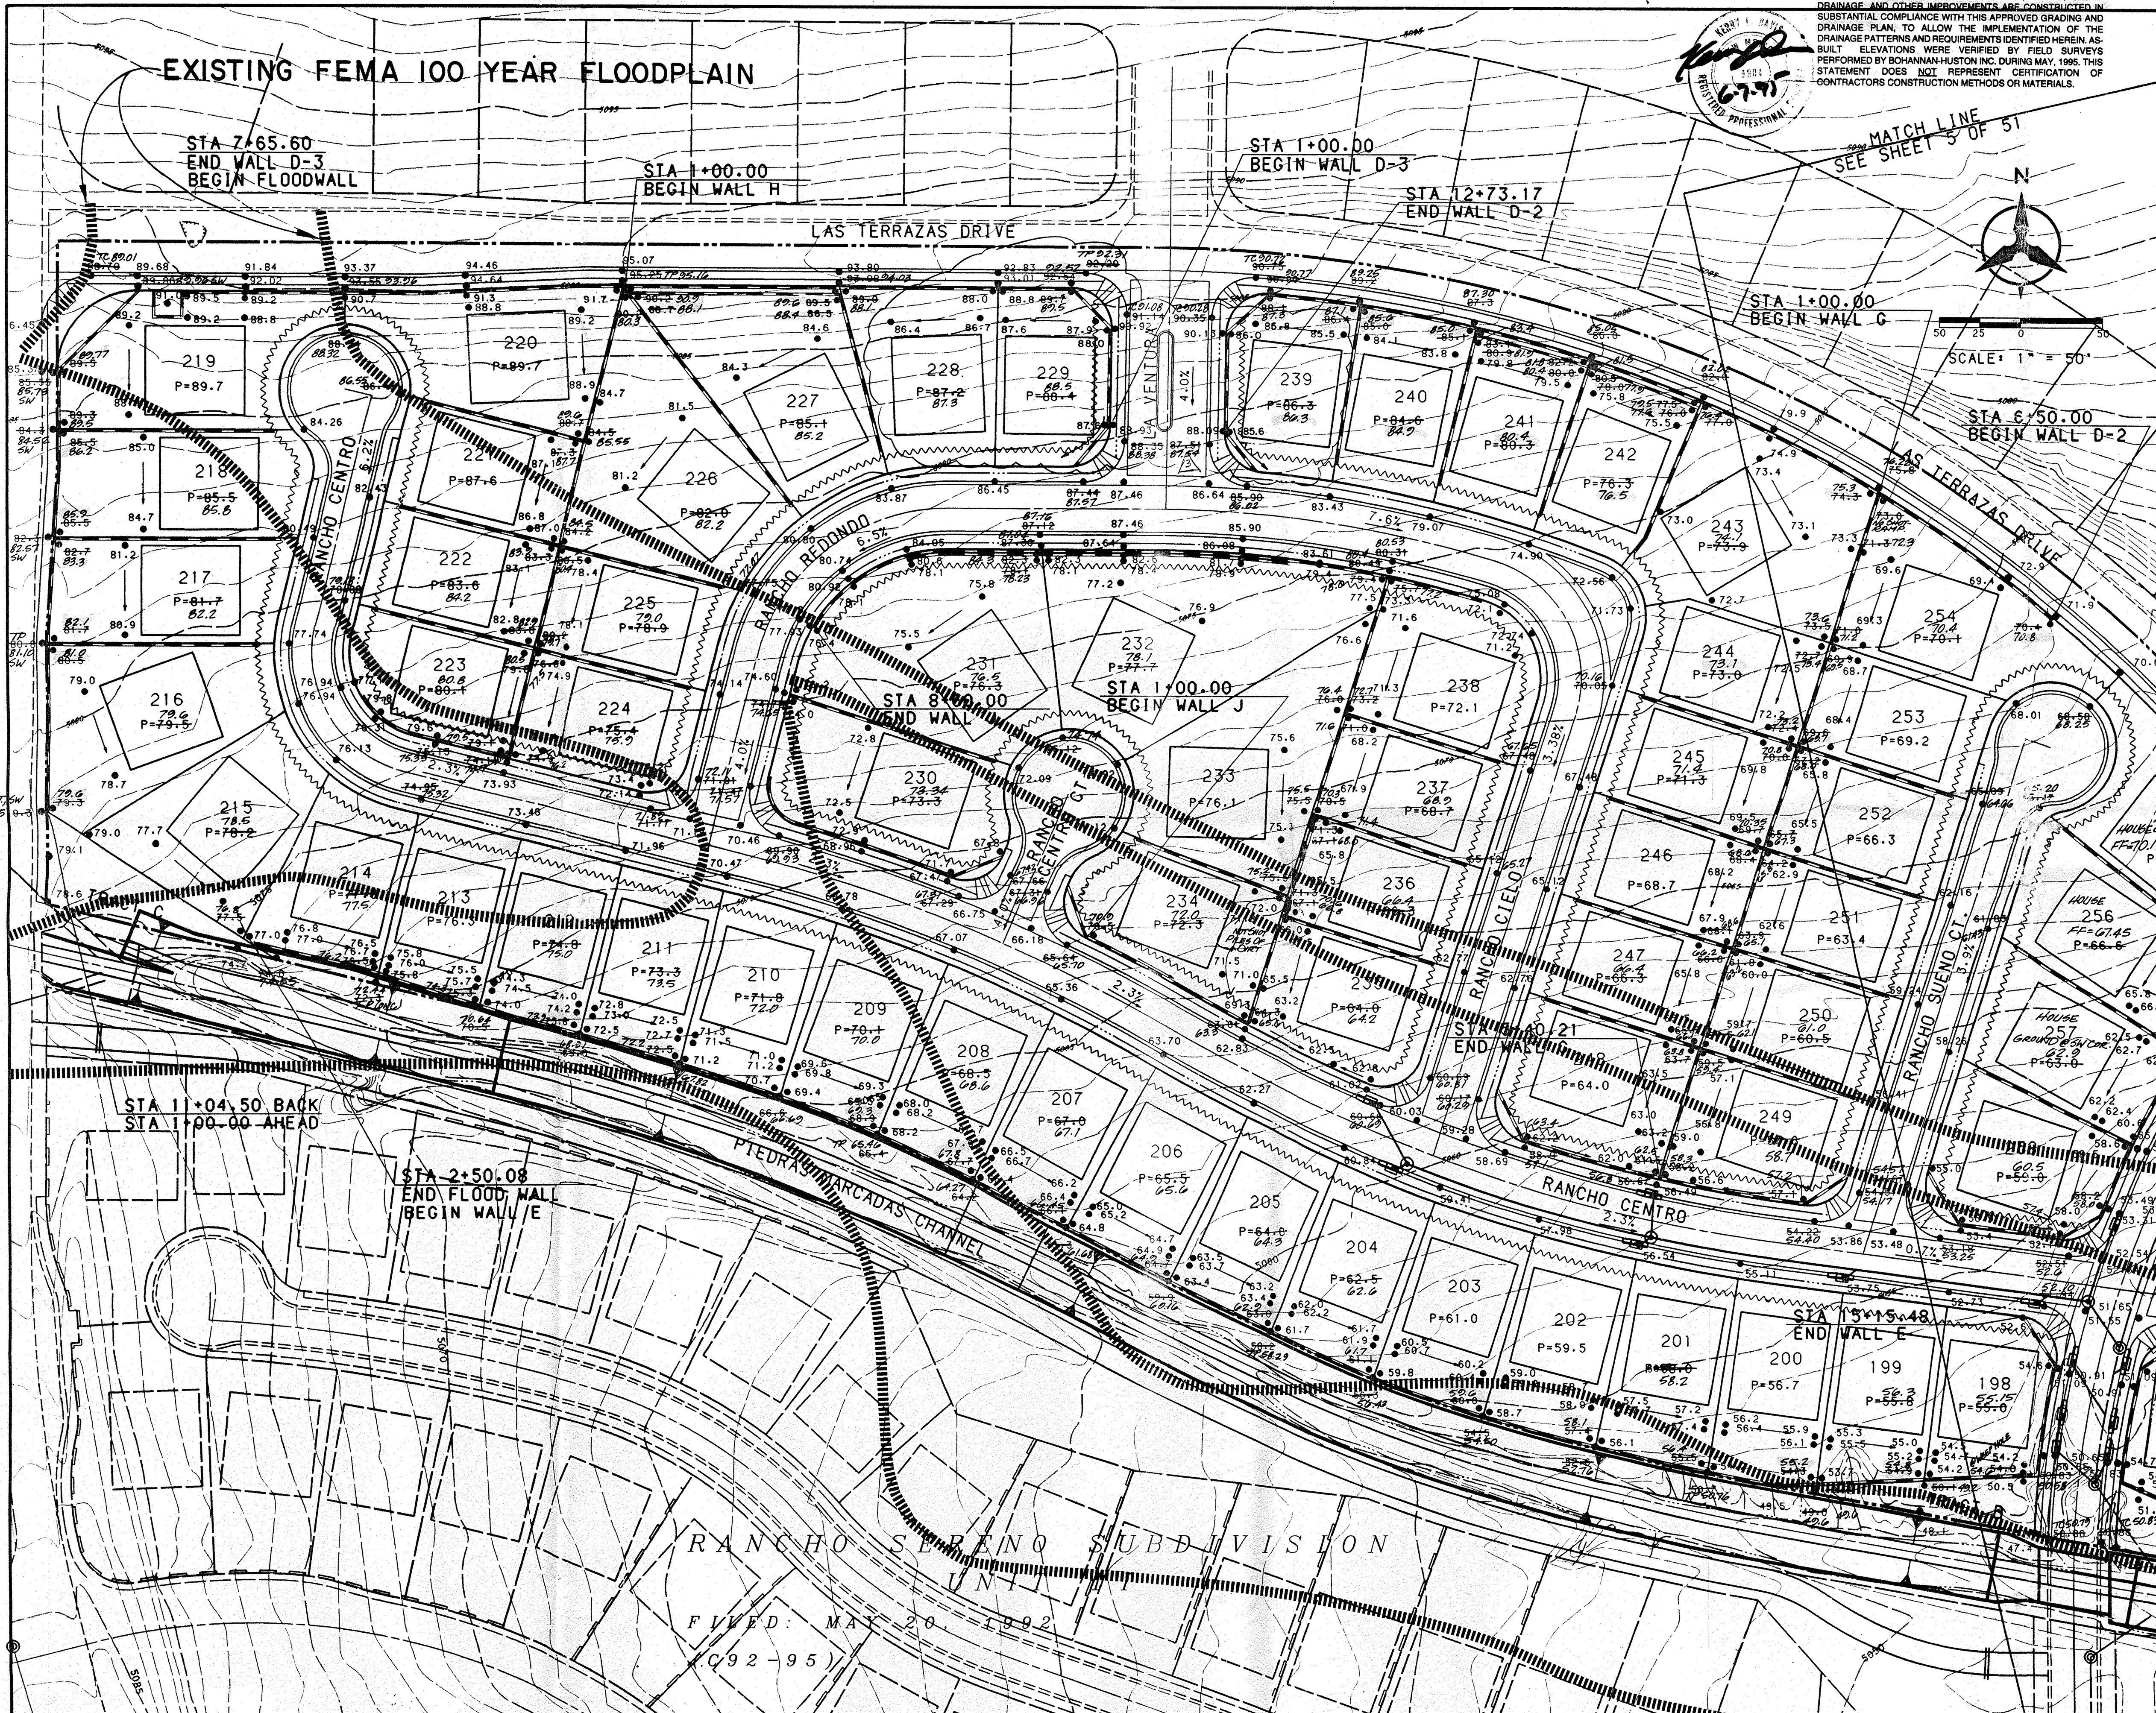

USERNAME: CDP21C8411401.PAD
FILENAME: GRADE1.GRF

26 4569.95 1950495


Eng. Cert

(C 3 0 - 1 7 8)

GRADING AND DRAINAGE CERTIFICATION

I, KERRY L. DAVIS, P.E. #9984, HAVE PERSONALLY VISITED THE SITE, AND HEREBY CERTIFY THAT SITE GRADING, PAVING, STORM DRAINAGE, AND OTHER IMPROVEMENTS ARE CONSTRUCTED IN SUBSTANTIAL COMPLIANCE WITH THIS APPROVED GRADING AND DRAINAGE PLAN, TO ALLOW THE IMPLEMENTATION OF THE DRAINAGE PATTERNS AND REQUIREMENTS IDENTIFIED HEREIN. AS-BUILT ELEVATIONS WERE VERIFIED BY FIELD SURVEYS PERFORMED BY BOWMAN-HUSTON INC. DURING MAY, 1995. THIS STATEMENT DOES NOT REPRESENT CERTIFICATION OF CONTRACTOR CONSTRUCTION METHODS OR MATERIALS.

Kay
6-7-95

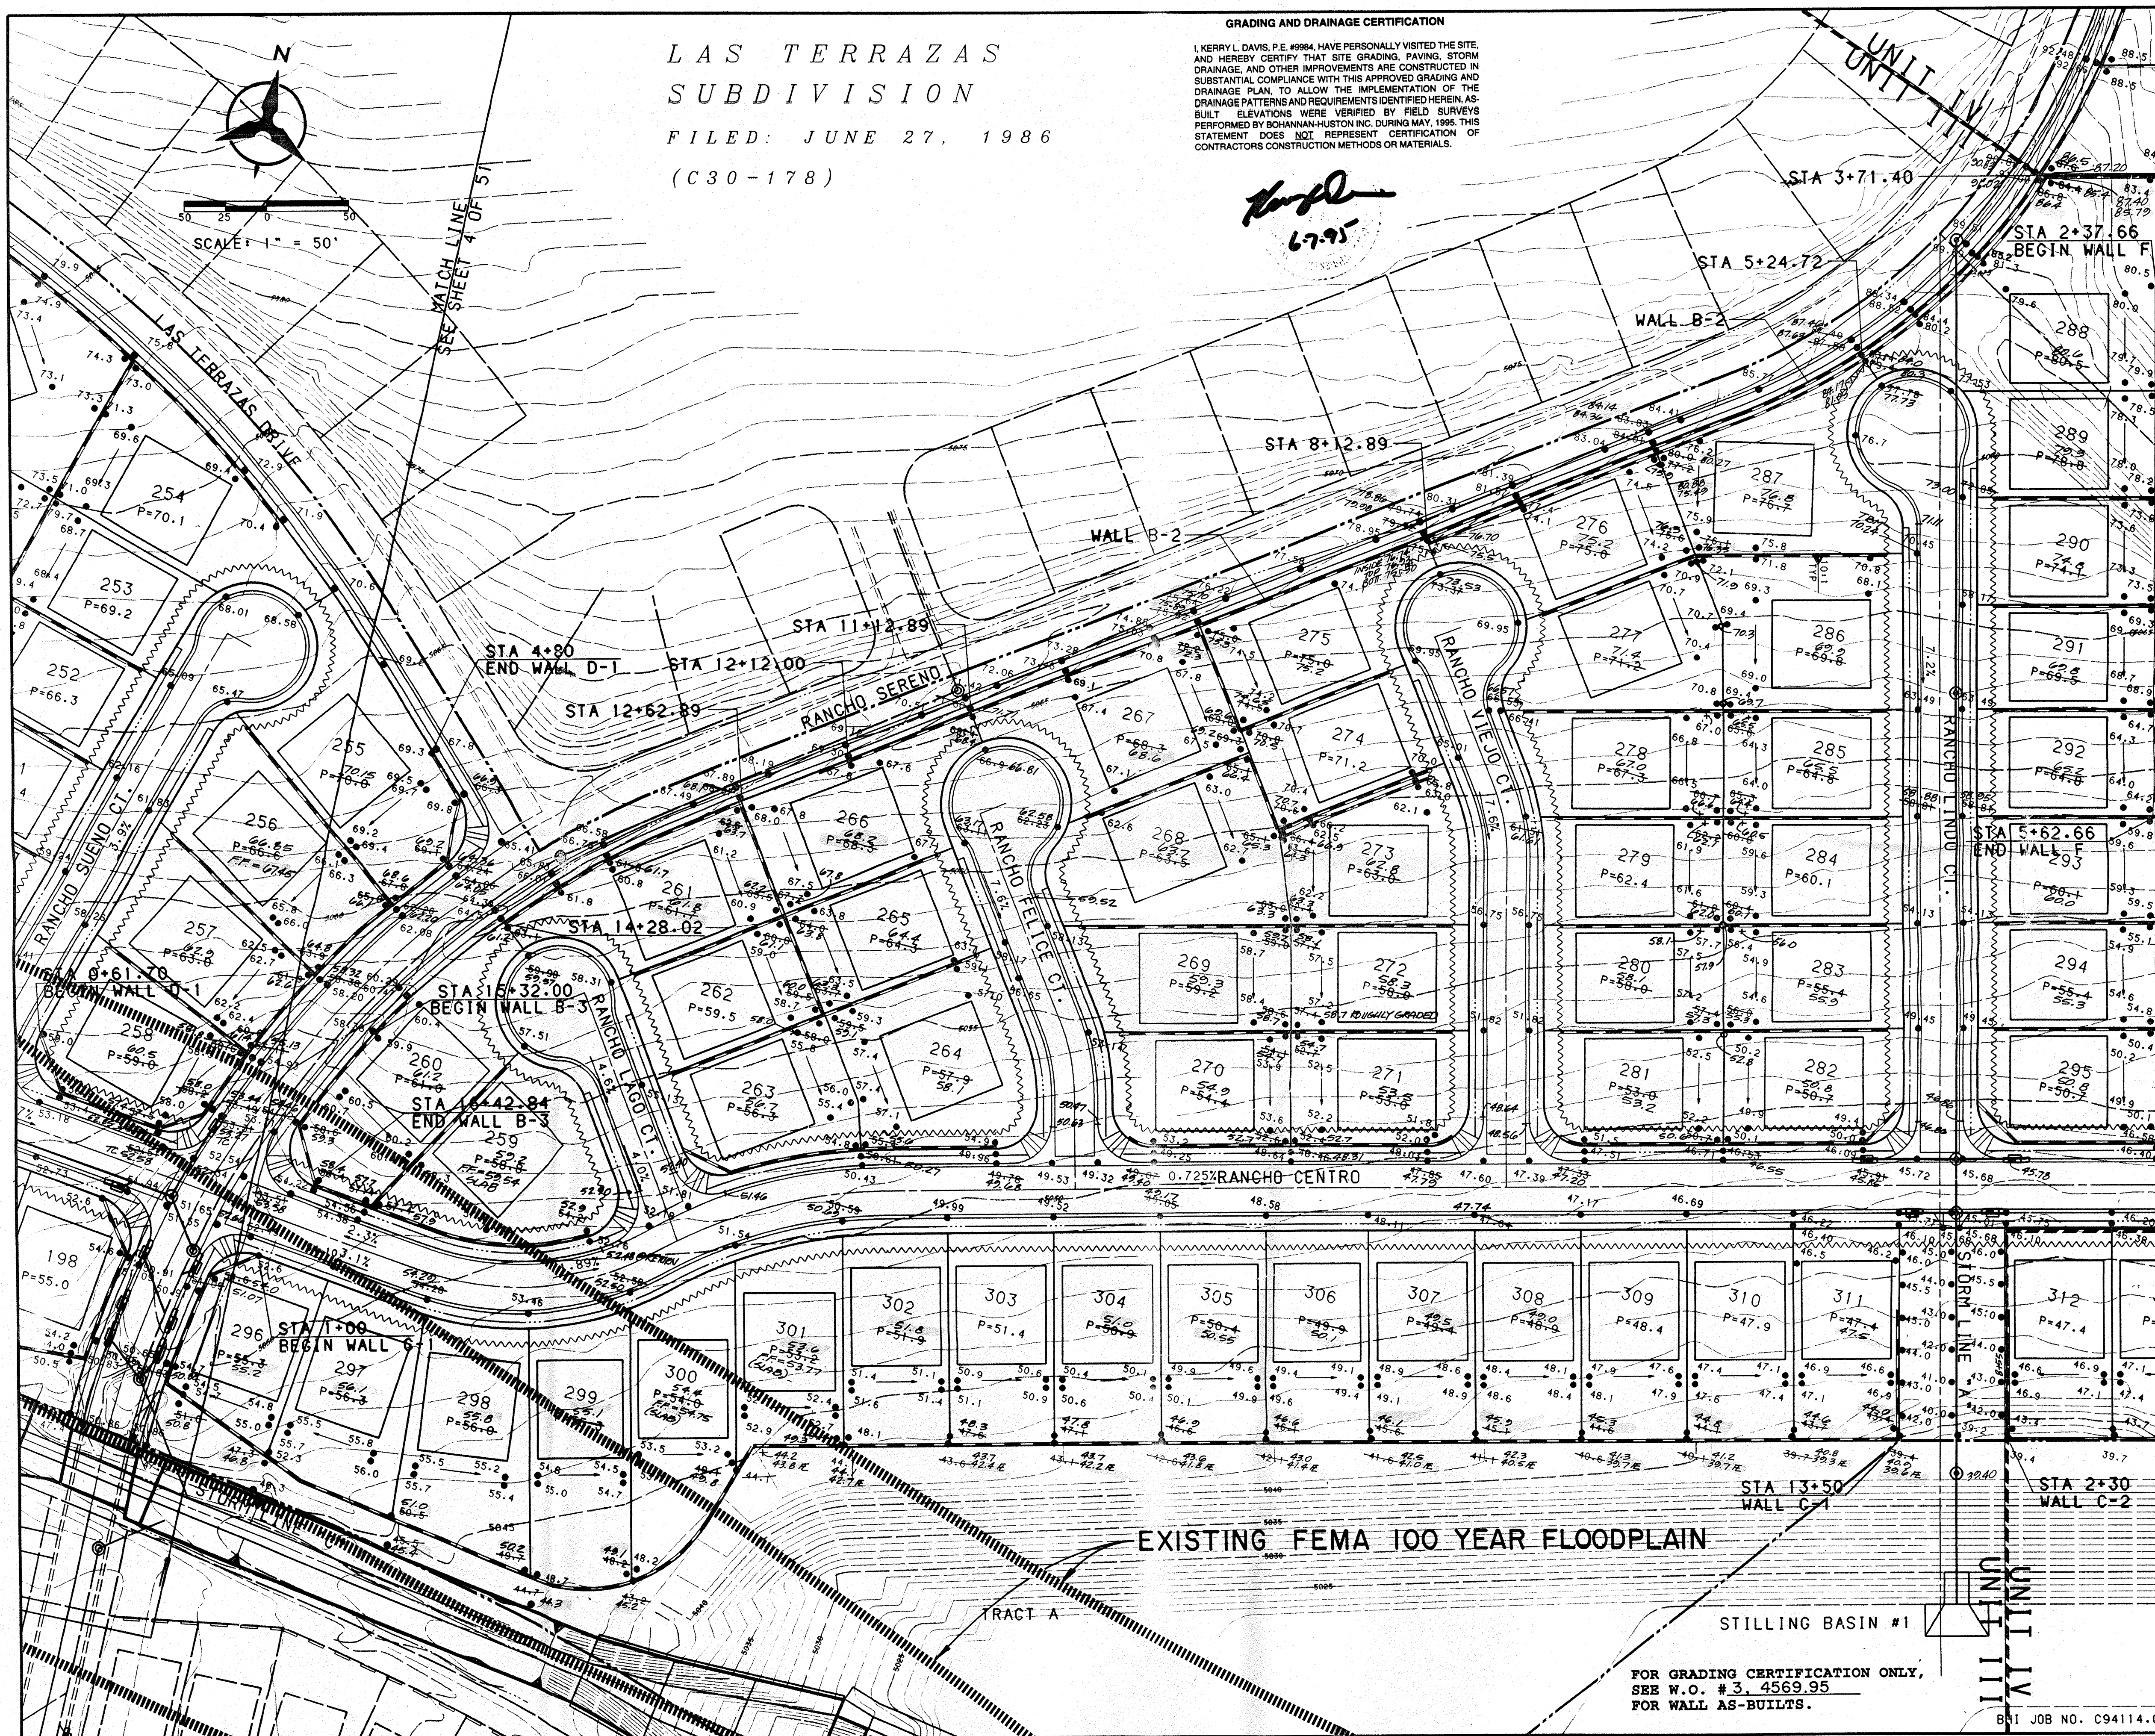

PROJECT BOUNDARY _____

EXISTING CONTOUR _____

EXISTED SPOT ELEVATION _____ 019.25

PROPOSED SPOT ELEVATION _____ ●05.70

DIRECTION OF FLOW _____ S=2.564%

BASIN BOUNDARY _____

EROSION CONTROL BERM _____

PROPOSED RETAINING WALL _____

EXISTING STORM DRAIN LINE _____ SD

EXISTING STORM DRAIN MANHOLE _____ (C)

EXISTING STORM DRAIN INLET _____ □

PROPOSED STORM DRAIN LINE _____ SD

PROPOSED STORM DRAIN MANHOLE _____ (C)

PROPOSED STORM DRAIN INLET _____ (C)

STREET FLOW _____ Q_s = 5.0CFS

PIPE FLOW _____ Q_p = 5.0CFS


SHEET FLOW _____ Q = 5.5CFS

1. THE CONTRACTOR MUST OBTAIN A TOPSOIL DISTURBANCE PERMIT FROM THE CITY OF ALBUQUERQUE, ENVIRONMENTAL HEALTH DIV., PRIOR TO CONSTRUCTION.

2. THE CONTRACTOR IS TO REFER TO THE EARTHWORK SPECIFICATIONS NOTED IN THE GEOTECHNICAL INVESTIGATION REPORT PREPARED BY VINEYARD AND ASSOCIATES, DATED JUNE 16, 1993 AND SUPPLIED BY THE OWNER.


3. THE CONTRACTOR SHALL CONFORM TO ALL CITY, COUNTY, STATE AND FEDERAL DUST CONTROL MEASURES AND REQUIREMENTS AND WILL BE RESPONSIBLE FOR PREPARING AND OBTAINING ALL NECESSARY APPLICATIONS, PERMITS AND APPROVALS.

THE CONTRACTOR SHALL ENSURE THAT NO SOIL ERODES FROM THE LOTS INTO PUBLIC RIGHT-OF-WAY. THIS CAN BE ACHIEVED BY CONSTRUCTING TEMPORARY EROSION CONTROL BERMS AS PER DETAIL THIS SHEET AND WETTING THE SOIL REGULARLY TO KEEP IT FROM BLOWING.

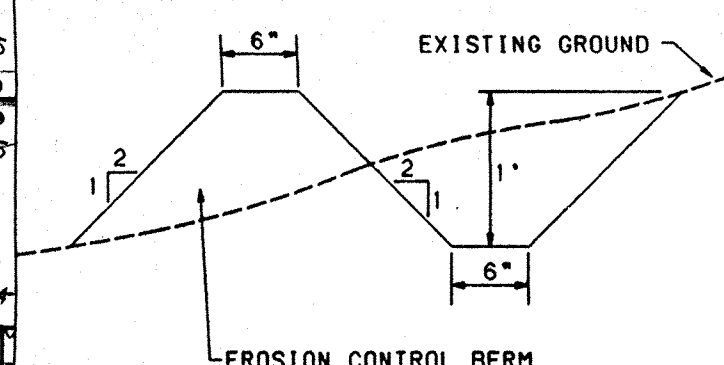


NO SCALE

A BERM WITH THE DIMENSIONS SHOWN SHALL BE MAINTAINED DURING CONSTRUCTION UNTIL COMPLETION OF INDIVIDUAL HOMES WITHIN THE PROJECT.

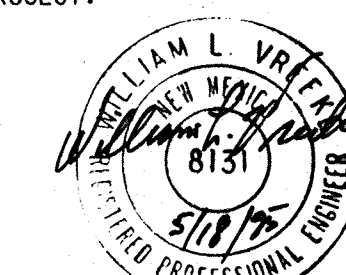

DATE: 5/18/95

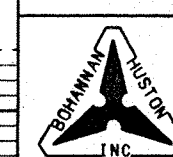


CITY OF ALBUQUERQUE
PUBLIC WORKS DEPARTMENT
ENGINEERING GROUP

RANCHO SERENO SUBDIVISION - UNIT III
FINAL GRADING & DRAINAGE PLAN

APPROVALS	ENGINEER	DATE	APPROVALS	ENGINEER	DATE
ORC CHAIRMAN	B.G. Gendley	7-14-94	WATER	N/A RWC	6-17-94
TRANSPORTATION	N/A RWC	6-17-94	WASTE WATER	N/A RWC	6-17-94
HYDROLOGY	Justin	6-17-94	A.M.A.F.C.A.	Paul	6-27-94

DRAWING NO.	4569.95	MAP NO.	C-12	SHEET	5	OF	51
-------------	---------	---------	------	-------	---	----	----

Copyright Bohannon-Huston, Inc. 199

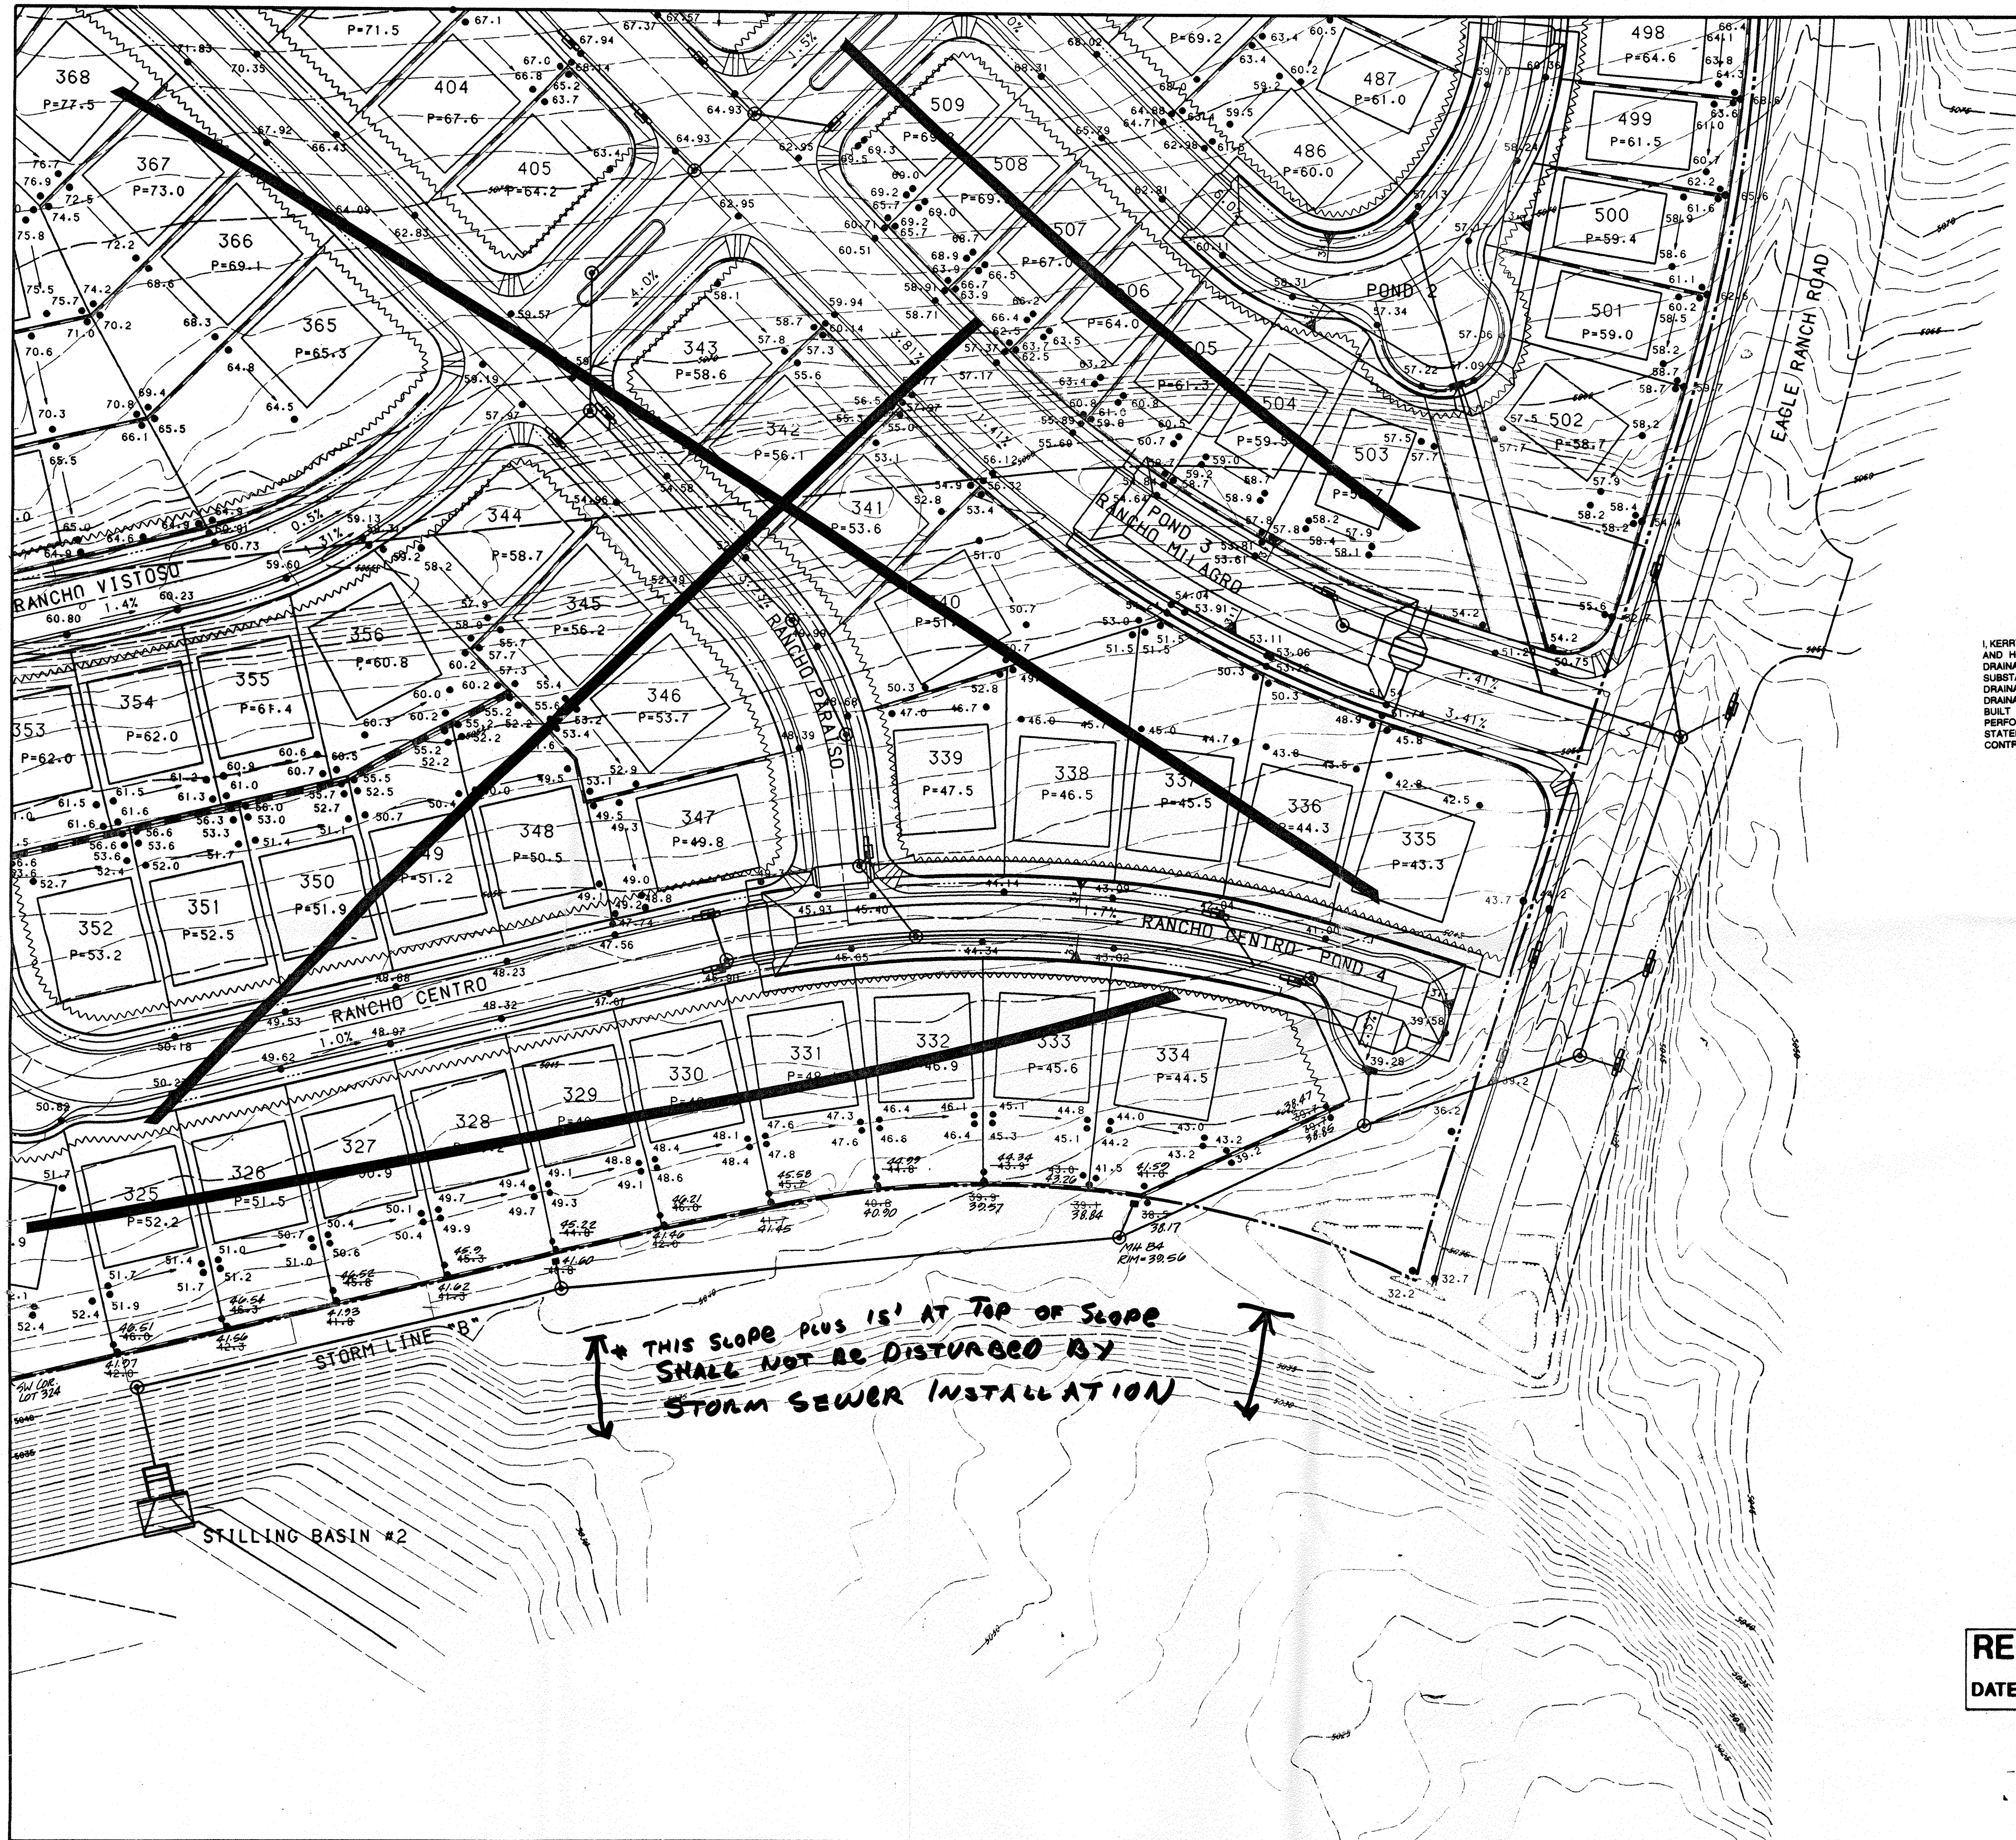


GRADING AND DRAINAGE CERTIFICATION
I, KERRY L. DAVIS, P.E. #9984, HAVE PERSONALLY VISITED THE SITE, AND HEREBY CERTIFY THAT THE GRADING, PAVING, STORM DRAINAGE, AND OTHER IMPROVEMENTS ARE CONSTRUCTED IN SUBSTANTIAL COMPLIANCE WITH THIS APPROVED GRADING AND DRAINAGE PLAN, TO ALLOW THE IMPLEMENTATION OF THE DRAINAGE PATTERNS AND REQUIREMENTS IDENTIFIED HEREIN AS BUILT ELEVATIONS WERE VERIFIED BY FIELD SURVEYS PERFORMED BY BOHANNAN-HUSTON INC. DURING MAY, 1995. THIS STATEMENT DOES NOT REPRESENT CERTIFICATION OF CONTRACTORS CONSTRUCTION METHODS OR MATERIALS.



LEGEND	
PROJECT BOUNDARY	---
EXISTING CONTOUR	---
EXISTING SPOT ELEVATION	019.25
PROPOSED SPOT ELEVATION	005.70
DIRECTION OF FLOW	S-2.584%
BASIN BOUNDARY	---
EROSION CONTROL BERM	---
PROPOSED RETAINING WALL	---
EXISTING STORM DRAIN LINE	SD
EXISTING STORM DRAIN MANHOLE	⊙
EXISTING STORM DRAIN INLET	⊙
PROPOSED STORM DRAIN LINE	SD
PROPOSED STORM DRAIN MANHOLE	⊙
PROPOSED STORM DRAIN INLET	⊙
STREET FLOW	Q _s = 5.0CFS
PIPE FLOW	Q _p = 5.0CFS
SHEET FLOW	Q _s = 5.0CFS
*ALL FLOWS SHOWN ARE 100 YEAR EVENT	


- GENERAL GRADING NOTES:**
1. THE CONTRACTOR MUST OBTAIN A TOPSOIL DISTURBANCE PERMIT FROM THE CITY OF ALBUQUERQUE, ENVIRONMENTAL HEALTH DIV., PRIOR TO CONSTRUCTION.
 2. THE CONTRACTOR IS TO REFER TO THE EARTHWORK SPECIFICATIONS NOTED IN THE GEOTECHNICAL INVESTIGATION REPORT PREPARED BY VINEYARD AND ASSOCIATES, DATED JUNE 16, 1993 AND SUPPLIED BY THE OWNER.
 3. THE CONTRACTOR SHALL CONFORM TO ALL CITY, COUNTY, STATE AND FEDERAL DUST CONTROL MEASURES AND REQUIREMENTS AND WILL BE RESPONSIBLE FOR PREPARING AND OBTAINING ALL NECESSARY APPLICATIONS, PERMITS AND APPROVALS.

EROSION CONTROL PLAN:
THE CONTRACTOR SHALL ENSURE THAT NO SOIL ERODES FROM THE LOTS INTO PUBLIC RIGHT-OF-WAY. THIS CAN BE ACHIEVED BY CONSTRUCTING TEMPORARY EROSION CONTROL BERMS AS PER DETAIL THIS SHEET AND WETTING THE SOIL REGULARLY TO KEEP IT FROM BLOWING.

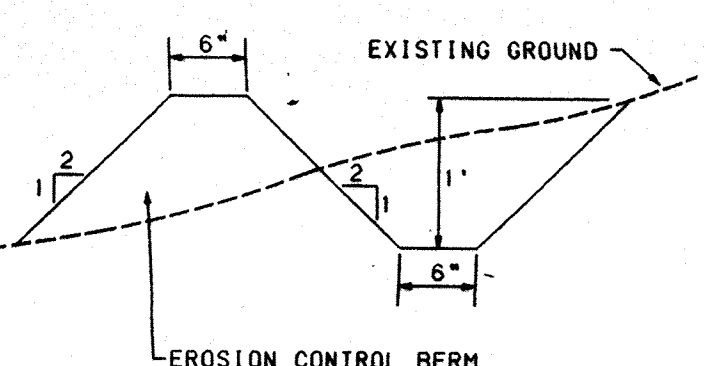

EROSION CONTROL PLAN
NO SCALE
A BERM WITH THE DIMENSIONS SHOWN SHALL BE MAINTAINED DURING CONSTRUCTION UNTIL COMPLETION OF INDIVIDUAL HOMES WITHIN THE PROJECT.

26	1	5	6	9	8	5	0	7	9	5
----	---	---	---	---	---	---	---	---	---	---

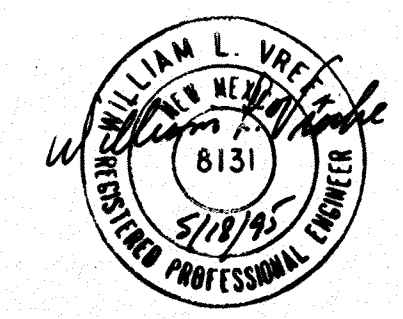

RECORD DRAWING
DATE: 5/19/95

CITY OF ALBUQUERQUE
PUBLIC WORKS DEPARTMENT
ENGINEERING GROUP

RANCHO SERENO SUBDIVISION - UNIT III
FINAL GRADING & DRAINAGE PLAN

APPROVALS	ENGINEER	DATE	APPROVALS	ENGINEER	DATE
DRC CHAIRMAN	<i>[Signature]</i>	7-14-94	WATER	<i>[Signature]</i>	7-14-94
TRANSPORTATION	<i>[Signature]</i>	6-17-94	WASTE WATER	<i>[Signature]</i>	6-17-94
HYDROLOGY	<i>[Signature]</i>	6-17-94	A.M.A.F.C.	<i>[Signature]</i>	6-17-94

DRAWING NO.	4569.95	MAP NO.	C-12	SHEET	7 OF 51
-------------	---------	---------	------	-------	---------

Copyright Bohannon-Huston, Inc. 1994



GRADING AND DRAINAGE CERTIFICATION

~~UNIT IV~~
~~UNIT III~~

STA 9+89.50

WALL A
STA 6+86.64

STA 16+08.70

STA 16+80.93 BACK
~~STA 1+00 AHEAD~~


STA 4+00.00
BEGIN WALL B-1

~~STA 7+06.49~~
~~END WALL B-~~

~~STA 0+62.12~~
~~BEGIN WALL~~

Copyright Behavioral-Hunter Inc. 1997


6 OF 17

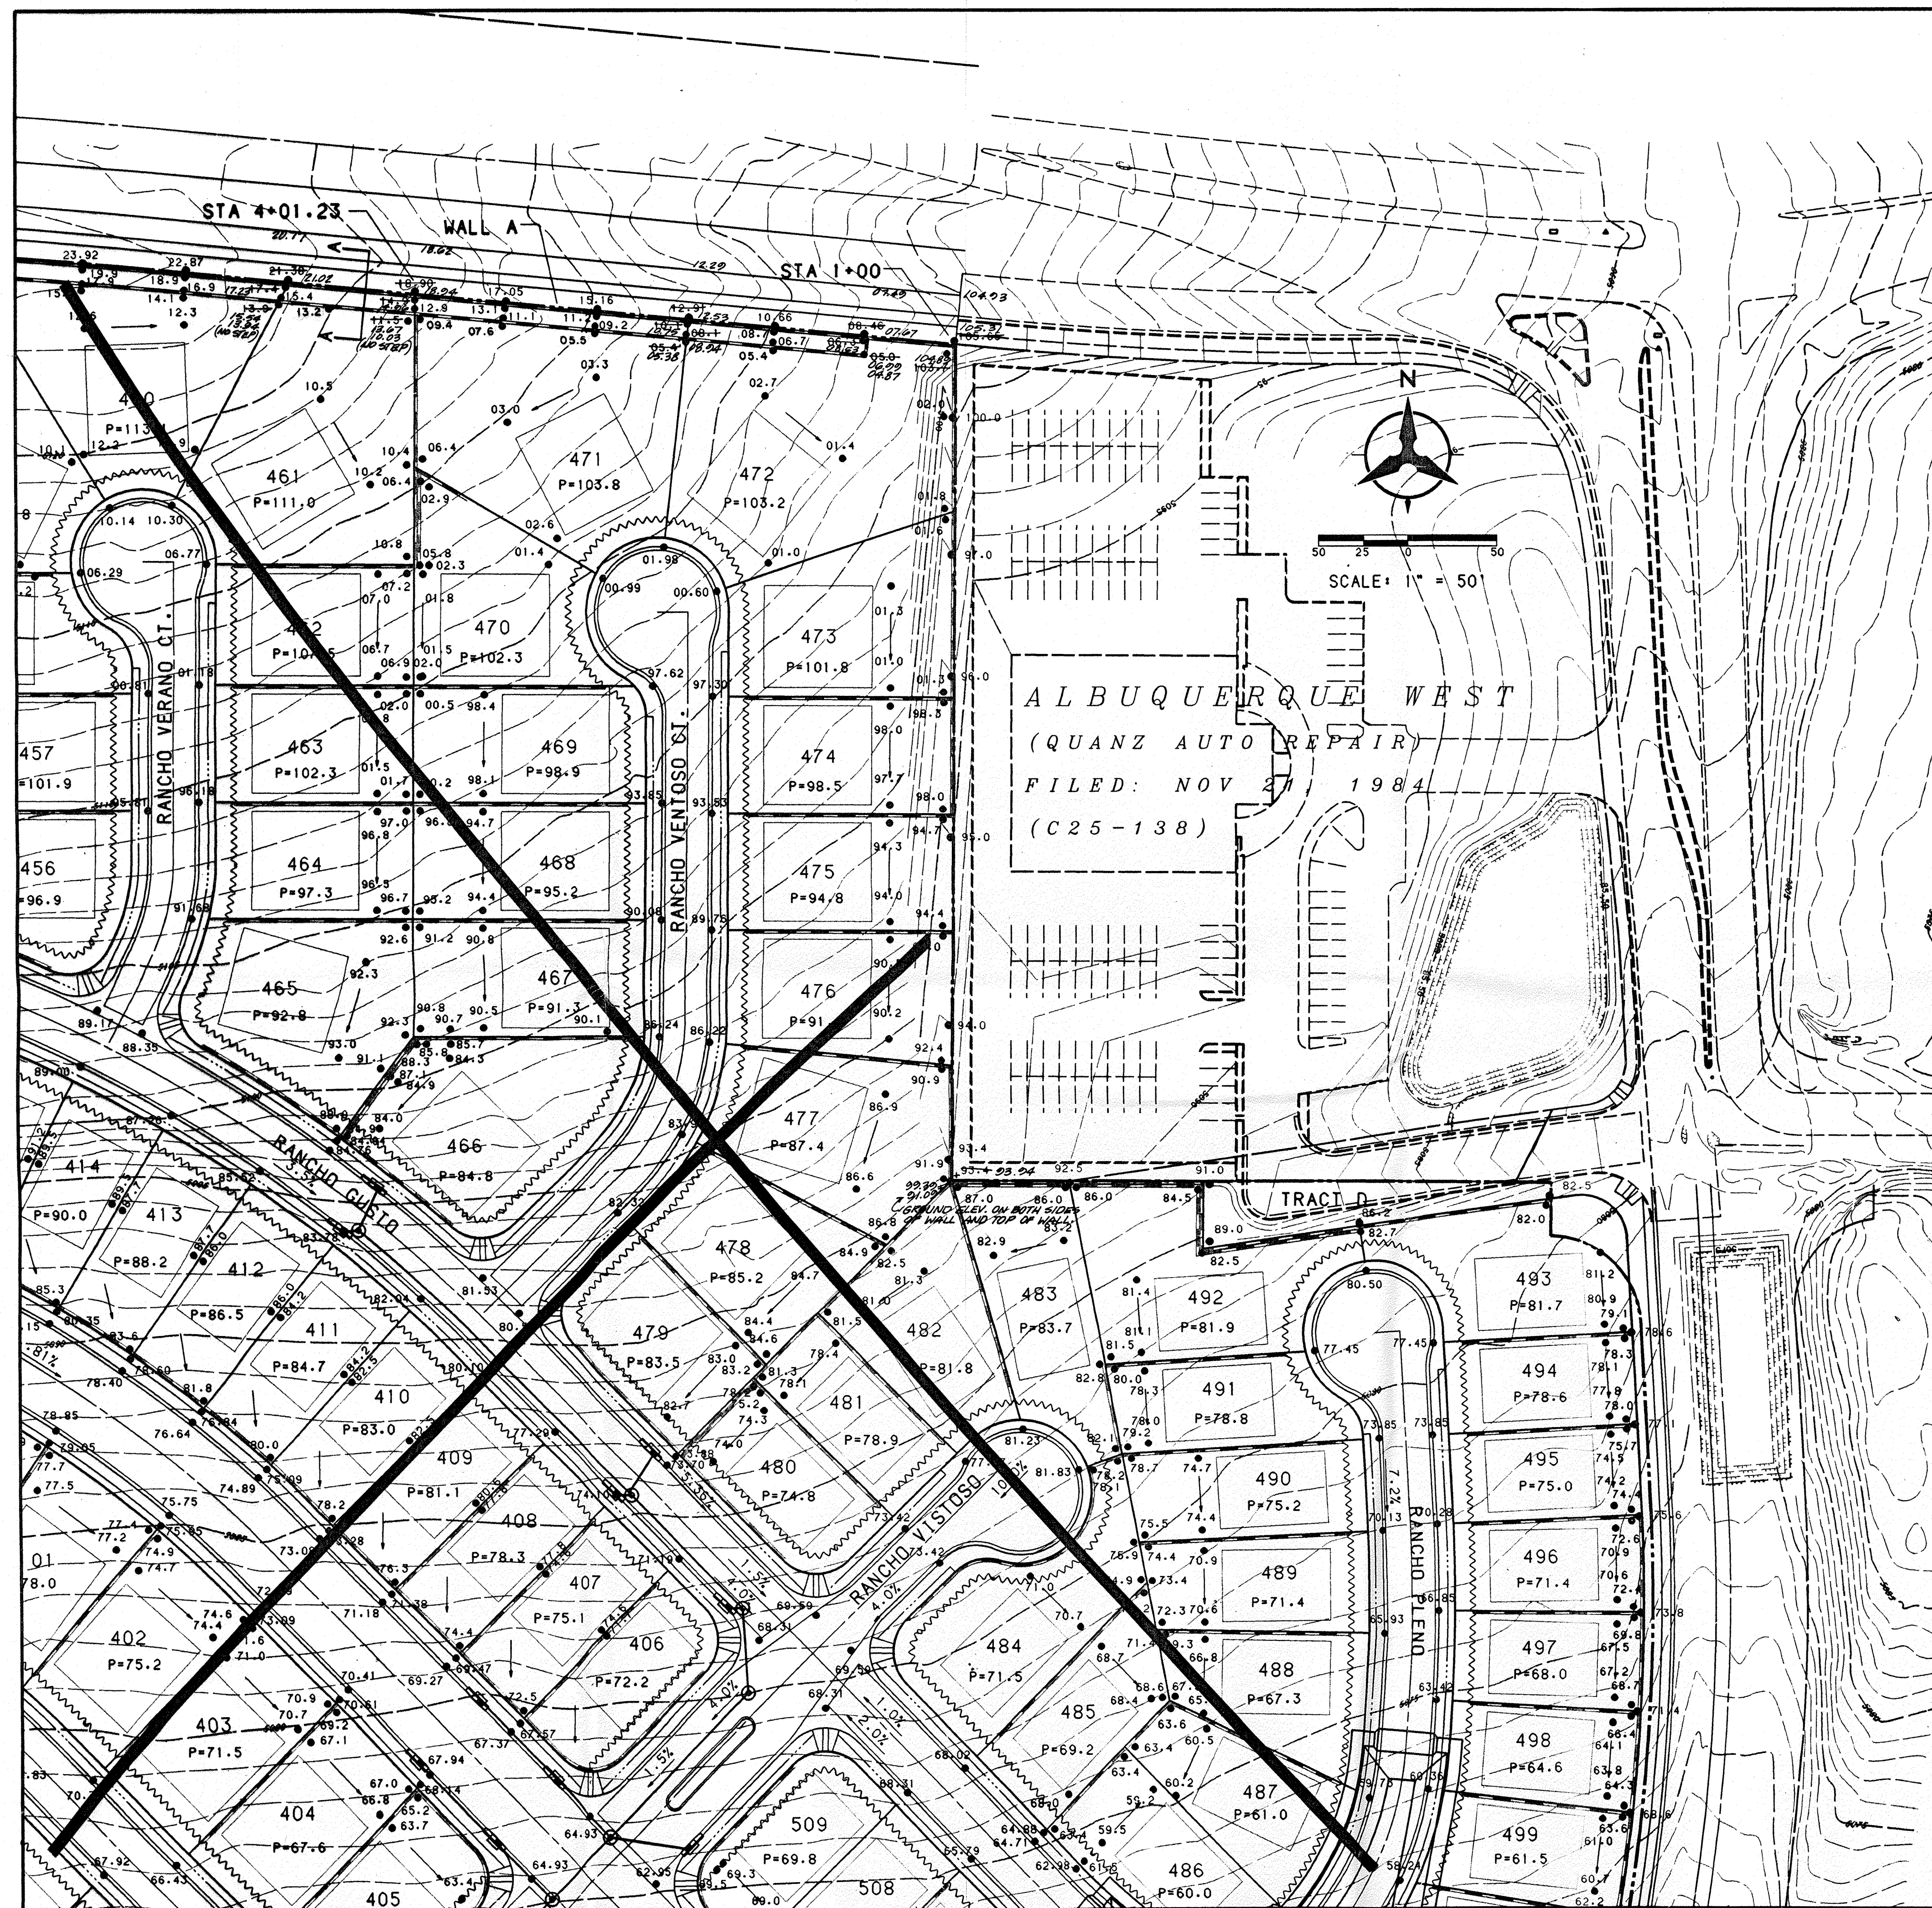

FOR GRADING CERTIFICATION ONLY,
SEE W.O. # 3 4569.95
FOR WALL AS-BUILTS.

GRADING AND DRAINAGE CERTIFICATION

I, KERRY L. DAVIS, P.E. #8984, HAVE PERSONALLY VISITED THE SITE, AND HEREBY CERTIFY THAT THE SITE GRADING, PAVING, STORM DRAINAGE, AND OTHER IMPROVEMENTS ARE CONSTRUCTED IN SUBSTANTIAL COMPLIANCE WITH THIS APPROVED GRADING AND DRAINAGE PLAN, TO ALLOW THE IMPLEMENTATION OF THE DRAINAGE PATTERNS AND REQUIREMENTS IDENTIFIED HEREIN. AS-BUILT ELEVATIONS WERE VERIFIED BY FIELD SURVEYS PERFORMED BY BOHANNAN-HUSTON INC. DURING MAY, 1994. THIS STATEMENT DOES NOT REPRESENT CERTIFICATION OF CONTRACTORS CONSTRUCTION METHODS OR MATERIALS.

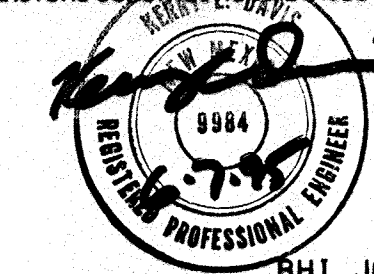

BHI JOB NO. C94114.01

LEGEND

PROJECT BOUNDARY	---
EXISTING CONTOUR	---
EXISTING SPOT ELEVATION	019.25
PROPOSED SPOT ELEVATION	005.70
DIRECTION OF FLOW	S-2.544X
BASIN BOUNDARY	---
EROSION CONTROL BERM	---
PROPOSED RETAINING WALL	---
EXISTING STORM DRAIN LINE	SD
EXISTING STORM DRAIN MANHOLE	SD
PROPOSED STORM DRAIN LINE	SD
PROPOSED STORM DRAIN MANHOLE	SD
PROPOSED STORM DRAIN INLET	SD
STREET FLOW	Q _s = 5.0 CFS
PIPE FLOW	Q _p = 5.0 CFS
SHEET FLOW	Q _s = 5.0 CFS


*ALL FLOWS SHOWN ARE 100 YEAR EVENT

GENERAL GRADING NOTES:

1. THE CONTRACTOR MUST OBTAIN A TOPSOIL DISTURBANCE PERMIT FROM THE CITY OF ALBUQUERQUE, ENVIRONMENTAL HEALTH DIV., PRIOR TO CONSTRUCTION.
2. THE CONTRACTOR IS TO REFER TO THE EARTHWORK SPECIFICATIONS NOTED IN THE GEOTECHNICAL INVESTIGATION REPORT PREPARED BY VINEYARD AND ASSOCIATES, DATED JUNE 16, 1993 AND SUPPLIED BY THE OWNER.
3. THE CONTRACTOR SHALL CONFORM TO ALL CITY, COUNTY, STATE AND FEDERAL DUST CONTROL MEASURES AND REQUIREMENTS AND WILL BE RESPONSIBLE FOR PREPARING AND OBTAINING ALL NECESSARY APPLICATIONS, PERMITS AND APPROVALS.


EROSION CONTROL PLAN:

THE CONTRACTOR SHALL ENSURE THAT NO SOIL ERODES FROM THE LOTS INTO PUBLIC RIGHT-OF-WAY. THIS CAN BE ACHIEVED BY CONSTRUCTING TEMPORARY EROSION CONTROL BERMS AS PER DETAIL THIS SHEET AND WETTING THE SOIL REGULARLY TO KEEP IT FROM BLOWING.

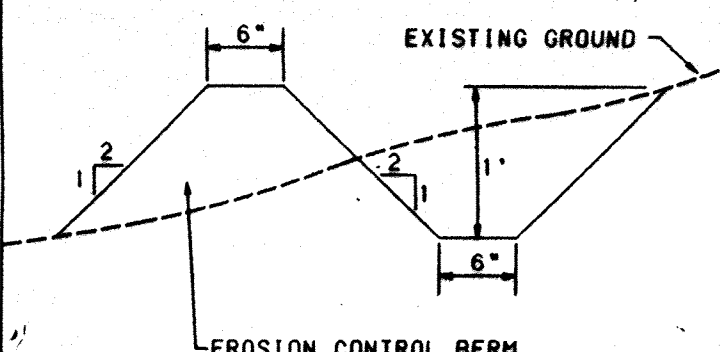


EROSION CONTROL PLAN

NO SCALE
A BERM WITH THE DIMENSIONS SHOWN SHALL BE MAINTAINED DURING CONSTRUCTION UNTIL COMPLETION OF INDIVIDUAL HOMES WITHIN THE PROJECT.

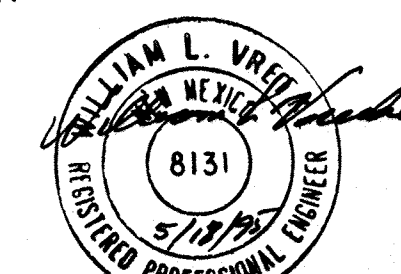

RECORD DRAWING

Perimeter Wall, Paved Driveway
DATE: 5/10/95

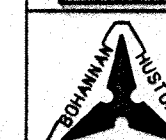

CITY OF ALBUQUERQUE
PUBLIC WORKS DEPARTMENT
ENGINEERING GROUP

RANCHO SERENO SUBDIVISION - UNIT III FINAL GRADING & DRAINAGE PLAN

APPROVALS	ENGINEER	DATE	APPROVALS	ENGINEER	DATE
DRG CHAIRMAN	W. L. Virdi	7-4-94	WATER	N/A	7-4-94
TRANSPORTATION	M. R. C. H.	6-17-94	WASTE WATER	N/A	6-17-94
HYDROLOGY	A. C. H.	6-17-94	A.M.A.F.C.A.	N/A	6-17-94











DRAWING NO.	4569.95	MAP NO.	C-12	SHEET	9 OF 51
-------------	---------	---------	------	-------	---------

Copyright Bohannon-Huston, Inc. 1994

USERNAME: CDP21TC9411401.PAD
FILENAME: GRADES.GRF

1 2 3 4 5 6 7 8 9 10 11 12 13 14 15
26 45 69 95 09 25

JUN - 9 1995

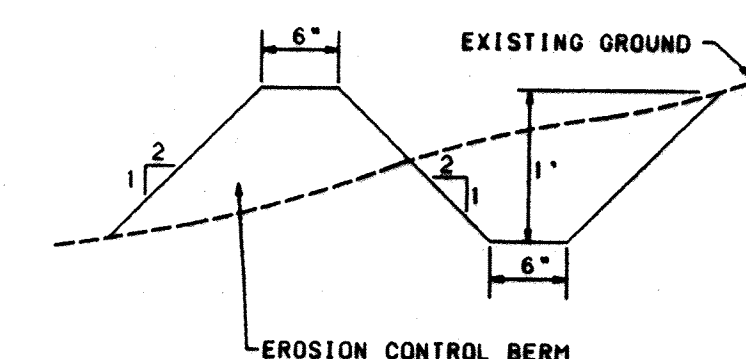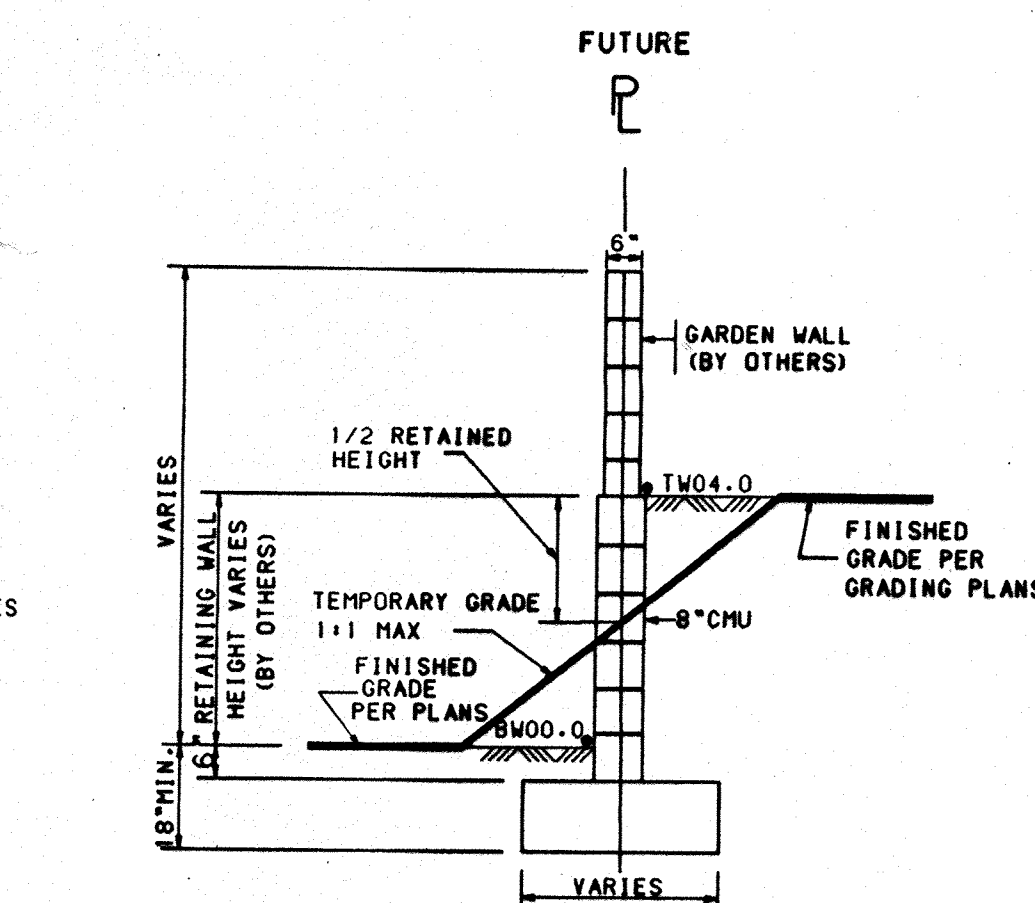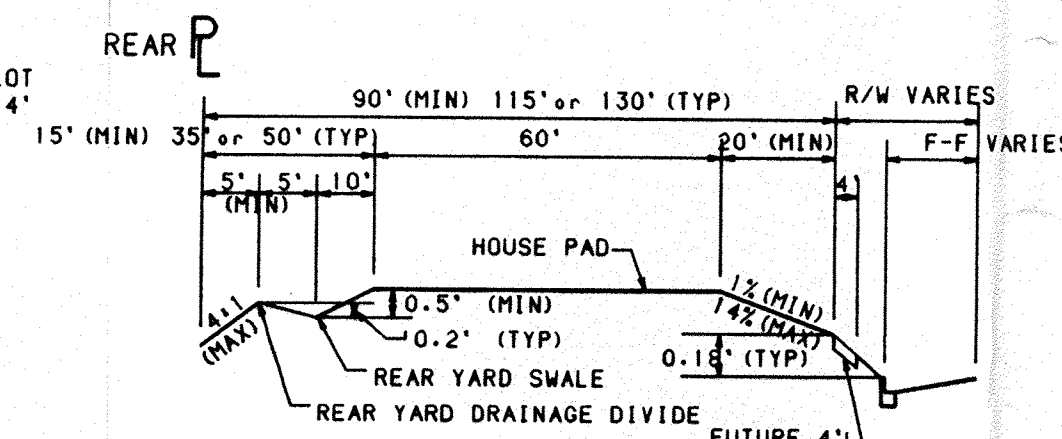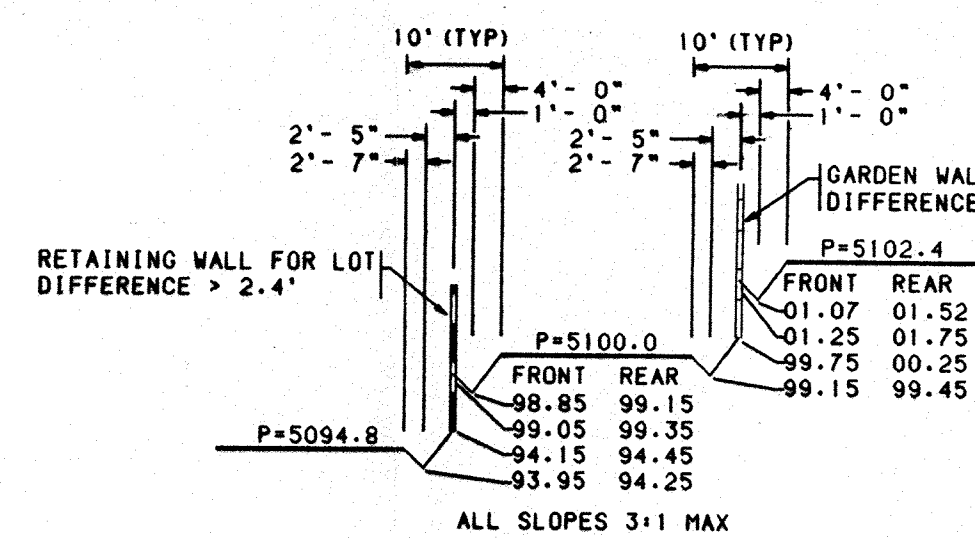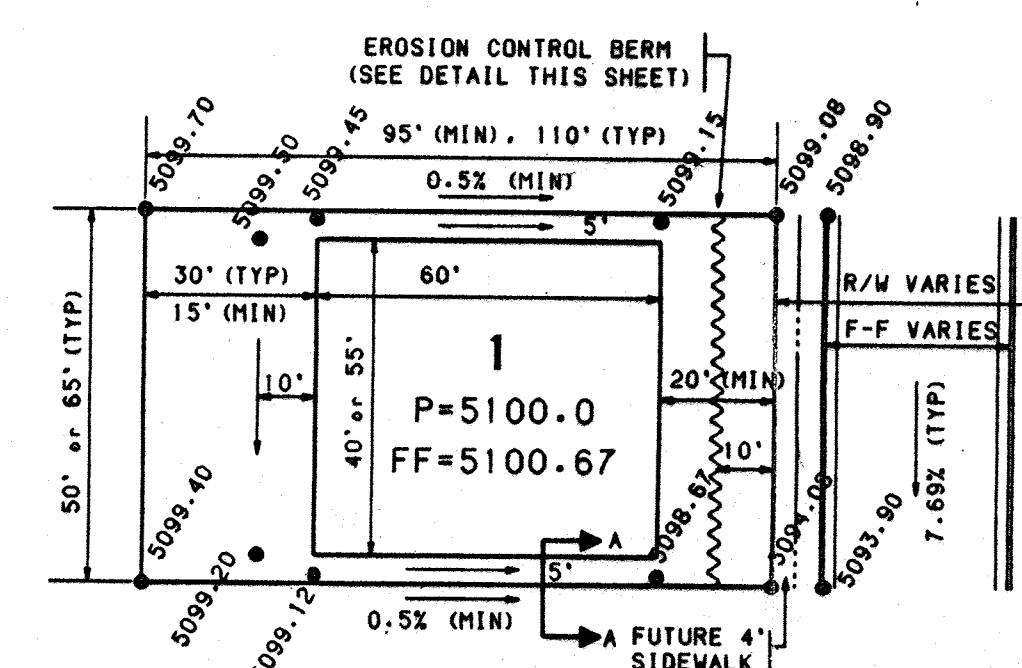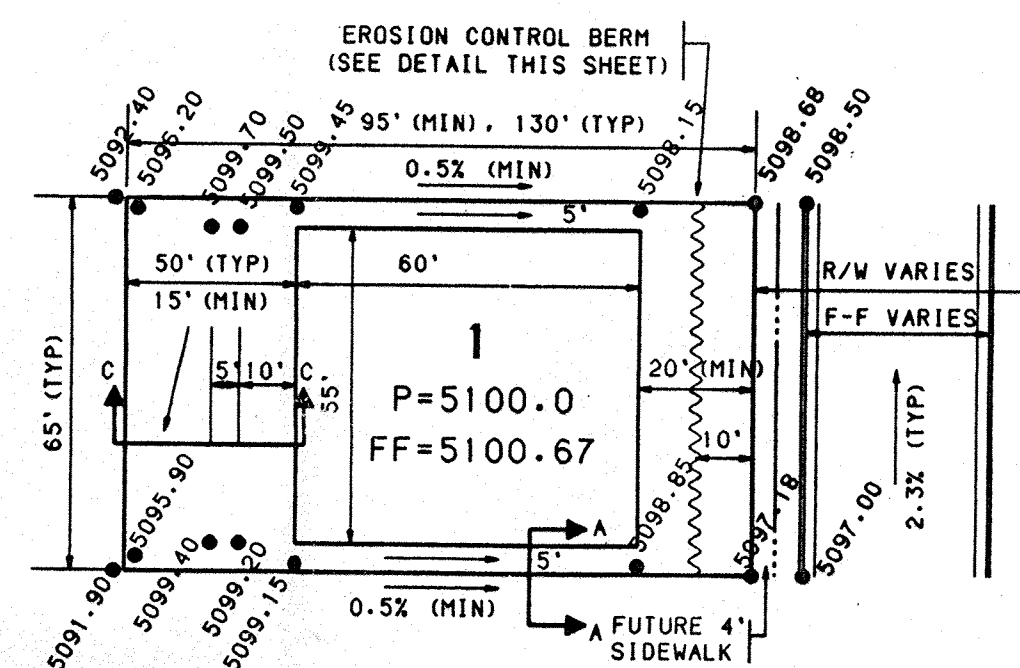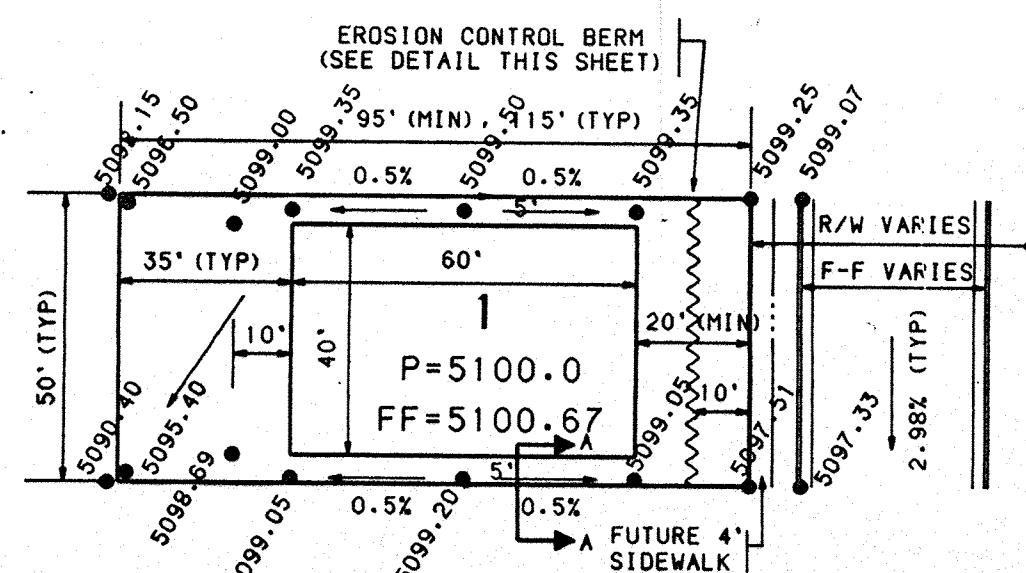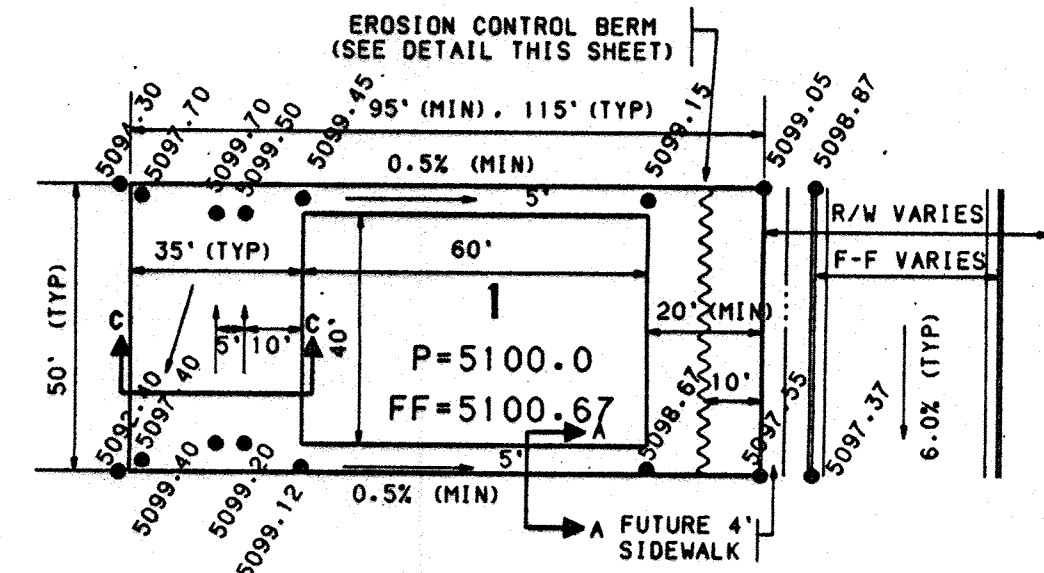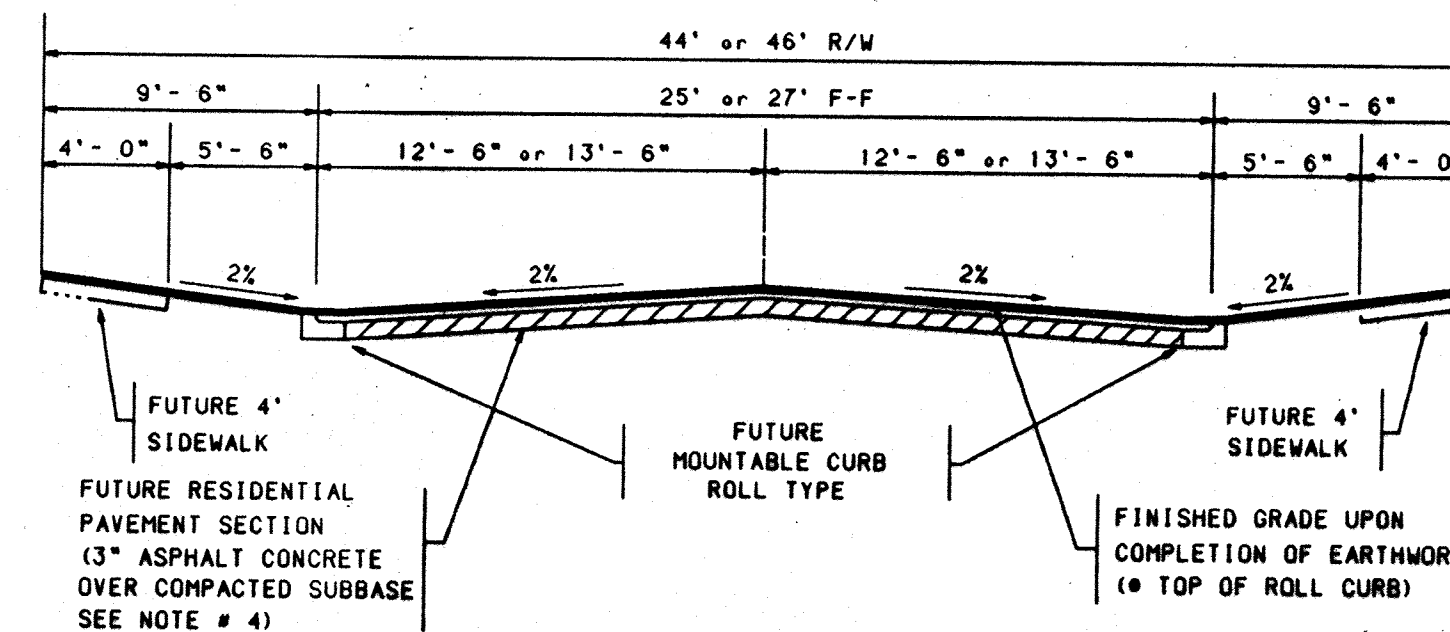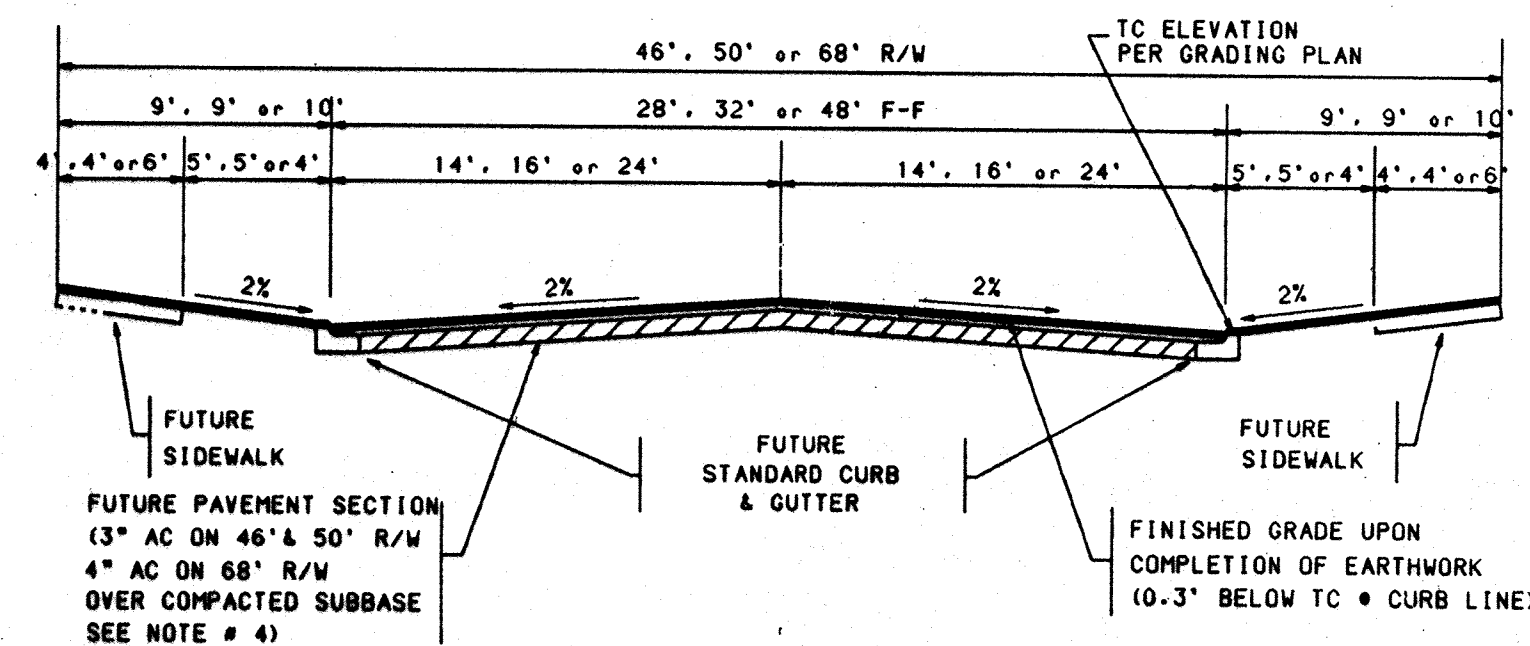

GENERAL GRADING NOTES:

1. THE CONTRACTOR MUST OBTAIN A TOPSOIL DISTURBANCE PERMIT FROM THE CITY OF ALBUQUERQUE, ENVIRONMENTAL HEALTH DIV., PRIOR TO CONSTRUCTION.
2. THE CONTRACTOR IS TO REFER TO THE EARTHWORK SPECIFICATIONS NOTED IN THE GEOTECHNICAL INVESTIGATION REPORT PREPARED BY VINEYARD AND ASSOCIATES, DATED JUNE 16, 1993 AND SUPPLIED BY THE OWNER.
3. THE CONTRACTOR SHALL CONFORM TO ALL CITY, COUNTY, STATE AND FEDERAL DUST CONTROL MEASURES AND REQUIREMENTS AND WILL BE RESPONSIBLE FOR PREVENTING AND OBTAINING ALL NECESSARY APPLICATIONS, PERMITS AND APPROVALS.
4. FINISHED GRADE IN ROADWAY SECTIONS IS BASED UPON MATERIAL IMPORTED DURING EARTHWORK BEING ACCEPTABLE FOR ROADWAY SUBBASE.

EROSION CONTROL PLAN:

THE CONTRACTOR SHALL ENSURE THAT NO SOIL ERODES FROM THE LOTS INTO PUBLIC RIGHT-OF-WAY. THIS CAN BE ACHIEVED BY CONSTRUCTING TEMPORARY EROSION CONTROL BERMS AS PER DETAIL THIS SHEET AND WETTING THE SOIL REGULARLY TO KEEP IT FROM BLOWING. IN ADDITION, THE CONTRACTOR SHALL RESEED ALL DISTURBED AREAS WITH AHAFCA'S PIEDRAS MARCADAS DAM BASIN ACCORDING TO CITY STANDARD REVEGETATION SPECIFICATIONS.

GRADING AND DRAINAGE CERTIFICATION

I, KERRY L. DAVIS, P.E. #0084, HAVE PERSONALLY VISITED THE SITE, AND HEREBY CERTIFY THAT SITE GRADING, PAVING, STORM DRAINAGE AND OTHER IMPROVEMENTS ARE CONSTRUCTED IN SUBSTANTIAL COMPLIANCE WITH THIS APPROVED GRADING AND DRAINAGE PLAN, TO ALLOW THE ELLEVATED STORM DRAINAGE PATTERNS AND REQUIREMENTS IDENTIFIED HEREIN. AS-BUILT ELEVATIONS WERE VERIFIED BY FIELD SURVEYS PERFORMED BY BOHANNAN-HUSTON INC. DURING MAY, 1995. THIS STATEMENT DOES NOT REPRESENT CERTIFICATION OF CONTRACTORS CONSTRUCTION METHODS OR MATERIALS.



RECORD DRAWING

DATE: 5/18/95

APPROVED FOR ROUGH GRADING ($\pm 1'$)

A.M.A.F.C.A. DATE

APPROVED FOR ROUGH GRADING ($\pm 1'$)

HYDROLOGY ENGINEER DATE

CITY OF ALBUQUERQUE
PUBLIC WORKS DEPARTMENT
ENGINEERING GROUP

RANCHO SERENO SUBDIVISION - UNIT III
GRADING & DRAINAGE DETAILS

APPROVALS	ENGINEER	DATE	APPROVALS	ENGINEER	DATE
DRC CHAIRMAN	<i>B.F. Gooding</i>	<i>7-14-94</i>	WATER	<i>N/A RWK</i>	<i>6-17-94</i>
TRANSPORTATION	<i>N/A RHO</i>	<i>6-17-94</i>	WASTE WATER	<i>N/A RWK</i>	<i>6-17-94</i>
HYDROLOGY	<i>C. Austin</i>	<i>6-17-94</i>	A.M.A.F.C.A.	<i>John Hall</i>	<i>6-17-94</i>




DRAWING NO.	4569.95	MAP NO.	C-12	SHEET	10 OF 51
-------------	---------	---------	------	-------	----------

DATE: 4/26/98
JAMES R. TOPMILLER, P.E.
K.M.P.E. NO. 9954

AS-BUILT ELEVATIONS ARE SHOWN ON THE PLAN IN LOCATIONS OUT AND THE NEW ELEVATION IS LISTED. ELEVATIONS WERE PROVIDED BY BOHANNAN-HUSTON, INC. AND DAVID C. CLAUSON.

REGISTERED PROFESSIONAL ENGINEER IN THE STATE OF NEW MEXICO, DO HEREBY CERTIFY THAT THE EXISTING AND PROPOSED DRAINAGE CONDITIONS OF THE SITE ARE IN SUBSTANTIAL COMPLIANCE WITH PREVIOUSLY APPROVED PLANS, TO THE BEST OF MY KNOWLEDGE AND BELIEF.

JAMES R. TOPMILLER
REGISTERED PROFESSIONAL ENGINEER
K.M.P.E. NO. 9954

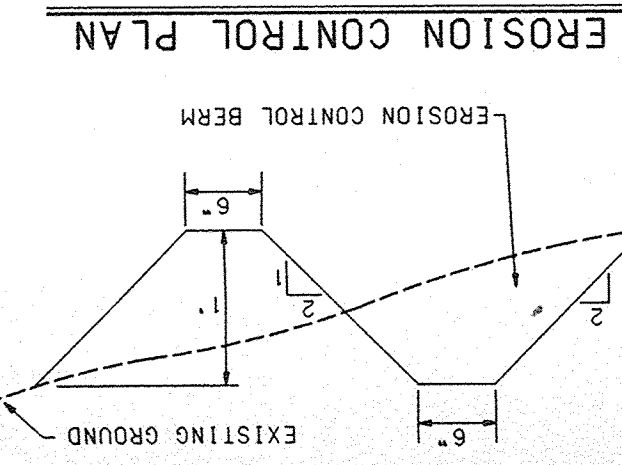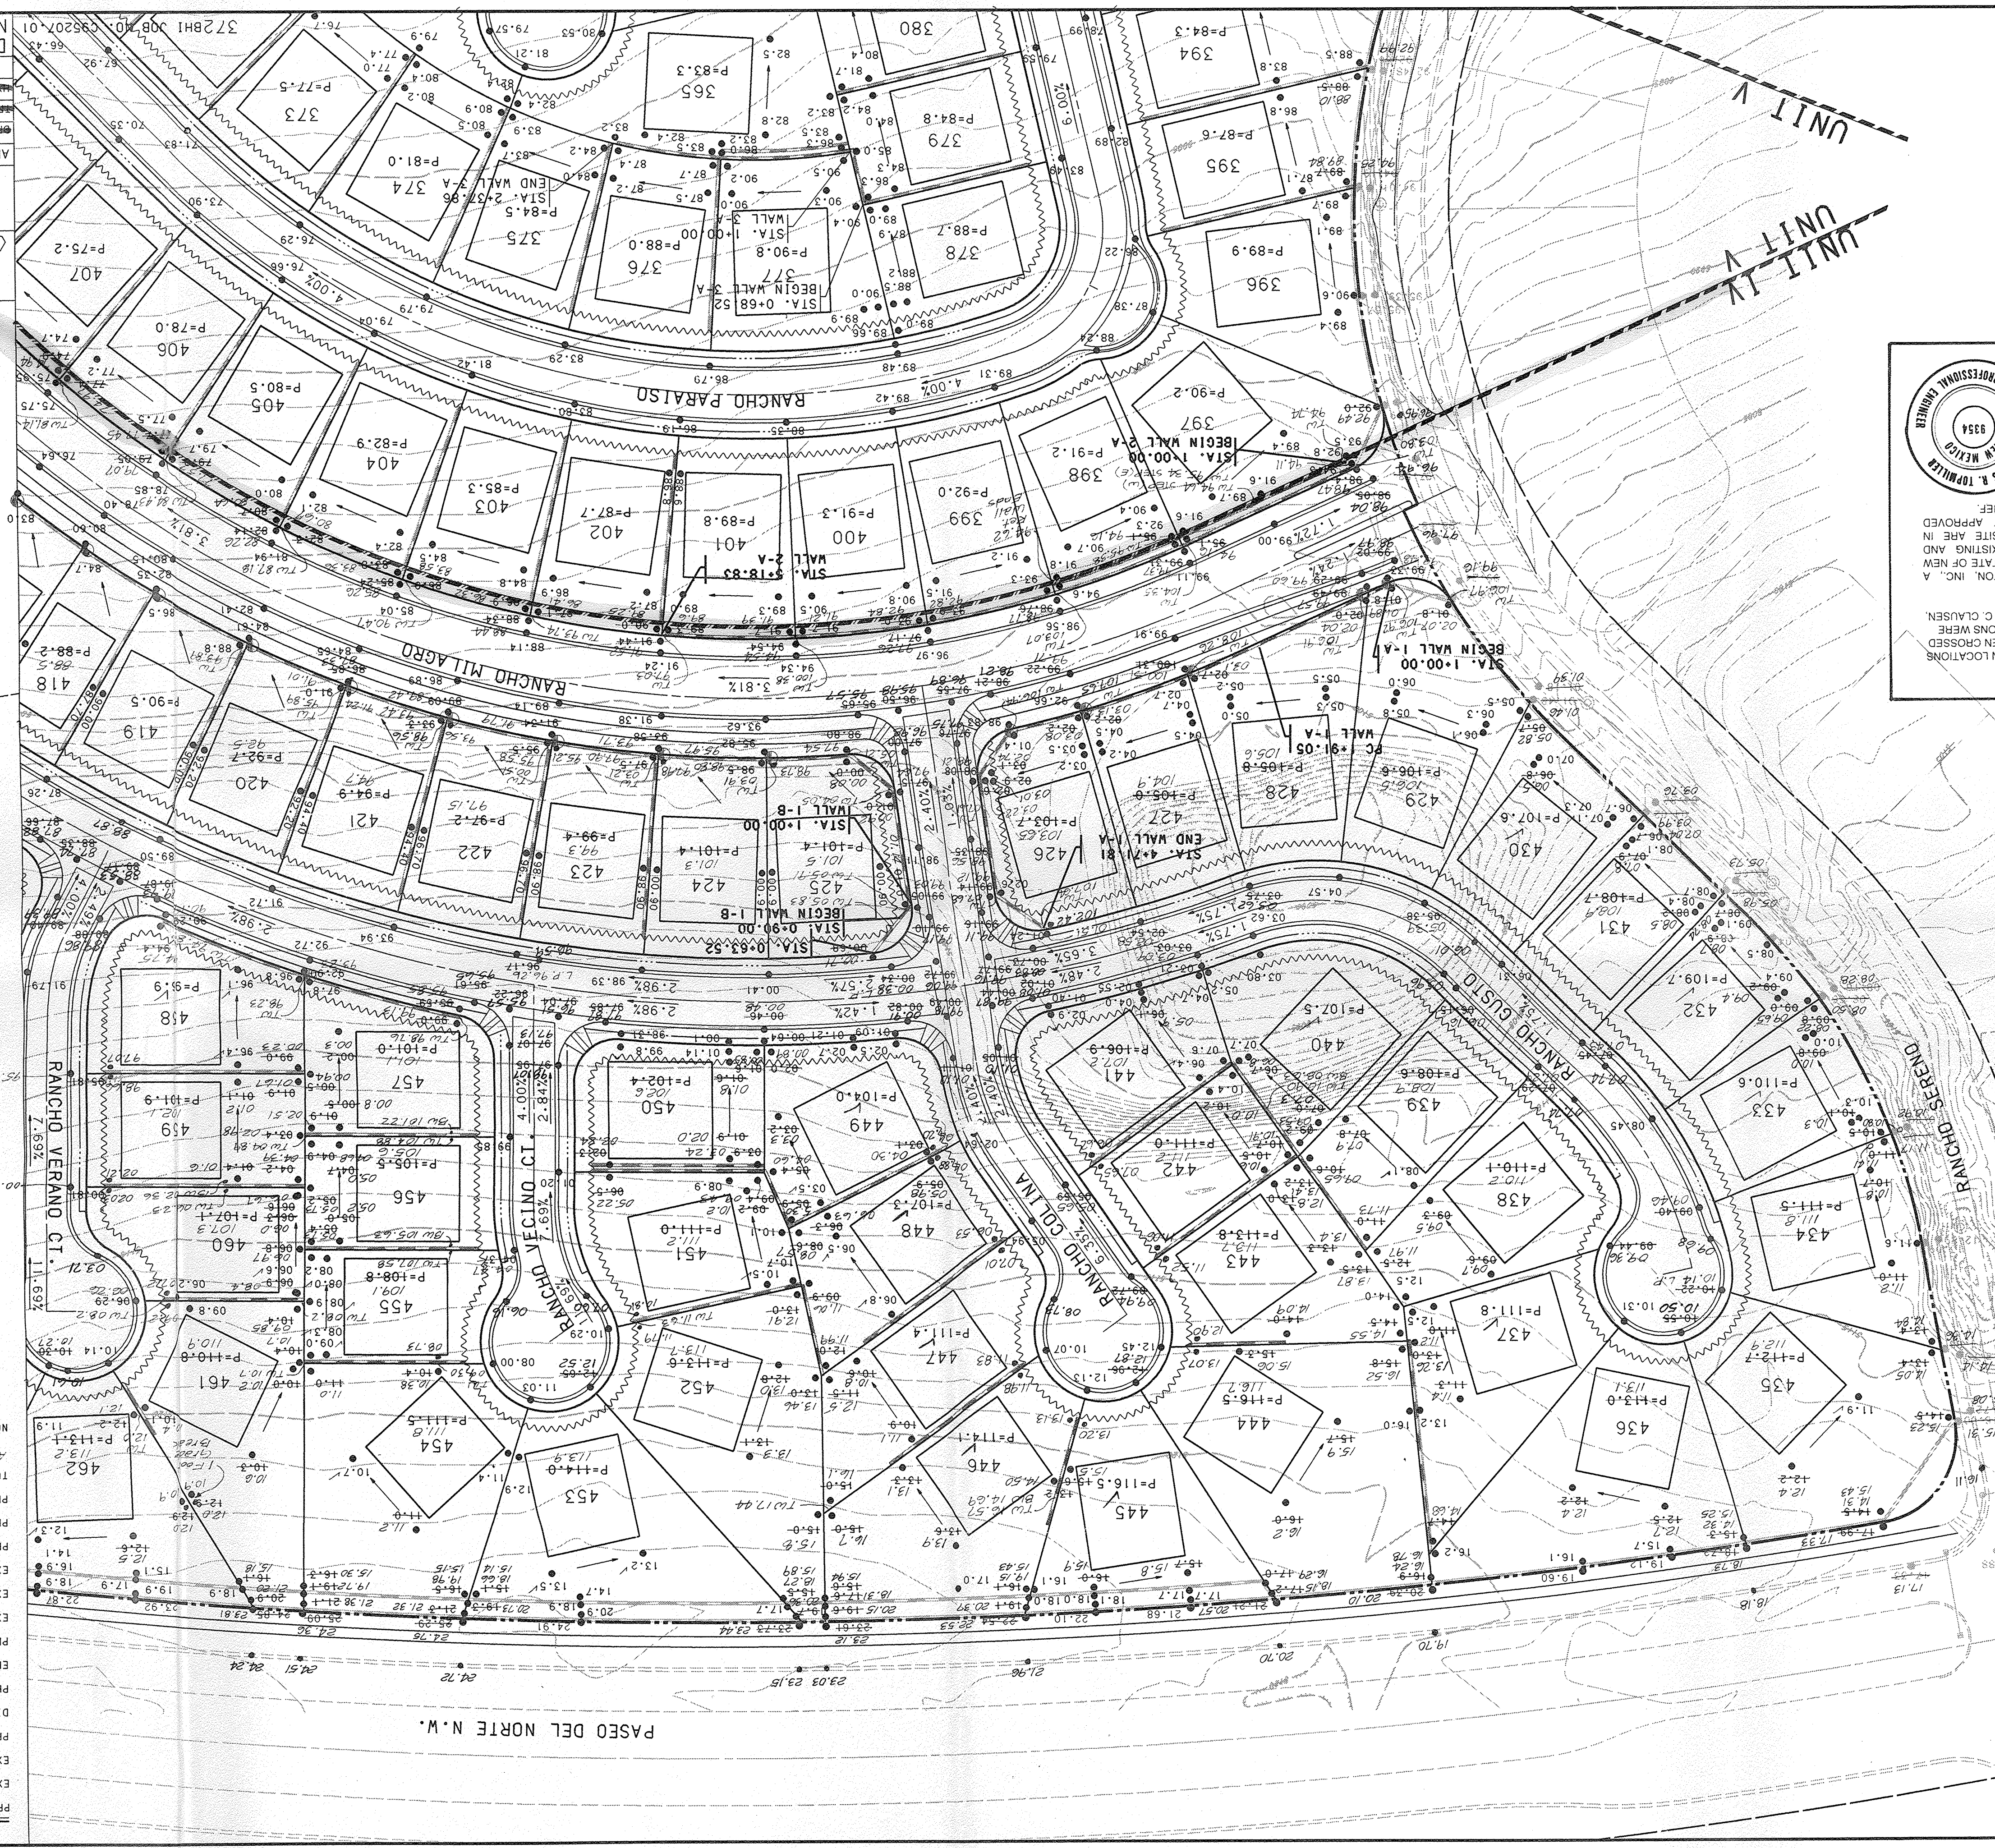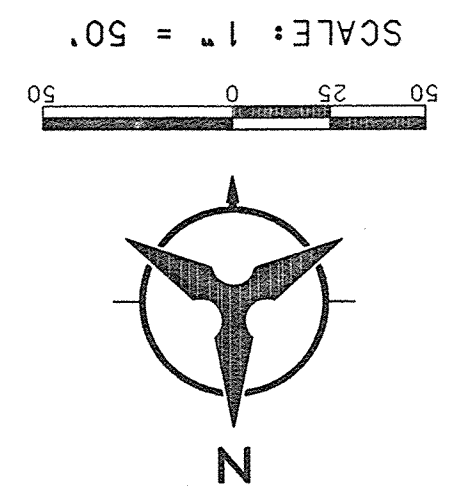

- LEGEND
- PROJECT BOUNDARY
 - EXISTING SPOT ELEVATION
 - PROPOSED SPOT ELEVATION
 - DIRECTION OF FLOW
 - PHASE BOUNDARY
 - EROSION CONTROL BERM
 - EXISTING STORM DRAIN LINE
 - EXISTING STORM DRAIN MANHOLE
 - PROPOSED STORM DRAIN LINE
 - PROPOSED STORM DRAIN MANHOLE
 - TURNED BLOCK LOCATION
 - AS-BUILT ELEVATION (TYPE)
 - NOTE: SPOT ELEVATIONS SHOWN AT CURB

RECORD DRAWING

DATE: _____

CITY OF ALBUQUERQUE
PUBLIC WORKS DEPARTMENT
ENGINEERING GROUP

APPROVALS: _____
ENGINEER: _____
DATE: _____
APPROVALS: _____
ENGINEER: _____
DATE: _____

DRAWING NO. 4569.96
MAP NO. C-12
SHEET 7 OF 38

DESIGNED BY: MSJ
DRAWN BY: SAR
CHECKED BY: KLD

DATE: 10/95
DATE: 10/95
DATE: 10/95

REVISIONS

NO.	DATE	REMARKS	BY
1	1/29/98	DARKENED PROPOSED RETAINING WALLS	MSJ

ENGINEER'S SEAL SURVEY INFORMATION

FIELD NOTES

DATE: _____
BY: _____

BENCH MARKS

STATION MARK IS A STANDARD USCSAS BRASS
TABLET, STAMPED "HUGHES, 1954", SET IN TOP
OF A CONCRETE POST PROJECTING 0.3 FT. ABOVE
THE GROUND. TO REACH THE STATION FROM THE
INTERSECTION OF CENTRAL AVE. AND STATE RD.
448, GO NORTH ON STATE RD. 448, 6.1 MILES.
THE STATION IS 450' WEST OF STATE RD. 448
IN A FENCED-IN PRAIRIE. ELEV. = 5049.93

AS-BUILT INFORMATION

CONTRACTOR: _____
INSPECTOR'S: _____
DATE: _____
RECORDED BY: _____
DATE: _____

	RANCHO SERENO SUBDIVISION - UNIT IV GRADING & DRAINAGE DETAILS	
---	---	---

ENGINEER'S SEAL

THE CONTRACTOR SHALL ENSURE THAT NO SOIL ERODES FROM THE LOTS INTO PUBLIC RIGHT-OF-WAY. THIS CAN BE ACHIEVED BY CONSTRUCTING TEMPORARY EROSION CONTROL BERRMS AS PER DETAIL THIS SHEET AND MENDING THE SOIL REGULARLY TO KEEP IT FROM BLOWING.
STATION MARK TABLET, STAINLESS STEEL, OF A CONCRETE FOUNDATION. INTERSECTION 448. GO NORTH IN A FENCED

1997, 1998, 1999, 2678, 26

EROSION CONTROL BERM

-EROSION CONTROL PERMIT

NO SCALE

BM=FINISHED GRADE ELEVATION AT BOTTOM OF RETAINING WALL

NO SCALE

1 2 3 1040 104


NO SCALE

SECTION A-A

REAR

RANCHO MILAGRO EROSION CONTROL

5810 000 0 000 000 011

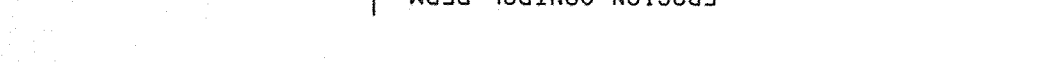

1. IC ELEVATION

UNCLASSIFIED//FOR OFFICIAL USE ONLY

GENERAL GRADING NOTES

1000