

# CITY OF ALBUQUERQUE

*Planning Department*  
Alan Varela, Director



*Mayor Timothy M. Keller*

March 4, 2022

Arthur Blessen  
J Arthur Blessen Engineering  
2429 Zena Lona St. NE  
Albuquerque, NM 87112

**RE: Jiffy Lube**  
**9386 Coors Blvd. NW**  
**Permanent CO – Accepted**  
**Grading Certification Stamp Date: 2/21/22**  
**Grading and Drainage Plan Stamp Date: 12/10/20**  
**Hydrology File: C13D024**

Dear Mr. Blessen:

PO Box 1293

Based on the submittal received on 2/22/22 and site visit on 3/3/22, this certification is approved in support of Permanent Release of Occupancy by Hydrology.

Albuquerque

If you have any questions, please contact me at 924-3986 or [earmijo@cabq.gov](mailto:earmijo@cabq.gov).

NM 87103

Sincerely,

[www.cabq.gov](http://www.cabq.gov)

Ernest Armijo, P.E.  
Principal Engineer, Planning Dept.  
Development Review Services



# City of Albuquerque

Planning Department

Development & Building Services Division

## DRAINAGE AND TRANSPORTATION INFORMATION SHEET (REV 11/2018)

**Project Title:** Jiffy Lube **Building Permit #:** \_\_\_\_\_ **Hydrology File #:** C13D024  
**DRB#:** \_\_\_\_\_ **EPC#:** \_\_\_\_\_ **Work Order#:** \_\_\_\_\_  
**Legal Description:** Tract 3C-1 Black Ranch  
**City Address:** 9386 Coors Blvd.

**Applicant:** J Arthur Blessen Engineering **Contact:** Arthur Blessen  
**Address:** 2429 Zenaa Lona, Albuquerque New Mexico 87112  
**Phone#:** 505-401-4142 **Fax#:** \_\_\_\_\_ **E-mail:** jab-engineering@hotmail.com

**Owner:** \_\_\_\_\_ **Contact:** \_\_\_\_\_  
**Address:** \_\_\_\_\_  
**Phone#:** \_\_\_\_\_ **Fax#:** \_\_\_\_\_ **E-mail:** \_\_\_\_\_

**TYPE OF SUBMITTAL:** \_\_\_\_\_ PLAT (\_\_\_\_# OF LOTS) \_\_\_\_\_ RESIDENCE \_\_\_\_\_ DRB SITE \_\_\_\_\_ ADMIN SITE

IS THIS A RESUBMITTAL?: \_\_\_\_\_ Yes ☒ No

**DEPARTMENT:** \_\_\_\_\_ TRAFFIC/ TRANSPORTATION ☒ HYDROLOGY/ DRAINAGE

Check all that Apply:

### TYPE OF SUBMITTAL:

- ☒ ENGINEER/ARCHITECT CERTIFICATION  
☐ PAD CERTIFICATION  
☐ CONCEPTUAL G & D PLAN  
☐ GRADING PLAN  
☐ DRAINAGE MASTER PLAN  
☐ DRAINAGE REPORT  
☐ FLOODPLAIN DEVELOPMENT PERMIT APPLIC  
☐ ELEVATION CERTIFICATE  
☐ CLOMR/LOMR  
☐ TRAFFIC CIRCULATION LAYOUT (TCL)  
☐ TRAFFIC IMPACT STUDY (TIS)  
☐ OTHER (SPECIFY) \_\_\_\_\_  
☐ PRE-DESIGN MEETING?

### TYPE OF APPROVAL/ACCEPTANCE SOUGHT:

- \_\_\_\_\_ BUILDING PERMIT APPROVAL  
☒ CERTIFICATE OF OCCUPANCY  
\_\_\_\_\_ PRELIMINARY PLAT APPROVAL  
\_\_\_\_\_ SITE PLAN FOR SUB'D APPROVAL  
\_\_\_\_\_ SITE PLAN FOR BLDG. PERMIT APPROVAL  
\_\_\_\_\_ FINAL PLAT APPROVAL  
\_\_\_\_\_ SIA/ RELEASE OF FINANCIAL GUARANTEE  
\_\_\_\_\_ FOUNDATION PERMIT APPROVAL  
\_\_\_\_\_ GRADING PERMIT APPROVAL  
\_\_\_\_\_ SO-19 APPROVAL  
\_\_\_\_\_ PAVING PERMIT APPROVAL  
☒ GRADING/ PAD CERTIFICATION  
\_\_\_\_\_ WORK ORDER APPROVAL  
\_\_\_\_\_ CLOMR/LOMR  
\_\_\_\_\_ FLOODPLAIN DEVELOPMENT PERMIT  
\_\_\_\_\_ OTHER (SPECIFY) \_\_\_\_\_


**DATE SUBMITTED:** 2-21-22 **By:** J Arthur Blessen

COA STAFF:


ELECTRONIC SUBMITTAL RECEIVED: \_\_\_\_\_

FEE PAID: \_\_\_\_\_




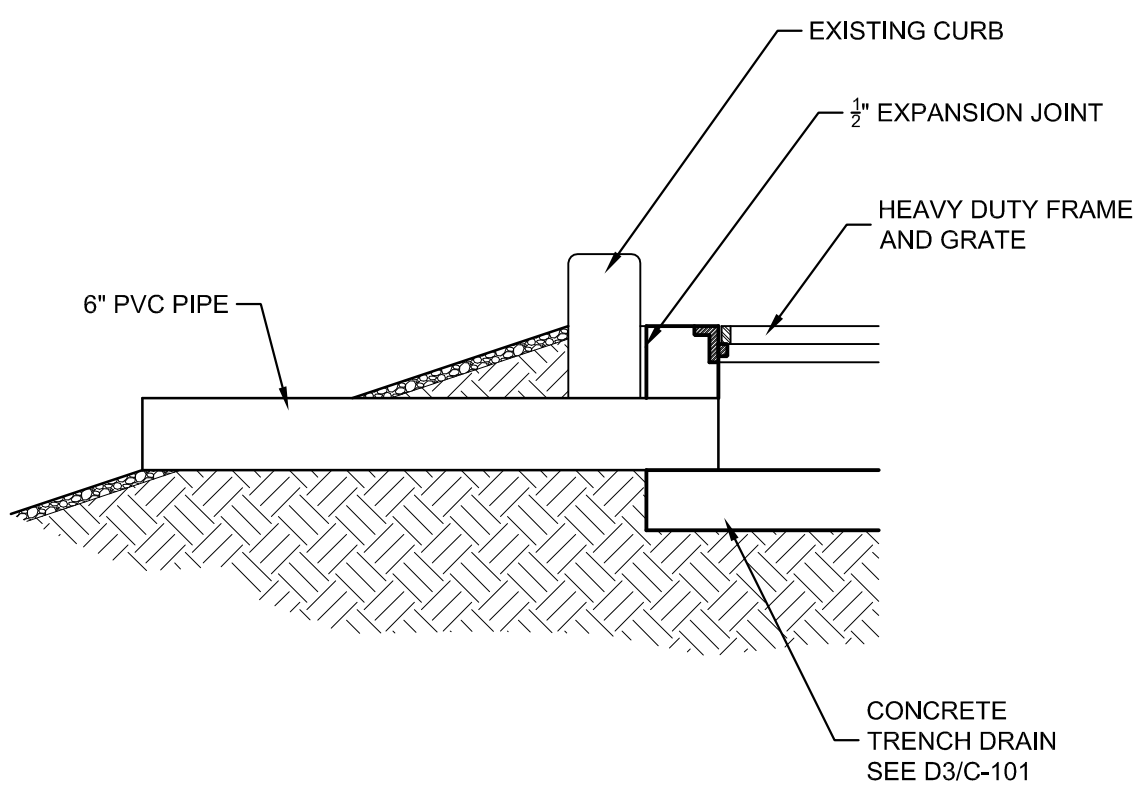

D1 TRENCH DRAIN DISCHARGE  
3/4"=1'-0"

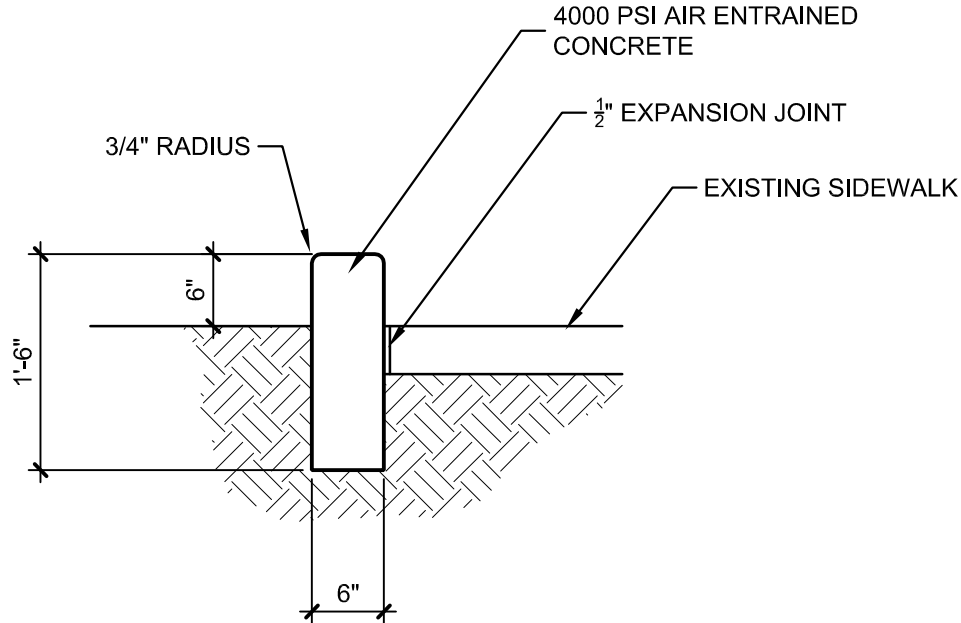

D2 CONCRETE CURB  
3/4"=1'-0"

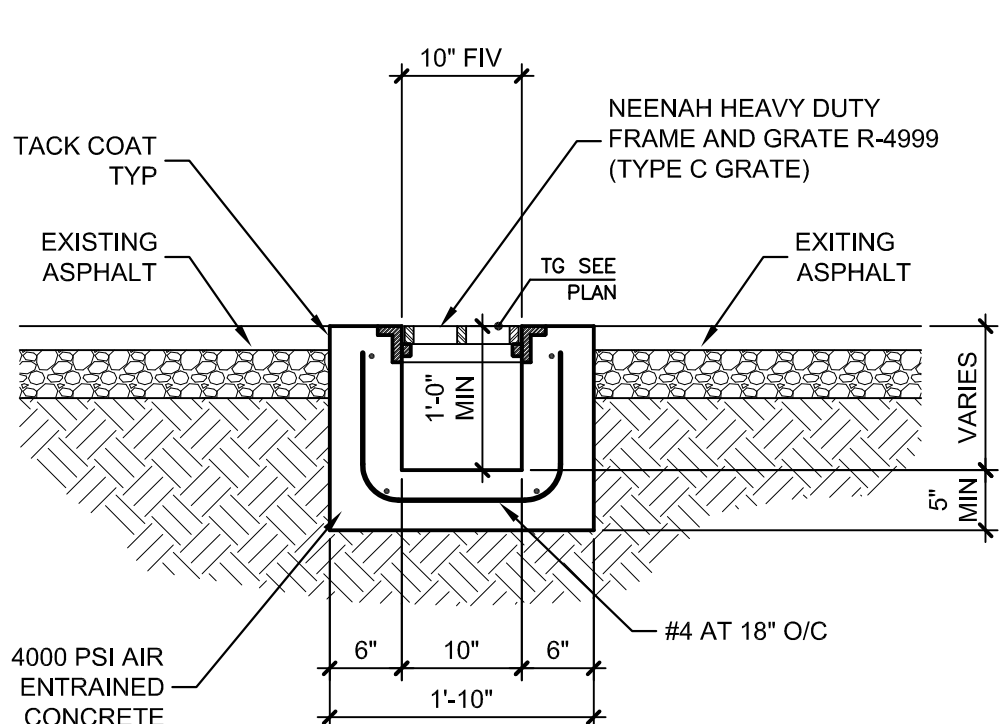

D3 TRENCH DETAIL  
3/4"=1'-0"

LEGEND:

× 93.1	EXISTING SPOT ELEVATION
• 51.00	NEW SPOT ELEVATION
— 51 —	EXISTING CONTOUR
— 51 —	NEW CONTOUR
← — — →	SWALE
FL	FLOW LINE
GND	GROUND
INV	INVERT
TA	TOP OF ASPHALT
TC	TOP OF CURB
TG	TOP OF GRATE
TS	TOP OF CONCRETE SLAB
TW	TOP OF WALL
TBM	TEMPORARY BENCH MARK
[Pattern]	GRAVEL
[Pattern]	ASPHALT PAVING
[Pattern]	CONCRETE

HYDROLOGY NOTES:  
ORIGINALLY, TRACT 3C WAS PLATED WITH AN AREA OF 1.200 ACRES. THE APPROVED MASTER PLAN (BLACK RANCH TRACT 3 GRADING, DRAINAGE, AND TERRAIN MANAGEMENT PLAN, OCT 1990, EASTERNLING AND ASSOC, INC.) INDICATES AL ALLOWABLE 100 TEAR PEAK RUNOFF FROM TRACT 3C OF 4.92 CFS. THE REPLAT OF TRACT 3C (TRACT 3C-1) IS 0.6245 ACRES IN SIZE. THEREFORE, PROPORTIONALLY, THE ALLOWABLE PEAK RUNOFF FORM TRACT 3C-1 IS (4.92 CFS) (0.6245 AC / 1.200 AC) = 2.56 CFS FOR THE 100-YEAR STORM.

EXISTING CONDITIONS: PER WILLSON AND CO. GRADING & DRAINAGE PLAN 12-19-20 THE EXISTING RUNOFF FROM THE SITE DISCHARGES TO VALLEY VIEW ROAD AT THE EXISTING DRIVE ENTRANCE.

NOTE: THERE IS NO OFFSITE DRAINAGE ONTO THIS SITE. THE SITE HAS BEEN RAISED WHICH PREVENTS ANY DRAINAGE FROM TRACT 3B TO ENTER THE SITE. THE ADJACENT ROAD HAS CURB AND GUTTER DRAINAGE SYSTEM WHICH DIRECTS THE DRAINAGE TO AN OFFSET DETENTION POND LOCATED APPROXIMATELY 400 FEET TO THE SOUTH ON VALLEY VIEW ROAD. A CURB AND GUTTER SYSTEM ALONG COORS BLVD INTERCEPTS AND DIVERTS RUNOFF FROM COORS BLVD. AWAY FROM THE SITE.

THE PROPOSED ADDITION WILL BE CONSTRUCTED OVER THE EXISTING PARKING LOT AREA. THEREFORE THE IS NO CHANGES TO THE EXISTING RUNOFF.

#### Drainage Calculation

City of Albuquerque DPM 2020 edition

9386 Coors Blvd

Precipitation Zone 1  
Basin Area = 0.624 acres

Existing Treatment	Area of A =	27203 sf	100%	Area of B =	0 sf	0%	Area of C =	0 sf	0%	Area of D =	0 sf	0%
Improved Conditions Treatment	Area of A =			Area of B =	5750 sf	21%	Area of C =	0 sf	0%	Area of D =	21453 sf	79%

Excess Precipitation, E (inches) 6 hr - 100 yr storm table 6.2.13

Existing Conditions Treatment	% of Area	En	Improved Conditions Treatment	% of Area	En
A	1.00 x	0.55 = 0.55	A	0.00 x	0.55 = 0.00
B	0.00 x	0.73 = 0.00	B	0.21 x	0.73 = 0.15
C	0.00 x	0.95 = 0.00	C	0.00 x	0.95 = 0.00
D	0.00 x	2.24 = 0.00	D	0.79 x	2.24 = 1.77
	E =	0.55		E =	1.92

Volume V = E \* A / 12  
V<sub>e</sub> = 0.550 x 0.6245 / 12 = 0.029 acre ft  
V<sub>i</sub> = 1.921 x 0.6245 / 12 = 0.100 acre ft  
1247 cf  
4354 cf

Discharge Rate, Q (cfs / acre) 100 yr storm table 6.2.14

Existing Conditions Treatment	% of Area	Q	Improved Conditions Treatment	% of Area	Q
A	1.00 x	1.54 = 1.54	A	0.00 x	1.54 = 0.00
B	0.00 x	2.16 = 0.00	B	0.21 x	2.16 = 0.46
C	0.00 x	2.87 = 0.00	C	0.00 x	2.87 = 0.00
D	0.00 x	4.12 = 0.00	D	0.79 x	4.12 = 3.25
	q =	1.54		q =	3.71

Peak Rate Q<sub>p</sub> = q \* A  
Q<sub>p(e)</sub> = 1.54 x 0.6245 = 0.96 cfs  
Q<sub>p(i)</sub> = 3.71 x 0.6245 = 2.31 cfs

Excess Volume = 0.071 acre ft  
Excess Rate = 1.35 cfs

t<sub>c</sub> = 0.2 hr  
t<sub>b</sub> = (2.107 \* E \* A / Q<sub>p</sub>) \* (0.25 \* A / A<sub>i</sub>) = 0.895 hr  
t<sub>p</sub> = (0.7 \* t<sub>c</sub>) + ((1.6 \* (A<sub>i</sub> / A)) / 12) = 0.208 hr



Discharge Rate	2.314 cfs	3.71 cfs/ac	
		Allowable Discharge Rate	2.560 cfs
Volume Discharged	4549 cf		
	4549 cf		
Pond Volume	0 cf		

WATER QUALITY POND (ARTICAL 6-12 PAGE 6-109)

FF POND VOLUME = (IMPERVIOUS AREA) (0.26 IN) FOR REDEVELOPED SITES  
IMPERVIOUS AREA = 21,453 SF  
REQUIRED POND VOLUME = (21,453 SF) (0.26 IN) (1 / 12 IN/FT) = 465 CF

FIRST FLUSH POND		
POND A1	ELEVATION	AREA
	19.5	364 SF
	19.0	253 SF
	18.0	81 SF
	VOL = (81+253)(0.5)(1 FT) + (253+364)(0.5)(0.5 FT) = 321 CF	
POND A2	ELEVATION	AREA
	19.5	315 SF
	19.0	203 SF
	18.0	47 SF
	VOL = (47+203)(0.5)(1 FT) + (203+315)(0.5)(0.5 FT) = 254 CF	
TOTAL POND VOL = 321 CF + 254 CF = 575 CF		

## VINICITY MAP C-13-Z

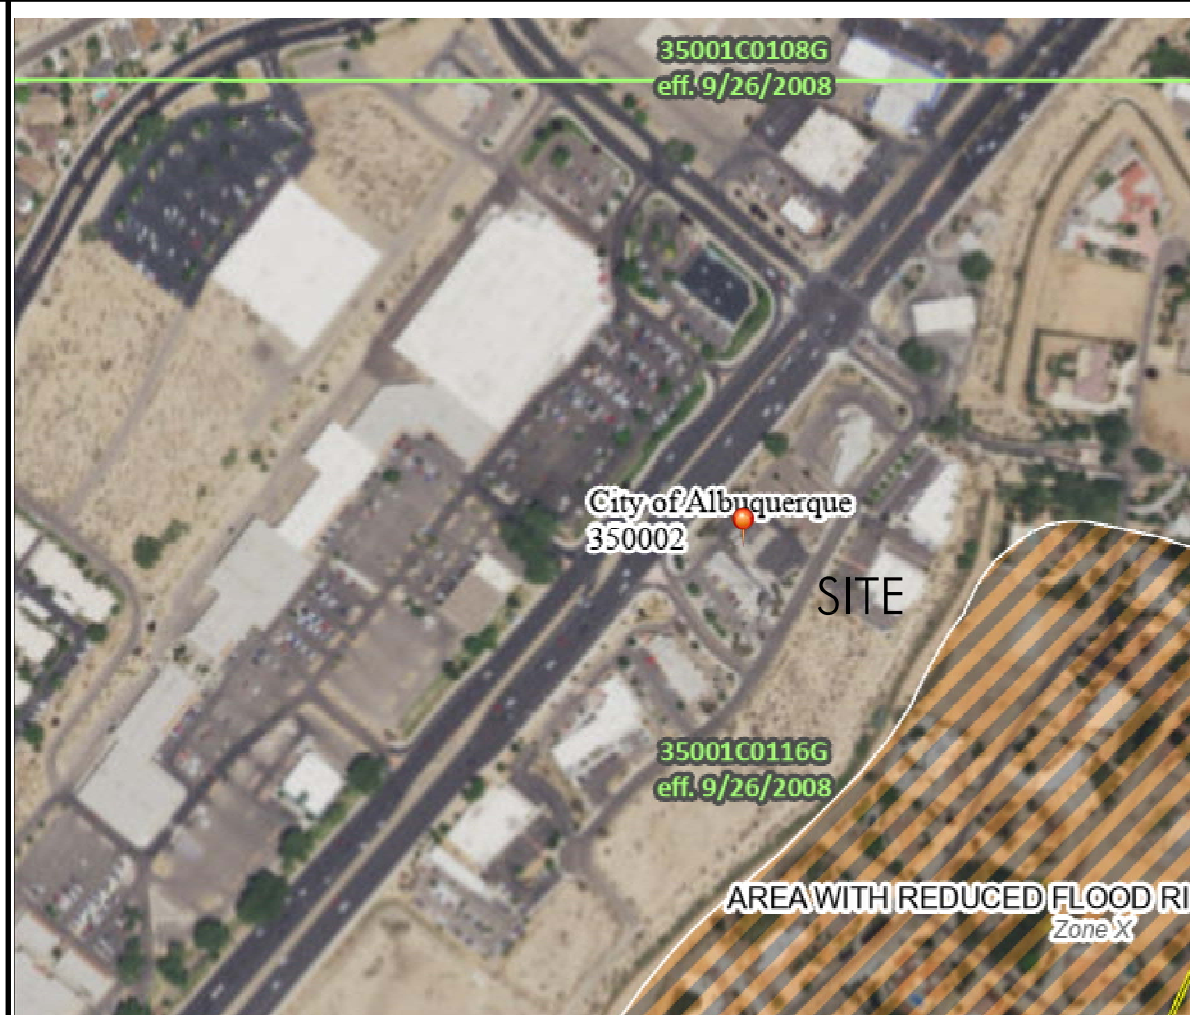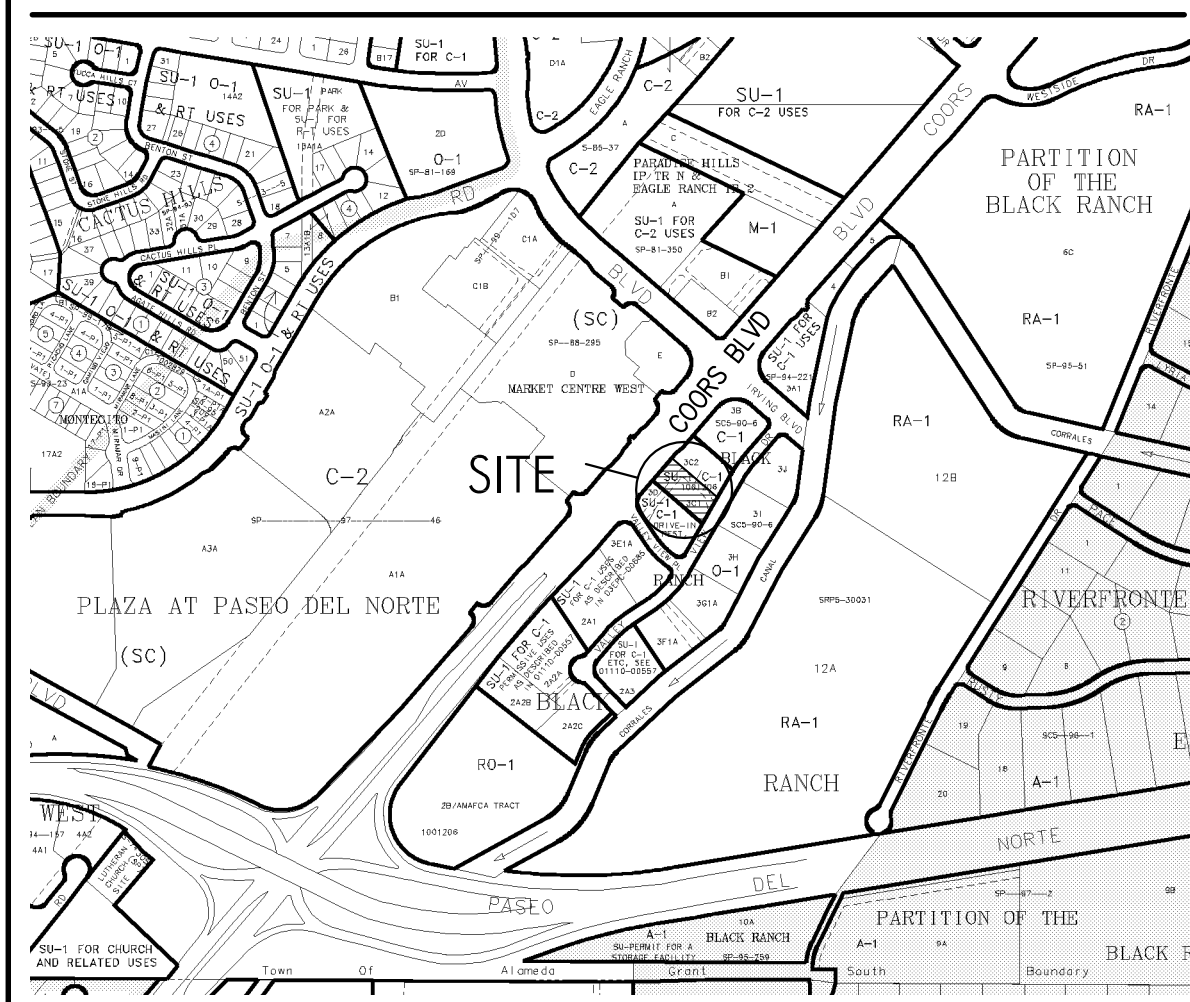

## FLOOD INSURANCE MAP PANEL 116

LEGAL DESCRIPTION: TRACT 3C-1 BLACK RANCH  
ADDRESS: 9386 COORS BLVD NW, ALBUQUERQUE, NM  
SITE AREA: 0.6245 ACRES  
BENCH MARK: ELEVATION DATUM IS BASED ON NAVD 1988 FROM ACS MONUMENT "NM-488-N10", PUBLISHED ELEVATION (FEET) = 5054.51

FLOOD HAZARD: AS SHOWN ON PANEL 35001C01166 (9-25-2008) OF THE FEMA FLOOD INSURANCE RATE MAPS, THIS SITE IS NOT WITHIN A DESIGNATED FLOOD HAZARD AREA.

#### CONSTRUCTION NOTES

- TWO WORKING DAYS PRIOR TO ANY EXCAVATION, THE CONTRACTOR SHALL CALL FOR LOCATION OF EXISTING UTILITIES.
- ALL WORK WITHIN THE CITY RIGHT-OF-WAY SHALL BE PERFORMED IN ACCORDANCE WITH THE APPLICABLE CITY OF ALBUQUERQUE STANDARDS AND PROCEDURES.
- ALL WORK SHALL BE PERFORMED IN ACCORDANCE WITH THE APPLICABLE FEDERAL, STATE, AND LOCAL REGULATIONS, LAWS, AND RULES CONCERNING SAFETY AND HEALTH.
- PRIOR TO CONSTRUCTION THE CONTRACTOR SHALL VERIFY THE EXISTING SITE CONDITIONS AND INFORM THE ARCHITECT / ENGINEER OF ANY DISCREPANCY BETWEEN THE INFORMATION SHOWN ON THE PLANS AND THOSE OF THE EXISTING SITE.
- THE CONTRACTOR SHALL PROVIDE THE ARCHITECT / ENGINEER WITH AN AS BUILT SURVEY FOR ENGINEER'S CERTIFICATION AT PROJECT COMPLETION.
- THE CONTRACTOR SHALL MAINTAIN A RECORD DRAWING SET OF PLANS AND PROMPTLY LOCATE EXISTING AND NEW ELEVATIONS (FINISH FLOORS, TOPS OF CURBS AND ASPHALT, FLOW LINE, PIPE INVERTS, ETC.), ON THE RECORD SET. THE RECORD SET SHALL BE MAINTAINED ON THE PROJECT SITE AND SHALL BE AVAILABLE TO THE OWNER AND ARCHITECT AT ANY TIME DURING CONSTRUCTION. UPON COMPLETION OF THE PROJECT, THE RECORD SET SHALL BE TURNED OVER TO THE OWNER.
- THE OWNER / CONTRACTOR SHALL SUBMIT A NOTICE OF INTENT (NOI) TO THE EPA PRIOR TO BEGINNING OF CONSTRUCTION.
- CONTRACTOR SHALL COMPLY WITH STORM WATER POLLUTION PREVENTION PLAN (SWPPP) SPECIFIC TO THIS PROJECT.

FACILITY ACCESSIBILITY  
ALL SURFACES ALONG THE ACCESSIBLE ROUTE SHALL COMPLY WITH ANSI A117-1998.

WALKING SURFACES SHALL BE STABLE, FIRM, AND SLIP RESISTANT. THE RUNNING SLOPE OF WALKING SURFACES SHALL NOT BE STEEPER THAN 1:20 WITH A CROSS SLOPE NOT STEEPER THAN 1:48.

CURB RAMP AND RAMP RUNS SHALL HAVE A RUNNING SLOPE NOT STEEPER THAN 1:12 WITH A CROSS SLOPE NOT STEEPER THAN 1:48. COUNTER SLOPES OF ADJOINING GUTTERS AND ROAD SURFACES IMMEDIATELY ADJACENT TO THE CURB RAMP OR ACCESSIBLE ROUTE SHALL NOT BE STEEPER THAN 1:20. TRANSITIONS FROM RAMPS TO WALKS, GUTTERS OR STREETS SHALL BE AT THE SAME LEVEL WHERE PEDESTRIANS MUST WALK ACROSS A CURB RAMP, THE RAMP SHALL HAVE FLARED SIDES WITH SLOPES NOT STEEPER THAN 1:10: WHERE THE TOP OF THE RAMP PARALLEL TO THE RUN OF THE RAMP IS LESS THAN 48 INCHES WIDE, THE FLARED SIDES SHALL HAVE A SLOPE NOT STEEPER THAN 1:12.


HANDICAP PARKING SPACES AND ACCESS AISLES SHALL HAVE SURFACE SLOPES NOT STEEPER THAN 1:48. ACCESS AISLES SHALL BE AT THE SAME LEVEL AS THE PARKING SPACES THEY SERVE.

TRAFFIC CONTROL  
THE CONTRACTOR SHALL PROVIDE ALL REQUIRED TRAFFIC CONTROL PLANS AND DEVICES. ALL SIGNS, BARRICADES, CHANNELIZATION DEVICES, SIGN FRAMES AND ERECTION OF SUCH DEVICES SHALL CONFORM THE THE REQUIREMENTS OF THE "MANUAL OF UNIFORM TRAFFIC CONTROL DEVICES FOR STREETS AND HIGHWAYS" LATEST EDITION. PRIOR TO CONSTRUCTION PRIOR TO CONSTRUCTION, THE TRAFFIC CONTROL PLAN SHALL BE SUBMITTED AND APPROVED BY THE GOVERNING AUTHORITY.


I, JOHN ARTHUR BLESSEN, NMPE 13481, OF THE FIRM J ARTHUR BLESSEN ENGINEERING, HEREBY CERTIFY THIS PROJECT HAS BEEN GRADED AND WILL DRAIN IN SUBSTANTIAL COMPLIANCE WITH AND IN ACCORDANCE WITH THE DESIGN INTENT OF THE APPROVED PLAN DATED 12/10/20. I FURTHER CERTIFY THAT I HAVE PERSONALLY VISITED THE SITE ON 2/18/22 AND HAVE DETERMINED BY VISUAL INSPECTION THAT THE SURVEY DATA PROVIDED IS REPRESENTATIVE OF ACTUAL SITE CONDITIONS AND IS CORRECT TO THE BEST OF MY KNOWLEDGE AND BELIEF. THIS CERTIFICATION IS SUBMITTED IN SUPPORT OF A REQUEST FOR PERMANENT CERTIFICATE OF OCCUPANCY.

THE RECORD INFORMATION PRESENTED HEREON IS NOT NECESSARILY COMPLETE AND INTENDED ONLY TO VERIFY SUBSTANTIAL COMPLIANCE OF THE GRADING AND DRAINAGE ASPECTS OF THIS PROJECT. THOSE RELYING ON THIS RECORD DOCUMENT ARE ADVISED TO OBTAIN INDEPENDENT VERIFICATION OR ITS ACCURACY BEFORE USING IT FOR ANY OTHER PURPOSE.


J Arthur Blessen, PE  
NM PE# 13481  
2-21-22  
date

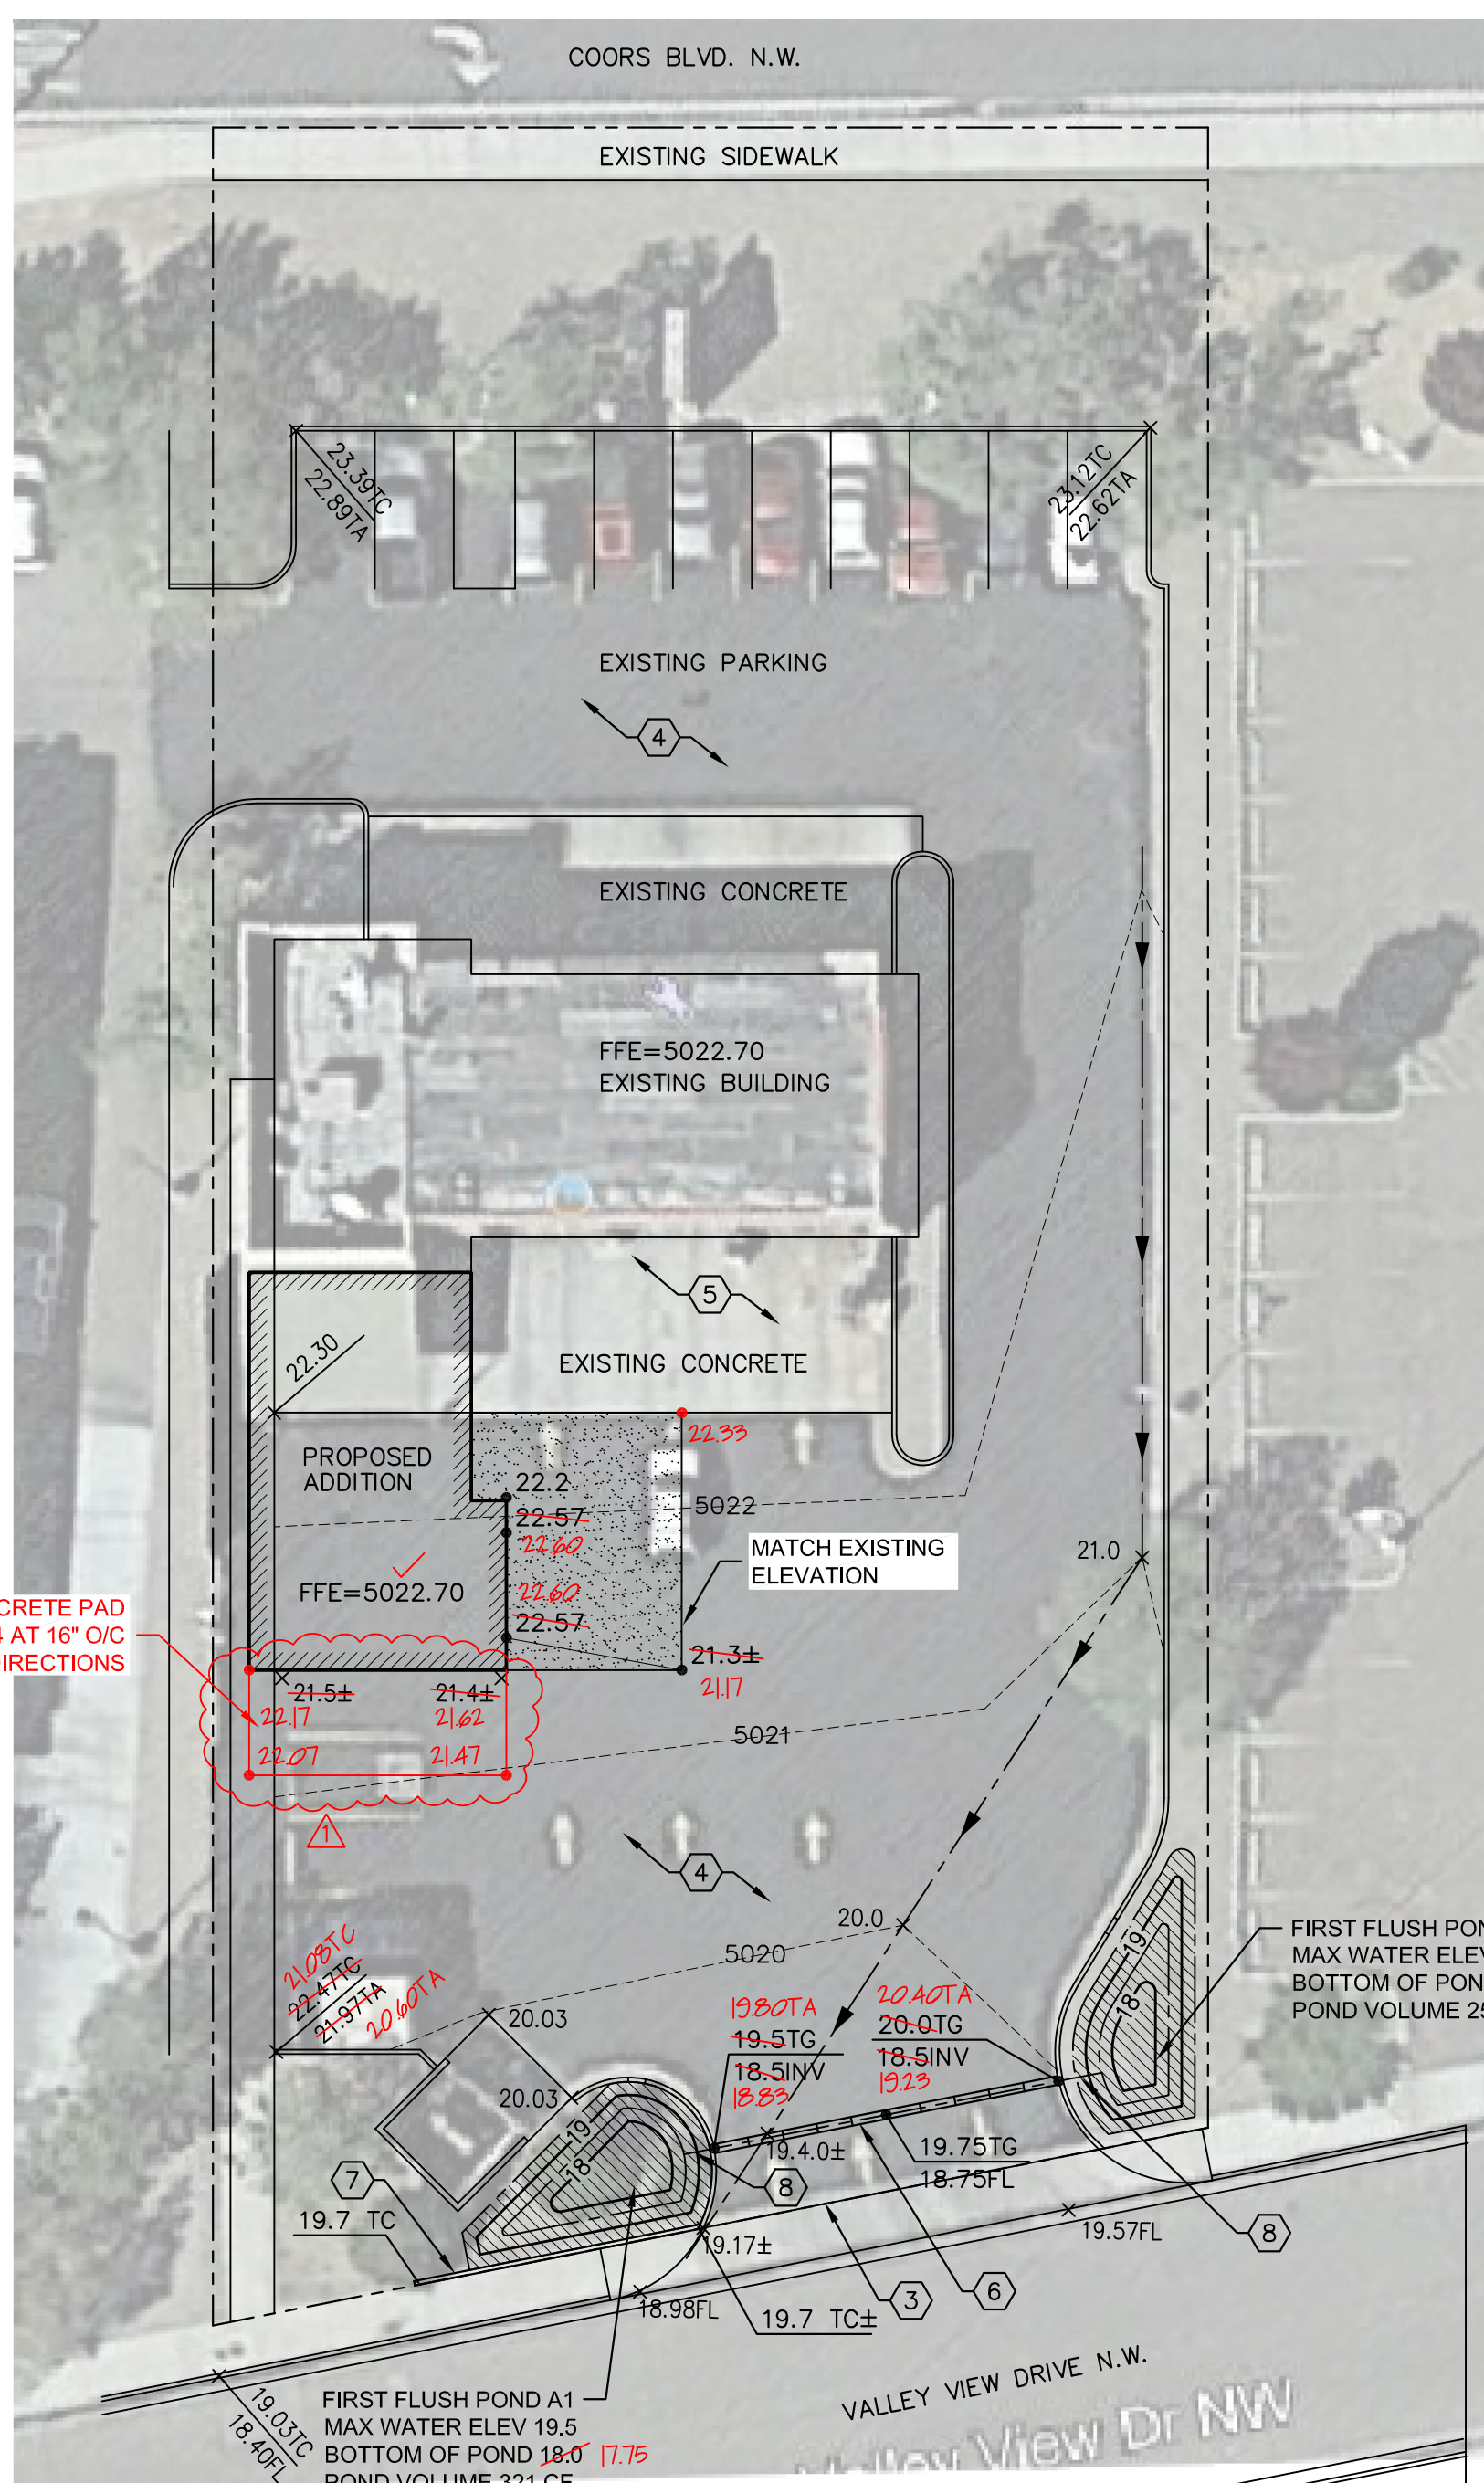

A3 SITE GRADING PLAN  
1"=20'-0"

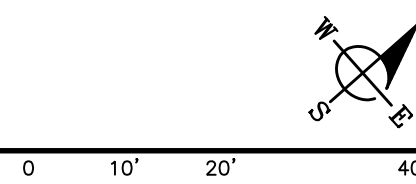

T A T E F I S H B U R N  
A R C H I T E C T  
ARCHITECT SEAL

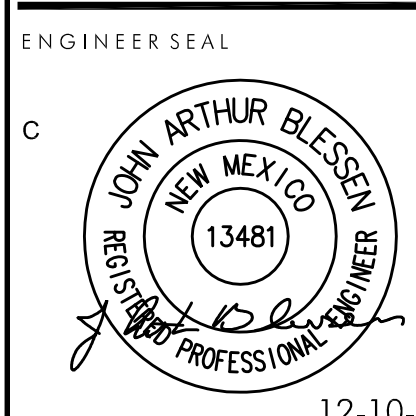

12-10-20

PROJECT

ADDITION FOR  
JIFFY LUBE  
9386 COORS BOULEVARD, NW  
ALBUQUERQUE, NEW MEXICO

REVISIONS  
12-17-21 ADD CONCRETE PAD

DATE  
DECEMBER 10, 2020

SCALE  
1"=20'-0"  
OR AS NOTED

DRAWING NAME  
SITE GRADING  
PLAN

SHEET NUMBER

C-101