
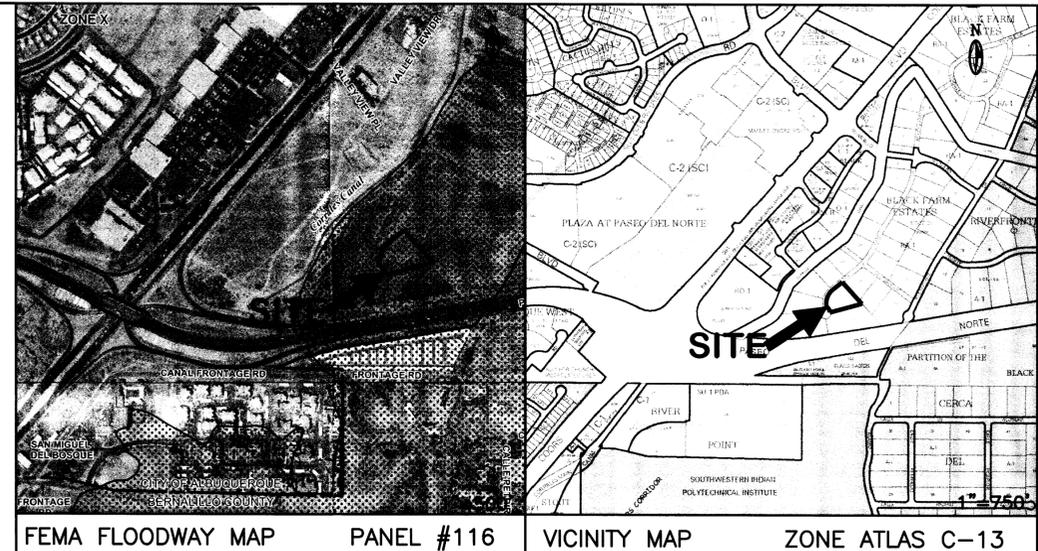
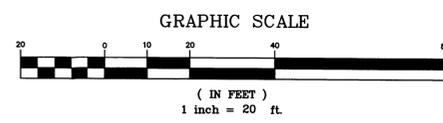


STANDARD GRADING NOTE: THE MAXIMUM GRADED SIDE SLOPE SHALL NOT EXCEED 3 FEET (HORIZONTALLY) TO 1 FOOT (VERTICALLY). AREAS DISTURBED BY GRADING WHICH WILL NOT BE TREATED WITH LANDSCAPING SHALL BE SEEDED.

ACS BM FROM PLAT:  
11-C13  
Z=5029.17  
NAVD88=5031.88

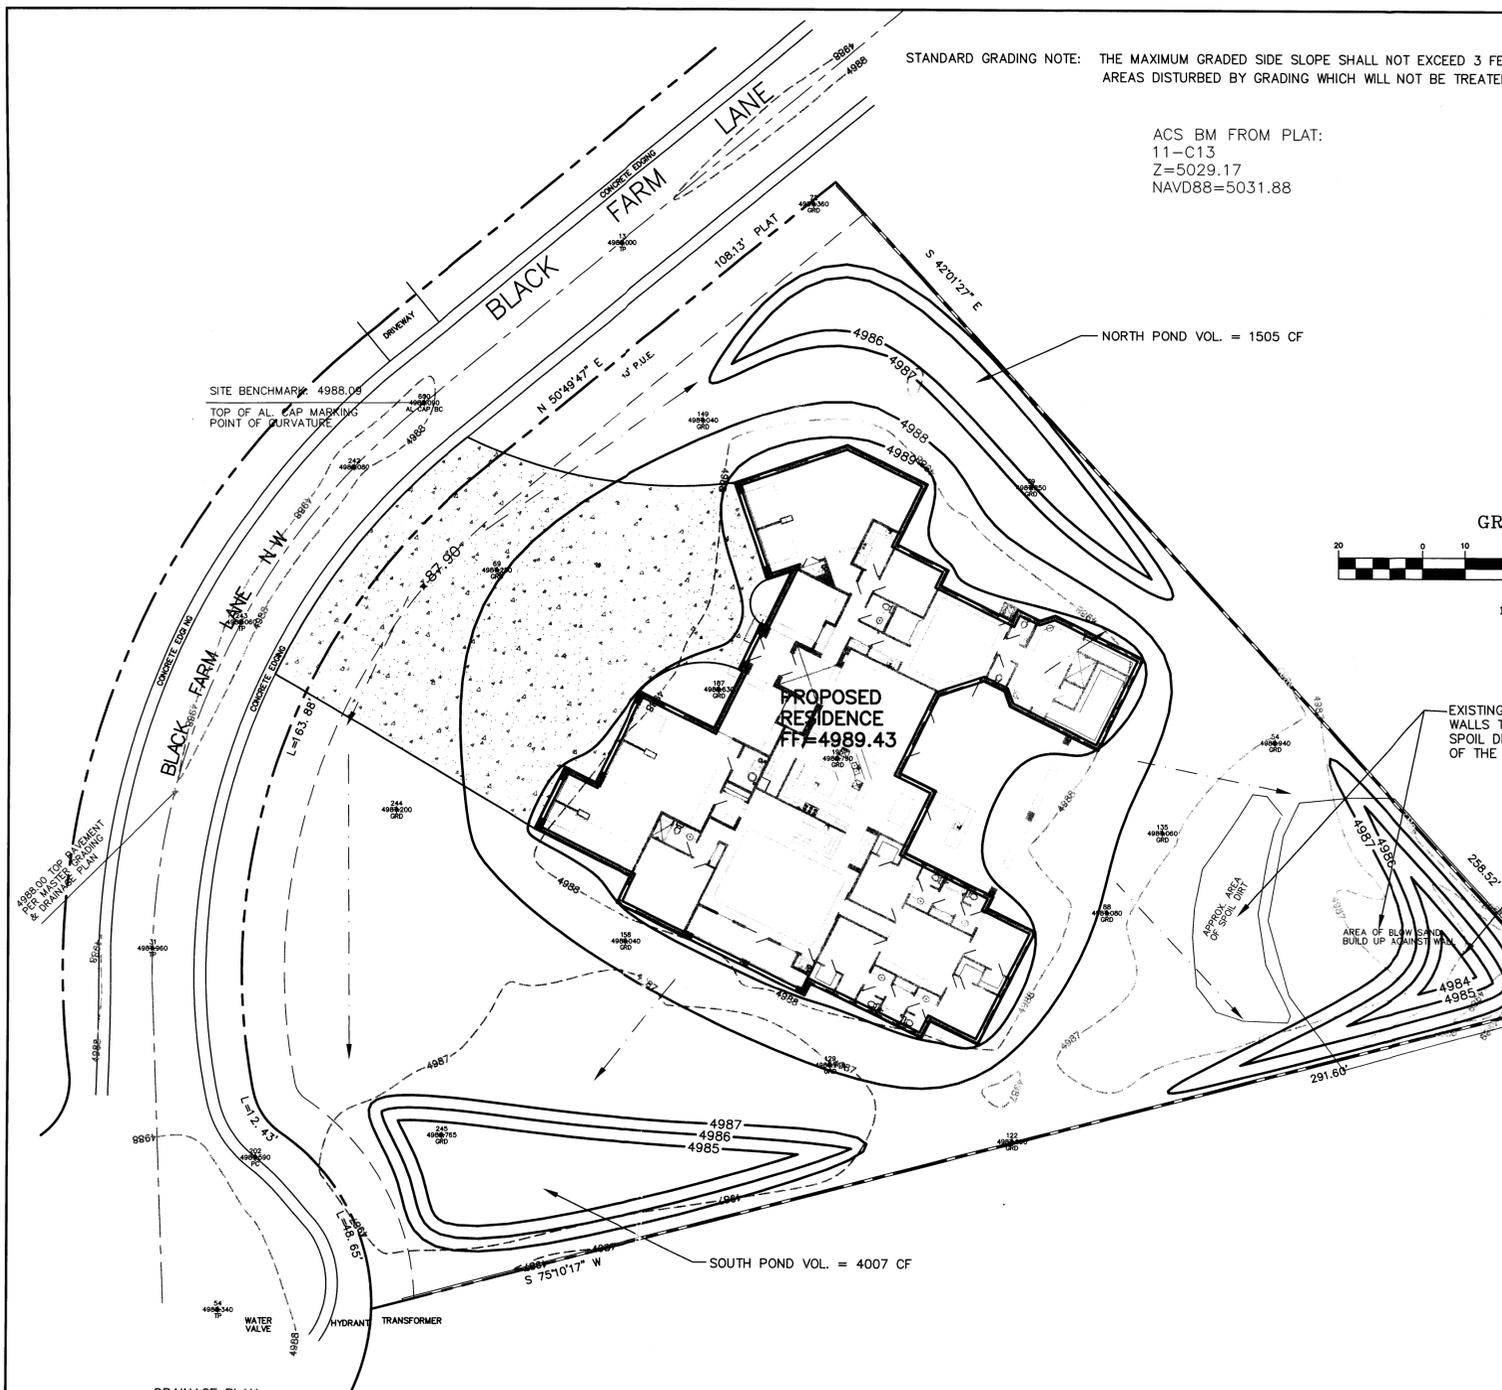

LEGEND

	EXISTING	PROPOSED
CONTOUR	6045	6045
PROPERTY LINE	---	---
ROAD	---	---
SETBACK	---	---
WALL	---	---
SPOT ELEVATION	4985.00	4985.00

LOT 32  
WITHIN  
UNIT 2  
BLACK FARM ESTATES  
ALBUQUERQUE, BERNALILLO COUNTY, NEW MEXICO  
9204 Black Farm Lane NW

Jackie S. McDowell  
Professional Engineer  
6-25-13

RECEIVED  
JUN 27 2013

DRAINAGE PLAN

SCOPE:

Pursuant to the latest Bernalillo County Ordinance, the Drainage Plan shown hereon outlines the drainage management criteria for controlling developed runoff on and exiting the project site. One single family home is proposed for the subject property, with associated access, landscaping, and utility improvements.

EXISTING CONDITIONS:

Presently, the 1.07 acre site is undeveloped. The site is bounded on the northeast and southeast by private property and on the northwest by Black Farm Lane NW. The site is not vegetated and is level. As shown on FEMA Panel #116 the site is not located in a 100 year flood plain. This plan follows the approved Drainage Report for Black Farms prepared by Tierra West, LLC, dated June 2004. The approved drainage study calls for all storm drainage from each lot to be retained on-site. The pond volume required is the 100-year, 10-day storm.

PROPOSED CONDITIONS:

As shown by the plan, the building is located within the center of the lot. There are no off-site flows entering the site with the exception of the roadway that fronts the property and will continue to drain into the site per the approved report. On site flows will drain around the structure via sheet flow and swales, and flow to one of the 3 proposed retention ponds. All roof drainage will discharge from the roof to the lot and be directed around the structure to drainage paths. Access will be taken from Black Farm Lane NW. This road is currently improved.

Supplemental calculations are shown as part of this Grading and Drainage plan.

CALCULATIONS:

The calculations shown hereon define the 100 year-6 hour design storm falling within the project area under existing and developed conditions. The Hydrology is per "Section 22.2, Hydrology of the Development Process Manual, Volume 2, Design Criteria, for the City of Albuquerque, New Mexico in cooperation with Bernalillo County, New Mexico and the Albuquerque Metropolitan Arroyo Flood Control Authority.

PROPERTY ADDRESS:

9204 Black Farm Lane NW

TOPOGRAPHY:

Topographic information provided by Mike Shook dated June 24, 2013.

25-Jun-13 DEBASSIGE LOT #32

Calculations: Total Basin  
Calculations are based on "Section 22.2 Hydrology of the Development Process Manual, Volume 2, Design Criteria for the City of Albuquerque, New Mexico, latest edition - basins < 40 acres".

Precipitation Zone = 1  
Depth at 100-year, 6-hour storm: (Table A-2)

Land Treatments:  
From Table 5 - Percent Treatment D

Area: (acres)	Existing	Proposed
Treatment A	1.07	0.00
Treatment B	0.00	0.75
Treatment C	0.00	0.00
Treatment D	0.00	0.32
Total (acres) =	1.07	1.07

Volume	100 year Existing	100 year Proposed	10 year Existing	10 year Proposed	2 year Existing	2 year Proposed
Volume (acre-feet) =	0.039	0.094	0.007	0.047	0.000	0.020
Volume (cubic feet) =	1,709	4,112	311	2,039	0	864

Total Q(p), cfs:	100 year Existing Q(p)*A	100 year Proposed Q(p)*A	10 year Existing Q(p)*A	10 year Proposed Q(p)*A	2 year Existing Q(p)*A	2 year Proposed Q(p)*A
Treatment A	1.38	0.00	0.26	0.00	0.00	0.00
Treatment B	0.00	1.52	0.00	0.57	0.00	0.02
Treatment C	0.00	0.00	0.00	0.00	0.00	0.00
Treatment D	0.00	1.40	0.00	0.92	0.00	0.54
Total Q (cfs) =	1.38	2.92	0.26	1.49	0.00	0.56

V (10 day) = V (360) + A (D) \* (P10day-P360)/12 in/ft = 0.1336 ac-ft = 5820 cu-ft = Regge Pond Volume

POND VOL. REQUIRED:

POND	Elev.	Area	Vol.
NORTH POND	4987	1922	1505cf
SOUTH POND	4986	1981	1142
EAST POND	4985	1302	4007
TOTAL			1390cf

BERNALILLO COUNTY NEW MEXICO

LOT 32, UNIT 2,  
BLACK FARM ESTATES



DEBASSIGE CUSTOM HOME - GRADING & DRAINAGE PLAN

**McDowell Engineering, Inc.**  
7820 BEVERLY HILLS AVE. NE • ALBUQUERQUE, NM 87122  
TELE: 505-828-2430 • FAX: 505-821-4857

Designed JSM Drawn STAFF Checked JSM Sheet of 1 1  
File DEB0113L Date JUNE,2013

STANDARD GRADING NOTE: THE MAXIMUM GRADED SIDE SLOPE SHALL NOT EXCEED 3 FEET (HORIZONTALLY) TO 1 FOOT (VERTICALLY). AREAS DISTURBED BY GRADING WHICH WILL NOT BE TREATED WITH LANDSCAPING SHALL BE SEEDED.

ACS BM FROM PLAT:  
11-C13  
Z=5029.17  
NAVD88=5031.88

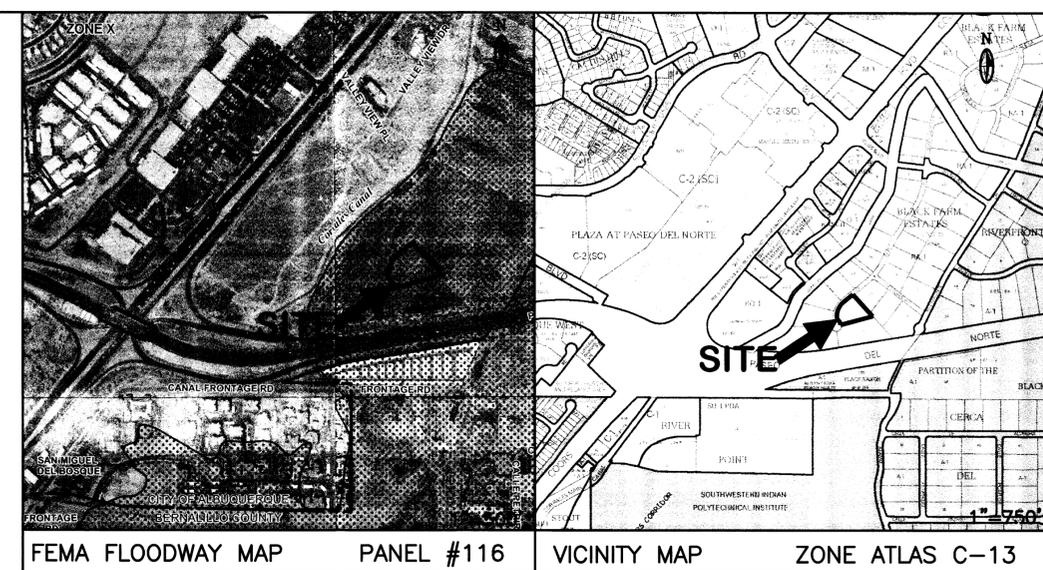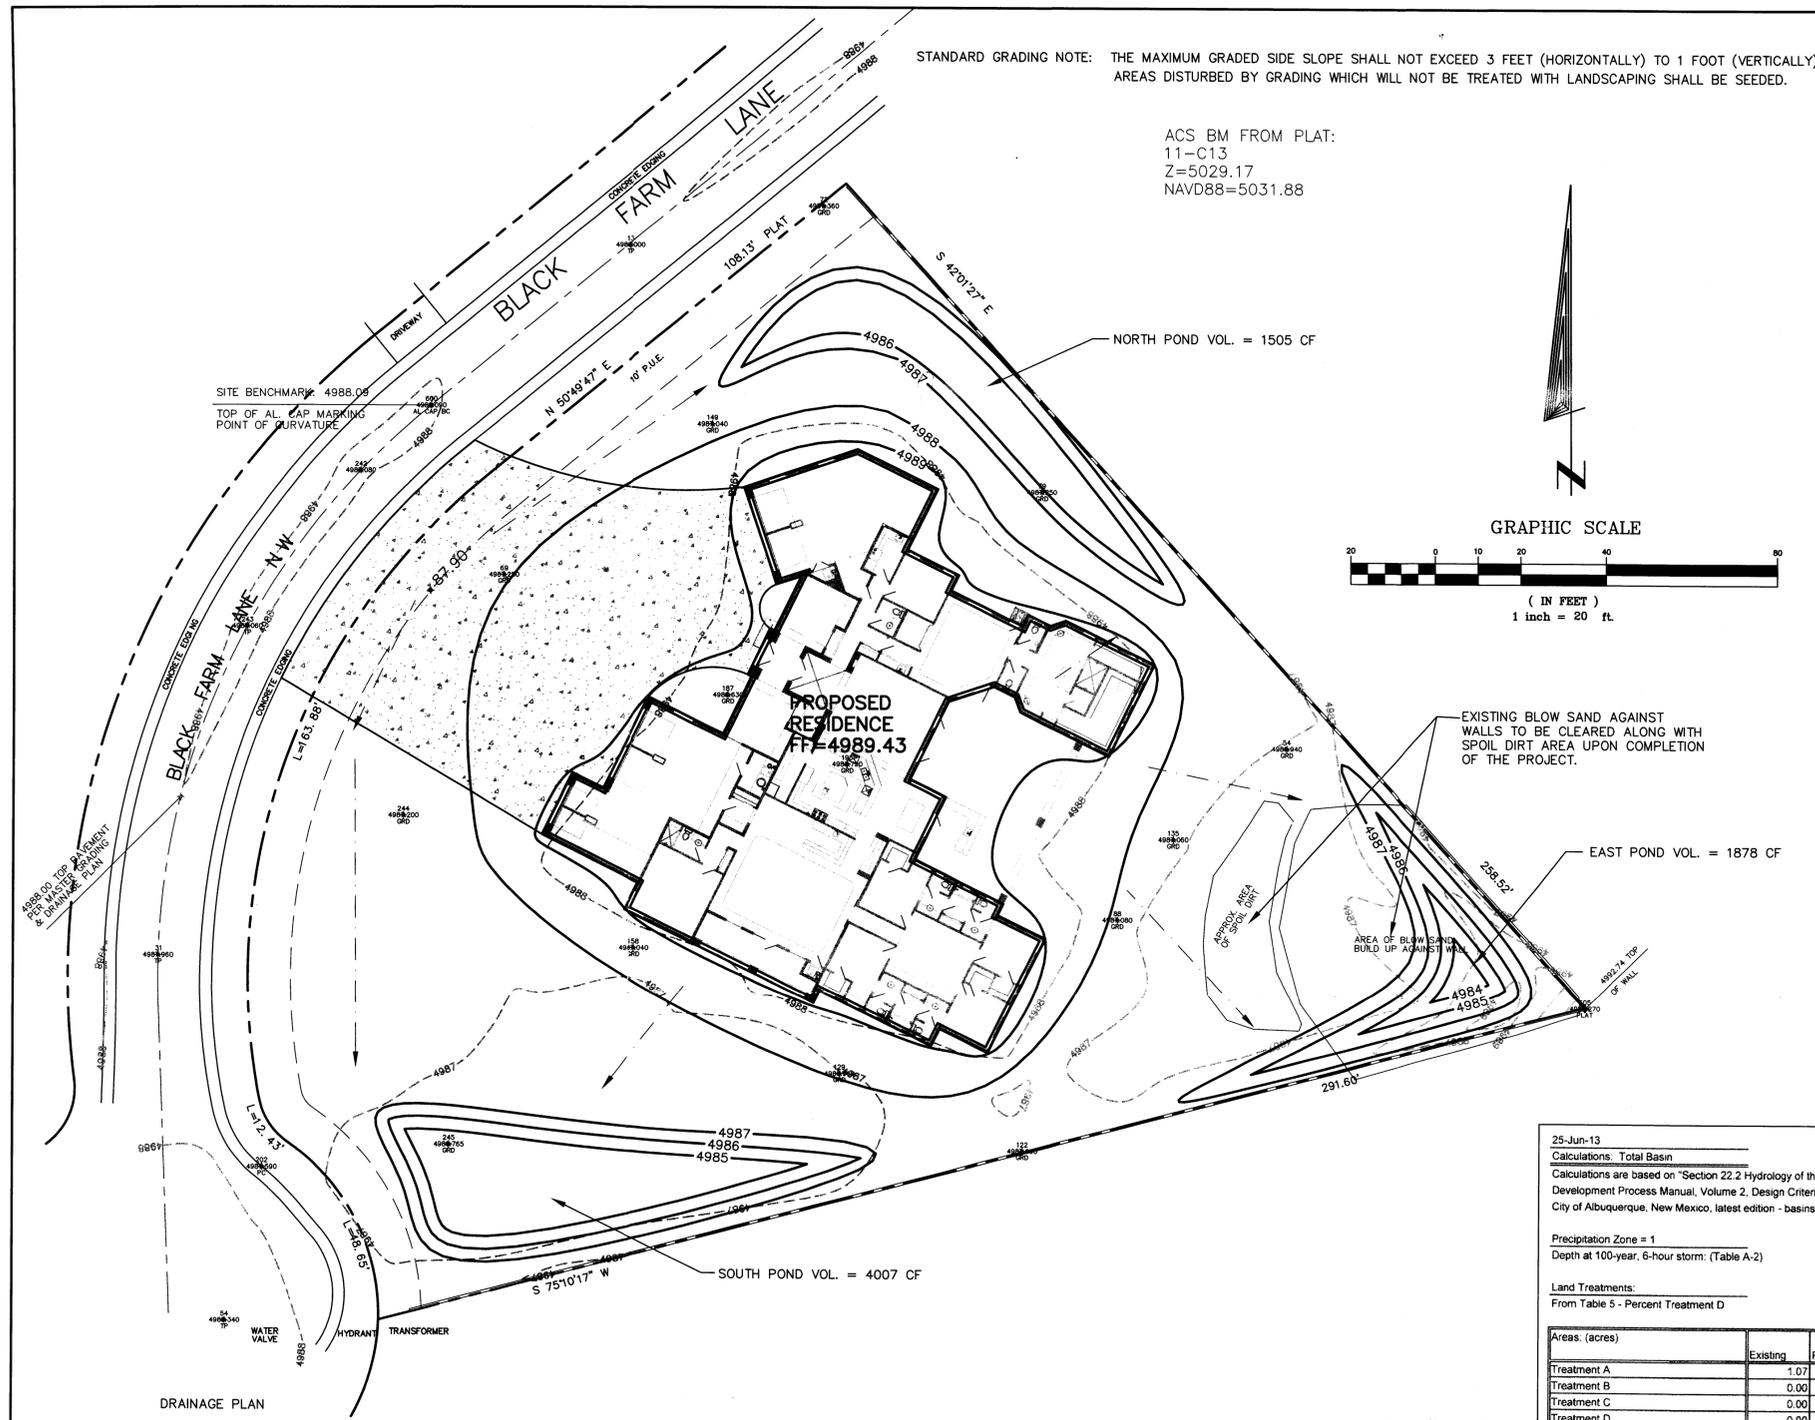

LEGEND

	EXISTING	PROPOSED
CONTOUR	6045	6045
PROPERTY LINE	---	---
ROAD	---	---
SETBACK	---	---
WALL	---	---
SPOT ELEVATION	244 498200	XXX

LOT 32  
WITHIN  
UNIT 2  
BLACK FARM ESTATES  
ALBUQUERQUE, BERNALILLO COUNTY, NEW MEXICO  
9204 Black Farm Lane NW

Jackie S. McDowell  
Professional Engineer  
6-25-13

RECEIVED JUN 27 2013

ENGINEER'S CERTIFICATION:  
I, Jackie S. McDowell, hereby certify that I personally inspected the site shown on this plan on June 17, 2013 and as of that date it appeared that no filling, grading, or excavation had occurred thereon since completion of the topographic survey used to prepare this plan.

BERNALILLO COUNTY NEW MEXICO

LOT 32, UNIT 2,  
BLACK FARM ESTATES

DEBASSIGE CUSTOM HOME - GRADING & DRAINAGE PLAN

**McDowell Engineering, Inc.**  
7820 BEVERLY HILLS AVE. NE • ALBUQUERQUE, NM 87122  
TELE: 505-828-2430 • FAX: 505-821-4857

Designed JSM Drawn STAFF Checked JSM Sheet of  
File DEB0113L Date JUNE, 2013 1 1

25-Jun-13 DEBASSIGE LOT #32

Calculations: Total Basin  
Calculations are based on "Section 22.2 Hydrology of the Development Process Manual, Volume 2, Design Criteria for the City of Albuquerque, New Mexico, latest edition - basins < 40 acres".  
P(360) = 2.20 inches  
P(10 day) = 3.67 inches

Precipitation Zone = 1  
Depth at 100-year, 6-hour storm: (Table A-2)

Land Treatments:  
From Table 5 - Percent Treatment D

Areas (acres)	Existing	Proposed
Treatment A	1.07	0.00
Treatment B	0.00	0.75
Treatment C	0.00	0.00
Treatment D	0.00	0.32
Total (acres) =	1.07	1.07

Volume	100 year Existing	100 year Proposed	10 year Existing	10 year Proposed	2 year Existing	2 year Proposed
Volume (acre-feet) =	0.039	0.094	0.007	0.047	0.000	0.020
Volume (cubic feet) =	1,709	4,112	311	2,039	0	864

Total Q(p), cfs:	100 year Existing Q(p)*A	100 year Proposed Q(p)*A	10 year Existing Q(p)*A	10 year Proposed Q(p)*A	2 year Existing Q(p)*A	2 year Proposed Q(p)*A
Treatment A	1.38	0.00	0.26	0.00	0.00	0.00
Treatment B	0.00	1.52	0.00	0.57	0.00	0.02
Treatment C	0.00	0.00	0.00	0.00	0.00	0.00
Treatment D	0.00	1.40	0.00	0.92	0.00	0.54
Total Q (cfs) =	1.38	2.92	0.26	1.49	0.00	0.56

V (10 day) = V (360) + A (D) \* (P10day-P360)/12 in/ft = 0.1336 ac-ft = 5820 cu-ft = Retain Pond Volume

POND VOL. REQUIRED:

POND	Elev.	Area	Vol.
NORTH POND	4987	1922	1505 CF
	4986	1088	
	4986	1088	
SOUTH POND	4987	2749	2365
	4986	1981	1642
	4985	1302	
EAST POND	4987	1517	1149
	4986	781	541
	4984	79	184
TOTAL			3990 CF

Tot = 1505  
Tot = 4007  
Tot = 1878

DRAINAGE PLAN

SCOPE:

Pursuant to the latest Bernalillo County Ordinance, the Drainage Plan shown hereon outlines the drainage management criteria for controlling developed runoff on and exiting the project site. One single family home is proposed for the subject property, with associated access, landscaping, and utility improvements.

EXISTING CONDITIONS:

Presently, the 1.07 acre site is undeveloped. The site is bounded on the northeast and southeast by private property and on the northwest by Black Farm Lane NW. The site is not vegetated and is level. As shown on FEMA Panel #116 the site is not located in a 100 year flood plain. This plan follows the approved Drainage Report for Black Farms prepared by Tierra West, LLC, dated June 2004. The approved drainage study calls for all storm drainage from each lot to be retained on-site. The pond volume required is the 100-year, 10-day storm.

PROPOSED CONDITIONS:

As shown by the plan, the building is located within the center of the lot. There are no off-site flows entering the site with the exception of the roadway that fronts the property and will continue to drain into the site per the approved report. On site flows will drain around the structure via sheet flow and swales, and flow to one of the 3 proposed retention ponds. All roof drainage will discharge from the roof to the lot and be directed around the structure to drainage paths. Access will be taken from Black Farm Lane NW. This road is currently improved.




Supplemental calculations are shown as part of this Grading and Drainage plan.

CALCULATIONS:

The calculations shown hereon define the 100 year-6 hour design storm falling within the project area under existing and developed conditions. The Hydrology is per "Section 22.2, Hydrology of the Development Process Manual, Volume 2, Design Criteria, for the City of Albuquerque, New Mexico in cooperation with Bernalillo County, New Mexico and the Albuquerque Metropolitan Arroyo Flood Control Authority.

PROPERTY ADDRESS:  
9204 Black Farm Lane NW

TOPOGRAPHY:  
Topographic information provided by Mike Shook dated June 24, 2013.

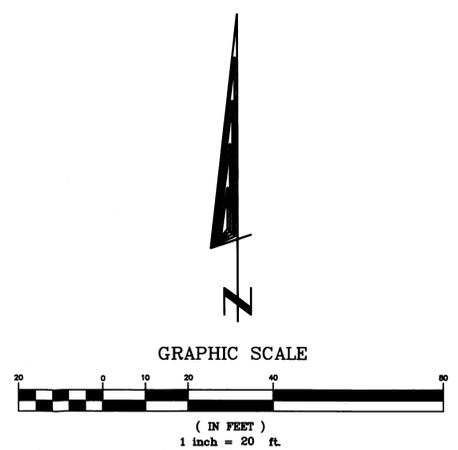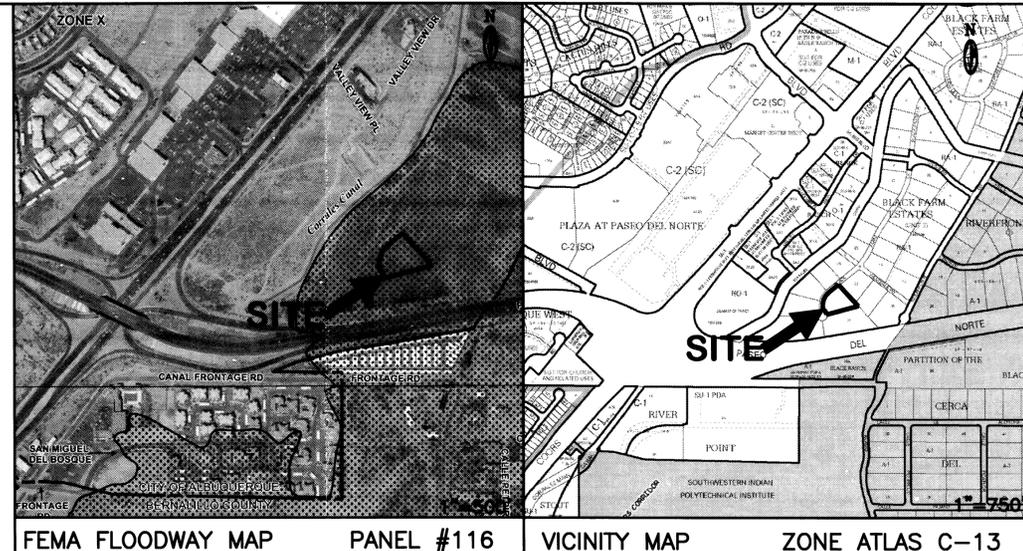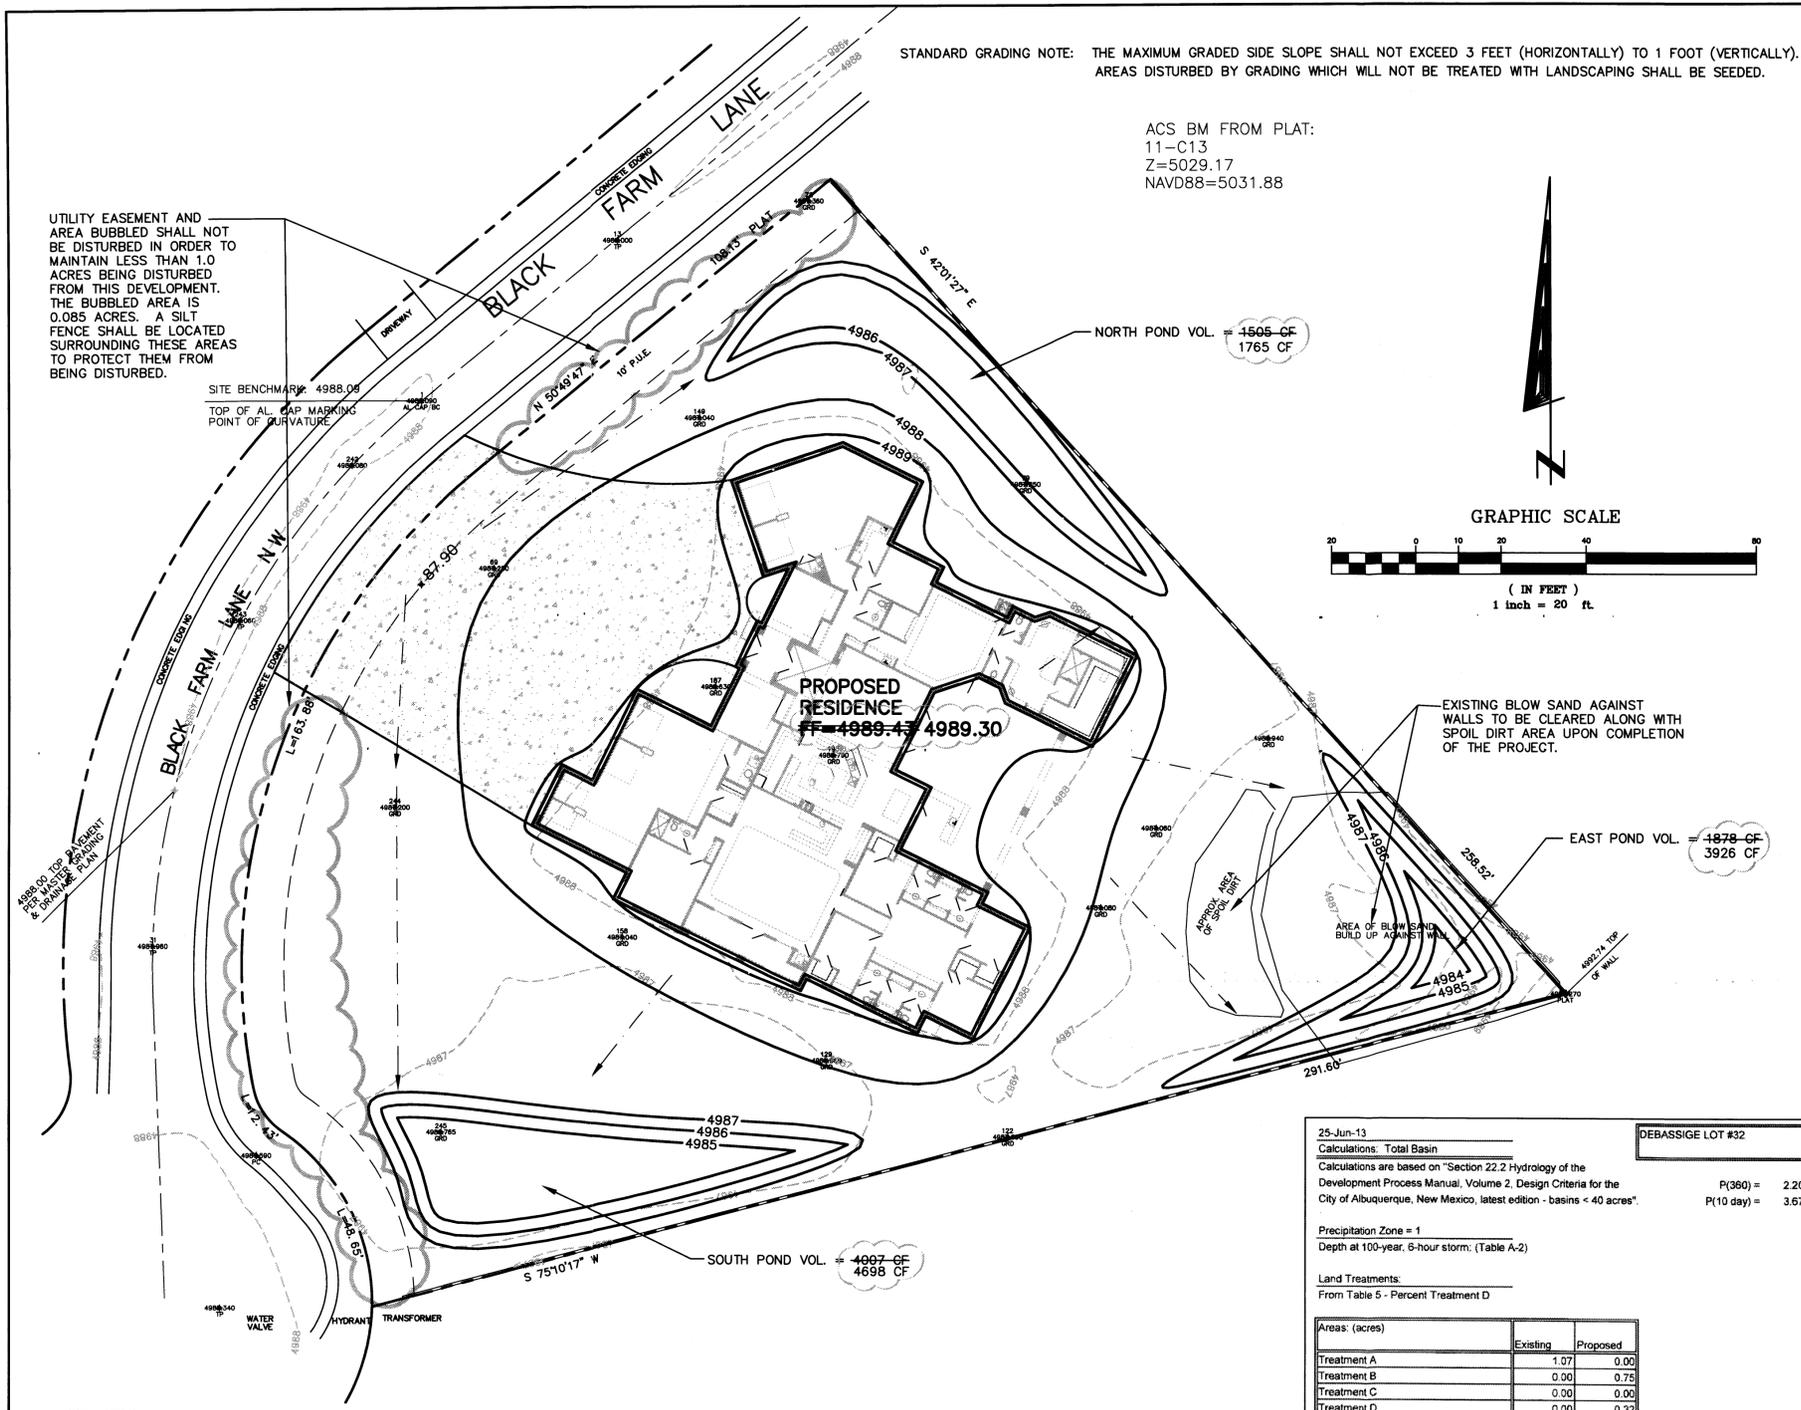

AS BUILT POND VOLUME CALCS:

	ELEV.	AREA	VOL.
NORTH POND	4986.50	99.00	1765.00
	4987.50	3431.00	
	<b>TOTAL</b>		<b>1765.00</b>
EAST POND	4985.50	83.00	550.00
	4986.50	1017.00	3375.50
	4987.50	5734.00	3925.50
<b>TOTAL</b>			<b>3925.50</b>
SOUTH POND	4986.00	77.00	1658.00
	4987.00	3239.00	3039.50
	4987.50	8919.00	3039.50
<b>TOTAL</b>			<b>4697.00</b>
<b>TOTAL VOLUME</b>			<b>10388.00</b>

LEGEND

	EXISTING	PROPOSED
CONTOUR	6045	6045
PROPERTY LINE	---	---
ROAD	---	---
SETBACK	---	---
WALL	---	---
SPOT ELEVATION	+	+
AS BUILT		EAST POND VOL. = 1878 CF 3926 CF

LOT 32  
WITHIN  
UNIT 2  
BLACK FARM ESTATES  
ALBUQUERQUE, BERNALILLO COUNTY, NEW MEXICO  
9204 Black Farm Lane NW

6-25-13  
3-13-14 AS BUILT

DRAINAGE CERTIFICATION  
I, Jackie S. McDowell, NMPE 10903, of McDowell Engineering, Inc., hereby certify that this project has been graded and will drain in substantial compliance with and in accordance with the design intent of the approved plan dated June 25, 2013. The record information edited onto the original/approved design document has been obtained by Mike Shook, NMPS #13240, of the firm Advantage Surveying. I further certify, that I have personally visited the project site on February 27, 2014 and have determined by visual inspection that the survey data provided is representative of actual site conditions and is true and correct to the best of my knowledge and belief. This certification is submitted in support of a request for a Certificate of Occupancy.

The record information presented hereon is not necessarily complete and intended only to verify substantial compliance of the Grading and Drainage aspects of this project. Those relying on this record document are advised to obtain independent verification of its accuracy before using it for any other purpose.

Jackie S. McDowell, NMPE #10903

3-20-14  
Date

ENGINEER'S CERTIFICATION:  
I, Jackie S. McDowell, hereby certify that I personally inspected the site shown on this plan on June 17, 2013 and as of that date it appeared that no filling, grading, or excavation had occurred thereon since completion of the topographic survey used to prepare this plan.

25-Jun-13 DEBASSIGE LOT #32

Calculations: Total Basin

Calculations are based on "Section 22.2 Hydrology of the Development Process Manual, Volume 2, Design Criteria for the City of Albuquerque, New Mexico, latest edition - basins < 40 acres".

P(360) = 2.20 inches  
P(10 day) = 3.67 inches

Precipitation Zone = 1  
Depth at 100-year, 6-hour storm: (Table A-2)

Land Treatments:  
From Table 5 - Percent Treatment D

Areas: (acres)	Existing	Proposed
Treatment A	1.07	0.00
Treatment B	0.00	0.75
Treatment C	0.00	0.00
Treatment D	0.00	0.32
<b>Total (acres) =</b>	<b>1.07</b>	<b>1.07</b>

Volume	100 year		10 year		2 year	
	Existing	Proposed	Existing	Proposed	Existing	Proposed
Volume (acre-feet) =	0.039	0.094	0.007	0.047	0.000	0.020
Volume (cubic feet) =	1,708	4,112	311	2,039	0	864

Total Q(p), cfs:	100 year		10 year		2 year	
	Existing Q(p)*A	Proposed Q(p)*A	Existing Q(p)*A	Proposed Q(p)*A	Existing Q(p)*A	Proposed Q(p)*A
Treatment A	1.38	0.00	0.28	0.00	0.00	0.00
Treatment B	0.00	1.52	0.00	0.57	0.00	0.02
Treatment C	0.00	0.00	0.00	0.00	0.00	0.00
Treatment D	0.00	1.40	0.00	0.92	0.00	0.54
<b>Total Q (cfs) =</b>	<b>1.38</b>	<b>2.92</b>	<b>0.28</b>	<b>1.49</b>	<b>0.00</b>	<b>0.56</b>

V(10 day) = V(360) + A(D) \* (P10day-P360)/12 in/ft = 0.1336 ac-ft = 5820 cu-ft = Regia Pond Volume.

POND VOL. RECORDED:

NORTH POND	SOUTH POND	EAST POND	TOTAL
Elev. Area Vol	Elev. Area Vol	Elev. Area Vol	
4987 1922 1505 CF	4987 2749 2305	4987 1517 1149	7390 CF
4986 1088 1505 CF	4986 1981 1642	4986 781 541	
	4985 1302	4985 301 184	
		4984 75 1878	
Tot = 1505	Tot = 4007	Tot = 1878	

DRAINAGE PLAN

SCOPE:

Pursuant to the latest Bernalillo County Ordinance, the Drainage Plan shown hereon outlines the drainage management criteria for controlling developed runoff on and exiting the project site. One single family home is proposed for the subject property, with associated access, landscaping, and utility improvements.

EXISTING CONDITIONS:

Presently, the 1.07 acre site is undeveloped. The site is bounded on the northeast and southeast by private property and on the northwest by Black Farm Lane NW. The site is not vegetated and is level. As shown on FEMA Panel #116 the site is not located in a 100 year flood plain. This plan follows the approved Drainage Report for Black Farms prepared by Tierra West, LLC, dated June 2004. The approved drainage study calls for all storm drainage from each lot to be retained on-site. The pond volume required is the 100-year, 10-day storm.

PROPOSED CONDITIONS:

As shown by the plan, the building is located within the center of the lot. There are no off-site flows entering the site with the exception of the roadway that fronts the property and will continue to drain into the site per the approved report. On site flows will drain around the structure via sheet flow and swales, and flow to one of the 3 proposed retention ponds. All roof drainage will discharge from the roof to the lot and be directed around the structure to drainage paths. Access will be taken from Black Farm Lane NW. This road is currently improved.

Supplemental calculations are shown as part of this Grading and Drainage plan.

CALCULATIONS:

The calculations shown hereon define the 100 year-6 hour design storm falling within the project area under existing and developed conditions. The Hydrology is per "Section 22.2, Hydrology of the Development Process Manual, Volume 2, Design Criteria, for the City of Albuquerque, New Mexico in cooperation with Bernalillo County, New Mexico and the Albuquerque Metropolitan Arroyo Flood Control Authority.

PROPERTY ADDRESS:  
9204 Black Farm Lane NW

TOPOGRAPHY:  
Topographic information provided by Mike Shook dated June 24, 2013.

BERNALILLO COUNTY NEW MEXICO

LOT 32, UNIT 2,  
BLACK FARM ESTATES

DEBASSIGE CUSTOM HOME - AS BUILT GRADING & DRAINAGE PLAN

**McDowell Engineering, Inc.**  
7820 BEVERLY HILLS AVE. NE • ALBUQUERQUE, NM 87122  
TELE: 505-828-2430 • FAX: 505-821-4857

Designed JSM Drawn STAFF Checked JSM Sheet of  
File DEB0113L Date JUNE, 2013 1 1