


SECTION A-A  
NTS  
(TYPICAL)

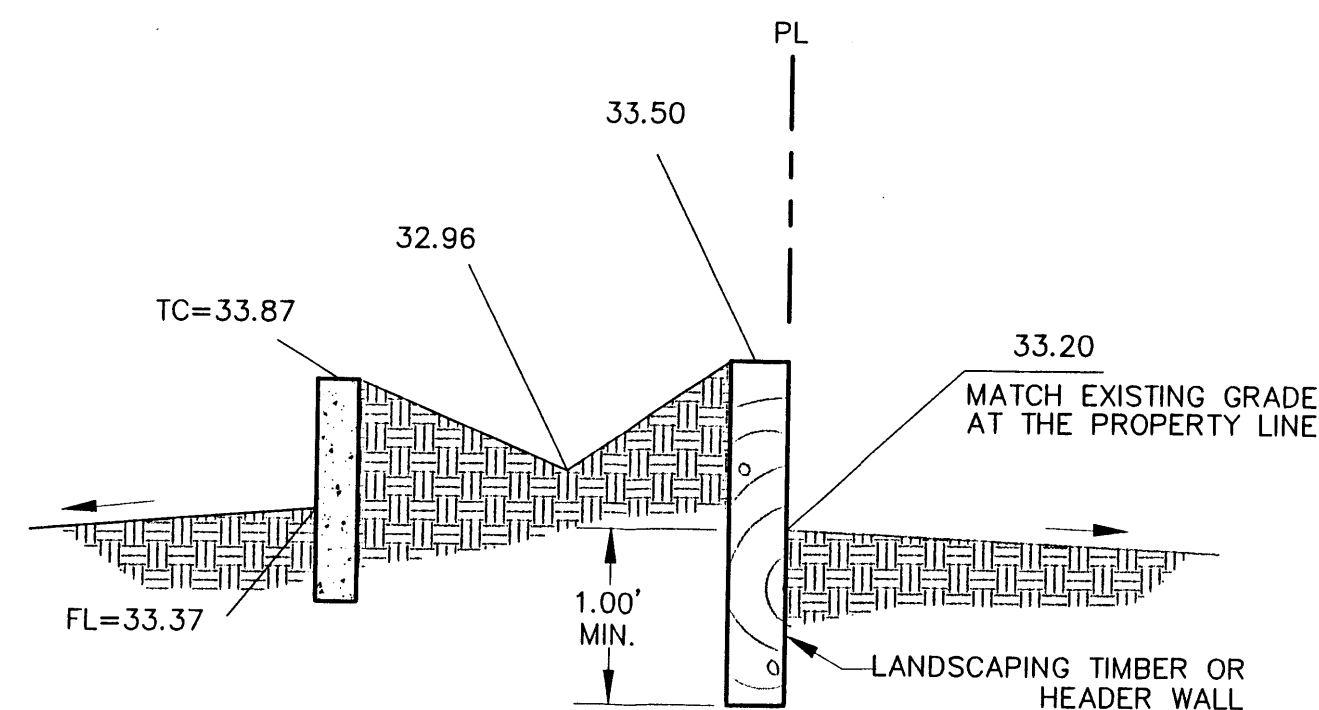

SECTION B-B  
NTS  
(TYPICAL)

#### NOTICE TO CONTRACTORS

1. AN EXCAVATION/CONSTRUCTION PERMIT WILL BE REQUIRED BEFORE BEGINNING ANY WORK WITHIN CITY RIGHT-OF-WAY.
2. ALL WORK DETAILED ON THESE PLANS TO BE PERFORMED, EXCEPT AS OTHERWISE STATED OR PROVIDED HEREON, SHALL BE CONSTRUCTED IN ACCORDANCE WITH CITY OF ALBUQUERQUE INTERIM STANDARD SPECIFICATIONS FOR PUBLIC WORKS CONSTRUCTION, 1985.
3. TWO WORKING DAYS PRIOR TO ANY EXCAVATION, CONTRACTOR MUST CONTACT LINE LOCATING SERVICE, 765-1234, FOR LOCATION OF EXISTING UTILITIES.
4. PRIOR TO CONSTRUCTION, THE CONTRACTOR SHALL EXCAVATE AND VERIFY THE HORIZONTAL AND VERTICAL LOCATIONS OF ALL CONSTRUCTIONS. SHOULD A CONFLICT EXIST, THE CONTRACTOR SHALL NOTIFY THE ENGINEER SO THAT THE CONFLICT CAN BE RESOLVED WITH A MINIMUM AMOUNT OF DELAY.
5. BACKFILL COMPACTION SHALL BE ACCORDING TO TRAFFIC/STREET USE.
6. MAINTENANCE OF THESE FACILITIES SHALL BE THE RESPONSIBILITY OF THE OWNER OF THE PROPERTY SERVED.
7. WORK ON ARTERIAL STREETS SHALL BE PERFORMED ON A 24-HOUR BASIS.

APPROVALS	NAME	DATE
INSPECTOR	COA SD <i>[Signature]</i>	9/4/01

I certify that the grades shown on the plans have been built in substantial compliance with approved grading and drainage plan dated 9/7/01. Survey information was supplied by Advanced Eng. & Consulting, LLC in accordance with normal surveying practices.

Shahab Biazar #13479


#### GENERAL NOTES:

1. ADD 5000 TO SPOT ELEVATIONS TO SHOW TRUE ELEVATION.
2. CONTOUR INTERVAL IS ONE (1) FOOT.
3. ELEVATIONS ARE BASED ON THE AMAFCA BRASS TABLET "NDC-7" HAVING AN ELEVATION OF 5062.60 FEET ABOVE SEA LEVEL.
4. UTILITIES SHOWN HEREON ARE IN THEIR APPROXIMATE LOCATION BASED ONLY ON ABOVE GROUND EVIDENCE FOUND IN THE FIELD AND AS-BUILT INFORMATION PROVIDED BY THE CLIENT. UTILITIES SHOWN HEREON, WHETHER INDICATED AS ABANDONED OR NOT, SHALL BE VERIFIED BY OTHERS FOR EXACT LOCATION AND/ OR DEPTH PRIOR TO EXCAVATION OR DESIGN CONSIDERATIONS.
5. THIS IS NOT A BOUNDARY SURVEY. BEARINGS ARE ASSUMED, DISTANCES AND FOUND PROPERTY CORNERS ARE FOR INFORMATIONAL PURPOSES ONLY.
6. SLOPES ARE AT 3:1 MAXIMUM.


ROUGH GRADING APPROVAL

DATE

GRAPHIC SCALE

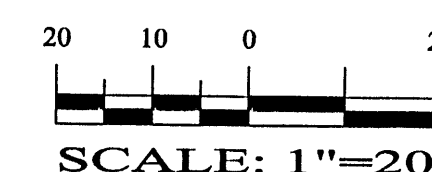

LAST REVISION: 01-10-01

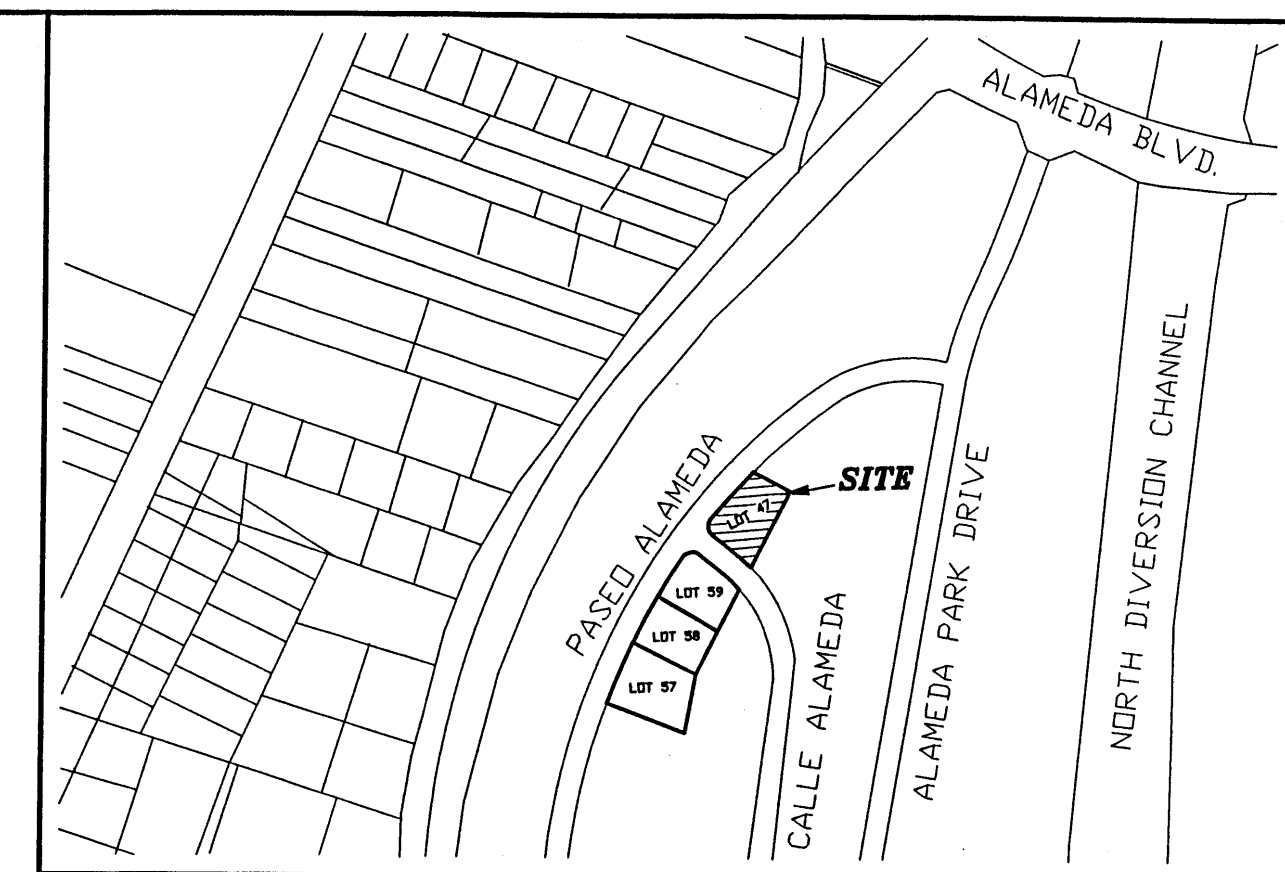

VICINITY MAP:

C-16-Z

#### LEGAL DESCRIPTION:



LOT 47, ALAMEDA BUSINESS PARK

#### LEGEND


- EXISTING SAS MANHOLE
- EXISTING METER
- EXISTING VALVE W/BOX
- EXISTING FIRE HYDRANT
- EXISTING AIR RELEASE VALVE
- EXISTING REDUCER
- EX. 8" SAS
- EX. 16" WL
- EXISTING SANITARY SEWER LINE
- EXISTING WATER LINE
- EXISTING CURB & GUTTER
- EXISTING CURB & GUTTER
- EXISTING CONTOUR (MAJOR)
- EXISTING CONTOUR (MINOR)
- BOUNDARY LINE
- EASEMENT
- PROPOSED GRADE
- PROPOSED SPOT ELEVATION
- EXISTING GRADE

#### EROSION CONTROL PLAN AND POLLUTION PREVENTION NOTES

1. CONTRACTOR IS RESPONSIBLE FOR OBTAINING A TOPSOIL DISTURBANCE PERMIT PRIOR TO BEGINNING WORK.
2. CONTRACTOR IS RESPONSIBLE FOR CLEANING ALL SEDIMENT OUT OF EXISTING RIGHT-OF-WAY.
3. CONTRACTOR IS RESPONSIBLE FOR MAINTAINING ALL STORM RUNOFF ON SITE.
4. REPAIR OF DAMAGED FACILITIES AND CLEAN-UP OF SEDIMENT ACCUMULATION ON ADJACENT PROPERTIES AND IN PUBLIC FACILITIES IS THE RESPONSIBILITY OF THE CONTRACTOR.
5. AND WATER EROSION PRIOR TO FINAL ACCEPTANCE OF ANY PROJECT.

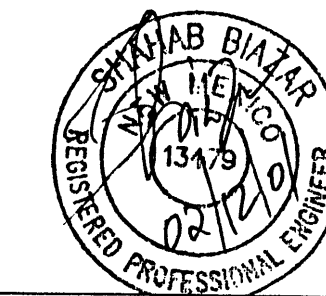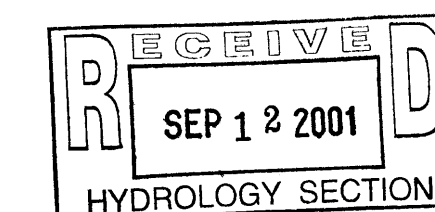

SHAHAB BIAZAR  
P.E. #13479

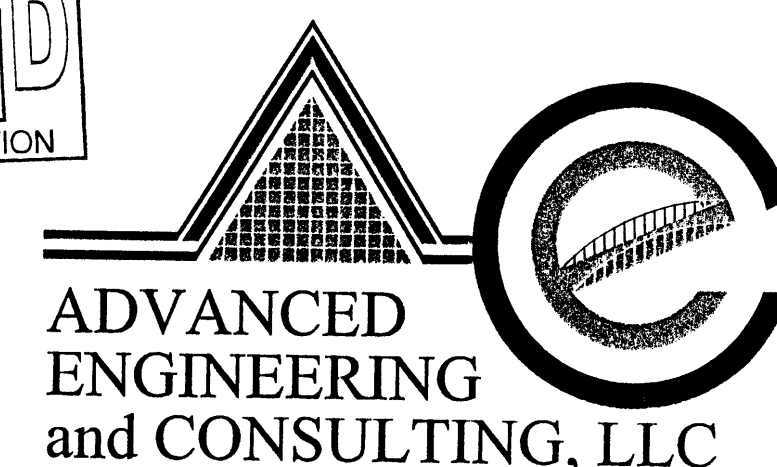

ADVANCED  
ENGINEERING  
and CONSULTING, LLC

10205 SNOWFLAKE CT, NW  
ALBUQUERQUE, NEW MEXICO 87114  
(505) 899-5570

ROMAN FOUNTAINS  
LOT 47, ALAMEDA BUSINESS PARK  
GRADING AND DRAINAGE PLAN

DRAWING:	DRAWN BY:	DATE:	SHEET #
2039-GR.DWG	SBB	01-05-01	

DRAINAGE  
As-Built