



CITY OF
Albuquerque
Public Works Department

February 6, 1997

Martin J. Chávez, Mayor

Robert E. Gurulé, Director

Chris Weiss
C.L. Weiss Engineerin, Inc.
P.O. Box 97
Sandia Park, NM 87047


**RE: AN OFFICE BUILDING (C17-D2A1). ENGINEER'S CERTIFICATION FOR
CERTIFICATE OF OCCUPANCY. ENGINEER'S CERTIFICATION DATED
JANUARY 17, 1997**

Dear Mr. Weiss:

Based on the information provided on your February 5, 1997
submittal, the above referenced project is approved for
Certificate of Occupancy

If I can be of further assistance, please feel free to contact me
at 924-3984.

Sincerely,

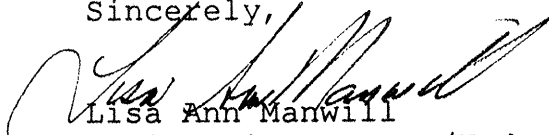

Lisa Ann Manwill
Engineering Assoc./Hyd.

c: Andrew Garcia
File

Good for You, Albuquerque!

P.O. Box 1293, Albuquerque, New Mexico 87103



DRAINAGE INFORMATION SHEET

PROJECT TITLE: An Office Building ZONE ATLAS / DRNG. FILE #: C-17-D2A1

LEGAL DESCRIPTION: Lot 12, Richfield Park Subdivision, Albuquerque NM

CITY ADDRESS: 8900 Washington St. NE

ENGINEERING FIRM: C.L. Weiss Engineering CONTACT: Chris Weiss

ADDRESS: P.O. Box 97, Sandia Park NM, 87047 PHONE: 281-1800

OWNER: Wescon, Inc. CONTACT: Steve Kraft

ADDRESS: 7301 Jefferson NE PHONE: 345-2511

ARCHITECT: Richard Bray, Architect CONTACT: Richard Bray

ADDRESS: 1813 Nakomis Ct. NE PHONE: 293-6337

SURVEYOR: N/A CONTACT: _____

ADDRESS: _____ PHONE: _____

CONTRACTOR FIRM: N/A CONTACT: _____

ADDRESS: _____ PHONE: _____

PRE-DESIGN MEETING:

YES

NO

COPY OF CONFERENCE RECAP SHEET PROVIDED

DRB NO. _____

EPC NO. _____

PROJ. NO. _____

TYPE OF SUBMITTAL:

DRAINAGE REPORT

DRAINAGE PLAN

CONCEPTUAL GRADING & DRAINAGE PLAN

GRADING PLAN

EROSION CONTROL PLAN

ENGINEER'S CERTIFICATION

CHECK TYPE OF APPROVAL SOUGHT:

SKETCH PLAT

PRELIMINARY PLAT

SITE DEVELOPMENT PLAN

FINAL PLAT

BUILDING PERMIT


FOUNDATION PERMIT

CERT. OF OCCUPANCY

ROUGH GRADING PERMIT


GRADING / PAVING PERMIT

OTHER _____

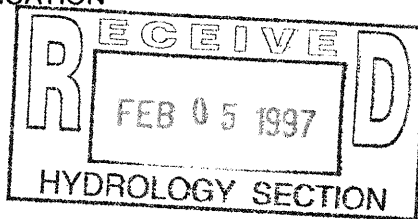

DATE SUBMITTED: February 4, 1997

BY: C.L. Weiss Engineering, Inc.

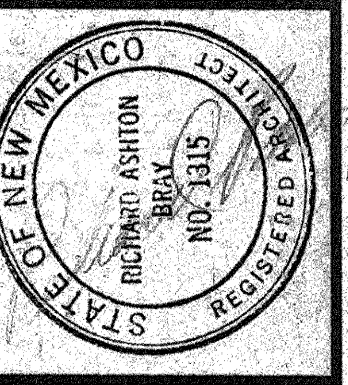

1/22/96

RICHARD A. BRAY, ARCHITECT
1813 NAKOMIS CT NE
ALBUQUERQUE, NEW MEXICO 87112
(505) 293-6337

AN OFFICE BUILDING
8900 WASHINGTON ST NE
ALBUQUERQUE, NEW MEXICO

| REVISIONS | Description | Date |
|-------------|-------------|------|
| No. | | |
| APPROVALS | | |
| Drawn By: | | |
| Checked By: | | |

PROJ. NO. 9160
SHEET NO. 1
OF 4
DATE JAN. 1996

DRB-96-69

SIGNATURE BLOCK

I CERTIFY THAT THIS PROJECT IS ZONED AND THIS PLAN IS CONSISTENT WITH THE SPECIFIC DEVELOPMENT PLAN APPROVED BY THE ENVIRONMENTAL PLANNING COMMISSION

ON Kevin L. Davis 5-2-96
PLANNING DEPARTMENT DATE

APPROVED AS TO THE REQUIREMENTS

Richard A. Bray 4-18-96
TRAFFIC ENGINEERING DATE


John J. Griffin 4-16-96
CITY ENGINEER DATE

John J. Griffin 4-16-96
AMAFCA DATE

Colleen K. Fong 4-16-96
PARKS & GENERAL SERVICES DATE

Robert W. Kane 4-16-96
WATER RESOURCES DATE

NEW MEXICO UTILITIES, INC DATE

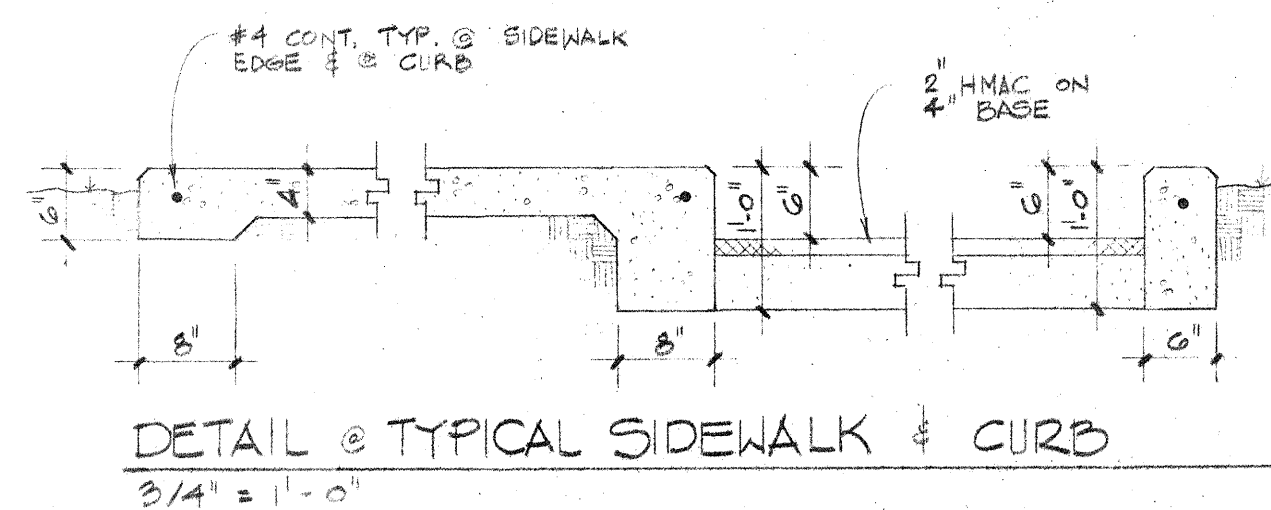

SCOPE

The proposed improvements include an approximately 6,150 SF (footprint) building area with adjacent concrete and asphalt paved walkways / parking areas, general site work, landscaping and site regrading.

The present site is an undeveloped commercial property which slopes at approx. 2% to the west, Columbine Ave. N.E. abuts the property to the south, Washington St. N.E. abuts the property to the west, the lands to the north is a developed commercial property and the lands to the east is an undeveloped commercial property.

The intent of this plan is to show:

- Grading relationships between the existing ground elevations and proposed finished elevations in order to facilitate positive drainage to designated discharge points.
- The extent of proposed site improvements, including buildings, walks and pavement.
- The flow rate/volume of rainfall runoff across or around these improvements and methods of handling these flows to meet City of Albuquerque requirements for drainage management.
- The relationship of on-site improvements with existing neighboring property to insure an orderly transition between proposed and surrounding grades.

DRAINAGE PLAN CONCEPT: The majority of the site will free discharge to Columbine Ave. N.E. Remaining flows will drain to Washington St. N.E.

GENERAL NOTES

- LEGAL:** Lot 12, Richfield Park Subdivision, Albuquerque, New Mexico.
- SURVEYOR:** From previous drainage plan. Site visit made by Christopher Weiss, PC during the week of January 22, 1996 to verify accuracy of the contours.
- B.M.:** City of Albuquerque Brass Cap NDC 7 located at the southwest quadrant of the intersection of Alameda Blvd. and AMAFCA NDC - elevation = 5062.60 (M.S.L.D.)
- T.B.M.:** Top of curb at Northwest property corner. Elevation = 5093.94
- SOILS:** SCS Soil Survey of Bernalillo County (Sheet 12) indicates that the soil is Embudo (EmB), a gravelly fine sandy loam classified in Hydrologic Soil Group 'B'.
- FLOOD HAZARD:** Per FEMA Boundary Map #9, the property is NOT within a flood zone.
- OFF-SITE DRAINAGE:** There is minimal off-site drainage onto this site (approx. 1/4 acre from the east).
- EROSION CONTROL:** The contractor is responsible for retaining on-site all sediment generated during construction by means of temporary earth berms or silt fences at the low points on the west property line.

CALCULATIONS:

Calculations are based on the Drainage Design Criteria for Albuquerque, New Mexico, Section 22.2, DPM, Vol 2, dated Jan., 1993


| | | |
|--|----------------------------|------------------------------|
| AREA OF SITE: | 22366 SF | = 0.51 Ac. |
| HISTORIC FLOWS: | | |
| On-Site Land Condition | On-Site Historic Flow Rate | EXCESS PRECIPITATION: |
| Area a = 0 SF | Area a = 0 SF | Precip. Zone = 2 |
| Area b = 0 SF | Area b = 0 SF | Ea = 0.53 |
| Area c = 22366 SF | Area c = 8733 SF | Eb = 0.78 |
| Area d = 0 SF | Area d = 15633 SF | Ec = 1.13 |
| Total Area = 22366 SF | Total Area = 22366 SF | Ed = 2.12 |
| On-Site Weighted Excess Precipitation (100-Year, 6-Hour Storm) | Weighted E = | EaAa + EbAb + EcAc + EdAd |
| Historic E = 1.13 in. | Proposed E = 1.82 in. | |
| On-Site Volume of Runoff: V360 = 0 CF | Proposed V360 = 3396 CF | |
| Historic V360 = 2106 CF | Proposed V360 = 3396 CF | |
| On-Site Peak Discharge Rate: Qp = QpaAa + QpbAb + QpcAc + QpdAd / 43,560 | | |
| For Precipitation Zone 2 | | |
| Qpa = 1.56 | Qpb = 3.14 | |
| Qpc = 2.28 | Qpd = 4.70 | |
| Historic Qp = 1.6 CFS | Proposed Qp = 2.2 CFS | |

| | | |
|---|-----------------------|------------------|
| AREA DRAINING TO DRIVE ENTRANCE: COLUMBINE AVE | 21166.0 SF | = 0.49 Ac. |
| The following calculations are based on Treatment areas as shown in table to the right. | | |
| Weighted Excess Precipitation (see formula above) | Weighted E = 1.86 in. | TREATMENT |
| Volume of Runoff (see formula above) | V360 = 3285 CF | A = 0% |
| Peak Discharge Rate: (see formula above) | Qp = 2.1 cfs | B = 0% |
| | | C = 26% |
| | | D = 74% |

| | | |
|---|-----------------------|------------------|
| LANDSCAPED AREA: TO WASHINGTON ST. | 1200.0 SF | = 0.03 Ac. |
| The following calculations are based on Treatment areas as shown in table to the right. | | |
| Weighted Excess Precipitation (see formula above) | Weighted E = 1.13 in. | TREATMENT |
| Volume of Runoff (see formula above) | V360 = 113 CF | A = 0% |
| Peak Discharge Rate: (see formula above) | Qp = 0.1 cfs | B = 0% |
| | | C = 100% |
| | | D = 0% |

| | | |
|---|-----------------------|------------------|
| OFFSITE FLOWS | 10880.0 SF | = 0.25 Ac. |
| The following calculations are based on Treatment areas as shown in table to the right. | | |
| Weighted Excess Precipitation (see formula above) | Weighted E = 2.02 in. | TREATMENT |
| Volume of Runoff (see formula above) | V360 = 1834 CF | A = 0% |
| Peak Discharge Rate: (see formula above) | Qp = 1.1 cfs | B = 0% |
| | | C = 10% |
| | | D = 90% |

These flows will pass through the site and exit to Columbine Ave. at the drive entrance.

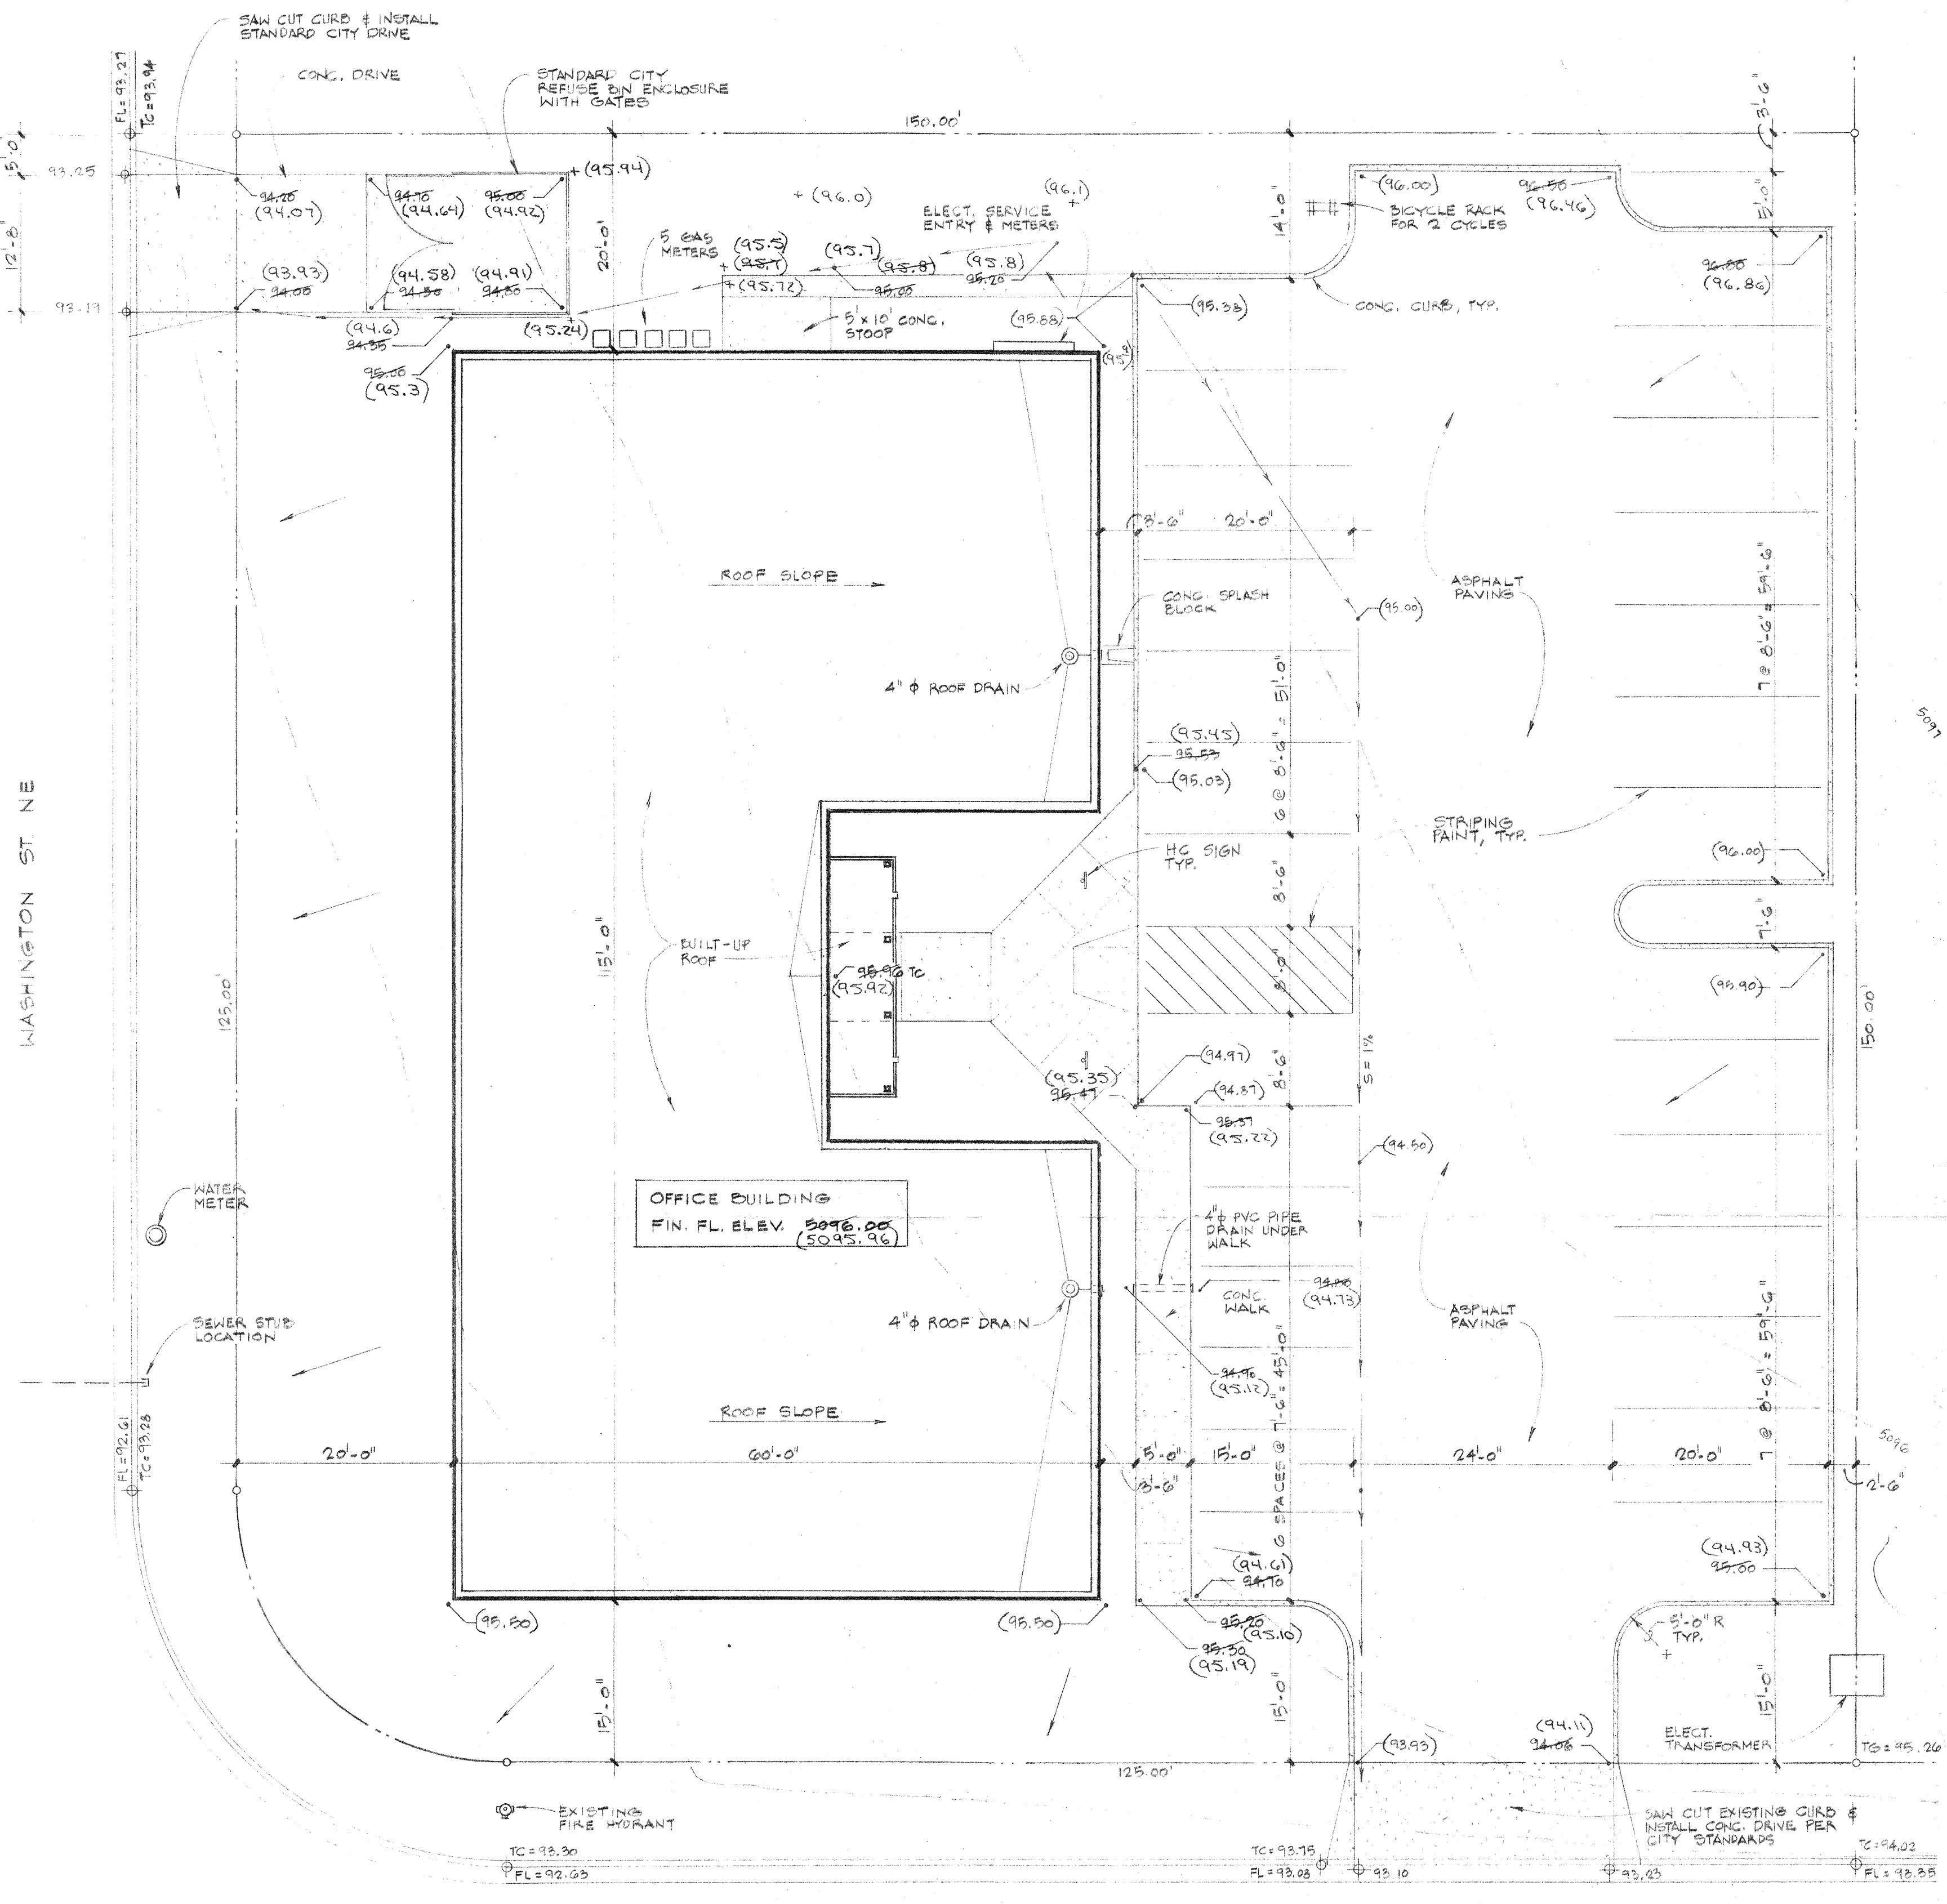

SITE PLAN

1" = 10'-0"

ADDRESS: 8900 WASHINGTON ST NE

LEGAL DESCRIPTION:
LOT 12, RICHFIELD PARK SUBDIVISION,
PHASE 1

ZONED: 1P

SITE DATA:

LOT AREA: 22,366 SF = 0.51 AC.

BLDG AREA: 6150 SF

WALKS & PAVING: 9483 SF

NET LOT AREA: 1666 SF

LANDSCAPE AREA: 6733 = 29% OF GROSS LOT OR 80% OF NET LOT

PARKING REQUIRED:
5120 NET LEASABLE SF + 220 = 26 SPACES

PARKING PROVIDED:
STANDARD 20
SMALL CAR 2
HANDICAPPED 2
TOTAL 28

SITE PLAN LEGEND

--- EXISTING CONTOURS

φ 00.00 EXISTING SPOT ELEVATIONS


— 00.00 NEW SPOT ELEVATION

(00.00) AS-BUILT ELEVATION

I, Christopher L. Weiss, P.E. hereby certify that the as-built information shown is in substantial compliance with the approved drainage / grading plan.

Christopher L. Weiss 1-17-97
Christopher L. Weiss, P.E. (N.M.P.E. #6653) Date

As-Built Survey provided by Forsitbauer Surveying Co. Jan 1997

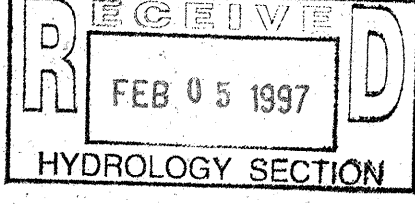

File 07/02/01