

AREAS OF MODIFICATION BETWEEN APPROVED DRAINAGE GRADING PLAN AND ACTUAL AS-BUILT

1. Parking Island / Landscaped area not constructed. Does not affect Drainage / Grading.

2. High point in paved area moved south. Very flat grades. Minimal slope to drain this area.

3. Landscaped area configuration not constructed per plan. Does not affect Drainage / Grading.

I, Christopher L. Weiss, P.E. hereby certify that the as-built information shown is in substantial compliance with the approved drainage / grading plan.

Christopher L. Weiss, P.E. (N.M.P.E. #6653) Date 11-2-96
As-Built Survey provided by E. Maxwell Doak NMPS#8127 • 11-96


BDA ARCHITECTURE
6000 UPTOWN BLVD. N.E.
SUITE #314 (505)266-0593
ALBUQUERQUE, NM 87110

Wayne Usiak & Associates

PROJECT: OFFICE WAREHOUSE FACILITY
LOCATION: COLUMBINE AVE. NE
ALBUQUERQUE, NM
OWNER: JOHN MECHENBIER

- KEYED NOTES**
1. CONSTRUCT DRIVE ENTRANCE. PROVIDE SMOOTH RIDING TRANSITION. SEE ARCHITECTURAL FOR DIMENSIONS.
 2. CONSTRUCT STANDARD CURB AND GUTTER.
 3. CONSTRUCT 6" CONCRETE CURB.
 4. CONCRETE DUMPSTER PAD.
 5. OFFICE ROOF FLOWS TO DRAIN THROUGH PIPES UNDER WALKS WITH OUTLET LOCATIONS AS SHOWN THIS PLAN. SEE ARCHITECTURAL FOR ADDITIONAL INFO.
 6. WAREHOUSE ROOF FLOWS TO DRAIN AT CANAL LOCATIONS AS SHOWN ON THIS PLAN. SEE ARCHITECTURAL FOR ADDITIONAL INFO.
 7. CONSTRUCT CONCRETE RUNDOWN / UNDERWALK DRAIN THIS AREA. SEE ENLARGED DETAIL AT LEFT.
 8. ALL SPOT ELEVATIONS REFERENCE TOP OF ASPHALT UNLESS NOTED OTHERWISE. ADD 0.5 FOR TOP OF CURB / TOP OF WALK.
 9. CONSTRUCT ASPHALT WATERBLOCK THIS AREA TO PREVENT FLOWS FROM ENTERING DOCK AREA.
 10. 3X3X3' CONCRETE BLOCK VAULT WITH SEALED CONDUIT STUB-IN FOR WIRING AND STUB OUT FOR 2" OUTLET PIPE HYDROMATIC 5K501A 0.4 HP SUBMERSIBLE PUMP OR EQUIVALENT. INENAH R-4808 24"X24" HEAVY DUTY GRATE WITH R-4808 24"X24" SCHEDULE 40 PVC DISCHARGE LINE FROM SUMP PUMP. TRULI VALVE. WALL. PREPARED. GROUT. SEAL. EXTEND DISCHARGE PIPE UP TO EXIT TO ASPHALT DRIVE AT FLOWLINE.
 11. LANDSCAPED AREA DRAINS UP TO STREET (TOTAL AREA = 9500 SF)

- GENERAL NOTES:**
1. BASED ON THE MASTER DRAINAGE STUDY FOR RICHFIELD PARK SUBDIVISION. FREE DISCHARGE TO WASHINGTON STREET IS PERMITTED.
 2. ALTHOUGH THE FEMA MAP INSERT INDICATES THE PRESENCE OF A 100 YEAR FLOOD BOUNDARY THROUGH A PORTION OF THIS PROPERTY, THE INFRASTRUCTURE CONSTRUCTED IN THIS AREA HAVE DIVERGED THESE FLOWS. NO ADDITIONAL METHODS OF FLOOD PROOFING WERE IMPLEMENTED UNTIL FEMA MAP REVISIONS ARE MADE. THIS PROPERTY MAY BE SUBJECT TO FLOOD INSURANCE.

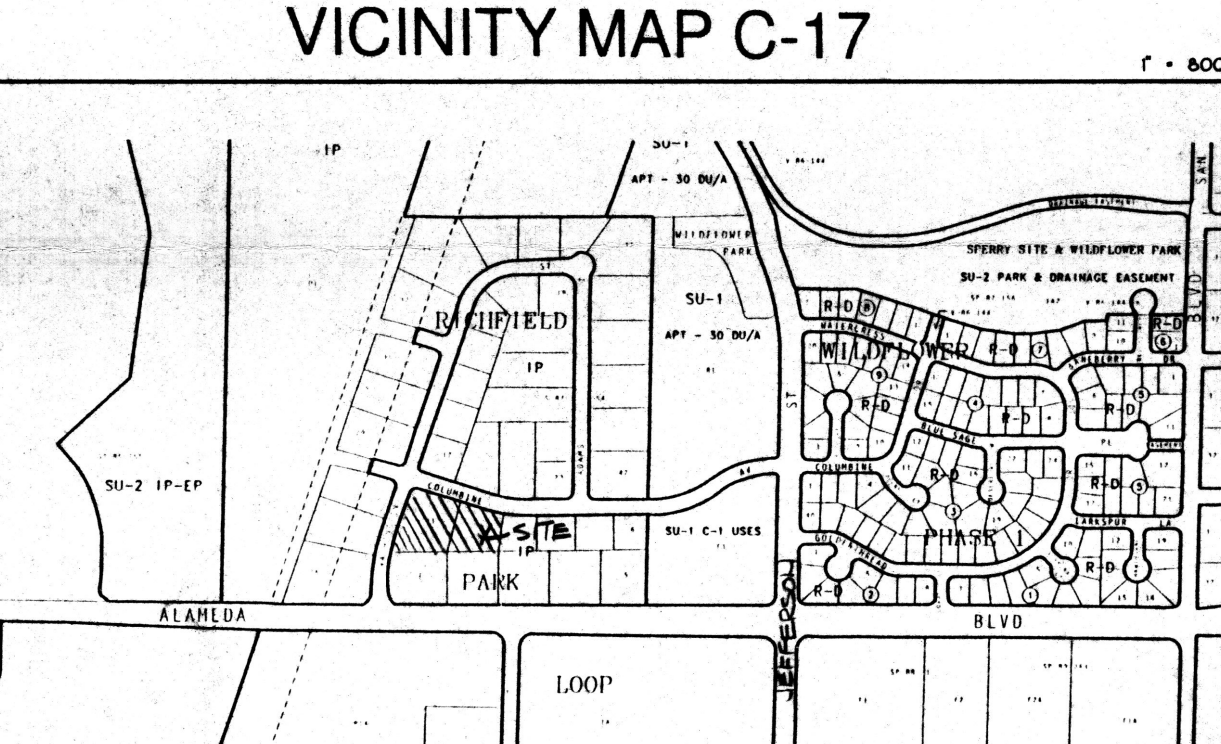

SCOPE:
The proposed improvements include an approximately 23,000 SF (footprint) building area with adjacent concrete and asphalt paved walkways / parking areas, general site work and site grading.

The present site is an undeveloped commercial property which grades at approx. 2% to the west. Columbine Ave. N.E. abuts the property to the north, Washington St. N.E. abuts the property to the west, the lands to the south and east are undeveloped commercial properties.

The intent of this plan is to show:

- Grading relationships between the existing ground elevations and proposed finished elevations in order to facilitate positive drainage to designated drainage points.
- The extent of proposed site improvements, including buildings, walks and pavement.
- The flow rate/volume of rainfall runoff across or around these improvements and methods of handling these flows to meet City of Albuquerque requirements for drainage management.
- The relationship of on-site improvements with existing neighboring property to insure an orderly transition between proposed and surrounding grades.

DRAINAGE PLAN CONCEPT: All flows will free discharge to Washington St. N.E. as they do currently. Approximately 1/2 of the flows will exit to Washington at the drive entrance while the remaining 1/2 will drain by means of a concrete channel / underwalk drain to the street.

GENERAL NOTES:
LEGAL: Lots 10 and 11, Richfield Park Subdivision, Albuquerque, New Mexico.

SURVEYOR: Forstbauer Surveying Co., Ron Forstbauer, 1100 Alvarado Dr. NE, Albuq. 87110 - December 1994

B.M.: City of Albuquerque Brass Cap NDC 7 located at the southwest quadrant of the intersection of Alameda Blvd. and AMAFCA NDC - elevation = 5062.60 (M.S.L.D.)

I.B.M.: "A" at top of curb near northeast property corner (see plan). Elevation = 5096.20 (M.S.L.D.)

SOILS: SCS Soil Survey of Bernalillo County indicates that the soil is Embudo (EmB): Hydrologic Soil Group "B".

FLOOD HAZARD: Per FEMA Boundary Map #9, the property is shown within a flood zone. However, this area has been developed with streets and other drainage infrastructure improvements and the site is no longer impacted by the aforementioned floodzone.

OFF-SITE DRAINAGE: There is minimal off-site drainage onto this site (approx. 1/4 acre from the east).

EROSION CONTROL: The contractor is responsible for retaining on-site all sediment generated during construction by means of temporary earth berms or silt fences at the low points on the west property line.

CALCULATIONS:
Calculations are based on the Drainage Design Criteria for Albuquerque, New Mexico, Section 22.2, DPM, Vol. 2, dated Jan., 1993

AREA OF SITE: 77565 SF = 1.781 Ac.

HISTORIC FLOWS:

On-Site Land Condition	Area	Area a	Area b	Area c	Area d	Total Area
On-Site Land Condition	0 SF	0 SF	0 SF	0 SF	0 SF	0 SF
Area a	0 SF	0 SF	0 SF	0 SF	0 SF	0 SF
Area b	0 SF	0 SF	0 SF	0 SF	0 SF	0 SF
Area c	77565 SF	11000 SF	68565 SF	77565 SF	77565 SF	77565 SF
Area d	0 SF	0 SF	0 SF	0 SF	0 SF	0 SF
Total Area	77565 SF	11000 SF	68565 SF	77565 SF	77565 SF	77565 SF

DEVELOPED FLOWS:

On-Site Historic Flow Rate	Area a	Area b	Area c	Area d	Total Area
On-Site Historic Flow Rate	0 SF	0 SF	0 SF	0 SF	0 SF
Area a	0 SF	0 SF	0 SF	0 SF	0 SF
Area b	0 SF	0 SF	0 SF	0 SF	0 SF
Area c	11000 SF	68565 SF	77565 SF	77565 SF	77565 SF
Area d	0 SF	0 SF	0 SF	0 SF	0 SF
Total Area	11000 SF	68565 SF	77565 SF	77565 SF	77565 SF

EXCESS PRECIPITATION:

Precip. Zone	Ea	Eb	Ec	Ed
Precip. Zone	0.53	0.78	1.13	2.12
Ea	0.53	0.78	1.13	2.12
Eb	0.53	0.78	1.13	2.12
Ec	0.53	0.78	1.13	2.12
Ed	0.53	0.78	1.13	2.12

AREA DRAINING TO DRIVE ENTRANCE

Area to Drive Entrance	Area	Area a	Area b	Area c	Area d	Total Area
Area to Drive Entrance	26600 SF	0 SF	0 SF	0 SF	0 SF	0 SF
Area a	0 SF	0 SF	0 SF	0 SF	0 SF	0 SF
Area b	0 SF	0 SF	0 SF	0 SF	0 SF	0 SF
Area c	0 SF	0 SF	0 SF	0 SF	0 SF	0 SF
Area d	0 SF	0 SF	0 SF	0 SF	0 SF	0 SF
Total Area	26600 SF	0 SF	0 SF	0 SF	0 SF	0 SF

WEST AREA DRAINING TO UNDERWALK DRAIN

Area to Underwalk Drain	Area	Area a	Area b	Area c	Area d	Total Area
Area to Underwalk Drain	17926 SF	0 SF	0 SF	0 SF	0 SF	0 SF
Area a	0 SF	0 SF	0 SF	0 SF	0 SF	0 SF
Area b	0 SF	0 SF	0 SF	0 SF	0 SF	0 SF
Area c	0 SF	0 SF	0 SF	0 SF	0 SF	0 SF
Area d	0 SF	0 SF	0 SF	0 SF	0 SF	0 SF
Total Area	17926 SF	0 SF	0 SF	0 SF	0 SF	0 SF

NORTH AREA DRAINING TO UNDERWALK DRAIN THRU CONCRETE CHANNEL

Area to underwalk drain: 23539.0 SF = 0.54 Ac.

The following calculations are based on Treatment areas as shown in table to the right.

Weighted Excess Precipitation (see formula above)

Weighted E	Volume of Runoff (see formula above)	V360	Peak Discharge Rate (see formula above)	Op
2.07 in.	4061 CF	4061 CF	2.5 cfs	2.5 cfs
2.07 in.	4061 CF	4061 CF	2.5 cfs	2.5 cfs
2.07 in.	4061 CF	4061 CF	2.5 cfs	2.5 cfs
2.07 in.	4061 CF	4061 CF	2.5 cfs	2.5 cfs

CAPACITY OF CONCRETE CHANNEL

Bottom Width	Channel Slope	Discharge	Total Depth Required	Total Depth Provided
1.5'	0.0100	2.5 cfs	0.41'	0.50'
0.0150	0.0100	2.5 cfs	0.41'	0.50'

CAPACITY OF CONCRETE RUNDOWN

Bottom Width	Channel Slope	Discharge	Total Depth Required	Total Depth Provided
2.0'	0.0467	4.4 cfs	0.28'	0.50'
0.0150	0.0467	4.4 cfs	0.28'	0.50'

CAPACITY OF UNDERWALK DRAIN

Bottom Width	Channel Slope	Discharge	Total Depth Required	Total Depth Provided
2.0'	0.0200	4.4 cfs	0.37'	0.50'
0.0150	0.0200	4.4 cfs	0.37'	0.50'

SUMP PUMP

Area to underwalk drain: 1000.0 SF = 0.02 Ac.

The following calculations are based on Treatment areas as shown in table to the right.

Weighted Excess Precipitation (see formula above)

Weighted E	Volume of Runoff (see formula above)	V360	Peak Discharge Rate (see formula above)	Op
2.12 in.	177 CF	177 CF	0.1 cfs	0.1 cfs
2.12 in.	177 CF	177 CF	0.1 cfs	0.1 cfs
2.12 in.	177 CF	177 CF	0.1 cfs	0.1 cfs
2.12 in.	177 CF	177 CF	0.1 cfs	0.1 cfs

Based on Manufacturer's pump curves for specified pump, pump volume rate: 75-100 gpm < 0.25 hour to pump peak volume. Volume of dock area = 177 CF = (7.5 gal / cf) * 177 cf = 1330 gal. In case of pump failure, flows will be contained in dock area. Volume of dock area = 20' wide x 24' long (to 95 contour) x 4' deep / 2 = 960 CF < 177 CF OK

LEGEND

- SIDEWALK, CURB AND GUTTER EXISTING, PROPOSED
- PROPOSED PAVED DRIVE
- BUILDING EXISTING, PROPOSED
- PROPERTY LINE
- EXISTING SPOT ELEVATION
- EXISTING CONTOUR
- PROPOSED SPOT ELEVATION
- PROPOSED CONTOUR
- SURFACE FLOW DIRECTION EXISTING, PROPOSED
- LANDSCAPED AREA
- TOP OF GRADE WALL < 10' HIGH
- TOP OF RETAINING WALL > 10' HIGH
- TOP OF ASPHALT
- TOP OF CURB +
- FLOW LINE
- FINISHED FLOOR
- RIGHT OF WAY
- PROPERTY LINE
- POWER POLE
- AS-BUILT INFORMATION

DRAINAGE / GRADING PLAN

DATE: 2/28/95 DRAWN: BJB CHECKED: CLW
APPROVED: PROJECT NO. 9436

REVISIONS:

Copyright, 1993, BDA Architecture

ARCH. SEAL ENGR. SEAL SHEET: C-1

4 OF 5