


DATE \_\_\_\_\_




# JEFFERSON STREET INDUSTRIAL PARK-GRADING AND DRAINAGE PLAN FOR SUBDIVISION

FEMA PANEL 350002 0009

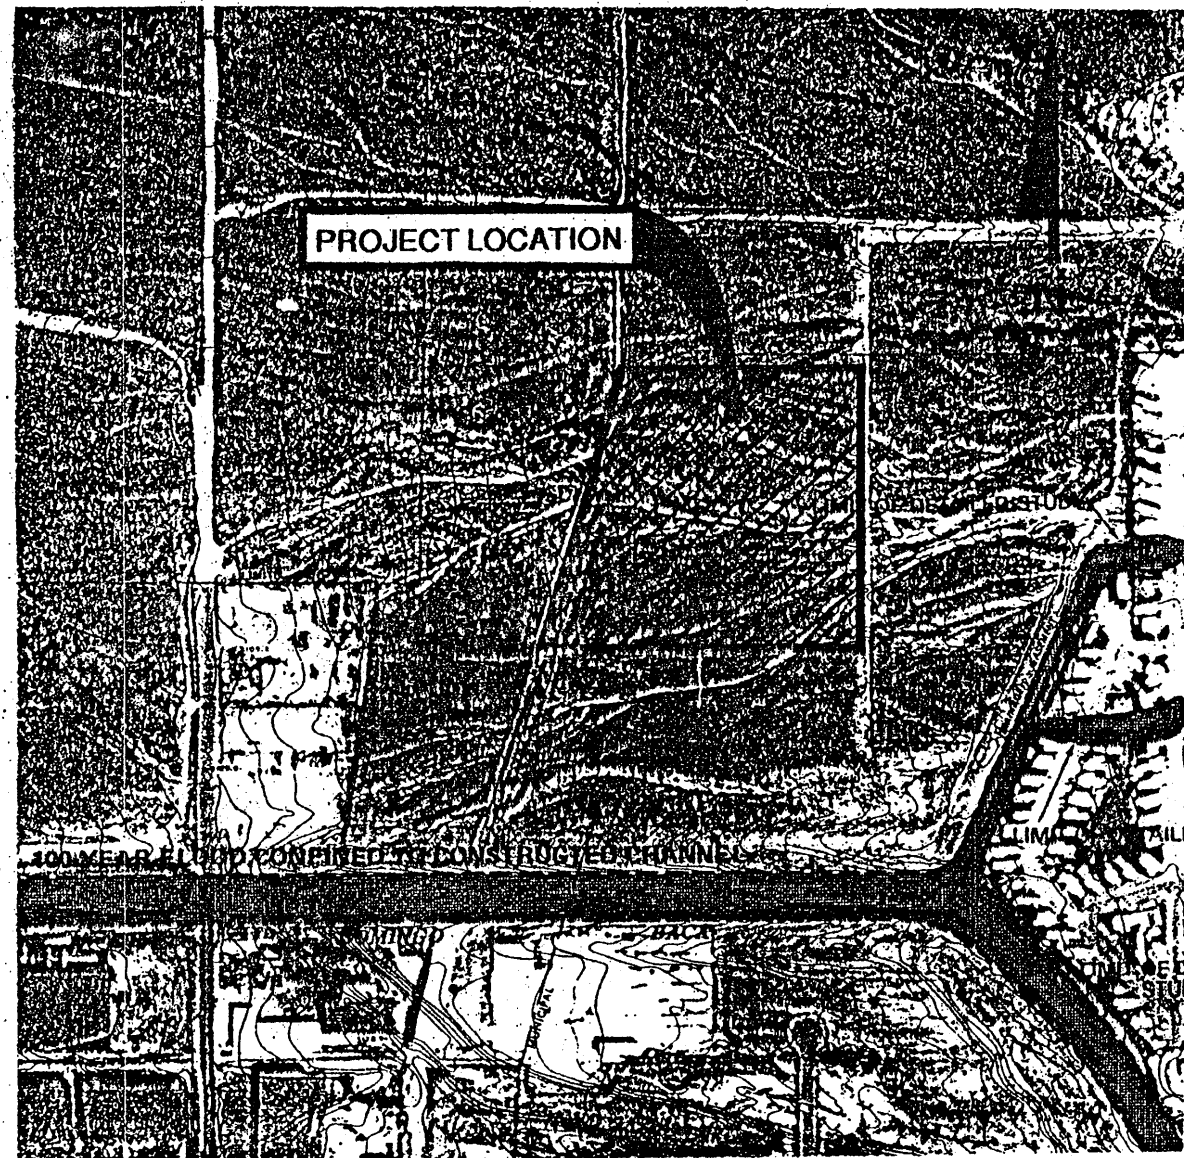

ZONE ATLAS MAP C-17

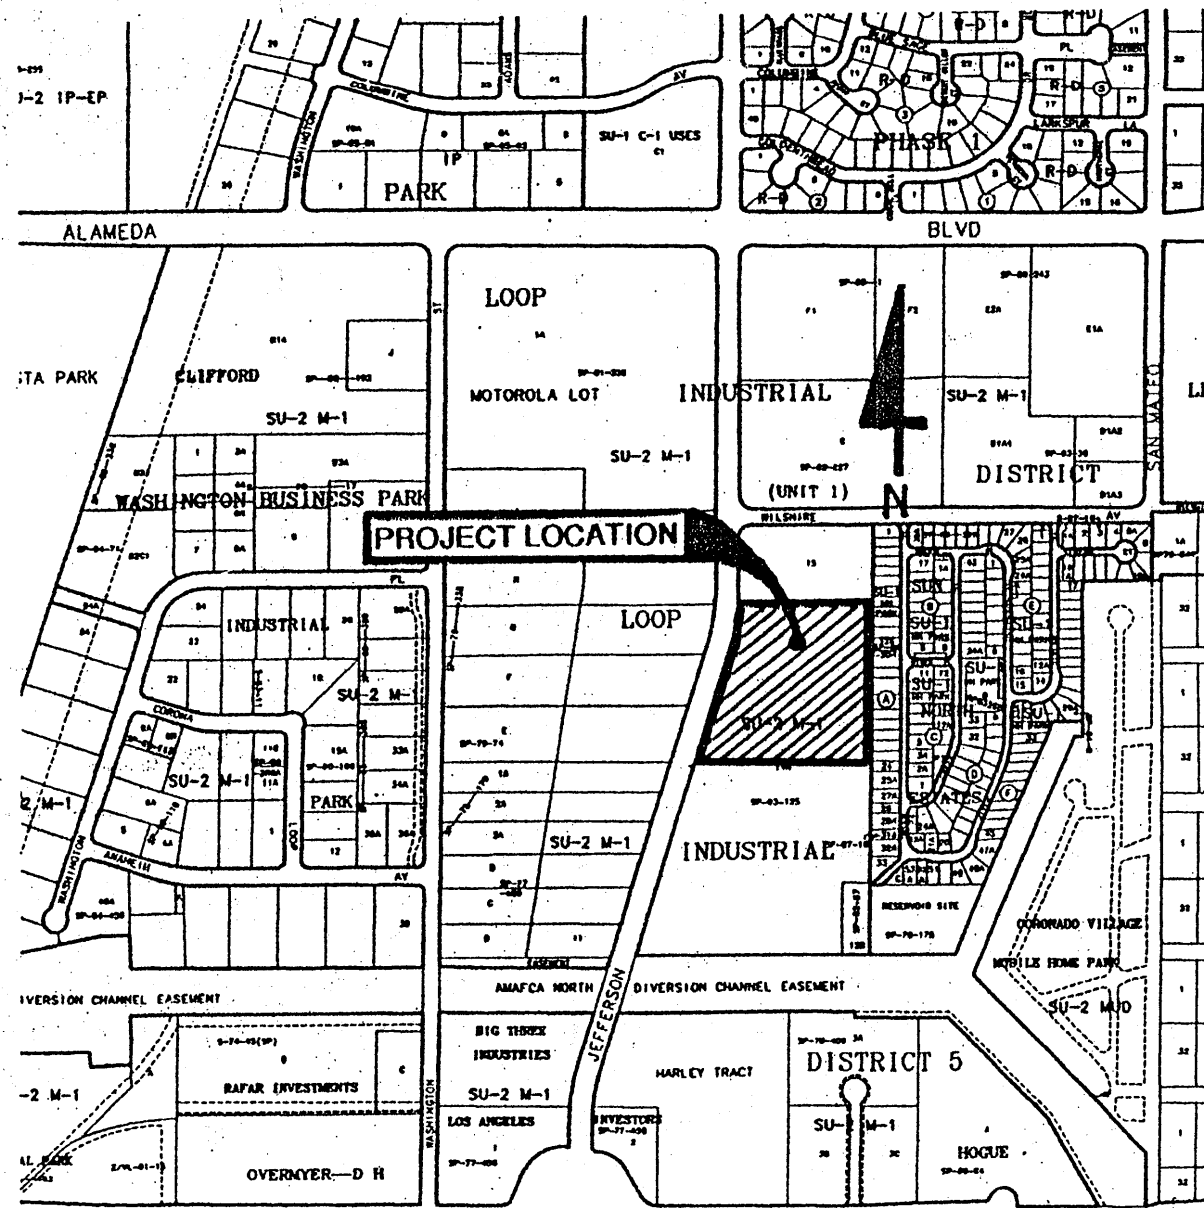

LEGAL DESCRIPTION:

TRACT A-14-2  
LOOP INDUSTRIAL TRACT UNIT IV

BENCH MARKS:

- ACS BRASS CAP.  
"LOOP INDUSTRIAL DISTRICT UNIT IV"  
JEFFERSON/WILSHIRE  
ELEVATION = 5131.89
- AMAFCA BRASS CAP  
"NDC 7-1B2"  
ELEVATION = 5064.40

## PLANNED DEVELOPMENT

Development planned for Tract 14-A-2, Unit 5, Loop Industrial Tract consists of subdividing the existing 9.4 +/- acre parcel into 6 lots and constructing an industrial park. The property is zoned SU-2/M1. A private access road is planned which provides six lots access to Jefferson Street. The remaining 1.9 acre parcel access Jefferson Street via private turnouts. This Drainage and Grading Plan for subdivision recommends drainage management and infrastructure improvements necessary to support the planned development.

The project is located on Jefferson Street between Paseo Del Norte and Wilshire Avenue, in northeast Albuquerque, New Mexico. Existing terrain consists predominately of mild slopes, 1%-3%, with minimal vegetation. The property generally slopes from east to west. The property is not located in a F.E.M.A. flood plain.

## EXISTING HYDROLOGIC CONDITIONS

The site is currently undeveloped. The site receives off-site flows from a portion of the mobile home park (1.9 acres) adjacent to its east property line. The remaining runoff originating at the mobile home park is diverted by Brook Street and drained southward to the North Division Channel. Flows generated by the site, including off-site flows, drain into Jefferson Street (west), where they are directed south to the AMAFCA North Division Channel. A curb drop inlet, approximately 100' south of the site's south property line, accepts flows from Jefferson Street and discharges them to the North Division Channel via a 24"/30" storm drain. Excess flow, above the capacity of the curb drop inlet, drains south on Jefferson Street until the AMAFCA North Division Channel is reached 550' south of the curb drop inlet. At the site's north property line, Jefferson Street reaches a high point that provides a water block from runoff originating north of the site. Properties to the west drain westerly. The stretch of Jefferson Street between the sites north property line and the AMAFCA North Division Channel receives flow from the subject site, including its off-site basin, and 12.8 +/- acres just south of the site. A curb drop inlet connected to a 30" storm sewer is in place at the southwest corner (along Jefferson Street) of the 12.8 acre basin.

## PURPOSE OF DRAINAGE AND GRADING PLAN FOR SUBDIVISION

This plan presents necessary drainage and grading improvements required to support subdivision into 6 parcels and the subsequent planned development. In addition, the plan accommodates a phased implementation process for development. As lots are purchased and developed, each lot will be required to submit a detailed grading plan that is intended to function as prescribed by this Drainage and Grading Plan. Submittal of detailed grading plans to the City Hydrology Department for grading plan review and approval, will be required. The grading plans will be stand alone construction documents that include detailed drainage and grading elements, proposed building foot print, foundation elevations, parking areas, landscape areas, roof drains, drainage swales, sidewalk culverts, etc.

Future plans will not be required to address hydrologic analysis except for designing and sizing minor drainage structures such as swales, rundowns, and sidewalk culverts. Pro-rating flow rates established by this plan based on basin area will be an acceptable method for determining these flow rates. Lots A, B, C, D, E, F, G, and H must incorporate a pro-ration of off-site flows based on the percentage of frontage each lot shares with the mobile home park to the east.

## ON-SITE HYDROLOGY

On-site hydrologic analysis is provided in order to determine flow rates conveyed by interior streets, swales, rundowns, and curb drains. Under existing, undeveloped conditions the site is 100% land treatment C, yielding 29.5 and 16.1 cfs for the 100 year and 10 year storm events, respectively. Under proposed conditions the site consists of 40% land treatment C and 60% land treatment B and 25.5 cfs for the 100 year and 10 year storm events, respectively. Lots A, B, C, D, E, F, G, and H accept off-site flows from a portion of the mobile home park (1.9 ac.) to the east. Under both existing, undeveloped and developed conditions the off-site basin is 40% land treatment B and 60% land treatment D, yielding 7.1 and 4.3 cfs for the 100 year and 10 year storm events, respectively.

## DEVELOPMENT IMPLEMENTATION AND PHASING

It is planned to build the private access road in conjunction with the first lot constructed. The private access road is available to convey flows generated by lots A, B, C, D, E, F, G, and H. At this time it is unknown which lot will be constructed first. The private access road will be located in a 24' Private Access and Drainage Easement.

Lot A may either discharge runoff to the private access road or directly to Jefferson Street via sidewalk culverts. Lots B, C, D, E, F, G, and H will discharge to the private access road. Lot G may discharge to Jefferson Street via sidewalk culverts or to the drainage easement along its north property line. Lot H will discharge to the 10' private drainage easement crossing lots A and B. Lot A will discharge directly to the Jefferson Street via sidewalk culverts. Lot G may discharge to Jefferson Street via sidewalk culverts or to the drainage easement along its south property line. Lot H will discharge to the 10' private drainage easement crossing the south side of lot A. A sidewalk culvert will be required at the outlets of the 10' drainage easements. All sidewalk culverts must be sized and designed accordingly along with the site specific plan.

Provision of the North 1-25 Sector Development require minimum 6' landscape buffers along all side and rear property lines. Flow in private drainage easements located in these landscape buffers shall be contained within a concrete rundown or an appropriately sized landscaped swale. (See Hydraulic Calculations.)

## INTERNAL EROSION CONTROL PLAN

It is planned to grade the site in a phased manner. Areas that are disturbed during construction but do not receive a permanent surface treatment will be required to install erosion control berms, or site fences and shall be required to revegetate disturbed areas. These measures will be shown on the lot specific grading plans and shall be an integral part of the Top Soil Disturbance Permit. Revegetation will be of a permanent type designed to City of Albuquerque Minimum Specifications for Public Works Construction.

## COMPUTATIONS

### HYDROLOGY

Analysis per COA DPM Chapter 22.2, HYMO Peak Discharge Method, zone 2.  
Design Storm 100 year - 6 hour event Applied Rainfall is 2.35 inches (table 2)  
10 year - 6 hour event Applied Rainfall is 2.35 inches x 0.67 = 1.57 inches (table 3)

### Runoff/Acre

100 year: B Treatment = 2.28 cfs/ac., C Treatment = 3.14 cfs/ac., D Treatment = 4.70 cfs/ac.  
10 year: B Treatment = 0.95 cfs/ac., C Treatment = 1.71 cfs/ac., D Treatment = 3.14 cfs/ac.

### Basin A (Subject Site - 9.4 acres zoned light industrial)

Land Treatments  
Existing Conditions 100.0% Treatment C  
Proposed Conditions 30% Treatment C and 70% Treatment D  
Peak Discharge  
Existing Conditions 100 year = 9.4 acres x (1.00x 3.14 cfs/ac.) = 29.5 cfs  
10 year = 9.4 acres x (1.00x 1.71 cfs/ac.) = 16.1 cfs  
Proposed Conditions 100 year = 9.4 acres x (0.30x 3.14 cfs/ac. + 0.70x 4.70 cfs/ac.) = 39.8 cfs  
10 year = 9.4 acres x (0.30x 1.71 cfs/ac. + 0.70x 3.14 cfs/ac.) = 25.5 cfs

### Basin B (Off-site Basin Site - 1.9 acre mobile home park east of site)

Land Treatments  
Existing and Proposed Conditions 40% Treatment B and 60% Treatment D  
Peak Discharge  
Existing and Proposed Conditions  
100 year = 1.9 acres x (0.40x 2.28 cfs/ac. + 0.60x 4.70 cfs/ac.) = 7.1 cfs  
10 year = 1.9 acres x (0.40x 0.95 cfs/ac. + 0.60x 3.14 cfs/ac.) = 4.3 cfs

### Basin C (Off-site Basin Site - 0.7 acres of Jefferson Street - south of the subject site's north property line - 100' south of the site's southern property line - approximate location of a curb drop inlet.)

Land Treatments  
Existing and Proposed Conditions 32.6% Treatment B and 67.4% Treatment D  
Peak Discharge  
Existing and Proposed Conditions  
100 year = 0.7 acres x (0.326x 2.28 cfs/ac. + 0.674x 4.70 cfs/ac.) = 2.6 cfs  
10 year = 0.7 acres x (0.326x 0.95 cfs/ac. + 0.674x 3.14 cfs/ac.) = 1.8 cfs

### Basin D (Site South of Subject Site - 12.8 acres includes 0.7 acres of mobile home park and 2.5 acres of future reservoir site, the remaining will be developed as light industrial)

Land Treatments  
Existing Conditions 2% Treatment B, 95% Treatment C, 3% Treatment D  
Proposed Conditions 2% Treatment B, 42% Treatment C, 56% Treatment D  
Peak Discharge  
Existing Conditions 100 year = 12.8 acres x (0.02x 2.28 cfs/ac. + 0.95x 3.14 cfs/ac. + 0.03x 4.70) = 40.5 cfs  
10 year = 12.8 acres x (0.02x 0.95 cfs/ac. + 0.95x 1.71 cfs/ac. + 0.03x 3.14) = 22.8 cfs  
Proposed Conditions 100 year = 12.8 acres x (0.02x 2.28 cfs/ac. + 0.42x 3.14 cfs/ac. + 0.56x 4.70) = 51.1 cfs  
10 year = 12.8 acres x (0.02x 0.95 cfs/ac. + 0.42x 1.71 cfs/ac. + 0.56x 3.14) = 31.9 cfs

### Basin E (Off-site Basin Site - 0.6 acres of Jefferson Street - 100' south of the subject site's southern property line - to the North Division Channel approximate location of a curb drop inlet.)

Land Treatments  
Existing and Proposed Conditions 32.6% Treatment B and 67.4% Treatment D  
Peak Discharge  
Existing and Proposed Conditions  
100 year = 0.6 acres x (0.326x 2.28 cfs/ac. + 0.674x 4.70 cfs/ac.) = 2.2 cfs  
10 year = 0.6 acres x (0.326x 0.95 cfs/ac. + 0.674x 3.14 cfs/ac.) = 1.5 cfs

## STREET HYDRAULICS

### Runoff Capacity of Jefferson Street

Street flow depths during peak flow were calculated using Manning's equation. Conjugate depths were calculated for flows in the super-critical state, should conditions be conducive to the formation a hydraulic jump.

- only the two tenth-bound lanes could be used due to the median, 2) n = 0.017 for the roadway surface, 3) road cross slope = 2.00%, 4) curb to curb distance = 25', 5) outside curb to inside driving lane = 13 ft, 6) eight inch curbs.

To establish DPM criteria flows the following parameters were used:

- 10 year-storm: one lane dry, max. flow depth = 0.5'
- 100 year-storm: max. flow depth = 0.87'

The relevant stretch of Jefferson Street has two slope regions: a flatter region fronting the subject site with an average slope 0.83%, and a steeper region with an average slope of 1.60% south of the subject property. Two curb drop inlets service Jefferson Street between the subject site and the North Division Channel; at point A and point B, 100 ft and 550 ft south of the subject site, respectively. Analyses were performed to determine peak flow and the resulting flow height within Jefferson Street both immediately before and after interception of flow at each curb drop inlet site. It was assumed 100% of the runoff from basins A, B, and C drain to the curb drop inlet at point A. Inlet capacity was computed to determine the proportion of flows intercepted by the curb drop inlet. Basin D was assumed to form two sub-basins; one (1/3 of basin D) discharging upstream of the curb drop inlet at analysis point B and the other (the remaining 2/3 of basin D) discharging immediately downstream of the curb drop inlet at point B. The analysis at point B assumed that the carry-over from the curb drop inlet at point A, the entire basin E, and the upper 1/3 of basin D comprised the peak discharge immediately upstream of the curb drop inlet at point A, the entire basin E, and the runoff from the remaining 2/3 of basin D comprise the peak flow immediately below point B. The table below summarizes the results of these analyses:

Point of Analysis	Storm Event/Condition	Max. Depth in Street * (ft.)	Peak Street Flow (cfs)	Peak Storm Sewer Flow (cfs)
Point A	10 year storm-DPM criteria	0.26	3.4	---
Jefferson St. 100' south of subject site--	existing conditions	0.52	22.2	---
prior to curb drop inlet	proposed conditions	0.61	31.6	---
(street slope = 0.0085 ft/ft)	100 year storm-DPM criteria	0.87	58.8	---
	existing conditions	0.70	39.6	---
	proposed conditions	0.80	49.5	---
Point A	10 year storm-DPM criteria	0.26	3.4	11.65
Jefferson St. 100' south of subject site--	existing conditions	0.40	10.5	15.19
after curb drop inlet	proposed conditions	0.52	21.7	---
(street slope = 0.0085 ft/ft)	100 year storm-DPM criteria	0.87	58.8	17.92
	existing conditions	0.47	16.4	21.05
	proposed conditions	0.58	28.5	---
Point B	10 year storm-DPM criteria	0.26	4.6	11.65
Jefferson St. 550' south of subject site--	existing conditions	0.45 (0.46)	19.6	15.19
prior to curb drop inlet	proposed conditions	0.55 (0.59)	33.8	---
(street slope = 0.0160 ft/ft)	100 year storm-DPM criteria	0.87	78.1	17.92
	existing conditions	0.58 (0.62)	37.5	21.05
	proposed conditions	0.65 (0.69)	47.7	---
Point B	10 year storm-DPM criteria	0.26	4.6	21.00
Jefferson St. 550' south of subject site--	existing conditions	0.55 (0.59)	33.1	29.96
after curb drop inlet	proposed conditions	0.61 (0.65)	41.4	---
(street slope = 0.0160 ft/ft)	100 year storm-DPM criteria	0.87	78.1	31.69
	existing conditions	0.67 (0.69)	49.8	38.53
	proposed conditions	0.79	64.5	---

\* Normal depths presented are sub-critical, unless the max. flow depth is followed by parenthesis; in which case, the normal depth is super-critical. Numbers in parenthesis denote the depth at sub-critical flow in the event of a hydraulic jump.

Analyses indicates that under existing undeveloped conditions Jefferson Street has insufficient capacity to meet the 10 year minimum design criteria of one dry lane, each direction. Both the 10 year and the 100 year storms, under existing and proposed conditions are contained within the right of way prism. Because the DPM's 10 year-storm criteria could not be met under existing conditions and the effects due to the proposed development produce negligible change in flow depth, it is requested that a variance to this criteria be allowed for the proposed development.

Please note that the hydraulic analysis of Jefferson Street presented above is somewhat conservative. Several median breaks and median drainage culverts along Jefferson Street exist as shown on this plan. With the properties to the west of Jefferson Street draining entirely to the west, the entire capacity of Jefferson's south-bound lanes is available. All flow depths shown above are based on a curbed median. All flows greater than 6" deep in the areas without curb median, noted above, will actually spill over into the south-bound lanes.

## STORM SEWER HYDRAULICS

A hydraulic grade line analysis was performed on the storm sewer paralleling Jefferson Street. The storm sewer was determined to have a capacity of 28 cfs in the 24" reach between the curb drop inlets at points A and B. South of point B, the pipe size increases to a 30" diameter with a capacity of 46 cfs.

## PRIVATE ACCESS/RAINAGE EASEMENT HYDRAULICS

This analysis is provided to verify the capacity of the access road to convey flows off-site to Jefferson Street while maintaining depths under the maximums set in the DPM. Assume the access road conveys 100% of the runoff from lots A, B, C, D, E, F, G, and H and the runoff from the off-site basin (1.98 of mobile home park) east of the site.

Peak Discharge  
Proposed Conditions 100 year = 39.8 cfs x (1.24ac. + 1.21ac. + 1.21ac. + 1.40ac.)/9.4ac. + 7.1cfs = 28.5 cfs  
10 year = 25.5cfs x (1.24ac. + 1.21ac. + 1.21ac. + 1.40ac.)/9.4ac. + 4.3 cfs = 18.0 cfs

Street flow depths during peak flow were calculated using Manning's equation. Conjugate depths were calculated for flows in the super-critical state, should conditions be conducive to the formation a hydraulic jump.

- use mild slope region, S = 0.0075 ft/ft 2) n = 0.017 for the roadway surface, 3) road cross slope = 1.5%, 4) curb to curb distance = 25', 5) outside curb to inside driving lane = 13 ft, 6) six inch curbs.

The 100 year and 10 year storm peak flow depths are 0.35 ft and 0.26 ft, respectively. These depths are contained within the roadway prism and well below the DPM's maximum allowable depths.

## PRIVATE DRAINAGE EASEMENT HYDRAULICS

The following analyses were provided as guidelines for the development and utilization of the private drainage easements.

### Peak Flows:

C & D A C  
10' Drainage Easement Crossing Lots A and C  
Assume lots A & C drain 50% and 100%, respectively, of runoff to easement  
Peak Flow = (0.65ac x 0.5 + 0.65ac)/9.4ac. x 39.8 cfs = 7.2 cfs  
F & G F  
10' Drainage Easement crossing lot F  
Assume lots F & G drain 50% and 100%, respectively, of runoff to easement  
Peak Flow = (1.22ac. + 0.5 x 0.65ac)/9.4ac. x 39.8 cfs = 9.1 cfs  
1.56 9.1

For the purpose of this drainage plan the following two options were evaluated for the 10' drainage easements with peak flows of 7.2 cfs and 9.1 cfs.

### Concrete Rundown Option


using n = 0.013, slope = 2.0%, a rectangular channel with a width of 7 ft has a normal depth of 0.20 ft and a velocity of 5.3 fps. The resulting energy head is 0.64 ft. Use a rectangular channel with a depth of 0.67 ft and a width of 7.0 ft.  
Weir Equation (King and Brater) for entrance channel  
Capacity = C \* L \* (H\*\*3/2)  
C = Weir Factor = 2.6 L = Weir Length = 7ft  
H = Depth of Water  
Capacity = 2.6 \* 7.0ft \* (0.67ft\*\*3/2) = 9.8 cfs > 7.2 [ok]

### Landscaped Swale Option (assume a triangular cross section with 3:1 side slopes and grass surface)


using n = 0.025, slope = 2.0%, a normal depth of 0.75 ft and a velocity of 4.23 fps. The resulting energy head is 1.02 ft. Use a triangular channel with a depth of 1.5 ft, side slopes of 3:1 and a width of 9.0 ft.  
Weir Equation (King and Brater) for entrance channel  
Capacity = C \* L \* (H\*\*3/2)  
C = Weir Factor = 2.6 L = Weir Length = 9ft  
H = Depth of Water, use average depth  
Capacity = 2.6 \* 9.0ft \* (0.75ft\*\*3/2) = 15.2 cfs > 9.1 [ok]

## CONCLUSIONS AND RECOMMENDATIONS

The analysis presented in this drainage plan demonstrate that under existing conditions, flows entering Jefferson Street are such that the DPM 10 year criteria is exceeded. Further, the planned development will not significantly alter the flow conditions in Jefferson under the existing conditions. Under both existing and developed flow conditions storm water is contained within the right of way. Depths shown in the table are actually conservative due to the fact that the flows are allowed to pass to the south-bound side of Jefferson where median curb does not exist. Additionally, it is likely that development of the property to the south will utilize the existing stub at the second inlet (analysis point B) and realize the full benefit of the existing of the storm sewer system, further decreasing the flows in the roadway assumed under this plan. Lastly, it should be noted that this project is an in-fill project with existing infrastructure designed and constructed under older criteria. In consideration of the information presented under this drainage plan, a variance from the DPM 10 year criteria is requested.

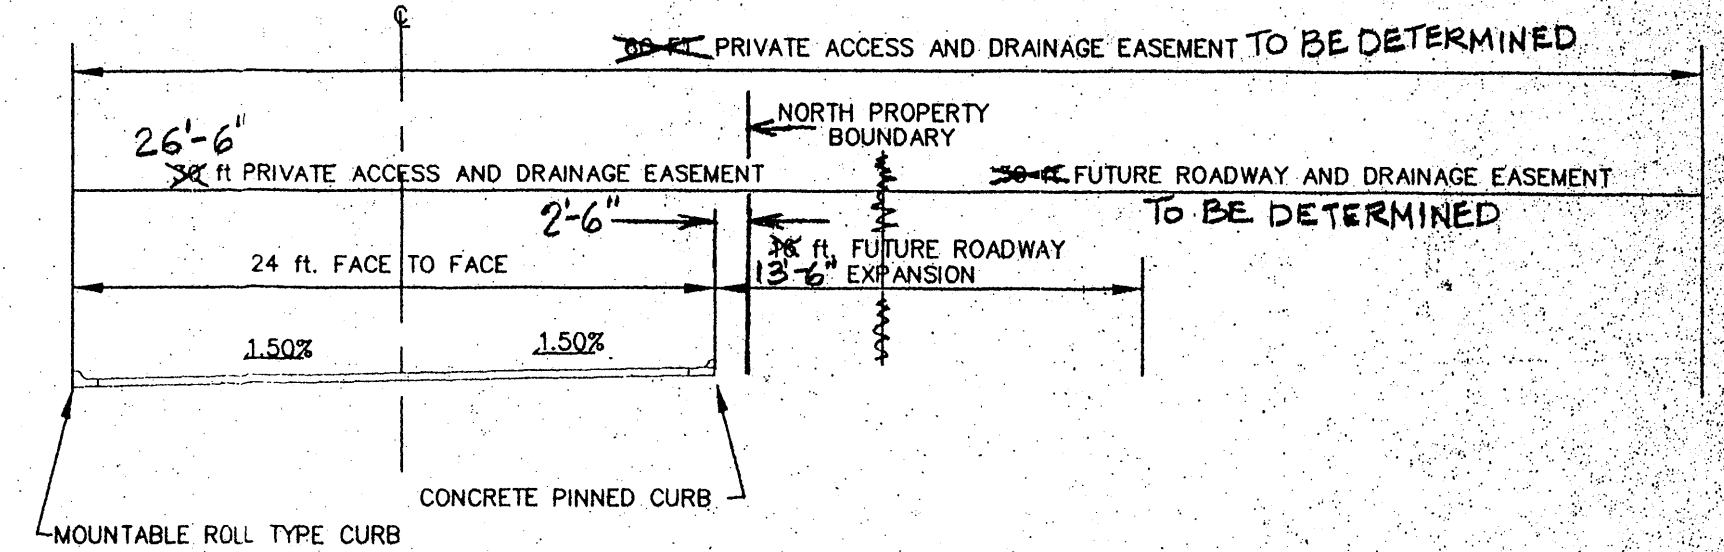

TYPICAL SECTION A-A' - PRIVATE ACCESS ROAD  
NOT TO SCALE

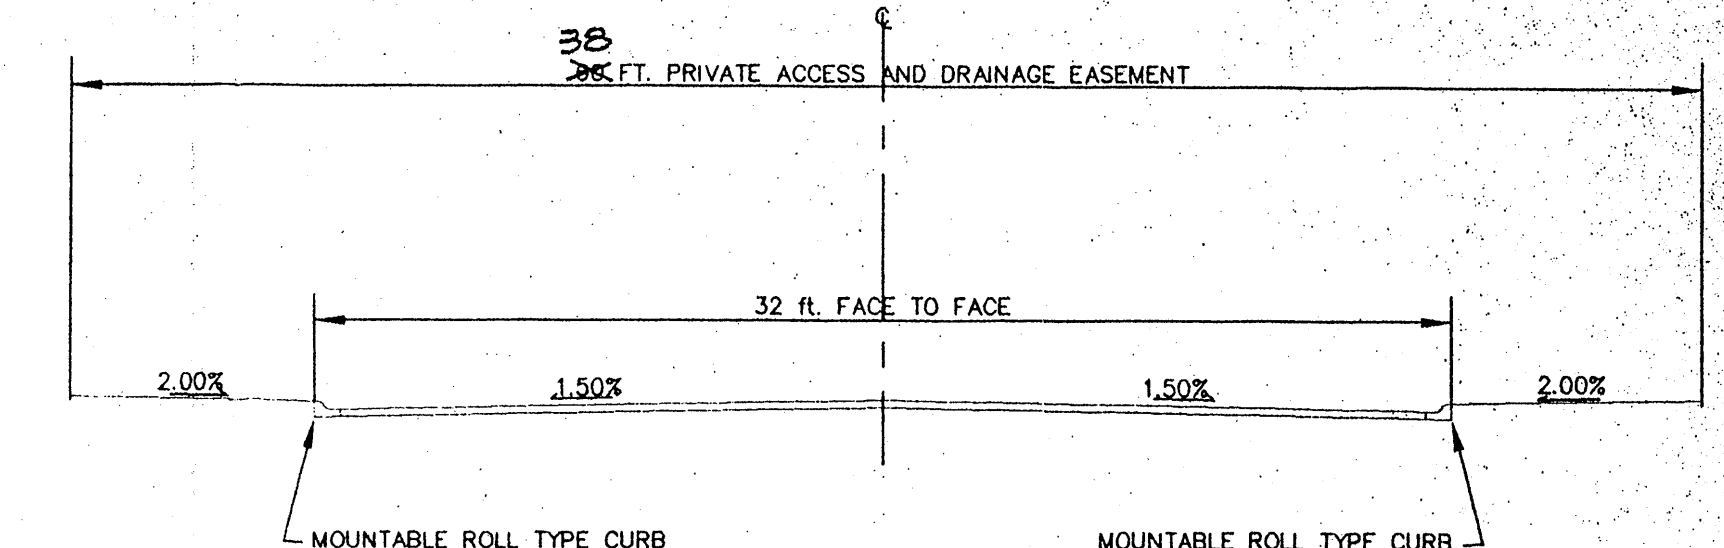


TYPICAL SECTION B-B' - PRIVATE ACCESS ROAD  
NOT TO SCALE

GRADING AND DRAINAGE CERTIFICATION Carlos G. Padilla (6/17/97)

I, CARLOS G. PADILLA, A PROFESSIONAL ENGINEER DULY REGISTERED IN THE STATE OF NEW MEXICO, HAVING CONDUCTED A SITE INSPECTION AND HAVING DIRECTED THE COLLECTION OF AS-BUILT SURVEY INFORMATION BY PRECISION SURVEYS, INC. (NEW MEXICO PROFESSIONAL SURVEYOR #11993, AGENT FOR THE OWNER), CERTIFY THAT THE SITE GRADING AND DRAINAGE IMPROVEMENTS ARE COMPLETE AND SUBSTANTIALLY COMPLY WITH THE APPROVED DRAINAGE REPORT AND CONSTRUCTION PLANS.

TRACT 14-A-2  
DRAINAGE AND GRADING PLAN  
PLATE 1

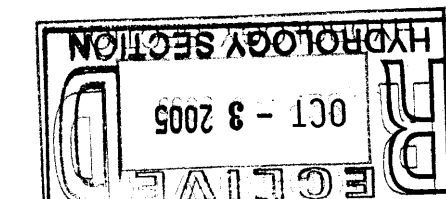

AVID ENGINEERING  
Civil • Structural • Transp  
5800 Osuna Rd. NE  
Albuquerque, NM 87109




# JEFFERSON STREET INDUSTRIAL PARK-GRADING AND DRAINAGE PLAN FOR SUBDIVISION

ANALYSIS POINT B

BASIN E

JEFFERSON ST. R.O.W. 0.60 ACRES

ANALYSIS POINT A

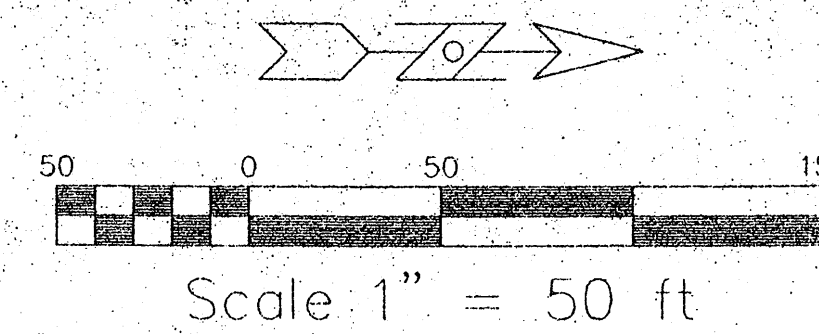

## LEGEND

- |                           |                              |                          |
|---------------------------|------------------------------|--------------------------|
| - 51.30 - CONTOUR (MAJOR) | - - - LIQUID NITROGEN LINE   | → FLOW LINE              |
| - - - CONTOUR (MINOR)     | - - - GAS LINE               | ▬ BASIN BOUNDARY         |
| — CURB AND GUTTER         | - - - SANITARY SEWER LINE    | ○ SANITARY SEWER MANHOLE |
| ▨ CONCRETE/SIDEWALK       | - - - WATER LINE             | ✕ WATER VALVE            |
| △ SIGN                    | ✕ FIRE HYDRANT               | - - - STORM SEWER LINE   |
| ○ CHAIN LINK FENCE        | ○ STORM SEWER MANHOLE        | ▬ DROP INLET             |
| ✕ WOOD FENCE              | - - - OVERHEAD ELECTRIC LINE |                          |
| • POLE                    |                              |                          |
| → ANCHOR                  |                              |                          |

BASIN C

JEFFERSON ST. R.O.W. 0.70 ACRES

BASIN D

12.8 ACRES

VACANT LOT

BASIN A

SUBJECT SITE 9.4 ACRES

FUTURE RESERVOIR SITE

MOBILE HOME PARK

MOBILE HOME PARK

BASIN B

MOBILE HOME PARK 1.9 ACRES

OFF-SITE FLOWS FROM EAST INTERCEPTED BY BROOK STREET (PUBLIC STREET)

WATER BLOCK



PRIVATE ACCESS, PRIVATE DRAINAGE & PUBLIC WATER EASEMENT GRANTED BY THIS PLAT SEE NOTES 6 & 10.

LOT 15 DISCHARGES TO POINTS NORTH OF WATER BLOCK

EXISTING 5' PUBLIC UTILITY EASEMENT 8/26/81 VOL. C18 FOLIO 171



TRACT 14-A-2  
DRAINAGE AND GRADING PLAN  
PLATE 2

**AVID** ENGINEERING, INC.  
Civil • Structural • Transportation  
5800 Osuna Rd. NE - Suite 200  
Albuquerque, NM 87109 - (505) 881-5357

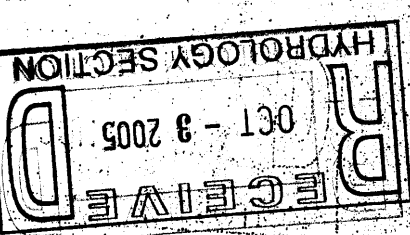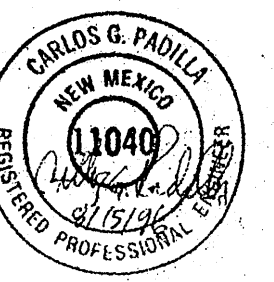



A.C.S. MONUMENT "NDC 7"  
STANDARD A.C.S. BRASS TABLET  
(FOUND IN PLACE)  
NEW MEXICO STATE PLANE COORDINATES  
(CENTRAL ZONE-N.A.D. 1927)  
X=394,094.80  
Y=1,522,635.84  
GROUND TO GRID FACTOR=0.99967075  
DELTA ALPHA ANGLE=-0°12'15"

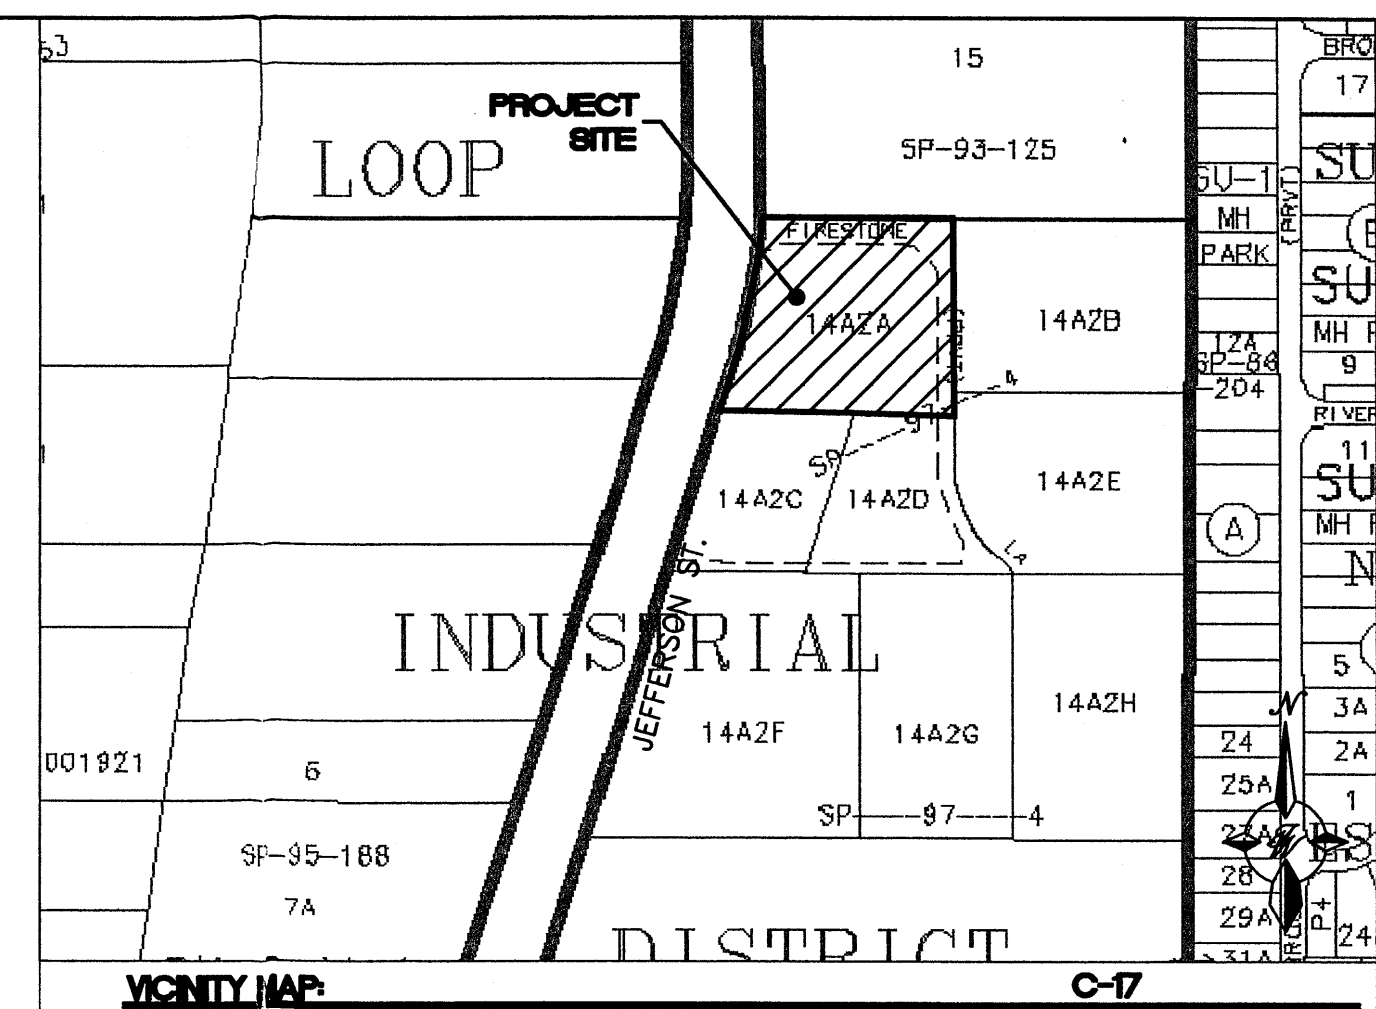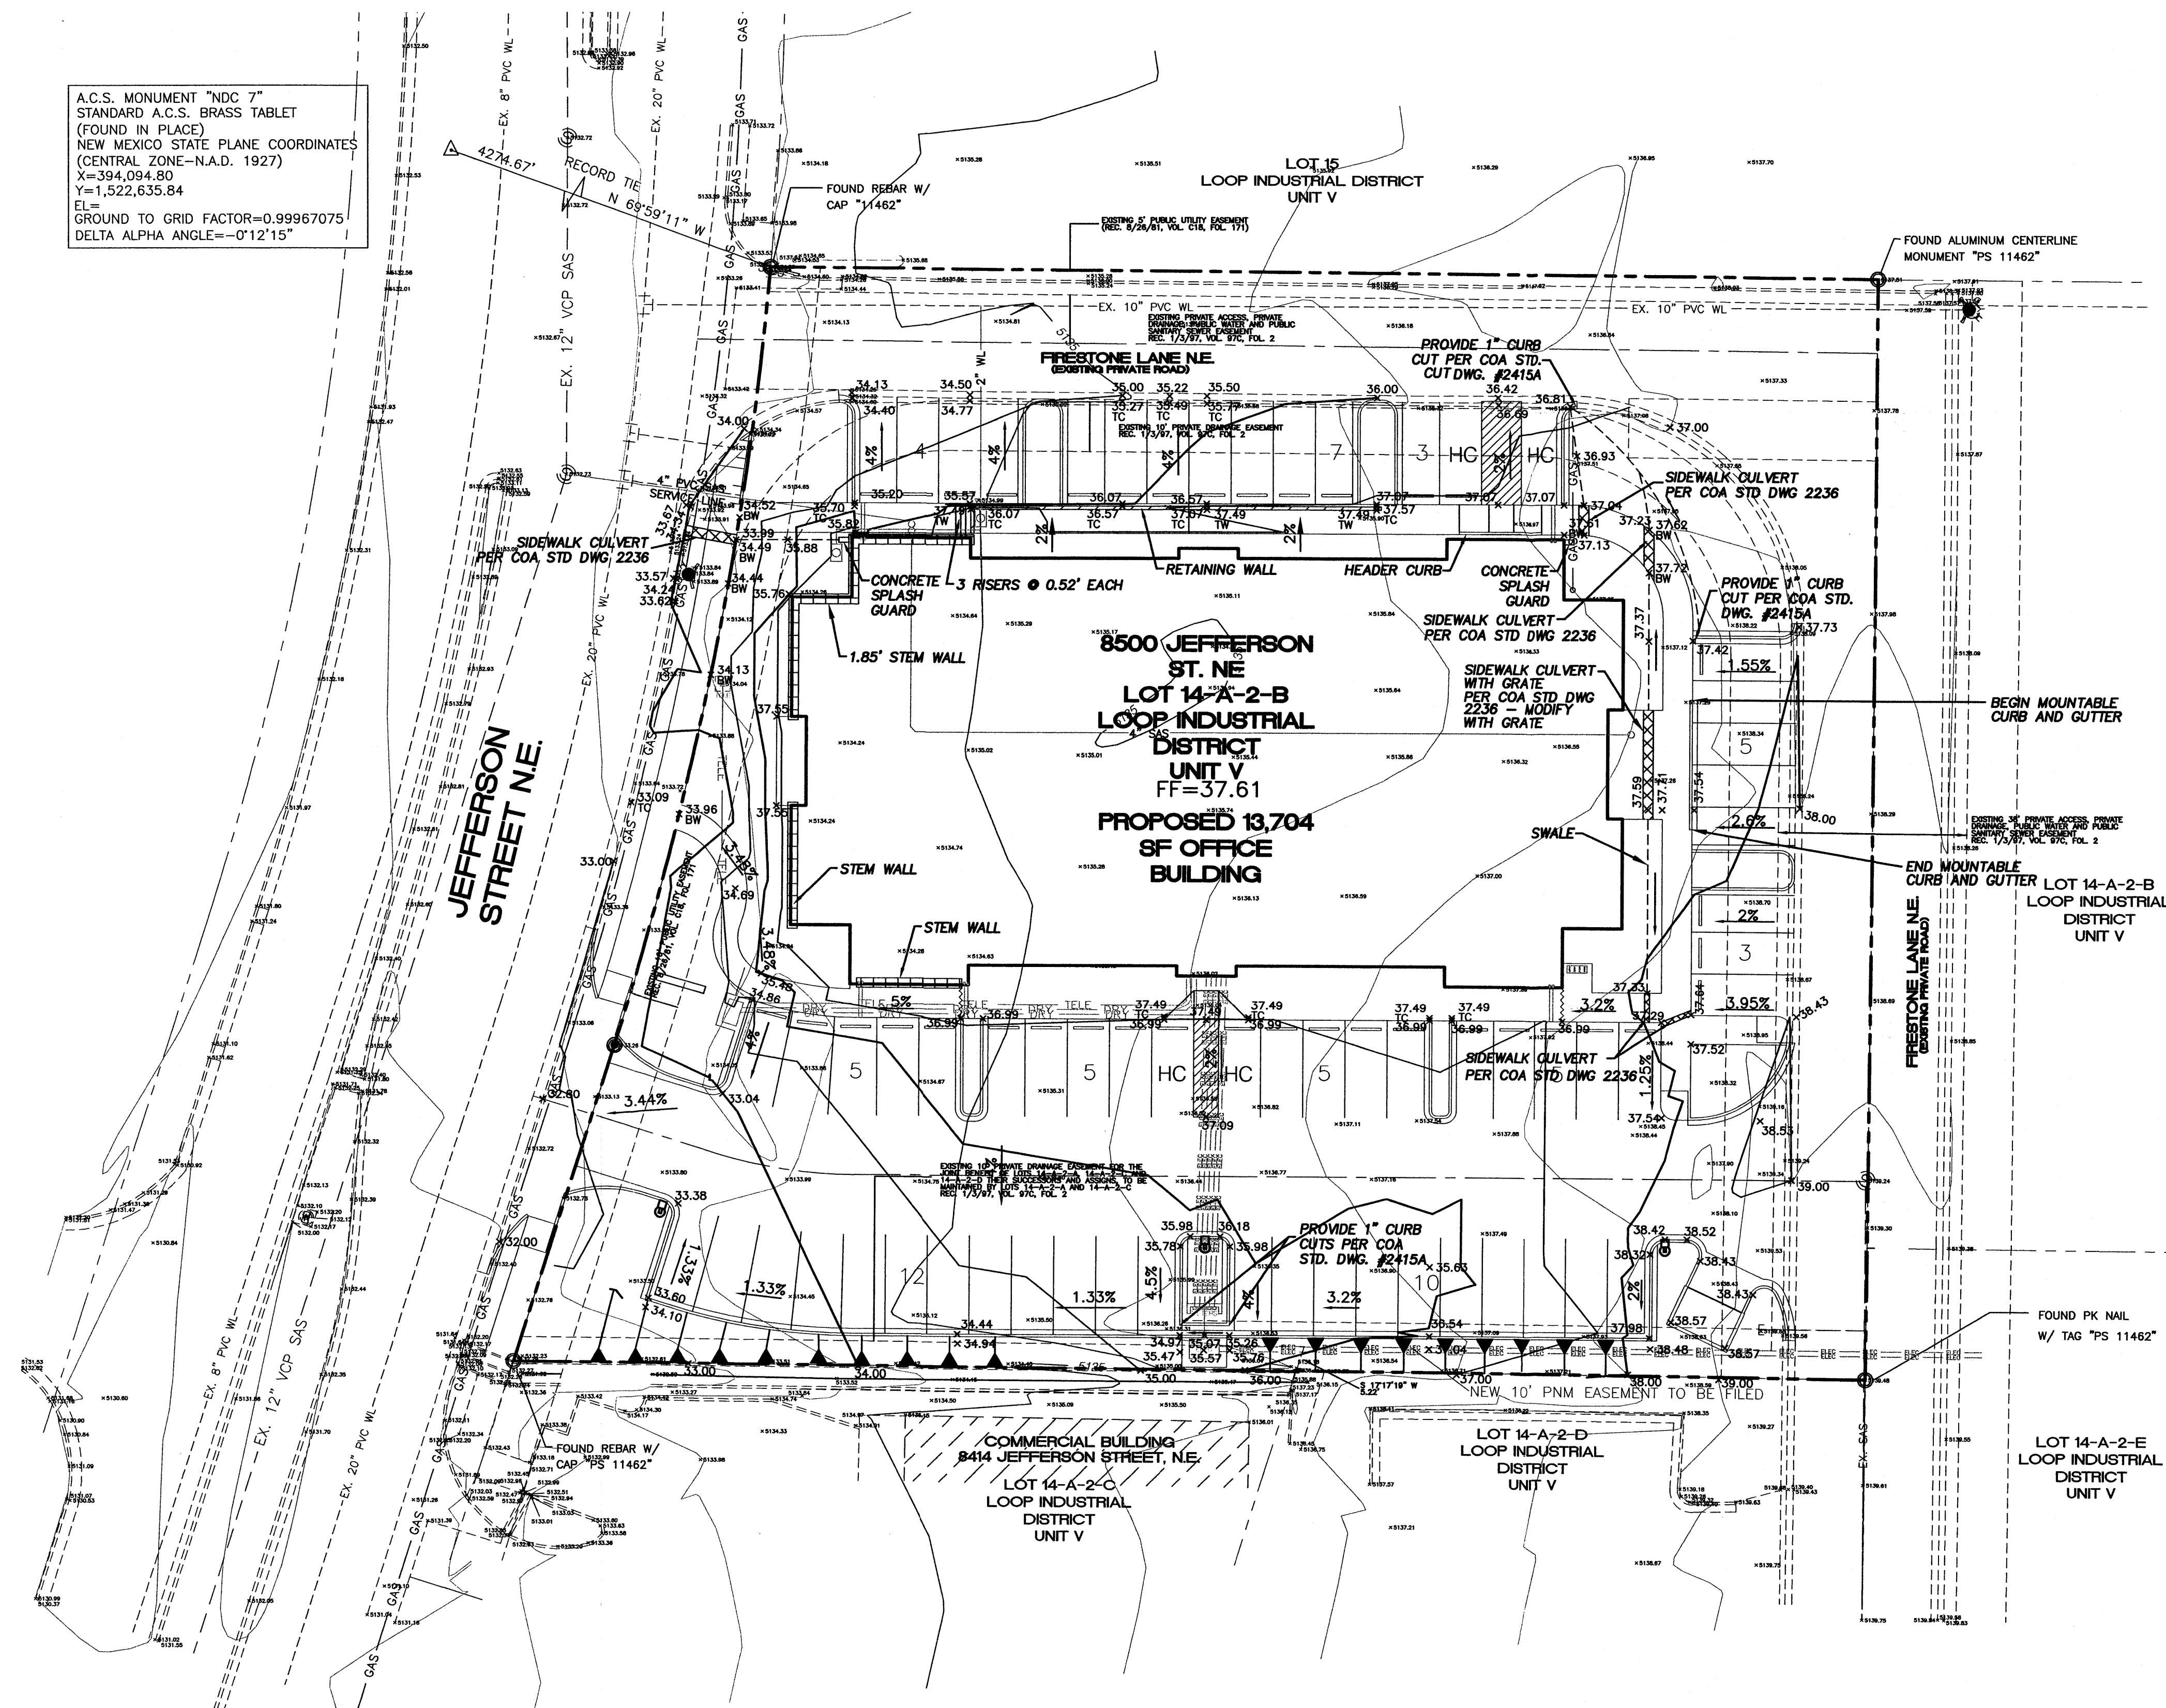

#### LEGEND

- EXISTING CURB & GUTTER
- PROPOSED CURB
- BOUNDARY LINE
- PROPOSED RETAINING WALL
- PROPOSED STEM WALL
- EXISTING CONTOUR
- EXISTING INDEX CONTOUR
- FLOW ARROW
- SLOPE TIE
- PROPOSED SPOT ELEVATION
- EXISTING SPOT ELEVATION


#### GENERAL NOTES:

- ALL CONCRETE IS TO BE 4000 PSI @ 28 DAYS.
- MINIMUM COMPACTION UNDER FOOTINGS IS TO BE 95% PER ASTM D 1557 FOR A DEPTH OF 12" MOISTURE CONTENT IS TO BE  $\pm 2.0\%$ .
- BACKFILL AGAINST WALLS IS TO BE HAND-PLACED AND COMPACTED.
- ALL BARS ARE TO BE GRADE 60, ASTM 615.
- TRUSS TYPE DRAINAGE WALL EVERY OTHER COURSE.
- DOWELS SHALL BE AT LEAST EQUAL IN SIZE AND SPACING TO V-BARS, SHALL PROJECT A MINIMUM OF 30 BAR DIA. INTO THE FILLED BLOCK CORES, AND SHALL EXTEND TO THE TOE OF THE FOOTING.
- JOINT REINFORCEMENT CONSISTING OF 9GA. LONGITUDINAL WIRE AND 3/16" CROSS RODS SHALL BE PROVIDED AT 8" CENTERS VERTICALLY.
- PROVIDE KEY FOR 8" AND 12" WALLS WHERE H EXCEEDS 6'-0" USE EITHER EXPANSION JOINTS ON 20' CENTERS OR PILASTERS EVERY 16'.
- ALL SPOT ELEVATIONS ARE TRUNCATED FROM 5100 AND REPRESENT FLOWLINE ELEVATION UNLESS OTHERWISE NOTED. (TC= TOP OF CURB) (BW= BACK OF SIDEWALK) (TW= TOP OF WALL)

#### EROSION CONTROL NOTES

- CONTRACTOR IS RESPONSIBLE FOR OBTAINING A TOPSOIL DISTURBANCE PERMIT PRIOR TO BEGINNING WORK.
- CONTRACTOR IS RESPONSIBLE FOR MAINTAINING RUN-OFF ON SITE DURING CONSTRUCTION.
- CONTRACTOR IS RESPONSIBLE FOR CLEANING ALL SEDIMENT THAT GETS INTO EXISTING RIGHT-OF-WAY.
- REPAIR OF DAMAGED FACILITIES AND CLEANUP OF SEDIMENT ACCUMULATIONS ON ADJACENT PROPERTIES AND IN PUBLIC FACILITIES IS THE RESPONSIBILITY OF THE CONTRACTOR.
- ALL EXPOSED EARTH SURFACES MUST BE PROTECTED FROM WIND AND WATER EROSION PRIOR TO FINAL (CITY) ACCEPTANCE OF ANY PROJECT.

GRAPHIC SCALE

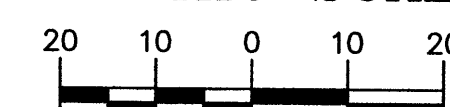


SCALE: 1"=20'


#### GRADING PLAN

**TIERRA WEST, LLC**  
8509 JEFFERSON NE  
ALBUQUERQUE, NEW MEXICO 87113  
(505)858-3100  
JOB # 24049

#### For Construction

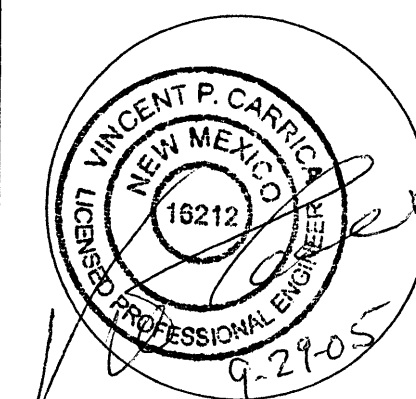

Project ID: 24049  
Path: z:\projects\24049\Drawings\DRW\24049GRD-9-28-05.dwg  
Original Issue Date: 9-28-05  
Drawn By: DY  
Reviewed By: VC

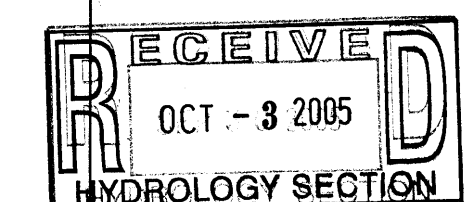

Project: JLM Investments  
Phase: Construction

**C3.0**

Drawing Number:  
Building Owner / JLM  
Client: Investments  
Project:  
Address: 8509 Jefferson St.  
N.E.  
Albuquerque, NM