




APPROVALS	NAME	DATE
INSPECTOR		


ADVISED TO OBTAIN INDEPENDENT

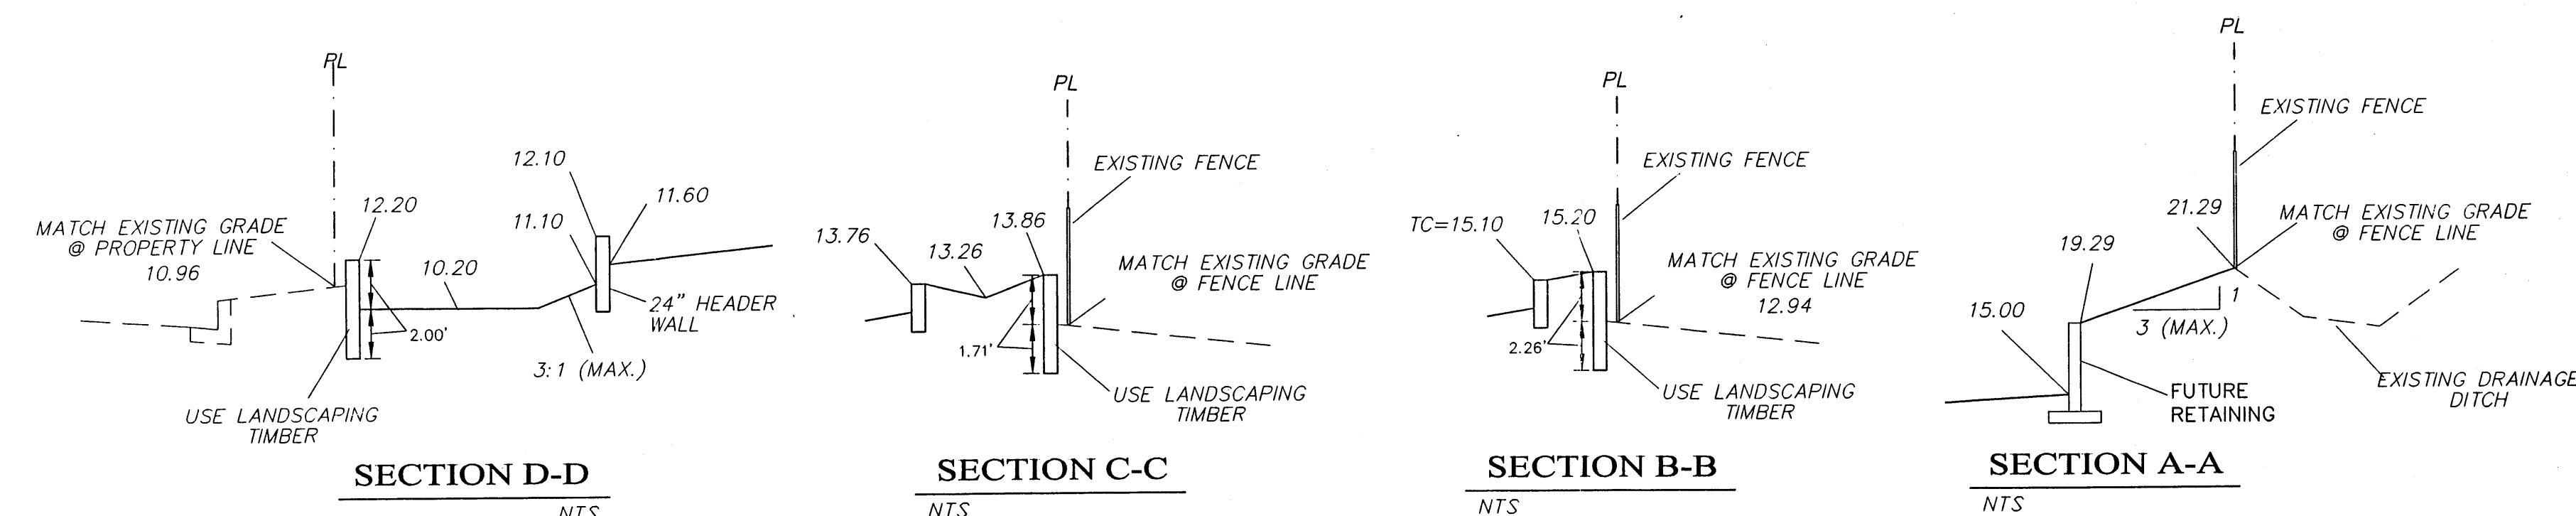


SHAHAB BIAZAR, NMPE # 13479

7/16/03

DATE

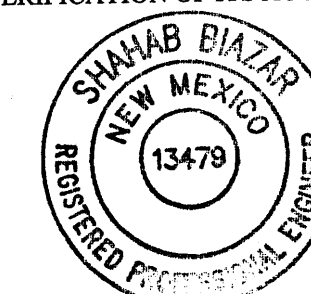


LEGEND

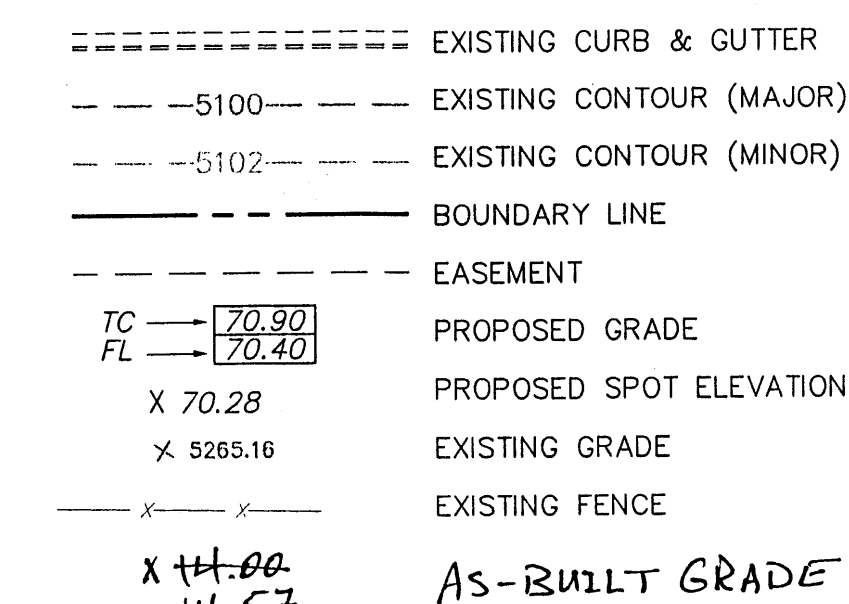

ROUGH GRADING APPROVAL	DATE
------------------------	------

GENERAL NOTES:

- 1: ADD 510C TO SPOT ELEVATIONS TO SHOW TRUE ELEVATION.
- 2: CONTOUR INTERVAL IS ONE (1) FOOT.
- 3: ELEVATIONS ARE BASED ON CITY OF ALBUQUERQUE CONTROL STATION HAVING AN ELEVATION OF 5102.95 FEET ABOVE SEA LEVEL.
- 4: UTILITIES SHOWN HEREON ARE IN THEIR APPROXIMATE LOCATION BASED ONLY ON ABOVE GROUND EVIDENCE FOUND IN THE FIELD AND AS-BUILT INFORMATION PROVIDED BY THE CLIENT. UTILITIES SHOWN HEREON, WHETHER INDICATED AS ABANDONED OR NOT, SHALL BE VERIFIED BY OTHERS FOR EXACT LOCATION AND/ OR DEPTH PRIOR TO EXCAVATION OR DESIGN CONSIDERATIONS.
- 5: THIS IS NOT A BOUNDARY SURVEY. BEARINGS ARE ASSUMED, DISTANCES AND FOUND PROPERTY CORNERS ARE FOR INFORMATIONAL PURPOSES ONLY.
- 6: SLOPES ARE AT 3:1 MAXIMUM.

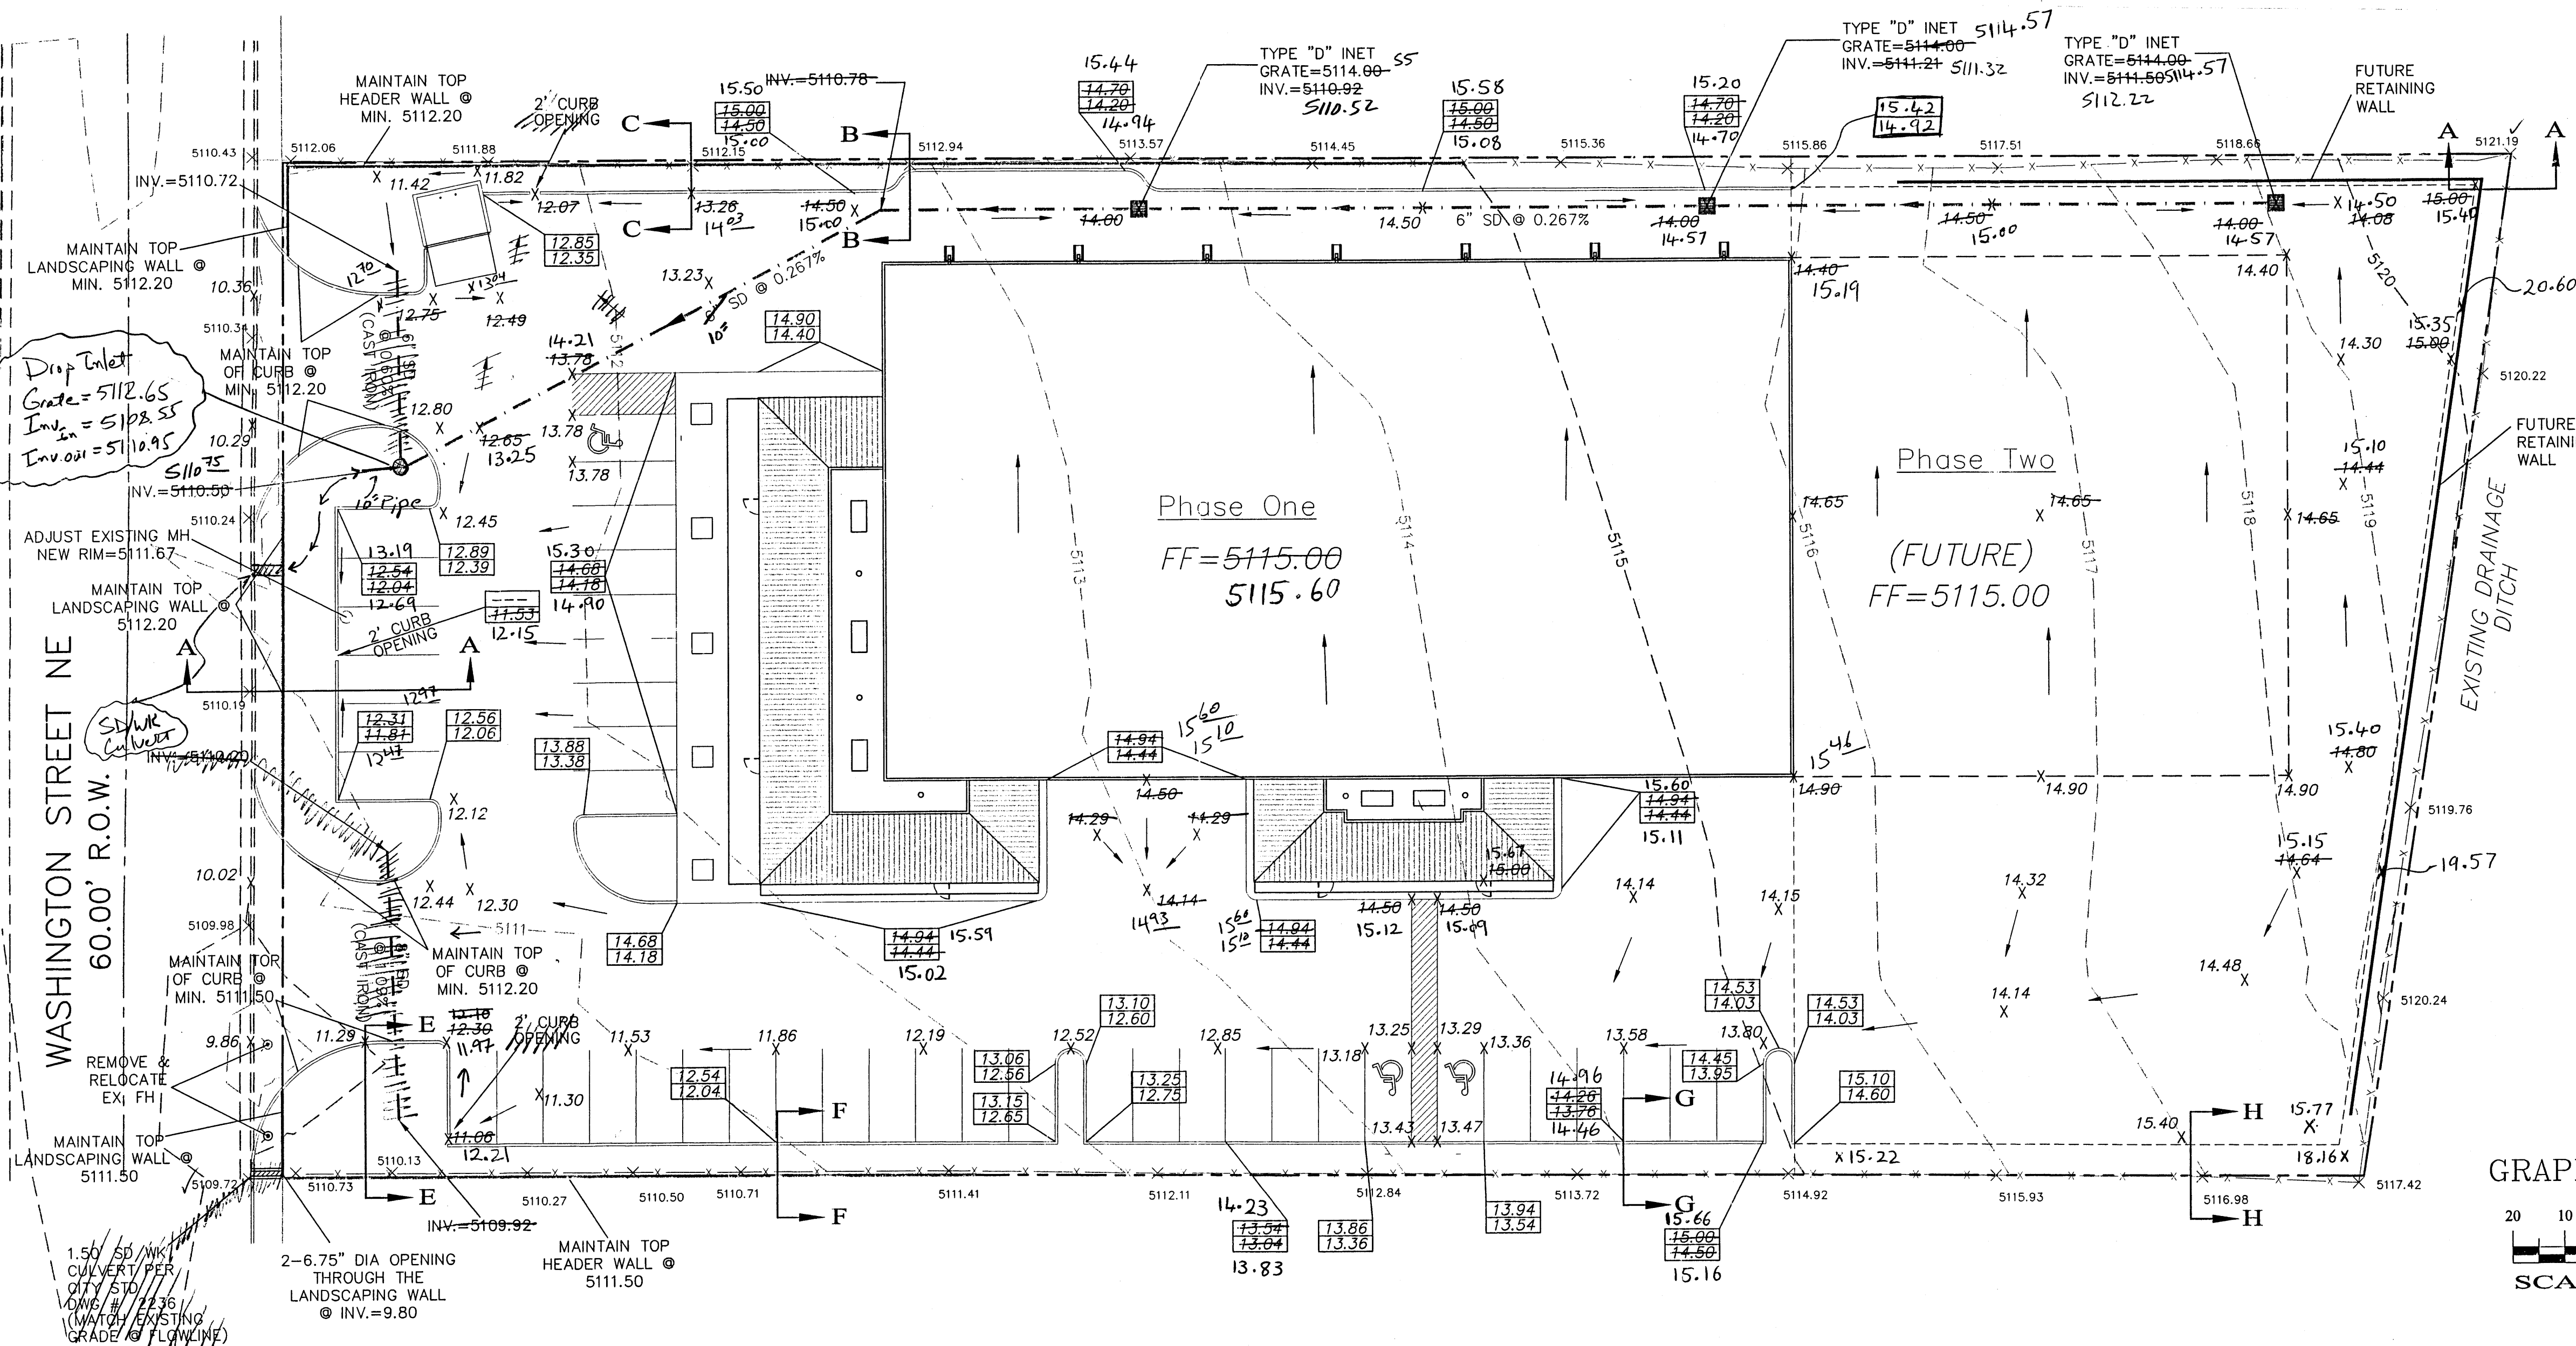

SCALE: 1"=20'



10205 SNOWFLAKE CT., NW
ALBUQUERQUE, NEW MEXICO 87114
(505)899-5570

DRAWING: 200206-GR.DWG	DRAWN BY: SBB	DATE: 03-08-2002	SHEET # 1 OF 1
---------------------------	------------------	---------------------	-----------------------

1 OF 1