CITY OF ALBUQUERQUE



June 4th, 2018

John Mahony, R.A. John Mahony Architect 850 W. Elloit Rd. #108 Tempe, AZ 85284

Re: American Toyota

5995 Alameda NE, Albuquerque, NM 87113 30-Day Temporary Certificate of Occupancy- Transportation Development Transportation Development Final Inspection Engineer's/Architect's Stamp dated 12-18-14 (C18-D012) Cert date 04-24-18

Dear Mr. Soule

Based upon the information provided in your submittal received 5-29-18, Transportation Development has no objection to the issuance of a <u>30-day Temporary</u> <u>Certificate of Occupancy</u>. This letter serves as a "green tag" from Transportation Development for a <u>30-day Temporary Certificate of Occupancy</u> to be issued by the Building and Safety Division.

Prior to the issuance of a permanent Certificate of Occupancy, the following items must be addressed:

- 1. The ADA accessible parking sign must have the required language per 66-7-352.4C NMSA 1978 "Violators Are Subject to a Fine and/or Towing." If that language is present it is not visible in the detail.
- 2. Please add parking bumpers to the two center ADA accessible spaces where the pavement is flush with the ADA ramp.
- 3. Motorcycle parking spaces shall be designated by its own conspicuously posted upright sign, either free-standing or wall mounted per the zoning code.
- 4. Please close the unused curb cut on San Pedro Dr. at the north end of the site with curb & gutter (Standard Drawing 2415) and sidewalk (Standard Drawing 2430).

Once corrections are complete resubmit acceptable package along with fully completed Drainage Transportation Information Sheet to front counter personnel for log in and evaluation by Transportation. For digital submittal and minor comments and/or repairs, please submit photos to <u>PLNDRS@cabq.gov</u> prior to submittal. If you have any questions, please contact me at (505) 924-3981.

Sincerely,

Logan Patz

Senior Engineer, Planning Dept. Development Review Services

Ernie Gomez Plan Checker, Planning Dept. Development Review Services

PO Box 1293

Albuquerque

NM 87103


www.cabq.gov

EG C:

via: email CO Clerk, File

PROJECT NUMBER: 1002848 Application Number: This Plan is consistent with the specific Site Development Plan approved by the Environmental Planning Commission (EPC), dated 8 - 15 - 14 and the Findings and Conditions in the Official Notification of Decision are satisfied. Is an infrastructure List required? () Yes () No If yes, then a set of approved DRC plans with a work order is required for any construction within Public Right-of-Way or for construction of public improvements. DRB SITE DEVELOPMENT PLAN SIGNOFF APPROVAL: MERCEOES BENZ AUTD DEALERSHIP Traffic Engineering, Transportation Division 3/25/15 Date 03/25/15 Date I, DAVID SOULE, OF THE FIRM RIO GRANDE ENGINEERING Month Caden HERE BY CERTIFY THE SITE HAS BEEN CONSTRUCTED IN CONFROMANCE TO THE APPROVED SITE DEVELOPMENT PLAN 03/25/18 avol S. Dumont THE BUILDING AND SITE WAS CONSTRUCTED IN Parks and Recreation Department 07-10-15 fint a she a Role PHASES TO ALLOW OPERATION OF EXISTING BUSINESS THIS CERTIFICATION IS FOR THE ENTIRE SITE AND City Engineer FOR CERTIFICATE OF OCCUPANCY 10-20-14 Date ENTIRE SITE Solid Waste Management 7 - 10 - 15 Date DR9 Chairperson, Planning Department SU-2 4/24/18 PDRSCHE/AUDI AUTD OEALERSHIP CURVE TABLE CURVE LENGTH RADIUS CHORD BEARING CHORD | DELTA C1 81.37 76.00 77.54 61°20'43" N30°51'00"E 44.33 100.00 S31°52'41''W 43.97 N22°26'21"E N44°52'33"W
 C3
 115.92
 150.00

 C4
 39.35
 25.00
113.06 44°16'41" 35.41 90°11'15" S00°13'23"W, 29.79' (24) S89°42'00"E 427,50 PRIVATE FACILITY DISPLAY DRAINAGE COVENANT TR, A-1 ______ -----____ _____ _____ _ _ ____ - -- --- ----_____ _____ ---------_____ ----____ _____ _____ _____ --do------------------------____ _____ ____ - 20' + 20' -, N84°25'53"W

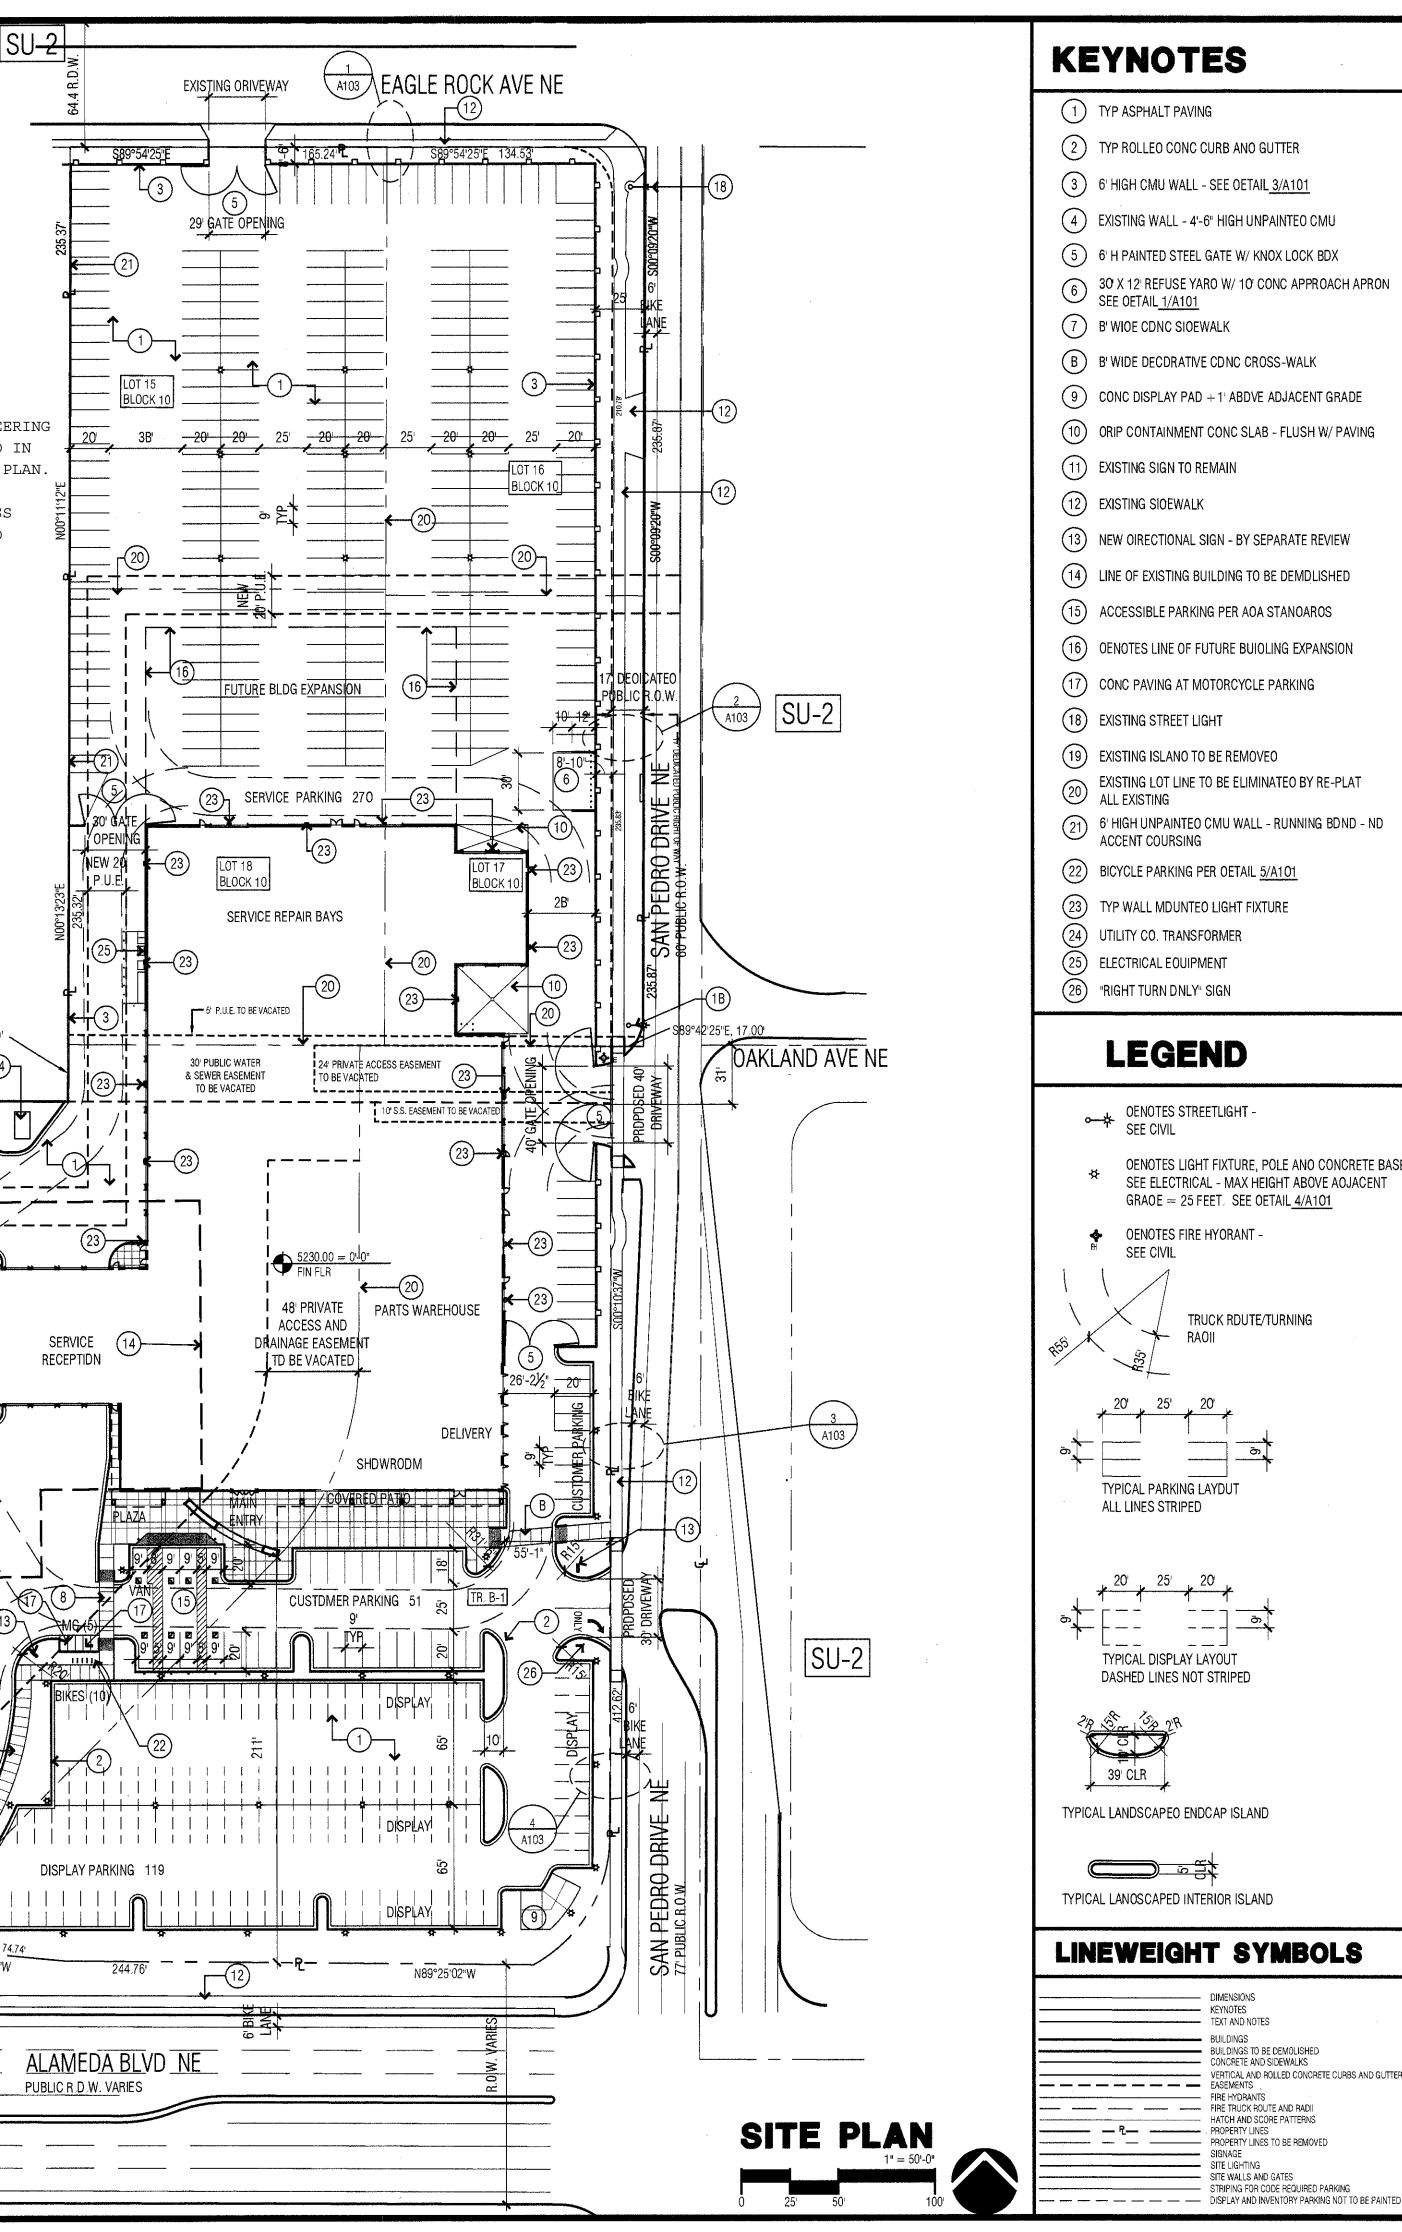



6 30 X 12' REFUSE YARO W/ 10' CONC APPROACH APRON SEE OETAIL <u>1/A101</u>

(9) CONC DISPLAY PAD $+ 1^{1}$ ABDVE ADJACENT GRADE

OENOTES LIGHT FIXTURE, POLE ANO CONCRETE BASI SEE ELECTRICAL - MAX HEIGHT ABOVE AOJACENT GRAOE = 25 FEET, SEE OETAIL 4/A101

TRUCK RDUTE/TURNING

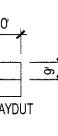

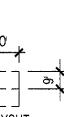

- DIMENSIONS ---- KEYNOTES ----- TEXT AND NOTES BUILDINGS BUILDINGS TO BE DEMOLISHED ----- CONCRETE AND SIDEWALKS VERTICAL AND ROLLED CONCRETE CURBS AND GUTTERS ------ FIRE HYDRANTS ----- FIRE TRUCK ROUTE AND RADII ---- HATCH AND SCORE PATTERNS ------ PROPERTY LINES PROPERTY LINES TO BE REMOVED SIGNAGE

- SITE WALLS AND GATES

PROJECT INFORMATION

LARRY H. MILLER AMERICAN TDYOTA 5995 ALAMEOA BLVO NE MILLER FAMILY REAL ESTATE 9350 S. 150 E STE 1000 SANDY, UTAH B4070-2721

DEMOLITION AND RECONSTRUCTION OF EXISTING AUTDMDBILE SALES AND SERVICE FACILITY, ANO RELATEO SITE IMPRDVEMENT

SU-2 SPECIAL NEIGHBORHOOO ZONE SU-1/SU-2 FDR AUTOMOTIVE SALES, SERVICE ANO REPAIR 10.1391 ACRES

9,52 ACRES

B9,772 S.F. 73,732 S.F. 16,255 S.F.

B, S-1 II-B WITH AUTOMATIC FIRE SPRINKLER SYSTEM

LEGAL OESCRIPTION TRACTS A-1 ANO B-1, AMERICAN TOYOTA, ALBUOUERQUE, BERNALILLD COUNTY, NEW MEXICO, AS THE SAME ARE SHOWN ANO OESIGNATEO ON THE PLAT THEREDF FILED IN THE DFFICE DF THE COUNTY CLERK DF BERNALILLO CDUNTY, NEW MEXICO, DN SEPTEMBER 24, 2004, IN PLAT BOOK 2004C, FOLIO 300

PROJECT NAME PROJECT AOORESS

PRDJECT DESCRIPTION

ZDNING (EXISTING)

ZDNING (PROPOSEO)

GROSS SITE AREA

GRDSS BUILOING AREA

GRDUNO FLDDR AREA

SECONO FLOOR AREA

CDNSTRUCTION TYPE

NET SITE AREA

OCCUPANCY


DWNER


LOTS NUMBEREO FIFTEEN (15), SIXTEEN (16), SEVENTEEN (17) AND EIGHTEEN (1B) IN BLOCK NUMBERED TEN (10) OF TRACT LETTEREO "A", UNIT LETTEREO "B" DF NDRTH ALBUQUERDUE ACRES, AS THE SAME ARE SHDWN AND DESIGNATEO ON THE PLAT THEREOF, FILEO IN THE OFFICE OF THE CLERK DF BERNALILLO COUNTY, NEW MEXICO ON APRIL 24, 1936, IN PLAT BDOK 0, FOLIO 130A.

PARKING CALCULATIONS

BUILOING ZONE	AREA	REQUIREMENT	SUB-TOTAL REOUIREO
SHDWROOM/ OFFICE	31,9B4	1/200 0-15,000 1/250 15,000 - 31,9B4	75 6B
PARTS WAREHDUSE	14,57B	1/2000	В
SERVICE BAYS	43,210	1/1000	44
SUBTDTAL 10% REOUCTION PER 14-16-3-1 (6)(a)			195 -19
TOTAL PARKING REQUIRED			176
ACCESSIBLE PARKING TOTAL REQUI	В		
MDTORCYCLE PARKING REQUIREO (101-150)			5
BICYCLE PARKING REC	9		
TDTAL PARKING PRDVIOEO			321
ACCESSIBLE PARKING PROVIDED			В
MOTORCYCLE PARKING PROVIOEO			5
BICYCLE PARKING PRO	10		

NDTE: TREE CANDPY SHALL CDUNT TDWARDS THE 75% VEGETATIVE GRDUND CDVER REQUIREMENTS PER THE NDRTH I-25 SECTDR DEVELOPMENT PLAN

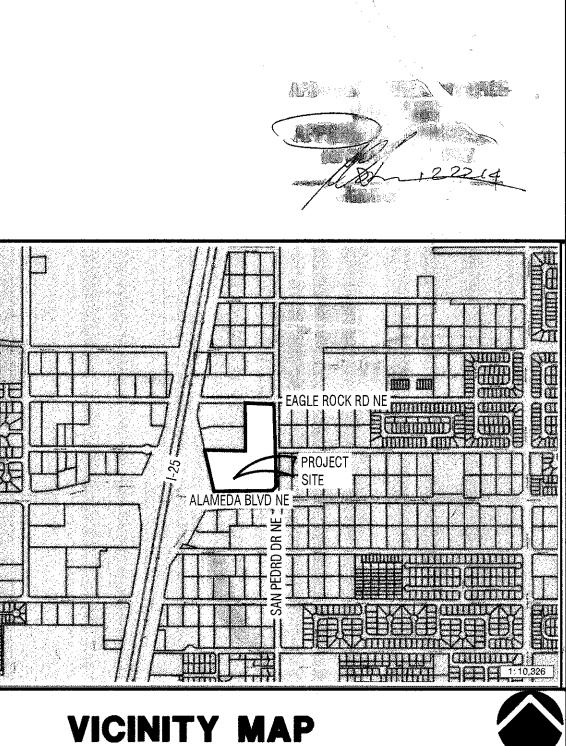

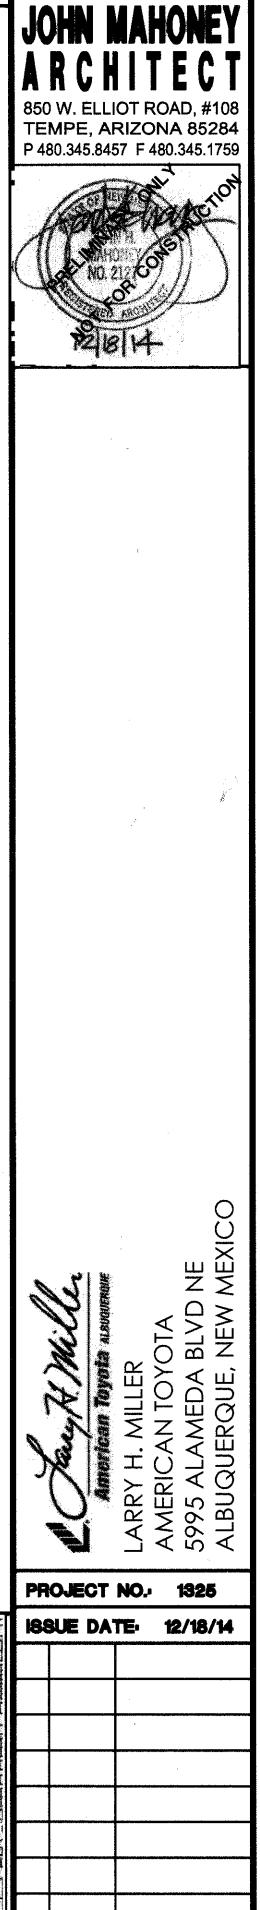

SITE PLAN



RIO GRANDE ENGINEERING OF NEW MEXICO, LLC

TRAFFIC CERTIFICATION

I, DAVID SOULE, NMPE, OF THE FIRM RIO GRANDE ENGINEERING, HEREBY CERTIFY THAT THIS PROJECT IS IN SUBSTANTIAL COMPLIANCE WITH AND IN ACCORDANCE WITH THE DESIGN INTENT OF THE APPROVED SITE PLAN DATED 12/18/14, APPROVED 7/10/15. THE RECORD INFORMATION EDITED ONTO THE ORIGINAL DESIGN DOCUMENT HAS BEEN OBTAINED BY GARY GRITSKO NMPLS 8686 OF THE FIRM CONSTRUCTION ALPHA PRO SURVEY. I FURTHER CERTIFY THAT I HAVE PERSONALLY VISITED THE PROJECT SITE ON 4/15/18 AND HAVE DETERMINED BY VISUAL INSPECTION THAT THE SURVEY DATA PROVIDED IS REPRESENTATIVE OF ACTUAL SITE CONDITIONS AND IS TRUE AND CORRECT TO THE BEST OF MY KNOWLEDGE AND BELIEF. THIS CERTIFICATION IS SUBMITTED IN SUPPORT OF A REQUEST FOR CERTIFICATE OF OCCUPANCY.

EXCEPTIONS: NONE

THE RECORD INFORMATION PRESENTED HEREON IS NOT NECESSARILY COMPLETE AND INTENDED ONLY TO VERIFY SUBSTANTIAL COMPLIANCE OF THE TRAFFIC ASPECTS OF THIS PROJECT. THOSE RELYING ON THE RECORD DOCUMENT ARE ADVISED TO OBTAIN INDEPENDENT VERIFICATION OF ITS ACCURACY BEFORE USING IT FOR ANY OTHER PURPOSE.



Signature of Engineer

4/24/18 Date



City of Albuquerque

Planning Department

Development & Building Services Division

DRAINAGE AND TRANSPORTATION INFORMATION SHEET

(REV 02/2013)

Project Title: American Toyota	Building Permit #:	City Drainage #: C18d012	
DRB#: EPC#:		Work Order#:	
Legal Description: Tracts A1 and B-1, American Toyota and lots 15	5-18 tract a unit b NAA		
City Address: 5995 Alameda NE			
Engineering Firm: RIO GRANDE ENGINEERING	Contact: DAVID SOULE		
Address: PO BOX 93924, ALBUQUERQUE, NM 87199			
Phone#: 505.321.9099 Fax#: 505.8			
Owner: miller family group		Contact:	
Address:			
Phone#: Fax#:	#: Fax#:		
Architect: john mahony		Contact:	
Address:			
Phone#: Fax#:	Fax#:		
Surveyor: CONSTRUCTION SURVEY INCORPORATED		Contact: JOHN GALLEGOS	
Address:			
Phone#: 917.8921 Fax#:		E-mail:	
Contractor:		Contact:	
Address:			
Phone#: Fax#:		E-mail:	
TYPE OF SUBMITTAL:	CHECK TYPE OF APPROV	AL/ACCEPTANCE SOUGHT:	
DRAINAGE REPORT	SIA/FINANCIAL GUARANTEE RELEASE		
DRAINAGE PLAN 1st SUBMITTAL	PRELIMINARY PLAT APPROVAL		
DRAINAGE PLAN RESUBMITTAL	S. DEV. PLAN FOR SUB'D APPROVAL		
CONCEPTUAL G & D PLAN	S. DEV. FOR BLDG. PERMIT APPROVAL		
GRADING PLAN	SECTOR PLAN APPROVAL		
EROSION & SEDIMENT CONTROL PLAN (ESC)	FINAL PLAT APPROVAL		
ENGINEER'S CERT (HYDROLOGY)	X CERTIFICATE OF OCCUPANCY (PERM)		
CLOMR/LOMR	CERTIFICATE OF OCCUPANCY (TCL TEMP)		
TRAFFIC CIRCULATION LAYOUT (TCL)	FOUNDATION PERMIT APPROVAL		
X ENGINEER'S CERT (TCL)	BUILDING PERMIT APPROVAL		
ENGINEER'S CERT (DRB SITE PLAN)	GRADING PERMIT APPRO	VAL SO-19 APPROVAL	
ENGINEER'S CERT (ESC)	PAVING PERMIT APPROV	AL ESC PERMIT APPROVAL	
	WORK ORDER APPROVAL	ESC CERT. ACCEPTANCE	
OTHER (SPECIFY)	GRADING CERTIFICATION		
WAS A PRE-DESIGN CONFERENCE ATTENDED:	Yes No Co	ppy Provided	
DATE SUBMITTED: 4/24/18	By:		

Requests for approvals of Site Development Plans and/or Subdivision Plats shall be accompanied by a drainage submittal. The particular nature, location, and scope to the proposed development defines the degree of drainage detail. One or more of the following levels of submittal may be required based on the following

1. Conceptual Grading and Drainage Plan: Required for approval of Site Development Plans greater than five (5) acres and Sector Plans

2. Drainage Plans: Required for building permits, grading permits, paving permits and site plans less than five (5) acres

3. Drainage Report: Required for subdivision containing more than ten (10) lots or constituting five (5) acres or more

4. Erosion and Sediment Control Plan: Required for any new development and redevelopment site with 1-acre or more of land disturbing area, including project less than 1-acre than are part of a larger common plan of development