

CITY OF ALBUQUERQUE



July 6, 2016

David Soule, PE
Rio Grande Engineering
1606 Central SE Suite 201
Albuquerque, NM 87106

**Re: Beehive Village at San Pedro-Building 2
6401 Corona NE
Requested for Permanent C. O. – Accepted
Engineers Stamp Date 6/23/11 (C18D016A)
Certification dated: 5-22-16**

Dear Mr. Soule,

Based on the Certification received 7/1/2016, the site is acceptable for release of Certificate of Occupancy by Hydrology.

PO Box 1293

- In the future ensure that the as-built accurately reflects the final condition. One inlet was not crossed off of the drawing.

Albuquerque

- In the future ensure that the roof drains do not flow over a pedestrian sidewalk.

If you have any questions, you can contact me at 924-3986 or Totten Elliott at 924-3982.

New Mexico 87103

www.cabq.gov

Sincerely,

Abiel Carrillo, P.E.
Principal Engineer, Planning Department
Development and Review Services




TE/AC

C: email

Cordova, Camille C.; Miranda, Rachel; Sandoval, Darlene M.; Blocker,
Lois

EROSION CONTROL NOTES:

1. CONTRACTOR IS RESPONSIBLE FOR OBTAINING A TOPSOIL DISTURBANCE PERMIT PRIOR TO BEGINNING WORK.
2. CONTRACTOR IS RESPONSIBLE FOR MAINTAINING RUN-OFF ON SITE DURING CONSTRUCTION.
3. CONTRACTOR IS RESPONSIBLE FOR CLEANING ALL SEDIMENT THAT GETS INTO EXISTING RIGHT-OF-WAY.
4. REPAIR OF DAMAGED FACILITIES AND CLEANUP OF SEDIMENT ACCUMULATIONS ON ADJACENT PROPERTIES AND IN PUBLIC FACILITIES IS THE RESPONSIBILITY OF THE CONTRACTOR.
5. ALL EXPOSED EARTH SURFACES MUST BE PROTECTED FROM WIND AND WATER EROSION PRIOR TO FINAL ACCEPTANCE OF ANY PROJECT.

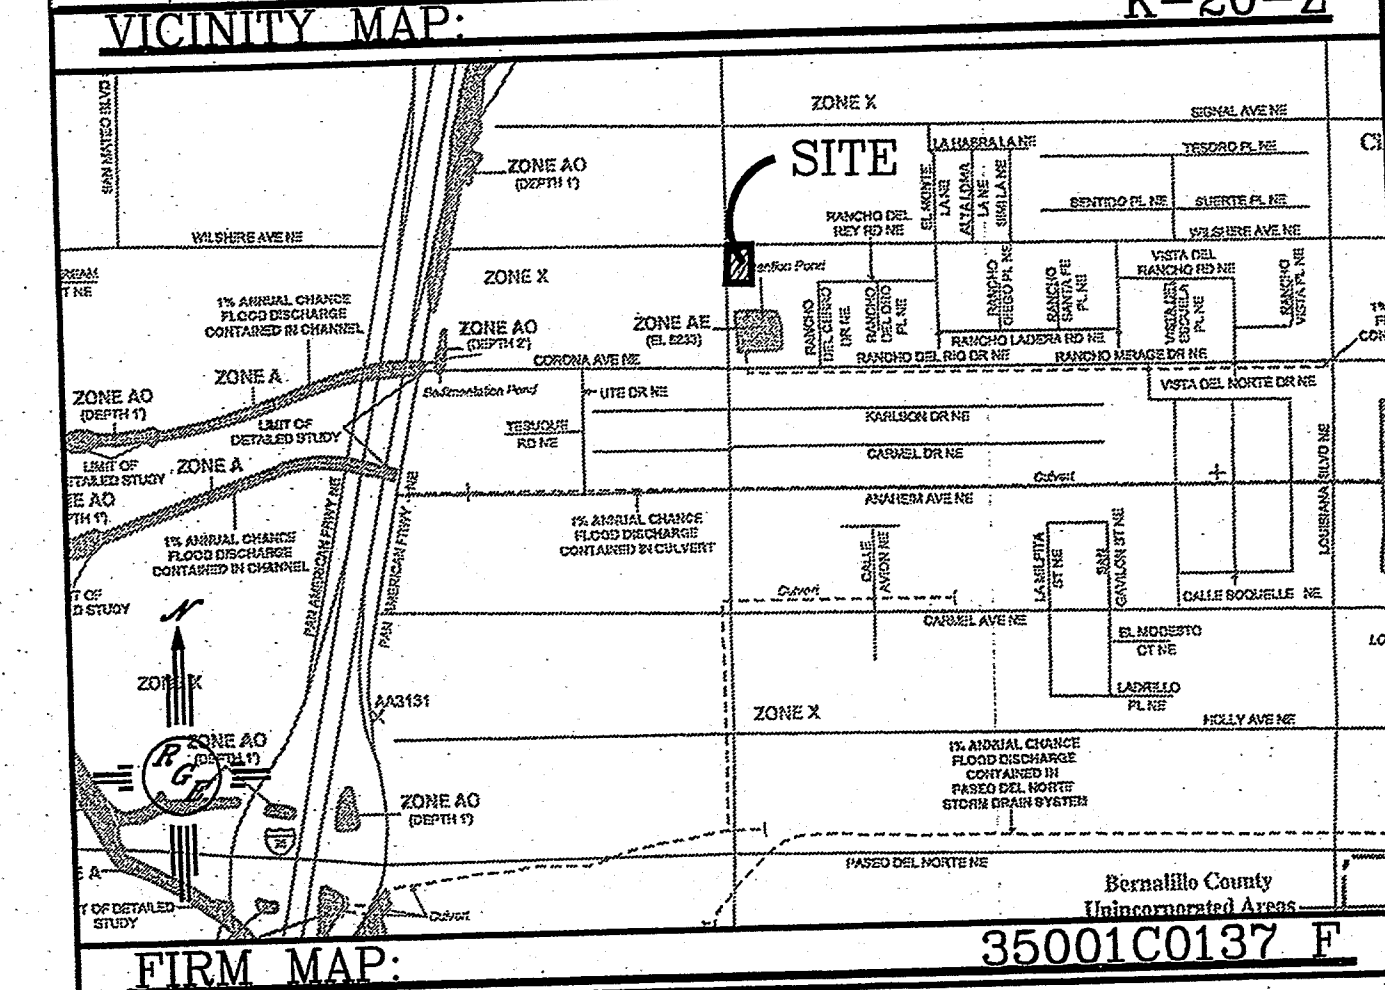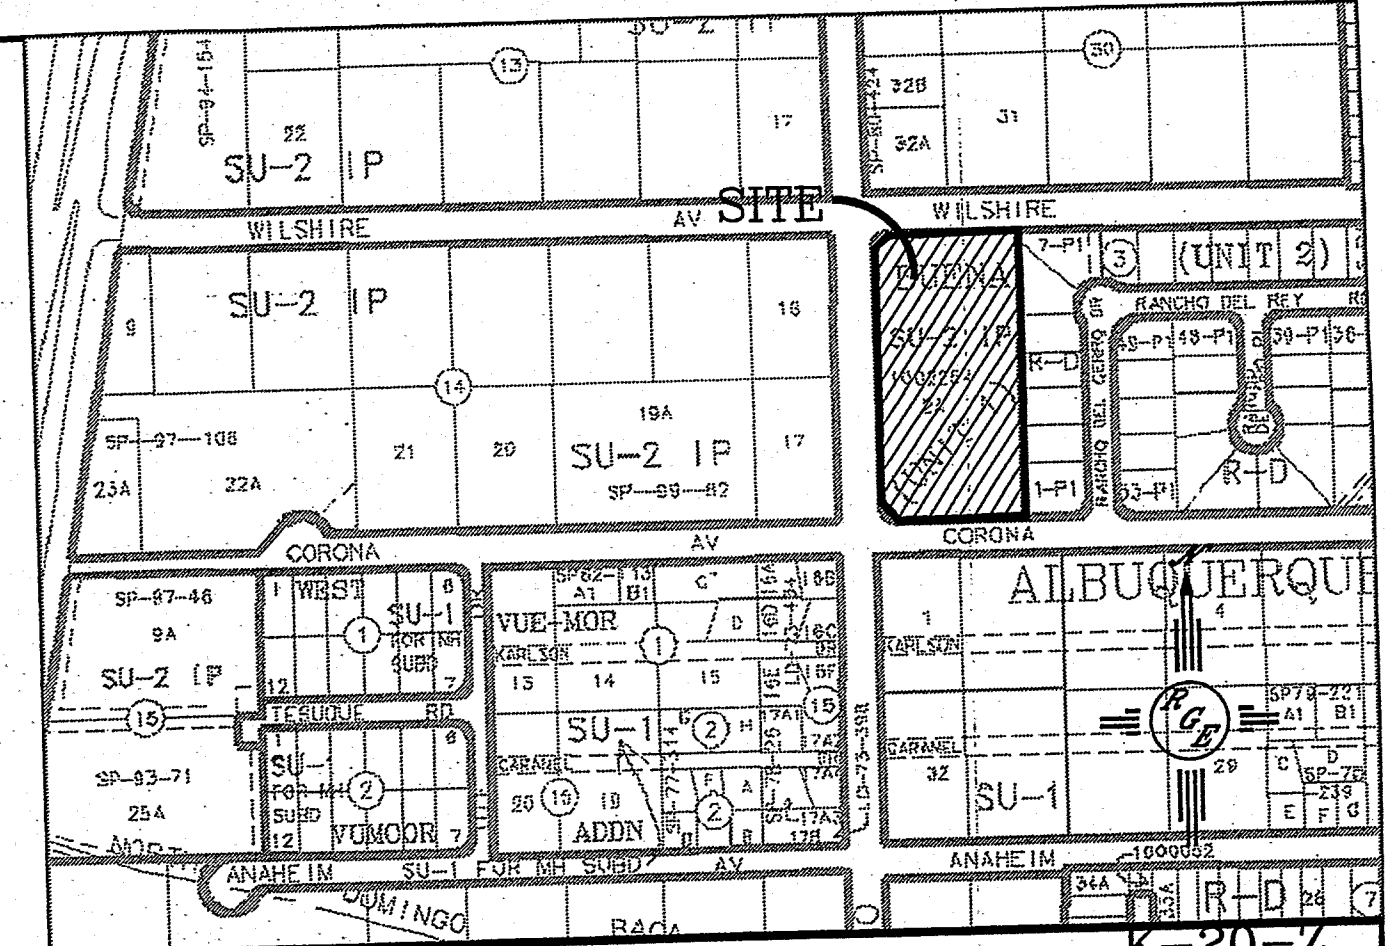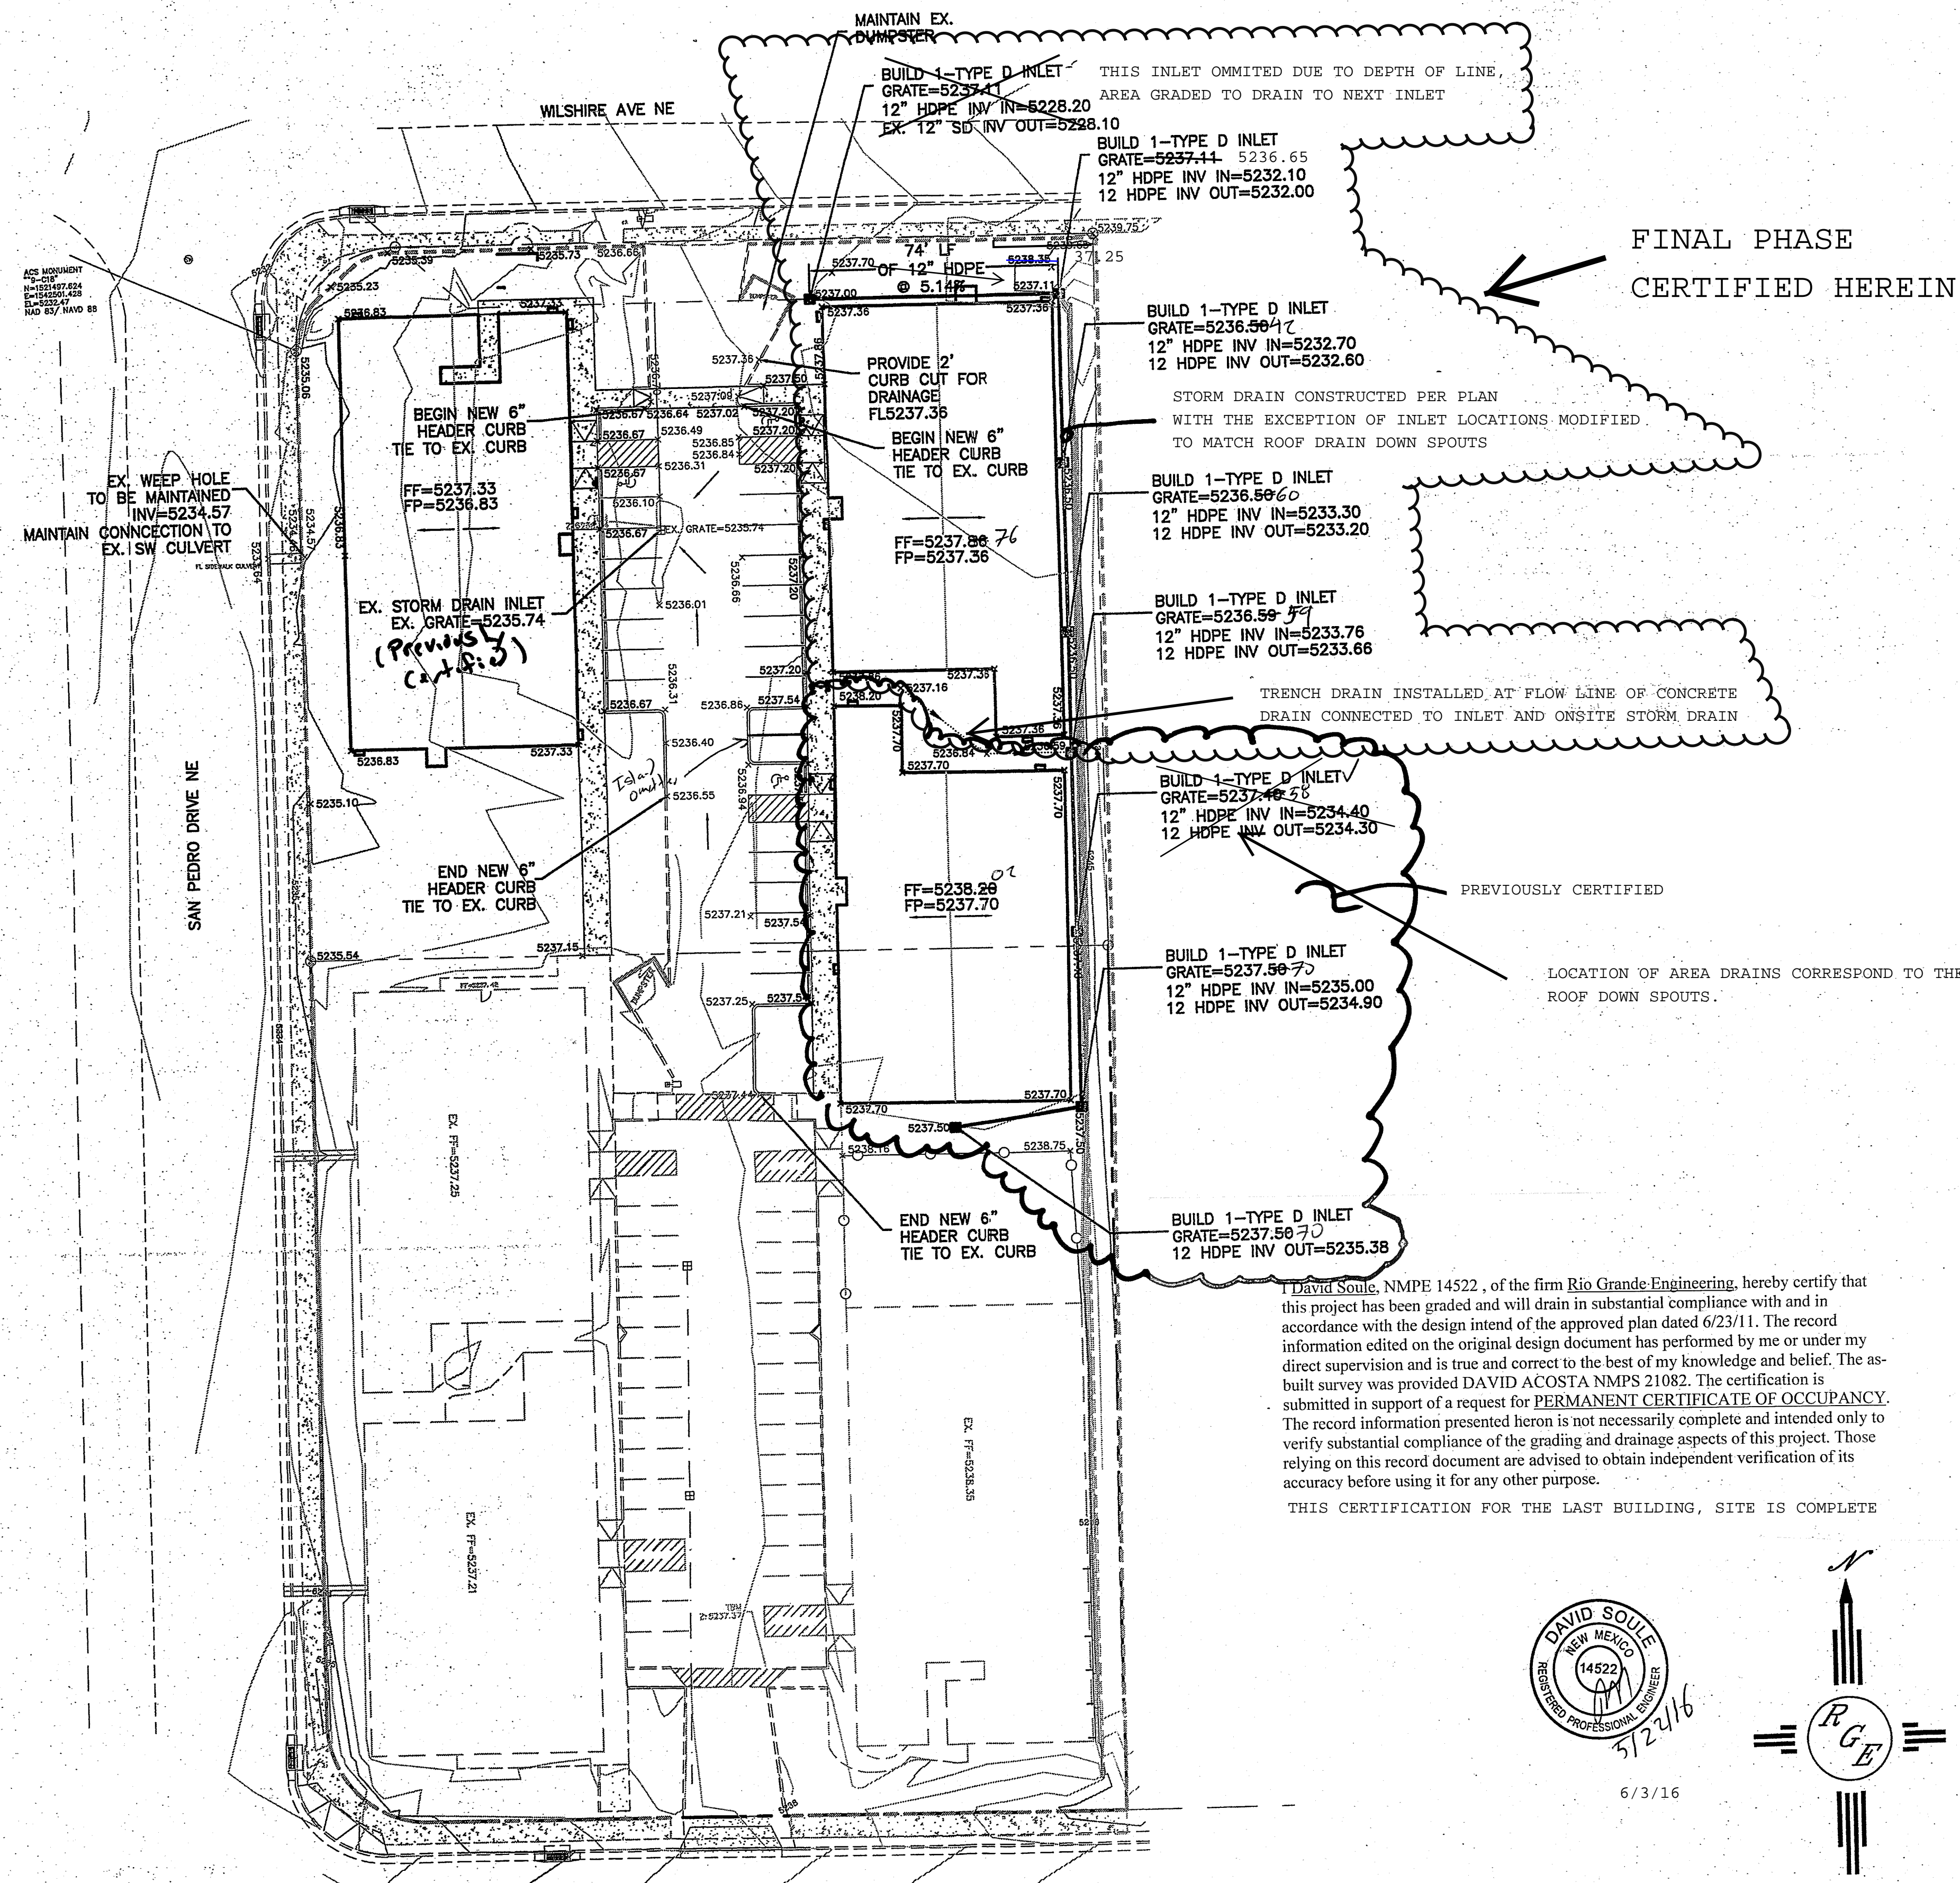


LEGAL DESCRIPTION:
TRACT A-1, BEEHIVE VILLAGE

NOTES:
1. ALL SPOT ELEVATIONS REPRESENT FLOWLINE ELEVATION UNLESS OTHERWISE NOTED.

LEGEND	
---	EXISTING CONTOUR
---	EXISTING INDEX CONTOUR
---	PROPOSED CONTOUR
---	PROPOSED INDEX CONTOUR
---	SLOPE TIE
×	EXISTING SPOT ELEVATION
×	PROPOSED SPOT ELEVATION
---	BOUNDARY
---	CENTERLINE
---	RIGHT-OF-WAY
---	EXISTING FENCE
---	PROPOSED CURB
---	EXISTING CURB
---	EXISTING SIDEWALK

ENGINEER'S SEAL DAVID SOULE P.E. #14522	BEEHIVE HOMES	DRAWN BY WCVJ
	GRADING AND DRAINAGE PLAN	DATE 6-21-11
	Rio Grande Engineering 1806 CENTRAL AVENUE SUITE 201 ALBUQUERQUE, NM 87106 (505) 872-0999	2119-14522-6-01-10
		SHEET # 2
		JOB # 2119

CAUTION:
EXISTING UTILITIES ARE NOT SHOWN. IT SHALL BE THE SOLE RESPONSIBILITY OF THE CONTRACTOR TO CONDUCT ALL NECESSARY FIELD INVESTIGATIONS PRIOR TO ANY EXCAVATION TO DETERMINE THE ACTUAL LOCATION OF UTILITIES & OTHER IMPROVEMENTS.

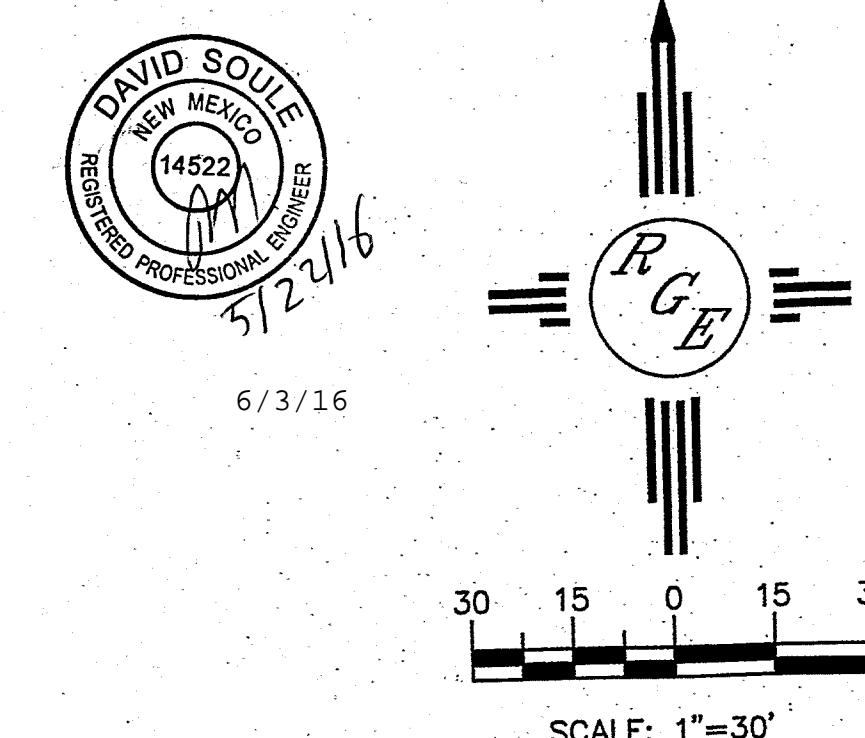

I, David Soule, NMPE 14522, of the firm Rio Grande Engineering, hereby certify that this project has been graded and will drain in substantial compliance with and in accordance with the design intent of the approved plan dated 6/23/11. The record information edited on the original design document has performed by me or under my direct supervision and is true and correct to the best of my knowledge and belief. The as-built survey was provided DAVID ACOSTA NMPS 21082. The certification is submitted in support of a request for PERMANENT CERTIFICATE OF OCCUPANCY. The record information presented herein is not necessarily complete and intended only to verify substantial compliance of the grading and drainage aspects of this project. Those relying on this record document are advised to obtain independent verification of its accuracy before using it for any other purpose.

THIS CERTIFICATION FOR THE LAST BUILDING, SITE IS COMPLETE

DRAINAGE AND TRANSPORTATION INFORMATION SHEET

(REV. 01/28/2003rd)

PROJECT TITLE: BeehiveVillage at San Pedro-phase 2
DRB #: _____ EPC #: _____

ZONE MAP/DRG. FILE #: C18/D016A
WORK ORDER #: _____

LEGAL DESCRIPTION: Tracts A1,B-1 Beehive village
CITY ADDRESS: 6401 Corona

ENGINEERING FIRM: Rio Grande Engineering
ADDRESS: PO BOX 67305
CITY, STATE: Alb

CONTACT: David Soule, PE
PHONE: (505)321-9099
ZIP CODE: 87199

OWNER: San Pedro Bee Hive
ADDRESS: 6401 Corona
CITY, STATE: alb, nm

CONTACT: _____
PHONE: _____
ZIP CODE: 87109

ARCHITECT: _____
ADDRESS: _____
CITY, STATE: _____

CONTACT: Dan Herr
PHONE: 246-0870
ZIP CODE: 87104

SURVEYOR: Geo surv CO
ADDRESS: _____
CITY, STATE: _____

CONTACT: David Vigil
PHONE: _____
ZIP CODE: _____

CONTRACTOR: _____
ADDRESS: _____
CITY, STATE: _____

CONTACT: _____
PHONE: _____
ZIP CODE: _____

CHECK TYPE OF SUBMITTAL:

- ☐ DRAINAGE REPORT
- ☐ DRAINAGE PLAN 1st SUBMITTAL, **REQUIRES TCL or equal**
- ☐ DRAINAGE PLAN RESUBMITTAL
- ☐ CONCEPTUAL GRADING & DRAINAGE PLAN
- ☐ GRADING PLAN
- ☐ EROSION CONTROL PLAN
- ☒ ENGINEER'S CERTIFICATION (HYDROLOGY)
- ☐ CLOMR/LOMR
- ☐ TRAFFIC CIRCULATION LAYOUT (TCL)
- ☐ ENGINEERS CERTIFICATION (TCL)
- ☐ ENGINEERS CERTIFICATION (DRB APPR. SITE PLAN)
- ☐ OTHER

CHECK TYPE OF APPROVAL SOUGHT:

- ☐ SIA / FINANACIAL GUARANTEE RELEASE
- ☐ PRELIMINARY PLAT APPROVAL
- ☐ S. DEV. PLAN FOR SUB'D. APPROVAL
- ☐ S. DEV. PLAN FOR BLDG. PERMIT APPROVAL
- ☐ SECTOR PLAN APPROVAL
- ☐ FINAL PLAT APPROVAL
- ☐ FOUNDATION PERMIT APPROVAL
- ☐ BUILDING PERMIT APPROVAL
- ☒ CERTIFICATE OF OCCUPANCY (PERM.)
- ☐ CERTIFICATE OF OCCUPANCY (TEMP.)
- ☐ GRADING PERMIT APPROVAL
- ☐ PAVING PERMIT APPROVAL
- ☐ WORK ORDER APPROVAL
- ☐ OTHER (SPECIFY)

WAS A PRE-DESIGN CONFERENCE ATTENDED:

- ☐ YES
- ☒ NO
- ☐ COPY PROVIDED

DATE SUBMITTED: 7/1/16 BY: David Soule

Requests for approvals of Site Development Plans and/or Subdivision Plats shall be accompanied by a drainage submittal.

The particular nature, location and scope of the proposed development defines the degree of drainage detail.

One or more of the following levels of submittal may be required based on the following:

1. **Conceptual Grading and Drainage Plans:** Required for approval of Site Development Plans greater than five (5) acres and Sector Plans.
2. **Drainage Plans:** Required for building permits, grading permits, paving permits and site plans less than five (5) acres.
3. **Drainage Report:** Required for subdivisions containing more than ten (10) lots or constituting five (5) acres or more.