

Backfill Compacted to 95% -

Modified Proctor Density per ASTM D-1557

Concrete Rundown Detail

FLOW ARROW

— — 515— — EXISTING CONTOUR

——··· FLOW LINE

- - RIDGE LINE


— PROPOSED CONTOUR

EXISTING STORM DRAIN

PROPOSED TOP OF GRADE/PVMT ELEVATIONS

PROPOSED FLOW LINE GUTTER ELEVATIONS

PROPOSED TOP OF CURB ELEVATIONS

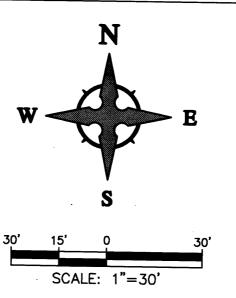


#### CAUTION - NOTICE TO CONTRACTOR

THE CONTRACTOR IS SPECIFICALLY CAUTIONED THAT THE LOCATION AND/OR ELEVATION OF EXISTING UTILITIES AS SHOWN ON THESE PLANS IS BASED ON RECORDS OF THE VARIOUS UTILITY COMPANIES AND, WHERE POSSIBLE, MEASUREMENTS TAKEN IN THE FIELD. THE INFORMATION IS NOT TO BE RELIED ON AS BEING EXACT OR COMPLETE
THE CONTRACTOR MUST CALL THE APPROPRIATE UTILITY COMPANY AT LEAST 48 HOURS BEFORE ANY EXCAVATION TO REQUEST EXACT FIELD LOCATION OF UTILITIES. IT SHALL BE THE RESPONSIBILITY OF THE CONTRACTOR TO RELOCATE ALL EXISTING UTILITIES WHICH CONFLICT WITH THE PROPOSED IMPROVEMENTS SHOWN ON THE PLANS.

#### DRAINAGE CERTIFICATION

I, JEFFREY T. WOOTEN, NMPE 16892, OF THE FIRM WOOTEN ENGINEERING, HEREBY CERTIFY THAT THIS PROJECT HAS BEEN GRADED AND WILL DRAIN IN SUBSTANTIAL COMPLIANCE WITH AND IN ACCORDANCE WITH THE DESIGN INTENT OF THE APPROVED PLAN DATED 05/29/08. THE RECORD INFORMATION EDITED ONTO THE ORIGINAL DESIGN DOCUMENT HAS BEEN OBTAINED BY LARRY W. MEDRANO, NMPS 11993. OF THE FIRM PRECISION SURVEYS, INC. I FURTHER CERTIFY THAT I PERSONALLY VISITED THE PROJECT SITE ON 10/24/08 AND HAVE DETERMINED BY VISUAL INSPECTION THAT THE SURVEY DATA PROVIDED IS REPRESENTATIVE OF ACTUAL SITE CONDITIONS AND IS TRUE AND CORRECT TO THE BEST OF MY KNOWLEDGE AND BELIEF. THIS CERTIFICATION IS SUBMITTED IN SUPPORT OF A REQUEST FOR FINAL CERTIFICATE OF OCCUPANCY (FINAL C.O.).

THE RECORD INFORMATION PRESENTED HEREON IS NOT NECESSARILY COMPLETE AND INTENDED ONLY TO VERIFY SUBSTANTIAL COMPLIANCE OF THE GRADING AND DRAINAGE ASPECTS OF THIS PROJECT. THOSE RELYING ON THIS RECORD DOCUMENT ARE ADVISED TO OBTAIN INDEPENDENT VERIFICATION OF ITS ACCURACY BEFORE USING IT FOR ANY OTHER PURPOSE.

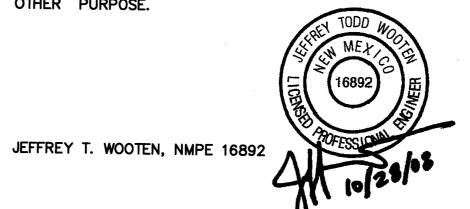

## DRAINAGE MANAGEMENT PLAN

The purpose of this submittal is to provide a conceptual and final drainage management plan for the new David Bernitski Eye Care Facility, whic includes a new +/- 6,600 square foot building and associated parking areas. The site is located at 6401 Holly Ave NE in Albuquerque, NM, which is near the northeast corner of San Pedro and Holly. The site contains approximately 0.76 acres.

EXISTING HYDROLOGIC CONDITIONS According to plans developed by Tierra West for Holly Ave, this site is allowed to surface flow 100% of the runoff to Holly Ave. The site is part the Paseo Nuevo campus, which was master planned for drainage. The curb cut onto Holly is existing.

According to the Drainage Calculations table, this sheet, the existing runoff from the site show that 2.29 cfs currently leaves the site to the west via surface flow. Analysis for these and all drainage calculations were performed using the COA DPM Section 22.2, released June 1997.

## PROPOSED HYDROLOGIC CONDITIONS


According to the approved drainage plan (Jan 2008) by David Aube, P.E., there is a proposed flow of 1.26 cfs that will drain onto the property via. the northeast corner of the property. This flow will be combined with the new 3.68cfs of runoff from this site (total 4.94 cfs) and directed across the site to the west and south through the parking lot and the concrete rundown. Calculations for the capacity of the rundown have been shown in plan view. An additional 4.65 cfs is shown draining to the common driveway at the southeast corner of the site. This flow shall continue out the driveway into Holly Ave. Calculations for the capacity of the swale in the driveway have been shown in plan view.

# CONCLUSION


This drainage management plan provides for grading and drainage elements which are capable of safely passing the 100 year storm and which meets city requirements. According to the previous approved Drainage Management Plan for the Paseo Nuevo campus, the site is allowed to discharge developed flows directly to the southwest corner of the site, without causing a negative impact. With this submittal, we are requesting conceptual grading and drainage plan (Site Plan for Building Permit) approval as well as Building Permit Approval.

Existing Bernitski Eye Care Drainage Calculations (based on COA DPM Section 22.2, Hydrologic Zone 3)										
BASIN	Area	Area	Land Treatment Percentages				Q(100)	Q(100)	WT E	V(100) <sub>360</sub>
	(SF)	(AC)	Α	В	С	D	(cfs/ac.)	(CFS)	(in)	(CF)
Site	32,929	0.76	0.0%	50.0%	50.0%	00.0%	3.03	2.29	1.15	3,032
									-	

Proposed Bernitski Eye Care Drainage Calculations (based on COA DPM Section 22.2, Hydrologic Zone 3)										
BASIN	Area	Area	Land Treatment Percentages				Q(100)	Q(100)	WT E	V(100) <sub>360</sub>
	(SF)	(AC)	Α	В	С	D	(cfs/ac.)	(CFS)	(in)	(CF)
Site	32,929	0.76	0.0%	00.0%	10.0%	90.0%	4.86	3.68	2.25	6,182

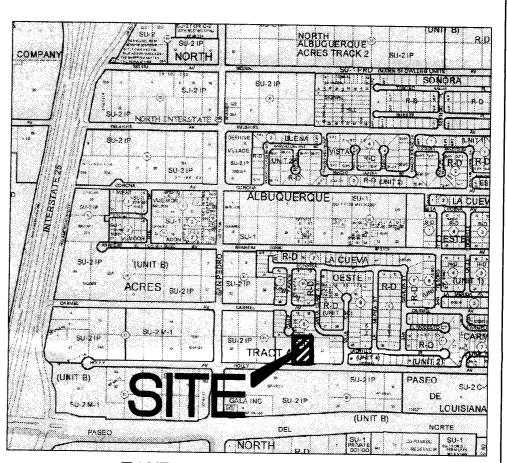

#### ZONE ATLAS PAGE C18

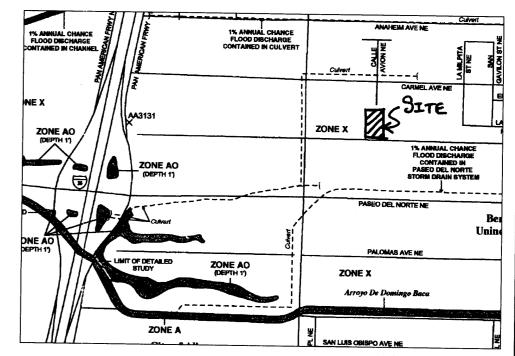

#### FRM MAP 35001C0137F

Per FIRM Map 35001C0137F, Dated Nov. 9, 2003, the site is located in Zone X 'Areas determined to be outside the 0.2% chance Annual

#### NOTICE TO CONTRACTORS

1. AN EXCAVATION/CONSTRUCTION PERMIT WILL BE REQUIRED BEFORE BEGINNING ANY WORK WITHIN CITY RIGHT-OF-WAY. 2. ALL WORK DETAILED ON THESE PLANS TO BE PERFORMED, EXCEPT AS OTHERWISE STATED OR PROVIDED HEREON, SHALL BE CONSTRUCTED IN ACCORDANCE WITH CITY OF ALBUQUERQUE INTERIM STANDARD SPECIFICATIONS FOR PUBLIC WORKS CONSTRUCTION, 1985.

3. TWO WORKING DAYS PRIOR TO ANY EXCAVATION, CONTRACTOR MUST CONTACT LINE LOCATING SERVICE, 260-1990, FOR LOCATION OF EXISTING UTILITIES. (NM ONE CALL = '811')

4. PRIOR TO CONSTRUCTION, THE CONTRACTOR SHALL EXCAVATE AND VERIFY THE HORIZONTAL AND VERTICAL LOCATIONS OF ALL CONSTRUCTIONS. SHOULD A CONFLICT EXIST, THE CONTRACTOR SHALL NOTIFY THE ENGINEER SO THAT THE CONFLICT CAN BE RESOLVED WITH A MINIMUM AMOUNT OF

5. BACKFILL COMPACTION SHALL BE ACCORDING TO TRAFFIC/STREET USE. 6. MAINTENANCE OF THESE FACILITIES SHALL BE THE RESPONSIBILITY OF THE OWNER OF THE PROPERTY SERVED.

7. WORK ON ARTERIAL STREETS SHALL BE PERFORMED ON A 24-HOUR

# **GRADING NOTES**

1. EXCEPT AS PROVIDED HEREIN, GRADING SHALL BE PERFORMED AT THE ELEVATIONS AND IN ACCORDANCE WITH THE DETAILS SHOWN ON THIS PLAN. 2. THE COST FOR REQUIRED CONSTRUCTION DUST AND EROSION CONTROL MEASURES SHALL BE INCIDENTAL TO THE PROJECT COST.

3. ALL WORK RELATIVE TO FOUNDATION CONSTRUCTION, SITE PREPARATION, AND PAVEMENT INSTALLATION, AS SHOWN ON THIS PLAN, SHALL BE CONSTRUCTED IN ACCORDANCE WITH THE "GEOTECHNICAL INVESTIGATION," AS PROVIDED BY THE ARCHITECT OR OWNER. ALL OTHER WORK SHALL, UNLESS OTHERWISE STATED OR PROVIDED FOR HEREON, BE CONSTRUCTED IN ACCORDANCE WITH THE PROJECT, (FIRST PRIORITY) SPECIFICATIONS, AND/OR THE CITY OF ALBUQUERQUE (COA) STANDARD SPECIFICATIONS FOR PUBLIC WORKS (SECOND PRIORITY).

4. EARTH SLOPES SHALL NOT EXCEED 3 HORIZONTAL TO 1 VERTICAL UNLESS SHOWN OTHERWISE.

5. IT IS THE INTENT OF THESE PLANS THAT THIS CONTRACTOR SHALL NOT PERFORM ANY WORK OUTSIDE OF THE PROPERTY BOUNDARIES EXCEPT AS REQUIRED BY THIS PLAN.

6. THE CONTRACTOR IS TO ENSURE THAT NO SOIL ERODES FROM THE SITE ONTO ADJACENT PROPERTY OR PUBLIC RIGHT-OF-WAY. THIS SHOULD BE ACHIEVED BY CONSTRUCTING TEMPORARY BERMS OR SILT FENCE AT THE PROPERTY LINES AND WETTING THE SOIL TO PROTECT IT FROM WIND

7. A DISPOSAL SITE FOR ANY & ALL EXCESS EXCAVATION MATERIAL, AND UNSUITABLE MATERIAL AND/OR A BORROW SITE CONTAINING ACCEPTABLE FILL MATERIAL SHALL BE OBTAINED BY THE CONTRACTOR IN COMPLIANCE WITH APPLICABLE ENVIRONMENTAL REGULATIONS AND APPROVED BY THE OBSERVER. ALL COSTS INCURRED IN OBTAINING A DISPOSAL OR BORROW SITE AND HAUL TO OR FROM SHALL BE CONSIDERED INCIDENTAL TO THE PROJECT AND NO SEPARATE MEASUREMENT OR PAYMENT SHALL BE MADE.

8. PAVING AND ROADWAY GRADES SHALL BE +/- 0.05' FROM PLAN ELEVATIONS. PAD ELEVATION SHALL BE +/- 0.05' FROM BUILDING PLAN

9. ALL PROPOSED CONTOURS REFLECT TOP OF PAVEMENT ELEVATIONS IN THE PARKING AREA AND MUST BE ADJUSTED FOR MEDIANS AND ISLANDS. 10. VERIFY ALL ELEVATIONS SHOWN ON PLAN FROM BASIS OF ELEVATION CONTROL STATION PRIOR TO BEGINNING CONSTRUCTION.

11. THE CONTRACTOR SHALL PROVIDE THE SWPPP DOCUMENT (IF NECESSARY) AND SHALL ABIDE BY ALL LOCAL, STATE, AND FEDERAL LAWS, RULES AND REGULATIONS WHICH APPLY TO THE CONSTRUCTION OF THESE IMPROVEMENTS, INCLUDING EPA REQUIREMENTS WITH RESPECT TO STORM




\\\\\/\ooten Lngineering 623 E. Dellas Rd, Grapevine, TX 78051 Ph: 214-235.5586 Fax: 817.481.1806



PROJECT

**DAVID** BERNITSKY M.D. **FACILITY** 


PROJECT ADDRESS 6401 HOLLY AVE NE ALBUQUREQUE, NM 87113

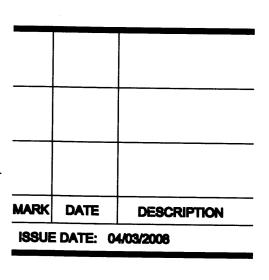

PROJECT NO: COPYRIGHT AKT ARCHITECTS, LLC SHEET TITLE

GRADING/DRAINAGE PLAN

C-101

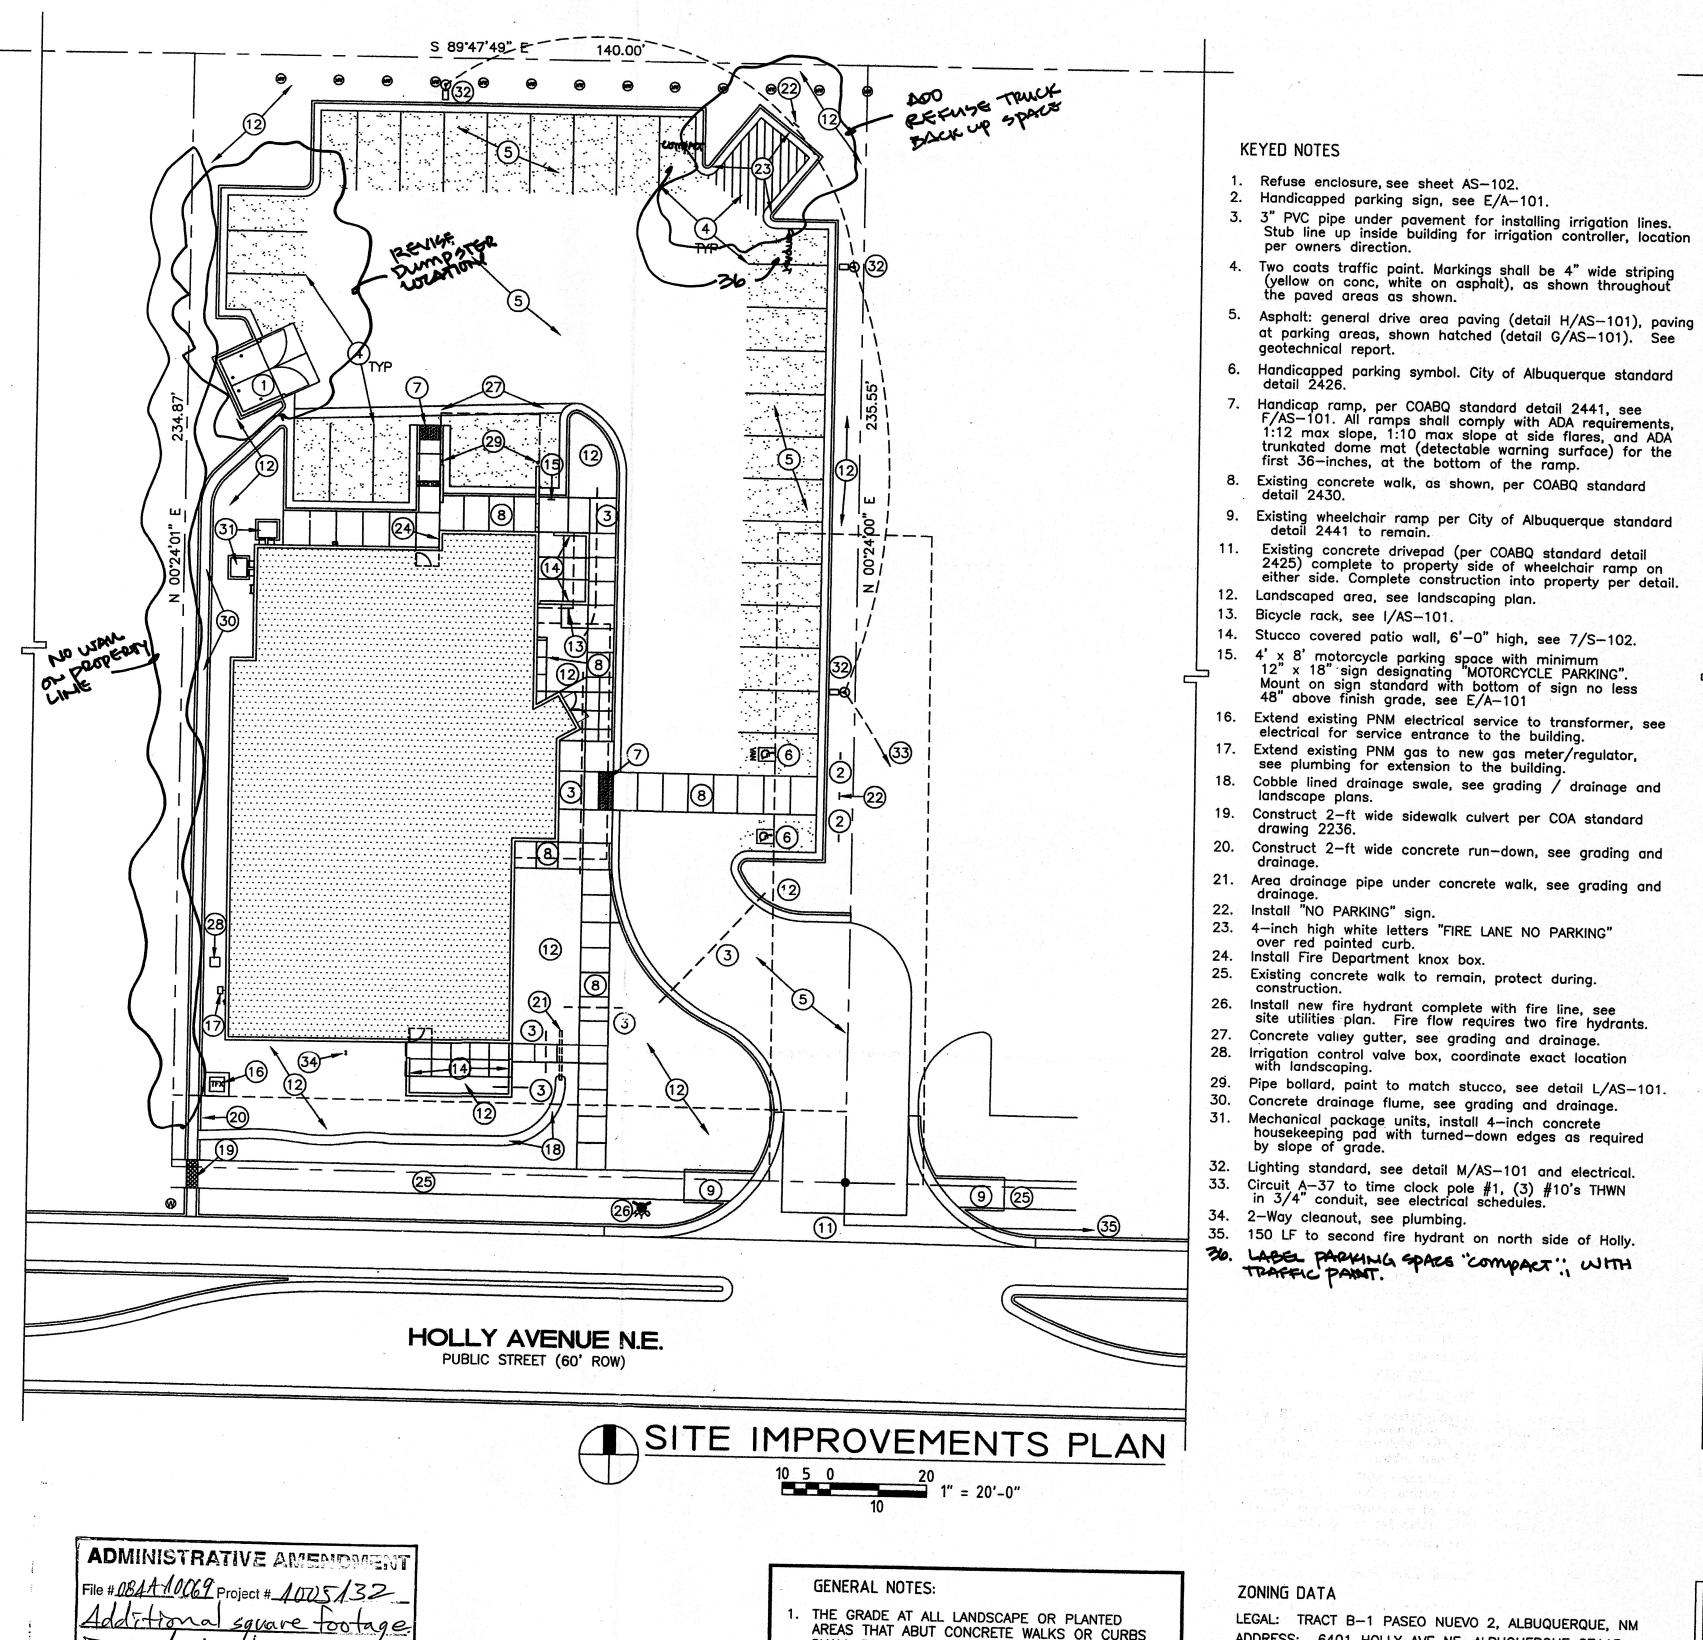

clevations Revise landscaping

- THE GRADE AT ALL LANDSCAPE OR PLANTED AREAS THAT ABUT CONCRETE WALKS OR CURBS SHALL BE DEPRESSED SO THAT THE LANDSCAPING SOIL AND/OR ROCK MATERIAL WILL BE FLUSH WITH THE TOP OF ADJOINING CONCRETE.
- 2. PROVIDE CURB CUTS FOR DRAINAGE AS REQUIRED BY THE GRADING AND DRAINAGE PLAN.
- 3. ALL EARTHWORK AND SITE PREPARATION SHALL COMPLY WITH THE GRADING AND DRAINAGE PLAN.
- F. THE CONTRACTOR SHALL REMOVE ALL EXISTING SITE IMPROVEMENTS, UTILITIES, AND PLANT MATERIALS AND SHALL DISPOSE OF THEM AS
- 5. ALL EXTERIOR CONCRETE SHALL BE 3000 PSI AT

#### ZONING DATA

per owners direction.

the paved areas as shown.

detail 2441 to remain


LEGAL: TRACT B-1 PASEO NUEVO 2, ALBUQUERQUE, NM ADDRESS: 6401 HOLLY AVE NE, ALBUQUERQUE 87113 SITE AREA: 0.7759 ACRES (32,929 SF) ACTUAL BLDG AREA (32% SITE AREA): 6500 SF ZONING: SU-2 FOR O-1 (OFFICE)


ATLAS PAGE C-18-Z REQUIRED SETBACKS: FRONT: 5-FT SIDE: 0-FT REAR: 15-FT


REQUIRED ON-SITE PARKING: 6500 / 200 = 33 SPACES PROVIDED ON-SITE PARKING: 31 SPACES, PARKING INCLUDES 1 HC AND 1 HC VAN SPACE.

1 MOTOR CYCLE PARKING SPACE PROVIDED 1 BICYCLE RACK PROVIDED



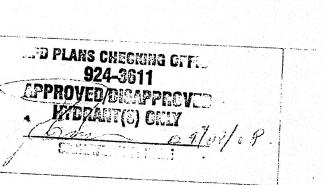

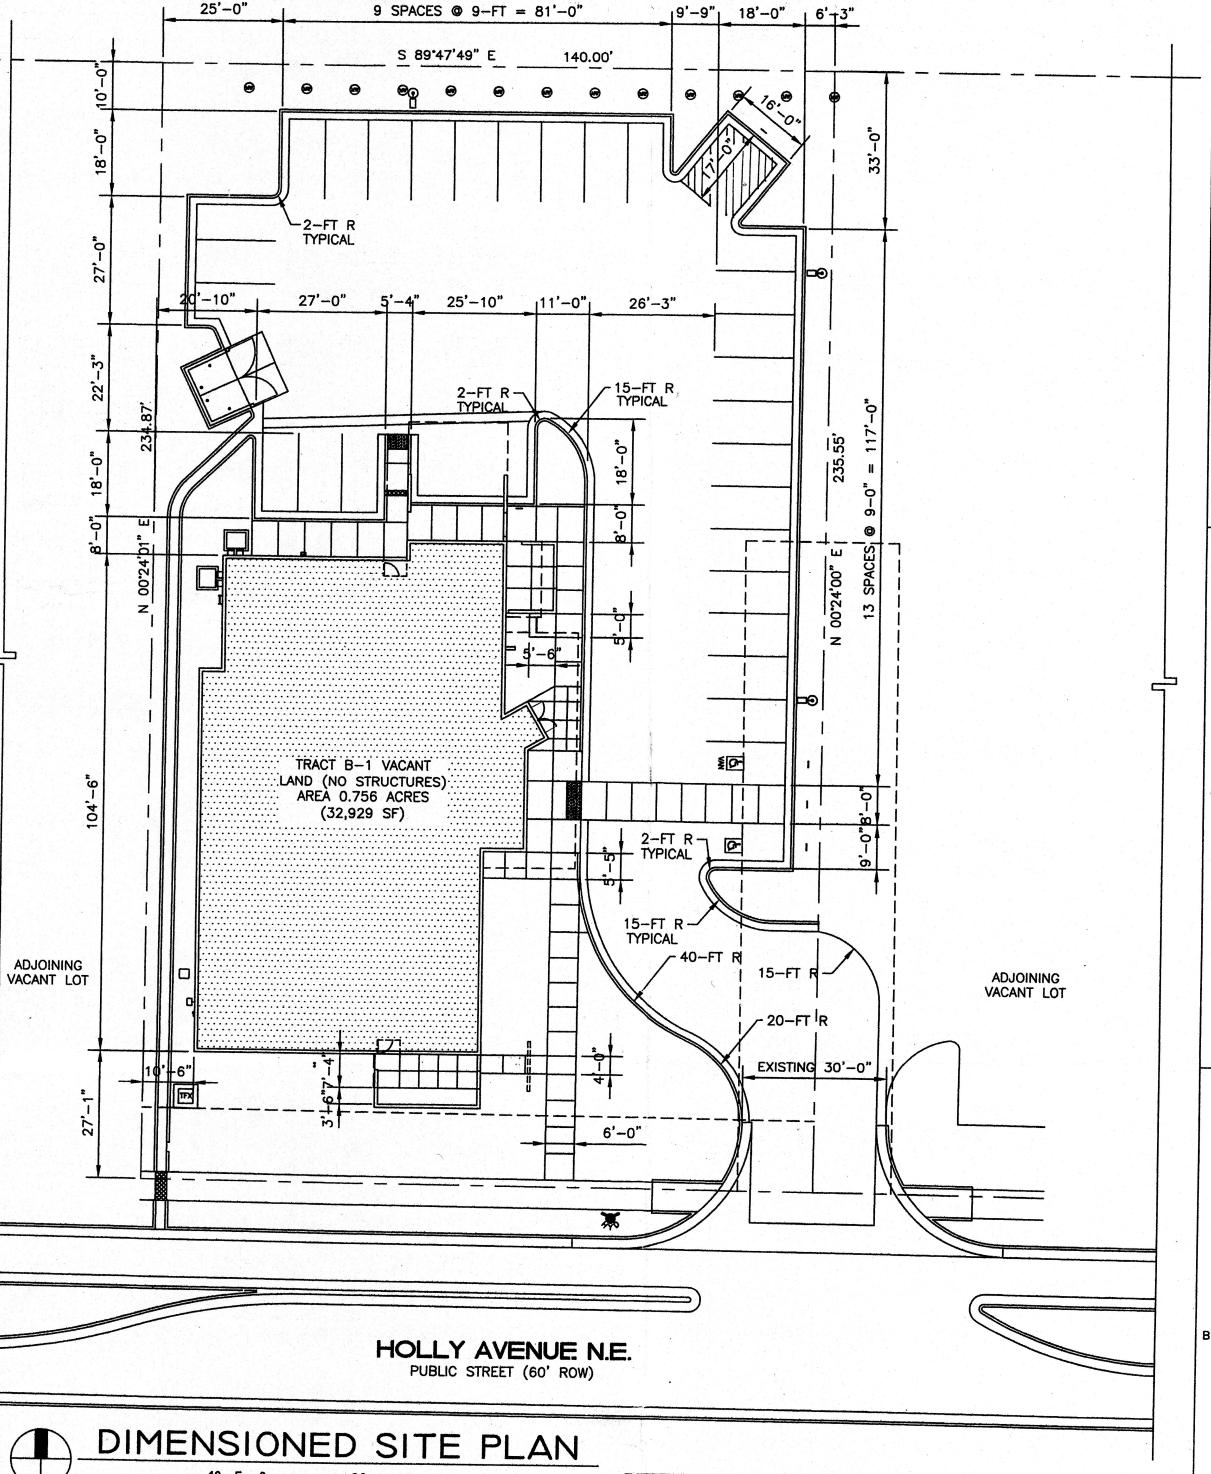

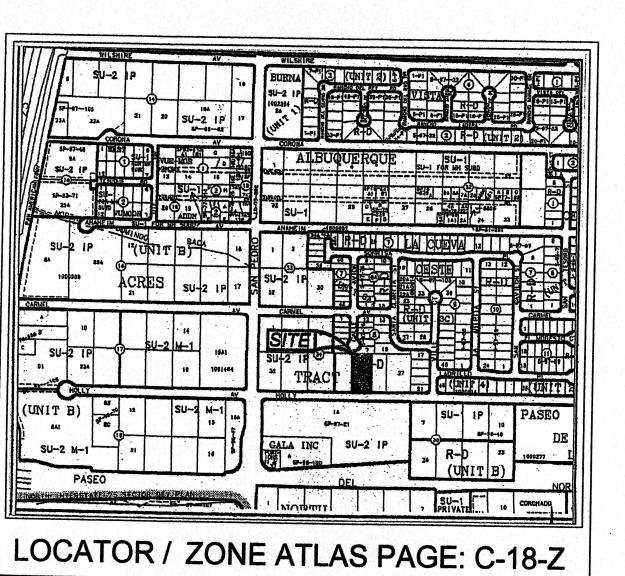

PROJECT NUMBER: 1005132 **APPLICATION NUMBER:** IS AN INFRASTRUCTURE LIST REQUIRED? ( )YES ( )NO IF YES, THEN A SET OF APPROVED DRC PLANS WITH A WORK ORDER IS REQUIRED FOR ANY CONSTRUCTION WITHIN THE PUBLIC RIGHT-OF-WAY OR FOR CONSTRUCTION OF PUBLIC IMPROVEMENTS. DRB SITE DEVELOPMENT PLAN APPROVAL: TRAFFIC ENGINEER, TRANSPORTATION DIVISION WATER UTILITY DEPARTMENT PARKS AND RECREATION DEPARTMEN CITY ENGINEER ENVIRONMENTAL HEALTH DEPARTMENT BUILDING 3-23-08M2 PLAN CHECK SECTION DRB CHAIRPERSON, PLANNING DEPARTMENT

P.O. BOX 3366 ALBUQUERQUE,NM 87190 T: (505) 281-9560 F: (505) 286-1055 C: (505) 259-7919 aktarch@earthlink.net

CONSULTANT

TRAUERNICHT

DAVID A. BERNITSKY M.D. **OFFICE BUILDING** 

PROJECT ADDRESS

**PROJECT** 

6401 HOLLY AVE NE ALBUQUERQUE, NM 87113

MARK DATE DESCRIPTION ISSUE DATE: 4/5/08

PROJECT NO: COPYRIGHT AKT ARCHITECTS, LLC SHEET TITLE

SITE DEVELOPMENT **PLAN FOR BUILDING PERMIT** 

**AS-100** 

OCT 3 0 2008 HYDROLOGY