

CITY OF ALBUQUERQUE



June 29, 2018

Rich Barber, R.A.
ORB, Rich Barber Architects LLC
P.O. Box 93924
Albuquerque, NM 87199

Re: Legacy Apartments , 6115 Alameda Blvd NE, Buildings 11&16
Request for Certificate of Occupancy
Transportation Development Final Inspection
Engineer's/Architect's Stamp dated 8-01-16 (C18-D064B)
Certification dated 05-27-18

Dear Mr. Soule

Based upon the information provided in your submittal received 6-28-18, Transportation Development has no objection to the issuance of a Permanent Certificate of Occupancy. This letter serves as a "green tag" from Transportation Development for a Permanent Certificate of Occupancy to be issued by the Building and Safety Division.

If you have any questions, please contact Ernie Gomez at (505) 924-3981 or me at (505)924-3991.


Sincerely,

Racquel M. Michel, P.E.
Traffic Engineer, Planning Dept.
Development Review Services

Ernie Gomez
Plan Checker, Planning Dept.
Development Review Services

EG via: email
C: CO Clerk, File

FILE: F:\06\ORB Job Files\15-218 -LH Legacy NAA\CAD Files\Construction Documents\15xxx 1st Submittal\15218 A130 Access & Address Site Plan.dwg USER: jps DATE: Aug. 01 2016 TIME: 12:33 pm

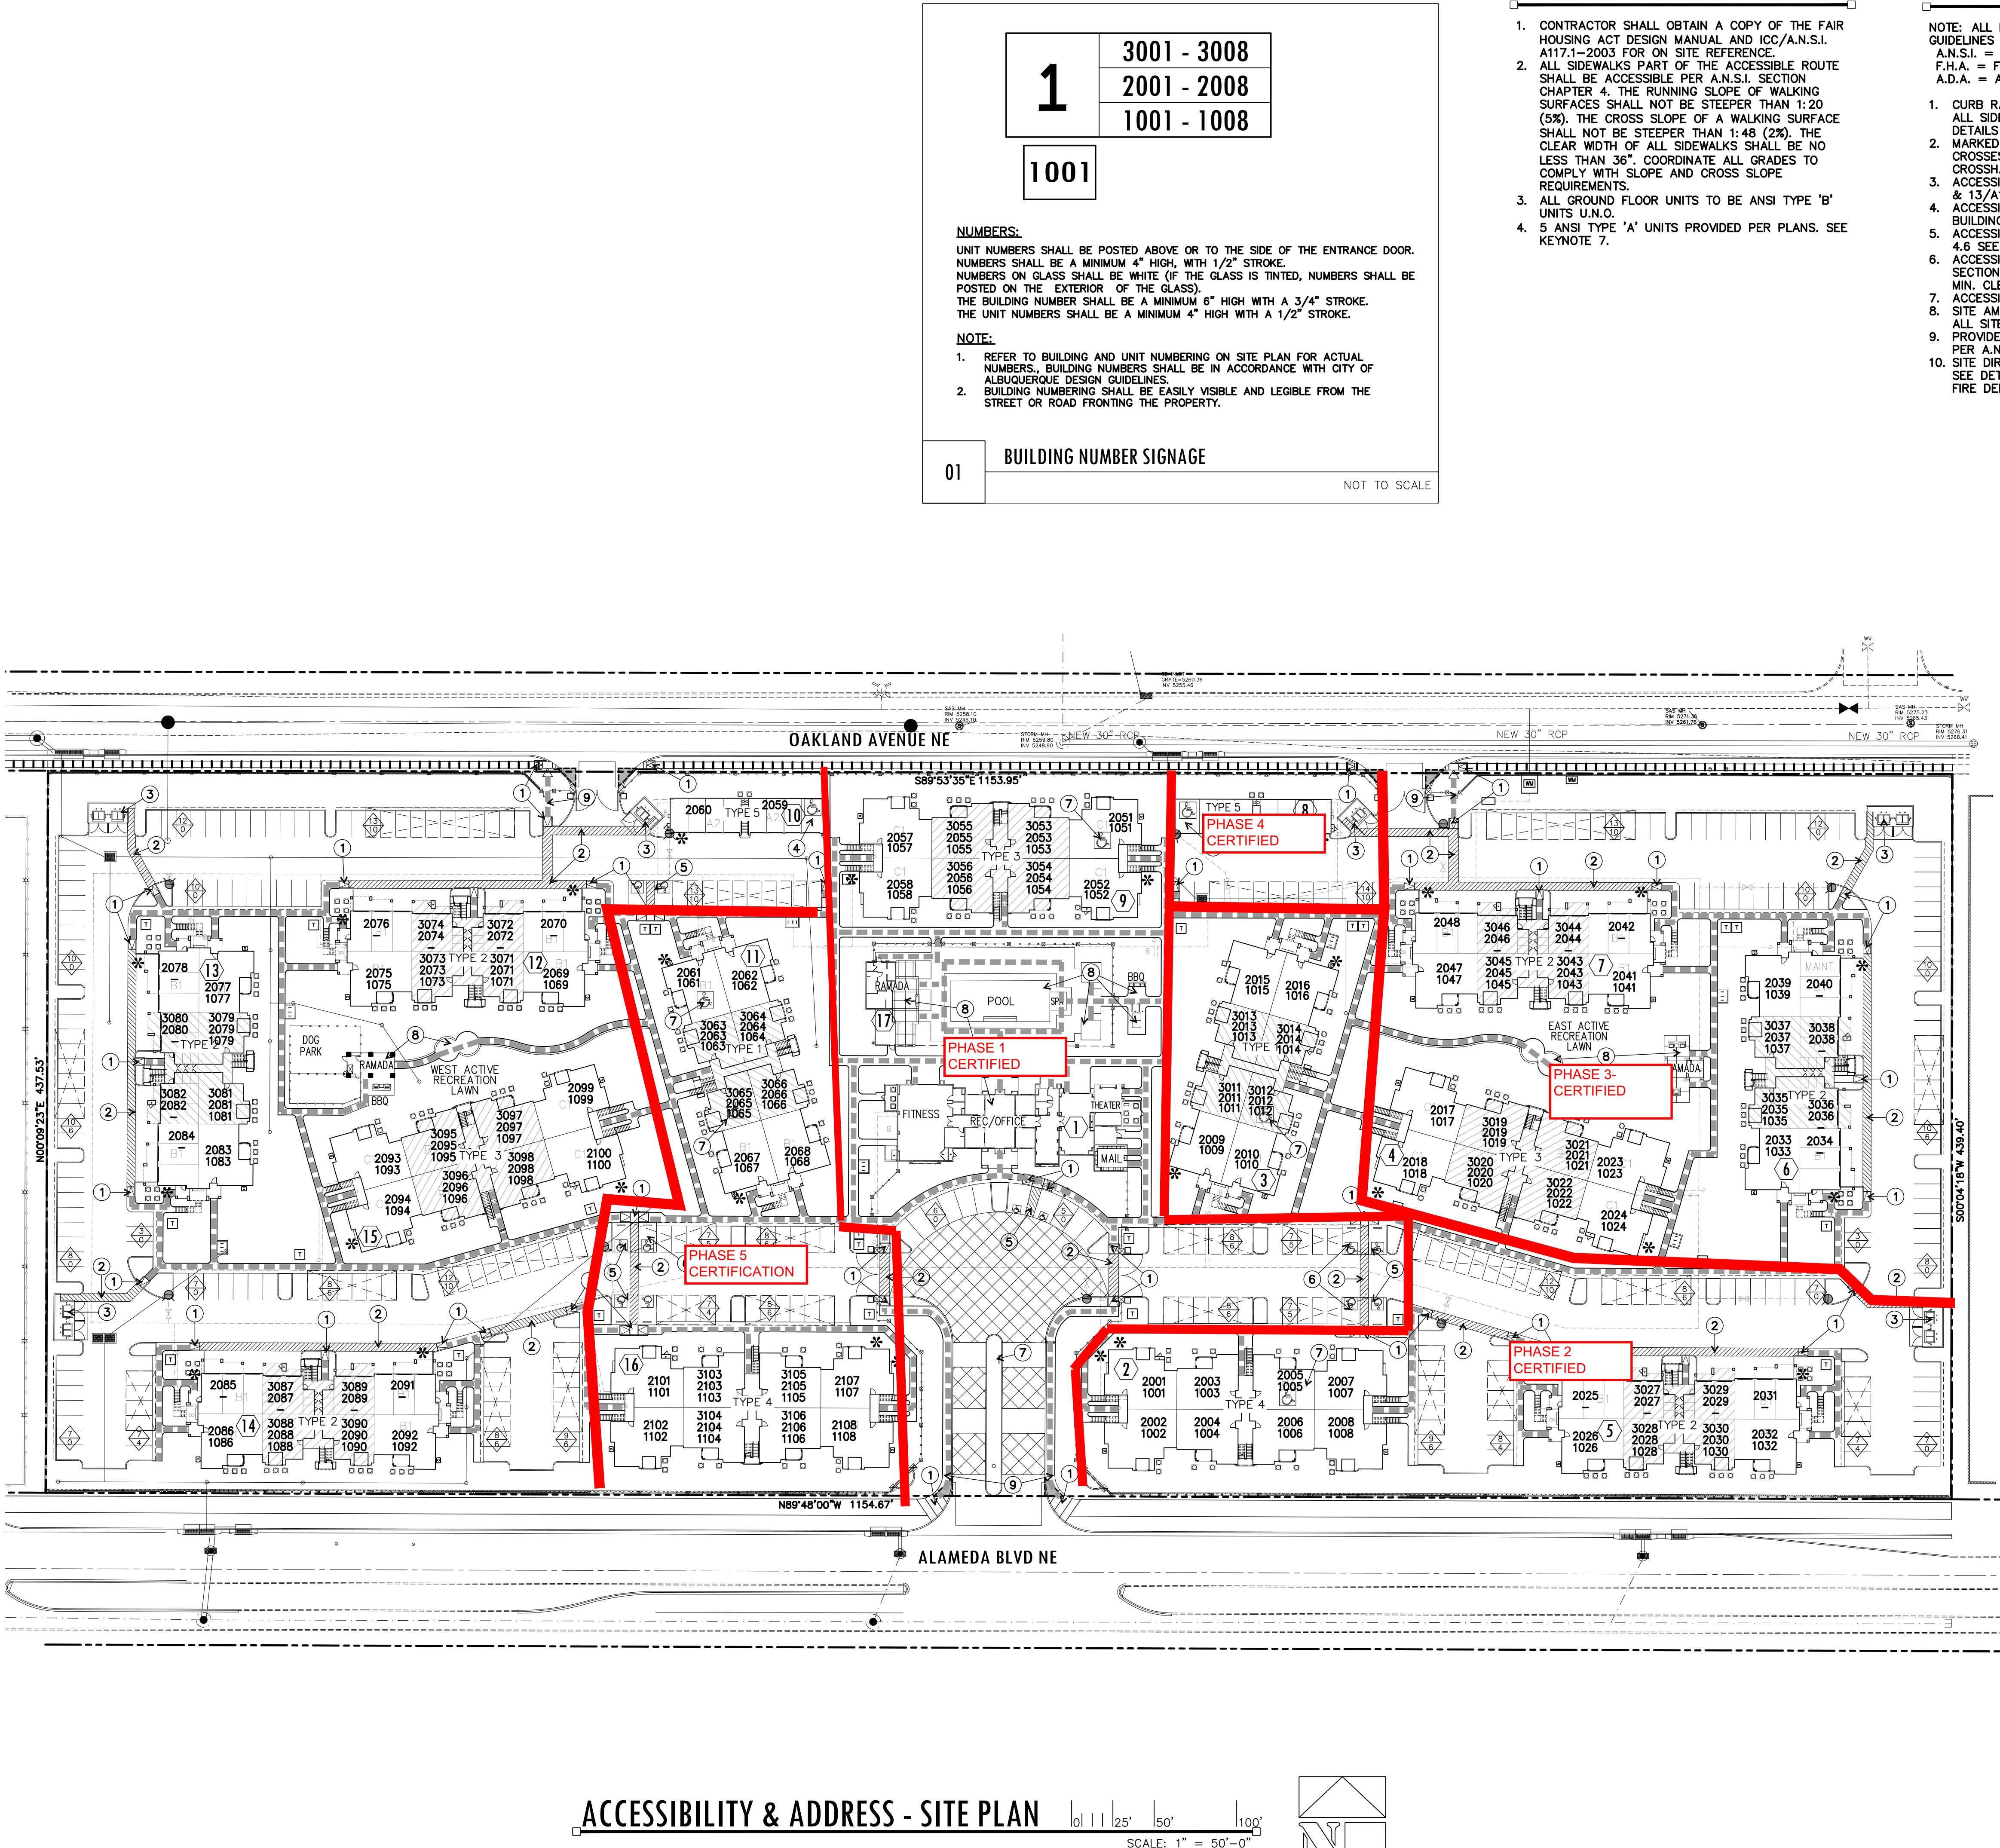


LEGACY NAA
APARTMENTS

SAN PEDRO AND ALAMEDA
Albuquerque, New Mexico

Office of Rich Barber
ORB
Architecture, LLC

WorldHQ@ORBArch.com

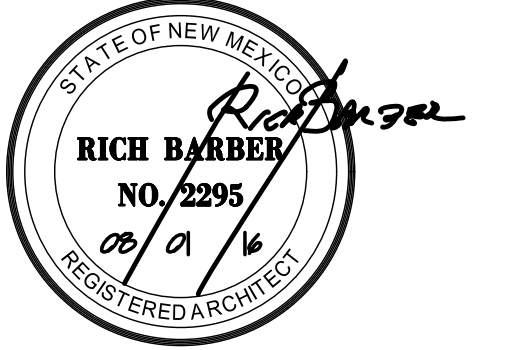

Contractor must verify all dimensions at project before proceeding with this work.

Do not reproduce these drawings and specifications without the expressed written permission of the Architect. The drawings and specifications are instruments of service and shall remain the property of the Architect, whether the project for which they are made is executed or not. These drawings and specifications shall not be used by anyone on any other projects, for additions to this project or for completion of this project by others except by the expressed written permission of the Architect.

© ORB Architecture, LLC 2015

REVISIONS	
△	
△	
1ST. CITY SUBMITTAL	

DATE: AUGUST 01, 2016 ORB # 15-218


A1.30

ACCESSIBILITY & ADDRESS
SITE PLAN

ACCESSIBILITY & ADDRESS - SITE PLAN

10' 11' 12' 15' 100'

SCALE: 1" = 50'-0"

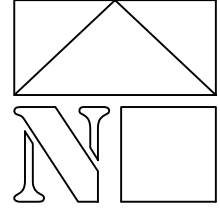



City of Albuquerque

Planning Department

Development & Building Services Division

DRAINAGE AND TRANSPORTATION INFORMATION SHEET

(REV 02/2013)

Project Title: LEGACY NAA APARTMENT Building Permit #: _____ City Drainage #: C18-d064B
DRB#: _____ EPC#: _____ Work Order#: _____
Legal Description: LOTS 4-10 & 23-29 BLOCK 28, TRACT A, UNT B NORTH ALB ACES
City Address: OAKLAND BETWEEN SAN PEDRO AND LOUISIANA

Engineering Firm: RIO GRANDE ENGINEERING Contact: DAVID SOULE
Address: PO BOX 93924, ALBUQUERQUE, NM 87199
Phone#: 505.321.9099 Fax#: 505.872.0999 E-mail: DAVID@RIOGRANDEENGINEERING.COM

Owner: VANDY INVESTMENTS, LLC Contact: _____
Address: 6501 EAGLE ROCK
Phone#: _____ Fax#: _____ E-mail: _____

Architect: Rich Barber Contact: _____
Address: _____
Phone#: _____ Fax#: _____ E-mail: _____

Surveyor: CONSTRUCTION SURVEY TECHNOLOGIES Contact: JOHN GALLEGOS
Address: _____
Phone#: 917.8921 Fax#: _____ E-mail: _____

Contractor: _____ Contact: _____
Address: _____
Phone#: _____ Fax#: _____ E-mail: _____

TYPE OF SUBMITTAL:

☐ DRAINAGE REPORT
☐ DRAINAGE PLAN 1st SUBMITTAL
☐ DRAINAGE PLAN RESUBMITTAL
☐ CONCEPTUAL G & D PLAN
☐ GRADING PLAN
☐ EROSION & SEDIMENT CONTROL PLAN (ESC)
☐ ENGINEER'S CERT (HYDROLOGY)
☐ CLOMR/LOMR
☒ TRAFFIC CIRCULATION LAYOUT (TCL) ***
☐ ENGINEER'S CERT (TCL)
☐ ENGINEER'S CERT (DRB SITE PLAN)
☐ ENGINEER'S CERT (ESC)
☐ SO-19
☐ OTHER (SPECIFY) _____

CHECK TYPE OF APPROVAL/ACCEPTANCE SOUGHT:

☐ SIA/FINANCIAL GUARANTEE RELEASE
☐ PRELIMINARY PLAT APPROVAL
☐ S. DEV. PLAN FOR SUB'D APPROVAL
☐ S. DEV. FOR BLDG. PERMIT APPROVAL
☐ SECTOR PLAN APPROVAL
☐ FINAL PLAT APPROVAL
☒ CERTIFICATE OF OCCUPANCY (PERM)
☐ CERTIFICATE OF OCCUPANCY (TCL TEMP)
☐ FOUNDATION PERMIT APPROVAL
☐ BUILDING PERMIT APPROVAL
☐ GRADING PERMIT APPROVAL ☐ SO-19 APPROVAL
☐ PAVING PERMIT APPROVAL ☐ ESC PERMIT APPROVAL
☐ WORK ORDER APPROVAL ☐ ESC CERT. ACCEPTANCE
☐ GRADING CERTIFICATION ☐ OTHER (SPECIFY) _____

WAS A PRE-DESIGN CONFERENCE ATTENDED: _____ Yes ☒ No _____ Copy Provided

DATE SUBMITTED: 6/28/18

By: _____

Requests for approvals of Site Development Plans and/or Subdivision Plats shall be accompanied by a drainage submittal. The particular nature, location, and scope to the proposed development defines the degree of drainage detail. One or more of the following levels of submittal may be required based on the following:

1. **Conceptual Grading and Drainage Plan:** Required for approval of Site Development Plans greater than five (5) acres and Sector Plans
2. **Drainage Plans:** Required for building permits, grading permits, paving permits and site plans less than five (5) acres
3. **Drainage Report:** Required for subdivision containing more than ten (10) lots or constituting five (5) acres or more
4. **Erosion and Sediment Control Plan:** Required for any new development and redevelopment site with 1-acre or more of land disturbing area, including project less than 1-acre that are part of a larger common plan of development

*** CERTIFICATION FOR BUILDING 16 (BP201700027) AND BUILDING 11 (BP201700022)
ONLY

RIO GRANDE ENGINEERING OF NEW MEXICO, LLC

TRAFFIC CERTIFICATION

I, DAVID SOULE, NMPE, OF THE FIRM RIO GRANDE ENGINEERING, HEREBY CERTIFY THAT THIS PROJECT IS IN SUBSTANTIAL COMPLIANCE WITH AND IN ACCORDANCE WITH THE DESIGN INTENT OF THE APPROVED PLAN DATED 12/14/15. THE RECORD INFORMATION EDITED ONTO THE ORIGINAL DESIGN DOCUMENT HAS BEEN OBTAINED BY WILL PLOTNER NMPLS 14271 OF THE CARTESIAN SURVEYSURVTEK. I FURTHER CERTIFY THAT I HAVE PERSONALLY VISITED THE PROJECT SITE ON 6/22/18 AND HAVE DETERMINED BY VISUAL INSPECTION THAT THE SURVEY DATA PROVIDED IS REPRESENTATIVE OF ACTUAL SITE CONDITIONS AND IS TRUE AND CORRECT TO THE BEST OF MY KNOWLEDGE AND BELIEF. THIS CERTIFICATION IS SUBMITTED IN SUPPORT OF A REQUEST FOR CERTIFICATE OF OCCUPANCY.

EXCEPTIONS:

THIS CERTIFICATION IS FOR 6301 ALAMEDA BUILDING 16 (BP20170027) AND BUILDING 11 (BP20170022) ONLY

THE RECORD INFORMATION PRESENTED HEREON IS NOT NECESSARILY COMPLETE AND INTENDED ONLY TO VERIFY SUBSTANTIAL COMPLIANCE OF THE TRAFFIC ASPECTS OF THIS PROJECT. THOSE RELYING ON THE RECORD DOCUMENT ARE ADVISED TO OBTAIN INDEPENDENT VERIFICATION OF ITS ACCURACY BEFORE USING IT FOR ANY OTHER PURPOSE.



Signature of Engineer



5/27/18

Date