

CITY OF ALBUQUERQUE



Richard J. Berry, Mayor

March 30, 2017

Fred C. Arfman, P.E.
Isaacson & Arfman, P.A.
128 Monroe St. N.E.
Albuquerque, NM, 87108

**RE: Alameda Self Storage – Oakland Storm Drain Improvements
Grading Plan
Stamp Date: 3/2/17
Hydrology File: C18D064A**

Dear Mr. Arfman:

PO Box 1293

Based upon the information provided in your submittal received 3/6/2017, the Grading Plan and Drainage Report (Supplemental Information Onsite Pond Revisions) is approved for Grading Permit and Paving Permit.

Albuquerque

If you have any questions, please contact me at 924-3995 or rbrissette@cabq.gov.

New Mexico 87103

Sincerely,

Renee C. Brissette

www.cabq.gov

Reneé C. Brissette, P.E.
Senior Engineer, Hydrology
Planning Department

MARCH 2, 2017

SUPPLEMENTAL INFORMATION

FOR

ALAMEDA SELF STORAGE BUILDING ADDITIONS

6800 Oakland Ave. NE
Albuquerque, NM



PROJECT NO. 2204

BY



ISAACSON & ARFMAN, P.A.
Consulting Engineering Associates

Thomas O. Isaacson, PE(RET.) & LS(RET.)
Fred C. Arfman, PE
Åsa Nilsson-Weber, PE

INTRODUCTION

The Alameda Self-Storage facility was developed in 2006 with an interim drainage solution consisting of a private on-site stormwater retention facility along the west property line. The holding of developed storm waters was required due to limited downstream capacity in the rural type public roadways adjacent to the site and the absence of a storm drain extension from the public system(s) to the west.

The purpose of this report is to support the elimination of the existing on-site detention pond based on the upcoming storm drain system in Oakland Ave.

I. EXISTING CONDITIONS

The approved Grading and Drainage Plan (**C18/D64A –included for information**) for the Alameda Self Storage facility (Property) prepared by this office (I&A Project Number 1418 dated May 2005) consisted of a full build plan and an interim condition plan which required on-site retention ponding until proposed off-site public storm drain infrastructure was available to the site.

II. PROPOSED CONDITIONS

Per the approved 2005 plans and supplemental information, once the Oakland Avenue / Alameda Blvd. storm drain systems are installed, the interim retention pond will no longer be required.

South Basin: The recent (2015) construction of the Alameda Blvd. storm drain and paving improvements included public storm drain with a stub provided to this property. The south First Flush / detention pond was constructed in 2015/16 to release to Alameda Blvd. at the allowable rate of 5.84 cfs.

North Basin: The 1.8 acre North Basin will generate 8.5 cfs. Per the Master Plan, the allowable discharge rate, based on a land treatment ratio of A:0 B:16 C:34 D:50 is 7.0 cfs.

The area outside the perimeter walls will continue to free discharge 0.5 cfs to Oakland Ave. 1.6 acres inside the perimeter walls will drain 8.0 cfs to the proposed detention pond which will provide orifice control to reduce the discharge to 6.5 cfs to the Oakland Ave. storm drain.

Total discharge to Oakland Ave. = 0.5 cfs (exterior basin) + 6.5 (from NW pond) = 7.0 cfs.
OK

Total detention will be 8.0 cfs (portion of north basin within perimeter walls) – 6.5 cfs (discharge from pond to Oakland storm drain stub) = 1.5 cfs.

III. FIRST FLUSH REQUIREMENTS

Effective May of 2014, the City of Albuquerque Drainage Ordinance requires that all new development projects, where practicable, shall manage the First Flush defined as the storm water runoff during the early stages of a storm equal to or less than runoff from a 90th Percentile Storm Event ($=0.34''/\text{sf}$ impervious area after initial abstraction).

The south pond, constructed in 2015 provides first flush retention volume of 1,800 cf.

The north pond which will be constructed by this project, has an area of 900 sf. At a depth of 1.5', the available retention volume = $900 \text{ sf} \times 1.5 \text{ ft} = 1,350 \text{ cf}$. Total First Flush retention = 3,150 cf.

CALCULATIONS: NORTH BASIN

Based on Drainage Design Criteria for City of Albuquerque Section 22.2, DPM, Vol 2, dated Jan., 1993

ON-SITE

AREA OF SITE: 77220 SF = 1.8

100-year, 6-hour

ALLOWABLE DISCHARGE:

DEVELOPED FLOWS:

EXCESS PRECIP:

	Treatment SF	%		Treatment SF	%	Precip. Zone	3
Area A =	0	0%	Area A =	0	0%	E _A	= 0.66
Area B =	26254.8	34%	Area B =	3861	5%	E _B	= 0.92
Area C =	12355.2	16%	Area C =	3861	5%	E _C	= 1.29
Area D =	38610	50%	Area D =	69498	90%	E _D	= 2.36
Total Area =	77220	100%	Total Area =	77220	100%		

On-Site Weighted Excess Precipitation (100-Year, 6-Hour Storm)

$$\text{Weighted E} = \frac{E_A A_A + E_B A_B + E_C A_C + E_D A_D}{A_A + A_B + A_C + A_D}$$

Historic E =	1.70 in.	Developed E =	2.23 in.
--------------	----------	---------------	----------

On-Site Volume of Runoff: $V_{360} = E * A / 12$

Historic V_{360} =	10934 CF	Developed V_{360} =	14379 CF
----------------------	----------	-----------------------	----------

On-Site Peak Discharge Rate: $Q_p = Q_{pA} A_A + Q_{pB} A_B + Q_{pC} A_C + Q_{pD} A_D / 43,560$

For Precipitation Zone 3

Q_{pA} =	1.87	Q_{pC} =	3.45
Q_{pB} =	2.60	Q_{pD} =	5.02
Historic Q_p =	7.0 CFS	Developed Q_p =	8.5 CFS

The allowable discharge to the public storm drain in Oakland is = 7.0 cfs. The exterior of the property (N2) discharges 0.5 cfs. The interior (N1) will control release to 7.0 - 0.5 = 6.5 cfs.

1.6 cfs will be detained. See Hydrograph next page.

BASIN NO.	N1	DESCRIPTION	INTERIOR WALLED AREA
Area of basin flows =	69948	SF =	1.6 Ac.
The following calculations are based on Treatment areas as shown in table to the right			
			LAND TREATMENT
Sub-basin Weighted Excess Precipitation (see formula above)			A = 0%
Weighted E =			2.36 in.
Sub-basin Volume of Runoff (see formula above)			B = 0%
V_{360} =			13756 CF
Sub-basin Peak Discharge Rate: (see formula above)			C = 0%
Q_p =			8.06 cfs
			D = 100%

BASIN NO.	N2	DESCRIPTION	AREA OUTSIDE PERIMETER WALLS
Area of basin flows =	7772	SF =	0.2 Ac.
The following calculations are based on Treatment areas as shown in table to the right			
			LAND TREATMENT
Sub-basin Weighted Excess Precipitation (see formula above)			A = 0%
Weighted E =			1.11 in.
Sub-basin Volume of Runoff (see formula above)			B = 50%
V_{360} =			716 CF
Sub-basin Peak Discharge Rate: (see formula above)			C = 50%
Q_p =			0.54 cfs
			D = 0%

CALCULATIONS: 0 : 0
HYDROGRAPH FOR SMALL WATERSHED
DPM SECTION 22-2 * PAGE A-13/14

Base time, t_B , for a small watershed hydrograph is,

$$t_B = (2.107 * E * A / Q_P) - (0.25 * A_D / A)$$

Where

E	=	2.36 inches
A	=	1.61 acres
A_D	=	1.61 acres
Q_P	=	8.1 cfs

t_B	=	0.74 hours
-------	---	------------


E is the excess precipitation in inches (from DPM TABLE A-8), Q_P is the peak flow, A_D is the area (acres) of treatment D, and A_T is the total area in acres. Using the time of concentration, t_C (hours), the time to peak in hours is:

$$t_P = (0.7 * t_C) + ((1.6 - (A_D / A)) / 12)$$

Where $t_C = 0.20$ hours

$t_P = 0.19$ hours

Continue the peak for $0.25 * A_D / A_T$ hours. When A_D is zero, the hydrograph will be triangular. When A_D is not zero, the hydrograph will be trapezoidal. see the graph below:

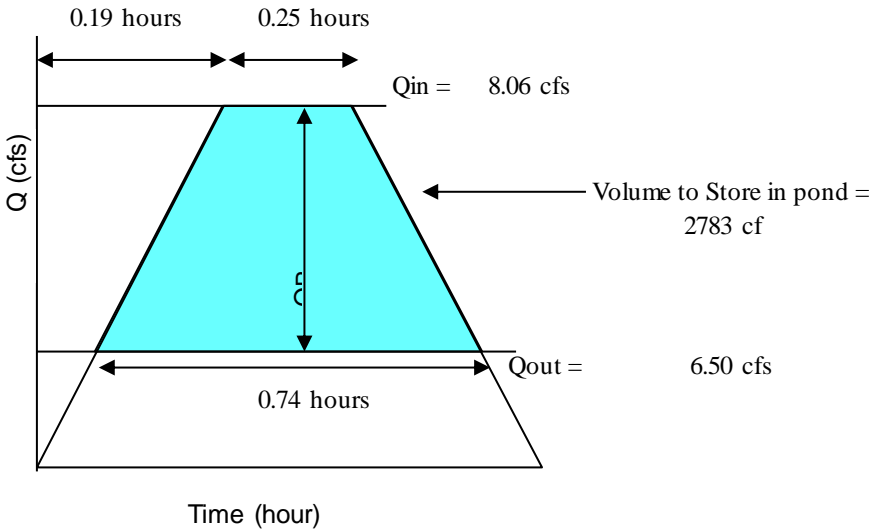

ORIFICE EQUATION - 13" ORIFICE IN POND WALL TO STORM DRAIN

The Orifice Equation is used to calculate the Flow at the opening of a Channel

$$Q = C * A * (2 * g * h)^{0.5}$$

Where	Q	=	6.46	cfs	
	C	=	0.6		(indicating that the opening will function at 60% capacity)
	A	=	0.85	sq.ft.	
	g	=	32.2	ft/sec^2	
	h	=	2.48	ft	depth of flow at opening from the center of culvert
		=			

18" outlet pipe



12.5" diameter hole cut orifice plate over outlet pipe

Invert of orifice opening = 73.0

Water Surface at emergency overflow = 76.0

Center of orifice = 73.52

At a head of 2.48' (76.0 - 73.52) a 12.5" dia. opening will pass 6.46 cfs. < 6.5 cfs

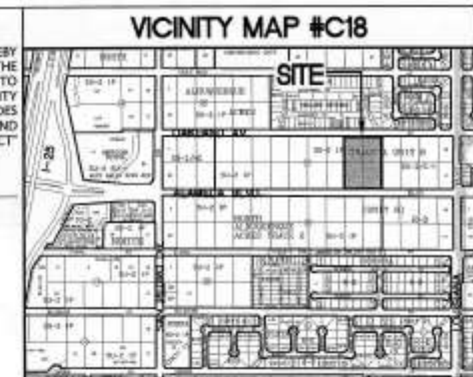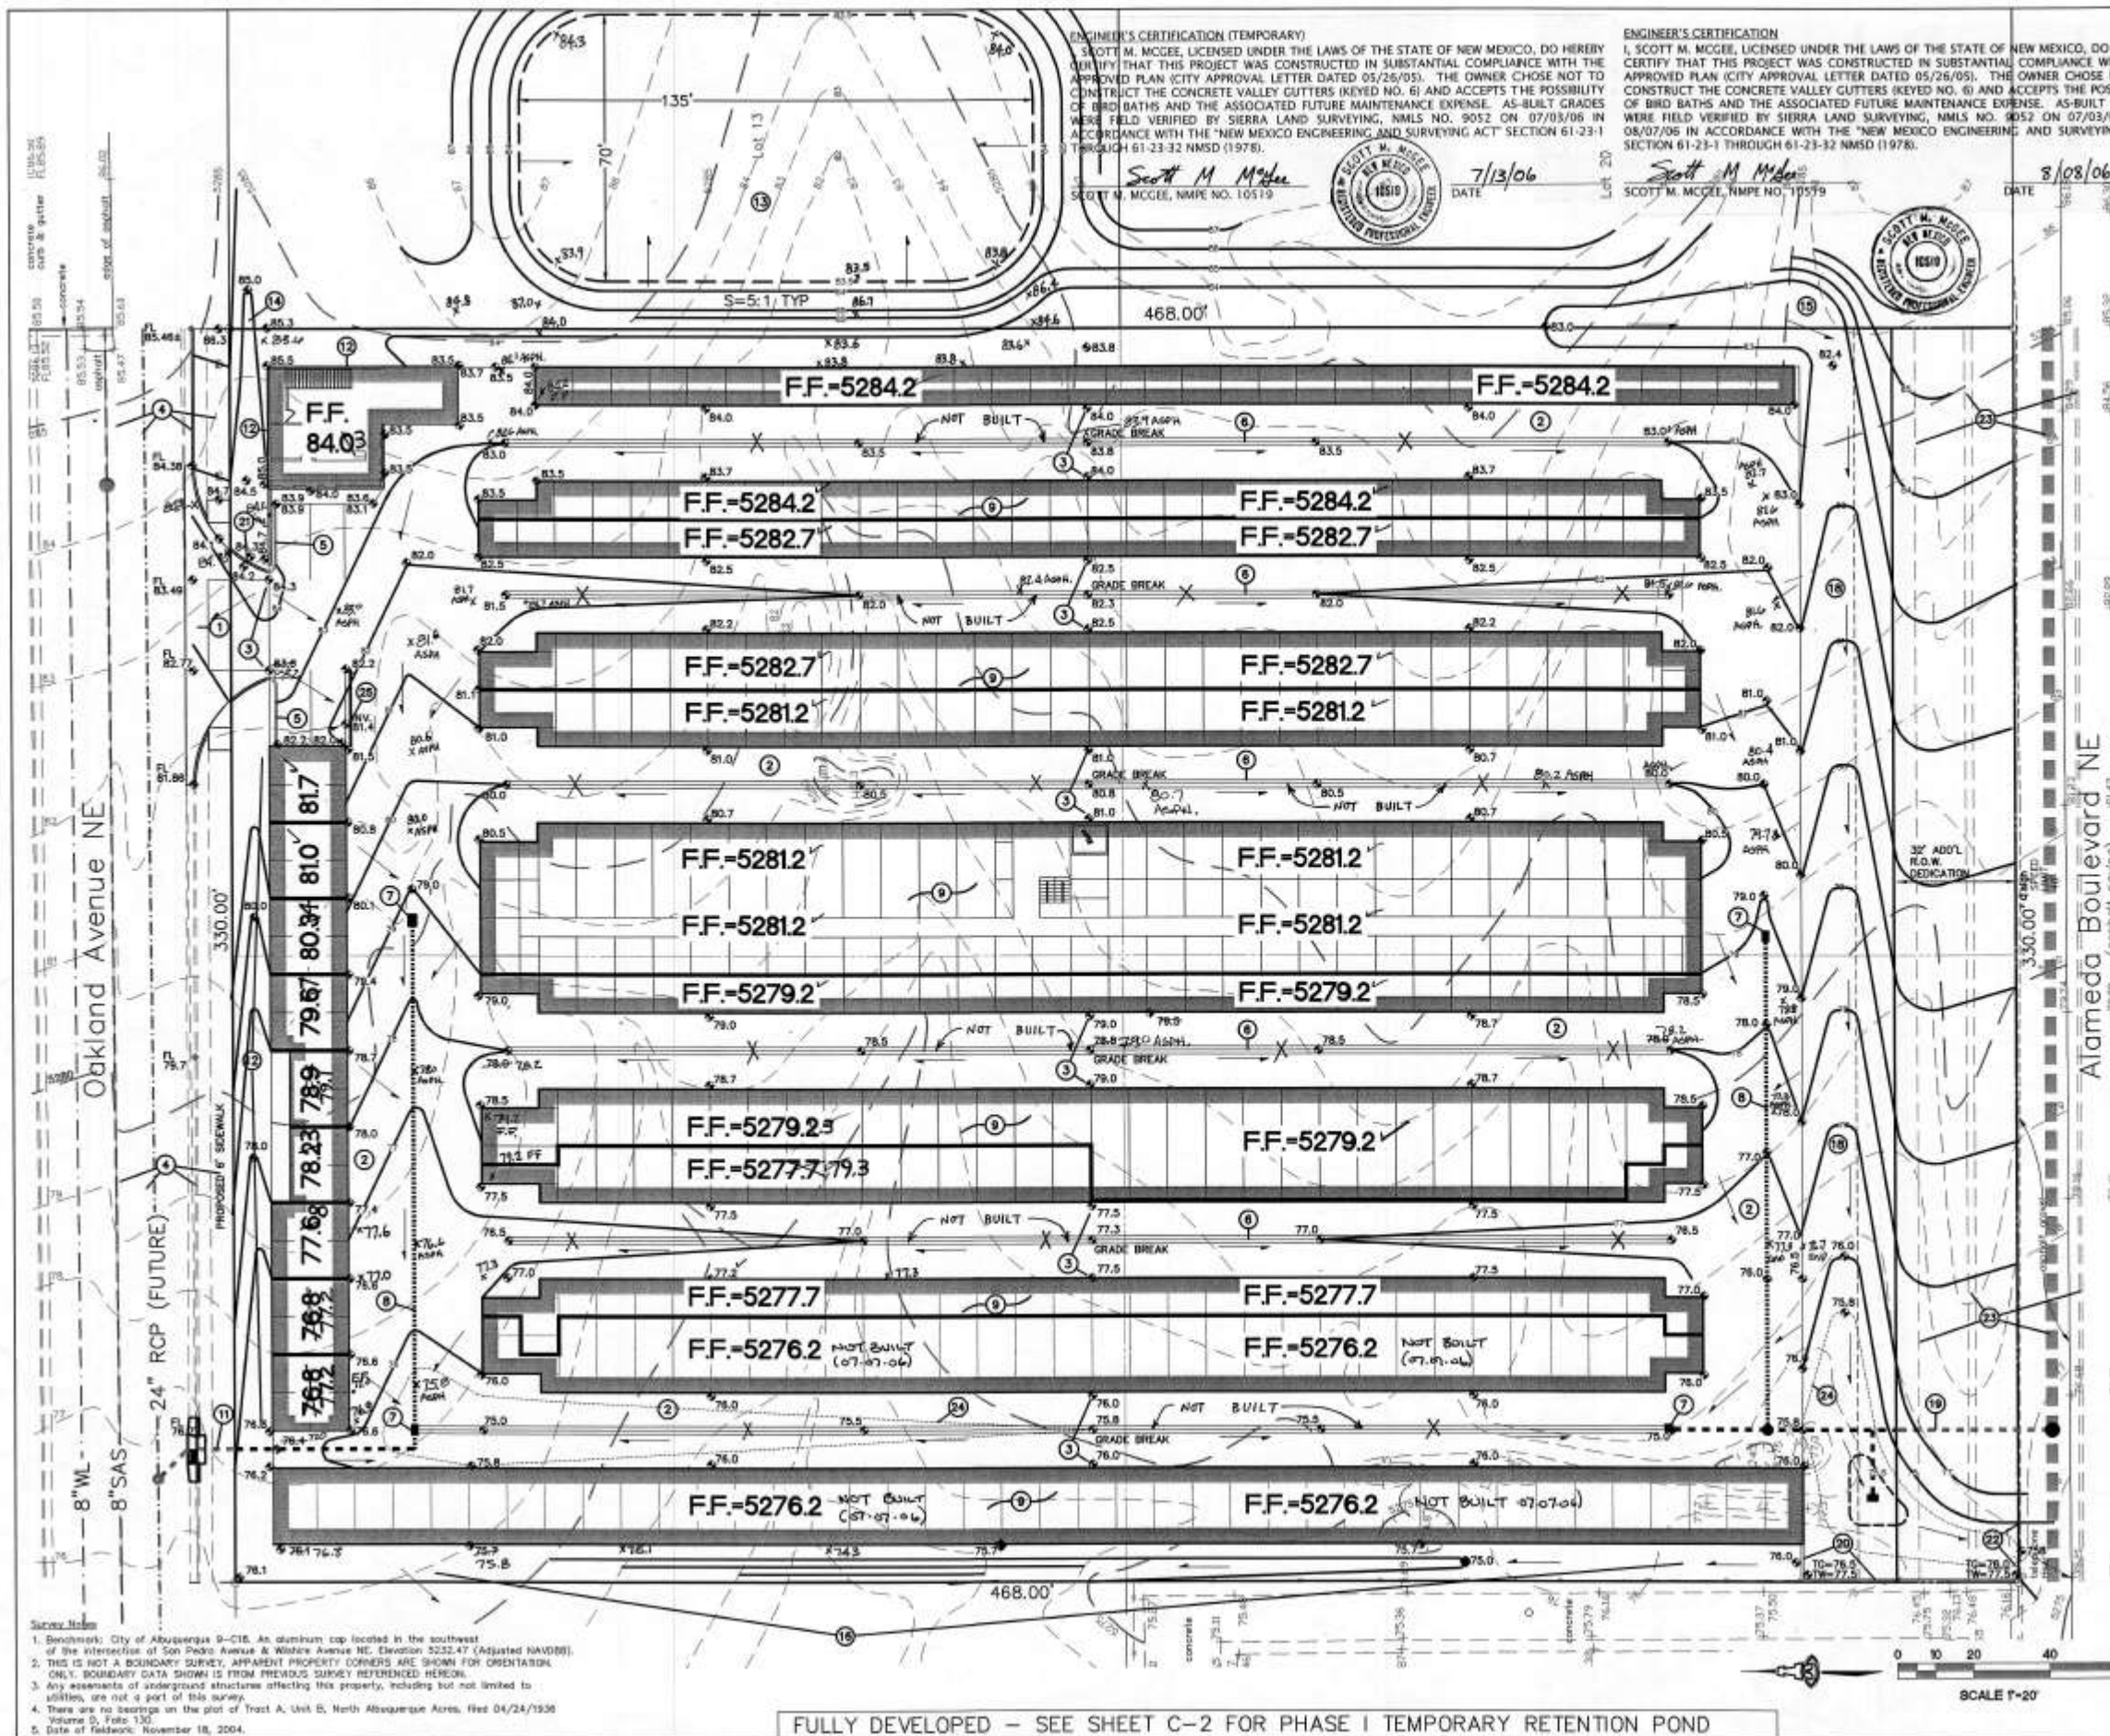

- ### KEYED NOTES
1. CONSTRUCT SITE ENTRANCE PER C.O.A. STD. DWG. 2426. SEE ARCHITECTURAL FOR ADD'L INFO. PROVIDE SMOOTH TRANSITION FROM 8" STANDARD CURB AND GUTTER AT STREET TO 6" MEDIAN CURB AND GUTTER ON-SITE.
 2. CONSTRUCT ASPHALT PAVING AT ELEVATIONS SHOWN. SEE ARCHITECTURAL FOR PARKING LAYOUT, DIMENSIONS, AND STRIPING.
 3. PAVING HIGH POINT.
 4. SOUTH HALF OF OAKLAND AVE. INFRASTRUCTURE INCLUDING PAVING, PUBLIC SIDEWALK AND PUBLIC STORM DRAIN TO BE CONSTRUCTED UNDER C.O.A. WORK ORDER.
 5. CONSTRUCT 6" HIGH MEDIAN CURB AND GUTTER AT ELEVATIONS SHOWN FOR ALL ON-SITE CURB LOCATIONS. SEE C-2 FOR DTL.
 6. CONSTRUCT 2" WIDE CONCRETE VALLEY GUTTER AT FLOWLINE ELEVATIONS SHOWN (0.0050' / MIN. SLOPE) TO DIRECT SURFACE FLOW. SEE C-2 FOR DTL.
 7. PROPOSED STORM DRAIN INLET. SEE C-2 FOR ADD'L INFO.
 8. PROPOSED PRIVATE STORM DRAIN SYSTEM (ULTIMATE CONFIGURATION). SEE DETAIL SHEET C-2 FOR INTERIM CONFIGURATION.
 9. ROOF FLOWS FROM THE PROPOSED BUILDINGS TO BE RELEASED TO INTERIOR PAVED ACCESS AISLES. NO ROOF DISCHARGE WILL BE DIRECTED TO EAST OR WEST 10' LANDSCAPE SETBACK. SEE ARCHITECTURAL PLANS.
 10. CONTRACTOR TO CONSTRUCT / VERIFY FF ELEVATIONS AND GRADES PER PLAN TO ENSURE DRAINAGE PATTERNS ARE ACHIEVED PER DESIGN.
 11. STORM SEWER DISCHARGE LINE TO BE EXTENDED FROM STUB AT PROPERTY LINE TO OAKLAND AVE. STORM DRAIN SYSTEM AS PART OF C.O.A. WORK ORDER. SEE DETAIL SHEET C-2.
 12. CONSTRUCT BUILDING RETAINING WALLS AS REQUIRED TO ACHIEVE GRADE DIFFERENCES. SEE ARCHITECTURAL DESIGN BY OTHERS.
 13. CONSTRUCT TEMPORARY OFF-SITE GRADED POND TO DIMENSIONS / ELEVATIONS SHOWN TO RETAIN OFF-SITE BASIN "200" UPSTREAM HISTORIC FLOW. OWNER NOTARIZED "PERMISSION TO GRADE" STATEMENT ON FILE. SEE SEPARATE CALCULATIONS.
 14. ADJUST GRADES THIS AREA TO DIRECT OFF-SITE BASIN "100" FLOW TO OAKLAND AVENUE.
 15. ADJUST GRADES THIS AREA TO DIRECT OFF-SITE BASIN "300" FLOW TO ALAMEDA BLVD. OWNER NOTARIZED "PERMISSION TO GRADE" STATEMENT ON FILE.
 16. DRAINAGE PLAN THIS SHEET REFLECTS FINAL SITE DEVELOPMENT WITH ALAMEDA BLVD. AND OAKLAND AVE. STORM DRAIN SYSTEMS IN PLACE. SEE SHEET C-2 FOR TEMPORARY RETENTION POND (INTERIM CONFIGURATION) THIS AREA.
 17. INTERIM CONFIGURATION: CONSTRUCT TEMPORARY GRADED ON-SITE POND TO DIMENSIONS / ELEVATIONS SHOWN TO RETAIN ON-SITE 100-YEAR 10-DAY STORM EVENT. SEE SEPARATE CALCULATIONS.
 18. CONSTRUCT 25" WIDE LANDSCAPED SWALE ON SOUTH SIDE OF SITE TO PASS OFF-SITE BASIN "300" FLOW.
 19. STORM SEWER DISCHARGE LINE TO BE EXTENDED FROM STUB AT PROPERTY LINE TO ALAMEDA BLVD. STORM DRAIN SYSTEM AS PART OF C.O.A. WORK ORDER. SEE DETAIL SHEET C-2.
 20. CONSTRUCT RETAINING GARDEN WALL (2'-2" HIGH) THIS AREA TO DIVERT OFF-SITE SUB-BASIN "300" DISCHARGE TO ALAMEDA BLVD.
 21. PROVIDE 1' WIDE OPENING IN CURB AT FLOWLINE ELEVATIONS SHOWN TO PASS OFF-SITE BASIN "100" DISCHARGE TO OAKLAND AVE.
 22. GRADE THIS AREA TO PROVIDE 15' WIDE LANDSCAPED BASIN OVERFLOW AT ELEVATIONS SHOWN.
 23. FUTURE ALAMEDA BLVD. INFRASTRUCTURE (PAVING, PUBLIC WALK AND PUBLIC STORM DRAIN).
 24. DETENTION POND EXTENTS - SEE CALCULATIONS.
 25. 1" WIDE X 6" HIGH OPENING AT FLOWLINE TO PASS MINOR FLOW.

ISAACSON & ARFMAN, P.A.
Consulting Engineering Associates
138 Monroe Street N.E.
Albuquerque, New Mexico 87106
Ph: 505-268-6828 Fax: 505-268-2632
14100250.dwg / 3/30 05.16.05


**OAKLAND AVE. NE
SELF STORAGE FACILITY**
PARKWEST CONSTRUCTION

DRAINAGE AND GRADING PLAN

Drawn by:	SMW	Check by:	BUE	Scale:	1"=20'
Date:	05.16.05	Job Number:	1410	Sheet:	C-1
					94 OF 94

Survey Notes:
1. Benchmark: City of Albuquerque 9-C18. An aluminum cap located in the southwest corner of the intersection of San Pedro Avenue & Whittier Avenue NE. Elevation 5232.47 (Adjusted NAVD83).
2. THIS IS NOT A BOUNDARY SURVEY. APPARENT PROPERTY CORNERS ARE SHOWN FOR ORIENTATION ONLY. BOUNDARY DATA SHOWN IS FROM PREVIOUS SURVEY REFERENCED HEREON.
3. Any easements or underground structures affecting this property, including but not limited to utilities, are not a part of this survey.
4. There are no bearings on the plot of Tract A, Unit B, North Albuquerque Acres. Rec'd 04/24/1998 Volume D, Page 130.
5. Date of fieldwork: November 18, 2004.



FULLY DEVELOPED - SEE SHEET C-2 FOR PHASE I TEMPORARY RETENTION POND

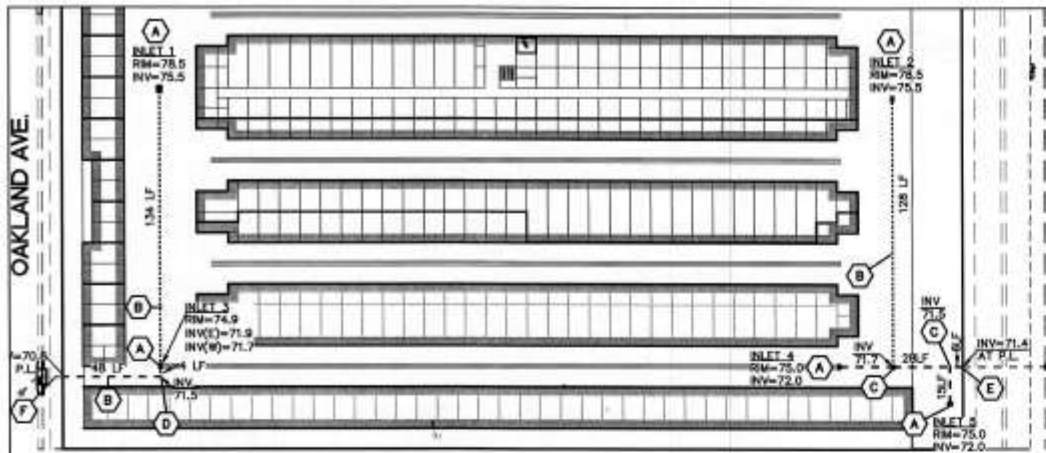


KEYED NOTES

- FINAL CONFIGURATION - SEE SHEET C-1 FOR GRADES
- (A) 30" DIA. NYLOPLAST INLINE DRAIN (#2730AG) WITH 30" DIA. STANDARD GRATE (#3099GDS) AND 12" DIA. OUTLET AT RM / INVERT ELEVATIONS SHOWN.
 - (B) ALL STORM DRAIN PIPE TO BE 12" DIA. PVC PIPE AT LENGTHS AND INVERTS SHOWN.
 - (C) 12" TEE
 - (D) 12" 90° BEND
 - (E) 12" PVC PIPE EXTENDED TO PROPERTY LINE FOR CONNECTION TO ALAMEDA STORM DRAIN SYSTEM. CONNECTION TO BE MADE AS PART OF ALAMEDA BLVD. CONSTRUCTION. SEE INTERIM PLAN THIS SHEET FOR TEMPORARY ON-SITE PONDING.
 - (F) 12" PVC PIPE EXTENDED TO PROPERTY LINE FOR CONNECTION TO OAKLAND STORM DRAIN SYSTEM. CONNECTION TO BE MADE AS PART OF OAKLAND AVE. CONSTRUCTION. SEE INTERIM PLAN THIS SHEET FOR TEMPORARY ON-SITE PONDING.

SEE INTERIM CONFIGURATION PLAN THIS SHEET FOR ON-SITE POND AND TEMPORARY STORM DRAIN CONFIGURATION.

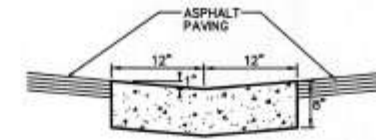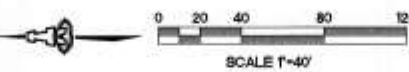

VALLEY GUTTER

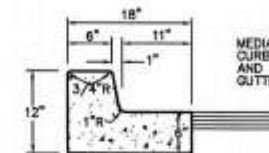

MEDIAN CURB AND GUTTER

GENERAL NOTES

- PROVIDE CONST. CONTROL JOINTS @ 8' O.C. MAX. AND 1/2" EXPANSION JOINTS @ 45' O.C. MAX.
- EDGES SHOULD BE REMOVED WITH 3/8" EDGING TOOL.
- MEDIAN C & G REQUIRE FULL FORM ON ALL FACES.

LEGEND

- PROPERTY LINE
- EXISTING SPOT ELEVATION
- EXISTING CONTOUR
- PROPOSED SPOT ELEVATION
- PROPOSED CONTOUR
- SURFACE FLOW DIRECTION
- TOP OF GRADE
- TOP OF WALL
- TOP OF CURB
- FLOW LINE
- FINISHED FLOOR
- R.O.W.
- PROPERTY LINE
- X 77.3 AT-BUILT ELEVATION

ON-SITE STORM DRAIN DESIGN - ULTIMATE CONFIGURATION

ENGINEER'S CERTIFICATION (TEMPORARY)
I, SCOTT M. MCCOE, LICENSED UNDER THE LAWS OF THE STATE OF NEW MEXICO, DO HEREBY CERTIFY THAT THIS PROJECT WAS CONSTRUCTED IN SUBSTANTIAL COMPLIANCE WITH THE APPROVED PLAN (CITY APPROVAL LETTER DATED 05/26/05). THE OWNER CHOSE NOT TO CONSTRUCT THE CONCRETE VALLEY GUTTERS (KEYED NO. 6) AND ACCEPTS THE POSSIBILITY OF BIRD BATHS AND THE ASSOCIATED FUTURE MAINTENANCE EXPENSE. AS-BUILT GRADES WERE FIELD VERIFIED BY SIERRA LAND SURVEYING, NMLS NO. 9052 ON 07/03/06 IN ACCORDANCE WITH THE 'NEW MEXICO ENGINEERING AND SURVEYING ACT' SECTION 61-23-1 THROUGH 61-23-32 NMSD (1978).

Scott M. McCoie
SCOTT M. MCCOE, NMPE NO. 10519



DATE 7/13/06


ENGINEER'S CERTIFICATION

I, SCOTT M. MCCOE, LICENSED UNDER THE LAWS OF THE STATE OF NEW MEXICO, DO HEREBY CERTIFY THAT THIS PROJECT WAS CONSTRUCTED IN SUBSTANTIAL COMPLIANCE WITH THE APPROVED PLAN (CITY APPROVAL LETTER DATED 05/26/05). THE OWNER CHOSE NOT TO CONSTRUCT THE CONCRETE VALLEY GUTTERS (KEYED NO. 6) AND ACCEPTS THE POSSIBILITY OF BIRD BATHS AND THE ASSOCIATED FUTURE MAINTENANCE EXPENSE. AS-BUILT GRADES WERE FIELD VERIFIED BY SIERRA LAND SURVEYING, NMLS NO. 9052 ON 07/03/06 AND 08/07/06 IN ACCORDANCE WITH THE 'NEW MEXICO ENGINEERING AND SURVEYING ACT' SECTION 61-23-1 THROUGH 61-23-32 NMSD (1978).

Scott M. McCoie
SCOTT M. MCCOE, NMPE NO. 10519



DATE 8/08/06

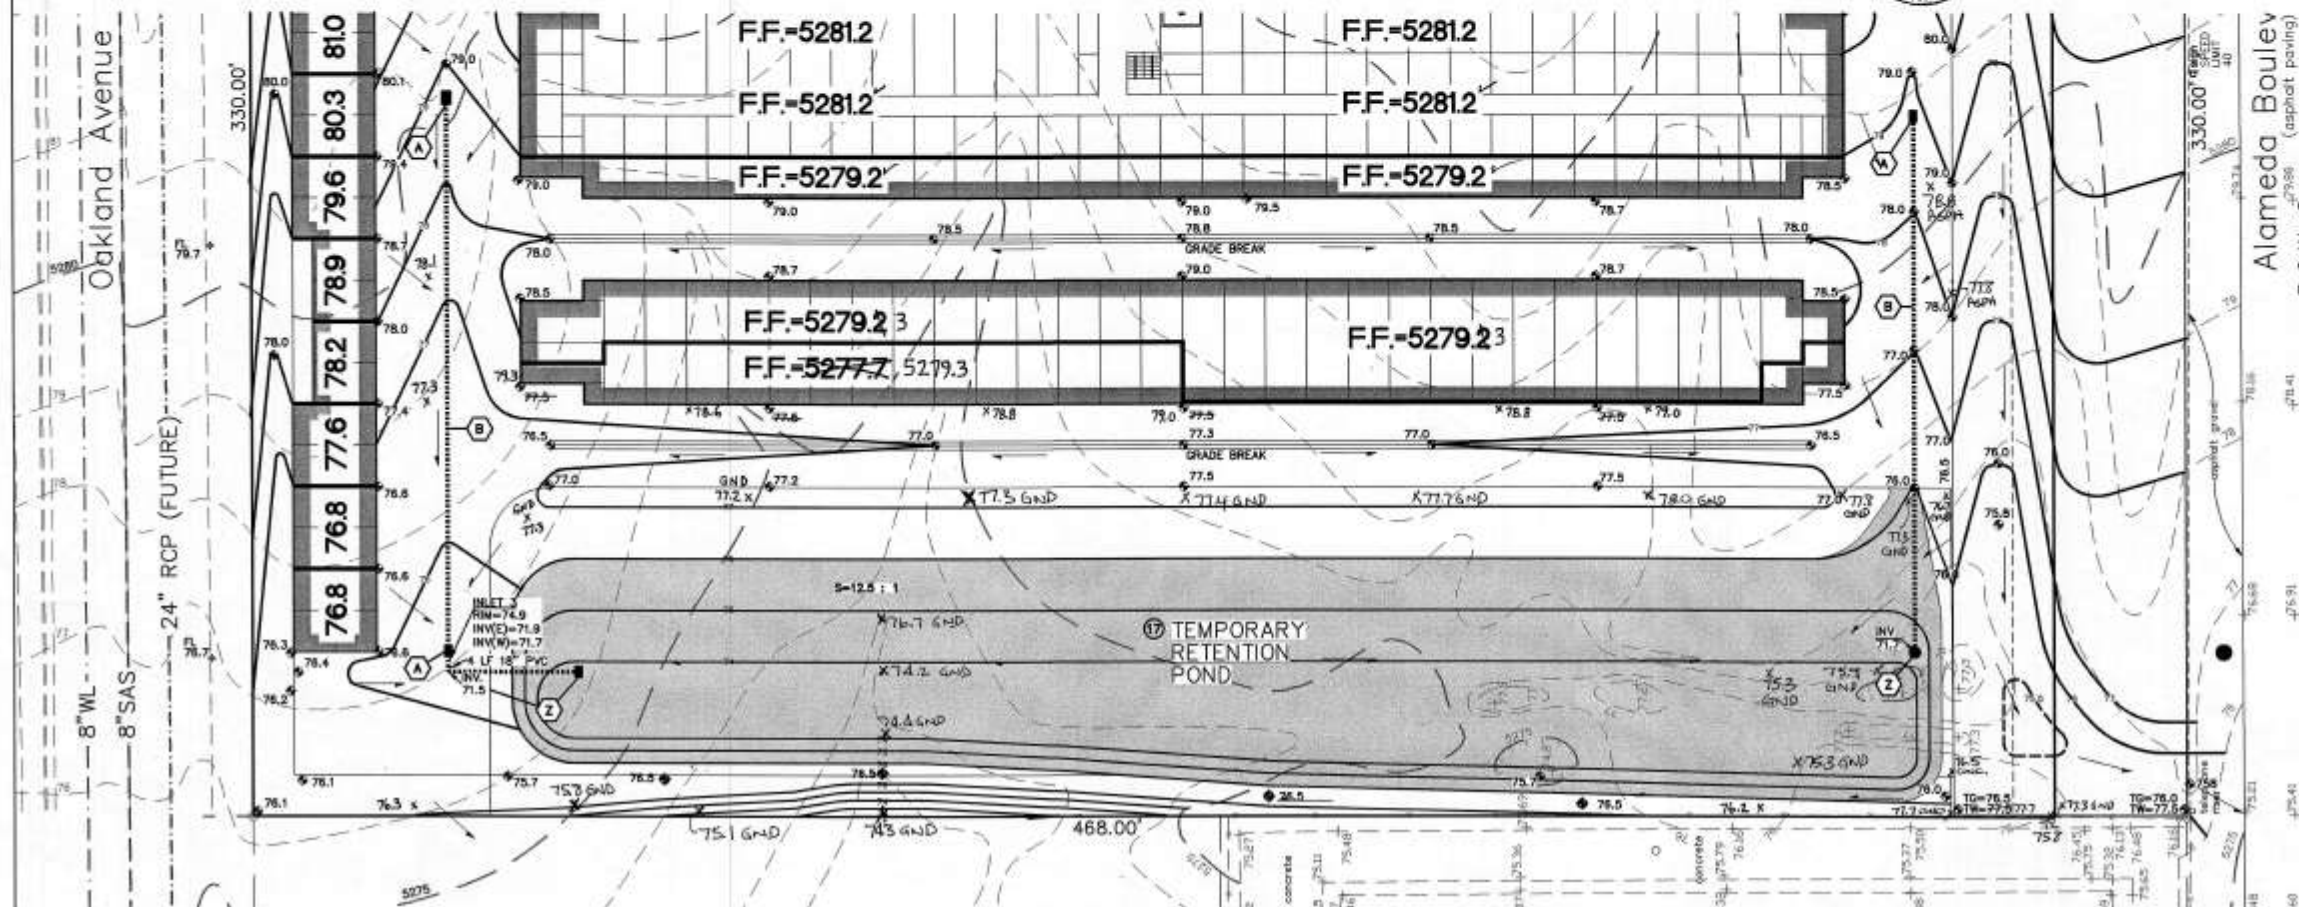

WEST TEMPORARY RETENTION POND - INTERIM CONFIGURATION

KEYED NOTES

- INTERIM GRADING, POND AND STORM DRAIN CONFIGURATION
- SEE FINAL CONFIGURATION PLAN AND KEYED NOTES THIS SHEET FOR INLET RIMS AND ELEVATIONS, PIPE SIZES AND LENGTHS, AND FITTINGS. THIS PLAN COVERS INTERIM INFORMATION ONLY.
- (A) INLINE DRAIN
 - (B) 12" PVC PIPE
- INTERIM CONFIGURATION PLAN AT LEFT TO BE CONSTRUCTED AND MAINTAINED UNTIL CONNECTIONS ARE MADE TO FUNCTIONING ALAMEDA BLVD. AND THE OAKLAND AVE. PUBLIC STORM DRAIN SYSTEMS AT WHICH TIME, THE FOLLOWING ITEMS MAY BE REMOVED FOR FINAL PHASE CONSTRUCTION.
- (Z) EXTEND 12" STORM DRAIN PIPE INTO TEMPORARY 38" CMP VERTICAL OUTLET PIPE TO RELEASE NORTH BASIN FLOW TO TEMPORARY RETENTION POND. CMP RM=75.0, INVERT=71.5.


ISAACSON & ARFMAN, P.A.
Consulting Engineering Associates
128 Monroe Street N.E.
Albuquerque, New Mexico 87108
Ph: 505-269-6828 Fax: 505-269-2632
1416620.dwg / bjb 05.18.05

This design, calculations, and concepts are owned by and remain the property of Isaacson & Arfman, P.A. and no part thereof shall be utilized by any person, firm or corporation for any purpose whatsoever except with the written permission of Isaacson & Arfman, P.A.

OAKLAND AVE. NE
SELF STORAGE FACILITY
PARKWEST CONSTRUCTION

DRAINAGE AND GRADING DETAILS

Drawn By: SWM	Drawn By: BJB	No.	Revision	C-2
Date: 05.18.05	Date: 1418			SH OF

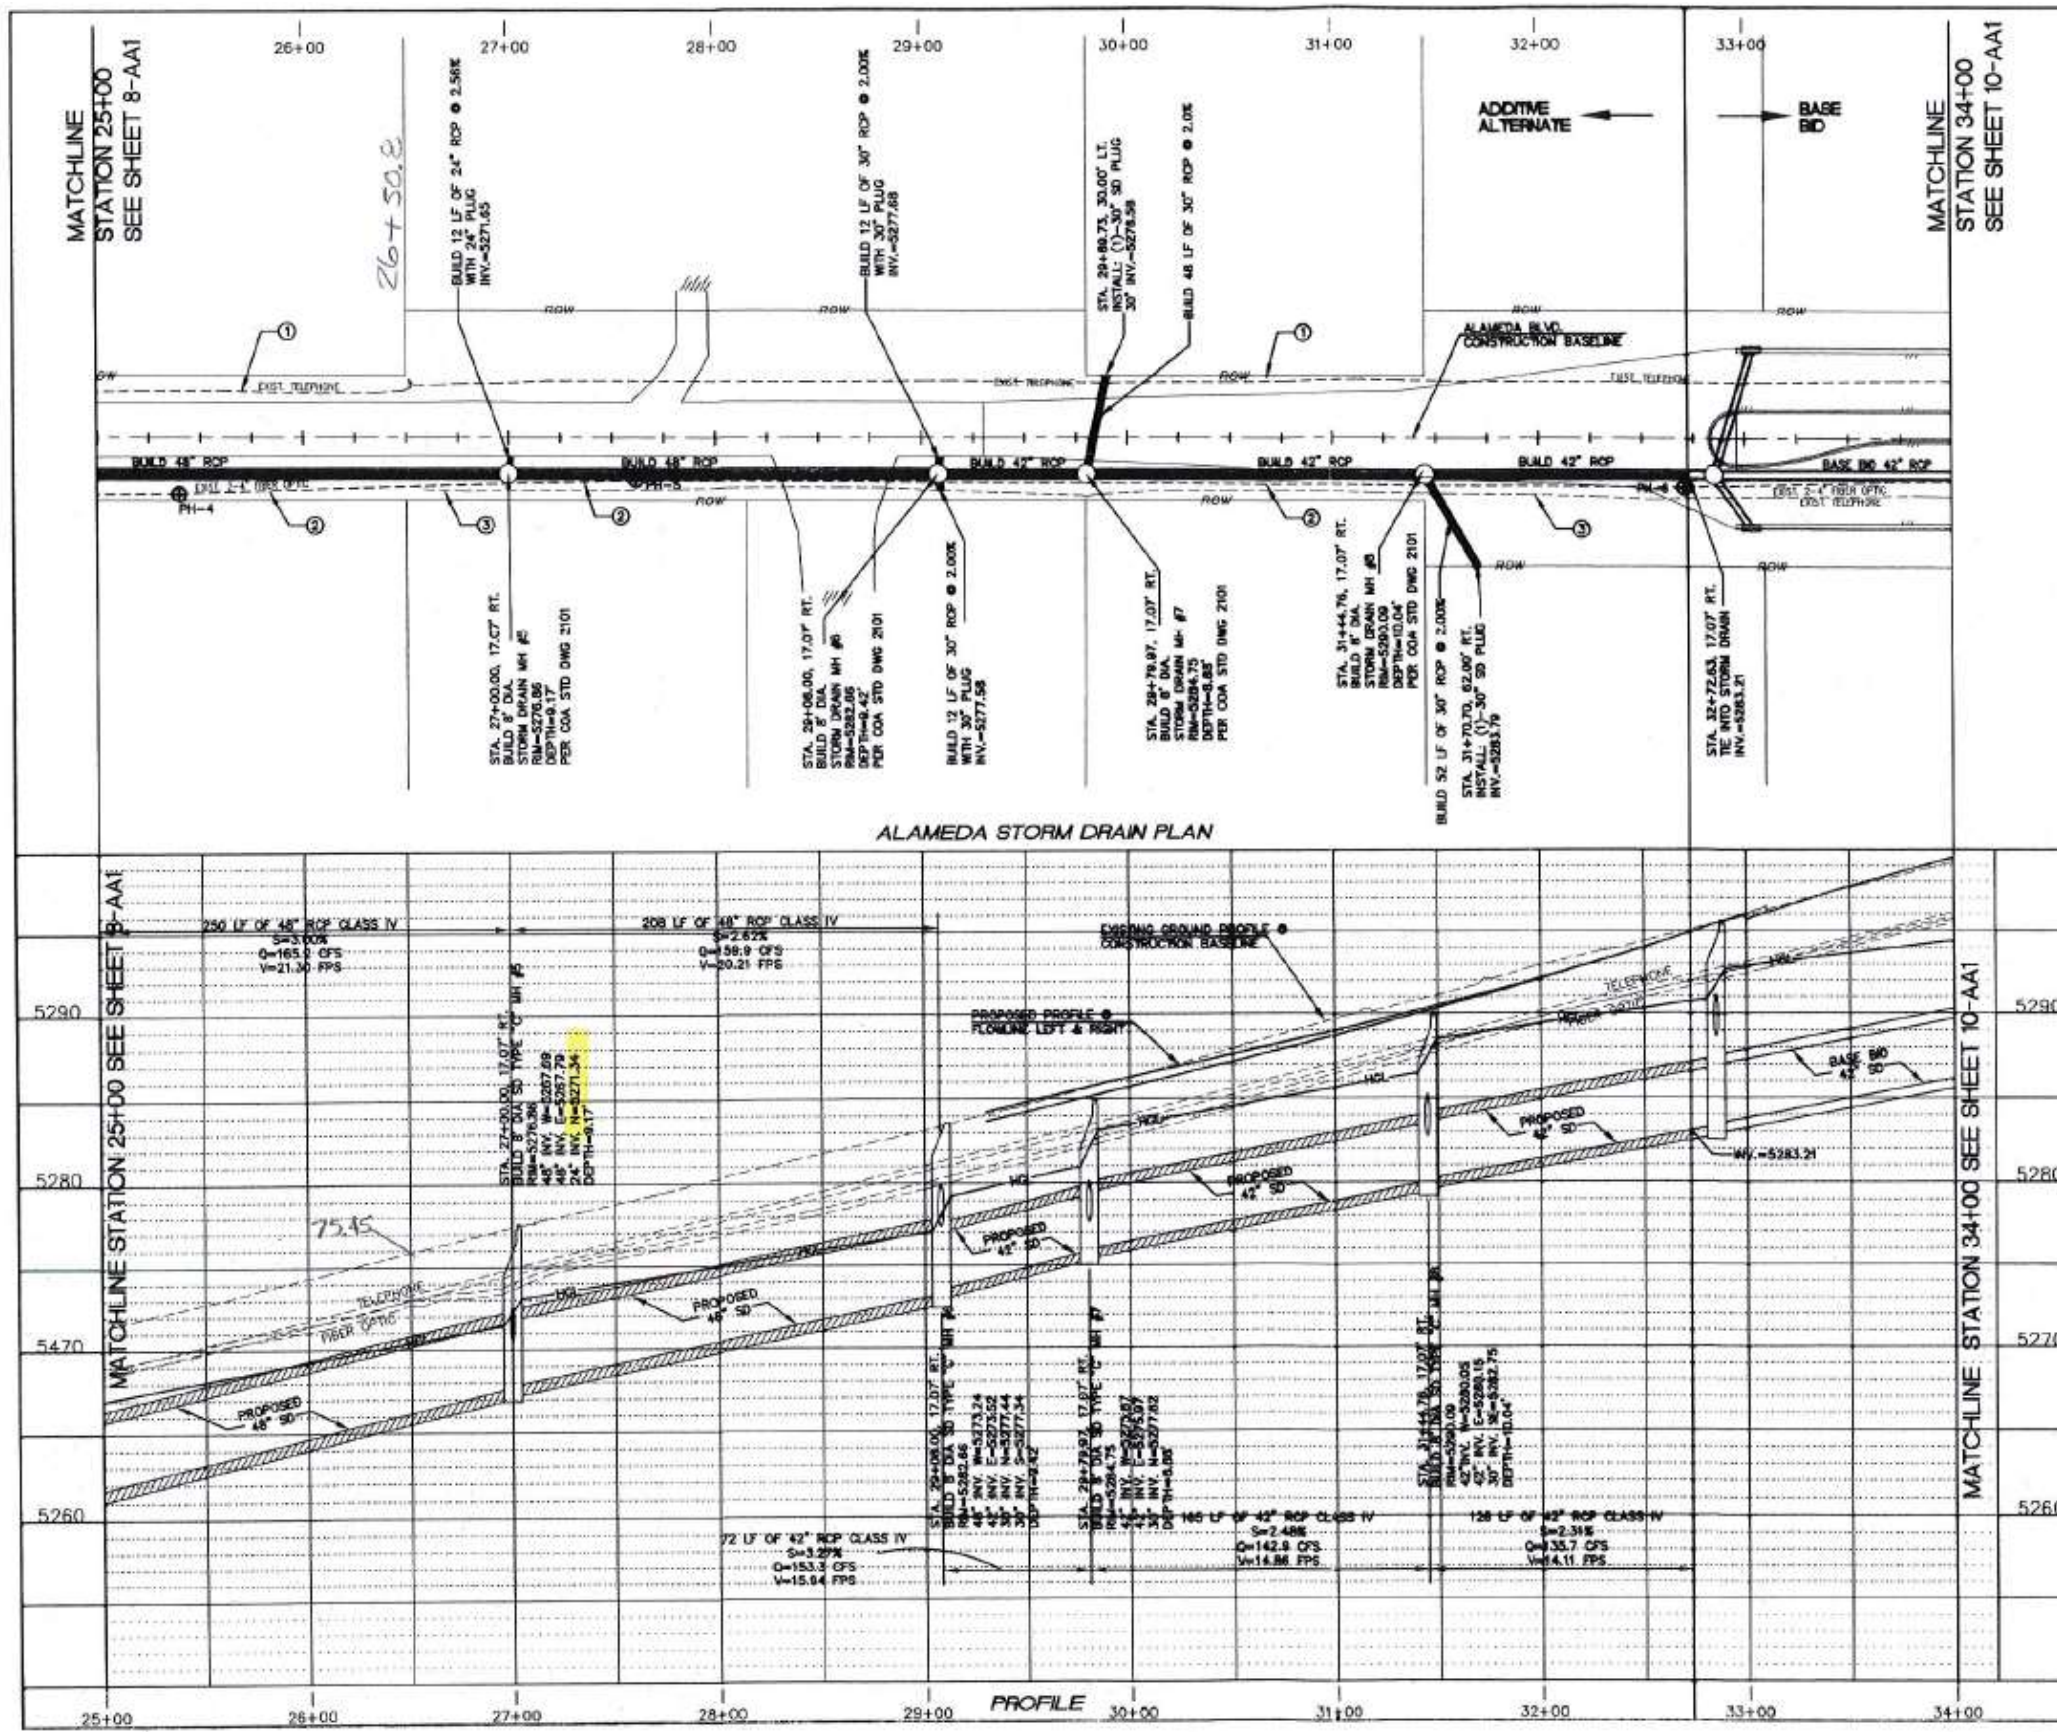

KEY NOTES:

- EXISTING DIRECT BURY TELEPHONE LINE TO BE REMOVED AND DISPOSED BY CENTURYLINK.
- EXISTING 2-4" PVC FIBER OPTIC LINES TO BE RELOCATED BY CENTURYLINK.
- EXISTING TELEPHONE LINE TO BE RELOCATED BY CENTURYLINK.

POT-HOLE INFORMATION

NO.	ELEV. AT TOP OF PIPE	UTILITY	MATERIAL	DIAMETER
PH-4	5266.52	FIBER OPT	PVC	2-4"
PH-5	5276.31	FIBER OPT	PVC	2-4"
PH-6	5281.01	FIBER OPT	PVC	2-4"

CONTRACTOR

NO. BY DATE
1199 SURVEYING CONTROL INC. 11-2010

ENGINEER'S SEAL

NO. DATE
1199 SURVEYING CONTROL INC. 11-2010


REMARKS

DESIGN

DESIGNED BY DBT
DRAWN BY DEM
CHECKED BY DBT

DATE 12-2012
DATE 12-2012
DATE 12-2012

NOTE:
H/L BASED ON DEVELOPED CONDITIONS WITH FUTURE STORM DRAIN SYSTEM CONSTRUCTED.

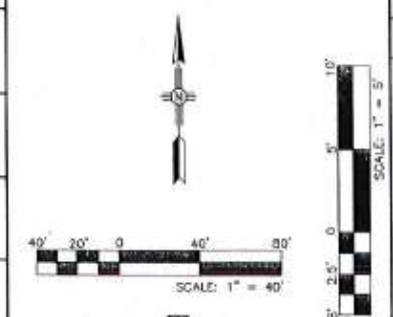


Thompson Engineering Consultants, Inc.
www.thompsoneng.com


CITY OF ALBUQUERQUE
DEPARTMENT OF MUNICIPAL DEVELOPMENT
ENGINEERING DIVISION

TITLE: ALAMEDA BLVD. WIDENING
ALAMEDA STORM DRAIN PLAN AND PROFILE STA. 25+00 TO STA. 34+00



City Project No. 766391
Zone Map No. C-18/C-19
Sequence No. 4-4
Sheet 9-AA1
11

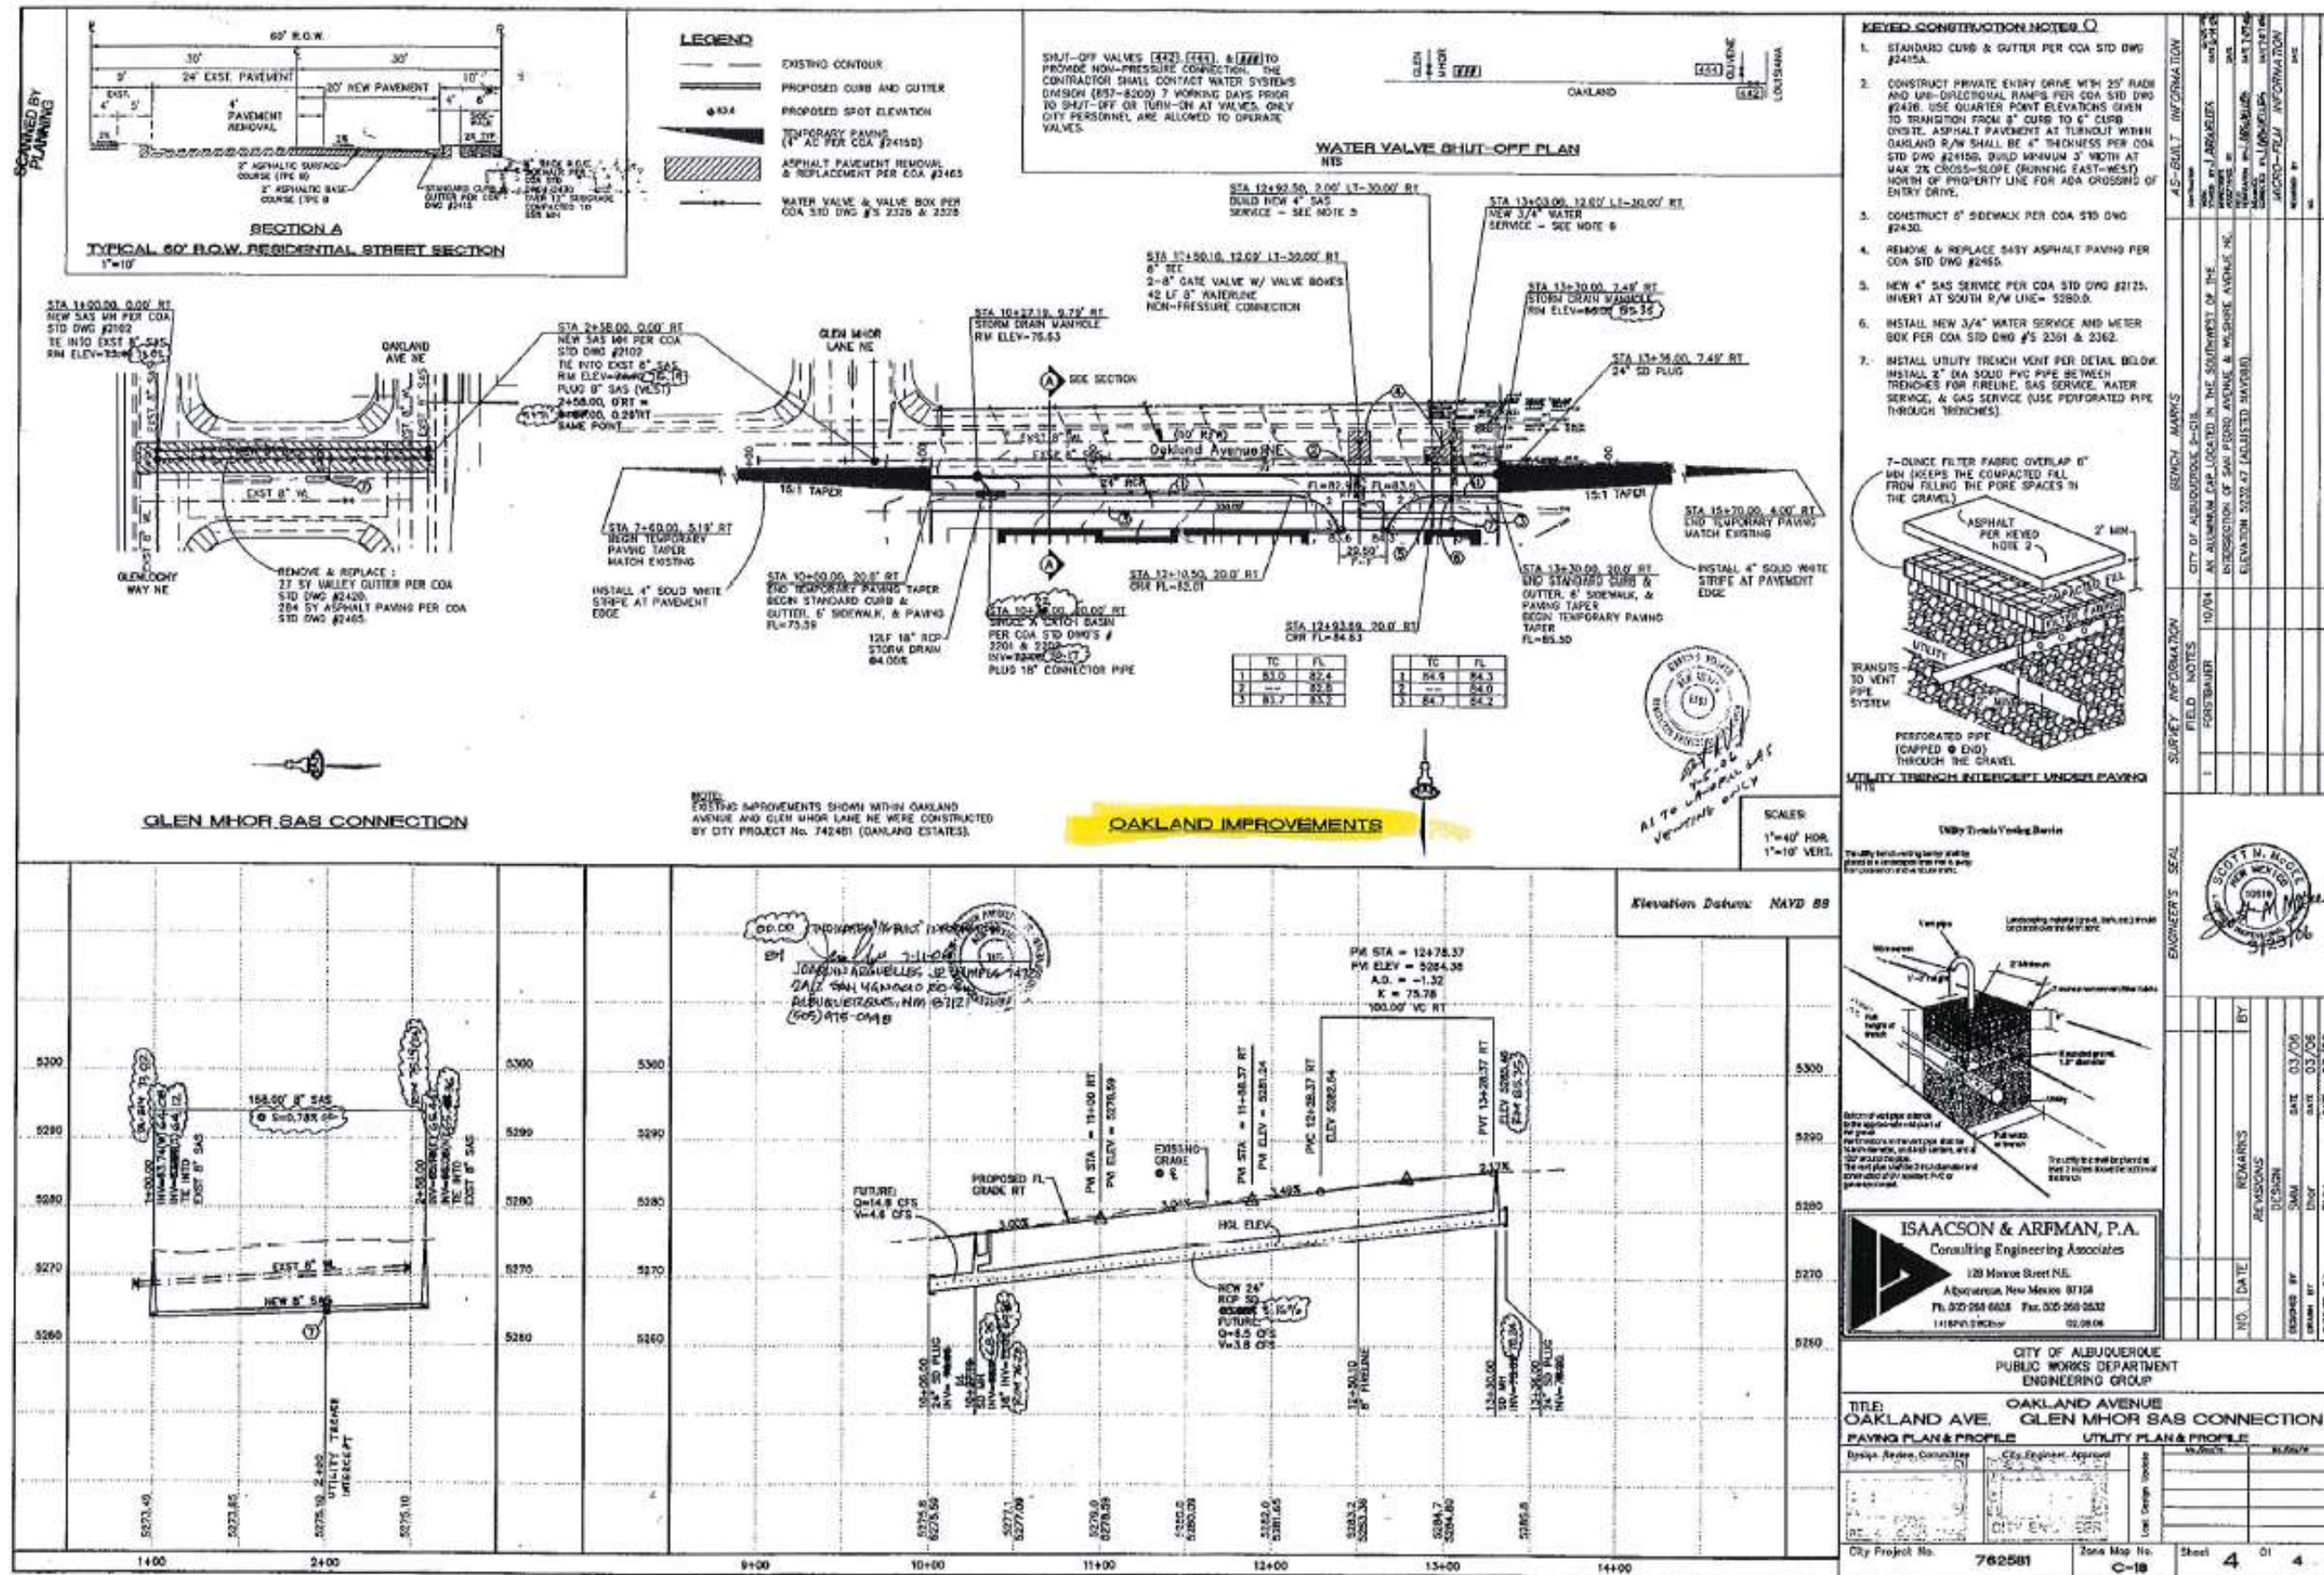

- INSTALL ALL STORM DRAIN PIPE PER ADS MANUFACTURER'S SPECIFICATIONS.
- ON-SITE PIPE SHALL BE ADS N-12 (WATERTIGHT) OR ENGINEER APPROVED EQUIVALENT. PIPE SHALL BE INSTALLED PER MANUFACTURER'S RECOMMENDATIONS. CONNECTION TO OAKLAND STUB (RCP) TO BE WATERTIGHT USING ADS FITTINGS AS REQUIRED.
- STORM DRAINS SHALL BE INSTALLED AT INVERTS AND SLOPES SPECIFIED ON THE PLANS. THE PIPE SHALL DRAIN AT A CONSTANT SLOPE BETWEEN FITTINGS AND MANHOLES. THE PIPE SHALL DRAIN TOWARD THE OUTLET AT ALL LOCATIONS.
- STORM DRAIN SYSTEM WILL REQUIRE REGULAR MAINTENANCE TO ENSURE PROPER FUNCTIONING DURING STORM EVENTS. ENGINEER RECOMMENDS THAT PROPERTY OWNER PUT IN PLACE INSPECTION AND MAINTENANCE CRITERIA SCHEDULED TO OCCUR MONTHLY AND AFTER EACH STORM EVENT.
- VIBRATORY COMPACTION SHALL NOT BE USED OVER IN-PLACE UTILITIES.
- ALL BACKFILL SHALL BE COMPACTED TO A MINIMUM 95% DENSITY PER ASTM D-1557.

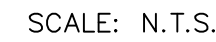


SCALE: N.T.S.

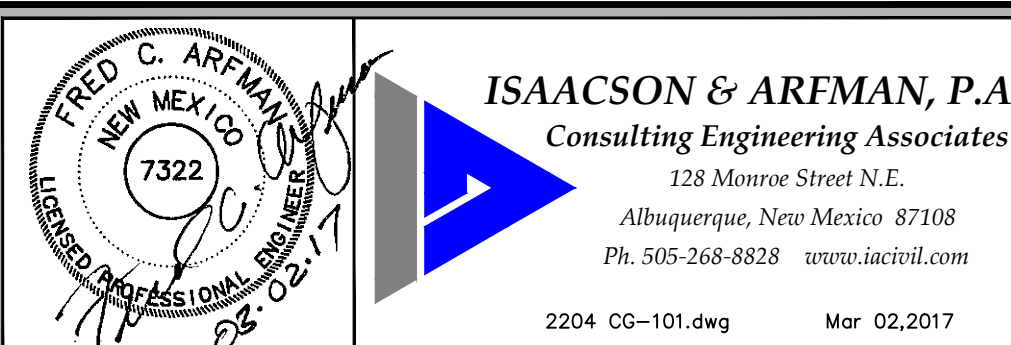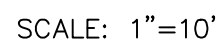

This design, calculations, and concepts are owned by and remain the property of Isaacson & Arfman, P.A. and no part thereof shall be utilized by any person, firm or corporation for any purpose whatsoever except with the written permission of Isaacson & Arfman, P.A. ©

GRADING AND DRAINAGE DETAILS

Date:	No.	Revision	Date	Job No.
03.02.17				2204
Drawn By:				CG-501
BJB				
Ckd By:				SH. OF
FCA				

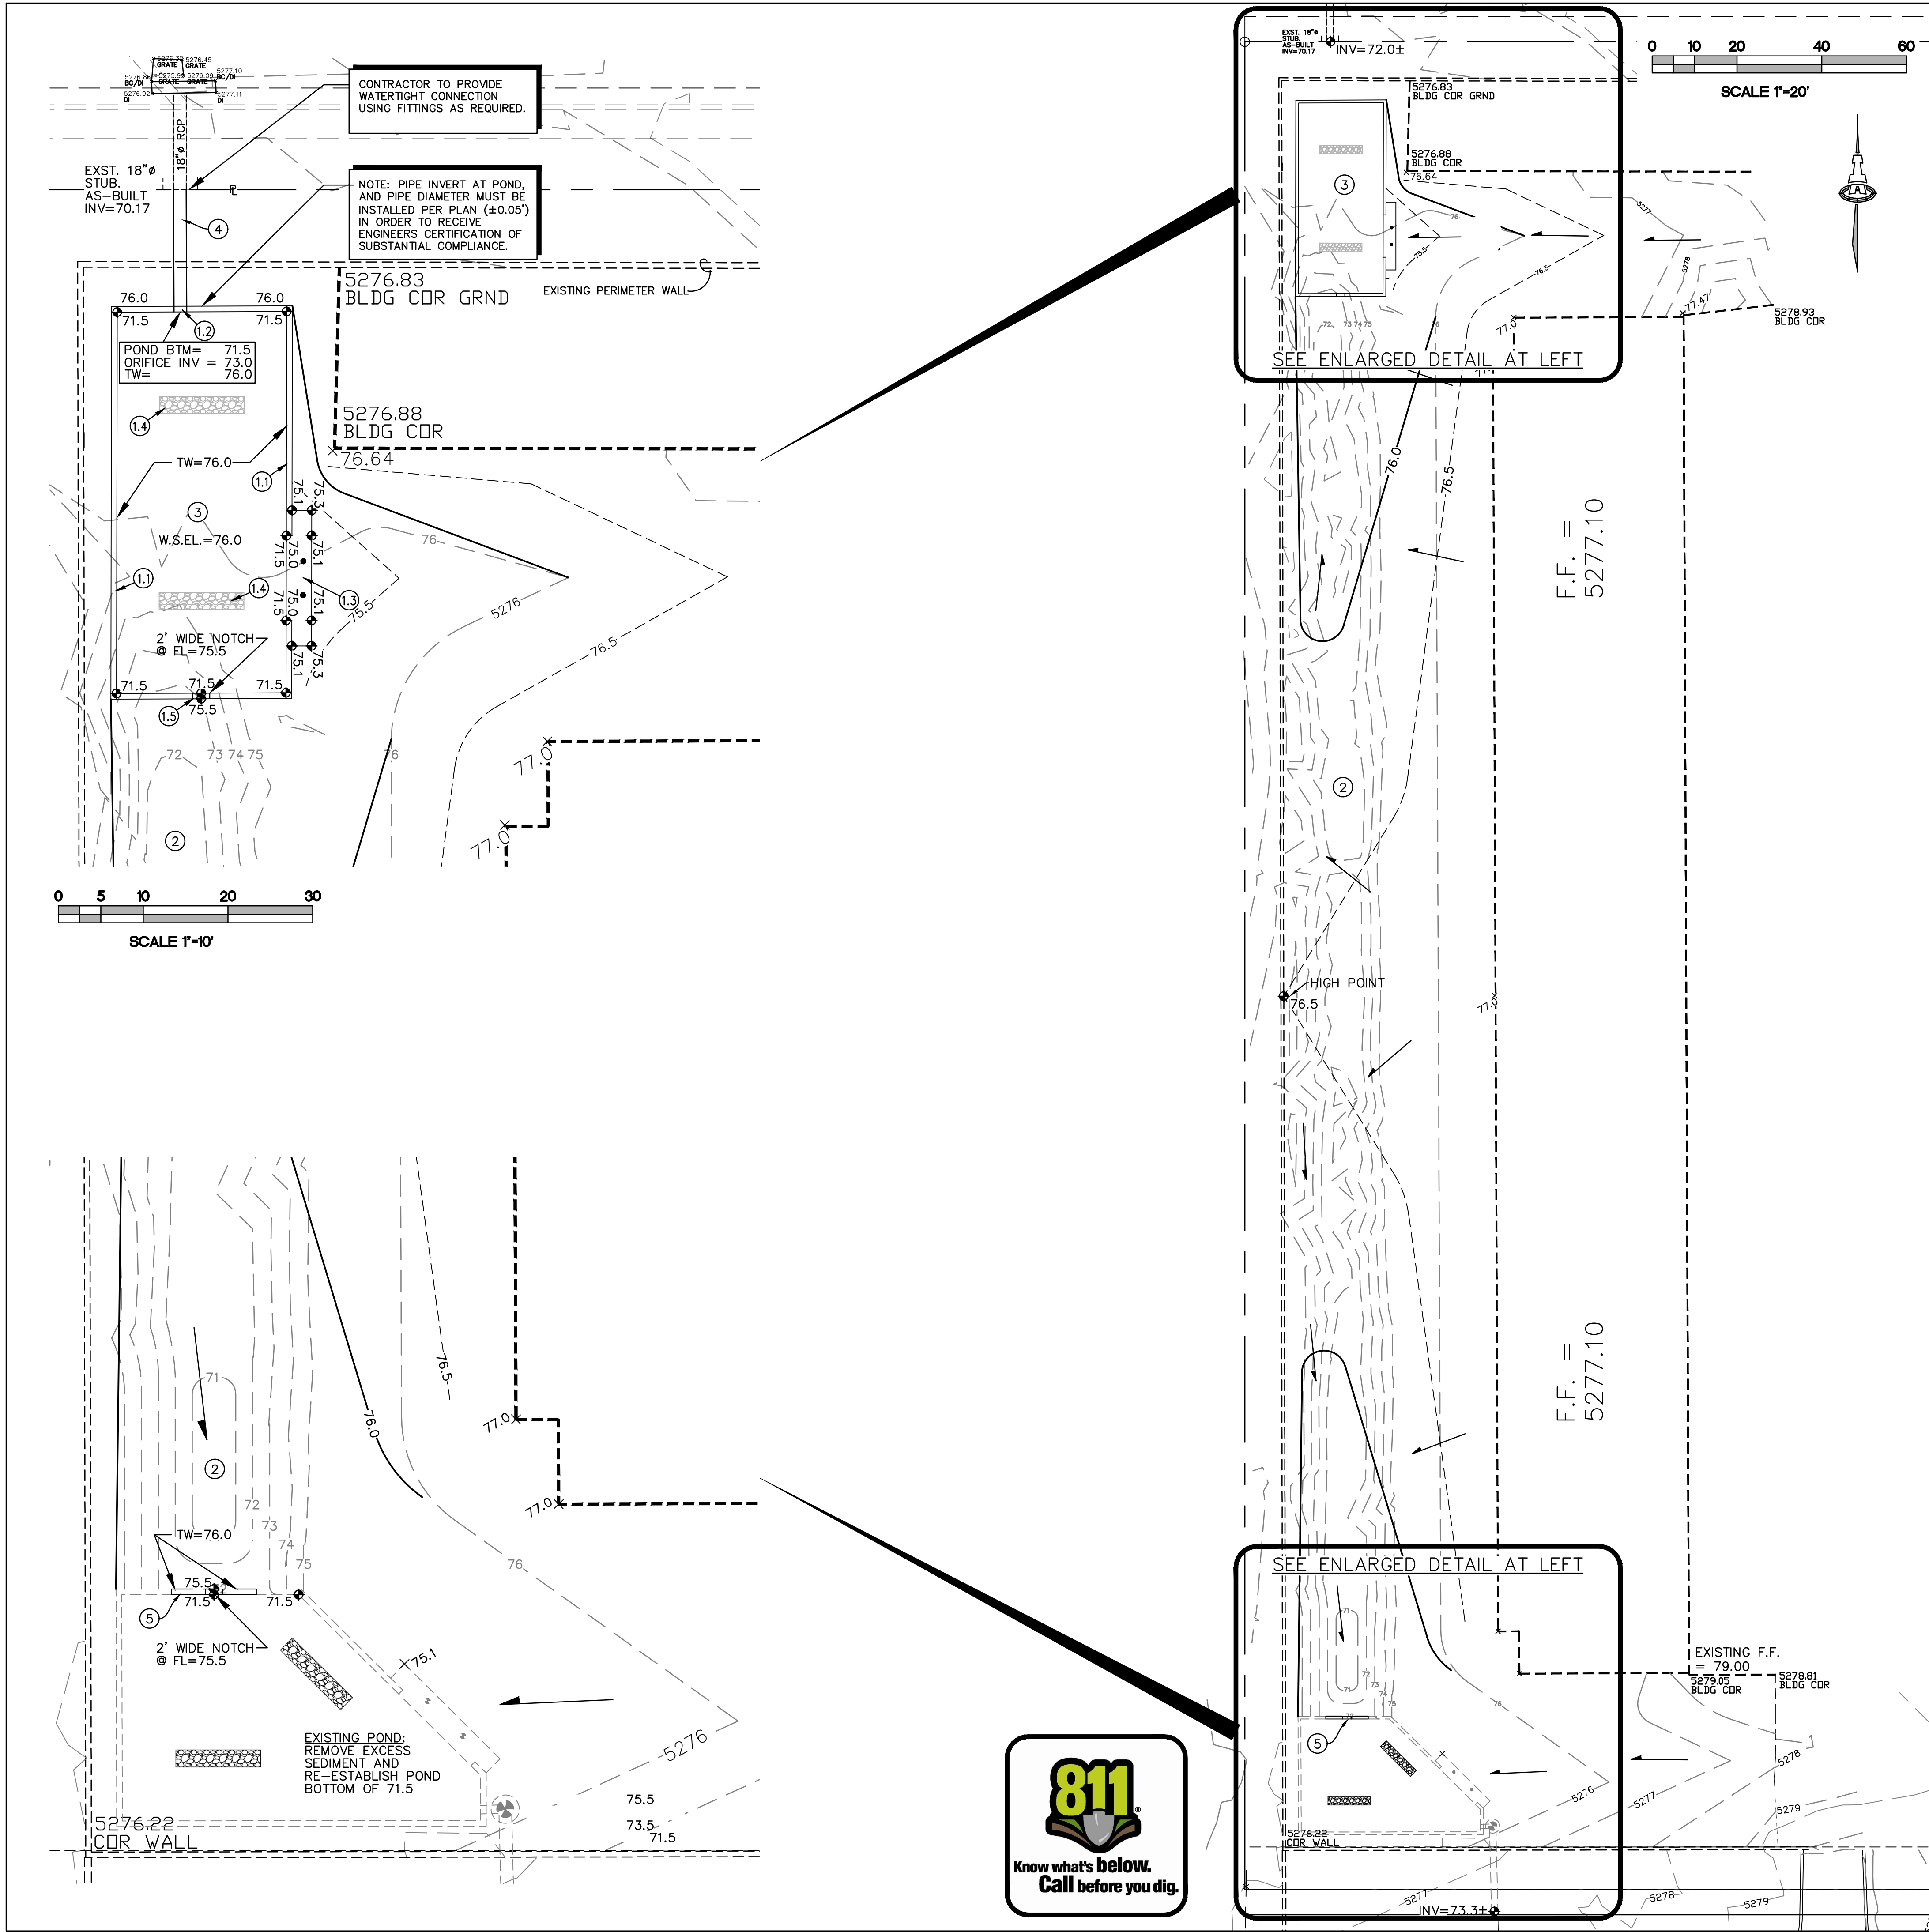

- ### KEYED NOTES
- CONSTRUCT ON-SITE STORM DRAIN SYSTEM TO INCLUDE:
 - POND PERIMETER WALLS @ TW=76.0 (SEE CG-501 FOR DIMENSIONS).
 - 18" OUTLET WITH ORIFICE CONTROL.
 - CONCRETE SPILLWAY WITH BOLLARDS @ 6' O.C.
 - 10'X2'X6'DEEP (MINIMUM) PERCOLATION TRENCH (2 LOCATIONS).
 - 2' WIDE X 6" HIGH OPENING IN WALL
- NOTE: DUE TO MAXIMUM ALLOWABLE DISCHARGE CAPACITY REQUIREMENTS, PRIVATE STORM DRAIN AND ORIFICE RIM, INVERT, AND DIAMETERS MUST BE WITHIN 0.05' TO BE CONSIDERED 'IN SUBSTANTIAL COMPLIANCE' FOR ENGINEER'S CERTIFICATION.
- FILL IN TEMPORARY POND (NO LONGER REQUIRED). GRADE TO SLOPE NORTH AND SOUTH. PAVEMENT MATERIAL IS OWNER'S OPTION. CALCULATIONS AND STORM DRAIN DESIGN ARE BASED ON IMPERVIOUS (ASPHALT / CONCRETE).
 - PERMANENT POND BOTTOM TO BE PERVIOUS MATERIAL (DIRT, GRAVEL, ETC.) FOR INFILTRATION OF RETAINED PORTION. OWNER TO MAINTAIN TO ELEVATIONS SHOWN.
 - INSTALL 18" ADS N-12 MEGA-GREEN STORM DRAIN (20 LF±) TO EXISTING PRIVATE STUB TO OAKLAND STORM DRAIN SYSTEM.
 - CONSTRUCT 10' SECTION OF SOUTH POND WALL WITH 2' WIDE X 6" HIGH NOTCH AT ELEVATIONS SHOWN.
- ### GENERAL NOTES
- THE CONTRACTOR SHALL ABIDE BY ALL STATE, LOCAL, AND FEDERAL LAWS, CODES, RULES AND REGULATIONS WHICH APPLY TO THE CONSTRUCTION OF THESE IMPROVEMENTS, INCLUDING EPA AND ADA REQUIREMENTS.
 - ALL SUBGRADE, OVEREXCAVATION, BACKFILL, AND FILL SHALL BE PLACED AND / OR COMPACTED PER THE GEOTECHNICAL REPORT AND CITY OF ALBUQUERQUE SPECIFICATIONS.
 - THE CONTRACTOR SHALL OBTAIN ALL REQUIRED PERMITS FOR THE PROJECT PRIOR TO COMMENCING CONSTRUCTION, OR PRIOR TO OCCUPANCY, AS APPROPRIATE.
 - IT IS THE CONTRACTOR'S RESPONSIBILITY TO FIELD VERIFY HORIZONTAL AND VERTICAL LOCATIONS OF ALL EXISTING OBSTRUCTIONS, AND THE CONDITION OF ALL EXISTING INFRASTRUCTURE PRIOR TO CONSTRUCTION. REPORT ALL DISCREPANCIES TO THE ENGINEER AND VERIFY THE ENGINEER'S INTENT BEFORE PROCEEDING.
 - THE CONTRACTOR SHALL NOT SCALE DRAWINGS. ONLY WRITTEN DIMENSIONS OR KEYED NOTES SHALL BE USED.
 - CONTRACTOR SHALL OBTAIN ALL REQUIRED INSPECTIONS OF THE WORK.
 - CONSTRUCTION ACTIVITY SHALL BE LIMITED TO THE PROPERTY AND/OR PROJECT LIMITS. ANY DAMAGE TO ADJACENT STRUCTURES RESULTING FROM THE CONSTRUCTION PROCESS SHALL BE REPAIRED OR REPLACED AT THE CONTRACTOR'S EXPENSE. CONTRACTOR SHALL BE RESPONSIBLE FOR DOCUMENTING EXISTING CONDITIONS PRIOR TO CONSTRUCTION.
 - ALL TRASH, DEBRIS, & SURFACE VEGETATION SHALL BE LEGALLY DISPOSED OF.
 - PROPOSED SPOT AND CONTOUR ELEVATIONS SHOWN REPRESENT TOP OF FINISH MATERIAL (I.E. TOP OF CONCRETE, TOP OF CONCRETE BUILDING PAD, TOP OF PAVEMENT MATERIAL, TOP OF LANDSCAPING MATERIAL, ETC.). CONTRACTOR SHALL GRADE, COMPACT SUBGRADE AND DETERMINE EARTHWORK ESTIMATES BASED ON ELEVATIONS SHOWN MINUS FINISH MATERIAL THICKNESSES.
 - IF FIELD GRADE ADJUSTMENTS ARE REQUIRED, THE CONTRACTOR SHALL NOTIFY THE ENGINEER.
 - EXISTING UTILITY LINES ARE SHOWN IN AN APPROXIMATE MANNER ONLY AND MAY BE INCOMPLETE OR OBSOLETE. SUCH LINES MAY OR MAY NOT EXIST WHERE SHOWN OR NOT SHOWN. CONTRACTOR SHALL CONTACT NM-811 FOR UTILITY LINE SPOTS TWO WORKING DAYS PRIOR TO CONDUCTING SITE FIELD WORK. CONTRACTOR SHALL FIELD VERIFY AND LOCATE ALL UTILITIES PRIOR TO COMMENCEMENT OF ANY CONSTRUCTION. CONTRACTOR IS FULLY RESPONSIBLE FOR ANY AND ALL DAMAGE CAUSED BY ITS FAILURE TO LOCATE, IDENTIFY AND PRESERVE ANY AND ALL EXISTING UTILITIES, PIPELINES, AND UNDERGROUND UTILITY LINES. THE CONTRACTOR SHALL BE RESPONSIBLE FOR COORDINATION OF NECESSARY DRY UTILITY ADJUSTMENTS.
 - CONTRACTOR SHALL PROVIDE ALL CONSTRUCTION STAKING. CONTRACTOR SHALL LOCATE AND PRESERVE ALL BOUNDARY CORNERS AND REPLACE ANY LOST OR DISTURBED CORNERS AT CONTRACTOR'S SOLE EXPENSE. PROPERTY CORNERS SHALL ONLY BE RESET BY A REGISTERED LAND SURVEYOR.
 - A CURRENT STORMWATER CONTROL PERMIT, INCLUDING AN EROSION SEDIMENT CONTROL PLAN (E.S.C.) FOR EROSION AND SEDIMENT CONTROL IS REQUIRED FOR ALL CONSTRUCTION, DEMOLITION CLEARING, AND GRADING OPERATIONS THAT DISTURB THE SOIL ON ONE ACRE OR MORE OF LAND. OWNER WILL COORDINATE.
 - POST-CONSTRUCTION MAINTENANCE FOR PRIVATE STORMWATER FACILITIES WILL BE THE RESPONSIBILITY OF THE FACILITIES OWNER. PERIODIC INSPECTION AND CERTIFICATIONS OF THE FACILITIES MAY BE REQUIRED BY THE CITY ENGINEER.
 - ADJUST ANY RIMS OF EXISTING UTILITY FEATURES AS NECESSARY TO MATCH NEW GRADES. UTILITIES IN PAVED AREAS SHALL BE HS-25 TRAFFIC RATED.
 - WHERE GRADES BETWEEN NEW AND EXISTING ARE SHOWN AS 'MATCH' OR '±', TRANSITIONS SHALL BE SMOOTH.
 - ENGINEER RECOMMENDS THAT OWNER INSPECT SITE YEARLY AND AFTER EACH RAINFALL TO IDENTIFY AREAS OF EROSION AND INSTALL EROSION PROTECTION AS NEEDED.
 - ALL SITE PREPARATION, GRADING OPERATIONS, FOUNDATION CONSTRUCTION, AND PAVEMENT INSTALLATION WORK SHALL BE CONSTRUCTED IN ACCORDANCE WITH THE GEOTECHNICAL REPORT, WHICH WILL BE PROVIDED BY THE OWNER.
 - ENGINEER'S CERTIFICATION CANNOT BE PROVIDED UNTIL ALL SITE DRAINAGE IMPROVEMENT WORK IS COMPLETE AND PERMANENT EROSION PROTECTION IS INSTALLED PER PLAN. LANDSCAPING IS NOT REQUIRED FOR CERTIFICATION.

VICINITY MAP

PROJECT DATA

LEGAL DESCRIPTION: LOT 22A, BLOCK 28, NORTH ALBUQUERQUE ACRES, TRACT A, UNIT B

FLOOD ZONE: PER BERNALILLO COUNTY FIRM MAP 35001C0137H, EFFECTIVE ON 08/16/2012, THE SITE IS LOCATED WITHIN FLOODZONE 'X' DESIGNATED AS AREAS DETERMINED TO BE OUTSIDE 500-YEAR FLOODPLAIN.

ENGINEER: FRED C. ARFMAN, P.E.
ISAACSON & ARFMAN, P.A.
128 MONROE ST NE, ABQ. NM 87108
PHONE: (505) 268-8828

SURVEYOR: DAVID COOPER
SIERRA LAND SURVEYING, INC.
1452 S. ST. FRANCIS DRIVE
SANTA FE, NM 87505
PHONE: (505) 983-5932

BENCHMARK: CITY OF ALBUQUERQUE 9-C18. AN ALUMINUM CAP LOCATED IN THE SOUTHWEST OF THE INTERSECTION OF SAN PEDRO AVENUE & WILSHIRE AVENUE NE. ELEVATION 5232.47 (ADJUSTED NAVD88).

LEGEND

- 5277 --- EXISTING CONTOUR
- 75 --- PROPOSED CONTOUR
- INFILTRATION TRENCH (SEE CG-501)
- ◆ 75.0 PROPOSED SPOT ELEVATION
- PROPOSED FLOW ARROW

This design, calculations, and concepts are owned by and remain the property of Isaacson & Arfman, P.A. and no part thereof shall be utilized by any person, firm or corporation for any purpose whatsoever except with the written permission of Isaacson & Arfman, P.A. ©

ALAMEDA SELF-STORAGE OAKLAND STORM DRAIN IMPROVEMENTS PARKS CONSTRUCTION

GRADING AND DRAINAGE PLAN

Date:	No. Revisions	Date	Job No.
03.02.17			2204
Drawn By:			CG-101
BJB			
Ckd By:			SH. OF
FCA			

