


NOTE: TRACT D
This tract is to be dedicated to the City of Albuquerque.
Surface treatment will be pavement or other hard or semi-hard surface.

Off-phase site for excess fill from Phases I and I-A. Fill shall be placed evenly and smoothly to a max. height of 3'. Perimeter and other slopes shall have a maximum slope of 3:1

"HEAVEN 1989"
USC & GS Brass Cap
N.M. State Plane Coordinates (Central Zone)
X = 407,051.31 Y = 1,518,737.03
Ground-to-Grid Factor = 0.9995263
Elev. = 5378.787

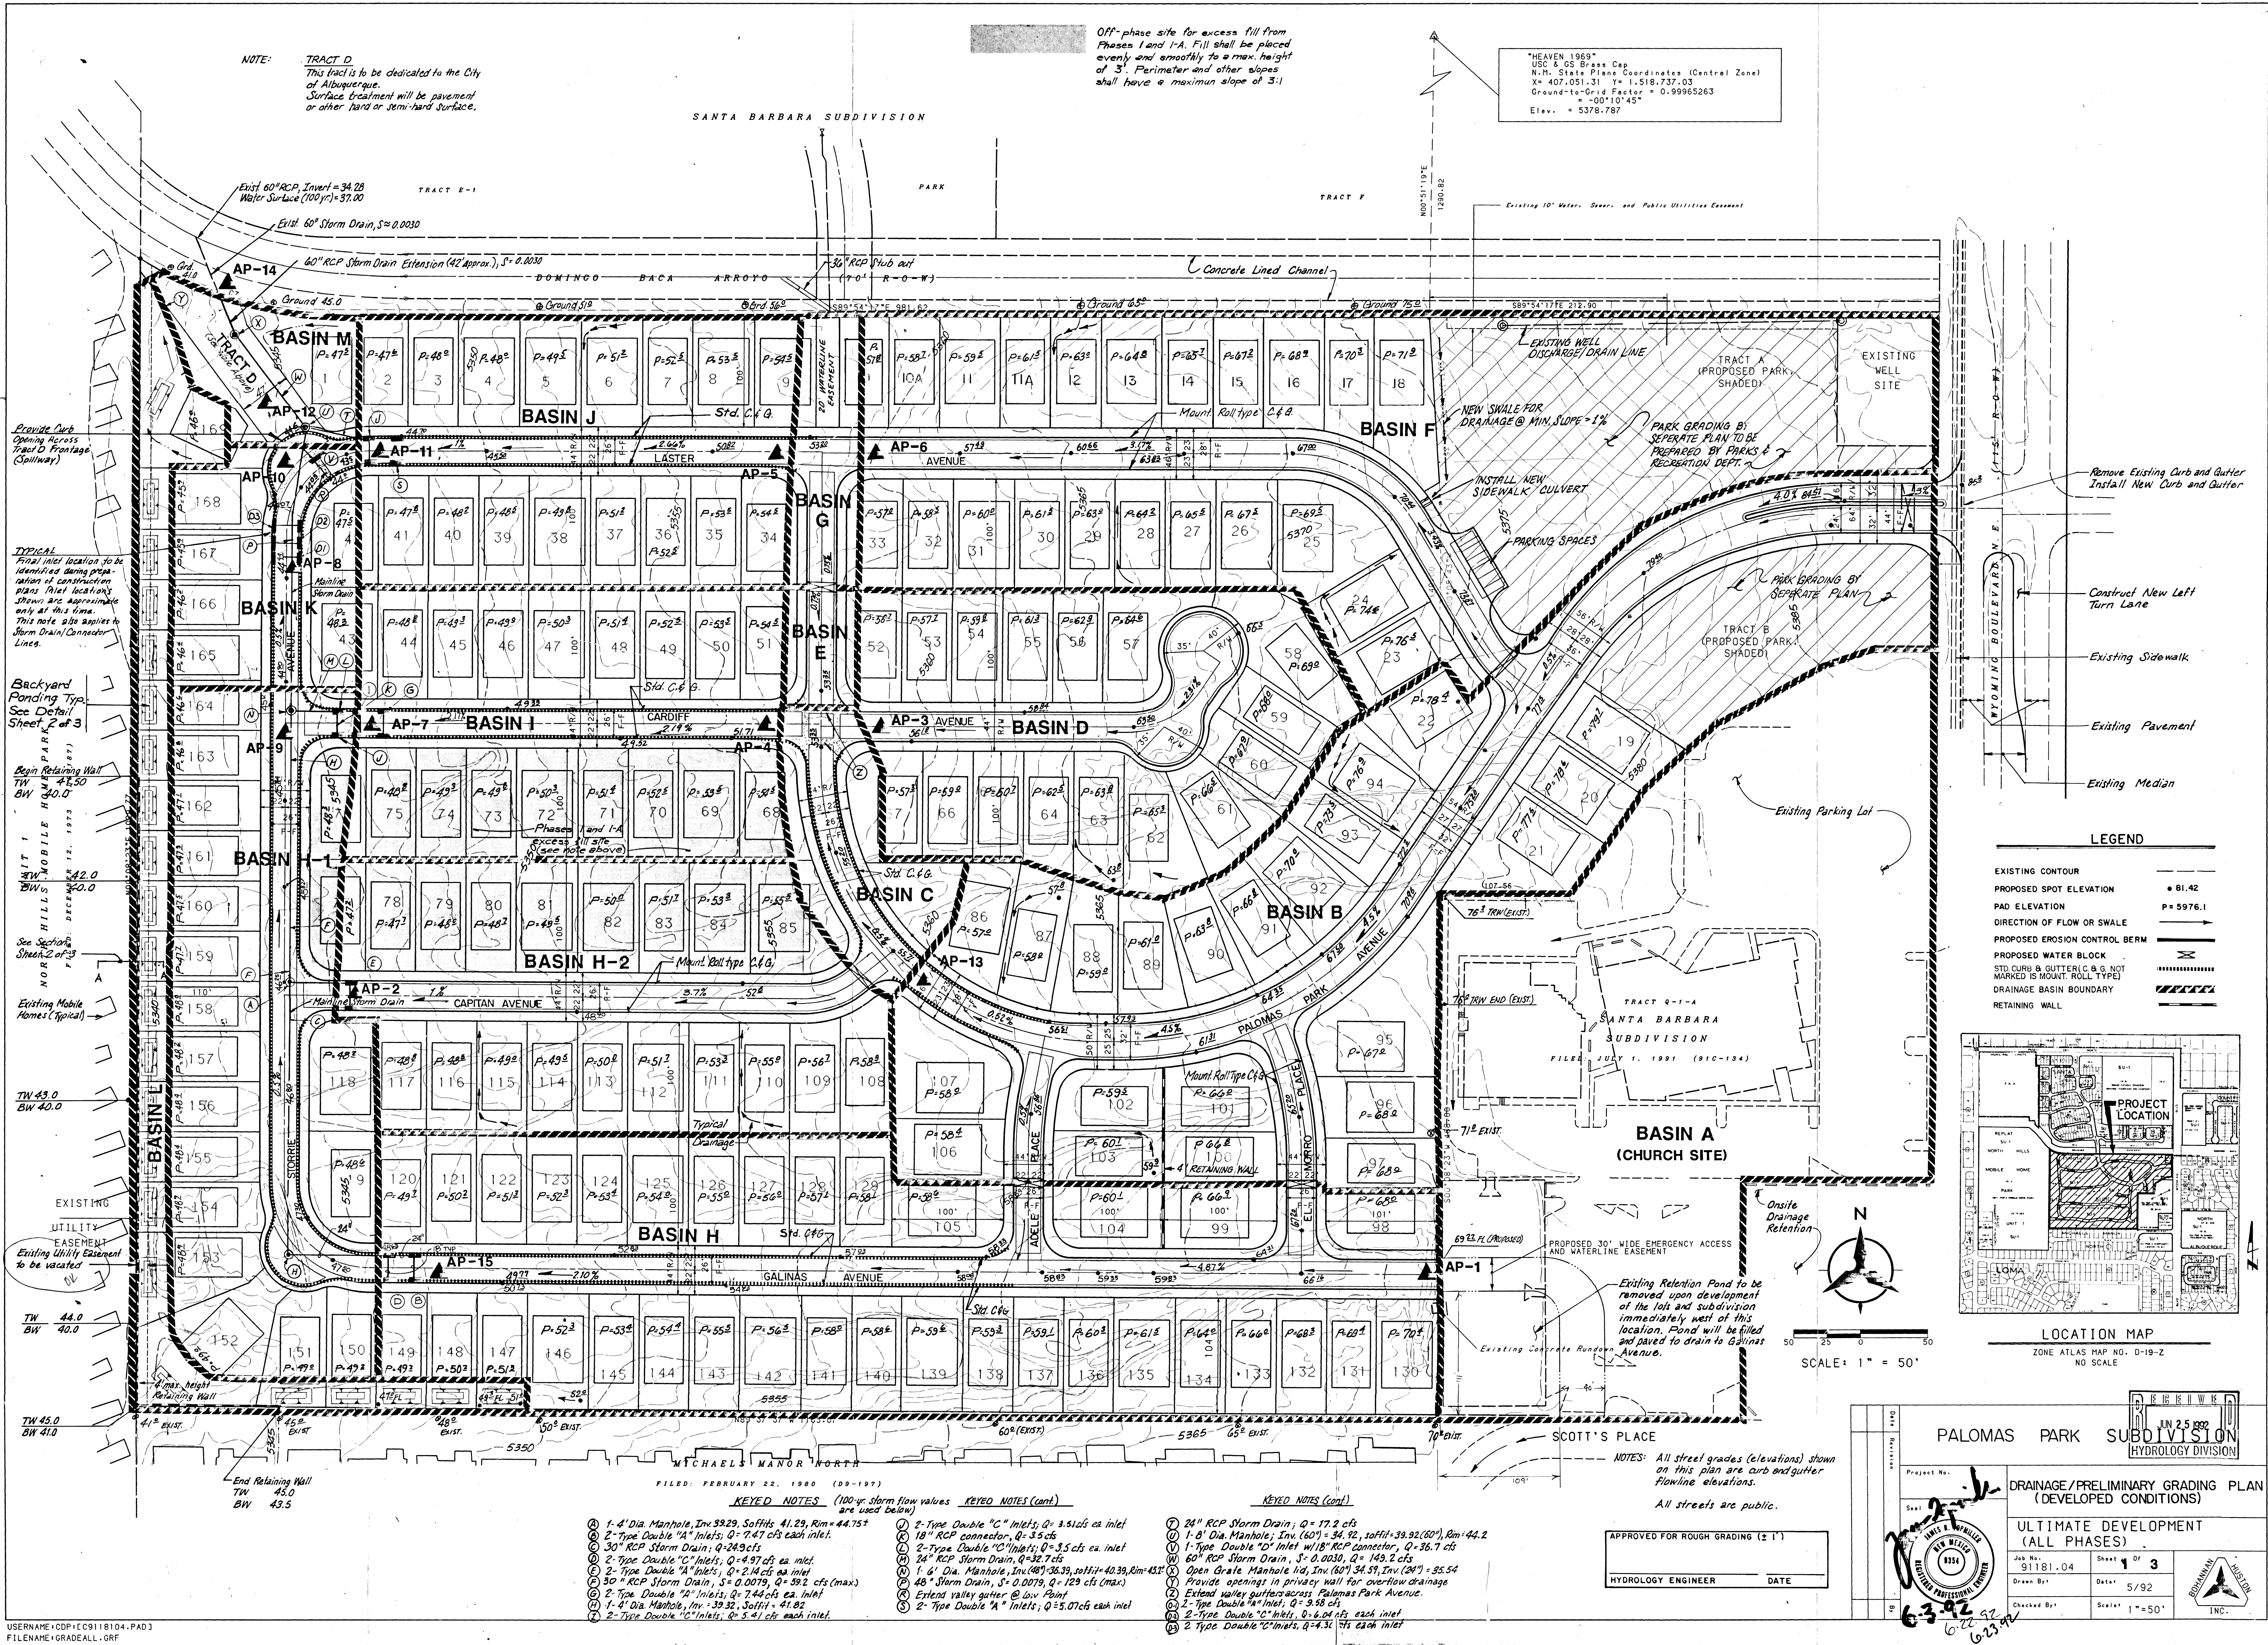

FILED: FEBRUARY 22, 1990 (09-197)

KEYED NOTES (100-yr. storm flow values are used below)

- 1-4" Dia. Manhole, Inv. 39.29, Soffits 41.29, Rim = 44.75'
- 2-Type Double "C" Inlets; Q = 7.47 cfs each inlet
- 30" RCP Storm Drain; Q = 24.9 cfs
- 2-Type Double "C" Inlets; Q = 4.97 cfs ea. inlet
- 2-Type Double "A" Inlets; Q = 2.14 cfs ea. inlet
- 30" RCP Storm Drain; S = 0.0079, Q = 59.2 cfs (max)
- 2-Type Double "A" Inlets; Q = 7.44 cfs ea. inlet
- 1-4" Dia. Manhole, Inv. 39.32, Soffits 41.82
- 2-Type Double "C" Inlets; Q = 5.41 cfs each inlet

- 2-Type Double "C" Inlets; Q = 9.51 cfs ea. inlet
- 18" RCP Connector; Q = 3.5 cfs
- 2-Type Double "C" Inlets; Q = 3.5 cfs ea. inlet
- 24" RCP Storm Drain; Q = 32.7 cfs
- 1-6" Dia. Manhole, Inv. 40.39, Soffits 40.39, Rim = 43.5'
- 48" Storm Drain; S = 0.0079, Q = 129 cfs (max)
- Extend valley gutter @ Low Point
- 2-Type Double "A" Inlets; Q = 5.07 cfs each inlet

KEYED NOTES (cont.)

- 24" RCP Storm Drain; Q = 17.2 cfs
- 1-8" Dia. Manhole, Inv. 40.12, Soffits 39.92 (80'), Rim = 44.2'
- 1-Type Double "C" Inlet w/18" RCP Connector; Q = 36.7 cfs
- 60" RCP Storm Drain; S = 0.0030, Q = 149.2 cfs
- Open Grate Manhole lid, Inv. 40.13, Inv. 40.13, Inv. 40.13 = 35.54
- Provide openings in privacy wall for overflow drainage
- Extend valley gutter across Palomas Park Avenue
- 2-Type Double "A" Inlet; Q = 3.58 cfs
- 2-Type Double "C" Inlets; Q = 6.04 cfs each inlet
- 2-Type Double "C" Inlets; Q = 4.31 cfs each inlet

NOTES: All street grades (elevations) shown on this plan are curb and gutter flowline elevations.
All streets are public.

APPROVED FOR ROUGH GRADING (± 1')

HYDROLOGY ENGINEER DATE

PALOMAS PARK SUBDIVISION

DRAINAGE/PRELIMINARY GRADING PLAN (DEVELOPED CONDITIONS)

ULTIMATE DEVELOPMENT (ALL PHASES)


Job No. 91181.04 Sheet 1 of 3

Drawn By: Date: 5/92

Checked By: Scale: 1" = 50'

INC.

FILED: DECEMBER 12, 1973 (95-187)

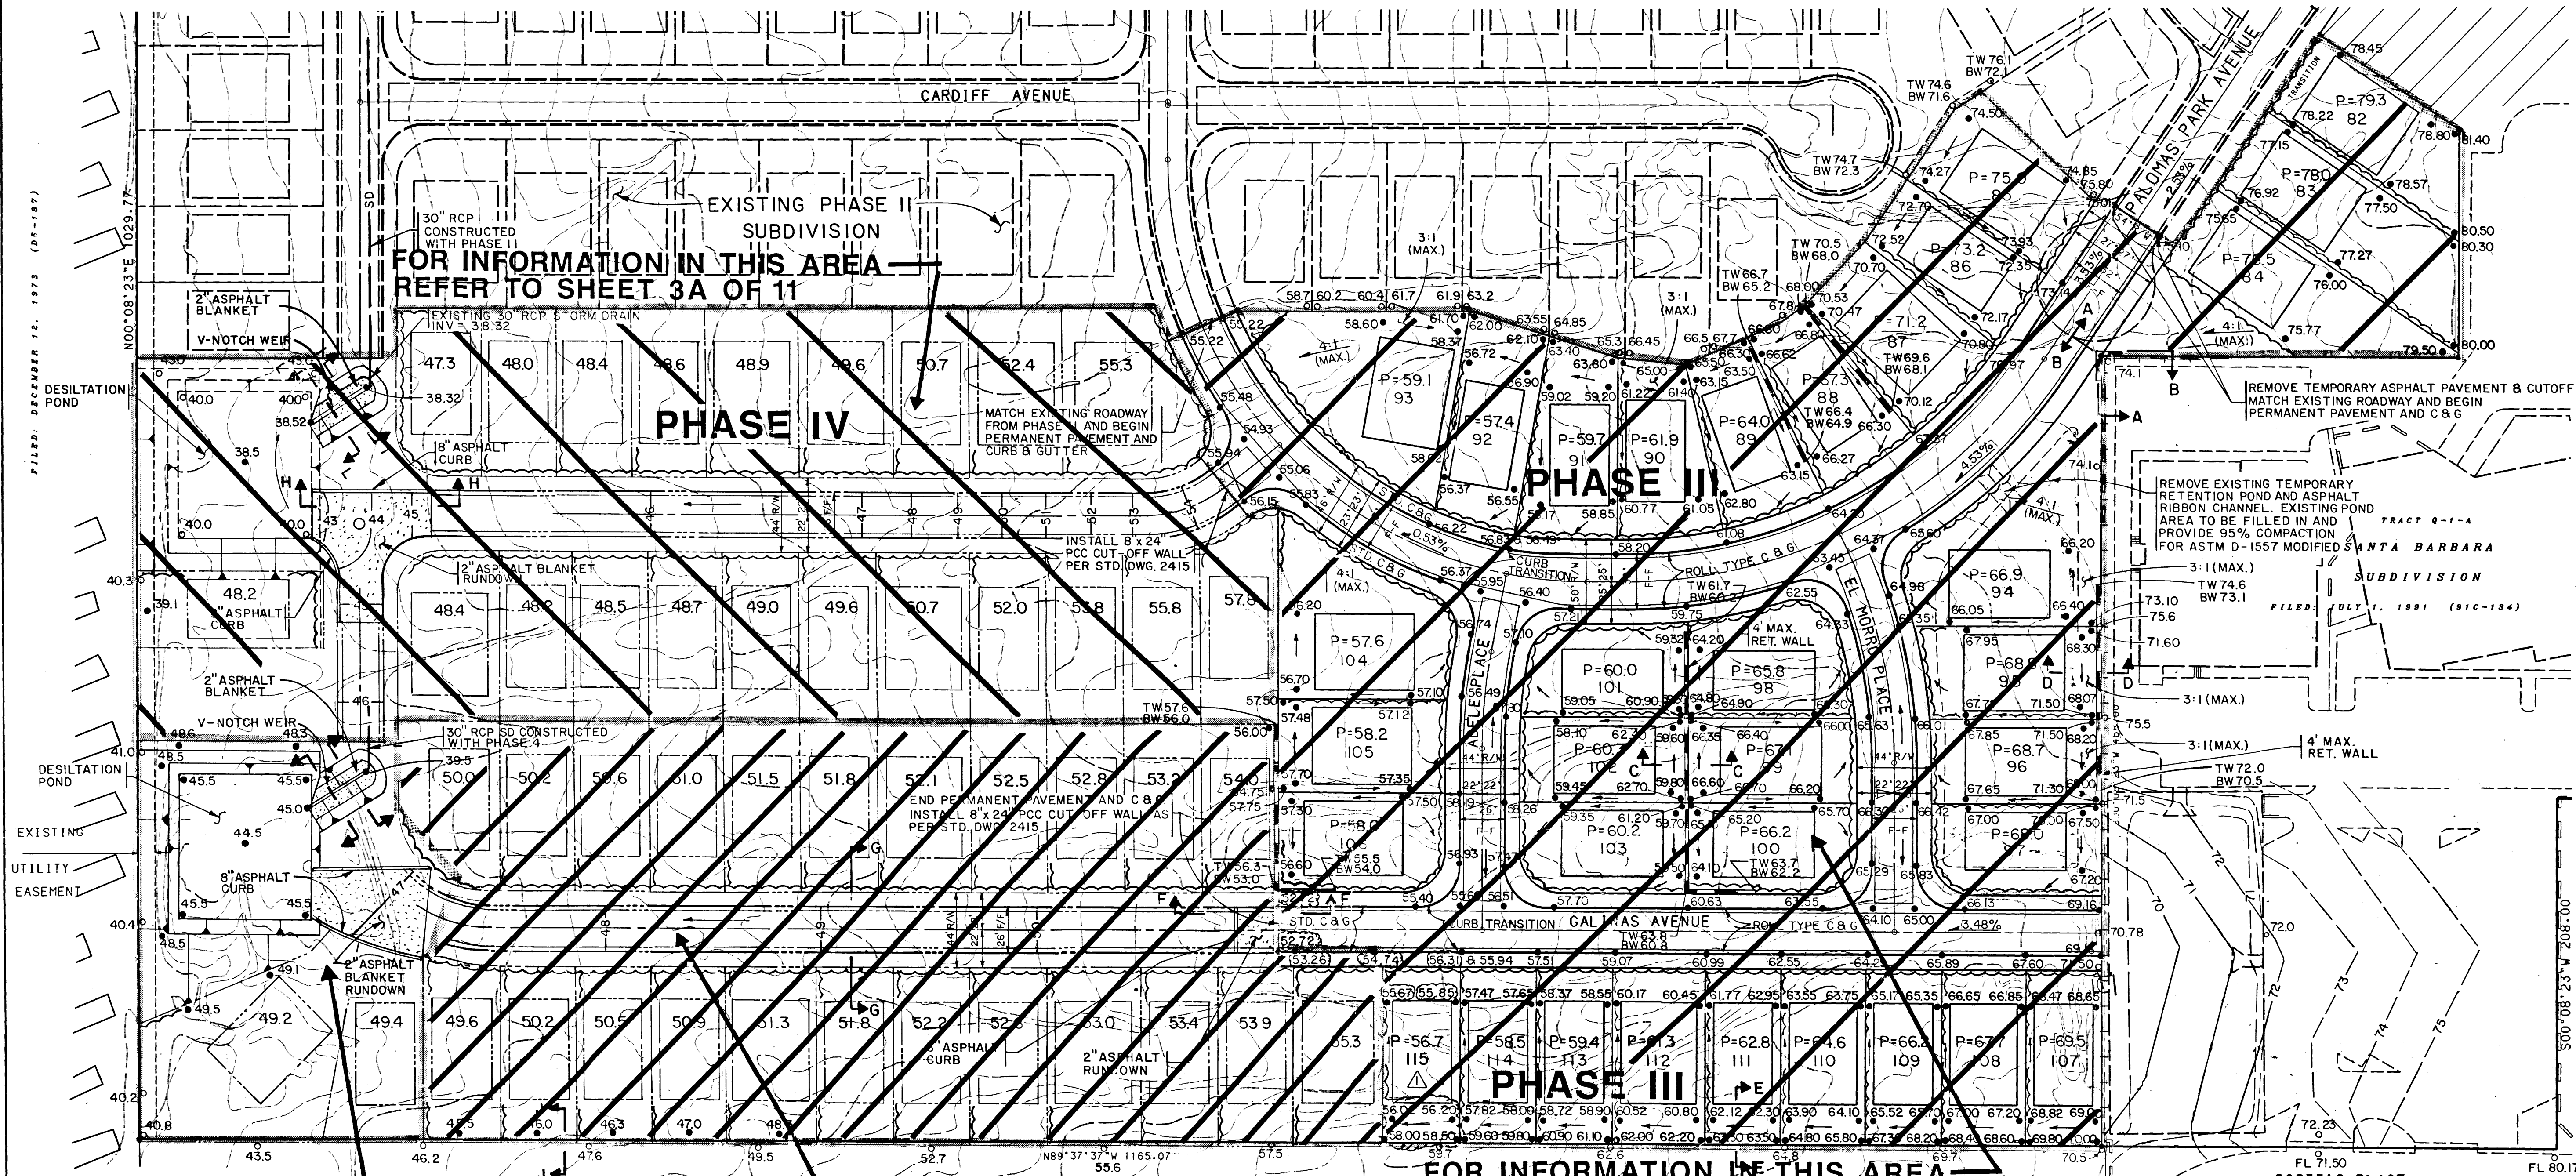

AREA OF CONCERN

NOTICE TO CONTRACTORS

1. AN EXCAVATION/CONSTRUCTION PERMIT WILL BE REQUIRED BEFORE BEGINNING ANY WORK WITHIN THE CITY RIGHT-OF-WAY. AN APPROVED COPY OF THESE PLANS MUST BE SUBMITTED AT THE TIME OF APPLICATIONS FOR THIS PERMIT.
2. ALL WORK DETAILED ON THESE PLANS TO BE PERFORMED, EXCEPT AS OTHERWISE STATED OR PROVIDED HEREON, SHALL BE CONSTRUCTED IN ACCORDANCE WITH CITY OF ALBUQUERQUE STANDARD SPECIFICATIONS FOR PUBLIC WORKS CONSTRUCTION, 1986.
3. TWO WORKING DAYS PRIOR TO ANY EXCAVATION, CONTRACTOR MUST CONTACT LINE LOCATION SERVICE, 765-1234, FOR LOCATION OF EXISTING UTILITIES.
4. PRIOR TO CONSTRUCTION, THE CONTRACTOR SHALL EXCAVATE AND VERIFY THE HORIZONTAL AND VERTICAL LOCATIONS OF ALL OBSTRUCTIONS. SHOULD A CONFLICT EXIST, THE CONTRACTOR SHALL NOTIFY THE ENGINEER SO THAT THE CONFLICT CAN BE RESOLVED WITH A MINIMUM AMOUNT OF DELAY.
5. BACKFILL COMPACTION SHALL BE TO RESIDENTIAL STREET USE.
6. MAINTENANCE OF THESE FACILITIES SHALL BE THE RESPONSIBILITY OF THE OWNER OF THE PROPERTY SERVED.
7. CONTRACTOR MUST OBTAIN A TOPSOIL DISTURBANCE PERMIT FROM THE ENVIRONMENTAL HEALTH DIVISION PRIOR TO CONSTRUCTION.
8. THE CONTRACTOR IS TO REFER TO EARTHWORK SPECIFICATIONS AS NOTED IN THE SOILS REPORT PREPARED BY VINYARD AND ASSOCIATES DATED SEPTEMBER 28, 1992.

9. THE CONTRACTOR SHALL CONFORM TO ALL CITY, COUNTY, STATE, AND FEDERAL DUST CONTROL MEASURES AND REQUIREMENTS AND WILL BE RESPONSIBLE FOR PREPARING AND OBTAINING ALL NECESSARY APPLICATIONS AND APPROVALS.
10. THE CONTRACTOR SHALL ENSURE THAT NO SOIL ERODES FROM THE LOTS INTO PUBLIC RIGHT-OF-WAY. THIS CAN BE ACHIEVED BY CONSTRUCTING TEMPORARY BERMS AS PER DETAIL THIS SHEET AND WETTING THE SOIL TO KEEP IT FROM BLOWING.
11. ALL SLOPES MAXIMUM OF 4:1 UNLESS AS OTHERWISE INDICATED.
12. ALL SPOT ELEVATIONS ALONG THE PROPOSED STREETS ARE TO TOP OF STANDARD OR MOUNTABLE ROLL TYPE CURB AND GUTTER (AS LABELED) UNLESS OTHERWISE NOTED.

IMPORTANT NOTE

THIS SHEET IS FOR THE RELOCATION AND GRADING OF THE DESILTATION POND FOR PHASE IV ONLY.
FOR GRADING AND DRAINAGE INFORMATION OTHER THAN THE DESILTATION POND FOR PHASE IV, REFER TO SHEET 3A OF 11.
FOR GRADING AND DRAINAGE INFORMATION FOR PHASE III, REFER TO PHASE III PLANS.

FUTURE PHASE V FOR INFORMATION IN THIS AREA REFER TO PHASE III PLANS

DRAINAGE PLAN

This Phase III drainage plan conforms to the overall drainage plan of the entire site, Palomas Park Subdivision Drainage Report on June 1992, #D19-D1B).

The east end temporary retention pond constructed for Phase II, and the temporary retention pond located in the proposed emergency access and waterline easement on the Church property, will be eliminated and regraded. The runoff from the Church property and the southern portion of this phase will be directed to Galinas Avenue to the west. The peak flow at the downstream end of Galinas Avenue at the Phase III boundary was calculated to be 36.2 cfs (see Drainage Calculations).

A temporary swale will be constructed to carry runoff through the proposed "rough graded" area of the site. The swale is designed to carry flow at under 3 fps (non-erosive per DPM, see Drainage Calculations) and approximates the future grade and alignment of Galinas Avenue.

The west end temporary retention pond constructed as part of Phase II will be partially regraded. The remaining portion will serve as a temporary desiltation pond for runoff from this phase. From the desiltation pond, runoff will be diverted to an existing 30" RCP storm drain via a 40' long channel. All of these temporary improvements will be removed with Phase IV Palomas Park Subdivision.

A drainage covenant is prepared for the swale and the desiltation pond of Phase III. Easements are placed over the desiltation pond and swale.

APPROVED FOR ROUGH GRADING (± 1')

HYDROLOGY ENGINEER DATE

NOTE: ALL CURB AND GUTTER ELEVATIONS SHOWN ARE TOP OF CURB ELEVATIONS.

(55.85) = REVISED / ADDED INFORMATION

DRAINAGE CALCULATIONS

SW = (continuation of Galinas Ave.):

Total area of rough treatment (developed portion of Basin H - see overall grading plan)

Treatment B = 1.487 AC

Treatment C = 1.100 AC

Treatment D = 1.312 AC

Discharge from 100-year, 6-hr storm, Zone 3.

From developed portion of Basin H

$Q_{100} = (0.487 \times 2.60) + (0.490 \times 3.45) + (1.100 \times 5.02) = 9.59 \text{ cfs}$

From church property (revised drainage plan for connection to Church of the Risen Savior)


$Q_{100} = 26.6 \text{ cfs}$

Total discharge downstream

$Q_{100} \text{ Total} = 9.59 + 26.6 = 36.2 \text{ cfs}$

Through trial and error analysis, assuming a discharge of 36.2, the maximum depth in the Galinas Avenue swale is found to be 0.7 ft (S=0.5%). The maximum velocity at peak flow is:

$V_{max} = 1.49 \text{ m}^3 \text{ s}^{-1} \text{ R}^{2/3} \text{ S}^{1/2} = 1.49 \text{ (0.3) }^{1/2} (13.8/29.2)^{2/3} (0.008)^{1/2} = 2.70 \text{ ft/s}$

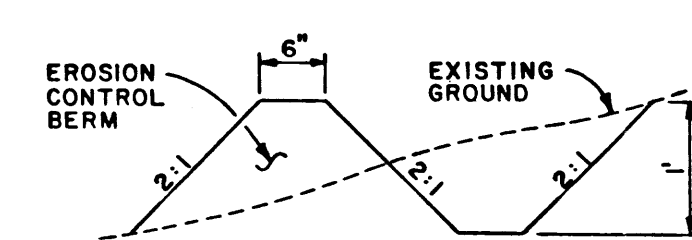

EROSION CONTROL PLAN


NO SCALE

A BERM WITH THE DIMENSIONS SHOWN SHALL BE MAINTAINED DURING CONSTRUCTION UNTIL COMPLETION OF INDIVIDUAL HOMES WITHIN THE PROJECT.

LEGEND

- EROSION CONTROL BERM
- EXISTING GROUND ELEVATION
- PROPOSED GROUND ELEVATION
- DRAINAGE FLOW DIRECTION
- RETAINING WALL
- EXISTING CONTOUR
- WATER BLOCK (HIGH POINT)
- PROPOSED CONTOUR

NOV - 2 1993
HYDROLOGY DIVISION

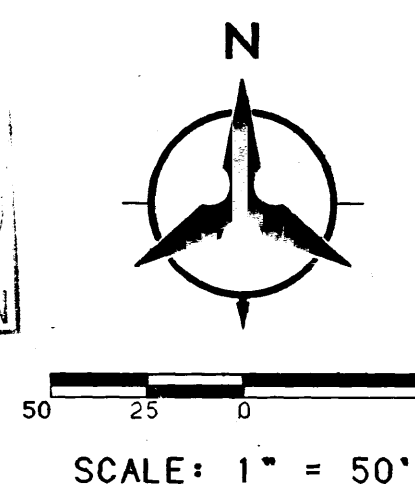

CITY OF ALBUQUERQUE PUBLIC WORKS DEPARTMENT ENGINEERING GROUP					
PALOMAS PARK- PHASE IV GRADING OF DESILTATION POND					
APPROVALS	ENGINEER	DATE	APPROVALS	ENGINEER	DATE
DRC CHAIRMAN			WATER		
TRANSPORTATION			WASTE WATER		
HYDROLOGY					
DRAWING NO.		MAP NO. D-19		SHEET 38 OF 11	


AS BUILT INFORMATION	
CONTRACTOR	
STAMPED BY'S	
ACCEPTANCE BY	
DATE	
FIELD INFORMATION	
LOCATION BY	
DATE	
DRAINING	
CORRECTED BY	
DATE	
MICRO-FILM INFORMATION	
RECORDED BY	
DATE	
NO.	

BENCH MARKS	
STATION IS A STANDARD USGS BRASS TABLET	
STAMPED "HEAVEN 1969" SET IN TOP OF A	
CONCRETE POST FLUSH WITH THE GROUND. LOCATED	
WEST ON PASEO DEL NORTE FROM WYOMING BLVD.	
APPROXIMATELY 800 FEET.	

SURVEY INFORMATION	
NO.	DATE
BY	


ENGINEER'S SEAL	
NO. DATE	
BY	

REMARKS	
REVISIONS	
DESIGN	
NO. DATE	BY
DESIGNED BY KP	DATE 10/93
DRAWN BY KW/MZM	DATE 10/93
CHECKED BY KP/JRT	DATE 10/93

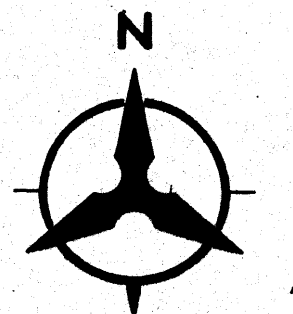


SCALE: 1" = 50'

NOTE:
I. PHASES I AND II OF THE OVERALL SUBDIVISION ARE IN FINAL STAGES OF COMPLETION. GRADES SHOWN AS EXISTING ARE DESIGN GRADES ONLY. CONTRACTOR SHALL BE FULLY RESPONSIBLE FOR VERIFYING EXISTING GRADES AND NOTIFYING ENGINEER OF ANY SIGNIFICANT DISCREPANCIES.

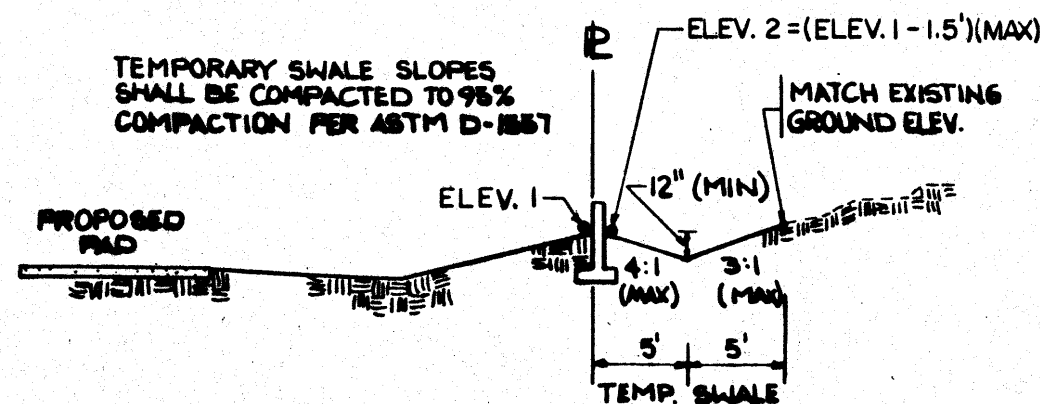

SECTION K-K
N.T.S.

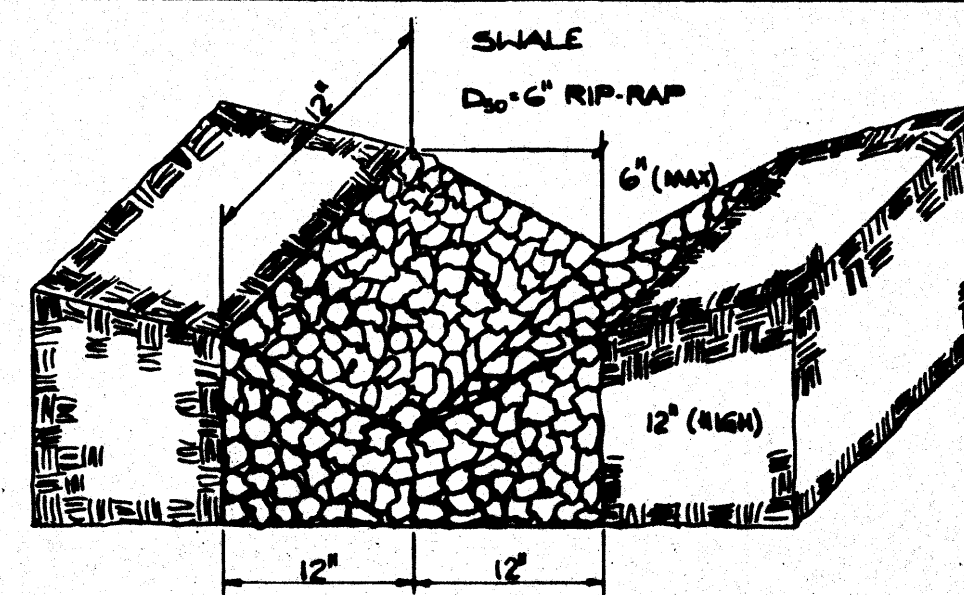

SWALE RIP-RAP
N.T.S.

GRADING CERTIFICATION

I, James Topmiller, P.E. #9354, hereby certify that grading at this site is constructed in substantial compliance with this plan, to allow the implementation of the drainage patterns and requirements identified herein. Side yard garden walls will be constructed concurrently with individual home construction, which will implement required side yard swales. As-built grade elevations were verified by field surveys performed by Aldrich Surveying during November 1993, after completion of construction. This statement does not represent certification of contractor's construction methods or materials.

Note: Record, or "as-built" elevations, are shown at selected locations across the site. Record information is identified by a double underline.


NOTICE TO CONTRACTORS

1. AN EXCAVATION/CONSTRUCTION PERMIT WILL BE REQUIRED BEFORE BEGINNING ANY WORK WITHIN THE CITY RIGHT-OF-WAY. AN APPROVED COPY OF THESE PLANS MUST BE SUBMITTED AT THE TIME OF APPLICATION FOR THIS PERMIT.
2. ALL WORK DETAILED ON THESE PLANS TO BE PERFORMED, EXCEPT AS OTHERWISE STATED OR PROVIDED HEREON, SHALL BE CONSTRUCTED IN ACCORDANCE WITH CITY OF ALBUQUERQUE STANDARD SPECIFICATIONS FOR PUBLIC WORKS CONSTRUCTION, 1986.
3. TWO WORKING DAYS PRIOR TO ANY EXCAVATION, CONTRACTOR MUST CONTACT LINE LOCATION SERVICE, 765-1234, FOR LOCATION OF EXISTING UTILITIES.
4. PRIOR TO CONSTRUCTION, THE CONTRACTOR SHALL EXCAVATE AND VERIFY THE HORIZONTAL AND VERTICAL LOCATIONS OF ALL OBSTRUCTIONS. SHOULD A CONFLICT EXIST, THE CONTRACTOR SHALL NOTIFY THE ENGINEER SO THAT THE CONFLICT CAN BE RESOLVED WITH A MINIMUM AMOUNT OF DELAY.
5. BACKFILL COMPACTION SHALL BE TO RESIDENTIAL STREET USE.
6. MAINTENANCE OF THESE FACILITIES SHALL BE THE RESPONSIBILITY OF THE OWNER OF THE PROPERTY SERVED.
7. CONTRACTOR MUST OBTAIN A TOPSOIL DISTURBANCE PERMIT FROM THE ENVIRONMENTAL HEALTH DIVISION PRIOR TO CONSTRUCTION.
8. THE CONTRACTOR IS TO REFER TO EARTHWORK SPECIFICATIONS AS NOTED IN THE SOILS REPORT PREPARED BY VINYARD AND ASSOCIATES DATED SEPTEMBER 28, 1992.
9. THE CONTRACTOR SHALL CONFORM TO ALL CITY, COUNTY, STATE, AND FEDERAL DUST CONTROL MEASURES AND REQUIREMENTS AND WILL BE RESPONSIBLE FOR PREPARING AND OBTAINING ALL NECESSARY APPLICATIONS AND APPROVALS.
10. THE CONTRACTOR SHALL ENSURE THAT NO SOIL ERODES FROM THE LOTS INTO PUBLIC RIGHT-OF-WAY. THIS CAN BE ACHIEVED BY CONSTRUCTING TEMPORARY BERMS AS PER DETAIL THIS SHEET AND WETTING THE SOIL TO KEEP IT FROM BLOWING.
11. TURN BLOCKS ON EDGE ON DOWNSTREAM END OF ALL REAR DRAINING LOTS TO PROVIDE WEEP HOLES IN WALLS (NOT APPLICABLE).
12. ALL SPOTS ELEVATIONS ALONG THE PROPOSED STREETS ARE TO TOP OF STANDARD MOUNTABLE ROLL TYPE CURB AND GUTTER (AS LABELED) UNLESS OTHERWISE NOTED.

FOR INFORMATION ONLY

LEGEND

- EROSION CONTROL BERM
- EXISTING GROUND ELEVATIONS
- PROPOSED GROUND ELEVATIONS
- DRAINAGE FLOW DIRECTION
- RETAINING WALL
- PROPOSED STORM DRAIN INLET
- EXISTING STORM DRAIN INLET
- PROPOSED STORM DRAIN MANHOLE
- EXISTING STORM DRAIN MANHOLE
- PROJECT BOUNDARY
- EXISTING CONTOUR
- FUTURE PAD ELEVATIONS

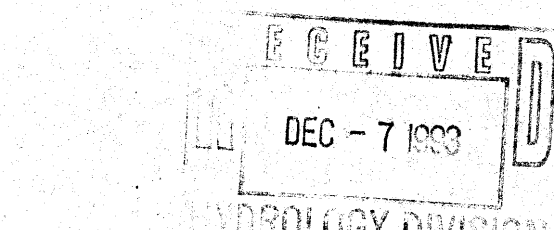

CITY OF ALBUQUERQUE
PUBLIC WORKS DEPARTMENT
ENGINEERING GROUP

PALOMAS PARK - PHASE TWO GRADING PLAN

APPROVALS	ENGINEER	DATE	APPROVALS	ENGINEER	DATE
DRG CHAIRMAN	J. Topmiller	3-10-93	WATER	NIA RWE	3-2-93
TRANSPORTATION	V. R. RHO	2-29-93	WASTE WATER	NIA RWE	3-2-93
HYDROLOGY	J. Topmiller	3-01-93			

DRAWING NO. 4510.91 MAP NO. D-19 SHEET 3 OF 12

BHI JOB NO. 91181.07

EXISTING MOBILE HOME PARK DEVELOPMENT (TYR)

BEGIN ASPHALT PAVING MATCH AND TIE INTO EXISTING PAVEMENT

GRADING CERTIFICATION
Perimeter Lots are Graded to Match Existing Grades at Subdivision Boundary.

BEGIN 4' HIGH (MAX) RETAINING WALL (SEE DETAIL SHEET FOR WALL SECTION)

SEE TYPICAL BACKYARD PONDING PLAN DETAIL SHEET

END PERMANENT CONCRETE CURB AND GUTTER AND ASPHALT PAVEMENT.

TEMPORARY RETENTION POND IS PART OF EROSION CONTROL CONSTRUCTION. POND SHALL REMAIN UNTIL POND AREA IS TO BE DEVELOPED UNDER A FUTURE PHASE.

INSTALL 3' HIGH (MIN) CHAIN LINK FENCING ALL AROUND

GRADING CERTIFICATION
Phase II Pond has been modified to meet Phase III Grading Operations. See approved Phase III plan.

TEMPORARY RETENTION POND 158 POND

VOLUME 112 AC.FT. BOTTOM = 5340.0 ELEV. 57 BERM ELEV. 5343.0

GRADING CERTIFICATION
Phase II swale has been modified to meet Phase III Grading Operations. See approved Phase III plan.

EROSION CONTROL BERM

NO SCALE

A BERM WITH THE DIMENSIONS SHOWN SHALL BE MAINTAINED DURING CONSTRUCTION UNTIL COMPLETION OF INDIVIDUAL HOMES WITHIN THE PROJECT.

EROSION CONTROL PLAN

USERNAME: C9118104.PAD
FILENAME: GRADING2.GRF

DRAINAGE PLAN
THIS PHASE 2 DRAINAGE PLAN CONFORMS TO THE OVERALL DRAINAGE PLAN OF THE ENTIRE SITE (SEE PALOMAS PARK SUBDIVISION DRAINAGE REPORT ON JUNE 1992 #D19-D18).

A PORTION OF PALOMAS PARK AVE. WILL BE DIRT GRADED SO AS TO PROVIDE AN EMERGENCY ACCESS RD. FOR PHASE 2.

THE RETENTION POND AT FUTURE LOTS 156 TO 160 IS TO BE CONSTRUCTED TO RETAIN RUNOFF FROM FUTURE PHASES.

THE RETENTION POND AT THE EAST SIDE CONSTRUCTED IN PHASE 1 SHALL BE RELOCATED SOUTH, BUT WILL SERVE SAME PURPOSE

POND CALCULATIONS (WEST)
BASINS H, H-1, H-2, & L (SEE OVERALL DRAINAGE PLAN)
TOTAL AREA OF EACH TREATMENT OF THE 4 BASINS COMBINED.
TREATMENT B 3.82 ACRES
TREATMENT C 7.65 ACRES
TOTAL AREA 10.94 ACRES
100 YEAR-6 HR STORM IN ZONE 3
EXCESS PRECIPITATION (E) =
 $0.92' (3.82 + 1.29 (7.65)) = 1.18'$
8.12 ACRES
RUNOFF VOLUME = $1.66' (8.12) = 1.07$ AC-FT

LOT LINE B4

BERM SHALL CONSIST OF 25% COMPACTION PER ASTM D-1557 MODIFIED

3' HIGH (MIN) CHAIN LINK FENCE

BERM ELEV. 43'

SECTION E-E
N.T.S.

GRADING CERTIFICATION
Phase II swale has been modified to meet Phase III Grading Operations. See approved Phase III plan.

EXISTING RETENTION POND TO BE REGRADED. SEE THIS SHEET FOR NEW LOCATION. EXISTING POND AREA TO BE FILLED IN AND PROVIDE OF 95% COMPACTION PER ASTM D-1557 MODIFIED.

LOT LINE B4

BERM SHALL CONSIST OF 25% COMPACTION PER ASTM D-1557 MODIFIED

3' HIGH (MIN) CHAIN LINK FENCE

BERM ELEV. 43'

SECTION E-E
N.T.S.


LOT LINE B4

BERM SHALL CONSIST OF 25% COMPACTION PER ASTM D-1557 MODIFIED

3' HIGH (MIN) CHAIN LINK FENCE

BERM ELEV. 43'

SECTION E-E
N.T.S.

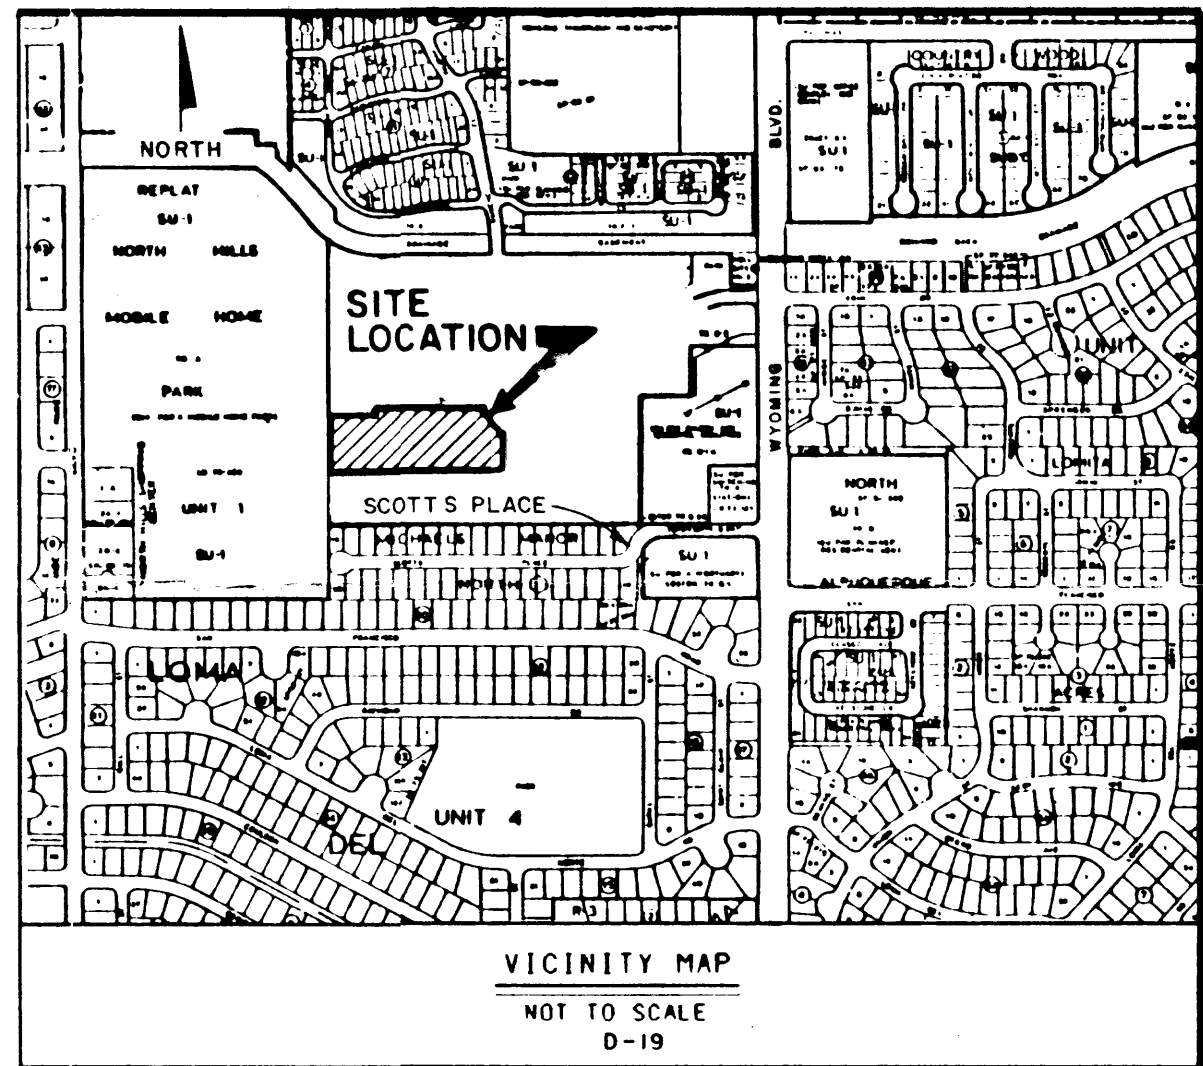

ROUTE MENT UP		ENGINEER'S SEAL		SURVEY INFORMATION		BENCH MARKS		AS BUILT INFORMATION	
				FIELD NOTES		STATION IS A STANDARD USCS BRASS TABLET			
				NO. BY DATE		STAMPED "HEAVEN 1969" SET IN TOP OF A		CONTRACTOR	
						CONCRETE POST FLUSH WITH THE GROUND. LOCATED		WORKED BY	
						WEST ON PASO DEL NORTE FROM WYOMING BLVD.		INSPECTOR'S	
						APPROXIMATELY 800 FEET.		ACCEPTANCE BY	
								FIELD LOCATION BY	
								DATE	
								DRAWINGS	
								CORRECTED BY	
								DATE	
								MICRO-FILM INFORMATION	
								RECORDED BY	
								DATE	
								NO.	

DESIGNED BY		MM/KW	DATE	9/93
DRAWN BY		MM/KW	DATE	9/93
CHECKED BY		KP/JRT	DATE	9/93

SHEET 3A OF 11	
----------------	--

1. AN EXCAVATION/CONSTRUCTION PERMIT WILL BE REQUIRED BEFORE BEGINNING ANY WORK WITHIN THE CITY RIGHT-OF-WAY. AN APPROVED COPY OF THESE PLANS MUST BE SUBMITTED AT THE TIME OF APPLICATIONS FOR THIS PERMIT.
2. ALL WORK DETAILED ON THESE PLANS TO BE PERFORMED, EXCEPT AS OTHERWISE STATED OR PROVIDED HEREON, SHALL BE CONSTRUCTED IN ACCORDANCE WITH CITY OF ALBUQUERQUE STANDARD SPECIFICATIONS FOR PUBLIC WORKS CONSTRUCTION, 1986.
3. TWO WORKING DAYS PRIOR TO ANY EXCAVATION, CONTRACTOR MUST CONTACT LINE LOCATION SERVICE, 765-1234, FOR LOCATION OF EXISTING UTILITIES.
4. PRIOR TO CONSTRUCTION, THE CONTRACTOR SHALL EXCAVATE AND VERIFY THE HORIZONTAL AND VERTICAL LOCATIONS OF ALL OBSTRUCTIONS. SHOULD A CONFLICT EXIST, THE CONTRACTOR SHALL NOTIFY THE ENGINEER SO THAT THE CONFLICT CAN BE RESOLVED WITH A MINIMUM AMOUNT OF DELAY.
5. BACKFILL COMPACTION SHALL BE TO RESIDENTIAL STREET USE.
6. MAINTENANCE OF THESE FACILITIES SHALL BE THE RESPONSIBILITY OF THE OWNER OF THE PROPERTY SERVED.
7. CONTRACTOR MUST OBTAIN A TOPSOIL DISTURBANCE PERMIT FROM THE ENVIRONMENTAL HEALTH DIVISION PRIOR TO CONSTRUCTION.
8. THE CONTRACTOR IS TO REFER TO EARTHWORK SPECIFICATIONS AS NOTED IN THE SOILS REPORT PREPARED BY VINYARD AND ASSOCIATES DATED SEPTEMBER 28, 1992.
9. THE CONTRACTOR SHALL CONFORM TO ALL CITY, COUNTY, STATE, AND FEDERAL DUST CONTROL MEASURES AND REQUIREMENTS AND WILL BE RESPONSIBLE FOR PREPARING AND OBTAINING ALL NECESSARY APPLICATIONS AND APPROVALS.

10. THE CONTRACTOR SHALL ENSURE THAT NO SOIL ERODES FROM THE SLOTS INTO PUBLIC RIGHT-OF-WAY. THIS CAN BE ACHIEVED BY CONSTRUCTING TEMPORARY BERMS AS PER DETAIL THIS SHEET AND WETTING THE SOIL TO KEEP IT FROM BLOWING.
11. ALL SLOPES MAXIMUM OF 4:1 UNLESS AS OTHERWISE INDICATED.
12. ALL SPOT ELEVATIONS ALONG THE PROPOSED STREETS ARE TO TOP OF STANDARD OR MOUNTABLE ROLL TYPE CURB AND GUTTER (AS LABELED) UNLESS OTHERWISE NOTED.


THIS PHASE DRAINAGE PLAN CONFORMS TO THE OVERALL DRAINAGE PLAN OF THE ENTIRE SITE (SEE PALOMAS PARK SUBDIVISION DRAINAGE REPORT ON JUNE 1992, #D19-D1B.)

THE WEST END TEMPORARY DESILTATION POND, RECONSTRUCTED AS A PART OF PHASE III, WILL BE RELOCATED SOUTH OF THE PHASE IV BOUNDARY LIMITS (SEE SHEET 3B OF 11).

RUNOFF FROM THE CHURCH PROPERTY AND FROM THE SOUTHERN PORTION OF PHASE II WILL BE DIRECTED DOWN GALINAS AVENUE TO THE WEST AS PER PHASE III GRADING AND DRAINAGE. (SEE PHASE III GRADING AND DRAINAGE PLAN).

THE SIZE AND VOLUME OF THE RELOCATED DESILTATION POND REMAINS THE SAME FROM PHASE III TO THIS PHASE. REFER TO PHASE III FOR DRAINAGE CALCULATIONS.

A DRAINAGE COVENANT IS PREPARED FOR THE RELOCATED DESILTATION POND OF PHASE IV. A PUBLIC EASEMENT IS PLACED OVER THE DESILTATION POND.

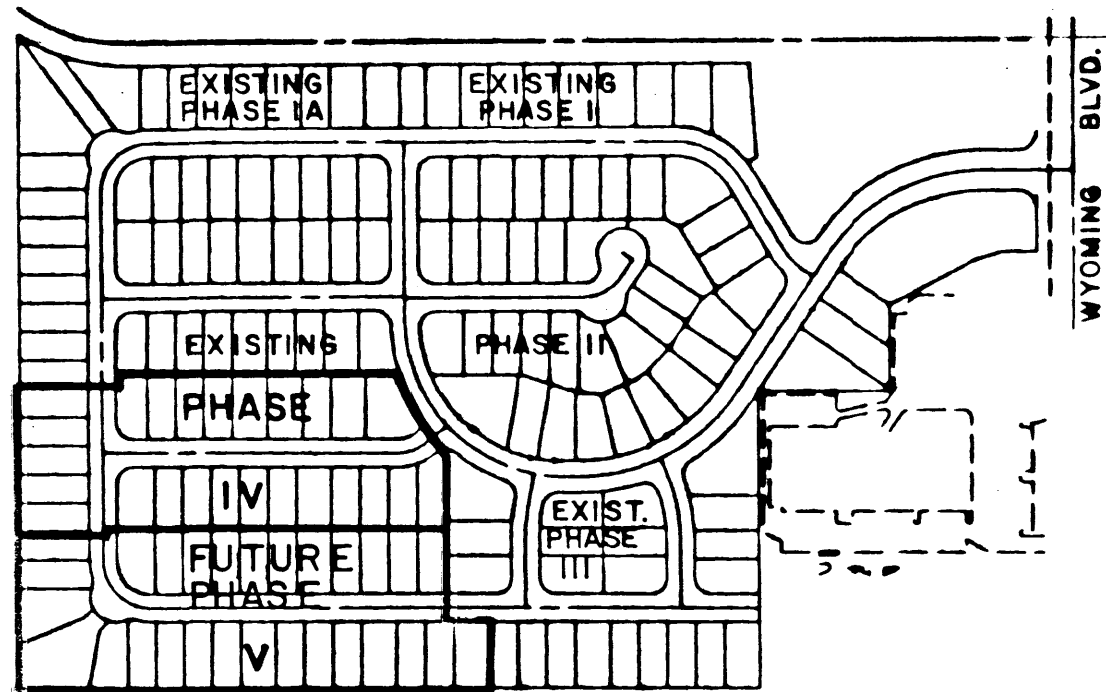


KEY MAP

NO SCALE


APPROVED FOR ROUGH GRADING ($\pm 1'$)

HYDROLOGY ENGINEER

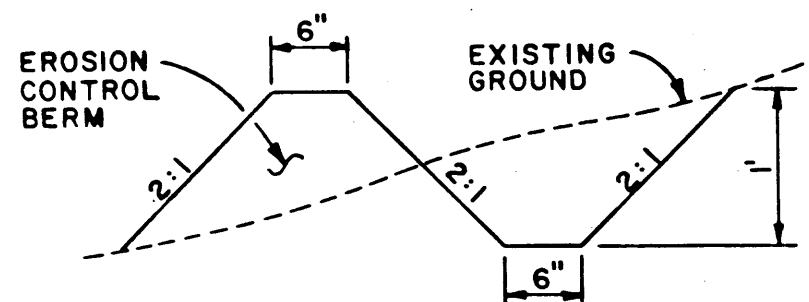



EROSION CONTROL PLAN
NO SCALE

A BERM WITH THE DIMENSIONS SHOWN SHALL BE MAINTAINED DURING CONSTRUCTION UNTIL COMPLETION OF INDIVIDUAL HOMES WITHIN THE PROJECT.

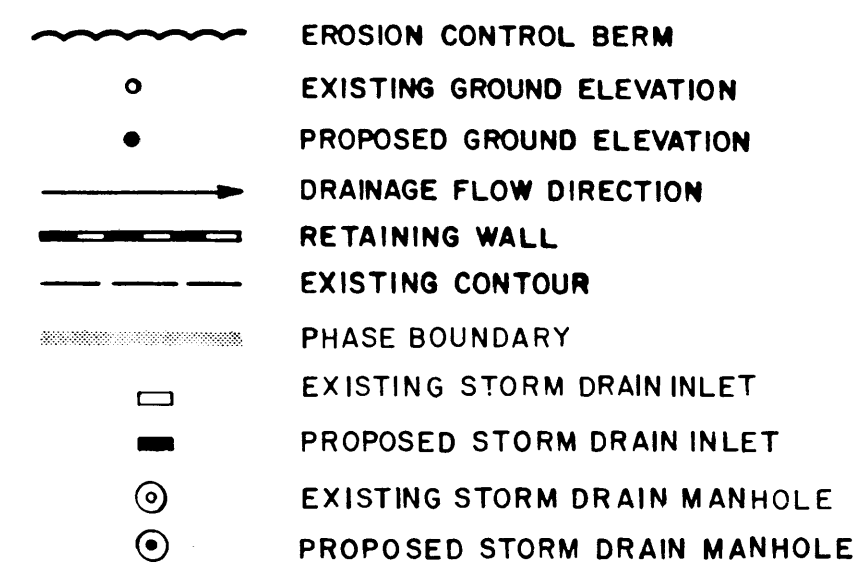

LEGAL DESCRIPTION

LOTS 133 TO 157, INCLUSIVE,
PALOMAS PARK SUBDIVISION, PHASE IV.

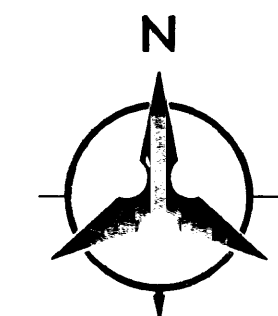
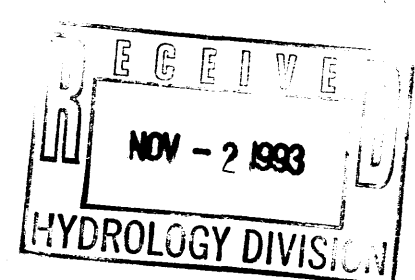


SCALE: 1" = 50'

	CITY OF ALBUQUERQUE PUBLIC WORKS DEPARTMENT ENGINEERING GROUP
PALOMAS PARK- PHASE IV FINAL GRADING & DRAINAGE PLAN	






APPROVALS	ENGINEER	DATE	APPROVALS	ENGINEER	DATE
DRC CHAIRMAN			WATER		
TRANSPORTATION			WASTE WATER		
HYDROLOGY					
DRAWING NO.		MAP NO. D-19		SHEET 3A OF 11	

CONTRACTOR TO PROVIDE STUCCO OR OTHER
EXTERIOR TREATMENT ON WALL AS
REQUIRED BY OWNER.

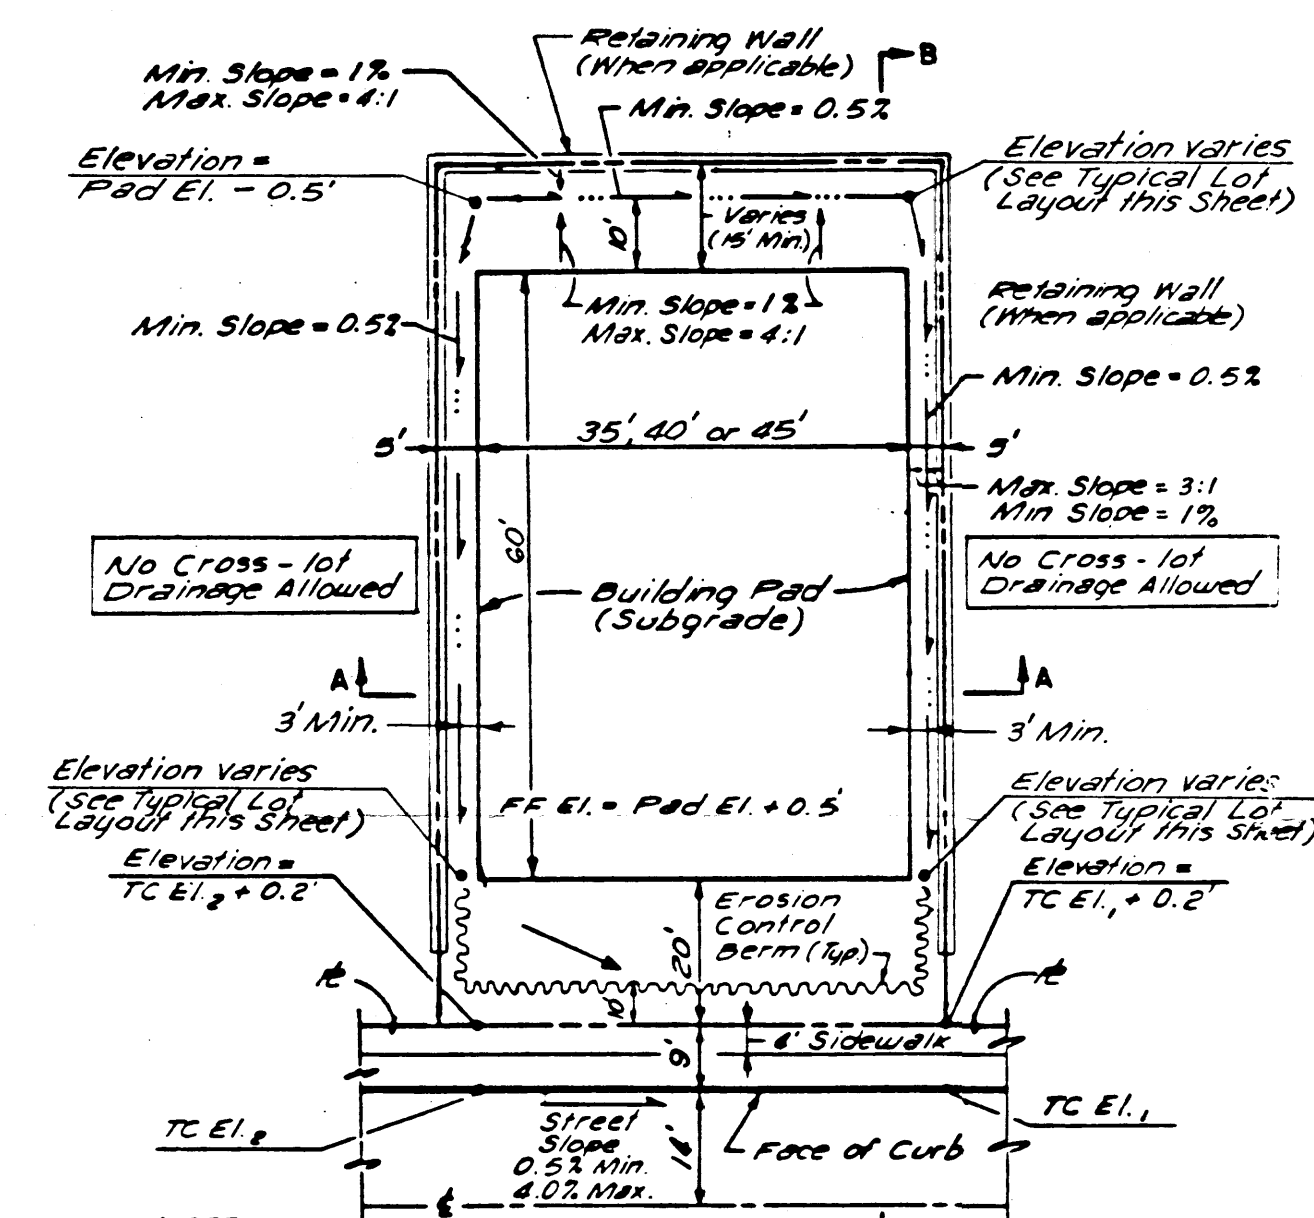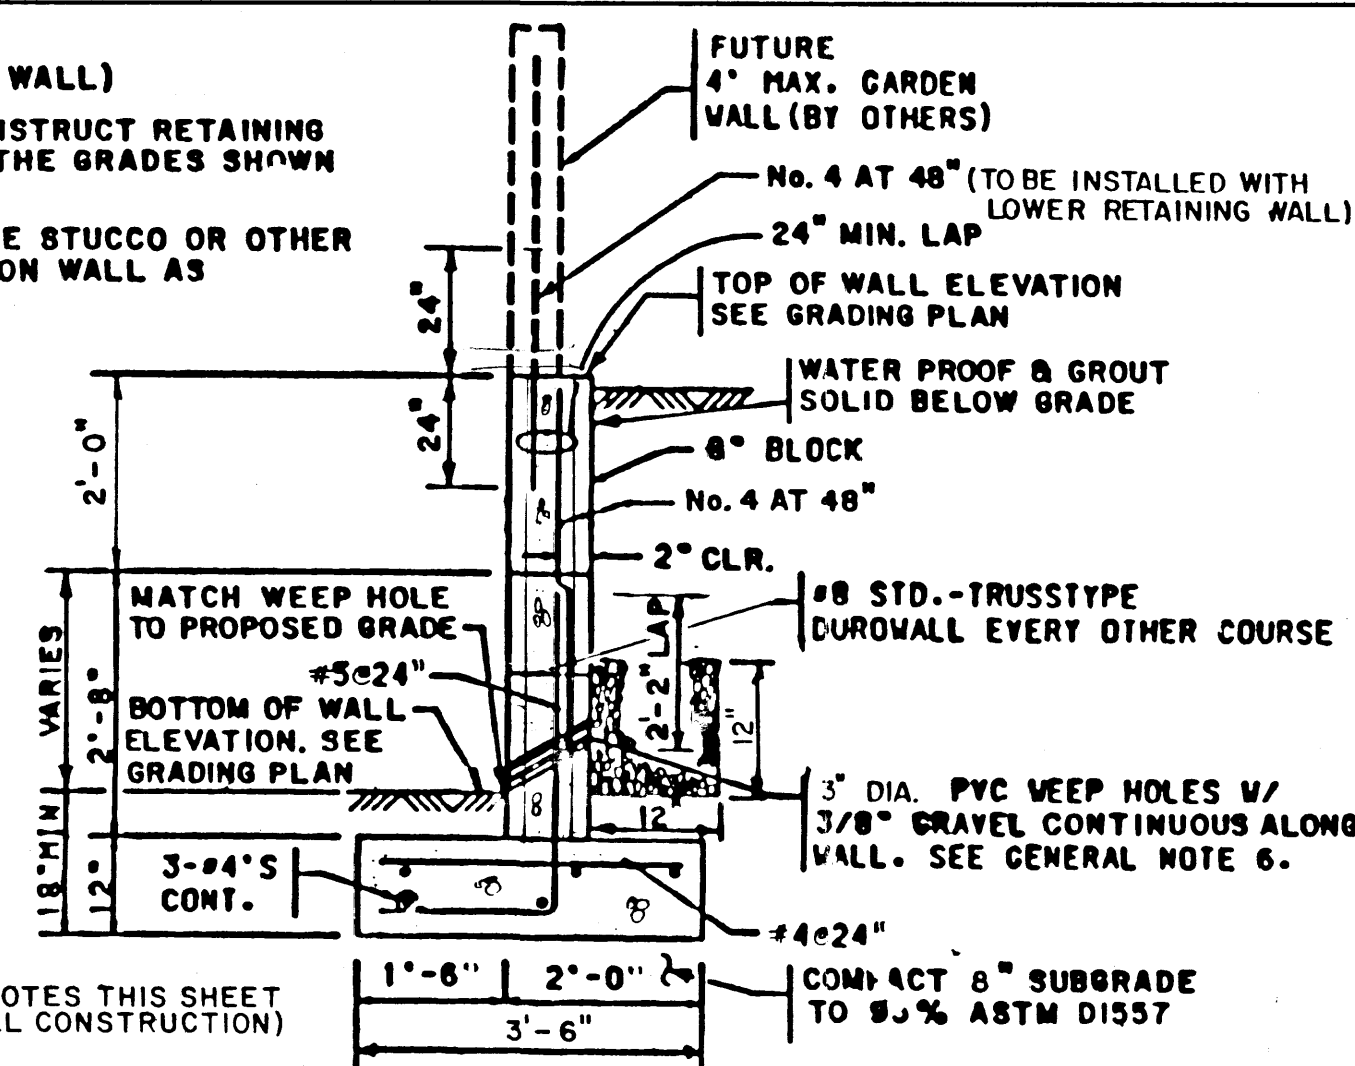

NOTE:





Side and rear-yard drainage allowed when side or rear-yard is adjacent to R.O.W. Weep holes shall be provided in side or rear property walls when walls are adjacent to R.O.W.

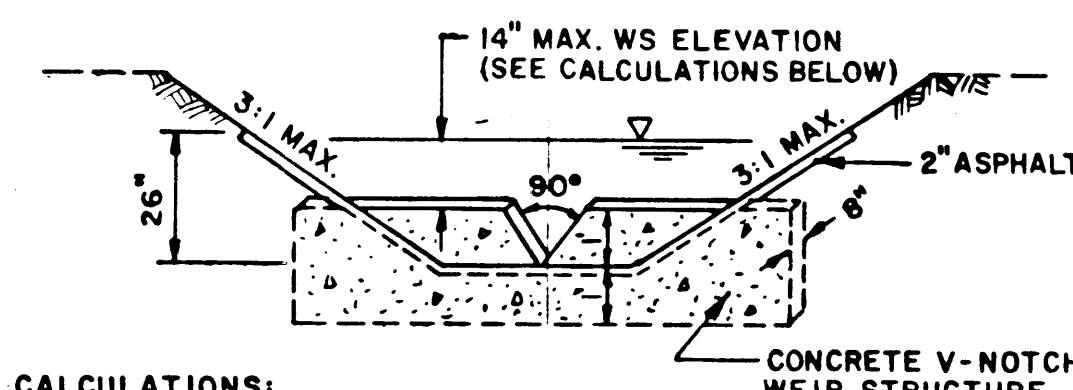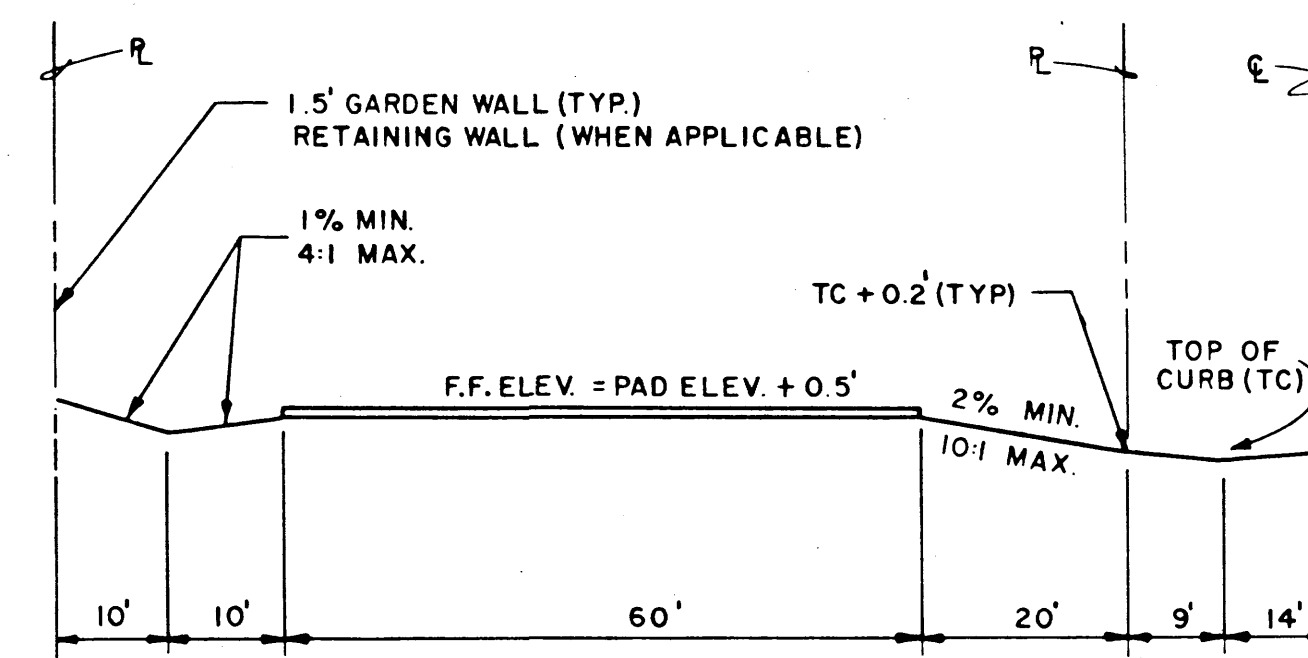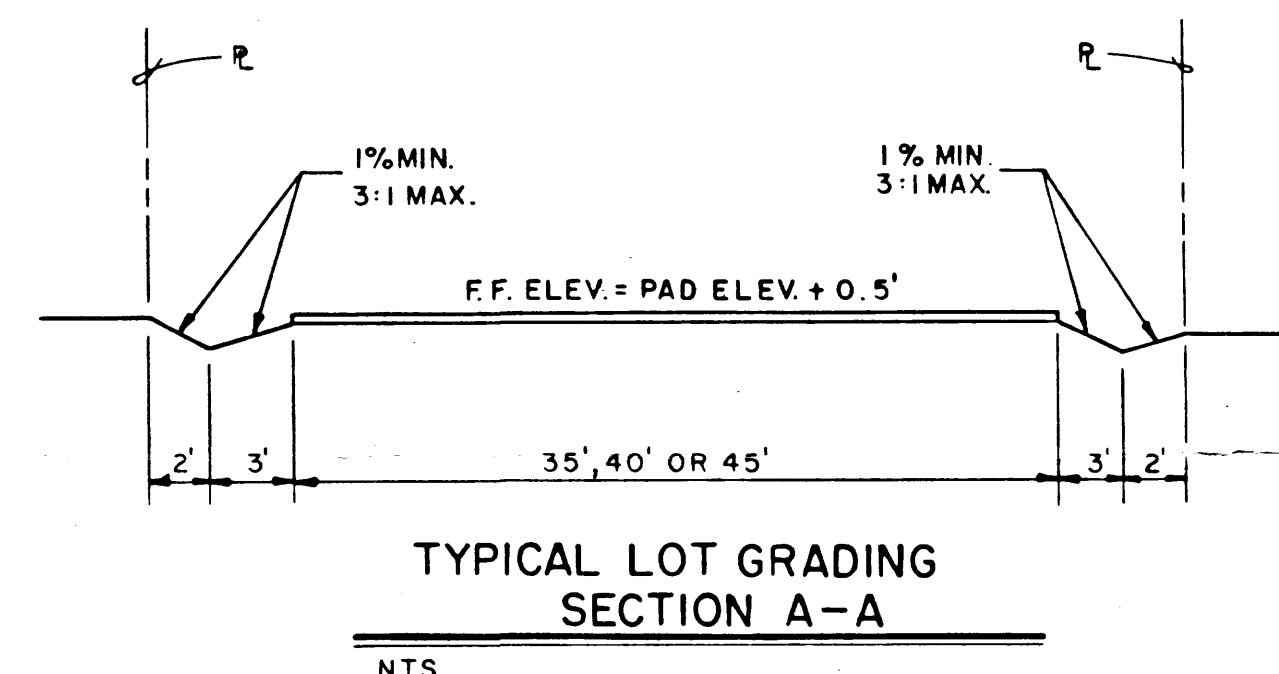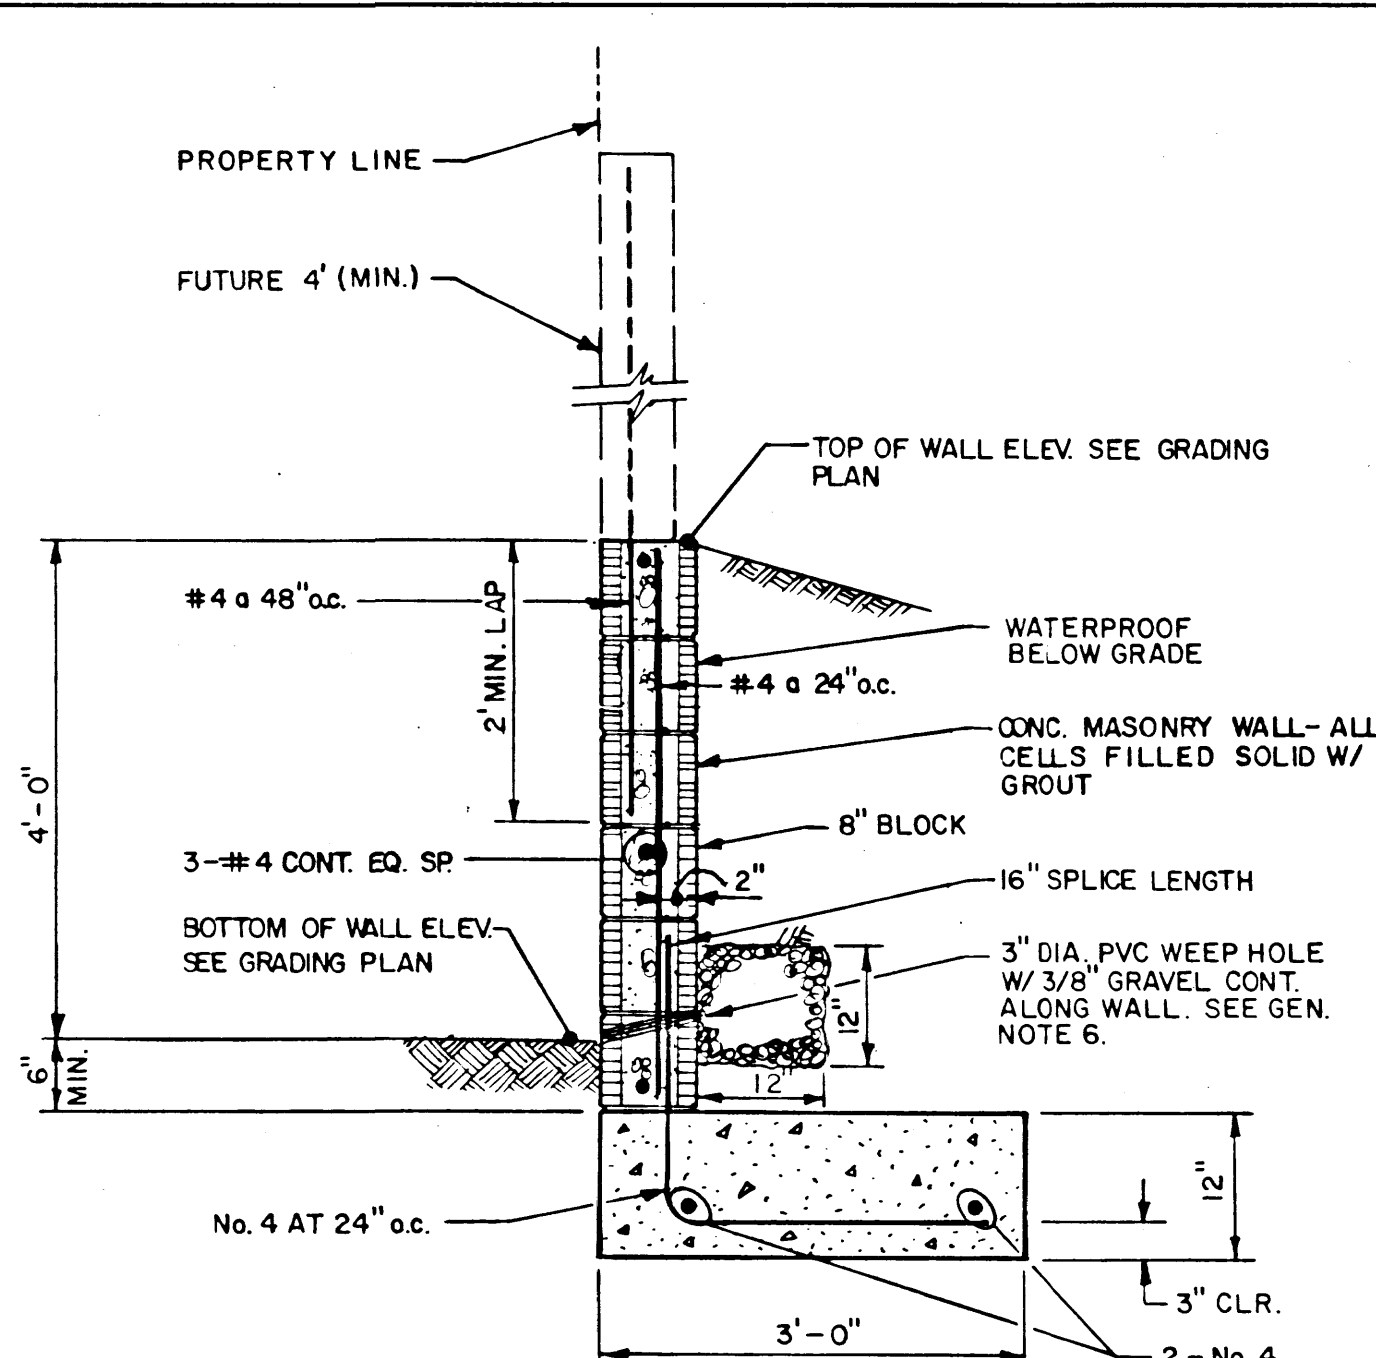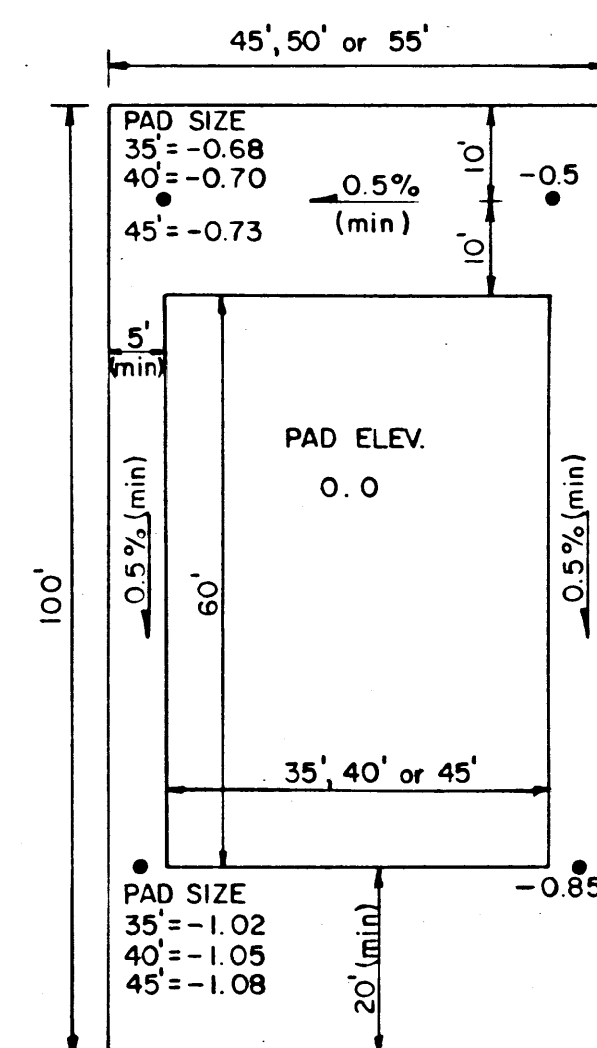

CALCULATIONS:
ASSUMING FULL
PASSES OVER THE
OF WEIR

$$H = \left(\frac{36.2}{3.367(b)} \right)^{2/3} = 1.13$$

H < 14" OK

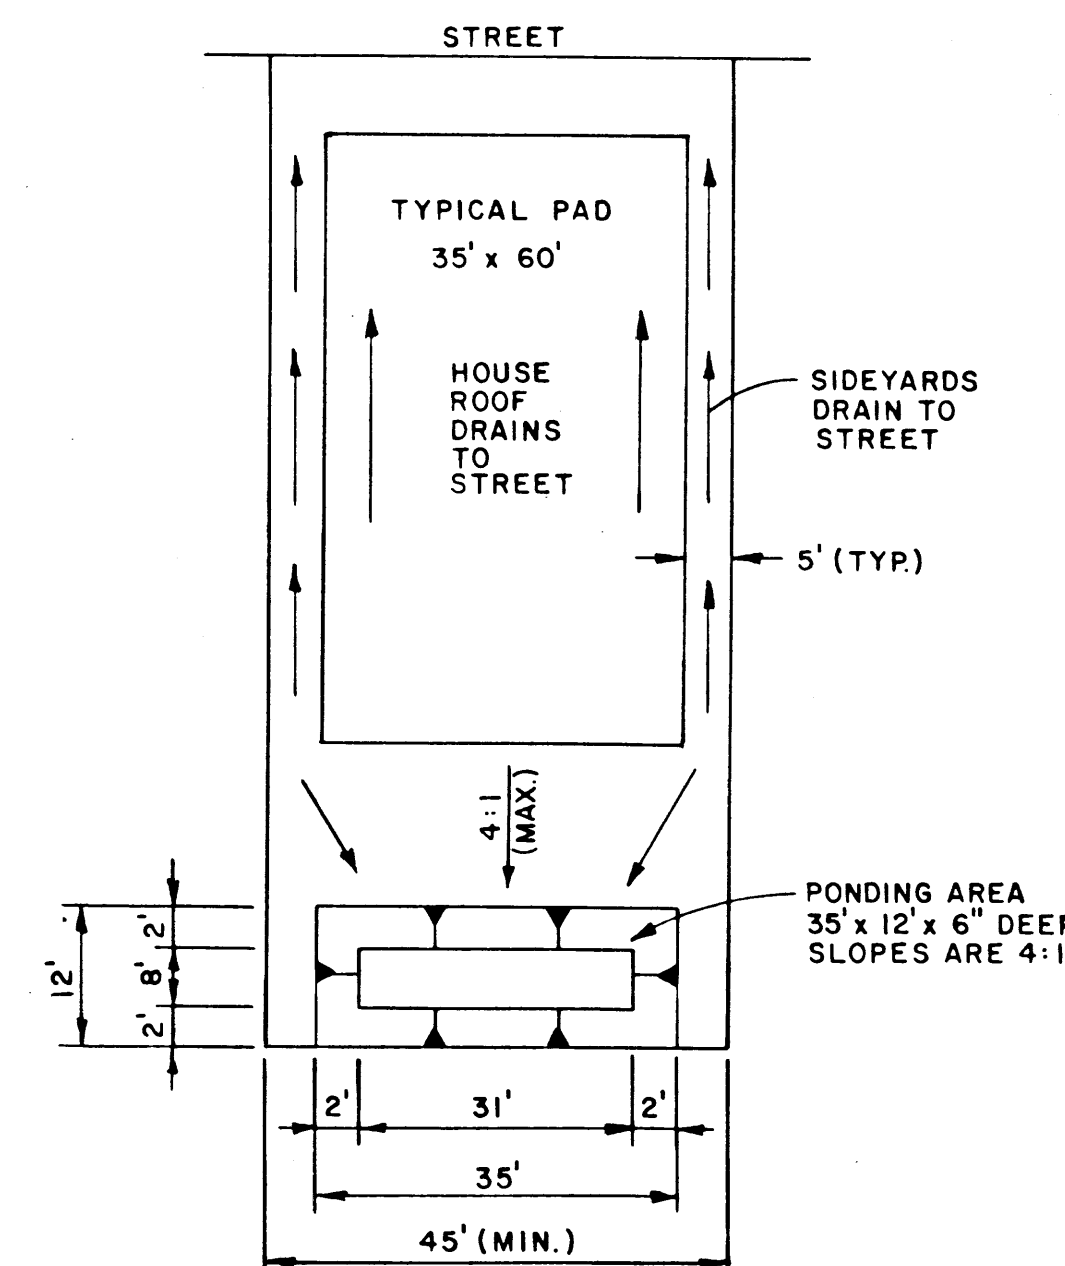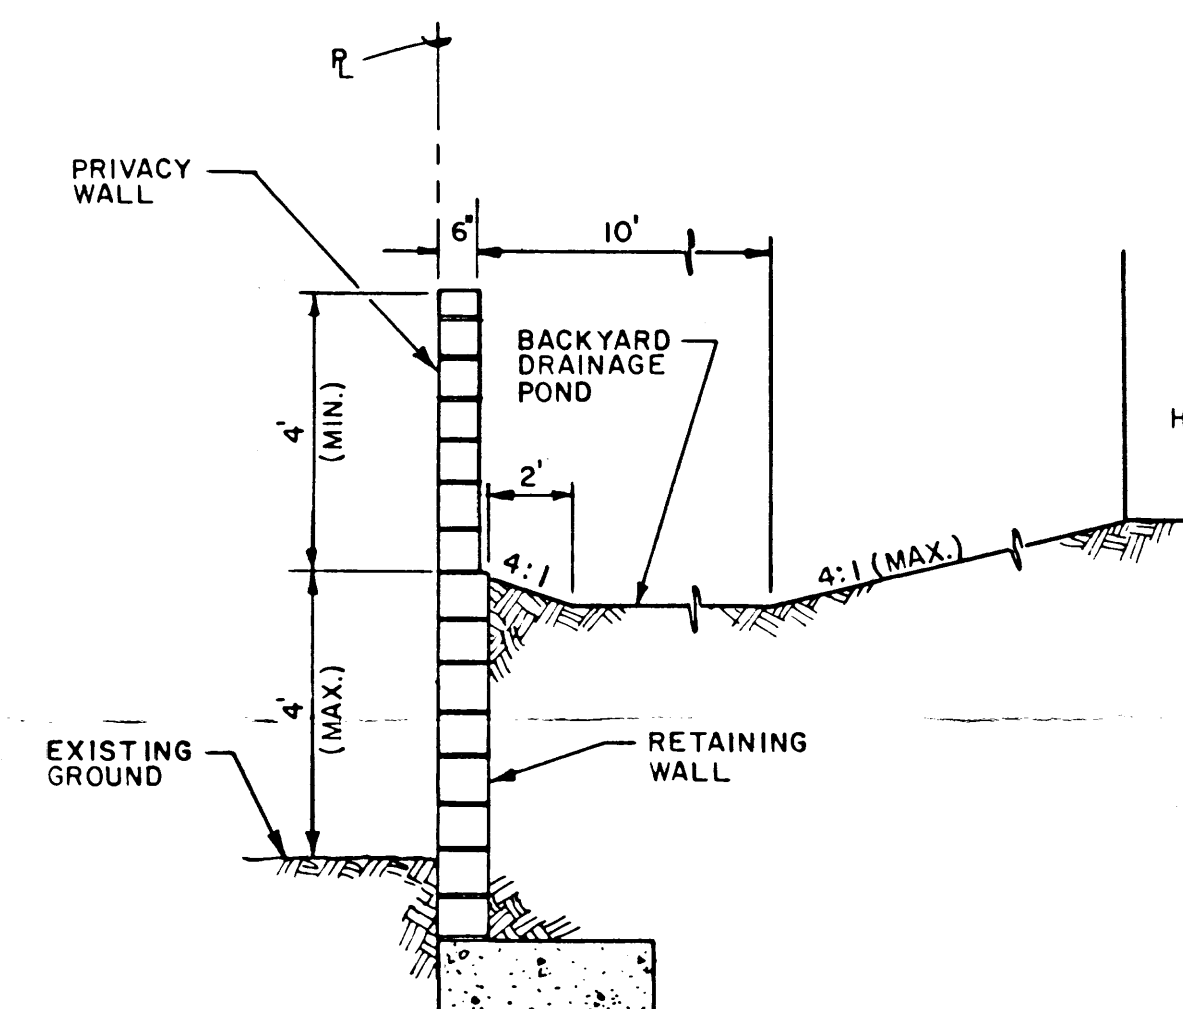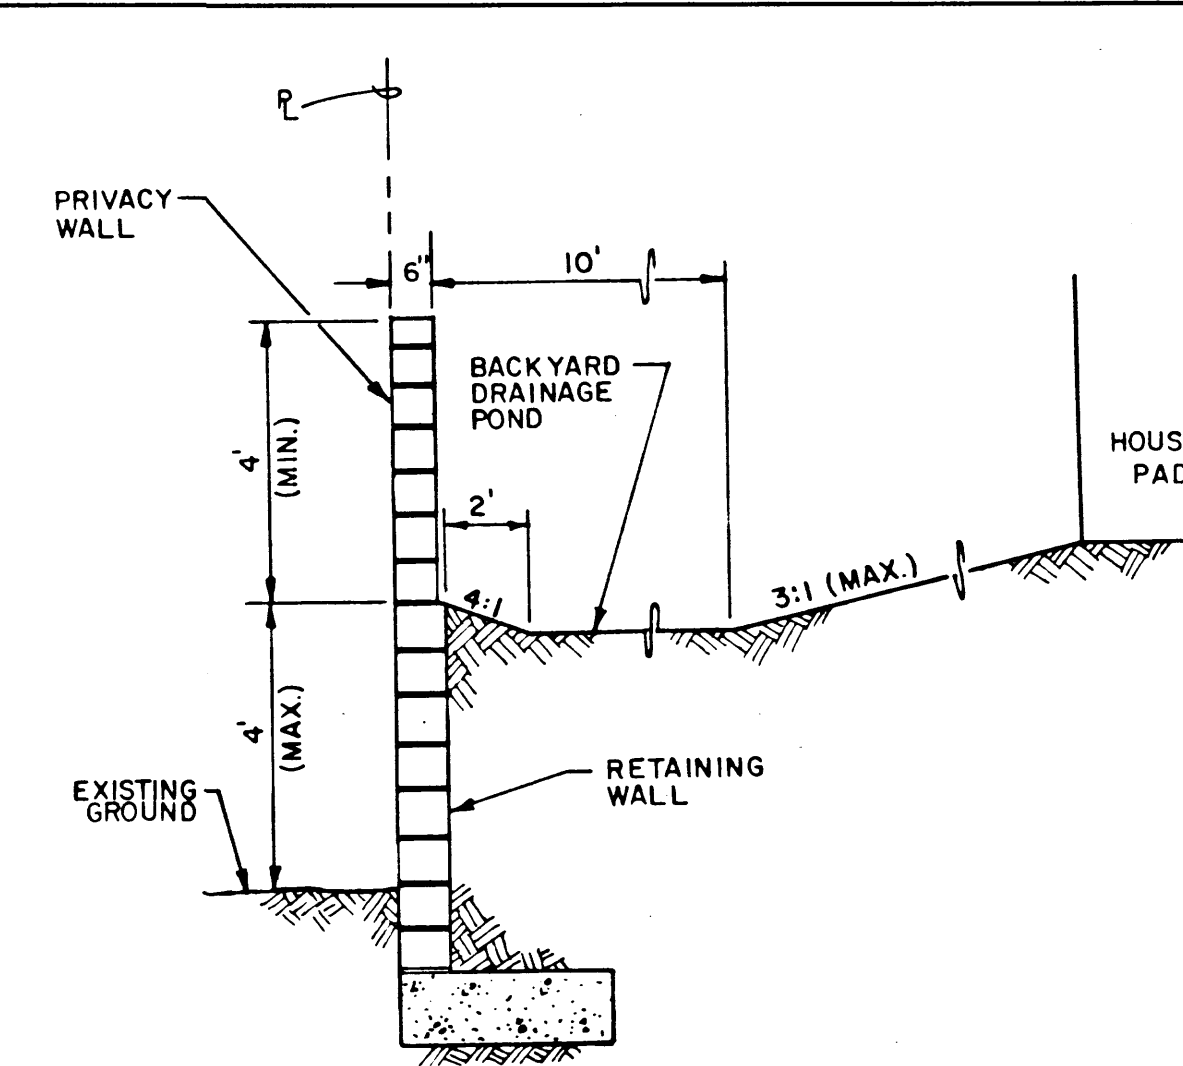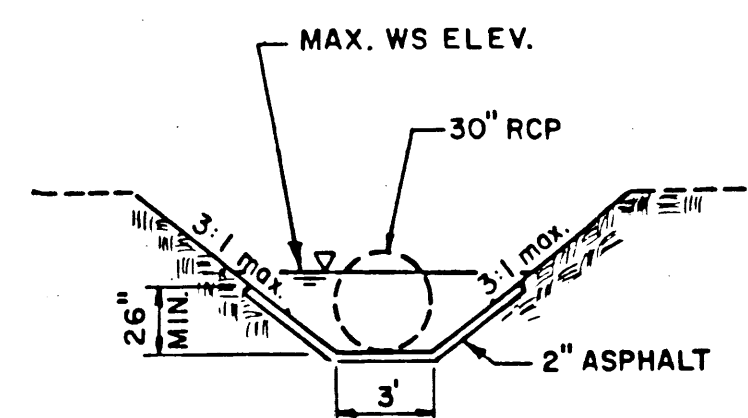

1. RETAINING WALL FOOTINGS SHOULD BE EMBEDDED A MINIMUM OF EIGHTEEN (18) INCHES BELOW LOWEST ADJACENT GRADE. PRIOR TO PLACING FOOTINGS, THE EXPOSED SOILS SHOULD BE SCARIFIED TO A DEPTH OF EIGHT (8) INCHES, MOISTURE CONDITIONED TO A NEAR OPTIMUM +/- 3% MOISTURE CONTENT AND COMPACTED TO A MINIMUM OF 95% OF MAXIMUM DENSITY AS DETERMINED BY ASTM D-1557.

2. RETAINING WALL SHALL NOT BE BACKFILLED UNTIL AT LEAST 7 DAYS AFTER PLACING OF FINAL GROUT LEVEL. WHERE HEAVY EQUIPMENT IS USED IN BACKFILLING, SUCH EQUIPMENT SHOULD NOT APPROACH CLOSER TO THE TOP OF THE WALL THAN A DISTANCE EQUAL TO THE HEIGHT OF THE WALL. CARE SHOULD BE TAKEN TO AVOID EXERTING IMPACT FORCES ON THE WALL AS COULD BE CAUSED BY A LARGE MASS OF MOVING EARTH.

SLOPES UP AWAY FROM WALLS SHOULD NOT EXCEED 3:1

3. VERTICAL CONTROL JOINTS WITH PVC INSERTS SHALL BE PLACED AT INTERVALS NOT TO EXCEED 30'-0" ON CENTER. PILASTERS MAY BE SUBSTITUTED FOR CONTROL JOINTS WHEN PLACED AT 12'-0" INTERVALS. DISCONTINUE DUROWALL EACH SIDE OF PILASTERS.

4. MINIMUM LAP SPLICE ON REINFORCING BARS SHALL BE 30" BAR DIAMETERS OR 1'-4" MINIMUM. REINFORCEMENT OF A SIZE AND SPACING OTHER THAN THAT GIVEN IN THE TABLES MAY BE USED PROVIDING SUCH OTHER REINFORCEMENT FURNISHES AN AREA OF STEEL AREA AT LEAST EQUAL TO THAT GIVEN IN THE TABLE.

5. CONSTRUCTION OF RETAINING WALLS SHALL CONFORM TO REQUIREMENTS OF THE UNIFORM BUILDING CODE SECTION 24, LOWLIFT GROUTING METHOD.

6. OMISSION OF A VERTICAL MORTAR JOINT ON FIRST COURSE AT 48" O.C. MAY BE SUBSTITUTED FOR PVC WEEP HOLES.

7. DESIGN DATA

- BLOCK WEIGHT 12" = 130 PSF
- BLOCK WEIGHT 8" = 85 PSF
- SOIL WEIGHT = 120 PCF
- EQUIV. FLUID PRESSURE = 35 PCF
- SOIL BEARING PRESSURE = 1500 PSF
(1/3 INCREASE FOR WIND/SEISMIC)
- COEFFICIENT OF FRICTION = 0.4
- PASSIVE SOIL PRESSURE = 300 PCF
- CONCRETE (7'C 28 DAYS) = 3000 PSI
- GROUT STRENGTH = 2000 PSI
- CMU GRADE N = 1500 PSI (GROUTED)
- REINFORCEMENT = 60 KSI ASTM A-615

8. CONTRACTOR SHALL NOTIFY ENGINEER PRIOR TO CONCRETE FOOTING POUR FOR INSPECTION OF COMPACTION UNDER FOOTING, FOOTING DEPTH AND WIDTH AND WALL STEEL AND SPACING. FINAL INSPECTION OF FOOTING AND WALL WILL BE REQUIRED.

9. CONTRACTOR SHALL BE RESPONSIBLE FOR CODE ADMINISTRATION APPROVAL AND FEES ASSOCIATED WITH IT.


10. PLACEMENT OF THE REINFORCING SHALL BE THE RESPONSIBILITY OF THE CONTRACTOR. IMPROPER PLACEMENT OF FOOTINGS OR REINFORCEMENT SHALL BE CORRECTED AT NO COST TO THE OWNER.

ENGINEER'S SEAL		SURVEY INFORMATION		BENCH MARKS		AS BUILT INFORMATION	
		FIELD NOTES		STATION IS A STANDARD USCGS BRASS TABLET		CONTRACTOR	
		NO.	BY	DATE	STAMPED "HEAVEN 1969" SET IN TOP OF A		WORKED BY
					CONCRETE POST FLUSH WITH THE GROUND. LOCATED		INSPECTOR'S
					WEST ON PASSED DEL NORTE FROM WYOMING BLVD.		ACCEPTANCE BY
					APPROXIMATELY 800 FEET.		FIELD LATION BY
							DRAWINGS
							CORRECTED BY
							MICRO-FILM INFORMATION
							RECORDED BY
							NO.
DESIGNED BY	KGP	DATE	9/93				
DRAWN BY	KCM/MZM	DATE	9/93				



INC.

CITY OF ALBUQUERQUE
PUBLIC WORKS DEPARTMENT
ENGINEERING GROUP

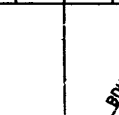

INC.

PALOMAS PARK - PHASE IV

DETAIL SHEET


APPROVALS	ENGINEER	DATE	APPROVALS	ENGINEER	DATE
DRC CHAIRMAN			WATER		
TRANSPORTATION			WASTE WATER		
HYDROLOGY					

DRAWING NO.

MAP NO.
D-19

SHEET 11 OF 11

FILED DECEMBER 12, 1973 (DS-187)

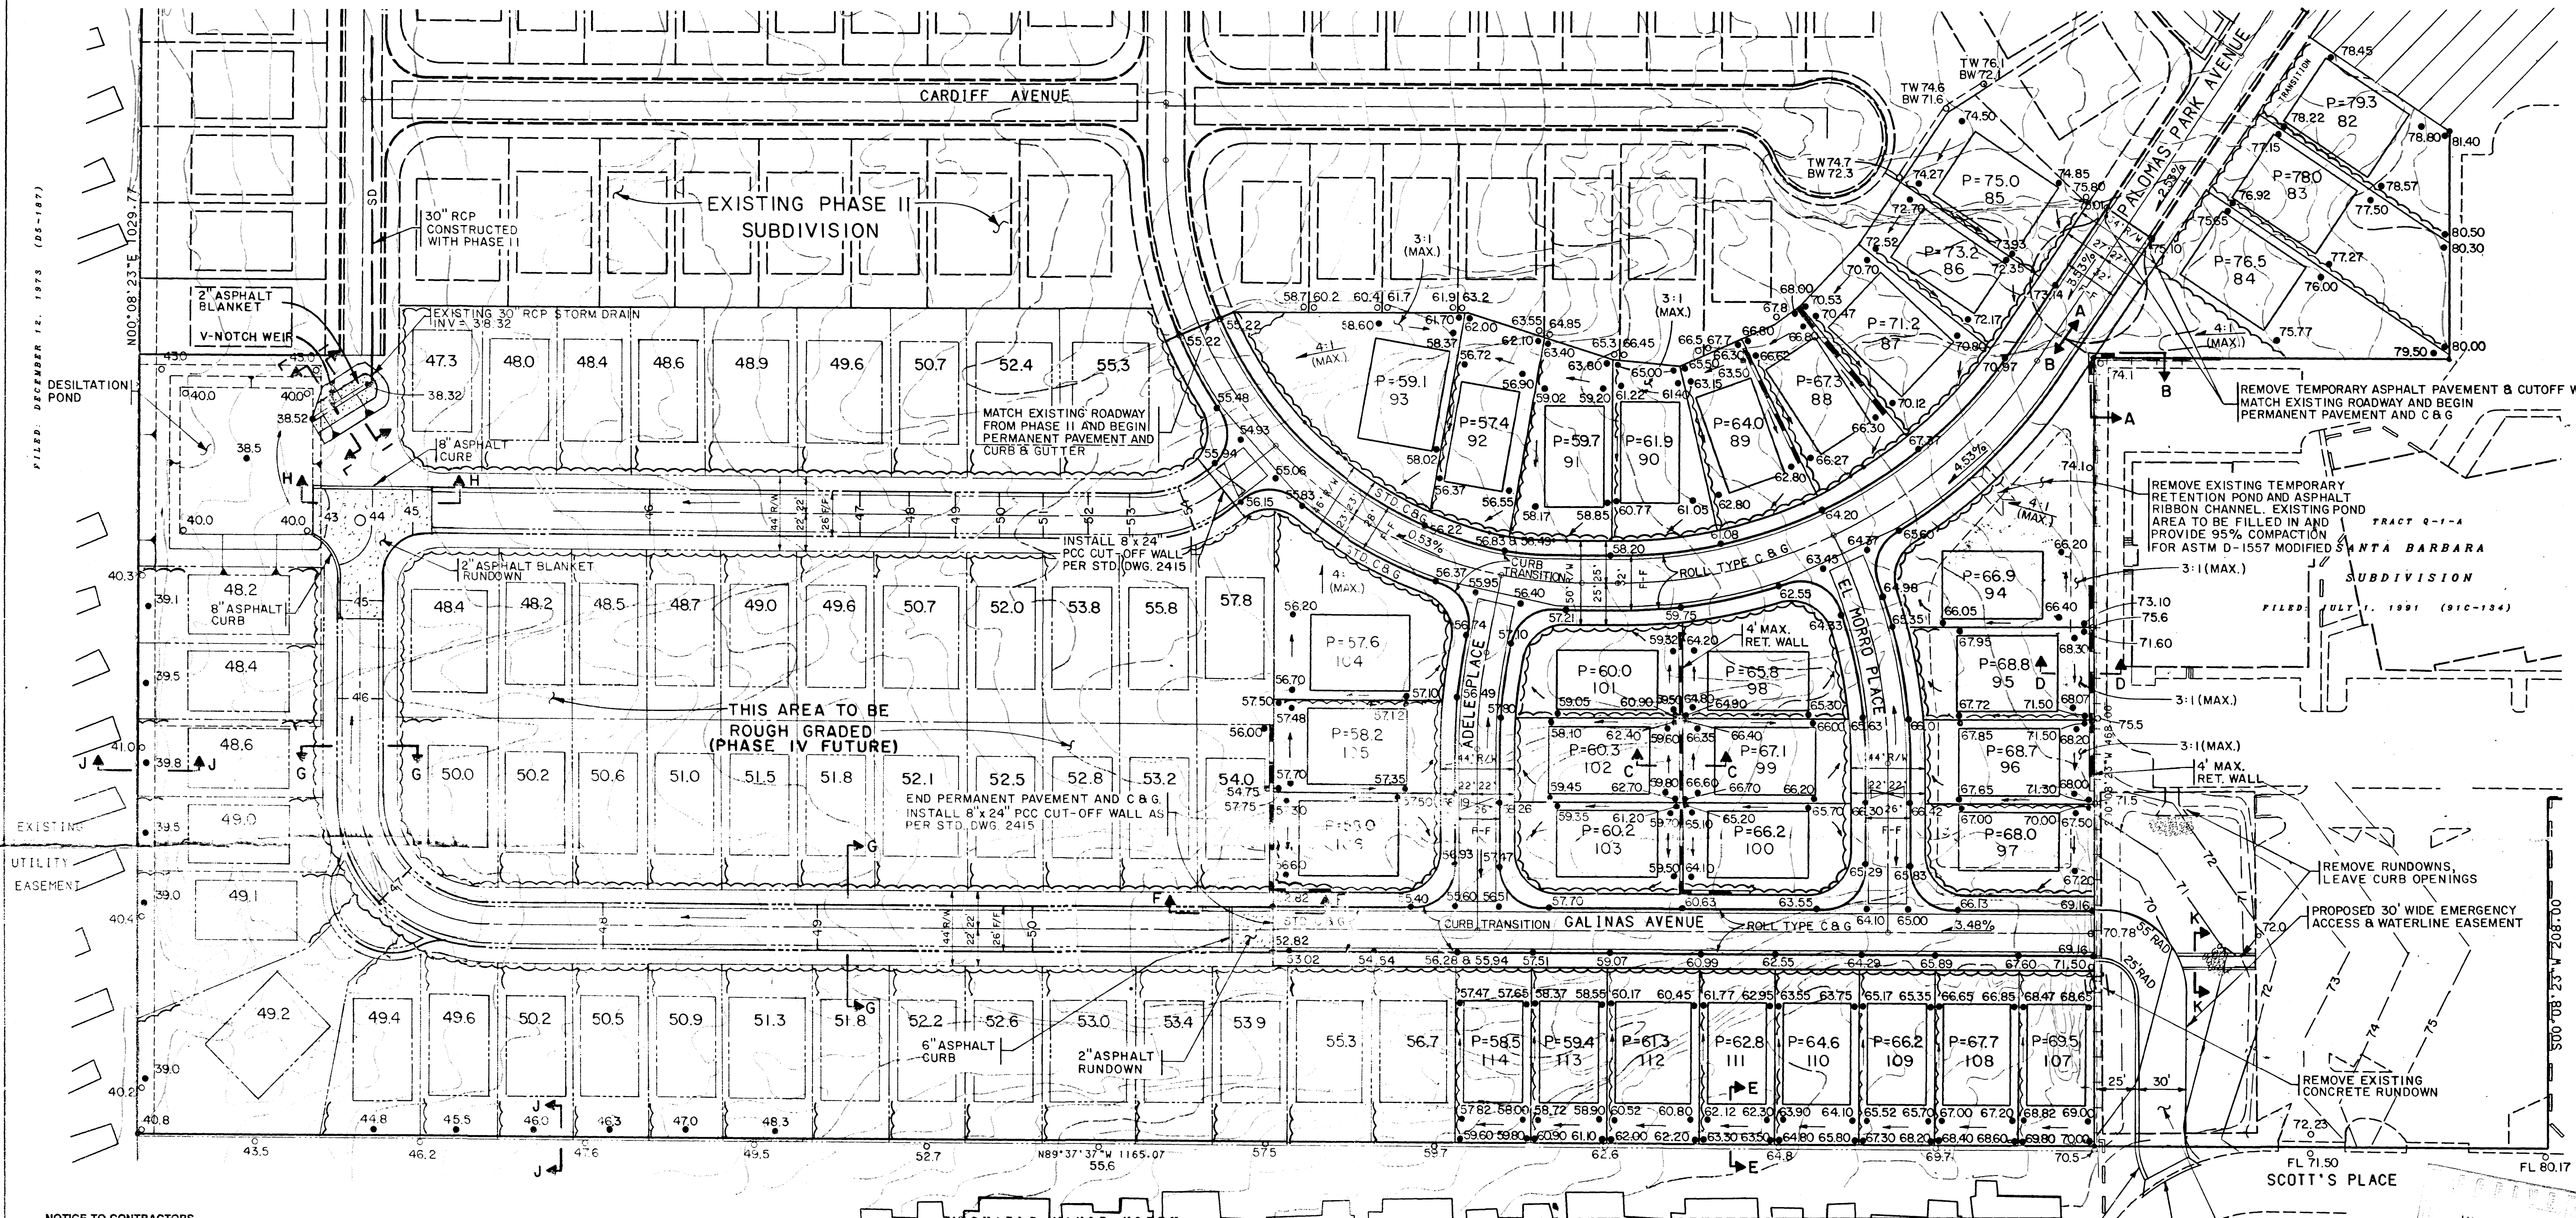

NOTICE TO CONTRACTORS

- AN EXCAVATION/CONSTRUCTION PERMIT WILL BE REQUIRED BEFORE BEGINNING ANY WORK WITHIN THE CITY RIGHT-OF-WAY. AN APPROVED COPY OF THESE PLANS MUST BE SUBMITTED AT THE TIME OF APPLICATIONS FOR THIS PERMIT.
- ALL WORK DETAILED ON THESE PLANS TO BE PERFORMED, EXCEPT AS OTHERWISE STATED OR PROVIDED HEREON, SHALL BE CONSTRUCTED IN ACCORDANCE WITH CITY OF ALBUQUERQUE STANDARD SPECIFICATIONS FOR PUBLIC WORKS CONSTRUCTION, 1986.
- TWO WORKING DAYS PRIOR TO ANY EXCAVATION, CONTRACTOR MUST CONTACT LINE LOCATION SERVICE, 765-1234, FOR LOCATION OF EXISTING UTILITIES.
- PRIOR TO CONSTRUCTION, THE CONTRACTOR SHALL EXCAVATE AND VERIFY THE HORIZONTAL AND VERTICAL LOCATIONS OF ALL OBSTRUCTIONS. SHOULD A CONFLICT EXIST, THE CONTRACTOR SHALL NOTIFY THE ENGINEER SO THAT THE CONFLICT CAN BE RESOLVED WITH A MINIMUM AMOUNT OF DELAY.
- BACKFILL COMPACTION SHALL BE TO RESIDENTIAL STREET USE.
- MAINTENANCE OF THESE FACILITIES SHALL BE THE RESPONSIBILITY OF THE OWNER OF THE PROPERTY SERVED.
- CONTRACTOR MUST OBTAIN A TOPSOIL DISTURBANCE PERMIT FROM THE ENVIRONMENTAL HEALTH DIVISION PRIOR TO CONSTRUCTION.
- THE CONTRACTOR IS TO REFER TO EARTHWORK SPECIFICATIONS AS NOTED IN THE SOILS REPORT PREPARED BY VINYARD AND ASSOCIATES DATED SEPTEMBER 28, 1992.
- THE CONTRACTOR SHALL CONFORM TO ALL CITY, COUNTY, STATE, AND FEDERAL DUST CONTROL MEASURES AND REQUIREMENTS AND WILL BE RESPONSIBLE FOR PREPARING AND OBTAINING ALL NECESSARY APPLICATIONS AND APPROVALS.
- THE CONTRACTOR SHALL ENSURE THAT NO SOIL ERODES FROM THE LOTS INTO PUBLIC RIGHT-OF-WAY. THIS CAN BE ACHIEVED BY CONSTRUCTING TEMPORARY BERMS AS PER DETAIL THIS SHEET AND WETTING THE SOIL TO KEEP IT FROM BLOWING.
- ALL SLOPES MAXIMUM OF 4:1 UNLESS AS OTHERWISE INDICATED.
- ALL SPOT ELEVATIONS ALONG THE PROPOSED STREETS ARE TO TOP OF STANDARD OR MOUNTABLE ROLL TYPE CURB AND GUTTER (AS LABELED) UNLESS OTHERWISE NOTED.

DRAINAGE PLAN

This Phase III drainage plan conforms to the overall drainage plan of the entire site (see Palomas Park Subdivision Drainage Report on June 1992, #D19-D1B).

The east end temporary retention pond constructed for Phase II, and the pond located in the proposed emergency access and waterline easement on the Church property, will be eliminated and regraded. Runoff from the Church property and from the southern portion of this phase will be directed down Galinas Avenue to the west. Peak flow at the downstream end of Galinas Avenue at the Phase III boundary was calculated to be 36.2 cfs (see Drainage Calculations).

A temporary swale will be constructed to carry runoff through the proposed "rough graded" area of the site. The swale is designed to carry peak flow at under 3 fps (non-erosive per DPM, see Drainage Calculations) and approximates the future grade and alignment of Galinas Avenue.

The west end temporary retention pond constructed as part of Phase II will be partially regraded. The remaining portion will serve as a temporary desiltation pond for runoff from this phase. From the desiltation pond, runoff will be diverted to an existing 30 inch RCP storm drain via a 40 foot long channel. All of these temporary improvements will be removed with Phase IV of Palomas Park Subdivision.

A drainage covenant is prepared for the swale and the desiltation pond of Phase III. Public easements are placed over the desiltation pond and swale.

APPROVED FOR ROUGH GRADING (± 1')

Hydrology Engineer
4-21-93
DATE

NOTE: ALL CURB AND GUTTER ELEVATIONS SHOWN ARE TOP OF CURB ELEVATIONS.

DRAINAGE CALCULATIONS

SWALE (continuation of Galinas Ave.):

Total area of each treatment (developed portion of Basin H - see overall grading plan)

Treatment B = 0.487 AC
Treatment C = 0.490 AC
Treatment D = 1.322 AC

Discharge from 100-year, 6-hour storm, Zone 3.

From developed portion of Basin H

$Q_{100} = (0.487 \times 2.60) + (0.490 \times 3.45) + (1.322 \times 5.02) = 9.59 \text{ cfs}$

From church property (revised drainage plan for addition to Church of the Risen Savior)


$Q_{100} = 26.6 \text{ cfs}$

Total discharge down swale

$Q_{100} \text{ Total} = 9.59 + 26.6 = 36.2 \text{ cfs}$

Through a trial and error analysis, assuming a discharge of 36.2, the maximum depth in the Galinas Avenue swale is found to be 0.7 ft (5=0.5%). The maximum velocity at peak flow is as follows:

$$V_{max} = 1.49/\text{ft}^2 \times R^{2/3} \times S^{1/2} = 1.49/0.3^{2/3} \times (13.8\text{ft}/29.2\text{ft})^{2/3} \times (.008)^{1/2} = 2.70 \text{ ft/s}$$

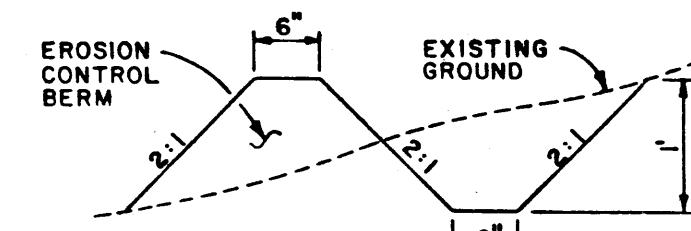


EROSION CONTROL PLAN

A BERM WITH THE DIMENSIONS SHOWN SHALL BE MAINTAINED DURING CONSTRUCTION UNTIL COMPLETION OF INDIVIDUAL HOMES WITHIN THE PROJECT.

LEGEND

- EROSION CONTROL BERM
- EXISTING GROUND ELEVATION
- PROPOSED GROUND ELEVATION
- DRAINAGE FLOW DIRECTION
- RETAINING WALL
- EXISTING CONTOUR
- WATER BLOCK (HIGH POINT)
- PROPOSED CONTOUR

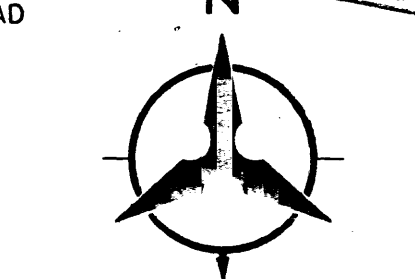

SCALE: 1" = 50'


CITY OF ALBUQUERQUE PUBLIC WORKS DEPARTMENT ENGINEERING GROUP			
PALOMAS PARK- PHASE III FINAL GRADING AND DRAINAGE PLAN			
APPROVALS	ENGINEER	DATE	APPROVALS
DRC CHAIRMAN			WATER
TRANSPORTATION			WASTE WATER
HYDROLOGY			
DRAWING NO.		MAP NO. D-19	SHEET OF

BENCH MARKS		AS BUILT INFORMATION	
CONTRACTOR	STATION IS A STANDARD USCS GRASS TABLET	CONTRACTOR	NO.
INSPECTOR'S	STAMPED "HEAVEN 1969" SET IN TOP OF A	INSPECTOR'S	DATE
FIELD	CONCRETE POST FLUSH WITH THE GROUND. LOCATED	FIELD	DATE
VERIFICATION	WEST ON PASO DEL NORTE FROM WYOMING BLVD.	VERIFICATION	DATE
CORRECTED	APPROXIMATELY 800 FEET.	CORRECTED	DATE
MICRO-FILM INFORMATION		MICRO-FILM INFORMATION	
RECORDED BY	ELEVATION = 5378.787	RECORDED BY	NO.

ENGINEER'S SEAL

SURVEY INFORMATION		FIELD NOTES	
NO.	DATE	NO.	DATE
BY		BY	
REMARKS		REMARKS	
DESIGNED BY	DATE 3/93	DESIGNED BY	DATE 3/93
DRAWN BY	DATE 3/93	DRAWN BY	DATE 3/93
CHECKED BY	DATE 3/93	CHECKED BY	DATE 3/93



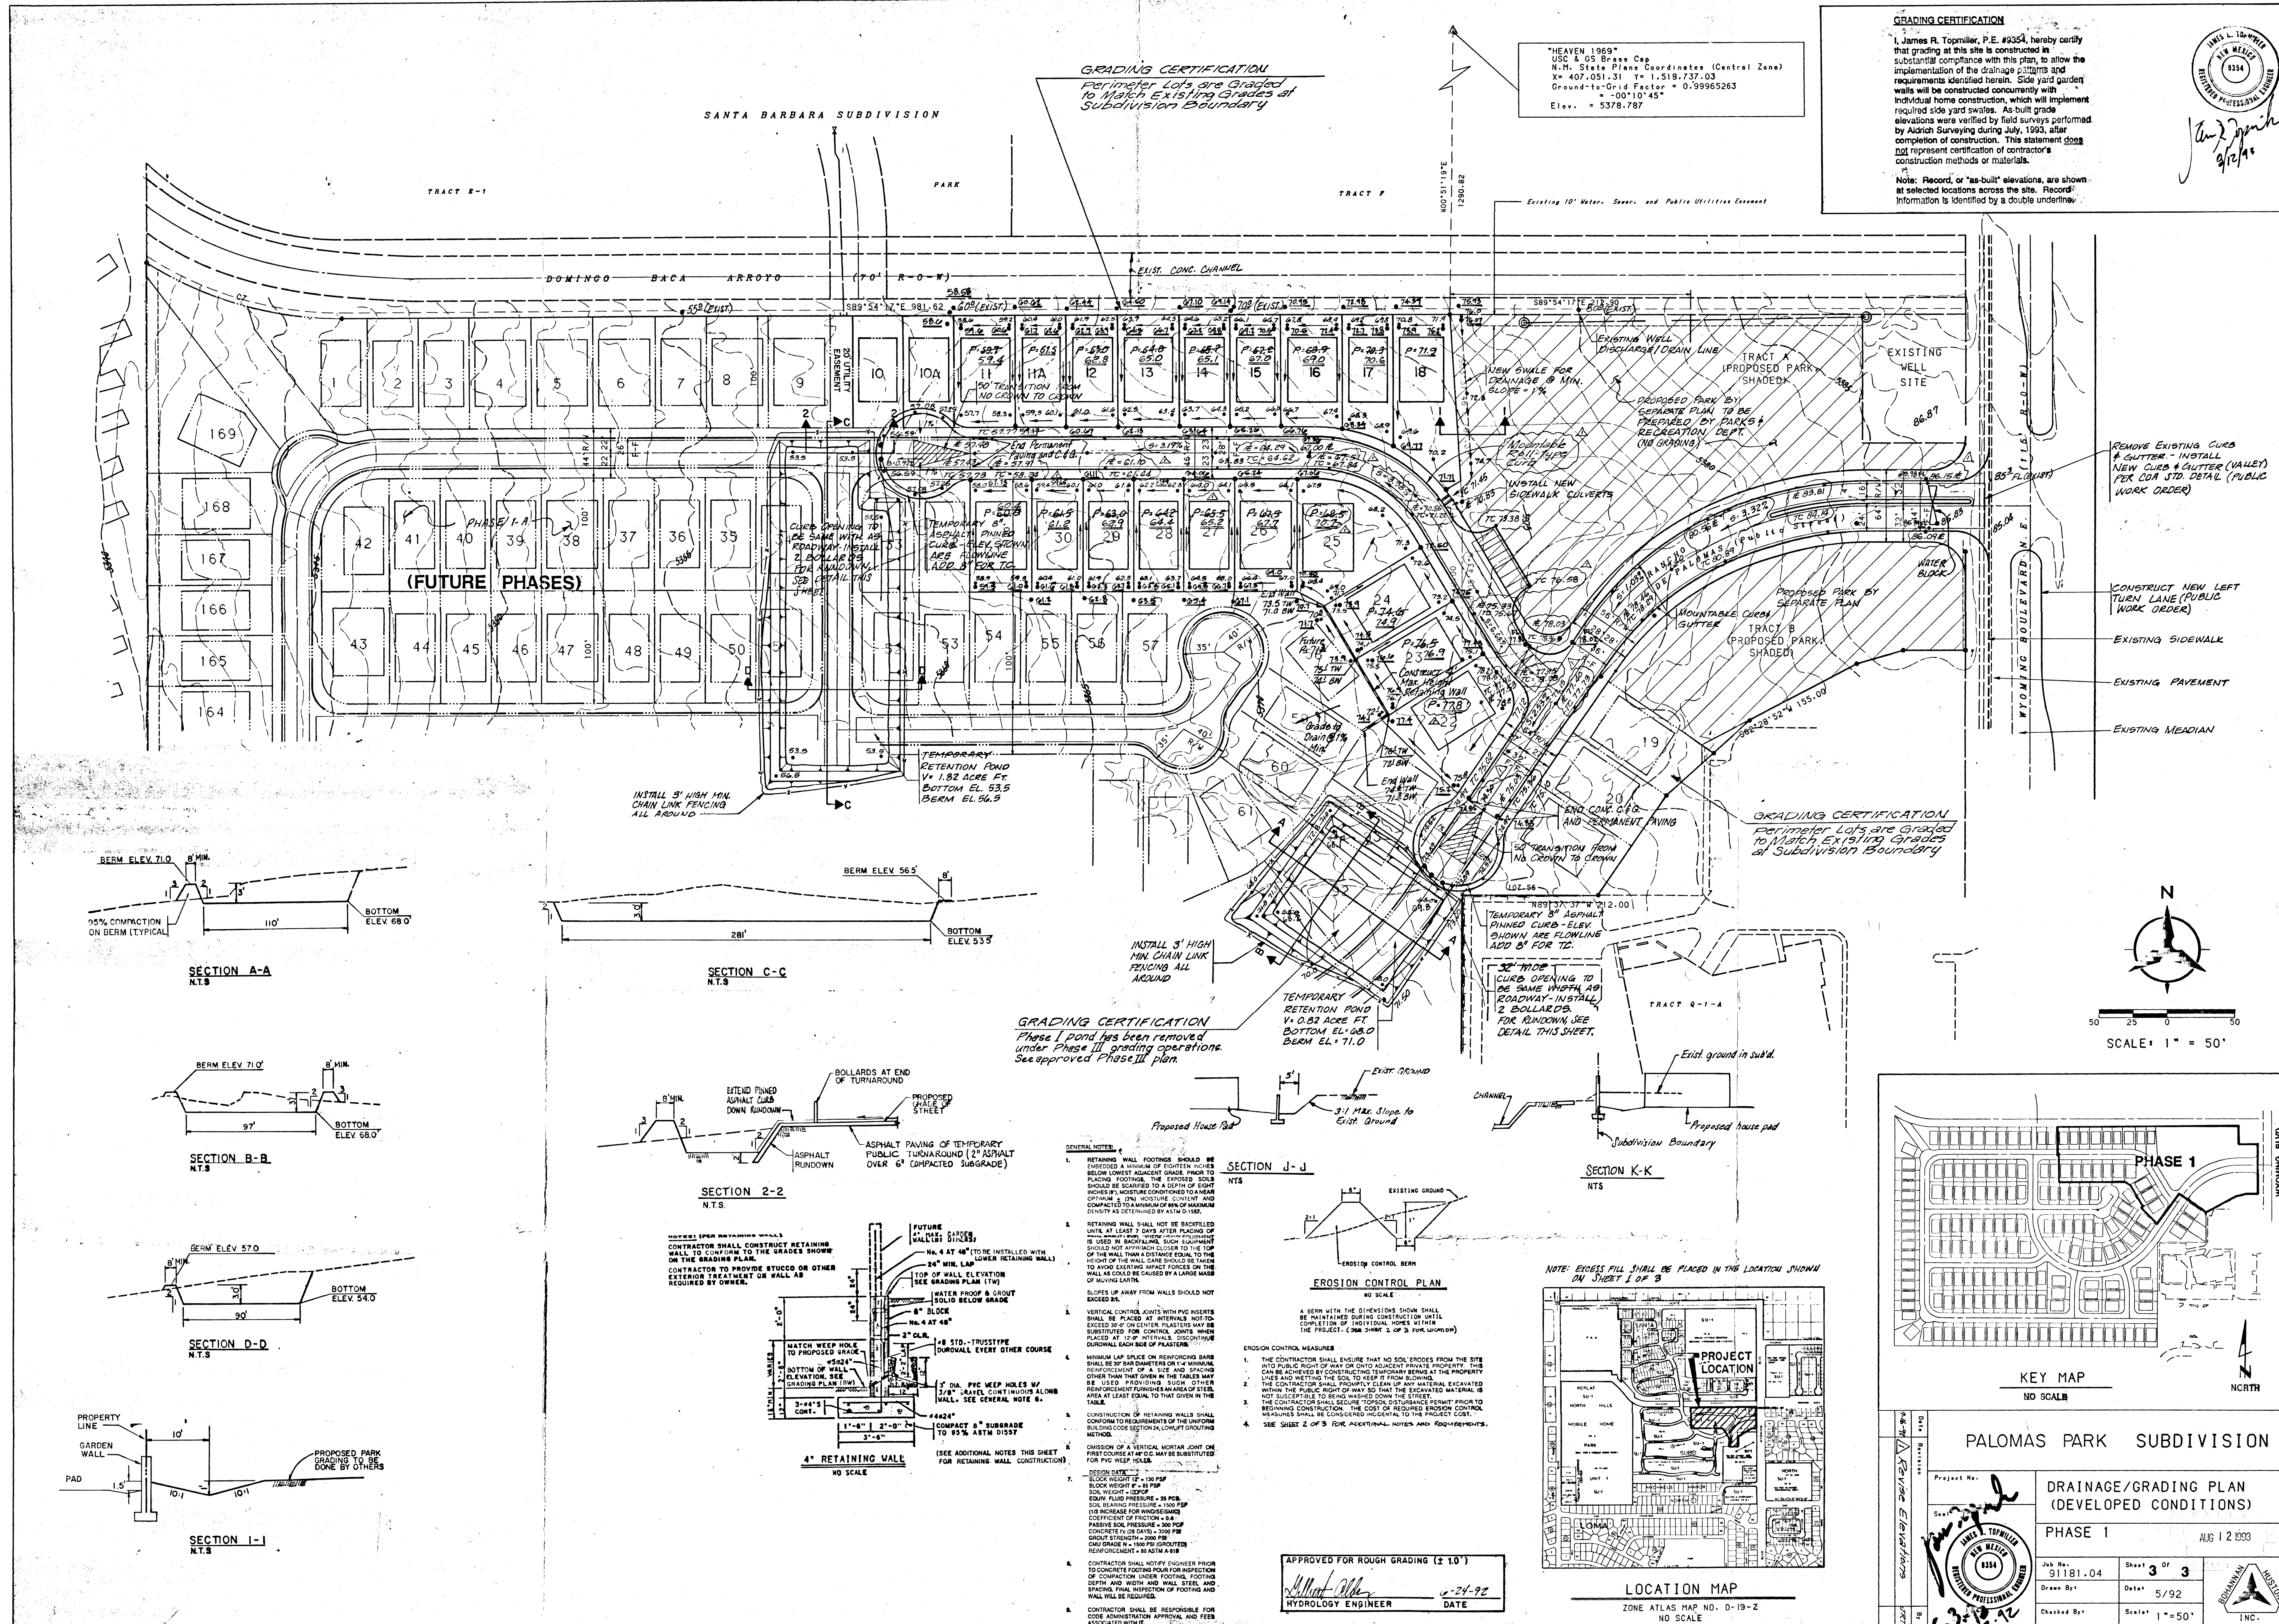

"HEAVEN 1989"
USC & GS Brass Cap
N.T.S. State Plane Coordinates (Central Zone)
X = 407,051.31 Y = 1,518,737.03
Ground-to-Grid Factor = 0.99965263
Elev. = 5378.787

GRADING CERTIFICATION
I, James R. Topmiller, P.E. #3354, hereby certify that grading at this site is constructed in substantial compliance with this plan, to allow the implementation of the drainage patterns and requirements identified herein. Side yard garden walls will be constructed concurrently with individual home construction, which will implement required side yard swales. As-built grade elevations were verified by field surveys performed by Adrich Surveying during July, 1993, after completion of construction. This statement does not represent certification of contractor's construction methods or materials.
Note: Record, or "as-built" elevations, are shown at selected locations across the site. Record information is identified by a double underline.

James R. Topmiller
9/12/93









REMOVE EXISTING CURB & GUTTER - INSTALL NEW CURB & GUTTER (VALLEY) PER CDA STD. DETAIL (PUBLIC WORK ORDER)

CONSTRUCT NEW LEFT TURN LANE (PUBLIC WORK ORDER)
EXISTING SIDEWALK
EXISTING PAVEMENT
EXISTING MEDIAN

GRADING CERTIFICATION
Perimeter Lots are Graded to Match Existing Grades at Subdivision Boundary

GRADING CERTIFICATION
Phase I pond has been removed under Phase III grading operations. See approved Phase III plan.

32" MID CURB OPENING TO BE SAME WIDTH AS ROADWAY - IN STALL 2 BOLLARDS FOR RUNDOWN SEE DETAIL THIS SHEET.

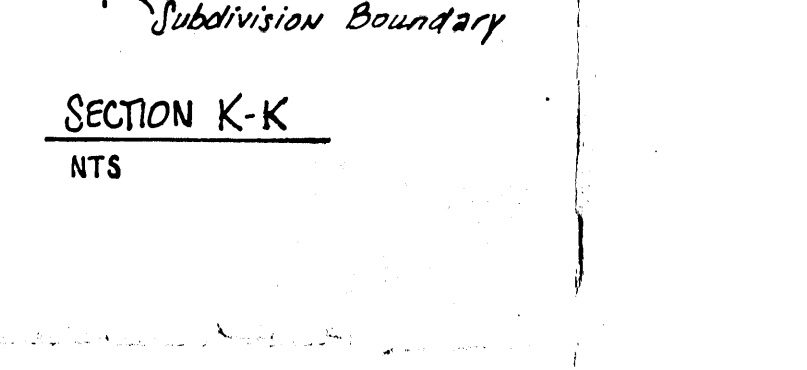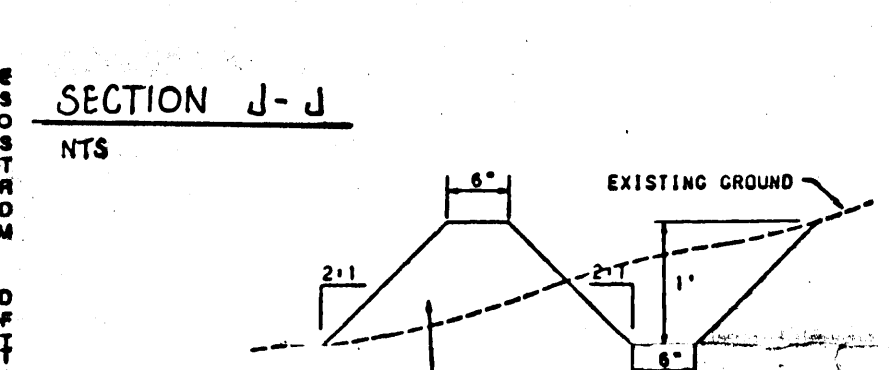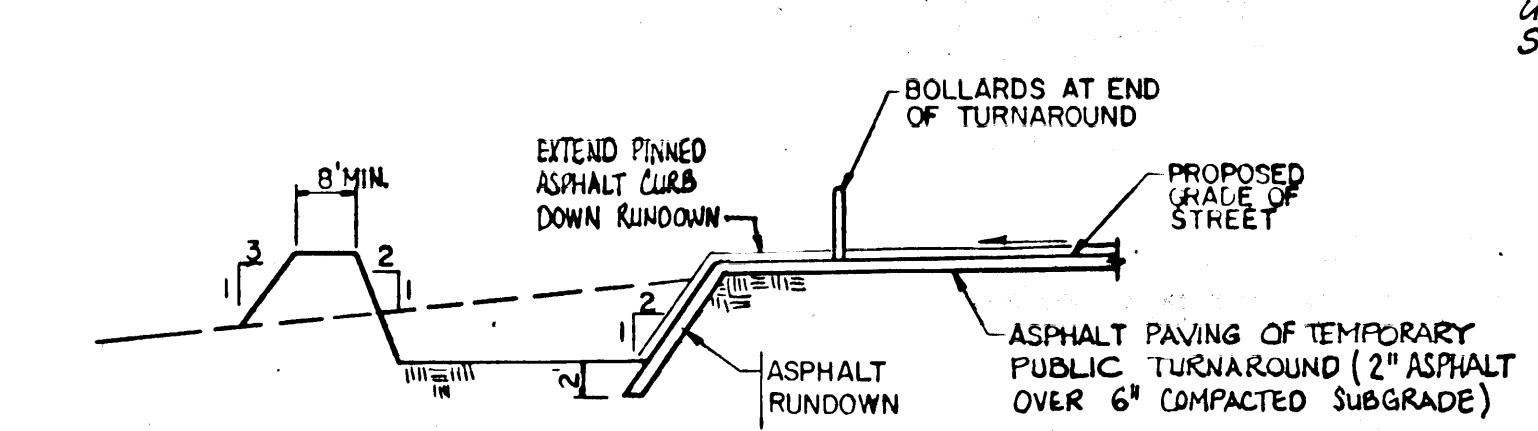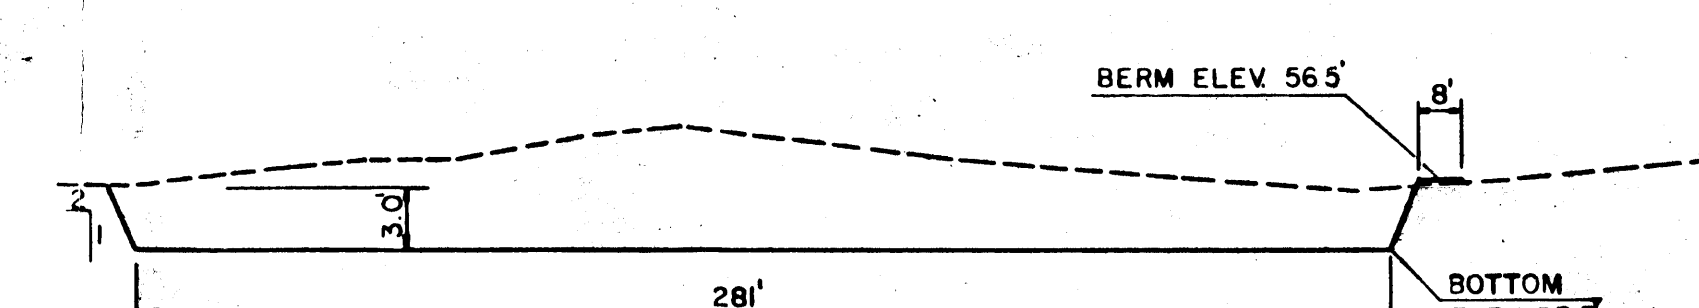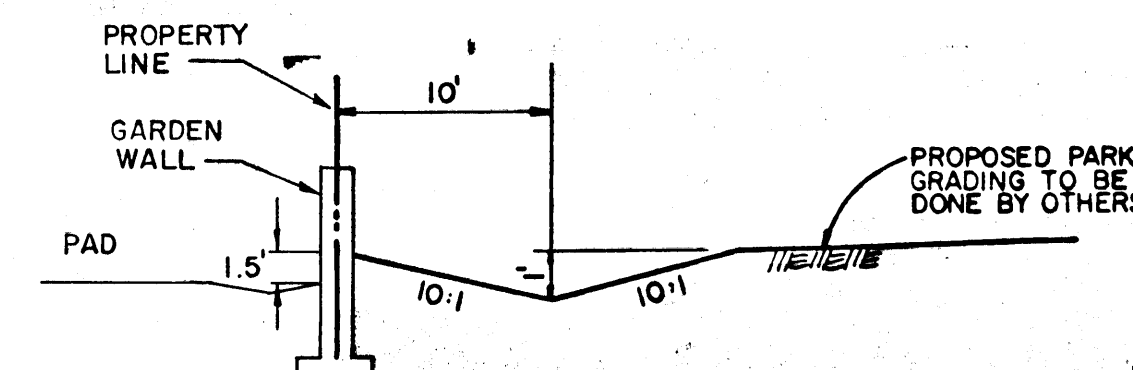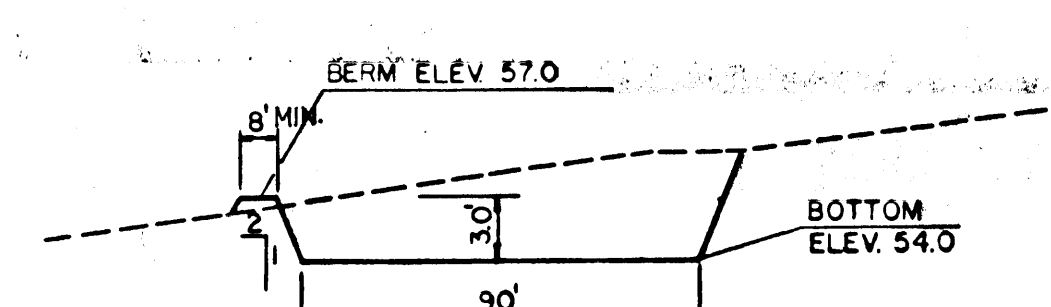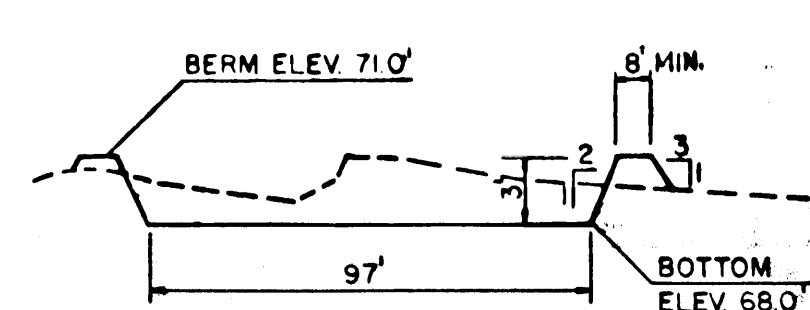
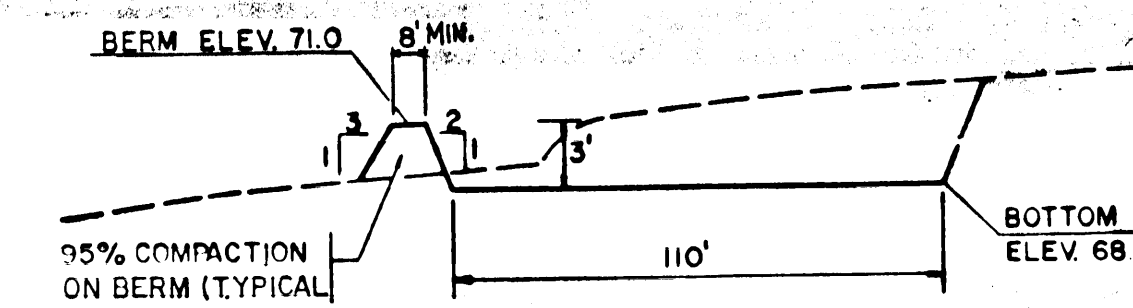


- GENERAL NOTES:**
- RETAINING WALL FOOTINGS SHOULD BE CHASED A MINIMUM OF EIGHTEEN INCHES BELOW LOWER ADJACENT GRADE PRIOR TO PLACING FOOTINGS. THE EXPOSED EIGHT INCHES IN MOISTURE CONDITION TO A NEAR SURFACE SHALL BE COVERED WITH A MINIMUM OF 12" OF MAXIMUM DENSITY AS DETERMINED BY ASTM D-1557.
 - RETAINING WALL SHALL NOT BE BACKFILLED UNTIL AT LEAST 7 DAYS AFTER PLACING OF FOOTINGS. BACKFILLING SHALL BE DONE IN BACKFILLS, SUCH EQUIPMENT SHOULD NOT APPROACH CLOSER TO THE TOP OF THE WALL THAN A DISTANCE EQUAL TO THE HEIGHT OF THE WALL. CARE SHOULD BE TAKEN TO AVOID EXERTING IMPACT FORCES ON THE WALL AS COULD BE CAUSED BY A LARGE MASS OF MOVING EARTH.
 - SLOPES UP AWAY FROM WALLS SHOULD NOT EXCEED 3:1.
 - VERTICAL CONTROL JOINTS WITH PVC INSERTS SHALL BE PLACED AT INTERVALS NOT TO EXCEED 20' FOR CONTROL JOINTS WHEN SUBMITTED AT 12' INTERVALS. DISCONTINUE JOINTS AT 12' INTERVALS.
 - MINIMUM LAP SPACE ON REMOVING BARS SHALL BE 30" BARS DIAMETERS OR 1/4" MINIMUM. REINFORCEMENT OF A BARS AND PUBLIC EXISTING OTHER THAN THAT GIVEN IN THE TABLES MAY BE USED. PROVIDING SUCH OTHER REINFORCEMENT FURNISHES AN AREA OF STEEL AT LEAST EQUAL TO THAT GIVEN IN THE TABLE.
 - CONSTRUCTION OF RETAINING WALLS SHALL CONFORM TO REQUIREMENTS OF THE UNIFORM BUILDING CODE SECTION 24, CONCRETE CONSTRUCTION.
 - OMISSION OF A VERTICAL MORTAR JOINT ON FIRST COURSE AT 4' O.C. MAY BE SUBSTITUTED FOR PVC WEAP HOLE.
 - DESIGN DATA:
BLOCK WEIGHT 12" x 16" = 120 LBS
BLOCK WEIGHT 12" x 8" = 60 LBS
SOIL BEARING PRESSURE - 35 PSF
SOIL BEARING PRESSURE - 1000 PSF
1/2" INCREASE FOR WINDSEISMIC
COEFFICIENT OF FRICTION = 0.8
PASSIVE SOIL PRESSURE = 200 PSF
CONCRETE (6" DIA.) = 3000 PSF
GROUT STRENGTH = 2000 PSF
GROUT GRADE = 150 PSF (GROUTED) REINFORCEMENT - 6" DIA. #4 @ 48"
 - CONTRACTOR SHALL NOTIFY ENGINEER PRIOR TO CONCRETE FOOTING POUR FOR INSPECTION OF COMPACTION UNDER FOOTING, FOOTING DEPTH AND WIDTH AND WALL STEEL AND SPACING. FINAL INSPECTION OF FOOTING AND WALL WILL BE REQUIRED.
 - CONTRACTOR SHALL BE RESPONSIBLE FOR CODE ADMINISTRATION APPROVAL AND FEES ASSOCIATED WITH IT.

EROSION CONTROL PLAN
NO SCALE

- EROSION CONTROL MEASURES:**
- THE CONTRACTOR SHALL ENSURE THAT NO SOIL ERODES FROM THE SITE INTO PUBLIC RIGHT OF WAY OR ONTO ADJACENT PRIVATE PROPERTY. THIS CAN BE ACHIEVED BY CONSTRUCTING TEMPORARY BARRIERS AT THE PROPERTY LINE AND MAINTAINING THE SOIL TO KEEP IT FROM MOVING.
 - THE CONTRACTOR SHALL BE RESPONSIBLE FOR MAINTAINING THE EXCAVATED MATERIAL IS NOT SUSCEPTIBLE TO BEING WASHED DOWN THE STREET.
 - THE CONTRACTOR SHALL SECURE TOPSOIL DISTANCE PERMIT PRIOR TO BEGINNING CONSTRUCTION. THE COST OF REQUIRED EROSION CONTROL MEASURES SHALL BE CONSIDERED INCIDENTAL TO THE PROJECT COST.
 - SEE SHEET 2 OF 3 FOR ADDITIONAL NOTES AND REQUIREMENTS.

NOTE: EXCESS FILL SHALL BE PLACED IN THE LOCATION SHOWN ON SHEET 1 OF 3

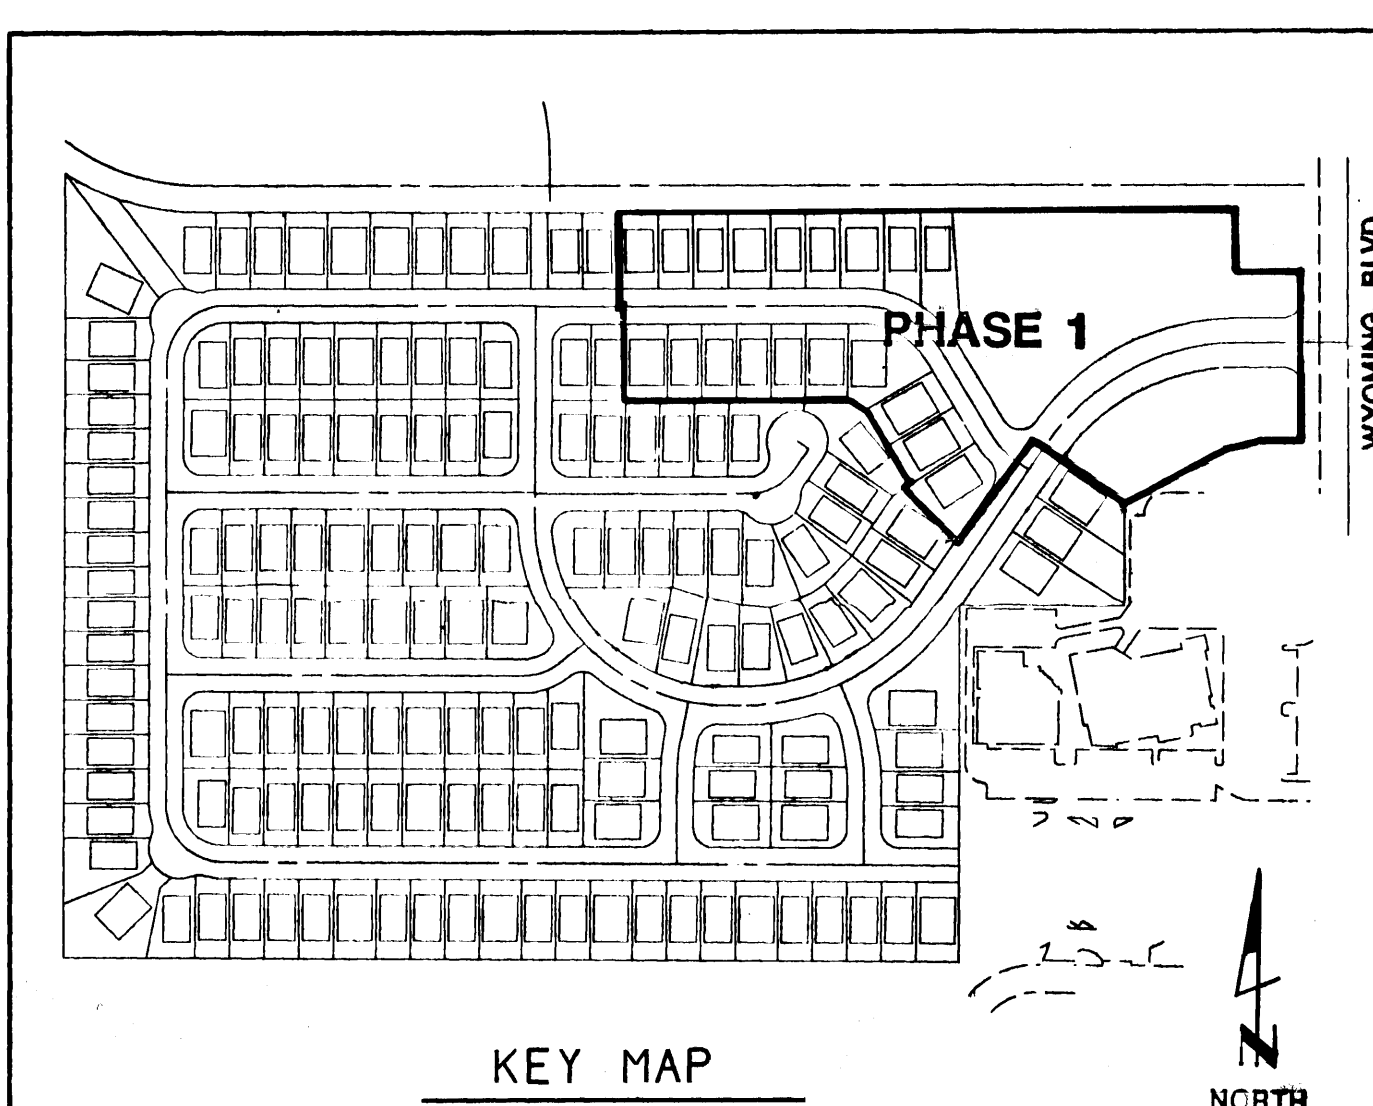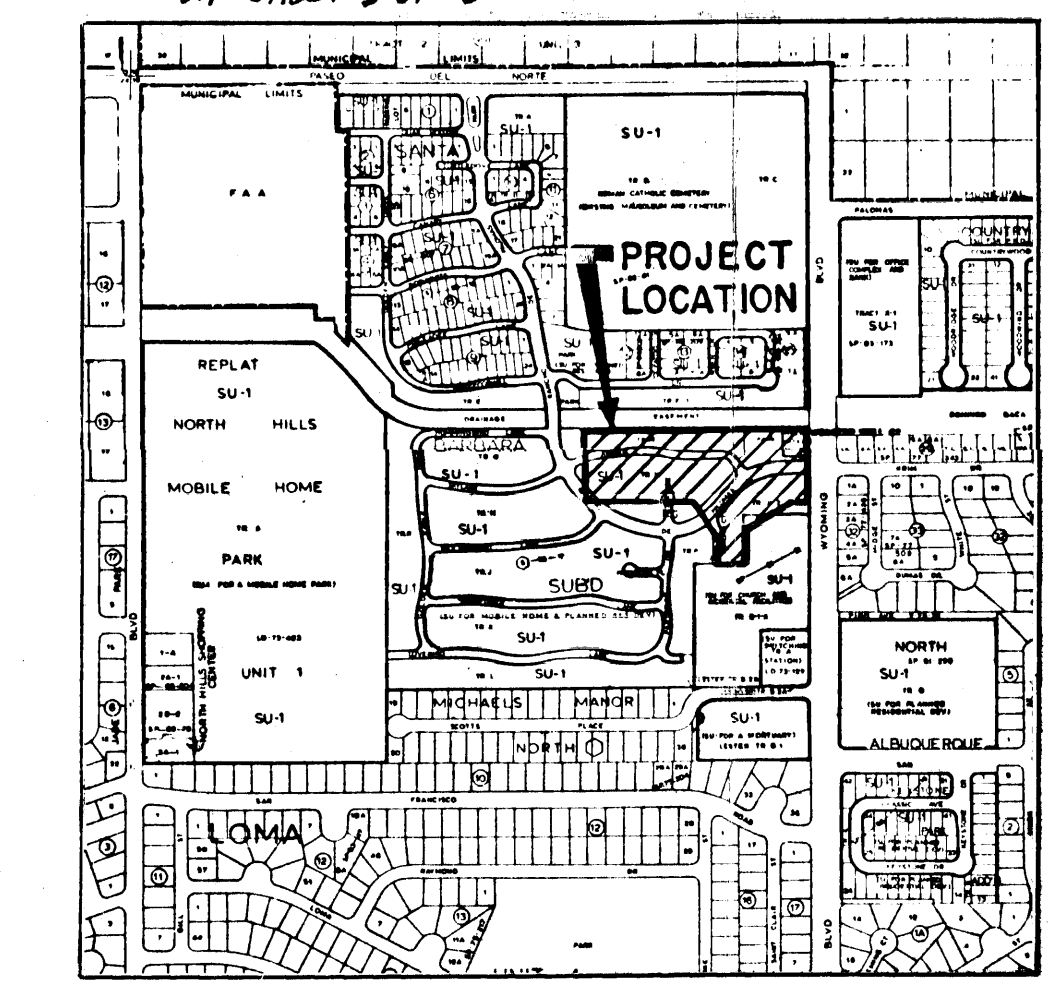

PALOMAS PARK SUBDIVISION

Project No. 91181.04

DRAINAGE/GRADING PLAN (DEVELOPED CONDITIONS)

PHASE 1

Job No. 91181.04

Sheet 3 of 3

Drawn By: 5/92

Checked By: 5/92

Scale: 1" = 50'

APPROVED FOR ROUGH GRADING (± 1.0')

James R. Topmiller

HYDROLOGY ENGINEER

DATE: 6-24-92

NOTE: Storm Drainage System is Public.
Final location and design of storm drains and inlets to be coordinated through construction plan review @ DRC.

SANTA BARBARA SUBDIVISION

GRADING CERTIFICATION





Perimeter Lots are Graded to Match Existing Grades at Subdivision Boundary. See Record Elevations on PLAN.

"HEAVEN 1969"
USC & GS Base Map
N.M. State Plane Coordinates (Central Zone)
X = 407,051.31 Y = 1,518,737.03
Ground-to-Grid Factor = 0.9995263
Elev. = 5376.787

GRADING CERTIFICATION

I, James R. Tognoli, P.E. #9354, hereby certify that grading at this site is constructed in substantial compliance with this plan, to allow the implementation of the drainage patterns and requirements identified herein. Side yard garden walls will be constructed concurrently with individual home construction, which will implement required side yard easements. As-built grade elevations were verified by field surveys performed by Aldrich Surveying during July, 1993, after completion of construction. This statement does not represent certification of contractor's construction methods or materials.

Note: Record, or "as-built" elevations, are shown at selected locations across the site. Record information is identified by a double underline.

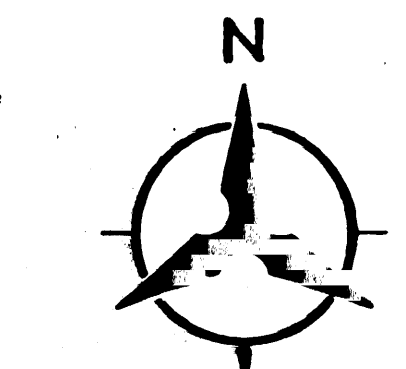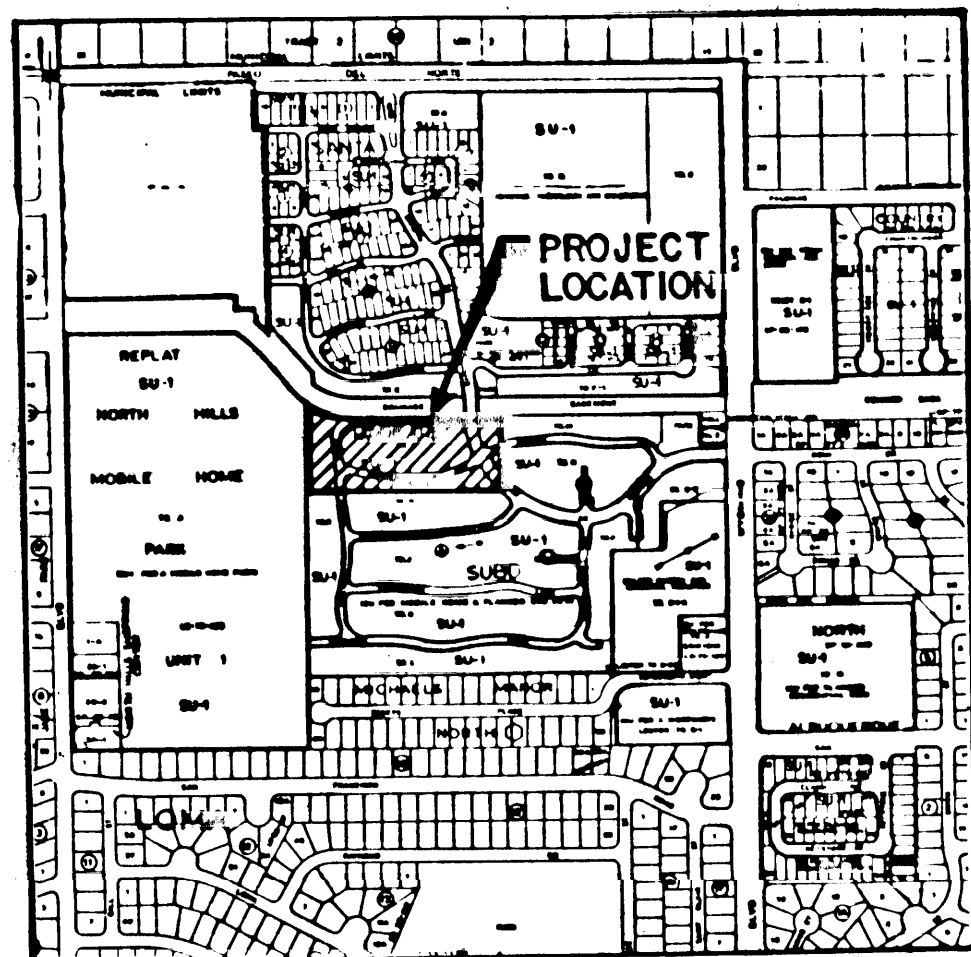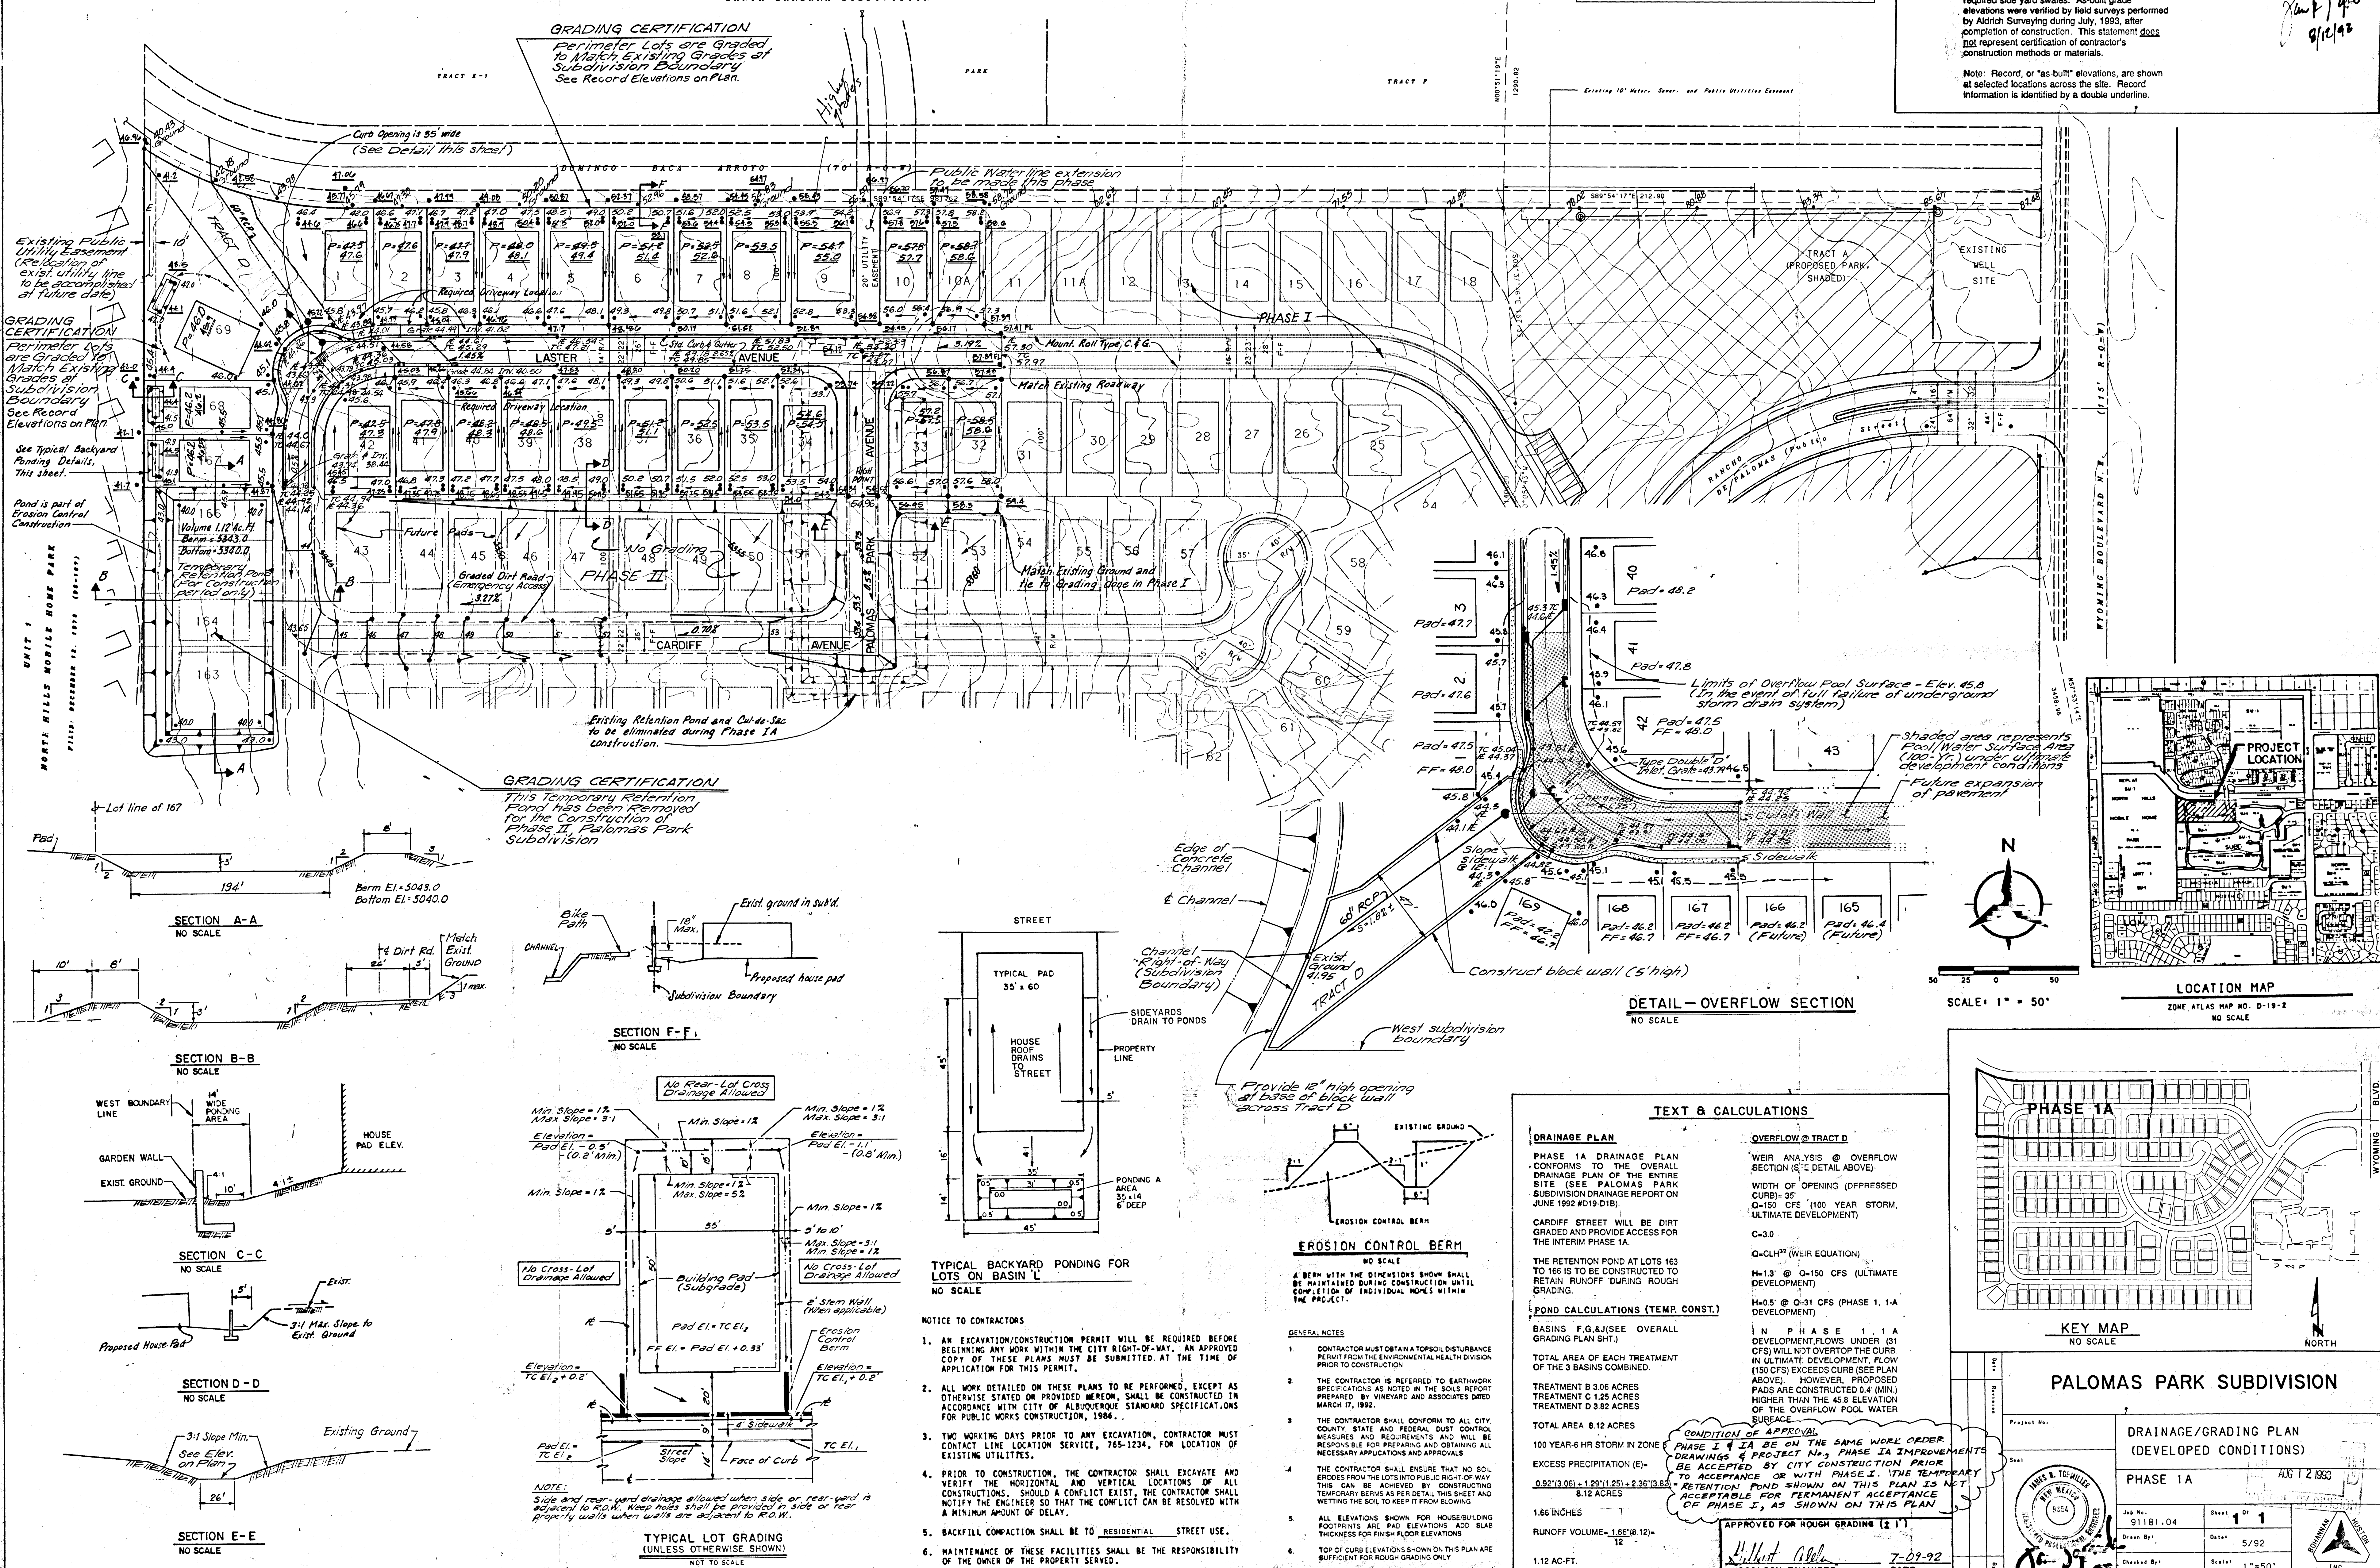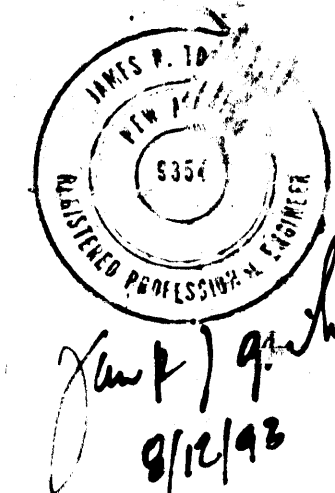

DETAIL - OVERFLOW SECTION

NO SCALE

TEXT & CALCULATIONS

DRAINAGE PLAN

PHASE 1A DRAINAGE PLAN CONFORMS TO THE OVERALL DRAINAGE PLAN OF THE ENTIRE SITE (SEE PALOMAS PARK SUBDIVISION DRAINAGE REPORT ON JUNE 1992 #D19-D18).

CARDIFF STREET WILL BE DIRT GRADED AND PROVIDE ACCESS FOR THE INTERIM PHASE 1A.

THE RETENTION POND AT LOTS 163 TO 165 IS TO BE CONSTRUCTED TO RETAIN RUNOFF DURING ROUGH GRADING.

POND CALCULATIONS (TEMP. CONST.)

BASINS F.G.A.H.S.EE OVERALL GRADING PLAN SHIT.

TOTAL AREA OF EACH TREATMENT OF THE 3 BASINS COMBINED.

TREATMENT B 3.06 ACRES

TREATMENT C 1.25 ACRES

TREATMENT D 3.82 ACRES

TOTAL AREA 8.12 ACRES

100 YEAR-6 HR STORM IN ZONE EXCESS PRECIPITATION (E) = 0.82(3.06) + 1.25(1.25) + 2.35(3.82) = 8.12 ACRES

1.66 INCHES

RUNOFF VOLUME = 1.66(8.12) = 13.5 AC-F.T.

1.12 AC-F.T.

OVERFLOW @ TRACT D

WEIR ANALYSIS @ OVERFLOW SECTION (SEE DETAIL ABOVE):

WIDTH OF OPENING (DEPRESSED CURB) = 35'

Q = 150 CFS (100 YEAR STORM, ULTIMATE DEVELOPMENT)

C = 3.0

Q = CLH^{3/2} (WEIR EQUATION)

H = 1.3' @ 0.150 CFS (ULTIMATE DEVELOPMENT)

H = 0.5' @ 0.31 CFS (PHASE 1, 1-A DEVELOPMENT)

EROSION CONTROL BERM

A BERM WITH THE DIMENSIONS SHOWN SHALL BE MAINTAINED DURING CONSTRUCTION UNTIL COMPLETION OF INDIVIDUAL HOMES WITHIN THE PROJECT.

GENERAL NOTES

- CONTRACTOR MUST OBTAIN A TOPSOIL DISTURBANCE PERMIT FROM THE ENVIRONMENTAL HEALTH DIVISION PRIOR TO CONSTRUCTION.
- THE CONTRACTOR IS REFERRED TO EARTHWORK SPECIFICATIONS AS NOTED IN THE SOILS REPORT PREPARED BY VINETARD AND ASSOCIATES DATED MARCH 17, 1992.
- THE CONTRACTOR SHALL CONFORM TO ALL CITY, COUNTY, STATE AND FEDERAL DUST CONTROL MEASURES AND REQUIREMENTS AND WILL BE RESPONSIBLE FOR PREPARING AND OBTAINING ALL NECESSARY APPLICATIONS AND APPROVALS.
- THE CONTRACTOR SHALL ENSURE THAT NO SOIL ERODES FROM THE LOTS INTO PUBLIC RIGHT OF WAY. THIS CAN BE ACHIEVED BY CONSTRUCTING TEMPORARY BERMS AS PER DETAIL THIS SHEET AND WETTING THE SOIL TO KEEP IT FROM BLOWING.
- ALL ELEVATIONS SHOWN FOR HOUSE BUILDING FOOTPRINTS ARE PAD ELEVATIONS. ADD SLAB THICKNESS FOR FINISH FLOOR ELEVATIONS.
- TOP OF CURB ELEVATIONS SHOWN ON THIS PLAN ARE SUFFICIENT FOR ROUGH GRADING ONLY.

TYPICAL BACKYARD PONDING FOR LOTS ON BASIN L


NO SCALE

NOTICE TO CONTRACTORS

- AN EXCAVATION/CONSTRUCTION PERMIT WILL BE REQUIRED BEFORE BEGINNING ANY WORK WITHIN THE CITY RIGHT-OF-WAY. AN APPROVED COPY OF THESE PLANS MUST BE SUBMITTED AT THE TIME OF APPLICATION FOR THIS PERMIT.
- ALL WORK DETAILED ON THESE PLANS TO BE PERFORMED, EXCEPT AS OTHERWISE STATED OR PROVIDED HEREON, SHALL BE CONSTRUCTED IN ACCORDANCE WITH CITY OF ALBUQUERQUE STANDARD SPECIFICATIONS FOR PUBLIC WORKS CONSTRUCTION, 1984.
- TWO WORKING DAYS PRIOR TO ANY EXCAVATION, CONTRACTOR MUST CONTACT LINE LOCATION SERVICE, 765-1234, FOR LOCATION OF EXISTING UTILITIES.
- PRIOR TO CONSTRUCTION, THE CONTRACTOR SHALL EXCAVATE AND VERIFY THE HORIZONTAL AND VERTICAL LOCATIONS OF ALL CONSTRUCTIONS. SHOULD A CONFLICT EXIST, THE CONTRACTOR SHALL NOTIFY THE ENGINEER SO THAT THE CONFLICT CAN BE RESOLVED WITH A MINIMUM AMOUNT OF DELAY.
- BACKFILL COMPACTION SHALL BE TO RESIDENTIAL STREET USE.
- MAINTENANCE OF THESE FACILITIES SHALL BE THE RESPONSIBILITY OF THE OWNER OF THE PROPERTY SERVED.


TYPICAL LOT GRADING (UNLESS OTHERWISE SHOWN)

NOT TO SCALE

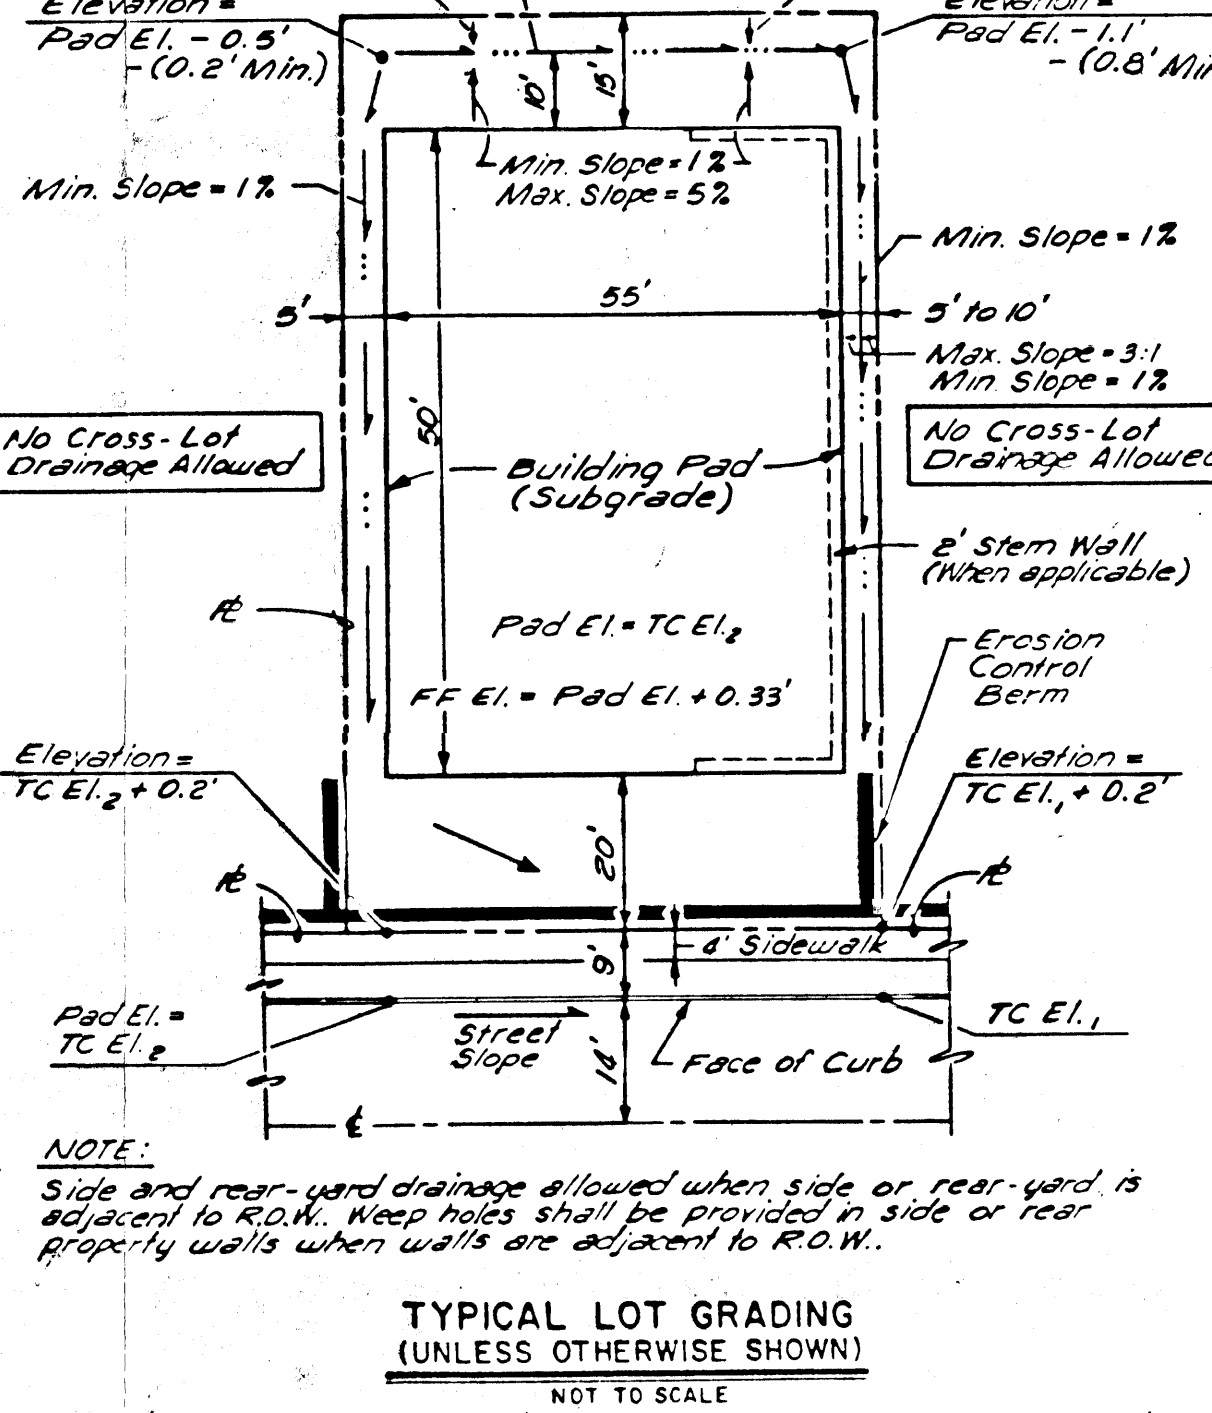

KEY MAP

NO SCALE

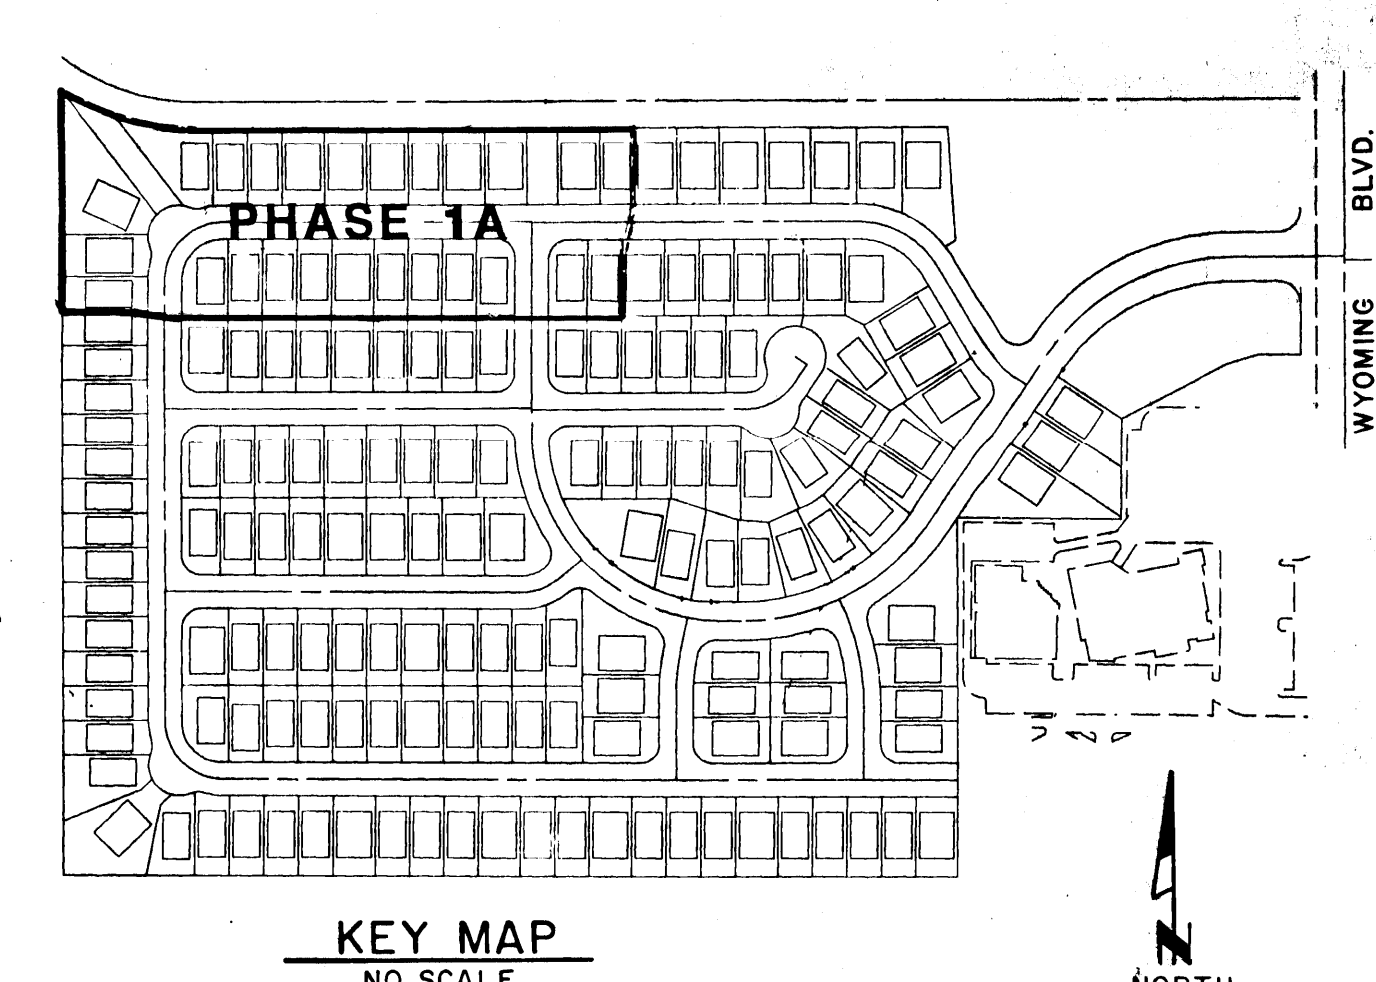

PALOMAS PARK SUBDIVISION

NO SCALE

Project No. _____

Job No. 91181.04

Drawn By: _____

Checked By: _____

Scale: 1" = 50'

DATE: 7-09-92

HYDROLOGIST ENGINEER

APPROVED FOR ROUGH GRADING (2")

8/12/93