

AS-BUILT CALCULATIONS - BASIN "B"

Pond Volume (Maximum Water Surface Elevation @ 94.0)

Elev	Area (sf)	Volume (cf)	Σ Volume (cf)
92.89	0		
93.0	42	2	2
94.0	2500	1271	1273

Pond design has a volume of 3620 cf. As-built volume is approximately 35% of the design volume.

Maximum Pipe Discharge

Orifice Restriction

$$Q = CA(2gh)^{0.5}$$
$$C = 0.6$$
$$A = 0.09 \text{ sf}$$
$$g = 32.2 \text{ ft/sec}^2$$
$$h = 94 - 92.89 - 0.17 = 0.94 \text{ ft}$$

Therefore: $Q = 0.4 \text{ cfs}$ Pipe Discharge Capacity - Gravity Flow
Using Feild's Hydraulic Calculator for Gravity Flow in Pipes


$$\text{Let: } S = 0.0145$$
$$n = 0.013$$
$$d = 4"$$

Therefore: $Q = 0.2 \text{ cfs}$ Pipe Discharge Capacity - Pressure Flow
Using Haestad Methods Computer Model

$$\text{Let: Pressure} = 0.4 \text{ psi}$$
$$S = 0.0145$$
$$C = 130$$
$$d = 4"$$

Therefore: $Q = 0.7 \text{ cfs}$ Average Discharge from the Pond is $Q = 0.3 \text{ cfs}$

AS-BUILT HYDROGRAPH

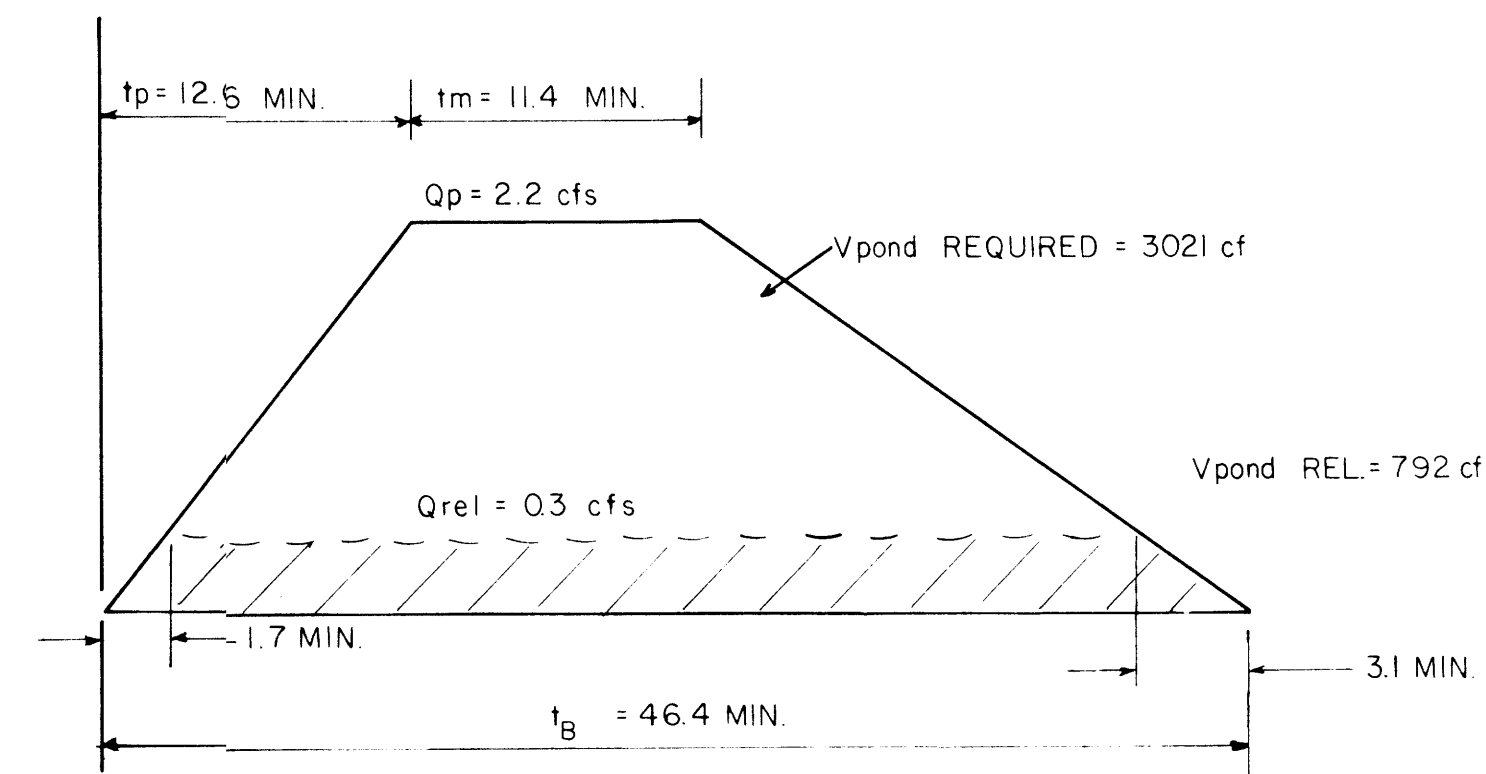

$$t_B = 2.107 * E * A_T / Q_p - 0.25 (A_D / A_T)$$
$$E = 2.01 \text{ in}$$
$$A_T = 0.50 \text{ ac}$$
$$Q_p = 2.2 \text{ cfs}$$
$$A_D = 0.38 \text{ ac}$$

Therefore: $t_B = 46.4 \text{ min.}$

$$t_p = 0.7 * t_c + (1.6 - A_D / A_T) / 12$$
$$t_c = 0.2 \text{ hr (per D.P.M.)}$$
$$A_D = 0.38 \text{ ac}$$
$$A_T = 0.50 \text{ ac}$$

Therefore: $t_p = 12.6 \text{ min}$

$$t_m = 0.25 A_D / A_T$$
$$A_D = 0.38 \text{ ac}$$
$$A_T = 0.50 \text{ ac}$$

Therefore: $t_m = 11.4 \text{ min}$

$$V_{\text{pond required (As-Built)}} = 3021 \text{ cf}$$
$$V_{\text{pond As-Built}} = 1273 \text{ cf}$$
$$V_{\text{pond needed}} = 1748 \text{ cf}$$

Maximum water surface level needs to be at 94.50 for ponding volume. Therefore, two additional courses of CMU blocks need to be constructed on the western garden wall and the berm needs to be raised to 95.00 to have 0.5 foot freeboard on the pond.

NOTE:

IN LIEU OF RECONSTRUCTING THE POND PER THE APPROVED PLAN, THE ELEVATION OF PONDED RUNOFF WAS RAISED IN ORDER TO PROVIDE THE VOLUME OF PONDING REQUIRED BY THE APPROVED DESIGN. THESE MODIFICATIONS ARE REFLECTED ON THE AS-CONSTRUCTED PLAN WHICH APPEARS ON THE PRECEDING SHEET.



JUL 22 1994



JEFF MORTENSEN & ASSOCIATES, INC.
6010-B MIDWAY PARK BLVD. N.E.
ALBUQUERQUE, NEW MEXICO 87109
ENGINEERS & SURVEYORS (505) 445-4250

DRAINAGE CERTIFICATION
BRIGHT BEGINNINGS - WYOMING

DESIGNED BY G.R.B.
DRAWN BY C.J.H.
APPROVED BY J.G.M.

NO.	DATE	BY	REVISIONS

JOB NO.	930458
DATE	05/1994
SHEET	1A OF 1