

VICINITY MAP  
SCALE: 1" = 750' (APPROX.)

### PROJECT BENCHMARK

CITY OF ALBUQUERQUE BENCHMARK "HEAVEN" A STAMPED USC AND GS BRASS TABLET STAMPED "HEAVEN 1969", SET IN TOP OF A CONCRETE POST FLUSH WITH THE GROUND LOCATED AT THE ENTRANCE WAY TO THE "GATE OF HEAVEN" CEMETERY 0.5 MILE WEST OF THE INTERSECTION OF PASSED DEL NORTE N.E. AND WYOMING BOULEVARD N.E. ON THE SOUTH SIDE OF PASSED DEL NORTE. ELEVATION = 5378.78 FEET (M.S.L.D.)

### T.B.M.

SANITARY SEWER MANHOLE RIM AT THE INTERSECTION OF WILSHIRE AVE. N.E. AND WYOMING BOULEVARD N.E. AS SHOWN IN THE DRAWING BELOW.  
ELEVATION = 5390.48 FEET (M.S.L.D.)

### LEGAL DESCRIPTION

LOT 5A, BLOCK 16, TRACT 2, UNIT 3,  
NORTH ALBUQUERQUE ACRES

### LEGEND

— 5390.0 — EXISTING CONTOUR  
— 02 — PROPOSED CONTOUR  
— 91.5 — PROPOSED SPOT ELEVATION  
— — PROPOSED DIRECTION OF FLOW  
— — PROPOSED BASIN BOUNDARY LINE  
— — EXISTING 100-YEAR FLOODPLAIN LINE

ALL SURVEY INFORMATION SHOWN HEREON OBTAINED FROM A SURVEY PERFORMED BY TOM VAGNER, N.M.P.S. 3517 ON 04/14/1993. THIS IS NOT A BOUNDARY SURVEY. APPARENT PROPERTY CORNERS ARE SHOWN FOR ORIENTATION ONLY. BOUNDARY DATA SHOWN IS FROM PREVIOUS SURVEY REFERENCED ABOVE.

The following items concerning the Covenant United Methodist Church Grading and Drainage Plan are contained hereon:

1. Vicinity Map
2. Grading Plan
3. Calculations

As shown by the Vicinity Map, the site is located at the southeast corner of the intersection of Wyoming Boulevard N.E. and Wilshire Avenue N.E. At present, the site is developed as a church. Under the proposed scheme of development, building additions, additional paved parking and landscaping will be constructed.

As shown by Panel 10 of 50 of the National Flood Insurance Program Flood Insurance Rate Maps (FIRM) for the City of Albuquerque, New Mexico, dated 10/14/83, a designated flood hazard zone lies within the site. The only improvements which lie within that flood zone are existing paving and landscaping. No building improvements are proposed within that flood zone. The approximate limits of the flood zone have been superimposed on the grading plan as scaled from the FIRM panel.

The Grading Plan shows 1) existing and proposed grades indicated by spot elevations and contours at one foot intervals, 2) the limit and character of the existing improvements, 3) the limit and character of the proposed improvements, and 4) the limit and character of Wilshire Avenue infrastructure improvements, 5) the limit and character of future improvements to Wyoming Boulevard N.E. and 6) continuity between existing and proposed grades. As shown by this plan, the proposed improvements consist of the construction of building additions and site improvements which will be accomplished in a phased manner. At this time, that portion of Wilshire Avenue N.E. which lies adjacent to the site will be paved. As an interim improvement, an asphalt rundown will channel the runoff to an interim retention pond. No 100-year emergency spillway has been designated for the right-of-way pond since this would result in channelization of runoff and damage to downstream properties. The interim retention pond will contain public runoff and will lie within public right-of-way. At such time as the Wyoming Boulevard N.E. improvements can be constructed, the interim pond will be eliminated and public storm drain improvements will be constructed. The retention ponds cannot be eliminated until the Wyoming Boulevard N.E. improvements are in place. The ability to construct these improvements is directly dependent upon the construction of the AMAFCA/Louisiana Dam and the extension of public storm drain improvements from the Dam within the North Arroyo de Domingo Baca Corridor to the crossing at Wyoming Boulevard N.E. Consequently, the public improvements will be constructed in two phases. The first phase will consist of the construction of the Wilshire Avenue N.E. paving along the property frontage. The second phase, which is deferred construction, will include the Wilshire Avenue N.E. improvements, the removal of the asphalt channel, and the addition of storm drain which will connect to the Wyoming Boulevard construction. In addition, retention ponding will be provided onsite to accommodate twice the increase in 100-year developed runoff generated by all phases of this project. The existing runoff will be allowed to flow historically, hence only the increase in developed runoff will be ponded. This will be implemented so as not to create an adverse impact on downstream properties. The emergency spillway for the onsite ponds is the driveway located on the west side of the site. It is designated "point of overflow" on the grading and drainage plan.

The Calculations which appear hereon analyze the existing and developed conditions for the 100-year, 6-hour rainfall event. Calculations have been performed in accordance with the Procedure for 40-acre and Smaller Basins set forth in the Revision of Section 22.2, Hydrology of the Development Process Manual, Volume II, Design Criteria, dated August, 1991. As shown by these calculations, the proposed project will result in an increase in developed runoff from this site. The increase in runoff will be offset, however, by the use of interim retention ponding. Retention ponds can be eliminated at such time as the Louisiana Dam and North Arroyo de Domingo Baca improvements, downstream from this site, are in place.

The residential area to the east is separated from this site by a wall and hence will not contribute offsite flows. The flood zone which runs through the site does introduce offsite flows. These offsite flows will be accepted and conveyed through the site.

### CALCULATIONS

#### Site Characteristics

1. Precipitation Zone 3
2.  $P_{6,100} = P_{360} = 2.60$
3. Total Area ( $A_T$ ) 4.01 Acres
4. Existing Land Treatment

Treatment	Area (sf/ac)	
a. Basin A	102,940/2.36	100
A	102,940/2.36	100
b. Basin B	71,810/1.65	100
A	38,780/0.89	54
D	33,030/0.76	46

Treatment	Area (sf/ac)	
a. Basin A	102,940/2.36	100
A	102,940/2.36	100
b. Basin B	71,810/1.65	100
A	22,400/0.52	31
D	49,410/1.13	69

#### Existing Condition

- a. Basin A  
1. Volume  
 $E_w = (E_A A_A + E_B A_B + E_C A_C + E_D A_D) / A_T$   
 $E_w = (0.66)(2.36) / 2.36 = 0.66$  in.  
 $V_{100} = (E_w / 12) A_T$   
 $V_{100} = (0.66 / 12)(2.36) = 0.1298$  ac.ft.; 5650 cf  
2. Peak Discharge  
 $Q_p = Q_{PA} A_A + Q_{PB} A_B + Q_{PC} A_C + Q_{PD} A_D$   
 $Q_p = Q_{100} = (1.87)(2.36) = 4.41$  cfs
- b. Basin B  
1. Volume  
 $E_w = (E_A A_A + E_B A_B + E_C A_C + E_D A_D) / A_T$   
 $E_w = [(0.66)(0.89) + (2.36)(0.76)] / (1.65) = 1.44$  in.  
 $V_{100} = (E_w / 12) A_T$   
 $V_{100} = (1.44 / 12)(1.65) = 0.1984$  ac.ft.; 8,640 cf  
 $V_{10 \text{ Day}} = V_{100} + A_d (P_{10 \text{ Day}} - P_{360}) / 12$  in/ft.  
 $V_{10 \text{ Day}} = 0.1984 + 0.1457 = 0.3441$  ac.ft.; 14,990 cf  
2. Peak Discharge  
 $Q_p = Q_{PA} A_A + Q_{PB} A_B + Q_{PC} A_C + Q_{PD} A_D$   
 $Q_p = Q_{100} = (1.87)(0.89) + (5.02)(0.76) = 5.5$  cfs

#### Developed Condition

- a. Basin A  
1. Volume  
No Change  
2. Peak Discharge  
No Change
- b. Basin B  
1. Volume  
 $E_w = (E_A A_A + E_B A_B + E_C A_C + E_D A_D) / A_T$   
 $E_w = [(0.92)(0.52) + (2.36)(1.13)] / (1.65) = 1.91$  in.  
 $V_{100} = (E_w / 12) A_T$   
 $V_{100} = (1.91 / 12)(1.65) = 0.2627$  ac.ft.; 11,440 cf  
 $V_{10 \text{ Day}} = V_{100} + A_d (P_{10 \text{ Day}} - P_{360}) / 12$  in/ft.  
 $V_{10 \text{ Day}} = 0.2627 + 0.2166 = 0.4793$  ac.ft.; 20,880 cf  
2. Peak Discharge  
 $Q_p = Q_{PA} A_A + Q_{PB} A_B + Q_{PC} A_C + Q_{PD} A_D$   
 $Q_p = Q_{100} = (2.60)(0.52) + (5.02)(1.13) = 7.0$  cfs

#### Comparison

- a. Basin A  
No Change
- b. Basin B  
1.  $\Delta V_{100} = 11,440 - 8,640 = 2,800$  cf (increase)  
2.  $\Delta Q_{100} = 7.0 - 5.5 = 1.5$  cfs (increase)
- c. Wilshire Avenue  
1.  $\Delta V_{100} = 1100$  cf  
2.  $\Delta Q_{100} = 0.5$  cfs  
(From Watershed Design & Analysis)

#### Pond Volume Calculations

A. Onsite Ponds (North Pond)			
Elev (ft)	Area (sf)	Vol (cf)	E Vol (cf)
91.5	1660		
92.0	1910	892.5	892.5
93.0	2600	2255.0	3147.5

B. (South Pond)			
Elev (ft)	Area (sf)	Vol (cf)	E Vol (cf)
91.5	1635		
92.0	2080	928.75	928.75
93.0	2770	2425.0	3353.75

Total Volume Both Ponds @ WSL 5,393 = 6501.25 cf

2 X  $\Delta V_{100} = 2(2260) = 4520$  cf  
 $V_{\text{pond}} > 2 \times \Delta V_{100}$


B. Right-of-Way Ponding			
Elevation	Area	V	ΣV
90.5	840		
91.0	1360	550	550
92.0	2100	1730	2280

2 X  $\Delta V_{100} = 2(1100) = 2200$  cf  
 $V_{\text{pond}} > 2 \times \Delta V_{100}$

#### Future Condition (Basin A)

(Assume same style development as for Basin B)

- a. Basin A  
1. Volume  
 $E_w = (E_A A_A + E_B A_B + E_C A_C + E_D A_D) / A_T$   
 $E_w = [(0.92)(0.73) + (2.36)(1.63)] / 2.36 = 1.91$  in.  
 $V_{100} = (E_w / 12) A_T$   
 $V_{100} = (1.91 / 12)(2.36) = 0.3765$  ac.ft.; 16,402 cf  
 $V_{10 \text{ Day}} = V_{100} + A_d (P_{10 \text{ Day}} - P_{360}) / 12$  in/ft.  
 $V_{10 \text{ Day}} = 0.3765 + 1.63(4.90 - 2.60) / 12$   
 $V_{10 \text{ Day}} = 0.6889$  ac.ft.; 30,010 cf  
2. Peak Discharge  
 $Q_p = Q_{PA} A_A + Q_{PB} A_B + Q_{PC} A_C + Q_{PD} A_D$   
 $Q_p = Q_{100} = (2.60)(0.73) + (5.02)(1.63) = 10.1$  cfs


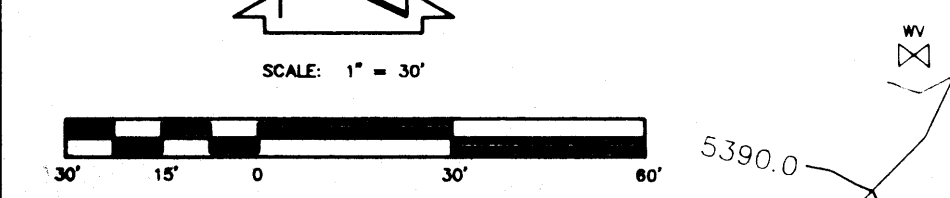


### CONSTRUCTION NOTES

1. Two (2) working days prior to any excavation, contractor must contact New Mexico City Service 266-1990, for location of existing utilities.
2. Prior to construction, the contractor shall excavate and verify the horizontal and vertical location of all potential obstructions. Should a conflict exist, the contractor shall notify the engineer in writing so that the conflict can be resolved with a minimum amount of delay.
3. All work on this project shall be performed in accordance with applicable federal, state and local laws, rules and regulations concerning construction safety and health.
4. All construction within public right-of-way shall be performed in accordance with applicable City of Albuquerque Standards and Procedures.
5. If any utility lines, pipelines, or underground utility lines are shown on these drawings, they are shown in an approximate manner only, and such lines may exist where none are shown. If any such existing lines are shown, the location is based upon information provided by the owner of said utility, and the information may be incomplete, or may be obsolete by the time construction commences. The engineer has conducted only preliminary investigation of the location, depth, size, or type of existing utility lines. This investigation is not conclusive, and may not be complete, therefore, makes no representation pertaining thereto, and assumes no responsibility or liability therefor. The contractor shall inform itself of the location of any utility line, pipeline, or underground utility line in or near the area of the work in advance of and during excavation work. The contractor is fully responsible for any and all damage caused by its failure to locate, identify and preserve any and all existing utilities, pipelines, and underground utility lines. In planning and conducting excavation, the contractor shall comply with state statutes, municipal and local ordinances, rules and regulations, if any, pertaining to the location of these lines and facilities.
6. The design of planters and landscaped areas is not part of this plan. All planters and landscaped areas adjacent to the building(s) shall be provided with positive drainage to avoid any ponding adjacent to the structure. For construction details, refer to landscaping plan.

### EROSION CONTROL MEASURES

1. The contractor shall ensure that no soil erodes from the site into public right-of-way or onto private property. This can be achieved by constructing temporary berms at the property lines and setting the soil to keep it from blowing.
2. The contractor shall promptly clean up any material excavated within the public right-of-way so that the excavated material is not susceptible to being washed down the street.
3. The contractor shall secure "Topsoil Disturbance Permit" prior to beginning construction.

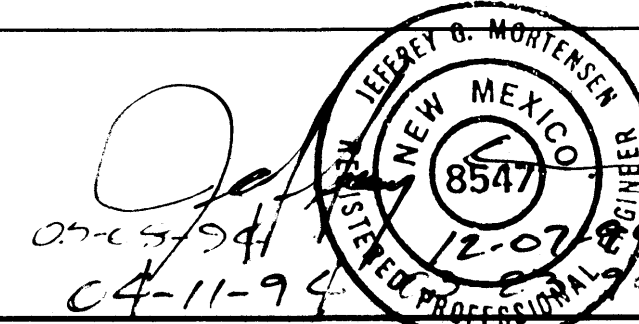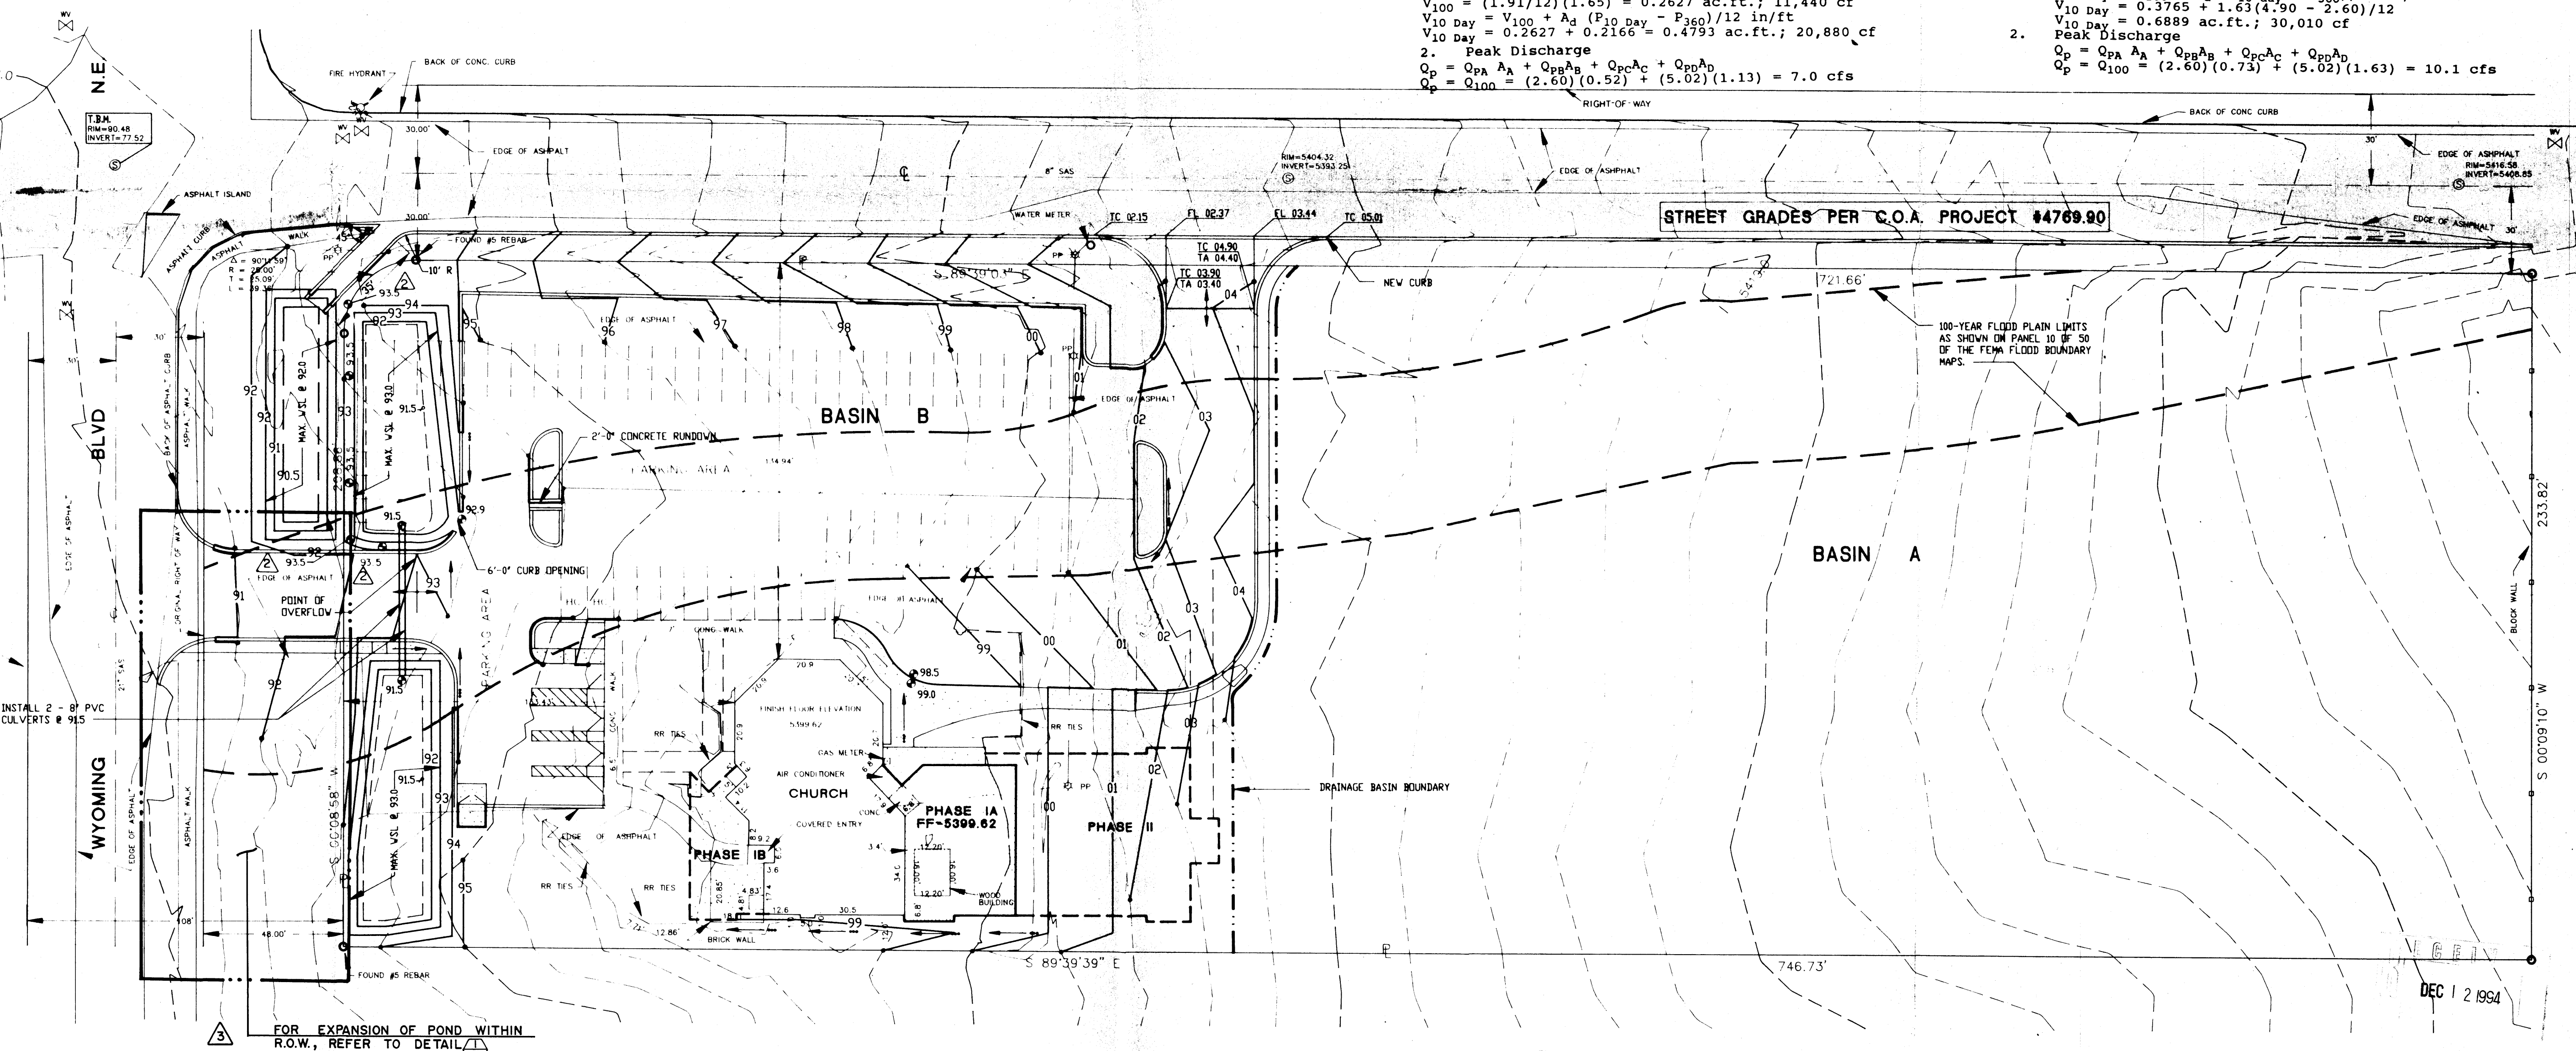

DESIGNED BY	DATE	BY	REVISIONS	JOB NO.
M.F.D.	4/94	M.F.D.	DRAINAGE PLAN PHASING, REVISE CALCS.	930682
ACAD	5/94	J.G.M.	BERM ELEVATION	DATE 03-1994
J.G.M.	11/94	J.G.M.	DETAIL (2)	SHEET 1 OF 2



## PROJECT BENCHMARK


CITY OF ALBUQUERQUE BENCHMARK "HEAVEN" A STAMPED  
LIST AND GS BRASS TABLE STAMPED "HEAVEN 1969"  
SET IN TOP OF A CONCRETE POST FLUSH WITH THE  
GROUND LOCATED AT THE ENTRANCE VAY TO THE "GATE  
OF HEAVEN" CEMETARY OLD MILE WEST OF  
INTERSECTION OF PASSED DEL NORTE NE. AND WYOMING  
BOULEVARD NE. ON THE SOUTH SIDE OF PASSED DEL NORTE  
ELEVATION = 5378.76 FEET (MSL.D.)

## T.B.M.

SANITARY SEWER MANHOLE RIM AT THE INTERSECTION OF  
WILSHIRE AVE. NE. AND WYOMING BOULEVARD NE. AS  
SHOWN ON THE DRAWING BELOW  
ELEVATION = 5390.48 FEET (MSL.D.)

## LEGAL DESCRIPTION

LOT 5A, BLOCK 16, TRACT 2, UNIT 3,  
NORTH ALBUQUERQUE, ACRES

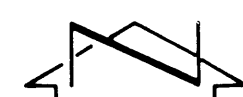

SCALE: 1" = 30'



## CONSTRUCTION NOTES:


- Two (2) working days prior to any excavation, contractor must contact New Mexico One Call Service 266-1990, for location of existing utilities.
- Prior to construction, the contractor shall excavate and verify the horizontal and vertical location of all potential obstructions. Should a conflict exist, the contractor shall notify the engineer in writing so that the conflict can be resolved with a minimum amount of delay.
- All work on this project shall be performed in accordance with applicable federal, state and local laws, rules and regulations concerning construction safety and health.
- All construction within public right-of-way shall be performed in accordance with applicable City of Albuquerque Standards and Procedures.
- If any utility lines, pipelines, or underground utility lines are shown on these drawings, they are shown in an approximate manner only, and such lines may exist where none are shown. If any such existing lines are shown, the location is based upon information provided by the owner of said utility, and the information may be incomplete or may be obsolete by the time construction commences. The engineer has conducted only preliminary investigation of the location, depth, size, or type of existing utility lines. This investigation is not conclusive, and may not be complete, therefore, makes no representation pertaining thereto, and assumes no responsibility or liability therefor. The contractor shall inform itself of the location of any utility line, pipeline, or underground utility line in or near the area of the work in advance of and during excavation work. The contractor is fully responsible for any and all damage caused by its failure to locate, identify and preserve any and all existing utilities, pipelines, and underground utility lines. In planning and conducting excavation, the contractor shall comply with state statutes, municipal and local ordinances, rules and regulations, if any, pertaining to the location of these lines and facilities.
- The design of planters and landscaped areas is not part of this plan. All planters and landscaped areas adjacent to the building(s) shall be provided with positive drainage to avoid any ponding adjacent to the structure. For construction details, refer to landscaping plan.

## EROSION CONTROL MEASURES

- The contractor shall ensure that no soil erodes from the site into public right-of-way or onto private property.
- The contractor shall promptly clean up any material excavated within the public right-of-way so that the excavated material is not susceptible to being washed down the street.
- The contractor shall secure "Topsoil Disturbance Permit" prior to beginning construction.
- Any areas of excess disturbance (traffic access, storage yard excavated material, etc.) shall be re-seeded according to C.O.A. Specification K012 Native Grass Seeding. This will be considered incidental to construction, therefore, no separate payment will be made.


## LEGEND

- 5390.0 — EXISTING CONTOUR  
02 — PROPOSED CONTOUR  
91.5 — PROPOSED SPOT ELEVATION  
— PROPOSED DIRECTION OF FLOW  
— PROPOSED BASIN BOUNDARY LINE  
— EXISTING 100-YEAR FLOODPLAIN LINE  
— NEW/ADDITIONAL PONDING  
— PROPOSED BY THIS PLAN

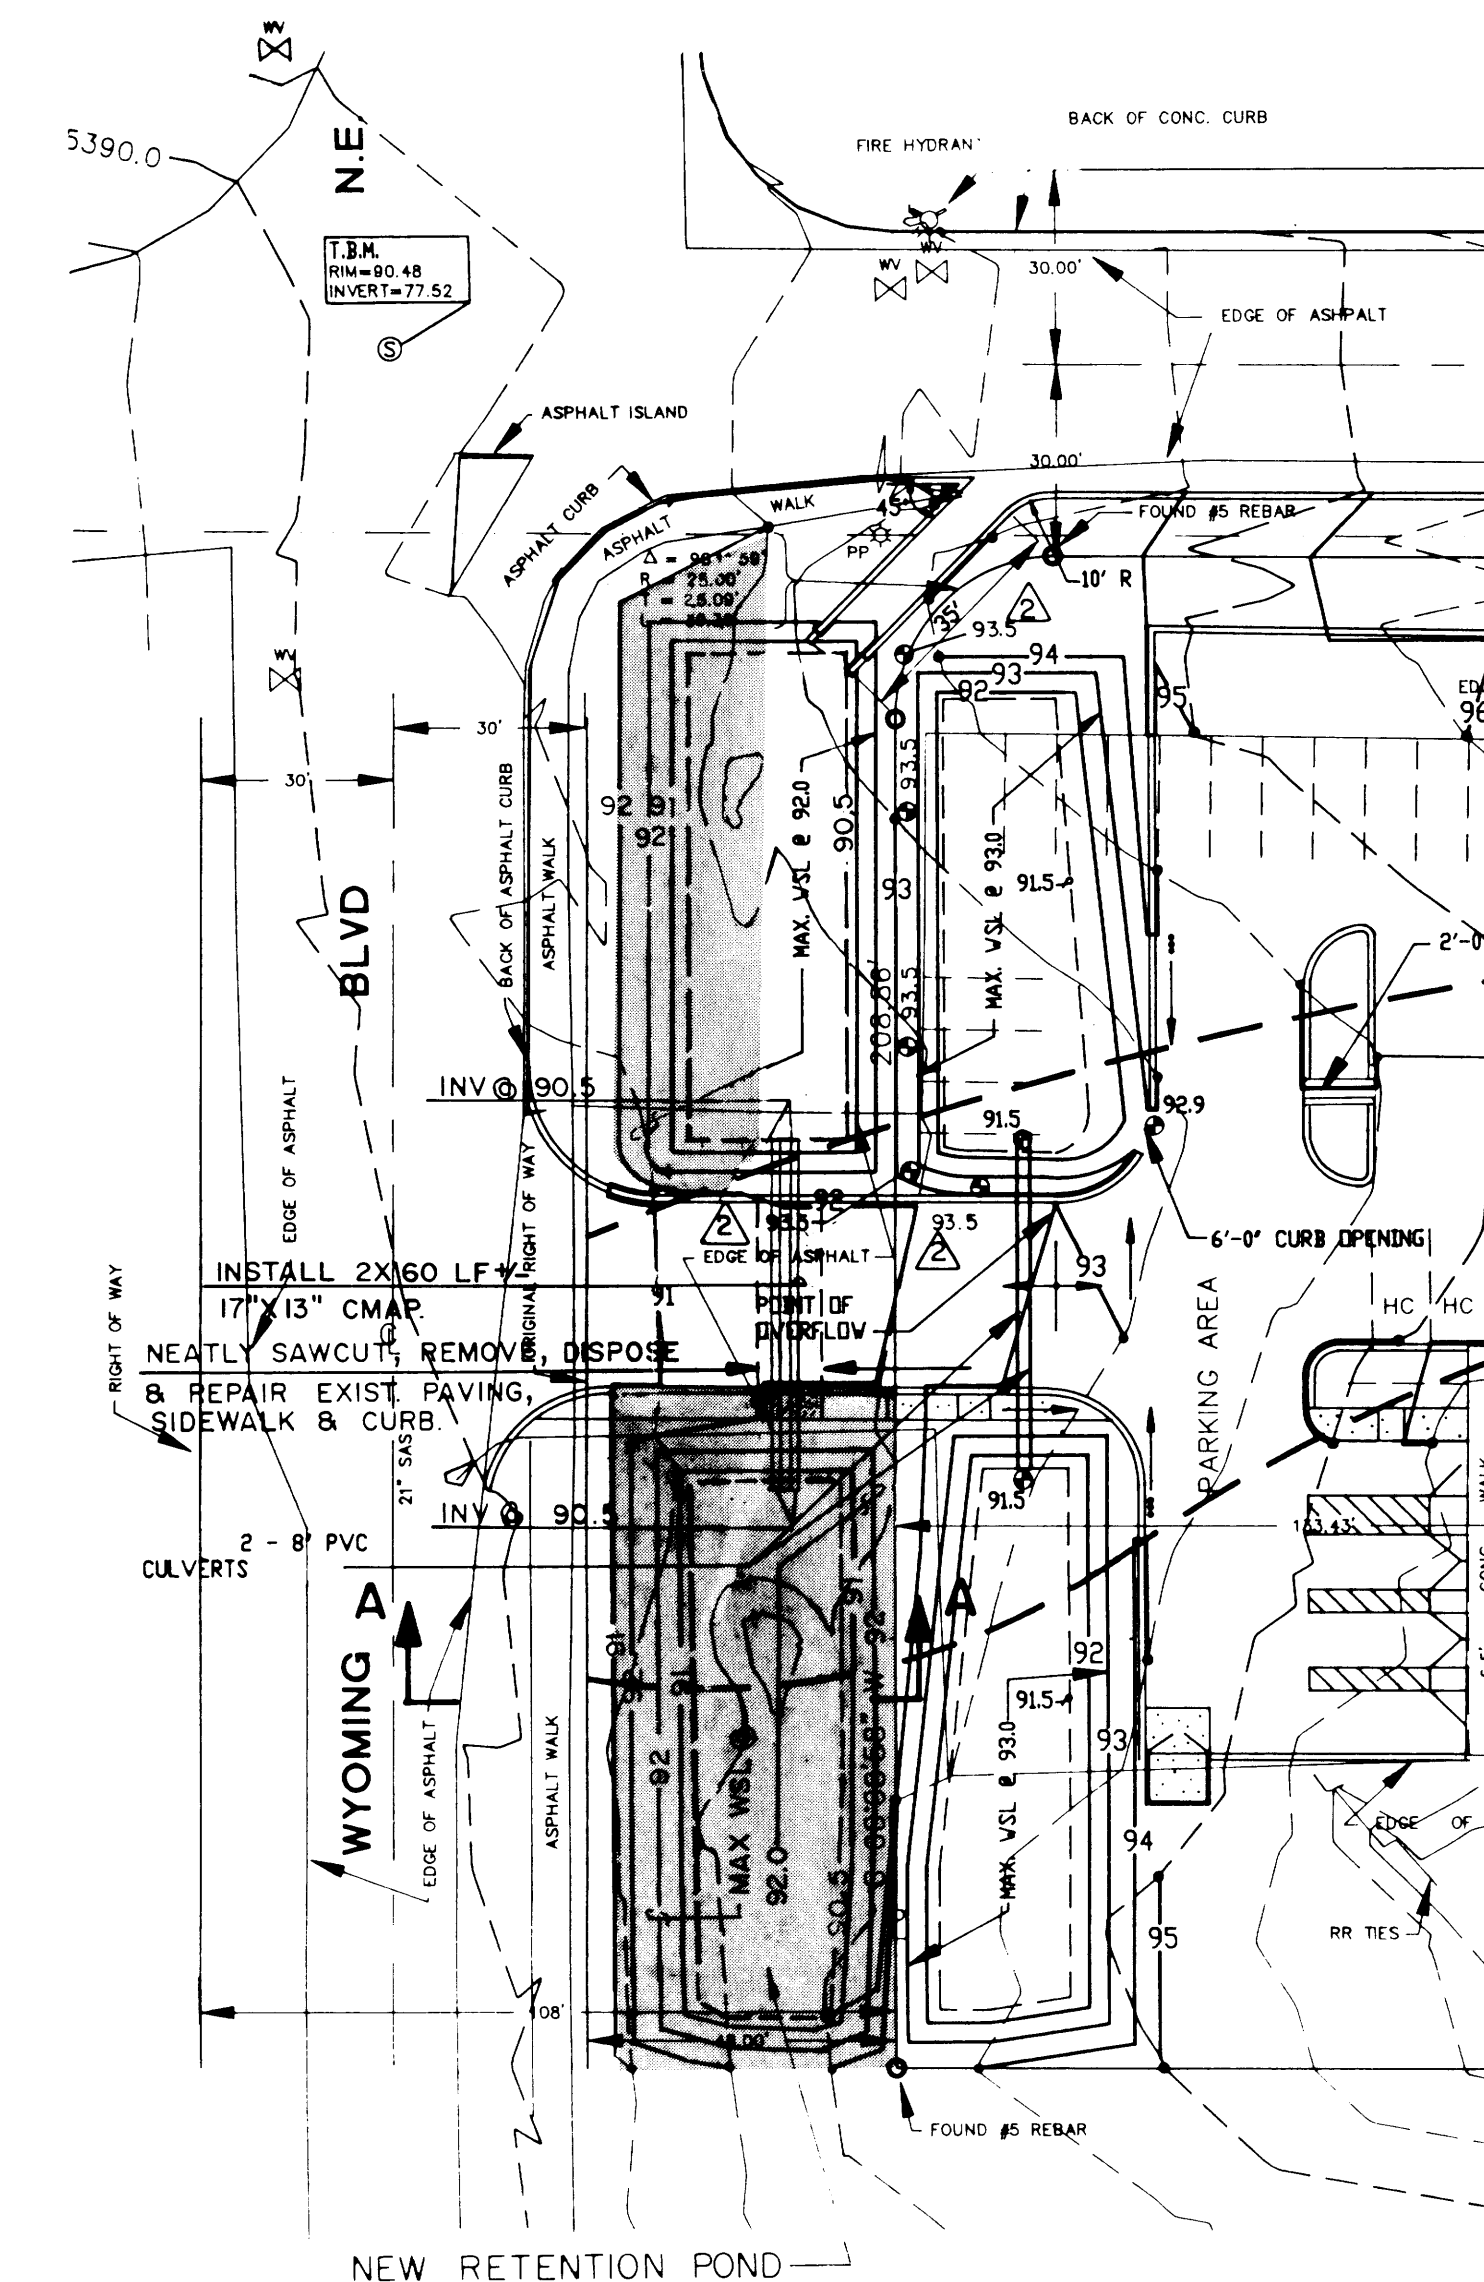

## DETAIL

SCALE: 1" = 30'

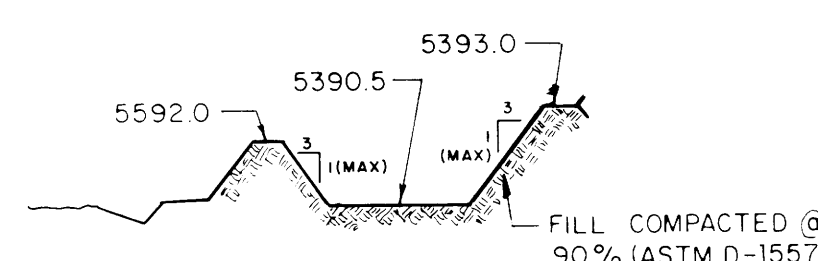

## SECTION A-A

SCALE: 1" = 30' HORIZ.  
1" = 50' VERT.

## CALCULATIONS (6 Hour-2 Year Storm)

## Site Characteristics (TIERRA LA CUEVA II)

- Precipitation Zone = 3
- $P_{6,2} = P_{6,0} = 1.13$
- Total Area ( $A_t$ ) = 5.88
- Existing Land Treatment

Treatment	Area (sf/ac)	%
A	256,020/5.88	100%

## 5. Developed Land Treatment

- Basin A  
 $N = 2 \text{ Lots}/0.29 \text{ Ac} = 6.9 \text{ du}/\text{Ac}$   
 $\% D = 7(N^2 + 5N)^{1/2} = 63\% = 0.18 \text{ Ac}$   
 $\% B = 100 - \% D = 37\% = 0.11 \text{ Ac}$

- Basin B  
 $N = 23 \text{ Lots}/5.09 \text{ Ac} = 4.5 \text{ du}/\text{Ac}$   
 $\% D = 7(N^2 + 5N)^{1/2} = 46\% = 0.24 \text{ Ac}$   
 $\% B = 100 - \% D = 54\% = 2.75 \text{ Ac}$

- Basin C  
 $N = 2 \text{ Lots}/0.49 \text{ Ac} = 4.1 \text{ du}/\text{Ac}$   
 $\% D = 7(N^2 + 5N)^{1/2} = 43\% = 0.21 \text{ Ac}$   
 $\% B = 100 - \% D = 57\% = 0.28 \text{ Ac}$

## Existing Condition

- Volume  
 $E_w = (E_A A_A + E_B A_B + E_C A_C + E_D A_D) / A_t$   
 $E_w = [(0.00)(5.88)/5.88 = 0.00 \text{ in.}]$   
 $V_2 = (E_w/12) A_t = 0 \text{ cf}$

- Peak Discharge  
 $Q_p = Q_{pA} A_A + Q_{pB} A_B + Q_{pC} A_C + Q_{pD} A_D$   
 $Q_p = Q_2 = (0.00)(5.88) = 0 \text{ cfs}$

## Developed Condition

- Basin A  
  - Volume  
 $E_w = (E_A A_A + E_B A_B + E_C A_C + E_D A_D) / A_t$   
 $E_w = [(0.06)(0.11) + (0.89)(0.18)]/0.29 = 0.58 \text{ in.}$   
 $V_2 = (E_w/12) A_t$   
 $V_2 = (0.58/12)(0.29) = 0.014 \text{ ac. ft.} = 610 \text{ cf}$

- Peak Discharge  
 $Q_p = Q_{pA} A_A + Q_{pB} A_B + Q_{pC} A_C + Q_{pD} A_D$   
 $Q_p = Q_2 = (0.21)(0.11) + (2.04)(0.18)$   
 $Q_2 = 0.4 \text{ cfs}$

## b. Basin B

- Volume  
 $E_w = (E_A A_A + E_B A_B + E_C A_C + E_D A_D) / A_t$   
 $E_w = [(0.06)(2.75) + (0.89)(2.34)]/5.09 = 0.44 \text{ in.}$   
 $V_2 = (E_w/12) A_t$   
 $V_2 = (0.44/12)(5.09) = 0.19 \text{ ac. ft.} = 8,280 \text{ cf}$

- Peak Discharge  
 $Q_p = Q_{pA} A_A + Q_{pB} A_B + Q_{pC} A_C + Q_{pD} A_D$   
 $Q_p = Q_2 = (0.21)(2.75) + (2.04)(2.34)$   
 $Q_2 = 5.4 \text{ cfs}$

## c. Basin C

- Volume  
 $E_w = (E_A A_A + E_B A_B + E_C A_C + E_D A_D) / A_t$   
 $E_w = [(0.06)(0.28) + (0.89)(0.21)]/0.49 = 0.42 \text{ in.}$   
 $V_2 = (E_w/12) A_t$   
 $V_2 = (0.42/12)(0.49) = 0.017 \text{ ac. ft.} = 740 \text{ cf}$

## 2. Peak Discharge

- $$Q_p = Q_{pA} A_A + Q_{pB} A_B + Q_{pC} A_C + Q_{pD} A_D$$
- $$Q_p = Q_2 = (0.21)(0.28) + (2.04)(0.21) = 0.5 \text{ cfs}$$

## d. Total Developed Basins

- Volume =  $V_{100A} + V_{100B} + V_{100C}$   
 $V_{100T} = 610 + 8,280 + 740 = 9,630 \text{ cf}$
- Peak Discharge =  $Q_{1A} + Q_{1B} + Q_{1C}$   
 $Q_{2T} = 0.4 + 5.4 + 0.5 = 6.3 \text{ cfs}$

## Comparison

- $\Delta V_2 = 9,630 - 0 = 9,630 \text{ cf (increase)}$
- $\Delta Q_2 = 6.3 - 0 = 6.3 \text{ cfs (increase)}$

 $\Delta V_2$  Calculations (T.L.C. 2 and Barstow Street Storm Drain)

$V_2 (\text{offsite}) = 0.01260 \text{ in. (From C.L.O.M.R. for Tierra La Cueva 2)}$   
 $A (\text{offsite}) = 0.0918 \text{ mi}^2 = 60 \text{ acres}$   
 $V_2 (\text{offsite}) = (0.01260 \text{ in./acre})(60 \text{ acres})(1 \text{ ft./12 in.})(43,560 \text{ ft}^2/\text{Ac})$   
 $V_2 (\text{offsite}) = 2,744 \text{ cf}$   
 $(2,744)(1.15) = 3,156 \text{ cf (15\% Bulking Factor)}$   
All 2 year offsite flows intercepted by Barstow St. Storm Drain  
 $\Delta V_2 (\text{net}) = \Delta V_2 (\text{onsite}) - V_2 (\text{offsite}) = 9,630 - 3,156 = 6,474 \text{ cf (increase)}$   
Additional Required Volume = 6,474 cf

## Pond Volume Calculations

- North Pond  
 $A_{10,5} = 1,924 \text{ sf}$   
 $A_{2,2} = 2,259 \text{ sf}$   
 $A_{2,2} = 2,962 \text{ sf}$   
 $V_{1,2} = (1/2)(1,924 + 2,259)(0.5) + (1/2)(2,259 + 2,962)(1.0)$   
 $V_{1,2} = 3,456 \text{ cf}$

- South Pond  
 $A_{10,5} = 1,728 \text{ sf}$   
 $A_{2,2} = 2,125 \text{ sf}$   
 $A_{2,2} = 2,867 \text{ sf}$   
 $V_{1,2} = (1/2)(1,728 + 2,125)(0.5) + (1/2)(2,125 + 2,867)(1.0)$   
 $V_{1,2} = 3,459 \text{ cf}$

- Total Volume = 3,650 cf + 3,459 = 7,115 cf

## Calculations (6 Hour-2 Year Storm)

## Site Characteristics (WILSHIRE AVENUE MODIFICATIONS BY COVENANT UMC)

- Precipitation Zone = 3
- $P_{6,2} = P_{6,0} = 1.13$
- Total Area ( $A_t$ ) = 3.44 ac  
(Areas taken from Hydrology File C19/D10) *Drainage Analysis (2 of 6)*
- Existing Land Treatment

Treatment	Area (sf/ac)
C	0.74 AC
D	2.70 AC

## 5. Developed Land Treatment

Treatment	Area (sf/ac)
C	0.46 AC
D	2.98 AC

## Existing Condition

- Volume  
 $E_w = (E_A A_A + E_B A_B + E_C A_C + E_D A_D) / A_t$   
 $E_w = [(0.20)(0.74) + (0.89)(2.70)]/(3.44) = 0.74 \text{ in.}$   
 $V_2 = (E_w/12) A_t$   
 $V_2 = (0.74/12)(3.44) = 0.212 \text{ ac-ft} = 9,235 \text{ cf}$

## Developed Condition

- Volume  
 $E_w = (E_A A_A + E_B A_B + E_C A_C + E_D A_D) / A_t$   
 $E_w = [(0.20)(0.46) + (0.89)(2.98)]/(3.44) = 0.80 \text{ in.}$   
 $V_2 = (E_w/12) A_t$   
 $V_2 = (0.80/12)(3.44) = 0.229 \text{ ac-ft} = 9,975 \text{ cf}$

## Comparison

$$\Delta V_2 = 9,975 - 9,235 = 740 \text{ cf (increase)}$$

Pond Volume required for Wilshire Modifications = 740 cf

Pond Volume provided = 7,115 cf  
Excess storage = 7,115 cf - 740 cf = 6,375 cf  
Volume of 17"x13" CMAP = (120 ft)(1.1 sf) = 132 cf  
Total storage = 6,375 cf + 132 cf = 6,507 cf  
6,507 cf > 6,474 cf

## DRAINAGE PLAN

The following items concerning Tierra La Cueva, Unit 2/Wyoming-Wilshire Improvements Drainage Plan are contained hereon:

- Updated Grading Plan
- Grading Detail
- Calculations
- Pond Section

Sheet one of this set shows the previously approved plan for the Covenant United Methodist Church (Hydrology file C19/D10). The purpose of the Tierra La Cueva Unit 2/Wyoming-Wilshire Improvements Plan is to expand the public temporary ponding area which was constructed in association with the Covenant United Methodist Church. This additional ponding volume is intended to contain the increase in volume generated by the construction of Tierra La Cueva Unit 2 Subdivision due to the 2-year, 6-hour rainfall event.

The updated Grading Plan cross-references the Grading Detail. The Grading Detail shows 1) existing and proposed grades indicated by spot elevations and contours at 1'0" intervals, 2) the limit and character of the existing improvements, 3) the limit and character of the proposed improvements, and 4) continuity between existing and proposed grades. The work specified by this Detail lies entirely in public right-of-way and will not require work on private property.

The Tierra La Cueva Unit 2 Drainage Plan (C19-D9) demonstrates that the construction of the subdivision, combined with the paving and storm drain improvements in Barstow Street (City of Albuquerque Project No. 4685.90), results in a decrease in storm water runoff during the 10 and 100-year, 6-hour rainfall events while producing an increase for the 2-year event. The calculations shown hereon demonstrate that the proposed grading improvements will eliminate any increase in stormwater volume observed below the intersection of Wyoming Blvd and Wilshire Avenue resulting from the 2-year, 6-hour event.

The need for this additional pond volume will be eliminated upon completion of storm drain and paving improvements within Wyoming Blvd. These improvements are driven by AMAFCA and are currently in the planning phase. Construction is to begin upon completion of the Louisiana Dam Project which is currently under construction. The proposed permanent improvements will construct a crown in Wyoming which it lacks currently. The lack of crown allows flows within Wilshire to cross Wyoming instead of flowing down Wyoming to the outfall at the North Domingo Baca Arroyo. Storm Drain construction is also planned to pick up flows from Wilshire and carry them to the Domingo Baca.

Suncor Development, the Developer of Tierra La Cueva Unit 2, had originally planned, by prior submittal, to reconstruct a portion of Wyoming Blvd in order to convey the more frequent flows within Wilshire to the Domingo Baca (see Hydrology file C-19/D9). In light of the proposed AMAFCA improvements, this reconstruction of temporary improvements would be wasteful as a permanent solution is in the near future. The Financial Guarantee that the City of Albuquerque is holding from Suncor Development for the temporary paving improvements would instead be used to accomplish the grading proposed hereon.

The required additional right-of-way ponding volume has been determined in the following manner: The 2-year offsite volume which originally crossed Barstow Street and flowed down Wilshire is now intercepted by Barstow Street and its Storm Drain. The bulked runoff was calculated by the AHVMO Program for the Tierra La Cueva Unit 2 CLOMR to be 3,156 cf. As shown by the 2-year calculations for the Tierra La Cueva Subdivision, there is an increase in volume of 9,630 cf. The net result of the recent construction is therefore a 9,630-3,156 = 6,474 cubic foot increase in volume. This 6,474 cubic feet is the additional volume which is to be ponded before it reaches Wyoming Blvd.

As shown on Sheet 1 of 2 of this Plan, a temporary pond was constructed by the Covenant United Methodist Church to pond the additional public storm runoff generated by their paving within Wilshire Avenue. The 2-year volume calculations shown on this Plan for the Wilshire paving shows that the required pond volume is 740 cf. The total capacity within the two right-of-way ponds is 7,115 cf. The excess capacity of 7,115-740 = 6,375 cf is added to the storage volume of the CMAP culverts to produce a total volume of 6,507 cf which is slightly greater than the 6,474 cf net increase in 2-year volume.

The lack of a distinguished crown within Wilshire allows flows in Wilshire to cross over to the south side of the street and into the runoff which outfalls to the proposed ponds. As shown by the Calculations, the increase in runoff during 2-year, 6-hour event caused by the construction of Tierra La Cueva Unit 2 will be neutralized by the proposed ponding.

The Calculations which appear hereon analyze both the existing and developed conditions for the 2-year, 6-hour rainfall event. The Procedure for 40-acre and Smaller Basins, as set forth in the Revision of Section 22.2, Hydrology of the Development Process Manual, Volume 2, Design Criteria, dated January, 1993, has been used to quantify the peak rate of discharge and volume of runoff generated.

DEC 12 1994



JEFF MORTENSEN & ASSOCIATES, INC.  
6010-B MIDWAY PARK BLVD. N.E.  
ALBUQUERQUE, NEW MEXICO 87109  
ENGINEERS & SURVEYORS (505)345-4250

## DRAINAGE PLAN, CALCULATIONS, DETAILS &amp; SECTIONS

TIERRA LA CUEVA, UNIT II/ WYOMING - WILSHIRE IMPROVEMENTS




DESIGNED BY	J.G.M.	NO.	DATE	BY	REVISIONS	JOB NO.
DRAWN BY	J.M.A.					930682
APPROVED BY	J.G.M.					DATE
						11/94
						SHEET 2 OF 2








3. ALL FILL SHALL BE COMPACTED TO A MINIMUM OF 90% ASTM D-1557; HOUSE PADS SHALL BE COMPACTED AT 95% ASTM D-1557.
4. THE PAD ELEVATIONS SHOWN HEREON ARE FOR ROUGH GRADING PURPOSES.
5. FINISHED FLOOR ELEVATIONS MAY VARY FROM THE PAD ELEVATIONS AND WILL BE DETERMINED AS A FUNCTION OF INDIVIDUAL HOUSE DESIGN.
6. FINISHED FLOOR ELEVATIONS SHOULD BE ESTABLISHED AT A MINIMUM OF 6 INCHES ABOVE PAD ELEVATIONS; DEVIATIONS FROM THESE GUIDELINES MUST BE BASED ON THE RECOMMENDATIONS AND/OR DESIGN OF A COMPETENT DESIGN PROFESSIONAL.
7. NO CROSS-LOT DRAINAGE WILL BE ALLOWED UNLESS PROVIDED FOR BY PRIVATE DRAINAGE EASEMENT.
8. RETAINING WALLS SHALL BE CONSTRUCTED BY THE DEVELOPER.
9. YARD (GARDEN) WALLS SHALL BE CONSTRUCTED BY THE LOT OWNER OR ITS BUILDER.
10. THE FINISHED GRADING OF EACH LOT SHALL BE ACCOMPLISHED BY THE LOT OWNER OR ITS BUILDER. ALL RUNOFF MUST BE DIRECTED TO THE STREETS OR DRAINAGE EASEMENT (IF APPLICABLE).
11. LOTS 1 THROUGH 8 INCLUSIVE AND LOTS 15 AND 16 WILL BE CONSTRUCTED WITH LOWER LEVELS WHICH WILL LIE BELOW THE ADJACENT STREET GRADE. THE UPPER LEVEL WILL BE ESTABLISHED ABOVE THE FINISHED STREET GRADE.
12. ALL DEVELOPED ROOF AND SIDE YARD RUNOFF MUST BE DRAINED TO THE STREET.
13. MAXIMUM SLOPES SHALL BE 3:1; MINIMUM SLOPES SHALL BE 1%.
14. TWO (2) WORKING DAYS PRIOR TO ANY EXCAVATION, CONTRACTOR MUST CONTACT NEW MEXICO ONE CALL SYSTEM, 260-1990, FOR LOCATION OF EXISTING UTILITIES.
15. IF ANY UTILITY LINES, PIPELINES, OR UNDERGROUND UTILITY LINES ARE SHOWN ON THESE DRAWINGS, THEY ARE SHOWN IN AN APPROXIMATE MANNER ONLY, AND SUCH LINES MAY EXIST WHERE NONE ARE SHOWN. IF ANY SUCH EXISTING LINES ARE SHOWN, THE LOCATION IS BASED UPON INFORMATION PROVIDED BY THE OWNER OF SAID UTILITY, AND THE INFORMATION MAY BE INCOMPLETE, OR MAY BE OBSOLETE BY THE TIME CONSTRUCTION COMMENCES. THE ENGINEER HAS CONDUCTED ONLY PRELIMINARY INVESTIGATION OF THE LOCATION, DEPTH, SIZE, OR TYPE OF EXISTING UTILITY LINES, PIPELINES, OR UNDERGROUND UTILITY LINES. THIS INVESTIGATION IS NOT CONCLUSIVE, AND MAY NOT BE COMPLETE, THEREFORE, MAKES NO REPRESENTATION PERTAINING THERETO, AND ASSUMES NO RESPONSIBILITY OR LIABILITY THEREFOR. THE CONTRACTOR SHALL INFORM ITSELF OF THE LOCATION OF ANY UTILITY LINE, PIPELINE, OR UNDERGROUND UTILITY LINE IN OR NEAR THE AREA OF THE WORK IN ADVANCE OF AND DURING EXCAVATION WORK. THE CONTRACTOR IS FULLY RESPONSIBLE FOR ANY AND ALL DAMAGE CAUSED BY ITS FAILURE TO LOCATE, IDENTIFY AND PRESERVE ANY AND ALL EXISTING UTILITIES, PIPELINES, AND UNDERGROUND UTILITY LINES. IN PLANNING AND CONDUCTING EXCAVATION, THE CONTRACTOR SHALL COMPLY WITH STATE STATUTES, MUNICIPAL AND LOCAL ORDINANCES, RULES AND REGULATIONS, IF ANY, PERTAINING TO THE LOCATION OF THESE LINES AND FACILITIES.
16. THE CONTRACTOR SHALL ENSURE THAT NO SOIL ERODES FROM THE SITE INTO PUBLIC RIGHT-OF-WAY OR ONTO PRIVATE PROPERTY. THIS CAN BE ACHIEVED BY CONSTRUCTING TEMPORARY BERMS AT THE PROPERTY LINES AND WETTING THE SOIL TO KEEP IT FROM BLOWING.
17. THE CONTRACTOR SHALL PROMPTLY CLEAN UP ANY MATERIAL EXCAVATED WITHIN THE PUBLIC RIGHT-OF-WAY SO THAT THE EXCAVATED MATERIAL IS NOT SUSCEPTIBLE TO BEING WASHED DOWN THE STREET.
18. THE CONTRACTOR SHALL SECURE "TOPSOIL DISTURBANCE PERMIT" PRIOR TO BEGINNING CONSTRUCTION. AN EXCAVATION PERMIT IS REQUIRED FOR ALL WORK WITHIN PUBLIC RIGHT-OF-WAY.

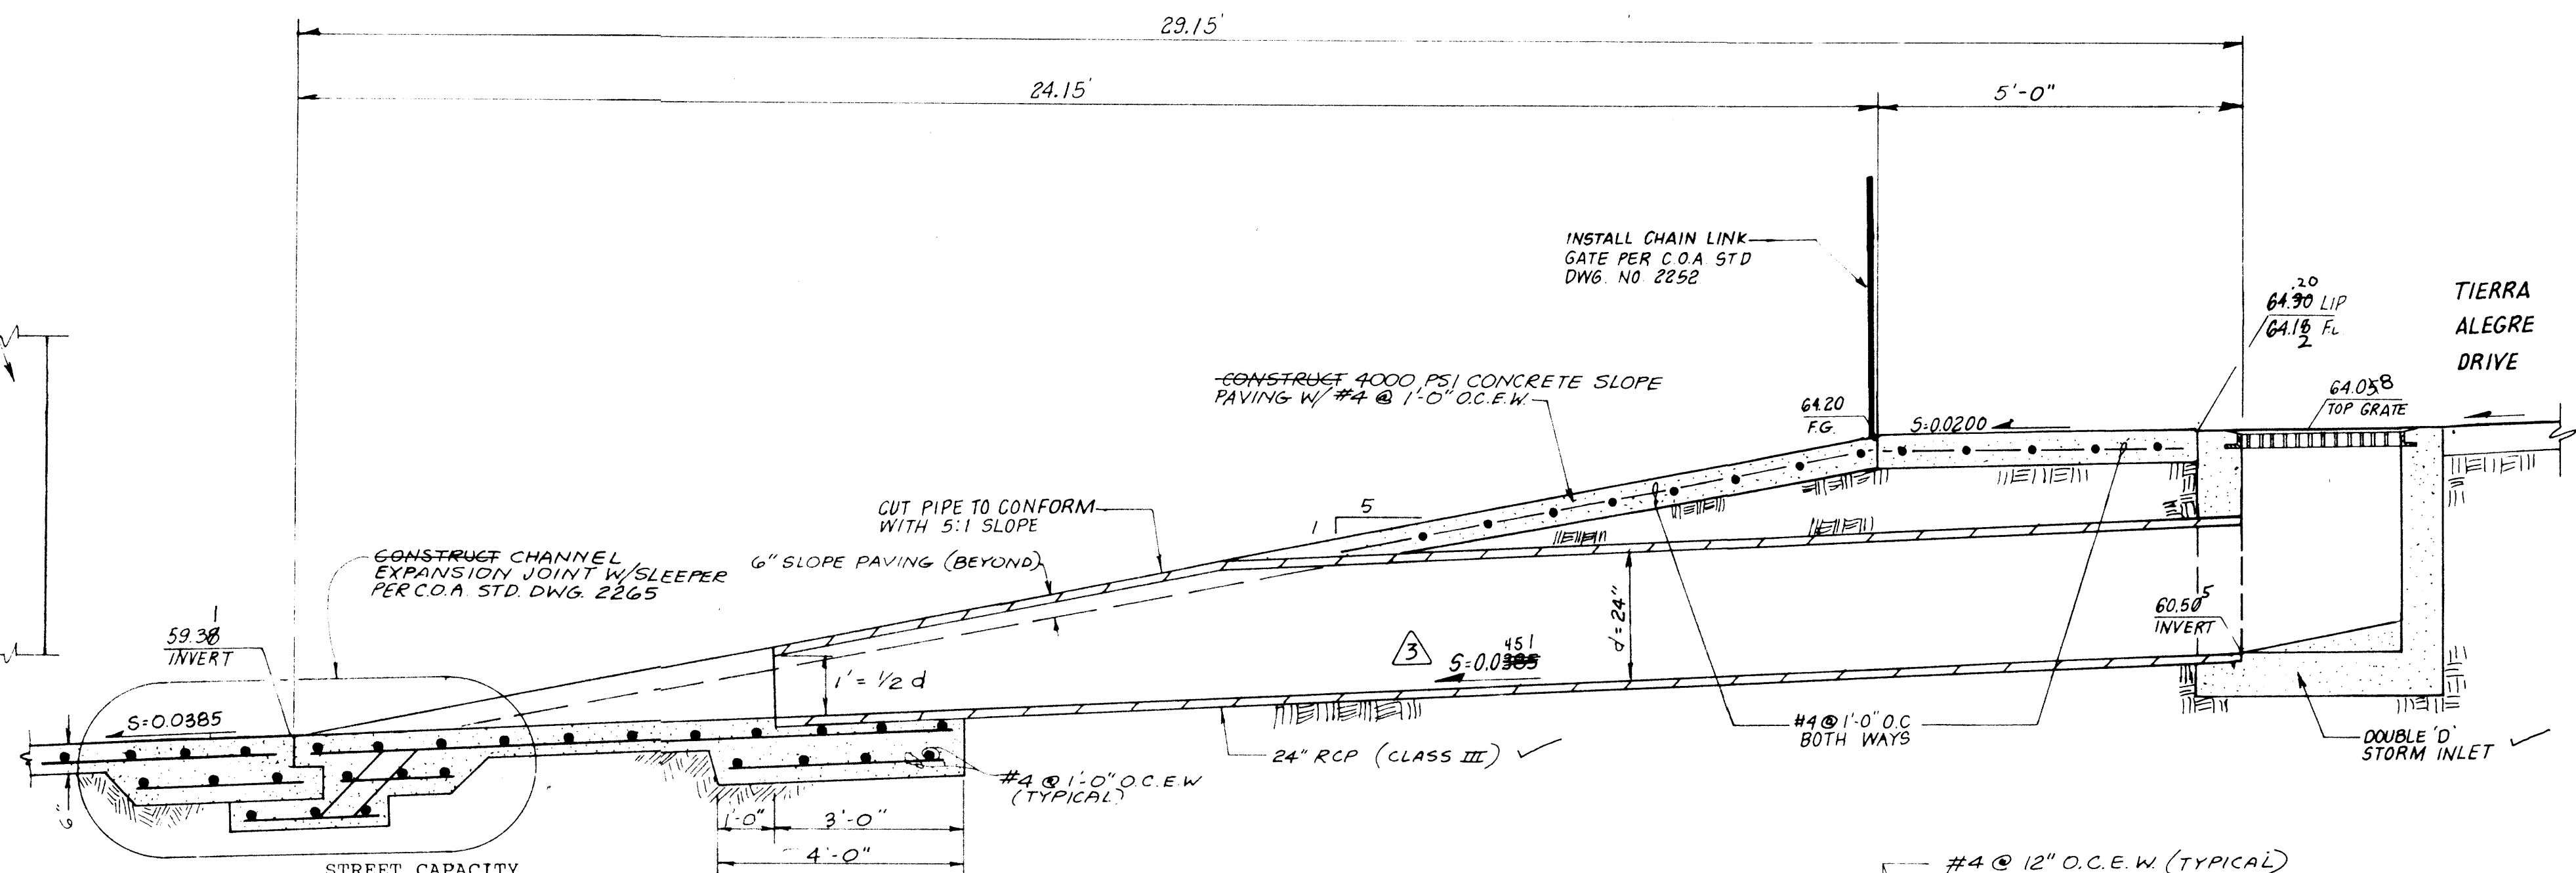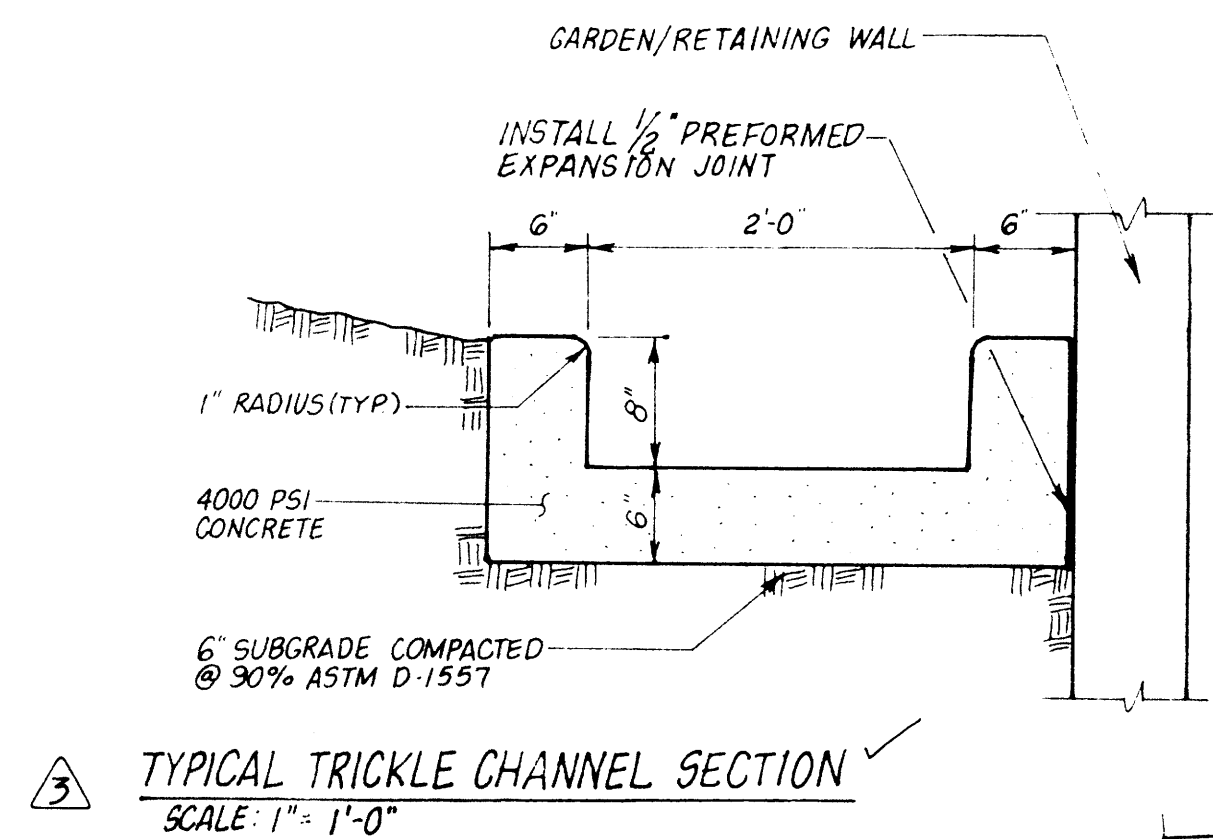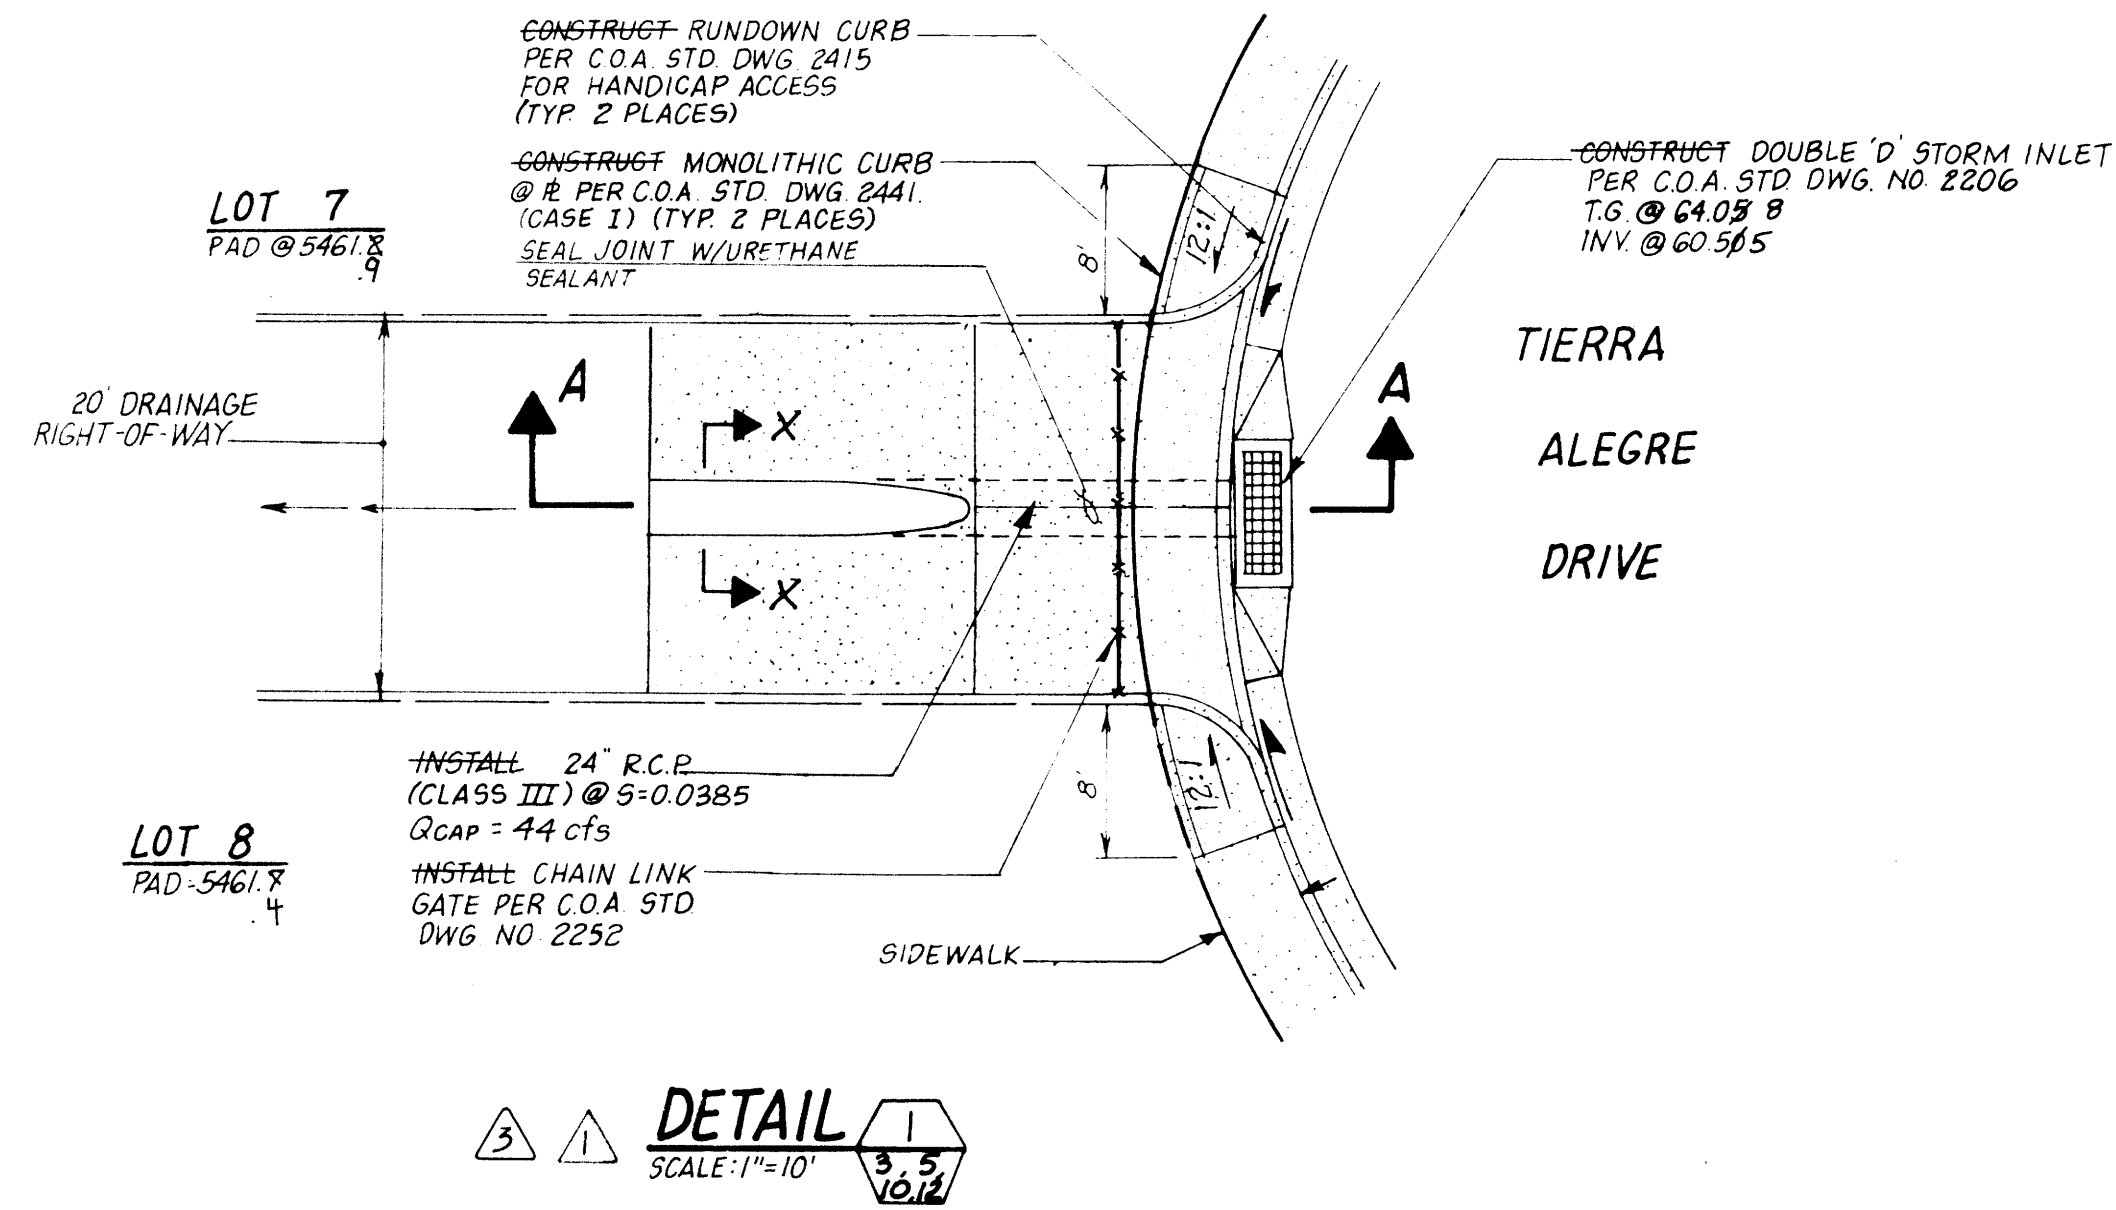

SUMP CONDITION @ CUL-DE-SAC

Required Capacity  $Q_{\text{req}} \approx 18.9 \text{ cfs}$


- a. Double "D" Inlet:
- $$Q_D = C A_{eff} (2g \Delta h)^{0.5}$$
- $$= 37.4 \text{ cfs}$$
- Where  $C = 0.7$
- $$A_{eff} = 0.5 (6.5 \times 2.5) = 8.125 \text{ sf (effective)}$$
- $$g = 32.2 \text{ ft/s}^2$$
- $$\Delta h = 0.67$$
- b. Pipe Capacity  
(By Feild's Hydraulics Calculator for Gravity Flow in Pipes)
- 24" RCP
- $$n = 0.013$$
- $$S = 0.0385$$
- $$Q_{cap} = 44 \text{ cfs}$$

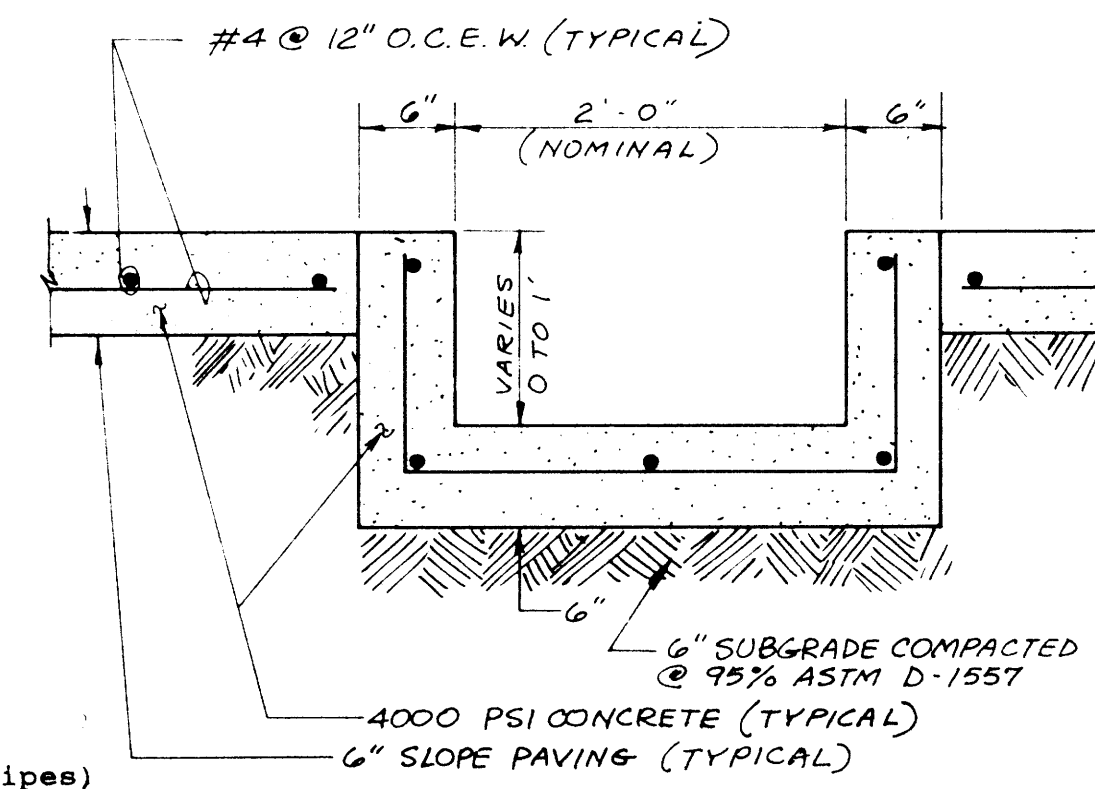

## DRAINAGE CERTIFICATION

As indicated by the as-built information shown hereon, Tierra La Cueva-Unit 2 has been graded in substantial conformance with the approved Plan. The streets are constructed and have been accepted by the City. Private drainage improvements and retaining walls have also been constructed. The concrete trickle channels, within private drainage easements, have been constructed in close tolerance to the approved grades. Pad elevations are the very close upon completion of the pad construction. As indicated, more than half of the lots have been developed or have houses under construction. Lots 14, 17, 18, and 19 have been completed. All other lots are still under construction with final lot grading pending completion of construction and yard landscaping. From review of the as-built information, the project has been constructed within construction tolerance with the exception of the finished grading which must be completed in conjunction with the finished landscaping of each lot. In addition, the existing paving along the south side of Wilshire Avenue N.E. was overlaid in order to raise the waterblock as required by previous submittal. Preliminary review also revealed that the as-constructed waterblock did not meet DPM criteria. In conjunction with the diversion of stormwaters by Barstow Street N.E., raising the waterblock was required.

The as-built information shown hereon was obtained by me or under my supervision and is true and correct to the best of my knowledge and belief.

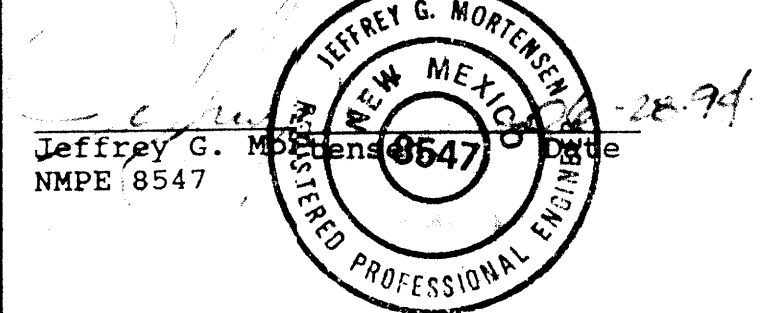[illegible]

JUN 29 1994

CITY OF ALBUQUERQUE  
PUBLIC WORKS DEPARTMENT  
ENGINEERING GROUP

TITLE: TIERRA LA CUEVA UNIT 2  
GRADING NOTES  
DRAINAGE DETAILS AND SECTIONS

APPROVALS	ENGINEER	DATE	APPROVALS	ENGINEER	DATE
DRC CHAIRMAN	<i>[Signature]</i>	8-04-93	WATER	<i>[Signature]</i> RWG	7-1-93
TRANSPORTATION	<i>[Signature]</i>	7-1-93	WASTE WATER	<i>[Signature]</i> RWG	7-1-93
HYDROLOGY	<i>[Signature]</i>	07-01-93			

PROJECT NO.	4368.91	MAP NO.	C-19	SHEET	4	OF	14
-------------	---------	---------	------	-------	---	----	----