

CARMEL AVENUE NE

R.O.W. VARIES / PAVEMENT WIDTH: VARIES


LOT 4

PAD1B
MAX DENSITY = .25
LOT SIZE
0,981 SF/.94 AC
MAX HEIGHT 28'

AVAILABLE
40,981 SF/.94 AC

NOT A PART

PROJECT LOCATION

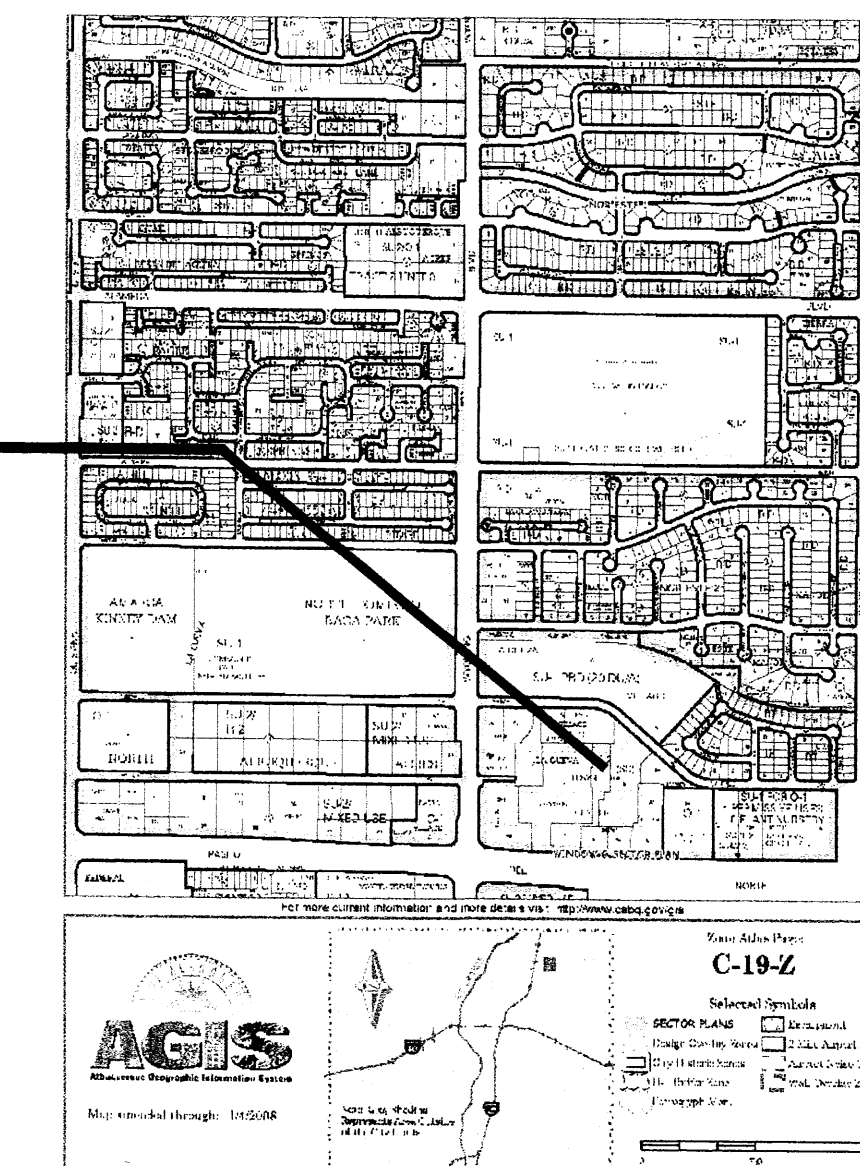

VICINITY MAP
TO REMAIN

LEGEND

- CABLE
- DRAIN INLET
- ELECTRIC PEDESTAL
- ELECTRIC TRANSFORMER
- HYDRANT
- LIGHT POLE
- SANITARY SEWER
- STORM SEWER
- TELEPHONE PEDESTAL
- WATER METER
- WATER VALVE

LOT 2
SMITHS
64,800 SF.
F.F 5413.75
MAX HEIGHT 39'

LOT 1-A
OFFICE MAX
23,500 SF.

BIG-5
10,000 SF
ENTRY 80'-0"

LOT 9
OFFICE PAD 7
MAX DENSITY = .25
MAX HEIGHT 39'

SHOPS
10,800 SF

SITEPLAN

SCALE: 1"=40'-0"



LOT 8
RETAIL PAD 6
6,000 SQ/FT
MAX DENSITY = .25
6,000 SF. MAX
LOT SIZE
49,516 SF/1.13 AC
MAX HEIGHT 24'

SHOPS B

ADMINISTRATIVE AMENDMENT	
Project # 1000163	
Decrease in square	
Footage from 30,000 s.f.	
to 10,000 s.f.	
APPROVED BY	DATE
Kusell	25 June 08

REV	DATE	BY	REVISION
1	6/25/08	SD	Initial
2	6/25/08	SD	Revised
3	6/25/08	SD	Revised
4	6/25/08	SD	Revised
5	6/25/08	SD	Revised

GEORGE RAINHART ARCHITECT AND ASSOCIATES PC
2325 SAN PEDRO NE. SUITE 2-B
ALBUQUERQUE, NEW MEXICO 87110
PHONE (505) 884-9110 FAX (505) 837-9877

PROJECT TITLE La Cueva Town Center NEC of Wyoming Boulevard and Paseo Del Norte Albuquerque, New Mexico		PROJECT MANAGER SD		JOB NO. 97068		DRAWN BY: M		SHEET TITLE Site Plan (BIG-5)	
DATE:		sheet-		SCALE:		C1A		of-	

CARMEL AVENUE NE

R.O.W. VARIES / PAVEMENT WIDTH: VARIES

ADMINISTRATIVE AMENDMENT


File # 09AA-10065 Project # 1000456

± 9,180 sq. ft. retail building.

APPROVED BY *Russell Bents* DATE 22 May 2009

NOT A PART

PROJECT LOCATION

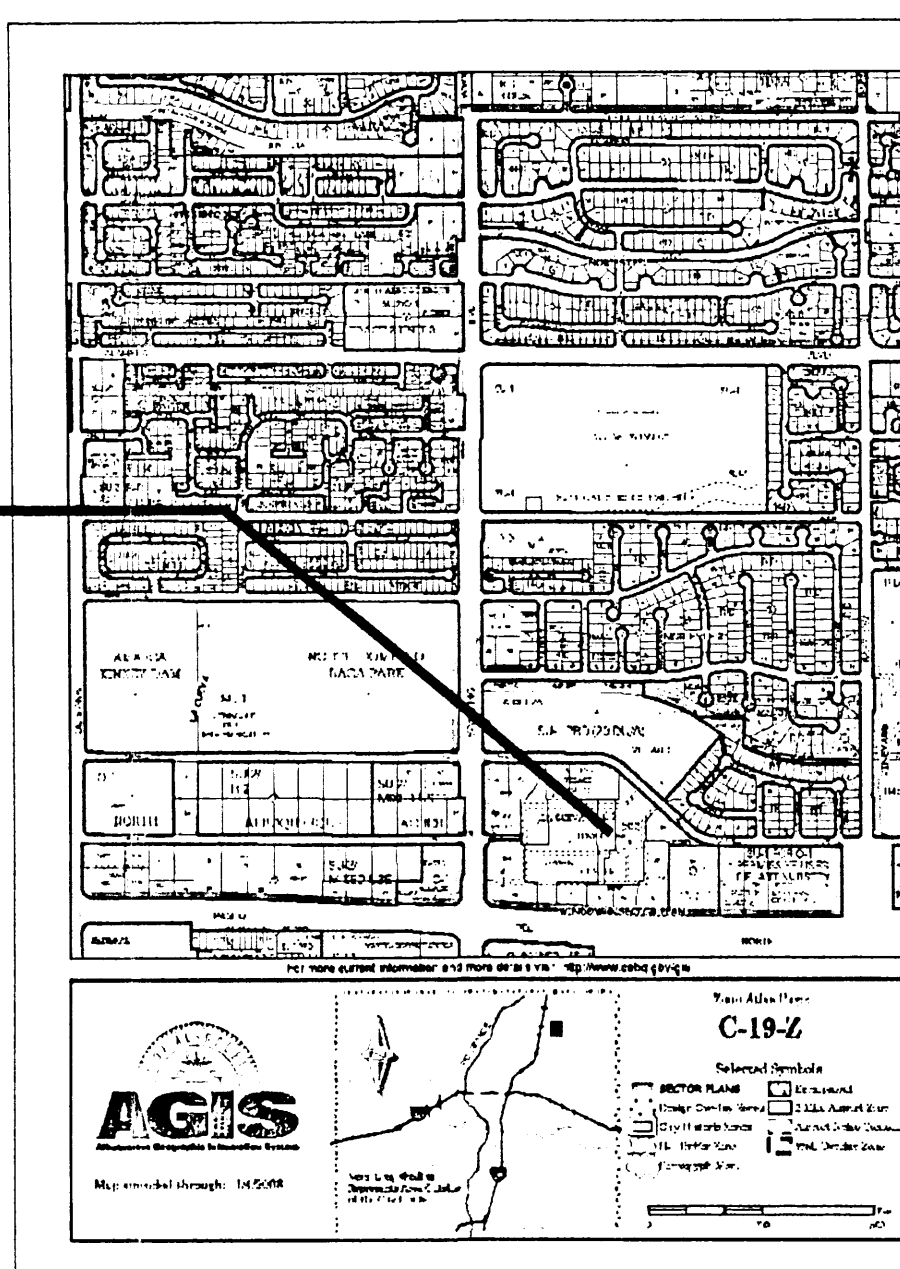

VICINITY MAP

LEGEND

- CABLE
- DRAIN INLET
- ELECTRIC PEDESTAL
- ELECTRIC TRANSFORMER
- HYDRANT
- LIGHT POLE
- SANITARY SEWER
- STORM SEWER
- TELEPHONE PEDESTAL
- WATER METER
- WATER VALVE

SITEPLAN

SCALE: 1"=40'-0"



SHOPS
10,800 SF

LOT 8
RETAIL PAD 6


6,000 SQ/FT
MAX DENSITY = .25
6,000 SF. MAX
LOT SIZE
49,516 SF/1.13 AC
MAX HEIGHT 24'

SHOPS B

RECEIVED
MAY 22 2009

RECEIVED
HYDROLOGY SECTION

MODULUS ARCHITECTS

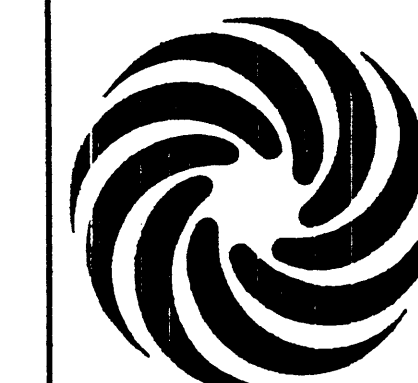

2325 SAN PEDRO N.E. SUITE 2-B
ALBUQUERQUE, NEW MEXICO 87110
PHONE (505) 338-1499 FAX (505) 338-1498
TOLL FREE 1-866-224-2161

PROJECT TITLE
DOLLAR TREE

PROJECT NUMBER
8200 WYOMING N.E.

PROJECT LOCATION
ALBUQUERQUE, NEW MEXICO

PROJECT MANAGER
STEPHEN DUNBAR, ARCHITECT

PROJECT DATE
11/24/08

PROJECT SCALE
AS NOTED

PROJECT DRAWN BY
MSW

PROJECT CHECKED BY
JL

PROJECT TITLE
SITE PLAN

SCALE
A1.0




HYDROLOGY SECTION

LEGEND

5031.05 FC	PROPOSED SPOT ELEVATION
5031.55 TC	
FL = 5031.05	EXISTING SPOT ELEVATION
---	EXISTING CONTOURS
---	PROPOSED CONTOURS

La Cueva Town Center BIG 5

- I. PURPOSE AND SCOPE
- The purpose of this drainage plan is to present the existing and proposed drainage management plans for the BIG 5 Sporting Goods store at the La Cueva Town Center. The site has been masterplanned by Tierra West with the grading and drainage plan completed in 1999 and as-built in April of 2000. The datum of the original grading and drainage plan and the survey completed are different and the change is approximately 2.6'.
- II. SITE DESCRIPTION AND HISTORY
- This site is almost completely developed per the approved Site Development Plan. There are a few outlots that still remain as well as the portion of the site to be developed as the Big 5 Sporting Goods Store. The previous grading and drainage plan showed a much larger store than the proposed 10,000 retail store. A portion of the prior building pad will still be available for a future building to the east of the proposed development.
- III. COMPUTATIONAL PROCEDURES
- Hydrologic analysis was performed utilizing the design criteria found in the COA-DPM Section 22.2 released in June 1997.
- IV. PRECIPITATION
- The 100-yr. 6-hr duration storm was used as the design storm for this analysis. This site is within Zone 2 as identified in the DPM Section 22.2. Tables within the section were used to establish the 6-hr precipitation, excess precipitation and peak discharge.

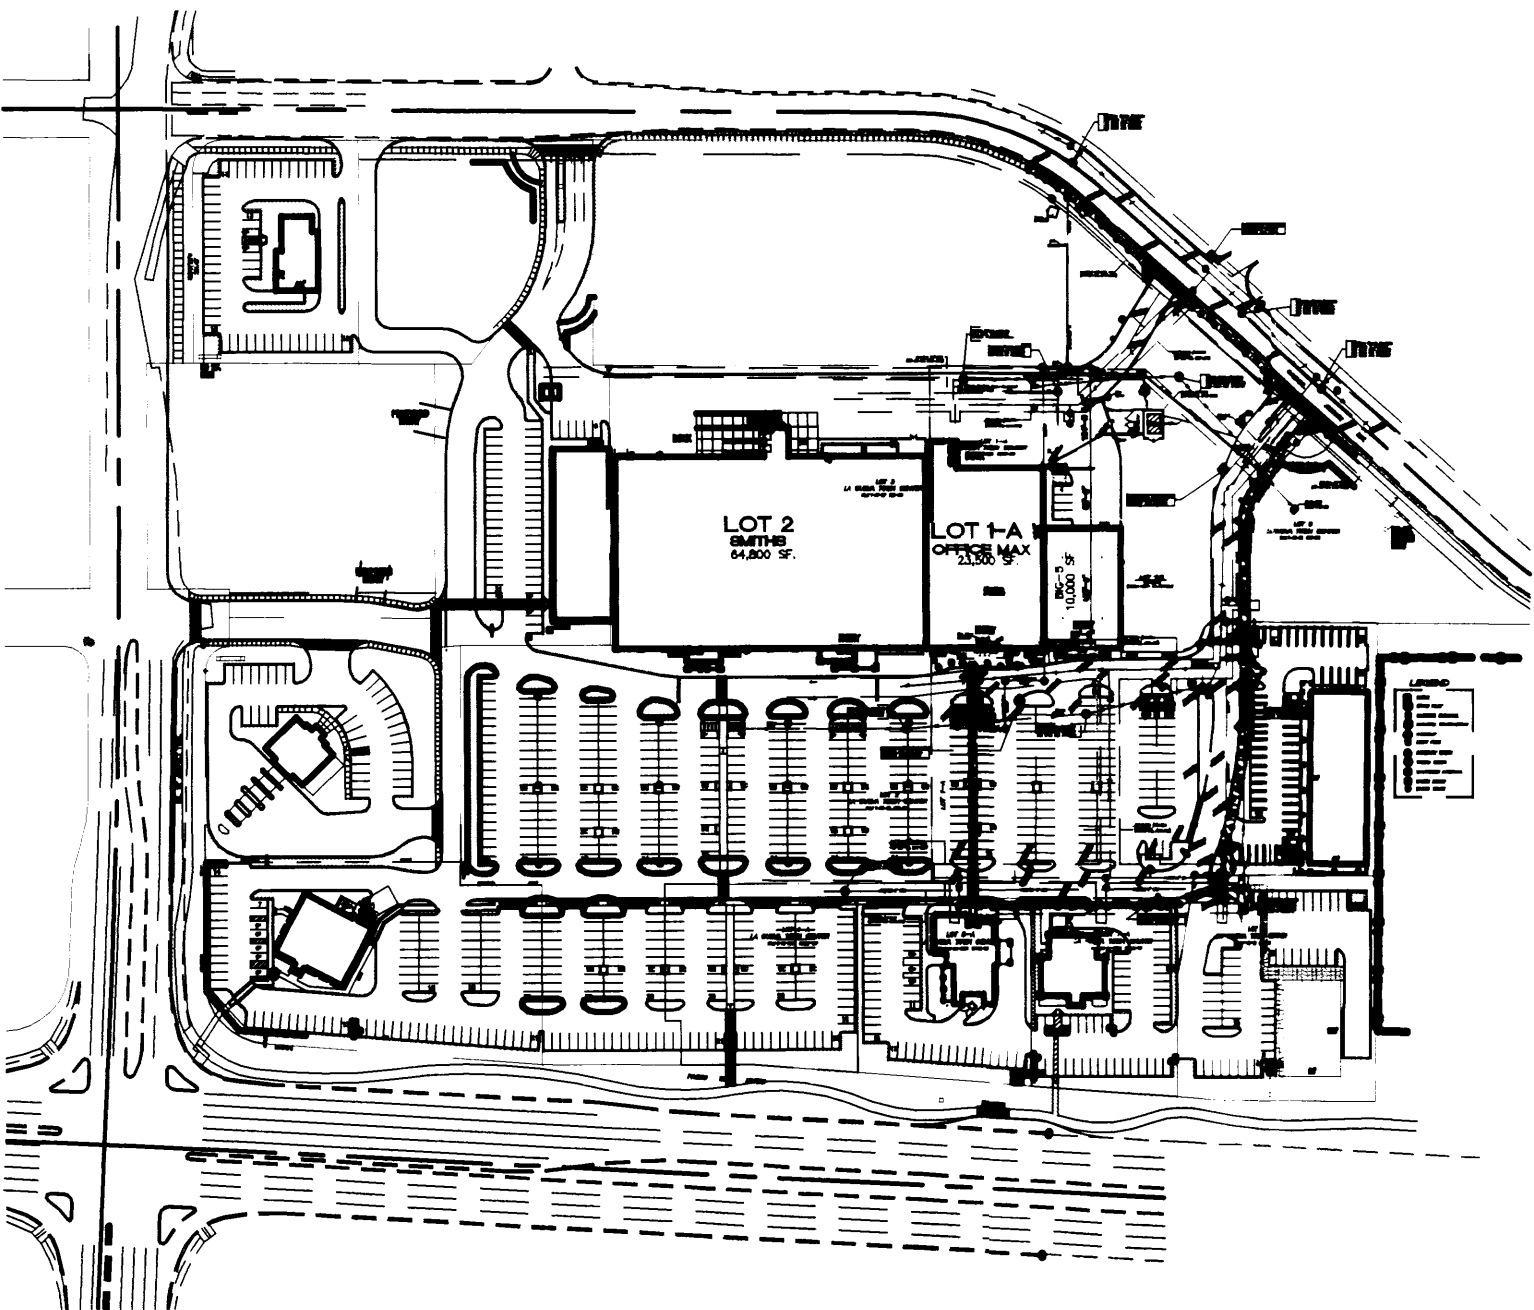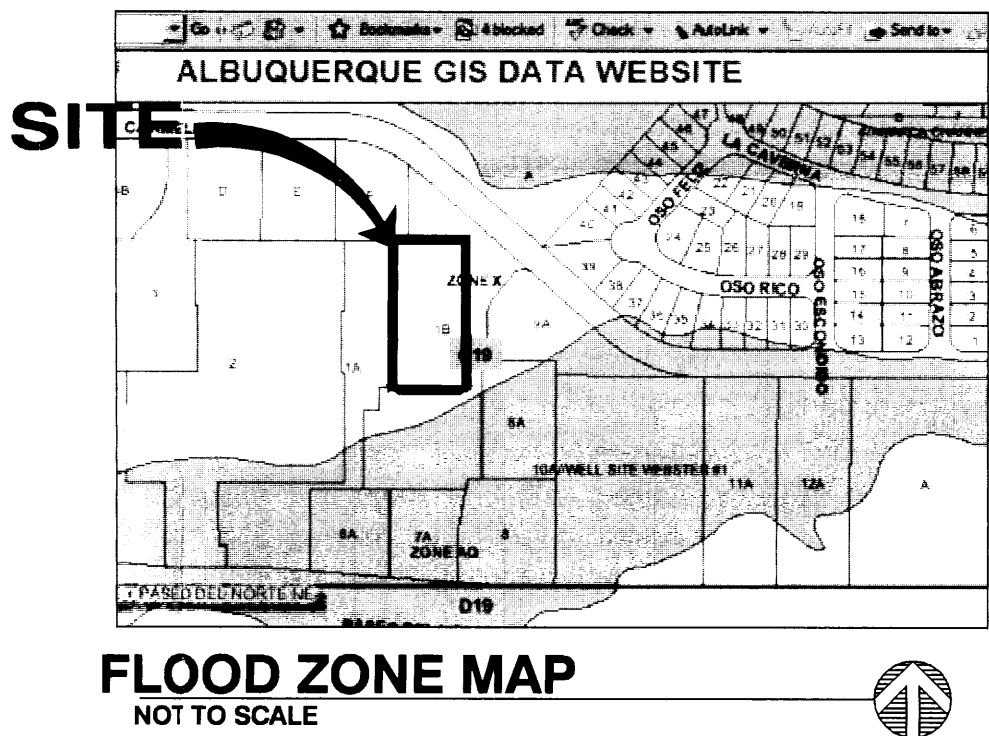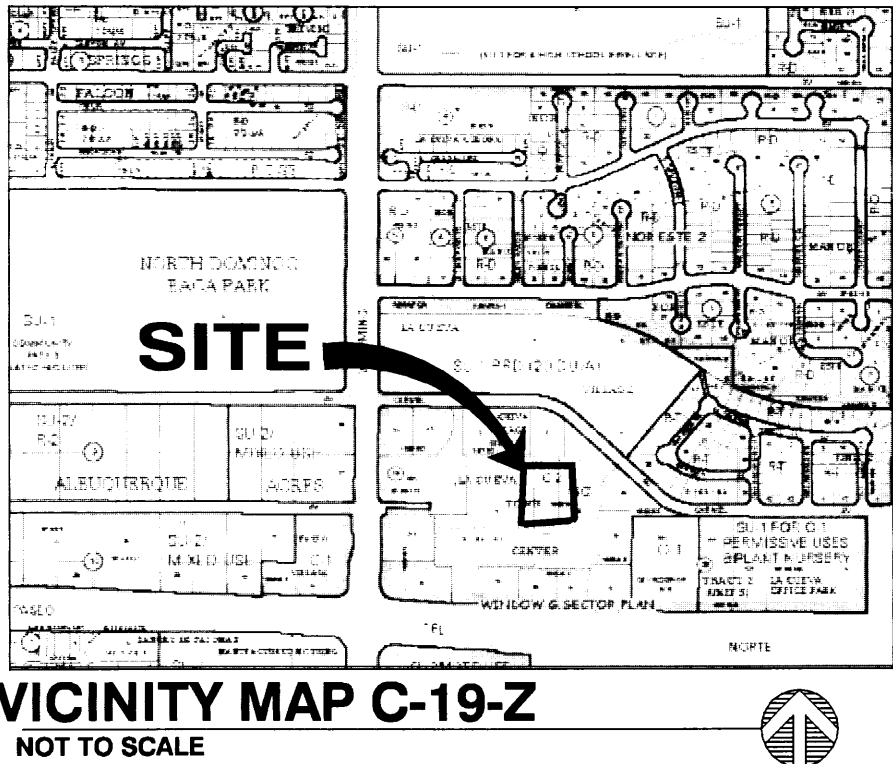

A1 OVERALL SITE GRADING AND DRAINAGE PLAN
SCALE: 1"=20'

V. EXISTING DRAINAGE CONDITIONS OVERVIEW


There is an approved Grading and Drainage Plan with information regarding the as-built conditions that was prepared by Tierra West in April of 2000. This plan shows an approximately 27,000 square foot building in the location of the proposed retail store. The site was designed to have a small swale in the driving lane on the south side of the building to convey and collect any runoff on the south side. A series of catch basins would then collect the runoff. It was then piped to the west via an "8" storm drain pipe. The final outlet of this collection system was into the ROW at Wyoming Boulevard N.E. and Paseo Del Norte. The runoff from the northern part of the proposed development was designed to convey storm water along the back sides of the buildings to a sump condition catch basin located on the access road from Carmel Avenue N.E..

VI. DRAINAGE MANAGEMENT PLAN

The proposed development consists of a new 10,000 sf retail store for Big 5, a small parking/delivery area on the north side, as well as new sidewalks to connect to the existing roadways on the south side. The previously approved grading and drainage plan was designed for a building approximately 27,000sf. Because this building does not cover the entire available retail pad it should be anticipated that another building will be constructed on the remaining vacant portion. Because the site has been designed and approved for a larger facility, it is not necessary to check the downstream capacity of the storm drainage improvements. This development will generate less runoff than was masterplanned.

VII. CONCLUSIONS


The project is an infill project into a almwow fully developed shopping center. A larger building ws masterplanned for this site and the Big 5 retail store will generate less runoff than was expected when the site was masterplanned. The proposed development should not have any adverse affects to downstream strom drainage improvements.

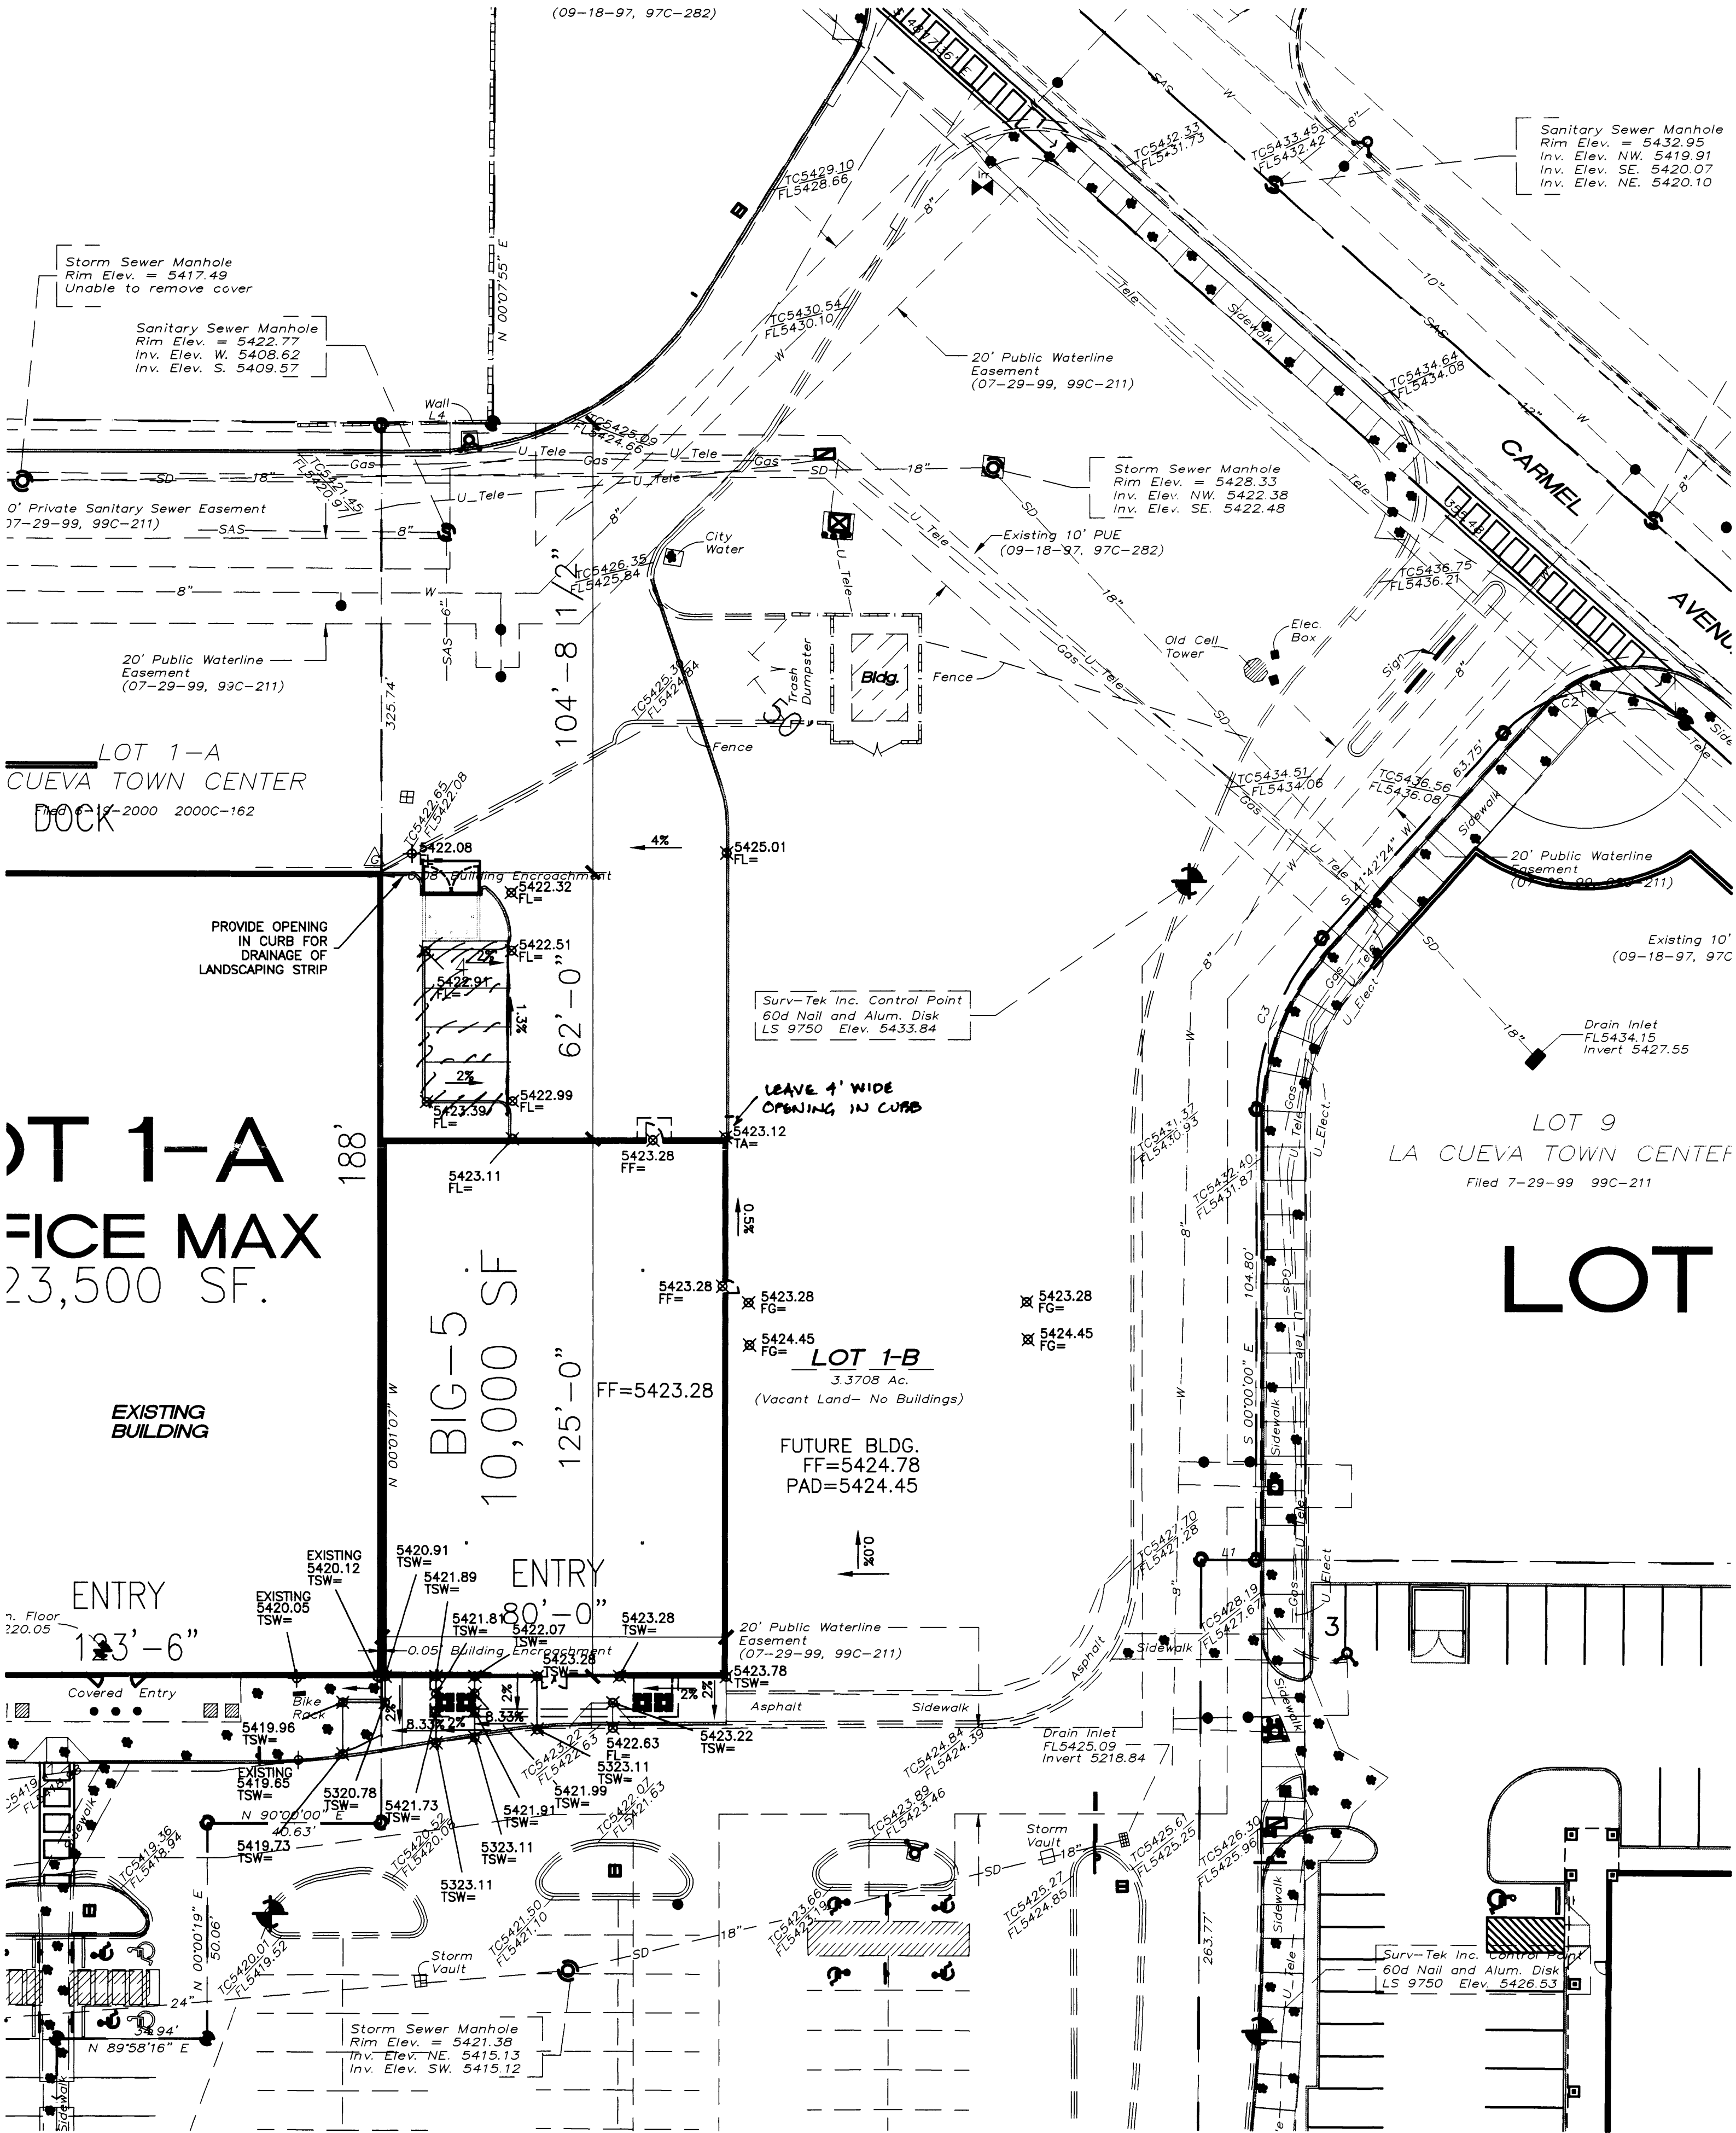

A3 SITE GRADING AND DRAINAGE PLAN
SCALE: 1"=20'
GRAPHIC SCALE
(IN FEET)
1 inch = 20 ft.

REV	DATE	BY	REVISION

GEORGE RAINHART ARCHITECT AND ASSOCIATES PC
2325 SAN PEDRO N.E. SUITE 2-B
ALBUQUERQUE, NEW MEXICO 87110
PHONE (505) 884-9110
FAX (505) 837-9877

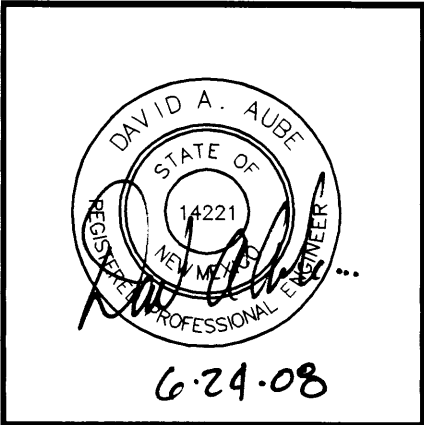

PROJECT TITLE BIG 5 LA CUEVA TOWN CENTER	PROJECT MANAGER	JOB NO.	DRAWN BY:
SHEET TITLE OVERALL SITE PLAN		sheet- CD.1 of-	

RECEIVED
DATE: 4.22.08
SCALE: 1"=20'
HYDROLOGY SECTION



I, Fred C. Arfman, NMPE No. 7322 of the firm Isaacson & Arfman, P.A. hereby certify that this project has been graded and will drain in substantial compliance with and in accordance with the design intent of the approved plan dated 04-28-09. The record information edited onto the original design document has been obtained by Russ Hugg, NMPS #9750 of the firm Surv-Tek. I further certify that I or a member of my firm under my direct supervision have visited the project site on 07-28-09 and have determined by visual inspection that the survey data provided is representative of actual site conditions and is true and correct to the best of my knowledge and belief. This certification is submitted in support of a request for permanent Certificate of Occupancy.

AREAS OF MODIFICATION BETWEEN APPROVED DRAINAGE GRADING PLAN AND ACTUAL AS-BUILT


- ▲ Curb opening not constructed. 4" pipe added to pass minor flow south within landscaping. OK
- ▲ No repaving this area.

The record information presented hereon is not necessarily complete and intended only to verify substantial compliance of the grading and drainage aspects of this project. Those relying on this record document are advised to obtain independent verification of its accuracy before using it for any other purpose.

Fred C. Arfman 07/31/09
FRED C. ARFMAN, NMPE #7322 DATE

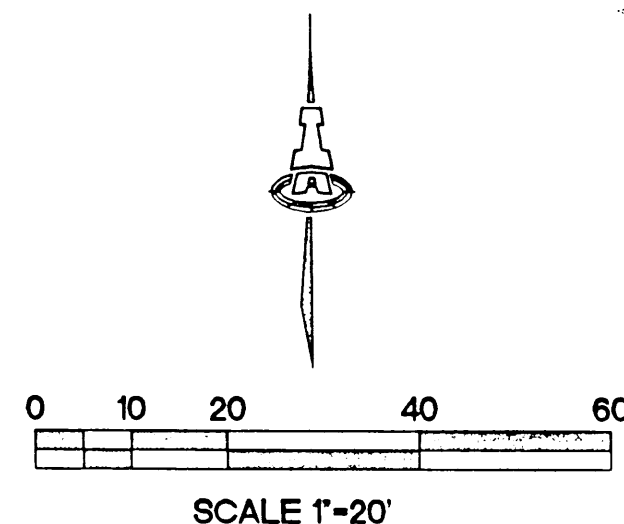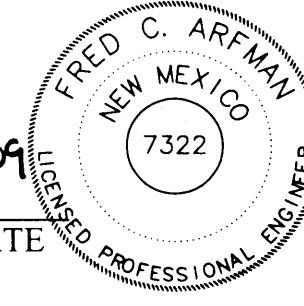


ENLARGED GRADES AT ACCESSIBLE RAMP AND PARKING

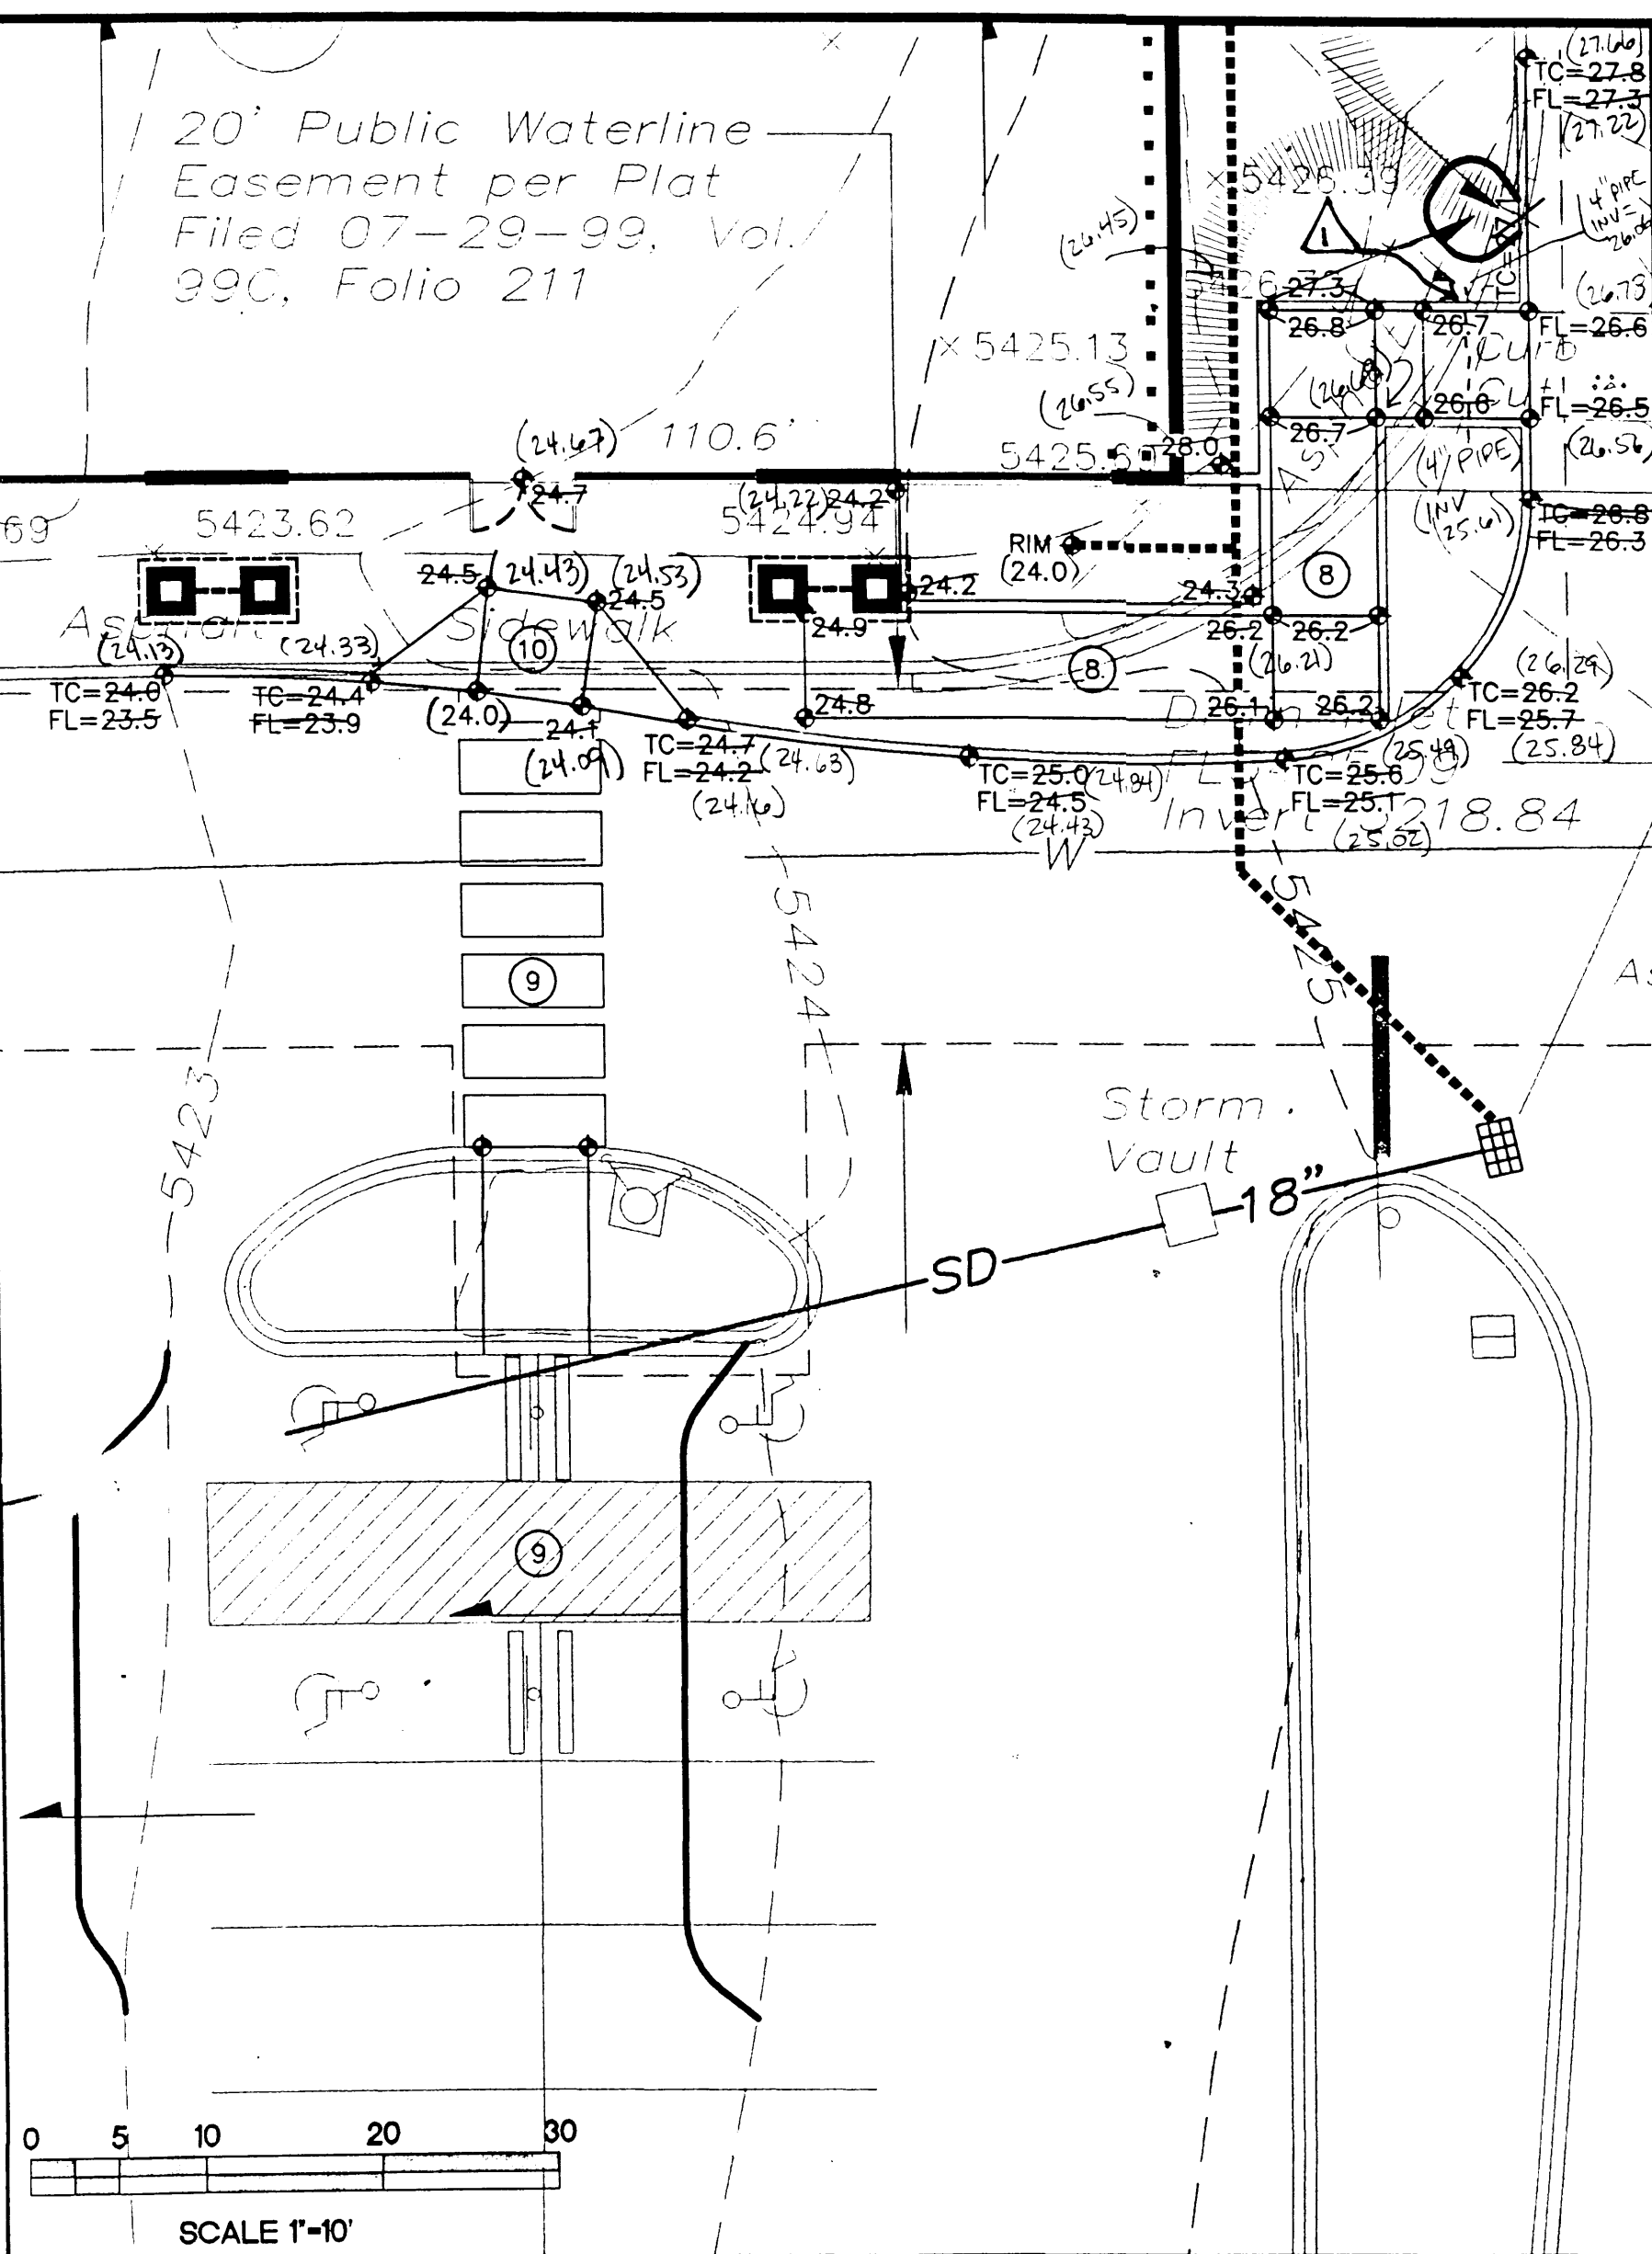

LOT 1-B

3.3708 ACRES
(146,939 SQUARE FEET)
(VACANT LAND- NO BUILDINGS)

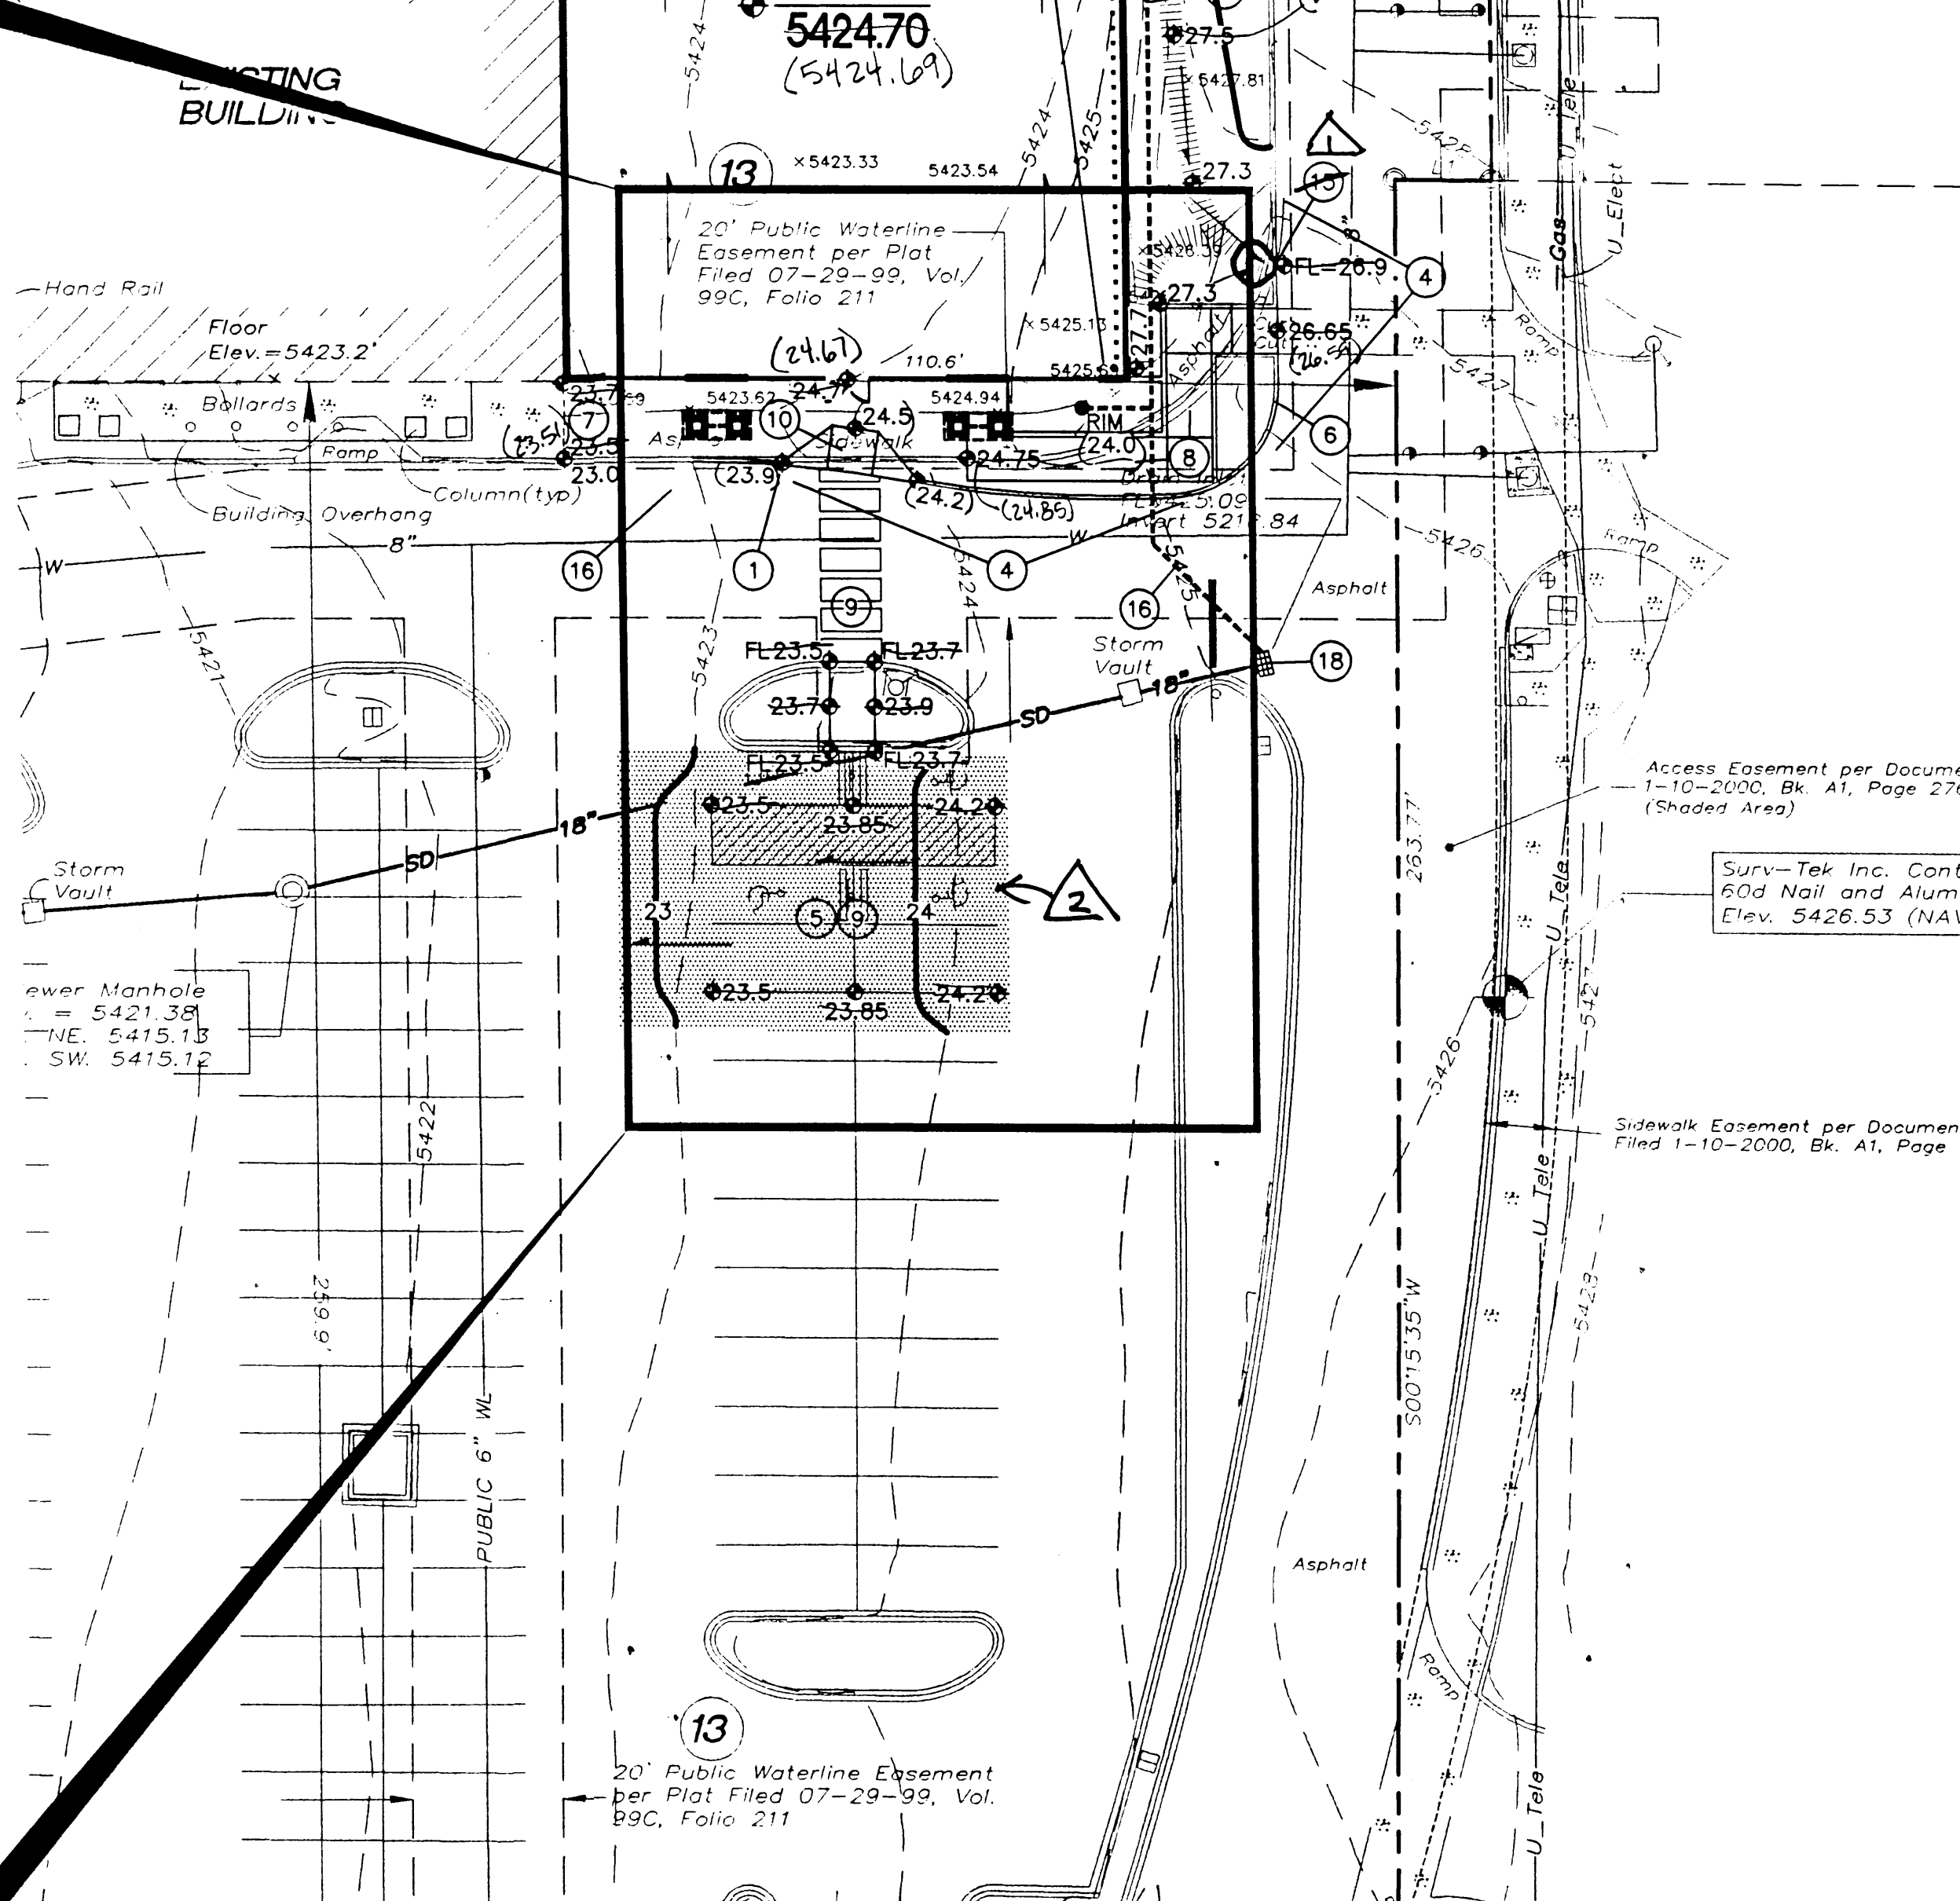

GENERAL NOTES

- COORDINATE WORK WITH SITE PLAN, UTILITY PLAN, DEMOLITION PLAN, AND LANDSCAPE PLAN.
- ALL TRASH, DEBRIS, & SURFACE VEGETATION SHALL BE CLEARED AND LEGALLY DISPOSED OF OFFSITE.
- FINAL GRADES SHOWN REPRESENT TOP OF FINISH MATERIAL (I.E. TOP OF CONCRETE, TOP OF CONCRETE BUILDING PAD, TOP OF PAVEMENT MATERIAL, TOP OF LANDSCAPING MATERIAL, ETC.). CONTRACTOR SHALL GRADE, COMPACT SUBGRADE AND DETERMINE EARTHWORK ESTIMATES BASED ON ELEVATIONS SHOWN MINUS FINISH MATERIAL THICKNESSES.
- MAXIMUM SLOPES SHALL BE 3:1. MINIMUM SLOPES SHALL BE 1% UNLESS OTHERWISE NOTED.
- EXISTING UTILITY LINES ARE SHOWN IN AN APPROXIMATE MANNER ONLY AND MAY BE INCOMPLETE OR OBSOLETE. SUCH LINES MAY OR MAY NOT EXIST WHERE SHOWN OR NOT SHOWN. ALL UTILITIES SHOULD BE FIELD VERIFIED AND LOCATED BY THE CONTRACTOR PRIOR TO COMMENCEMENT OF ANY CONSTRUCTION. THE CONTRACTOR IS FULLY RESPONSIBLE FOR ANY AND ALL DAMAGE CAUSED BY ITS FAILURE TO LOCATE, IDENTIFY AND PRESERVE ANY AND ALL EXISTING UTILITIES, PIPELINES, AND UNDERGROUND UTILITY LINES.
- ADJUST RIMS OF EXISTING UTILITY FEATURES AS NECESSARY TO MATCH NEW GRADES, TYPICAL.
- ALL NEW PAVEMENT SURFACES SHALL BE CONSTRUCTED WITH POSITIVE SLOPE AWAY FROM BUILDING AND POSITIVE SLOPE TOWARD EXISTING AND/OR PROPOSED DRAINAGE PATHS. WHERE NEW GRADES ARE SHOWN AS 'MATCH' OR 'A', TRANSITIONS SHALL BE SMOOTH AND LEVEL.
- ALL FRACTURED FACE ROCK (F.F. ROCK) TO BE 3" TO 6" DIA. ANGULAR FACED ROCK PLACED OVER GEOTEX 50 NON-WOVEN GEOTEXTILE (O.E.).
- OWNER SHALL MAINTAIN EROSION PROTECTION ELEMENTS. OWNER SHALL INSPECT SITE YEARLY AND AFTER EACH RAINFALL TO IDENTIFY NEW AREAS OF EROSION AND INSTALL ADDITIONAL EROSION PROTECTION AS NEEDED BASED ON ACTUAL OCCURRENCES.

PROJECT DATA

PROPERTY: THE SITE IS A DEVELOPED PROPERTY LOCATED WITHIN C.O.A. VICINITY MAP C-19. THE SITE IS BOUND TO THE NORTH, SOUTH, EAST AND WEST BY DEVELOPED COMMERCIAL PROPERTY.

PROPOSED IMPROVEMENTS: THE PROPOSED IMPROVEMENTS INCLUDE A 9,180 SF DOLLAR TREE RETAIL STORE WITH ASSOCIATED WALKS, ASPHALT PAVEMENT AND LANDSCAPING.

LEGAL: LOT NUMBERED ONE-B, LA CUEVA TOWN CENTER, ALBUQUERQUE, BERNALILLO COUNTY, NEW MEXICO

ADDRESS: 8200 WYOMING BLVD. N.E.

SURVEYOR: RUSS P. HUGG NMPS 9750, SURV-TEK INC. 9384 VALLEY VIEW DRIVE, N.W. ALBUQUERQUE, NEW MEXICO 87114. PHONE: 505-897-3366

BENCHMARK: COA "9-C19", ELEVATION = 5435.665 (NAVD88) AN ALUMINUM DISK, STAMPED "ACS BM, 9-C19", EPOXYED TO TOP OF CONCRETE CURB, NORTH SIDE OF PASEO DEL NORTE NE., ON THE WEST SIDE OF ENTRANCE TO THE W.A. WEBSTER WELL NO. 1 SITE.

TEMPORARY BENCHMARK: SURV-TEK INC. CONTROL POINT 60D NAIL AND ALUM. DISK "LS 9750" ELEV. 5433.84 (NAVD88)

OFF-SITE: NO OFF-SITE DRAINAGE AFFECTS THIS PROPERTY.


FLOOD HAZARD: PER BERNALILLO COUNTY FIRM MAP #108, THE SITE IS LOCATED WITHIN FLOODZONE "X" DESIGNATED AS AREAS DETERMINED TO BE OUTSIDE 500-YEAR FLOODPLAIN.

DRAINAGE CONCEPT: A PRIVATE STORM DRAIN SYSTEM WILL BE INSTALLED TO COLLECT THE MAJORITY OF ON-SITE RUNOFF AND ROUTE TO THE EXISTING PRIVATE STORM DRAIN INLET AT THE SOUTHEAST SIDE OF THE BUILDING. RUNOFF IS THEN CARRIED WEST WITHIN THE SHOPPING CENTER STORM DRAIN SYSTEM AND RELEASED TO THE PUBLIC STORM DRAIN SYSTEM AT THE CORNER OF WYOMING BLVD. AND CARMEL AVE. NE. FREE DISCHARGE IS APPROPRIATE FOR THE SITE AS PROVIDED IN THE MASTER DRAINAGE AND GRADING PLAN.

LEGEND

- EXISTING CONTOUR
- PROPOSED CONTOUR
- ◆ 24.5 PROPOSED SPOT ELEVATION
- FLOW ARROW
- FF = 5424.7 FINISH FLOOR ELEVATION
- TC TOP OF CURB
- FL FLOWLINE
- INV INVERT
- TW TOP OF WALL
- (24.5) AS BUILT SPOT ELEVATION

VICINITY MAP

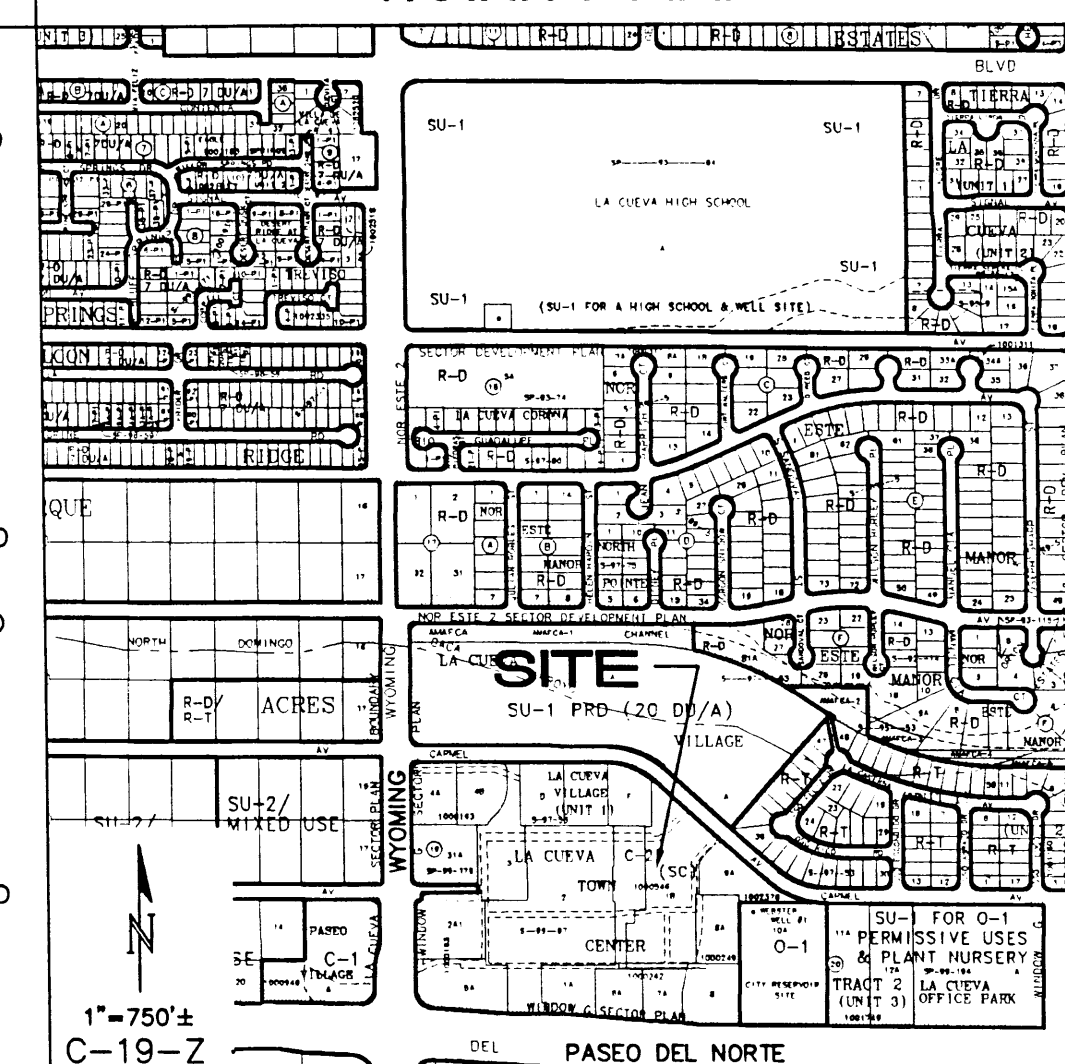

KEYED NOTES

- SPOT ELEVATIONS WITHIN FLOWLINE AREA REPRESENT FLOWLINE UNLESS NOTED. ADD 0.5' TYPICAL FOR TOP OF CURB AND TOP OF ADJACENT WALK ELEVATIONS.
- EXTENDED STEMWALL REQUIRED THIS AREA. SEE STRUCTURAL.
- RETAINING STEMWALL REQUIRED THIS AREA. SEE STRUCTURAL.
- SAWCUT EXISTING AS REQUIRED TO PROVIDE CLEAN BONDING EDGE AND SMOOTH GRADE TRANSITION. MATCH EXISTING TOP OF WALK * ASPHALT * CONCRETE CURB AND GUTTER FOR SMOOTH TRANSITION.
- CONSTRUCT ASPHALT PAVING AT ELEVATIONS SHOWN. SEE SITE PLAN FOR LAYOUT.
- CONSTRUCT MEDIAN CURB AND GUTTER AT ALL CURB LOCATIONS UNLESS NOTED OTHERWISE.
- CONSTRUCT CONCRETE WALK AT ELEVATIONS SHOWN. MAXIMUM SLOPE = 5% TYPICAL. MAXIMUM CROSS-SLOPE = 2% TYPICAL.
- CONSTRUCT 12:1 ACCESS RAMP AT ELEVATIONS SHOWN. SEE ENLARGED PLAN FOR ADDITIONAL GRADES. SEE ARCHITECTURAL FOR DETAILS.
- REMOVE AND REPLACE ASPHALT WITHIN HANDICAP SPACES TO MEET ADA REQUIREMENTS. MAX. SLOPE = 2% IN ANY DIRECTION. PROVIDE SMOOTH TRANSITION TO EXISTING ALL SIDES.
- CONSTRUCT 12:1 HANDICAP ACCESS RAMP.
- CONSTRUCT CONCRETE LANDING. TOP OF ADJACENT ASPHALT TO BE FLUSH WITH TOP OF CONCRETE LANDING.
- PROVIDE SLOPE WITHIN NEW ASPHALT AT SLOPES AND ELEVATIONS SHOWN TO DIRECT RUNOFF TO STORM DRAIN INLET #1 (MIN. 1% SLOPE). PROVIDE 6" SUMP AT INLET AS SHOWN.
- NOT USED.
- NOT USED.
- PROVIDE 24" WIDE OPENING IN CURB TO PASS FLOW TO PAVEMENT.
- INSTALL STORM DRAIN SYSTEM. SEE CG-102 FOR SIZES * SLOPES * INLET INFORMATION.
- BUILDING ROOF DISCHARGE TO BE RELEASED TO PAVEMENT AT GRADE VIA DOWNSPOUTS (SEE ARCHITECTURAL FOR SPECIFIC LOCATIONS).
- EXISTING STORM DRAIN INLET. CONTRACTOR TO CLEAN EXISTING STORM DRAINS TO REESTABLISH FULL FUNCTION.
- EXISTING CONCRETE DUMPSER PAD AND ENCLOSURE.
- INSTALL 3' WIDE FRACTURED FACE ROCK SWALE TO DIRECT CONCENTRATED RUNOFF. SEE GENERAL NOTE H.
- TRANSITION ASPHALT SLOPE PAVEMENT THIS AREA FROM FLUSH WITH NEW CONCRETE APRON TO SMOOTH TRANSITION AT EXISTING.

ISAACSON & ARFMAN, P.A.
Consulting Engineering Associates
128 Monroe Street N.E.
Albuquerque, New Mexico 87108
Ph. 505-268-8828 Fax. 505-268-2632
1715 CG-101.dwg Apr 27, 2009


This design, calculations, and concepts are owned by and remain the property of Isaacson & Arfman, P.A. and no part thereof shall be utilized by any person, firm or corporation for any purpose whatsoever except with the written permission of Isaacson & Arfman, P.A. ©

DOLLAR TREE
8200 WYOMING N.E.

REID AND ASSOCIATES

GRADING AND DRAINAGE PLAN

Date:	No.	Revision	Date:	Job No.
04/28/09				1715
Drawn By:				CG-101
BJB				
Ckd By:				SH. OF
FCA				

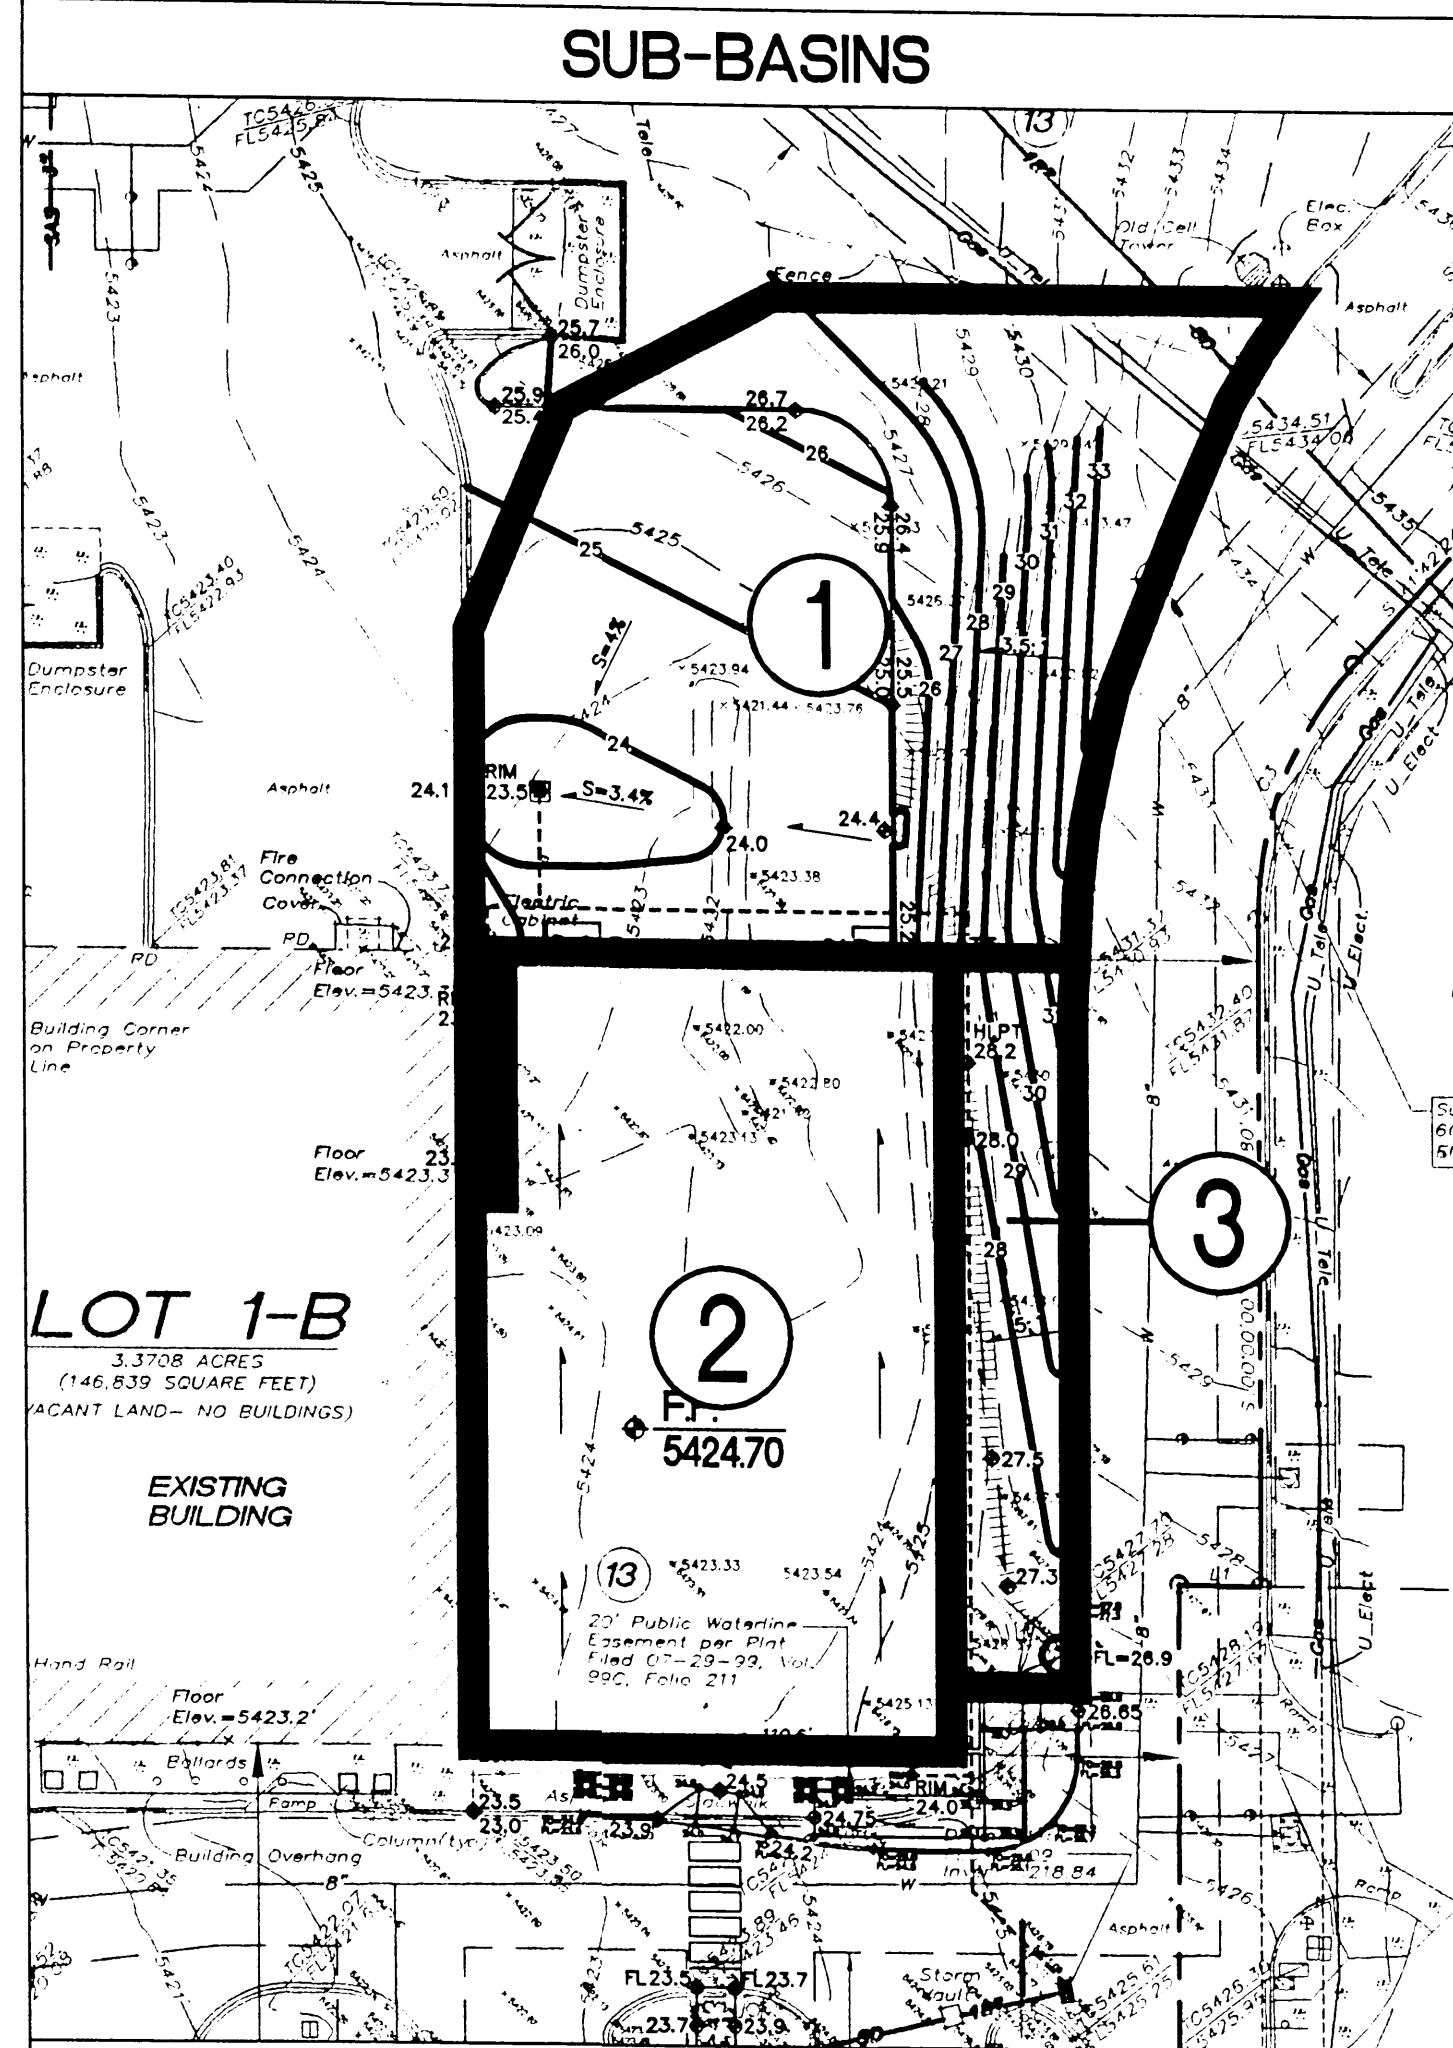

CALCULATIONS

CALCULATIONS: 1715 - Dollar Tree : 4-22-2009
Based on Drainage Design Criteria for City of Albuquerque Section 22.2, DPM, Vol 2, dated Jan., 1993

ON-SITE			
AREA OF SITE: PORTION TO BE DEVELOPED	21885	SF	= 0.5

HISTORIC FLOWS:		DEVELOPED FLOWS:		EXCESS PRECIP:	
Treatment SF	%	Treatment SF	%	Precip Zone	
Area A = 0	0%	Area A = 0	0%	E _A = 0.66	
Area B = 13131	60%	Area B = 2189	10%	E _B = 0.92	
Area C = 6565.5	30%	Area C = 4377	20%	E _C = 1.29	
Area D = 2188.5	10%	Area D = 15320	70%	E _D = 2.36	
Total Area = 21885	100%	Total Area = 21885	100%		

On-Site Weighted Excess Precipitation (100-Year, 6-Hour Storm)

$$\text{Weighted } E = \frac{E_A A_A + E_B A_B + E_C A_C + E_D A_D}{A_A + A_B + A_C + A_D}$$

Historic E	=	1.18 in.	Developed E	=	2.00 in.
------------	---	----------	-------------	---	----------

On-Site Volume of Runoff: $V_{360} =$		$E \cdot A / 12$			
Historic V_{360}	=	2143 CF	Developed V_{360}	=	3651 CF


On-Site Peak Discharge Rate: Q_p = Q_{pA} A_A + Q_{pB} A_B + Q_{pC} A_C + Q_{pD} A_D / 43.560

For Precipitation Zone 3

Q _{pA}	=	1.87	Q _{pC}	=	3.45
Q _{pB}	=	2.60	Q _{pD}	=	5.02
Historic Q _p	=	1.6 CFS	Developed Q _p	=	2.2 CFS


BASIN NO.	1	DESCRIPTION
Area of basin flows =	10465	SF
The following calculations are based on Treatment areas as shown in table to the right		
Sub-basin Weighted Excess Precipitation (see formula above)		LAND TREATMENT
Weighted E	=	1.91 in.
Sub-basin Volume of Runoff (see formula above)		
V ₃₆₀	=	1653 CF
Sub-basin Peak Discharge Rate (see formula above)		
Q _p	=	1.0 cfs
BASIN NO.	2	DESCRIPTION
Area of basin flows =	9188	SF
The following calculations are based on Treatment areas as shown in table to the right		
Sub-basin Weighted Excess Precipitation (see formula above)		LAND TREATMENT
Weighted E	=	2.36 in.
Sub-basin Volume of Runoff (see formula above)		
V ₃₆₀	=	1807 CF
Sub-basin Peak Discharge Rate (see formula above)		
Q _p	=	1.1 cfs
BASIN NO.	3	DESCRIPTION
Area of basin flows =	2232	SF
The following calculations are based on Treatment areas as shown in table to the right		
Sub-basin Weighted Excess Precipitation (see formula above)		LAND TREATMENT
Weighted E	=	1.47 in.
Sub-basin Volume of Runoff (see formula above)		
V ₃₆₀	=	272 CF
Sub-basin Peak Discharge Rate (see formula above)		
Q _p	=	0.2 cfs

MEDIAN CURB AND GUTTER


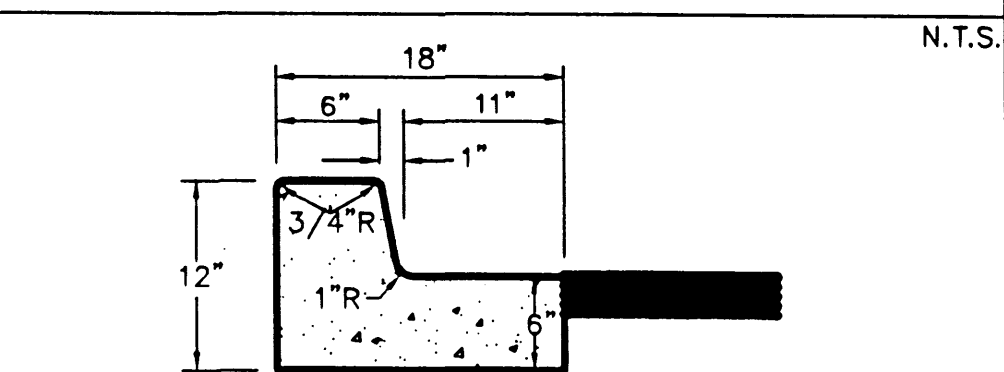


- GENERAL NOTES**
1. PROVIDE CONST. CONTROL JOINTS @ 6' O.C. MAX. AND 1/2" EXPANSION JOINTS @ 48' O.C. MAX
 2. EDGES SHOULD BE REMOVED WITH 3/8" EDGING TOOL
 3. MEDIAN C & G REQUIRE FULL FORM ON ALL FACES

IN-LINE DRAINS

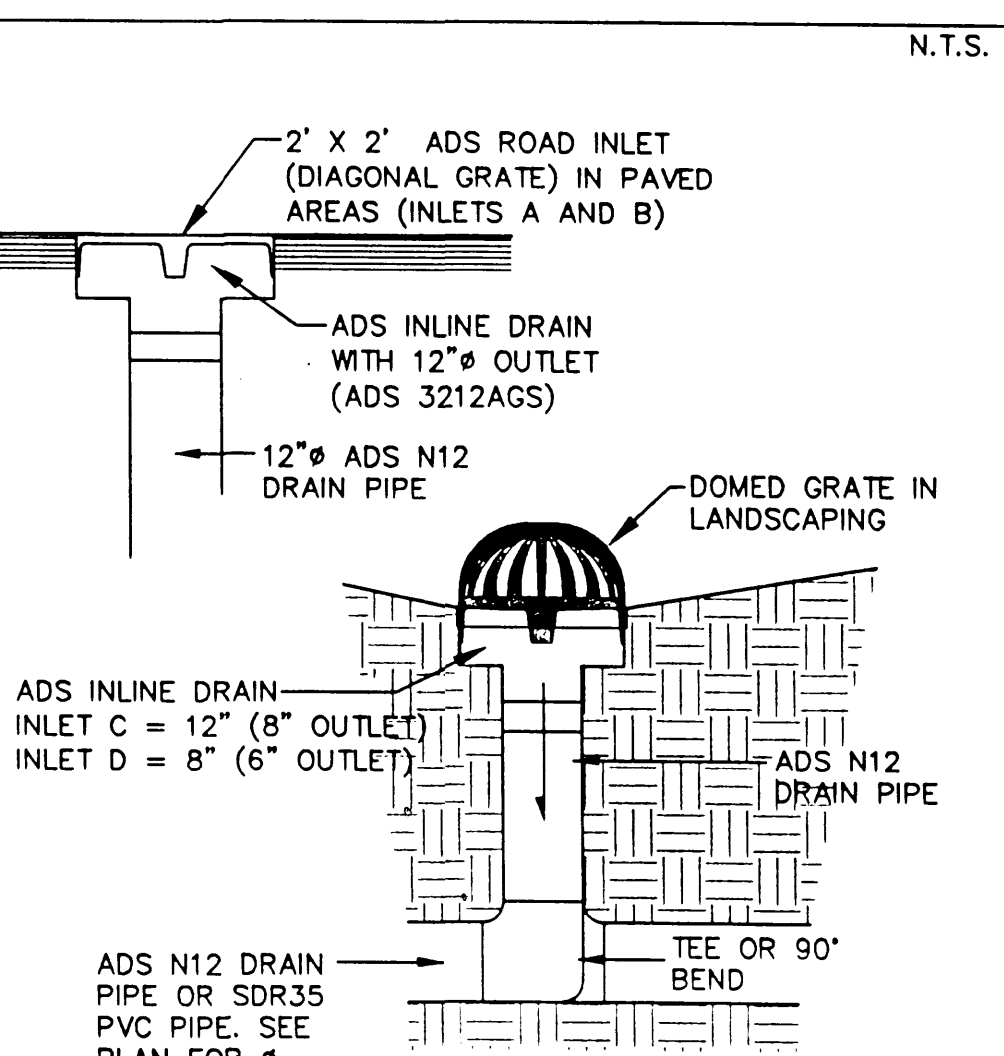

COBBLE SWALE

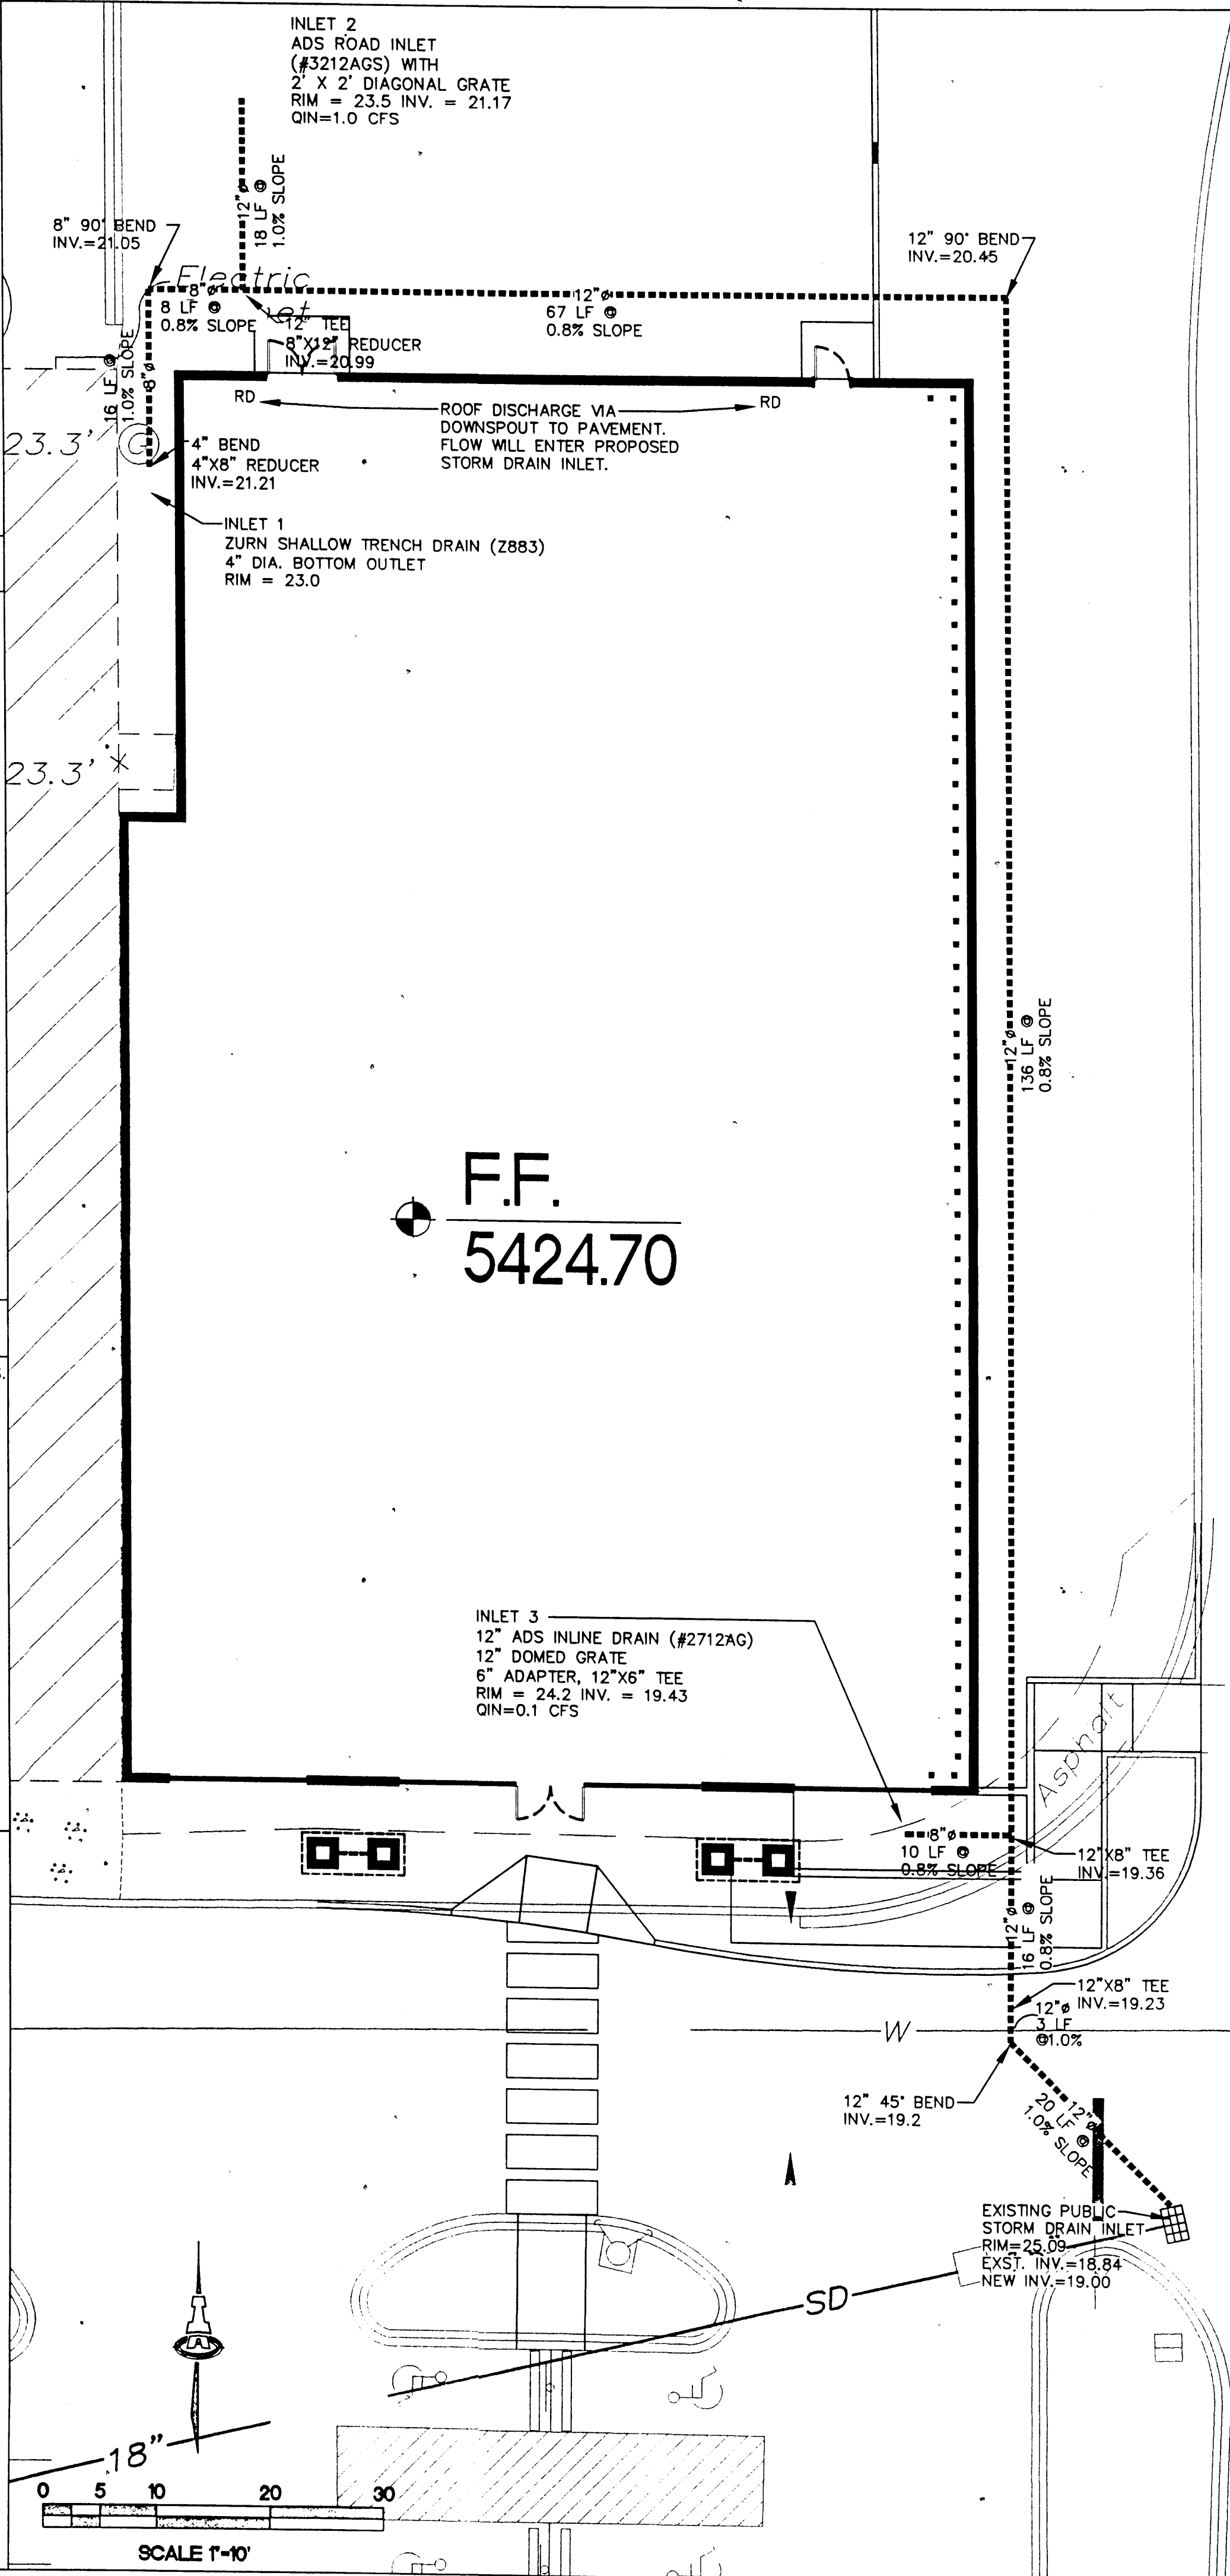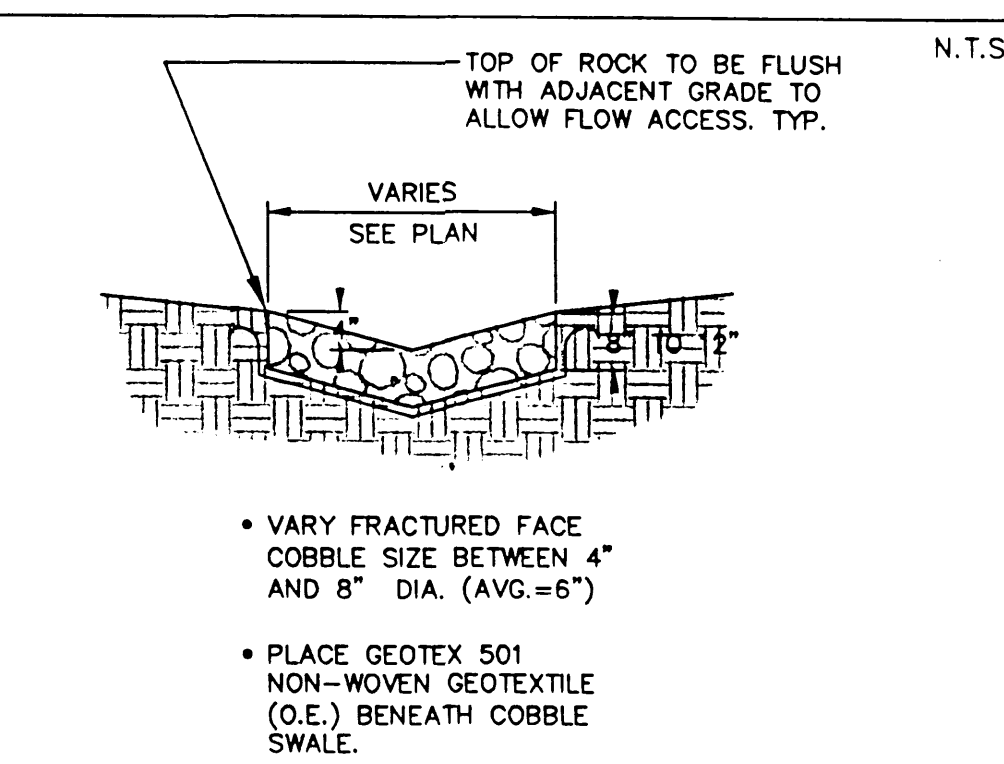

STORM DRAIN NOTES

- A. EACH PROPOSED INLET TO CONSIST OF AN ADS NYLOPLAST INLINE DRAIN WITH OUTLET (SEE PLAN FOR SIZES) WITH DOME GRATE INSTALLED IN LANDSCAPED AREA(S) AND PEDESTRIAN GRATE IN PAVEMENT. EXTEND ADS N12WT (WATERTIGHT) PIPE AND CONNECT TO PROPOSED STORM DRAIN MAIN LINE USING ADS N12WT (WT=WATERTIGHT) TEES AND BENDS.
- B. ALL STORM DRAIN LINES AND FITTINGS TO BE ADS N-12WT WATERTIGHT O.A.E.
- C. STORM DRAIN SYSTEM WILL REQUIRE REGULAR MAINTENANCE TO ENSURE PROPER FUNCTIONING DURING STORM EVENTS. IT IS RECOMMENDED THAT PROPERTY OWNER PUT IN PLACE INSPECTION AND MAINTENANCE CRITERIA SCHEDULED TO OCCUR MONTHLY AND AFTER EACH STORM EVENT.

ISAACSON & ARFMAN, P.A.
Consulting Engineering Associates
128 Monroe Street N.E.
Albuquerque, New Mexico 87108
Ph. 505-268-8828 Fax. 505-268-2632
1715 CG-101.dwg Apr. 27, 2009

DOLLAR TREE
8200 WYOMING N.E.
REID AND ASSOCIATES

GRADING AND DRAINAGE DETAILS

Date:	No. / Revision	Date	Job No.
04/28/09			1715
Drawn By:			CG-102
BJB			
Chk By:			SH. OF
FCA			