

NOTES

**Desert Lane Subdivision
DRAINAGE CERTIFICATION**

I, Diane Hoelzer, NMPE 11987, of the firm Mark Goodwin & Associates, hereby certify that this project has been graded and will drain in substantial compliance with the standards and in accordance with the design intent of the approved plan dated 8-8-92. The relevant information edited onto the original design document has been entered by Tom Aldrich, NMPS 7719, of the firm Aldrich Land Surveying. I further certify that I have personally visited the project site on 5/1/03, and have determined by visual inspection that the survey data provided is representative of actual site conditions and is true and correct to the best of my knowledge and belief. This certification is submitted in support of a request for Release of Financial Guarantees.

The record information presented hereon is not necessarily complete and intended only to verify substantial compliance of the grading and drainage aspects of this project. Those relying on this record document are advised to obtain independent verification of its accuracy before using it for any other purpose.

Dane Hoeger


Date May 7, 2003



VICINITY MAP ZONE MAP: C-19-Z

UNIT 1
VISTA DEL AGUILA

UNIT 2
VISTA DEL AGUILA
PROJECT No. 650681
(UNDER CONSTRUCTION)

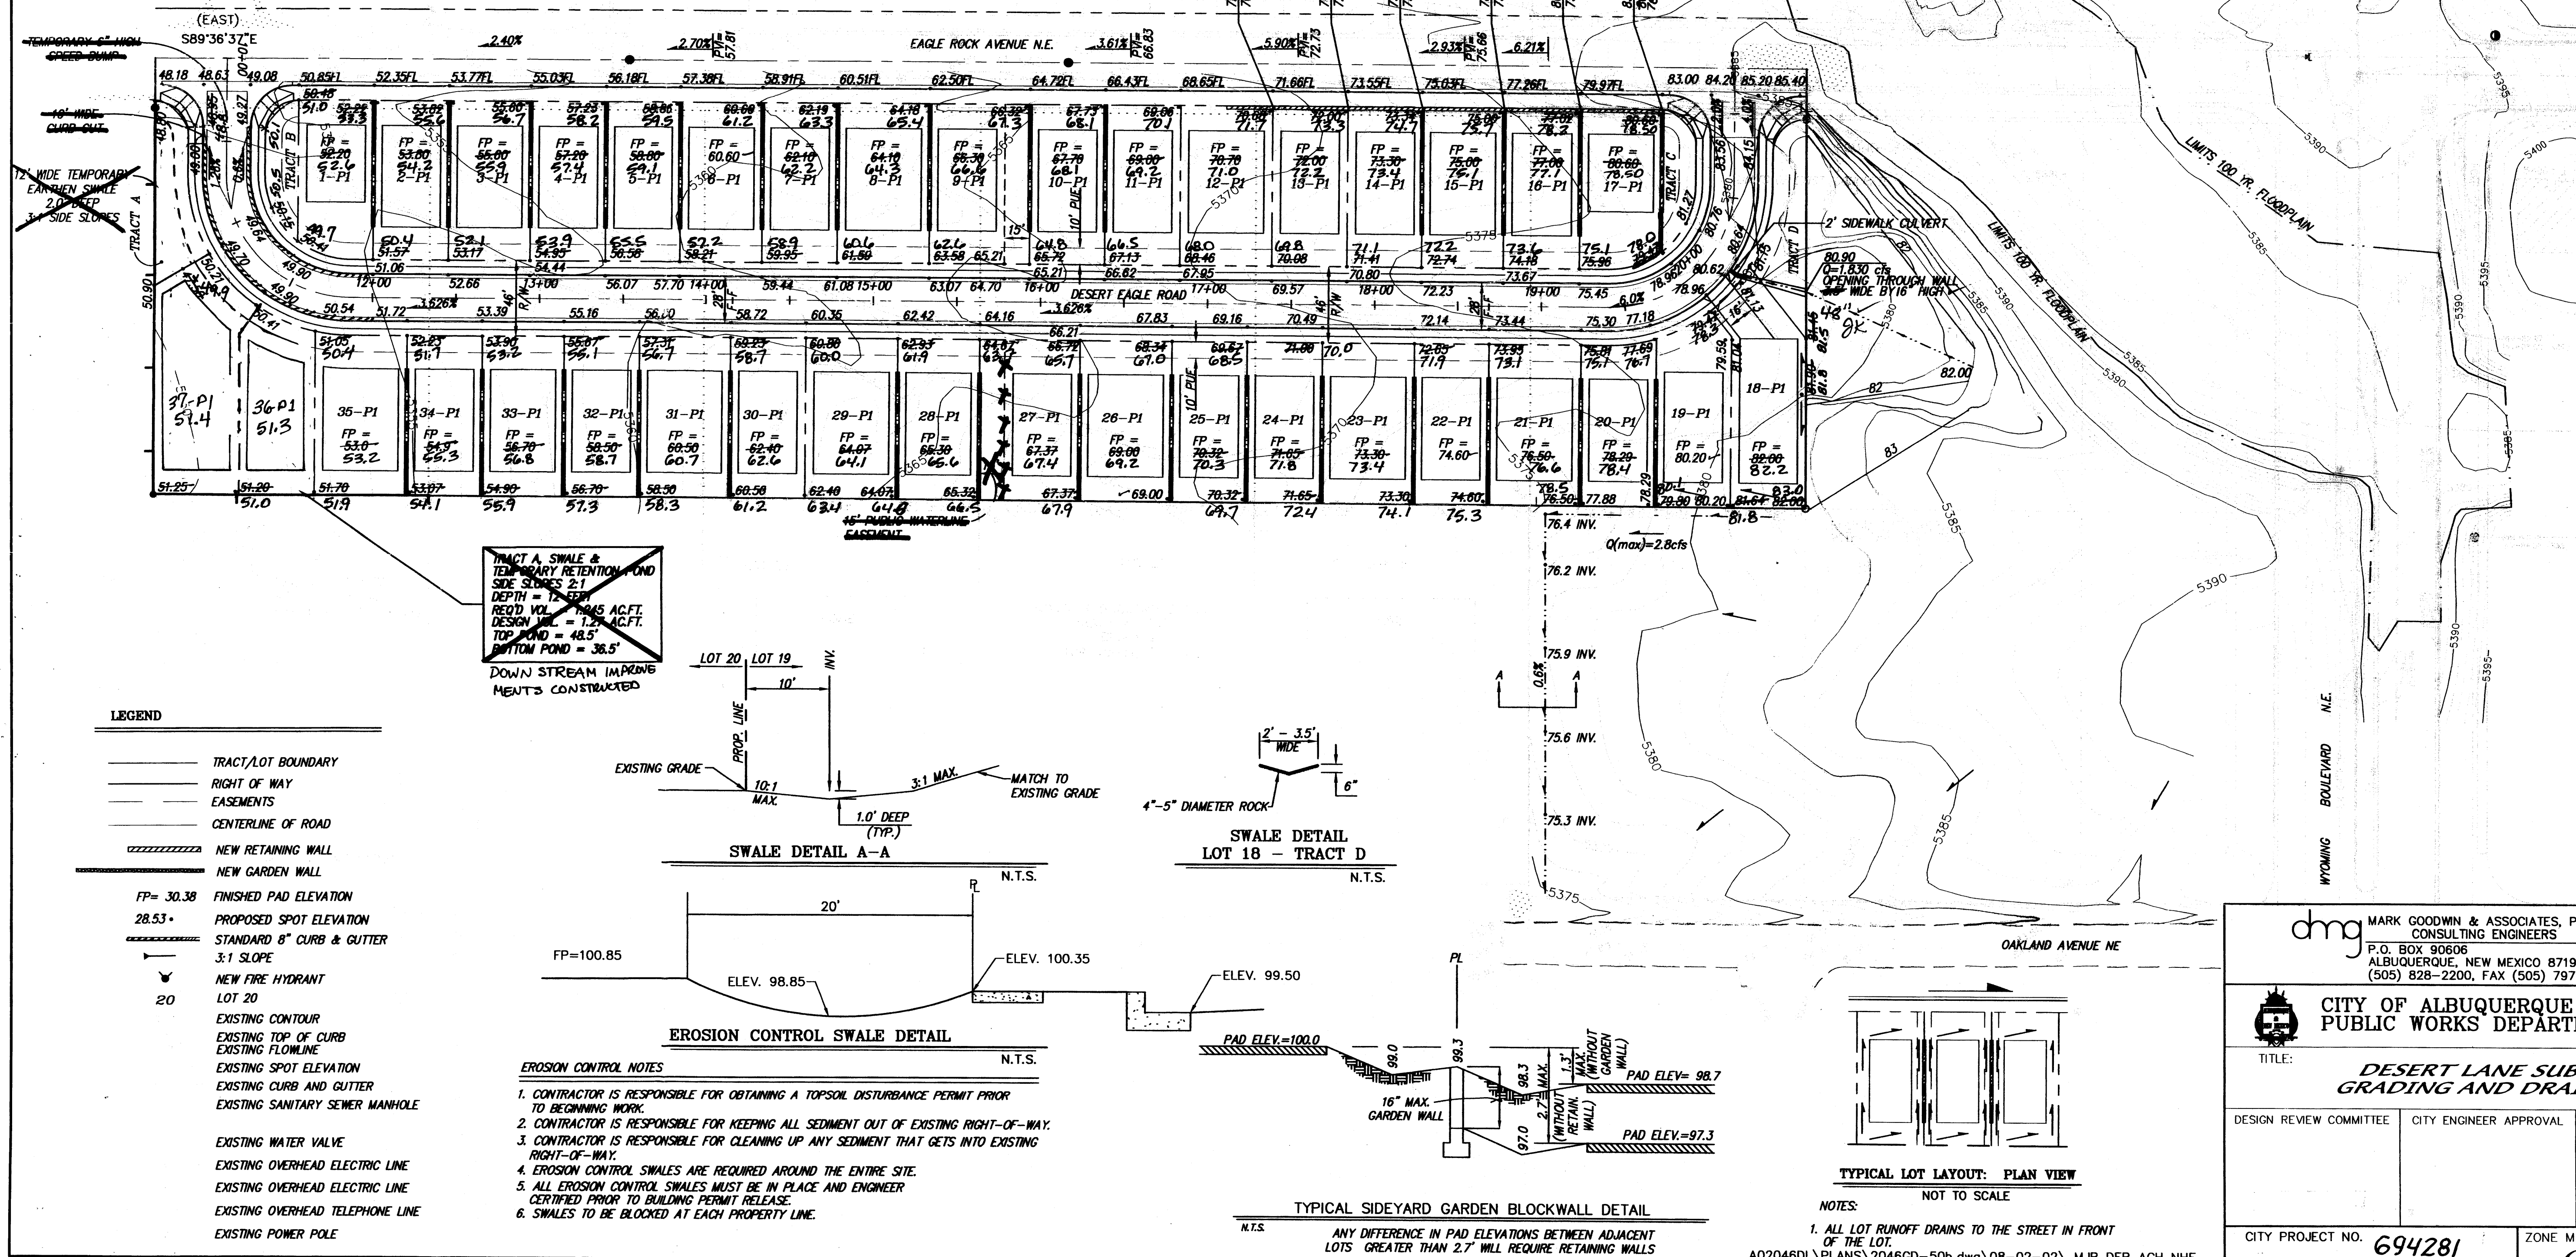


Brad L. Bingham 8-7-08
CITY HYDROLOGY APPROVAL DATE

John P. Kelly 8-7-02
A.M.A.F.C.A. APPROVAL DATE

ADIL RIZVI 8-5-02

ADIL RIZVI
(LOT 19, TRACT 2, UNIT 3, BLOCK 2,
NORTH ALBUQUERQUE ACRES)

SURVEY INFORMATION			BENCH MARKS		AS BUILT INFORMATION		
NO.	BY	DATE	FIELD NOTES		CONTRACTOR	WORK STATED BY	DATE
			"1-B20", THE STATION IS LOCATED 9 MILES N. E. OF DOWNTOWN ALBUQUERQUE. TO REACH THE STATION FROM THE INTERSECTION OF LOUISIANA BLVD. AND LOS ANGELES DR., GO EAST ON LOS ANGELES OR 1.0 MILE TO BARSTOW ST.; THEN NORTH ON BARSTOW ST., 1.0 MILE TO MODESTO AVE. THE STA. IS LOCATED IN THE N.E. QUADRANT STATION MARK IS A STANDARD ACS BRASS TABLET, STAMPED "1-B20" X = 410,237.56, Y = 1,524,082.46; G-G = .99864740 DELTA ALPHA = 010°23' CENTRAL ZONE. (NAD 1927) ELEVATION = 5424.510' (SD 1920)				
						INSPECTOR'S FIELD VERIFICATION BY	DATE
						CORRECTED BY	DATE
					MICRO-FILM INFORMATION		
						RECORDED BY	DATE
						NO.	

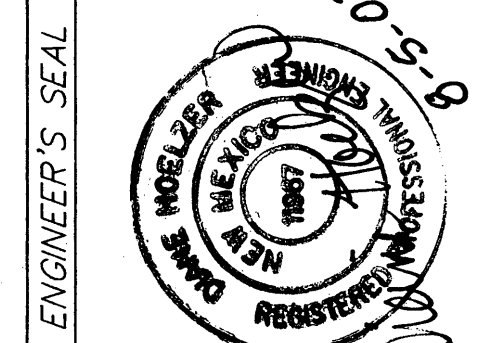

DESIGN		REVISIONS		BY
DESIGNED BY	DATE	NO.	DATE	REMARKS
DLH	06/02			
MJR	06/02			
CMS	06/02			

dmg MARK GOODWIN & ASSOCIATES, P.A.
CONSULTING ENGINEERS
P.O. BOX 90606
ALBUQUERQUE, NEW MEXICO 87199
(505) 828-2200 FAX (505) 707-0530



CITY OF ALBUQUERQUE
PUBLIC WORKS DEPARTMENT

TITLE: **DESERT LANE SUBDIVISION
GRADING AND DRAINAGE PLAN**

DESIGN REVIEW COMMITTEE	CITY ENGINEER APPROVAL	LAST DESIGN UPDATE	MO./DAY/YR.	MO./DAY/YR.
CITY PROJECT NO.	694281	ZONE MAP NO.	SHEET	OF