

REQUEST FOR LETTER OF MAP REVISION
NORTH DOMINGO BACA PARK

REQUEST FOR LETTER OF MAP REVISION
TO FIRM PANEL 35001C0141G & 35001C0137H

PREPARED FOR:



FEMA



PREPARED BY:

HUITT-ZOLIARS

333 RIO RANCHO BLVD., SUITE 101
RIO RANCHO, NEW MEXICO 87124

MAY 2025

HZI Project R312254.01

City of Albuquerque
Planning Department
Development Review Services
HYDROLOGY SECTION
APPROVED

DATE: 8/21/2025
BY: *Quetta M. [Signature]*
HydroTrans # C19D043E

THE APPROVAL OF THESE PLANS/REPORTS SHALL NOT BE CONSTRUED TO PERMIT VIOLATIONS OF ANY CITY ORDINANCE OR STATE LAW, AND SHALL NOT PREVENT THE CITY OF ALBUQUERQUE FROM REQUIRING CORRECTIONS FOR ERRORS OR DIMENSIONS IN PLANS, SPECIFICATIONS, OR CONSTRUCTION DOCUMENTS. SUCH APPROVED PLANS/REPORTS SHALL NOT BE CHANGED, MODIFIED OR ALTERED WITHOUT AUTHORIZATION.

THE APPROVAL OF THESE PLANS/REPORTS SHALL EXPIRE TWO (2) YEARS AFTER THE APPROVAL DATE IF NO BUILDING PERMIT HAS BEEN PULLED ON THE DEVELOPMENT.

Request for Letter of Map Revision North Domingo Baca Park

I, Nina Leung-Villa, being first duly sworn upon my oath, state that I am a registered professional engineer, qualified in civil engineering and that the accompanying report was prepared by me or under my supervision and is true and correct to the best of my knowledge and belief.



Nina Leung-Villa
May 12, 2025

**REQUEST FOR LETTER OF MAP REVISION
NORTH DOMINGO BACA PARK**

TABLE OF CONTENTS

	<u>ITEM</u>
Description of the Revision	1
FEMA, MT-2 Form 1	2
FEMA, MT-2 Form 2	3
Culvert Analysis (HEC-RAS Output, Upstream Channel)	4
National Flood Hazard Layer Firmette (Existing and Proposed)	5
References.....	6
NDB Park Phase 4 Construction – Box Culvert Record Drawings	7

Item 1

Description of the Revision

Item 1. Description of the Revision

The purpose of the request is to revise the current floodplain mapping for the North Domingo Baca (NDB) Park between Wyoming Blvd NE and Louisiana Blvd NE. The map revision references The FIS report numbered 35001CV001D. This report provides the 1-percent-annual-chance peak discharge for the North Arroyo de Domingo Baca flooding source at Wyoming Boulevard.

The NDB Pool Complex will be the next project to be constructed within the North Domingo Baca development. This will include an indoor and outdoor aquatic center for community engagement. The North Domingo Baca development is currently documented as being within flood zone AO (Depth 1'), however current conditions altered the flood zone and is constrained to a designated area in the development. This report is only providing current conditions in order to update FIRM panels 0141G and 0137H.

The drainage structure that was constructed to direct the stormwater is two 6'x10' box culverts from Wyoming Blvd to the Kinney Dam and acts as the current drainage device that directs the stormwater to the Kinney Dam. Refer to the "Construction Plans for North Domingo Baca Park Phase 4 Construction – Box Culvert", (Smith Engineering, 2005) for culvert details located in Appendix 7. Hydraulic analysis was completed utilizing the HEC-RAS application and indicates the current culvert is efficient and directs the stormwater to Kinney Dam appropriately. The current FEMA flood zone indicates the development is within flood zone AO (Depth 1') and needs to be updated to reflect that the entire development, not including Kinney Dam should not be in a flood zone. See Exhibit 5 for the updated flood zone area (Kinney Dam is the flood zone in the area and will remain zone AE (EL 5320)). For the existing Kinney Dam Design please refer to "Final Design Analysis Report for Lower North Domingo Baca Detention Dam (Resource Technology, Inc., 1995)"

Huitt-Zollars requests that FEMA revise the current Flood Insurance Rate Map of Albuquerque, NM to incorporate and reflect the current flood zone conditions FIRM panels 0141G & 0137H.

Item 2

**FEMA MT-2 Form 1
(OVERVIEW & CONCURRENCE FORM)**

DEPARTMENT OF HOMELAND SECURITY
Federal Emergency Management Agency
OVERVIEW & CONCURRENCE FORM

OMB Control Number: 1660-0016
Expiration: 1/31/2024

PAPERWORK BURDEN DISCLOSURE NOTICE

Public reporting burden for this form is estimated to average 1 hours per response. The burden estimate includes the time for reviewing instructions, searching existing data sources, gathering and maintaining the needed data, and completing, reviewing, and submitting the form. You are not required to respond to this collection of information unless it displays a valid OMB control number. Send comments regarding the accuracy of the burden estimate and any suggestions for reducing this burden to: Information Collections Management, Department of Homeland Security, Federal Emergency Management Agency, 500 C Street, SW, Washington, DC 20472 , Paperwork Reduction Project (1660-0016). Submission of the form is required to obtain or retain benefits under the National Flood Insurance Program. **Please do not send your completed survey to the above address.**

PRIVACY ACT STATEMENT

AUTHORITY: The National Flood Insurance Act of 1968, Public Law 90-448, as amended by the Flood Disaster Protection Act of 1973, Public Law 93-234.

PRINCIPAL PURPOSE(S): This information is being collected for the purpose of determining an applicant's eligibility to request changes to National Flood Insurance Program (NFIP) Flood Insurance Rate Maps (FIRM).

ROUTINE USE(S): The information on this form may be disclosed as generally permitted under 5 U.S.C § 552a(b) of the Privacy Act of 1974, as amended. This includes using this information as necessary and authorized by the routine uses published in DHS/FEMA/NFIP/LOMA-1 National Flood Insurance Program (NFIP); Letter of Map Amendment (LOMA) February 15, 2006, 71 FR 7990.

DISCLOSURE: The disclosure of information on this form is voluntary; however, failure to provide the information requested may delay or prevent FEMA from processing a determination regarding a requested change to a (NFIP) Flood Insurance Rate Maps (FIRM).

A. REQUESTED RESPONSE FROM DHS-FEMA

This request is for a (check one):

- CLOMR: A letter from DHS-FEMA commenting on whether a proposed project, if built as proposed, would justify a map revision or proposed hydrology changes (See 44 CFR Ch. 1, Parts 60, 65 & 72). All CLOMRs require documentation of compliance with the Endangered Species Act. Refer to the Instructions for details.
- LOMR: A letter from DHS-FEMA officially revising the current NFIP map to show the changes to floodplains, regulatory floodway or flood elevations. (See 44 CFR Ch. 1, Parts 60, 65 & 72).

B. OVERVIEW

1. The NFIP map panel(s) affected for all impacted communities is (are):

Community No.	Community Name	State	Map No.	Panel No.	Effective Date
350002	City of Albuquerque	NM	35001C	0137H	8/16/2012
350002	City of Albuquerque	NM	35001C	0141G	9/26/2008

2. a. Flooding Source:

- b. Types of Flooding: Riverine Coastal Shallow Flooding (e.g., Zones AO and AH)
 Alluvial Fan Lakes Other (Attach Description)

3. Project Name/Identifier:

4. FEMA zone designations (choices: A, AH, AO, A1-A30, A99, AE, AR, V, V1-V30, VE, B, C, D, X)

a. Effective:

b. Revised:

5. Basis for Request and Type of Revision:

a. The basis for this revision request is (check all that apply)

- | | | | |
|--|---|---|--|
| <input checked="" type="checkbox"/> Physical Change | <input checked="" type="checkbox"/> Improved Methodology/Data | <input type="checkbox"/> Regulatory Floodway Revision | <input checked="" type="checkbox"/> Base Map Changes |
| <input type="checkbox"/> Coastal Analysis | <input checked="" type="checkbox"/> Hydraulic Analysis | <input type="checkbox"/> Hydrologic Analysis | <input type="checkbox"/> Corrections |
| <input type="checkbox"/> Weir-Dam Changes | <input type="checkbox"/> Levee Certification | <input type="checkbox"/> Alluvial Fan Analysis | <input type="checkbox"/> Natural Changes |
| <input checked="" type="checkbox"/> New Topographic Data | <input type="checkbox"/> Other (Attach Description) | | |

Note: A photograph and narrative description of the area of concern is not required, but is very helpful during review.

b. The area of revision encompasses the following structures (check all that apply)

- Structures:
- | | | |
|---|--|--|
| <input type="checkbox"/> Channelization | <input type="checkbox"/> Levee/Floodwall | <input checked="" type="checkbox"/> Bridge/Culvert |
| <input type="checkbox"/> Dam | <input type="checkbox"/> Fill | <input checked="" type="checkbox"/> Other (Attach Description) |

6. Documentation of ESA compliance is submitted (required to initiate CLOMR review). Please refer to the instructions for more information.

C. REVIEW FEE

Has the review fee for the appropriate request category been included? Yes Fee amount: \$ _____
 No, Attach Explanation


- Please see the DHS-FEMA Web site at <http://www.fema.gov/forms-documents-and-software/flood-map-related-fees> for Fee Amounts and Exemptions.

D. SIGNATURES

1. REQUESTOR'S SIGNATURE


All documents submitted in support of this request are correct to the best of my knowledge. I understand that any false statement may be punishable by fine or imprisonment under Title 18 of the United States Code, Section 1001.

Name: Nina Leung-Villa	Company: Huitt-Zollars, Inc.	
Mailing Address: 333 Rio Rancho Drive NE, Suite 101 Rio Rancho, NM 87124	Daytime Telephone: 505-264-8249	Fax No.:
	E-mail Address: nvilla@huitt-zollars.com	
	Date: May 12, 2025	

Signature of Requestor (required): 

2. COMMUNITY CONCURRENCE

As the community official responsible for floodplain management, I hereby acknowledge that we have received and reviewed this Letter of Map Revision (LOMR) or conditional LOMR request. Based upon the community's review, we find the completed or proposed project meets or is designed to meet all of the community floodplain management requirements, including the requirements for when fill is placed in the regulatory floodway, and that all necessary Federal, State, and local permits have been, or in the case of a conditional LOMR, will be obtained. For Conditional LOMR requests, the applicant has documented Endangered Species Act (ESA) compliance to FEMA prior to FEMA's review of the Conditional LOMR application. For LOMR requests, I acknowledge that compliance with Sections 9 and 10 of the ESA has been achieved independently of FEMA's process. For actions authorized, funded, or being carried out by Federal or State agencies, documentation from the agency showing its compliance with Section 7(a)(2) of the ESA will be submitted. In addition, we have determined that the land and any existing or proposed structures to be removed from the SFHA are or will be reasonably safe from flooding as defined in 44CFR 65.2(c), and that we have available upon request by FEMA, all analyses and documentation used to make this determination.

Community Official's Name and Title: Anthony Montoya, Jr., P.E., C.F.M., Senior Engineer		
Mailing Address: PO Box 1293 Albuquerque, NM 87103	Community Name: City of Albuquerque	
	Daytime Telephone: 505-924-3314	Fax No.:
	E-mail Address: amontoya@cabq.gov	
Community Official's Signature (required): 		Date: 8/21/2025

3. CERTIFICATION BY REGISTERED PROFESSIONAL ENGINEER AND/OR LAND SURVEYOR

This certification is to be signed and sealed by a licensed land surveyor, registered professional engineer, or architect authorized by law to certify elevation information data, hydrologic and hydraulic analysis, and any other supporting information as per NFIP regulations paragraph 65.2(b) and as described in the MT-2 Forms Instructions. All documents submitted in support of this request are correct to the best of my knowledge. I understand that any false statement may be punishable by fine or imprisonment under Title 18 of the United States Code, Section 1001.

Certifier's Name: Nina Leung-Villa		License No.: 25970	Expiration Date: 12-31-26
Company Name: Huitt-Zollars		Mailing Address:	
Telephone No.: 505-892-5141	Fax No.:	333 Rio Rancho Dr. NE Rio Rancho, NM 87124	
E-mail Address: nvilla@huitt-zollars.com			

Signature: *Nina Leung-Villa* Date: May 12, 2025

Ensure the forms that are appropriate to your revision request are included in your submittal.

Form Name and (Number)

Required if ...

- | | |
|--|---|
| <input type="checkbox"/> Riverine Hydrology and Hydraulics Form (Form 2) | New or revised discharges or water-surface elevations |
| <input type="checkbox"/> Riverine Structures Form (Form 3) | Channel is modified, addition/revision of bridge/culverts, addition/revision of levee/floodwall, addition/revision of dam |
| <input type="checkbox"/> Coastal Analysis Form (Form 4) | New or revised coastal elevations |
| <input type="checkbox"/> Coastal Structures Form (Form 5) | Addition/revision of coastal structure |
| <input type="checkbox"/> Alluvial Fan Flooding Form (Form 6) | Flood control measures on alluvial fans |



Item 3

FEMA MT-2 Form 2
(RIVERINE HYDROLOGY & HYDRAULICS)

DEPARTMENT OF HOMELAND SECURITY
Federal Emergency Management Agency
RIVERINE HYDROLOGY & HYDRAULICS FORM (FORM 2)

OMB Control Number: 1660-0016
Expiration: 1/31/2024

PAPERWORK BURDEN DISCLOSURE NOTICE

Public reporting burden for this form is estimated to average 3.5 hours per response. The burden estimate includes the time for reviewing instructions, searching existing data sources, gathering and maintaining the needed data, and completing, reviewing, and submitting the form. You are not required to respond to this collection of information unless it displays a valid OMB control number. Send comments regarding the accuracy of the burden estimate and any suggestions for reducing this burden to: Information Collections Management, Department of Homeland Security, Federal Emergency Management Agency, 500 C Street, SW, Washington, DC 20472, Paperwork Reduction Project (1660-0016). Submission of the form is required to obtain or retain benefits under the National Flood Insurance Program. **Please do not send your completed survey to the above address.**

PRIVACY ACT STATEMENT

AUTHORITY: The National Flood Insurance Act of 1968, Public Law 90-448, as amended by the Flood Disaster Protection Act of 1973, Public Law 93-234.

PRINCIPAL PURPOSE(S): This information is being collected for the purpose of determining an applicant's eligibility to request changes to National Flood Insurance Program (NFIP) Flood Insurance Rate Maps (FIRM).

ROUTINE USE(S): The information on this form may be disclosed as generally permitted under 5 U.S.C § 552a(b) of the Privacy Act of 1974, as amended. This includes using this information as necessary and authorized by the routine uses published in DHS/FEMA/NFIP/LOMA-1 National Flood Insurance Program (NFIP); Letter of Map Amendment (LOMA) February 15, 2006, 71 FR 7990.

DISCLOSURE: The disclosure of information on this form is voluntary; however, failure to provide the information requested may delay or prevent FEMA from processing a determination regarding a requested change to a (NFIP) Flood Insurance Rate Maps (FIRM).

Flooding Source: North Arroyo de Domingo Baca

A. HYDROLOGY

1. Reason for New Hydrologic Analysis (check all that apply):

- Not revised (skip to section B)
 No existing analysis
 Improved data
 Alternative methodology
 Proposed Conditions (CLOMR)
 Changed physical condition of watershed

2. Comparison of Representative 1%-Annual-Chance Discharges

Location	Drainage Area (Sq. Mi.)	Effective/FIS (cfs)	Revised (cfs)
----------	-------------------------	---------------------	---------------

3. Methodology for New Hydrologic Analysis (check all that apply)

- Precipitation/Runoff Model → Specify Model: _____ Duration: _____ Rainfall Amount: _____
 Statistical Analysis of Gage Records
 Regional Regression Equations
 Other (please attach description)

Please enclose all relevant models in digital format, maps, computations (including computation of parameters), and documentation to support the new analysis.

4. Review/Approval of Analysis

If your community requires a regional, state, or federal agency to review the hydrologic analysis, please attach evidence of approval/review. 4. HEC-RAS File Description**:

5. Impacts of Sediment Transport on Hydrology

Is the hydrology for the revised flooding source(s) affected by sediment transport? Yes No

If yes, then fill out Section F (Sediment Transport) of Form 3. If No, then attach your explanation.

B. HYDRAULICS

1. Reach to be Revised

	Description	Cross Section	Water-Surface Elevation (ft.)	
			Effective	Proposed/Revised
Downstream Limit*	Kinney Dam		5320	5320

*Proposed/Revised elevations must tie-into the Effective elevations within 0.5 foot at the downstream and upstream limits of revision.

2. Hydraulic Method/Model Used: HEC-RAS

Steady State Unsteady State One-Dimensional Two-Dimensional

3. Pre-Submittal Review of Hydraulic Models*

DHS-FEMA has developed two review programs, CHECK-2 and CHECK-RAS, to aid in the review of HEC-2 and HEC-RAS hydraulic models, respectively. We recommend that you review your HEC-2 and HEC-RAS models with CHECK-2 and CHECK-RAS.

4. HEC-RAS File Description**:

Models Submitted	Natural Run		Floodway Run		Datum
Duplicate Effective Model*	File Name:	Plan Name:	File Name:	Plan Name:	
NONE					
Corrected Effective Model*	File Name:	Plan Name:	File Name:	Plan Name:	
NONE					
Existing or Pre-Project Conditions Model	File Name:	Plan Name:	File Name:	Plan Name:	
North Arroyo de Domingo Baca			North Arroyo de Domingo Baca	Plan 03	
Revised or Post-Project Conditions Model	File Name:	Plan Name:	File Name:	Plan Name:	
NONE					
Other - (attach description)	File Name:	Plan Name:	File Name:	Plan Name:	
NONE					

* For details, refer to the corresponding section of the instructions.

**See instructions for information about modeling other than HEC-RAS. Digital Models Submitted? (Required)

C. MAPPING REQUIREMENTS

A **certified topographic work map** must be submitted showing the following information (where applicable): the boundaries of the effective, existing, and proposed conditions 1%-annual-chance floodplain (for approximate Zone A revisions) or the boundaries of the 1%- and 0.2%-annual-chance floodplains and regulatory floodway (for detailed Zone AE, AO, and AH revisions); location and alignment of all cross sections with stationing control indicated; stream, road, and other alignments (e.g., dams, levees, etc.); current community easements and boundaries; boundaries of the requester's property; certification of a registered professional engineer registered in the subject State; location and description of reference marks; and the referenced vertical datum (NGVD, NAVD, etc.).

Topographic Information: Digital Mapping (GIS/CADD) Data Submitted (preferred)

Source: SURVEY - NDB_PARK TOPO & NDB_CHANNEL_TOPO Date: 12/6/2024

Vertical Datum: NAVD 1988 Spatial Projection: New Mexico State Plane

Accuracy:

Note that the boundaries of the existing or proposed conditions floodplains and regulatory floodway to be shown on the revised FIRM and/or FBFM must tie-in with the effective floodplain and regulatory floodway boundaries. Please attach a **copy of the effective FIRM and/or FBFM**, at the same scale as the original, annotated to show the boundaries of the revised 1%-and 0.2%-annual-chance floodplains and regulatory floodway that tie-in with the boundaries of the effective 1%-and 0.2%-annual-chance floodplain and regulatory floodway at the upstream and downstream limits of the area on revision.

Annotated FIRM and/or FBFM (Required)

D. COMMON REGULATORY REQUIREMENTS*

1. For LOMR/CLOMR requests, do Base Flood Elevations (BFEs) or Special Flood Hazard Areas (SFHAs) increase compared to the effective BFEs? Yes No
- If Yes, please attach **proof of property owner notification**. Examples of property owner notifications can be found in the MT-2 Form 2 Instructions.
2. For CLOMR requests, if either of the following is true, please submit **evidence of compliance with Section 65.12 of the NFIP regulations**:
- The proposed project encroaches upon a regulatory floodway and would result in increases above 0.00 foot compared to pre-project conditions.
 - The proposed project encroaches upon a SFHA with or without BFEs established and would result in increases above 1.00 foot compared to pre-project conditions.
3. Does the request involve the placement or proposed placement of fill? Yes No
- If Yes, the community must be able to certify that the area to be removed from the special flood hazard area, to include any structures or proposed structures, meets all of the standards of the local floodplain ordinances, and is reasonably safe from flooding in accordance with the NFIP regulations set forth at 44 CFR 60.3(A)(3), 65.5(a)(4), and 65.6(a)(14). Please see the MT-2 instructions for more information.
4. Does the request involve the placement or proposed placement of fill? Yes No
- If Yes, attach **evidence of regulatory floodway revision notification**. As per Paragraph 65.7(b)(1) of the NFIP Regulations, notification is required for requests involving revisions to the regulatory floodway Elements and examples of regulatory floodway revision notification can be found in the MT-2 Form 2 Instructions.
5. For CLOMR requests, please submit documentation to FEMA and the community to show that you have complied with Sections 9 and 10 of the Endangered Species Act (ESA). For actions authorized, funded, or being carried out by Federal or State agencies, please submit documentation from the agency showing its compliance with Section 7(a)(2) of the ESA. Please see the MT-2 instructions for more detail.

Item 4

**Culvert Analysis
(HEC-RAS, North Arroyo de Domingo Baca)**

**Existing Pond Survey
&
Upstream North Domingo Baca Survey**

Item 4. HEC-RAS, North Arroyo de Domingo Baca

HEC-RAS:

Version: 6.5 Date: 01Feb2024

The analysis for the culvert design utilizes HEC-RAS to assure the design is adequate to handle the peak flow. The culvert cross section was determined by way of new survey. The survey verified that the culvert is two 10' x 6' CBC's located between Wyoming Boulevard and the Kinney Dam entry opening. The cross-section dimensions will be held through the culvert beginning at the Wyoming location down to the outfall into Kinney Dam pond. See the HEC-RAS report for more details.

The peak flow was obtained from the existing Flood Insurance Study, Volume 1 of 2 for the Bernalillo County and Incorporated Areas. The indicated flow for the 1-Percent-Annual-Chance is 658 CFS at Wyoming Boulevard. The peak flow maintains an elevation that is lower than the top of the culvert and will efficiently be directed towards Kinney Dam. These results indicate that the culvert is currently functioning as a sustainable drainage device.

HEC-RAS HEC-RAS 6.5 February 2024
 U.S. Army Corps of Engineers
 Hydrologic Engineering Center
 609 Second Street
 Davis, California

```

X   X XXXXXX   XXXX   XXXX   XX   XXXX
X   X X       X  X   X  X   X  X   X
X   X X       X     X  X   X  X   X
XXXXXXXX XXXX   X     XXX XXXX XXXXXX XXXX
X   X X       X     X  X   X  X   X   X
X   X X       X  X   X  X   X  X   X
X   X XXXXXX   XXXX   X  X   X  X   XXXXX
  
```

PROJECT DATA

Project Title: North Arroyo de Domingo Baca
 Project File : NorthArroyodeDom.prj
 Run Date and Time: 12/9/2024 11:48:04 AM

Project in English units

PLAN DATA

Plan Title: Plan 03
 Plan File : h:\Transfer\Corie\NorthArroyodeDom.p03

Geometry Title: NORTH DOMINGO BACA
 Geometry File : h:\Transfer\Corie\NorthArroyodeDom.g02

Flow Title : NDB Flow
 Flow File : h:\Transfer\Corie\Aquatic Center\HEC-RAS\NorthArroyodeDom.f12

Plan Summary Information:

Number of: Cross Sections = 4 Multiple Openings = 0
 Culverts = 1 Inline Structures = 0
 Bridges = 0 Lateral Structures = 0

Computational Information

Water surface calculation tolerance = 0.01
 Critical depth calculation tolerance = 0.01
 Maximum number of iterations = 20
 Maximum difference tolerance = 0.3
 Flow tolerance factor = 0.001

Computation Options

Critical depth computed only where necessary
 Conveyance Calculation Method: At breaks in n values only
 Friction Slope Method: Average Conveyance
 Computational Flow Regime: Subcritical Flow

FLOW DATA

Flow Title: NDB Flow
 Flow File : h:\Transfer\Corie\Aquatic Center\HEC-RAS\NorthArroyodeDom.f12

Flow Data (cfs)

River	Reach	RS	PF 1
NDB	1	1900	658

Boundary Conditions

River	Reach	Profile	Upstream	Downstream
NDB	1	PF 1	Normal S = 0.025	Known WS = 5320

CROSS SECTION

RIVER: NDB
 REACH: 1 RS: 1900

CROSS SECTION OUTPUT Profile #PF 1

E.G. Elev (ft)	5385.14	Element	Left OB	Channel	Right OB
Vel Head (ft)	0.42	Wt. n-Val.		0.013	
W.S. Elev (ft)	5384.72	Reach Len. (ft)	10.00	10.00	10.00
Crit W.S. (ft)		Flow Area (sq ft)		126.13	
E.G. Slope (ft/ft)	0.000382	Area (sq ft)		126.13	
Q Total (cfs)	658.00	Flow (cfs)		658.00	
Top Width (ft)	31.44	Top Width (ft)		31.44	
Vel Total (ft/s)	5.22	Avg. Vel. (ft/s)		5.22	
Max Chl Dpth (ft)	4.72	Hydr. Depth (ft)		4.01	
Conv. Total (cfs)	33660.6	Conv. (cfs)		33660.6	
Length Wtd. (ft)	10.00	Wetted Per. (ft)		35.35	
Min Ch El (ft)	5380.00	Shear (lb/sq ft)		0.09	
Alpha	1.00	Stream Power (lb/ft s)		0.44	
Frctn Loss (ft)	0.00	Cum Volume (acre-ft)		1.04	
C & E Loss (ft)	0.01	Cum SA (acres)		1.37	

Profile #PF 1

	Pos	Left Sta (ft)	Right Sta (ft)	Flow (cfs)	Area (sq ft)	W.P. (ft)	Percent Conv	Hydr Depth(ft)	Velocity (ft/s)	Shear (lb/sq ft)	Power (lb/ft s)
1	Chan	0.00	6.80	48.88	14.92	7.48	7.43	2.70	3.28	0.05	0.16
2	Chan	6.80	13.60	186.75	32.10	6.80	28.38	4.72	5.82	0.11	0.66
3	Chan	13.60	20.40	186.75	32.10	6.80	28.38	4.72	5.82	0.11	0.66
4	Chan	20.40	27.20	186.74	32.10	6.80	28.38	4.72	5.82	0.11	0.66
5	Chan	27.20	34.00	48.88	14.92	7.48	7.43	2.70	3.28	0.05	0.16

CROSS SECTION


RIVER: NDB
 REACH: 1 RS: 1890

CROSS SECTION OUTPUT Profile #PF 1

E.G. Elev (ft)	5385.13	Element	Left OB	Channel	Right OB
Vel Head (ft)	0.38	Wt. n-Val.		0.013	
W.S. Elev (ft)	5384.75	Reach Len. (ft)	1880.00	1880.00	1880.00
Crit W.S. (ft)	5382.69	Flow Area (sq ft)		133.33	
E.G. Slope (ft/ft)	0.000325	Area (sq ft)		133.33	
Q Total (cfs)	658.00	Flow (cfs)		658.00	
Top Width (ft)	31.90	Top Width (ft)		31.90	
Vel Total (ft/s)	4.94	Avg. Vel. (ft/s)		4.94	
Max Chl Dpth (ft)	4.95	Hydr. Depth (ft)		4.18	
Conv. Total (cfs)	36484.9	Conv. (cfs)		36484.9	
Length Wtd. (ft)	1880.00	Wetted Per. (ft)		35.99	
Min Ch El (ft)	5379.80	Shear (lb/sq ft)		0.08	
Alpha	1.00	Stream Power (lb/ft s)		0.37	
Frctn Loss (ft)		Cum Volume (acre-ft)		1.01	
C & E Loss (ft)		Cum SA (acres)		1.36	

Profile #PF 1

	Pos	Left Sta (ft)	Right Sta (ft)	Flow (cfs)	Area (sq ft)	W.P. (ft)	Percent Conv	Hydr Depth(ft)	Velocity (ft/s)	Shear (lb/sq ft)	Power (lb/ft s)
1	Chan	0.00	6.80	50.18	16.20	7.80	7.63	2.82	3.10	0.04	0.13
2	Chan	6.80	13.60	185.88	33.64	6.80	28.25	4.95	5.52	0.10	0.56
3	Chan	13.60	20.40	185.88	33.64	6.80	28.25	4.95	5.52	0.10	0.56
4	Chan	20.40	27.20	185.88	33.64	6.80	28.25	4.95	5.52	0.10	0.56
5	Chan	27.20	34.00	50.18	16.20	7.80	7.63	2.82	3.10	0.04	0.13

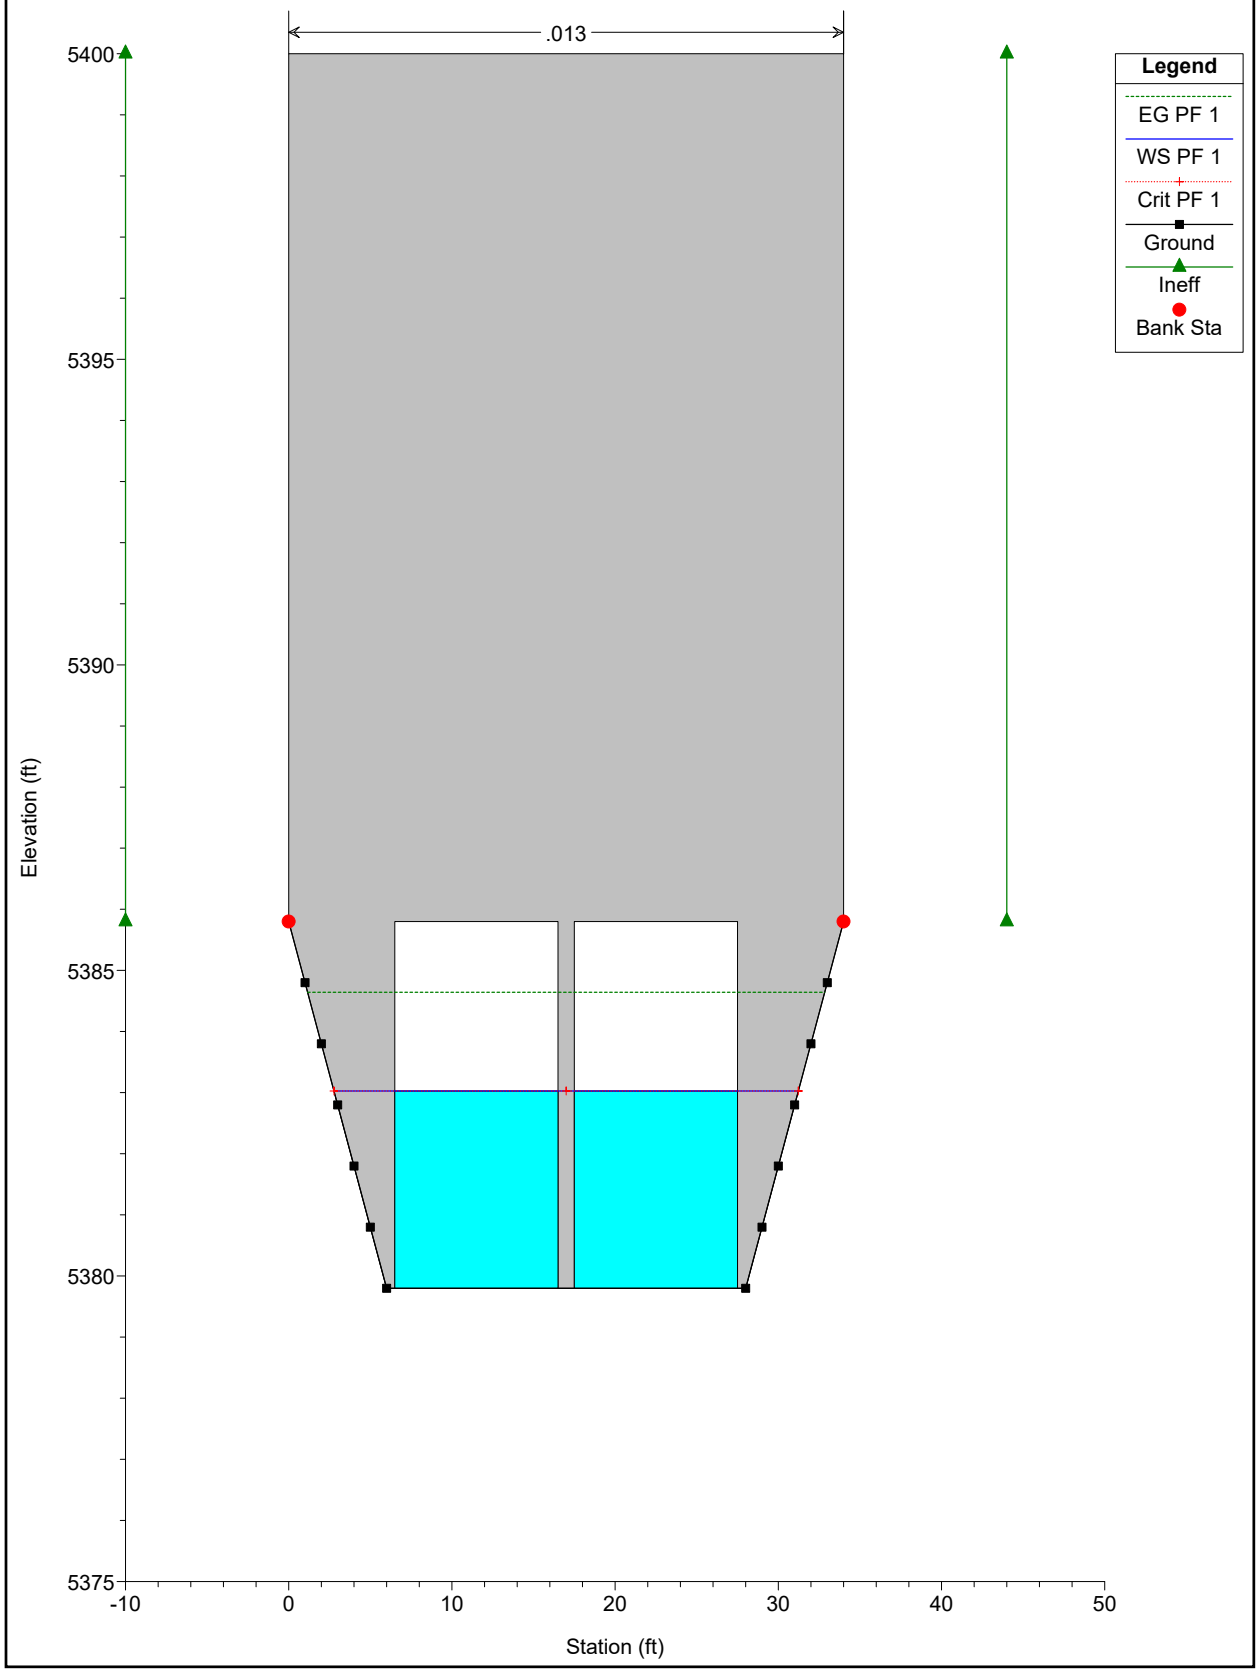

1

2

3

4


5

D

C

B

A

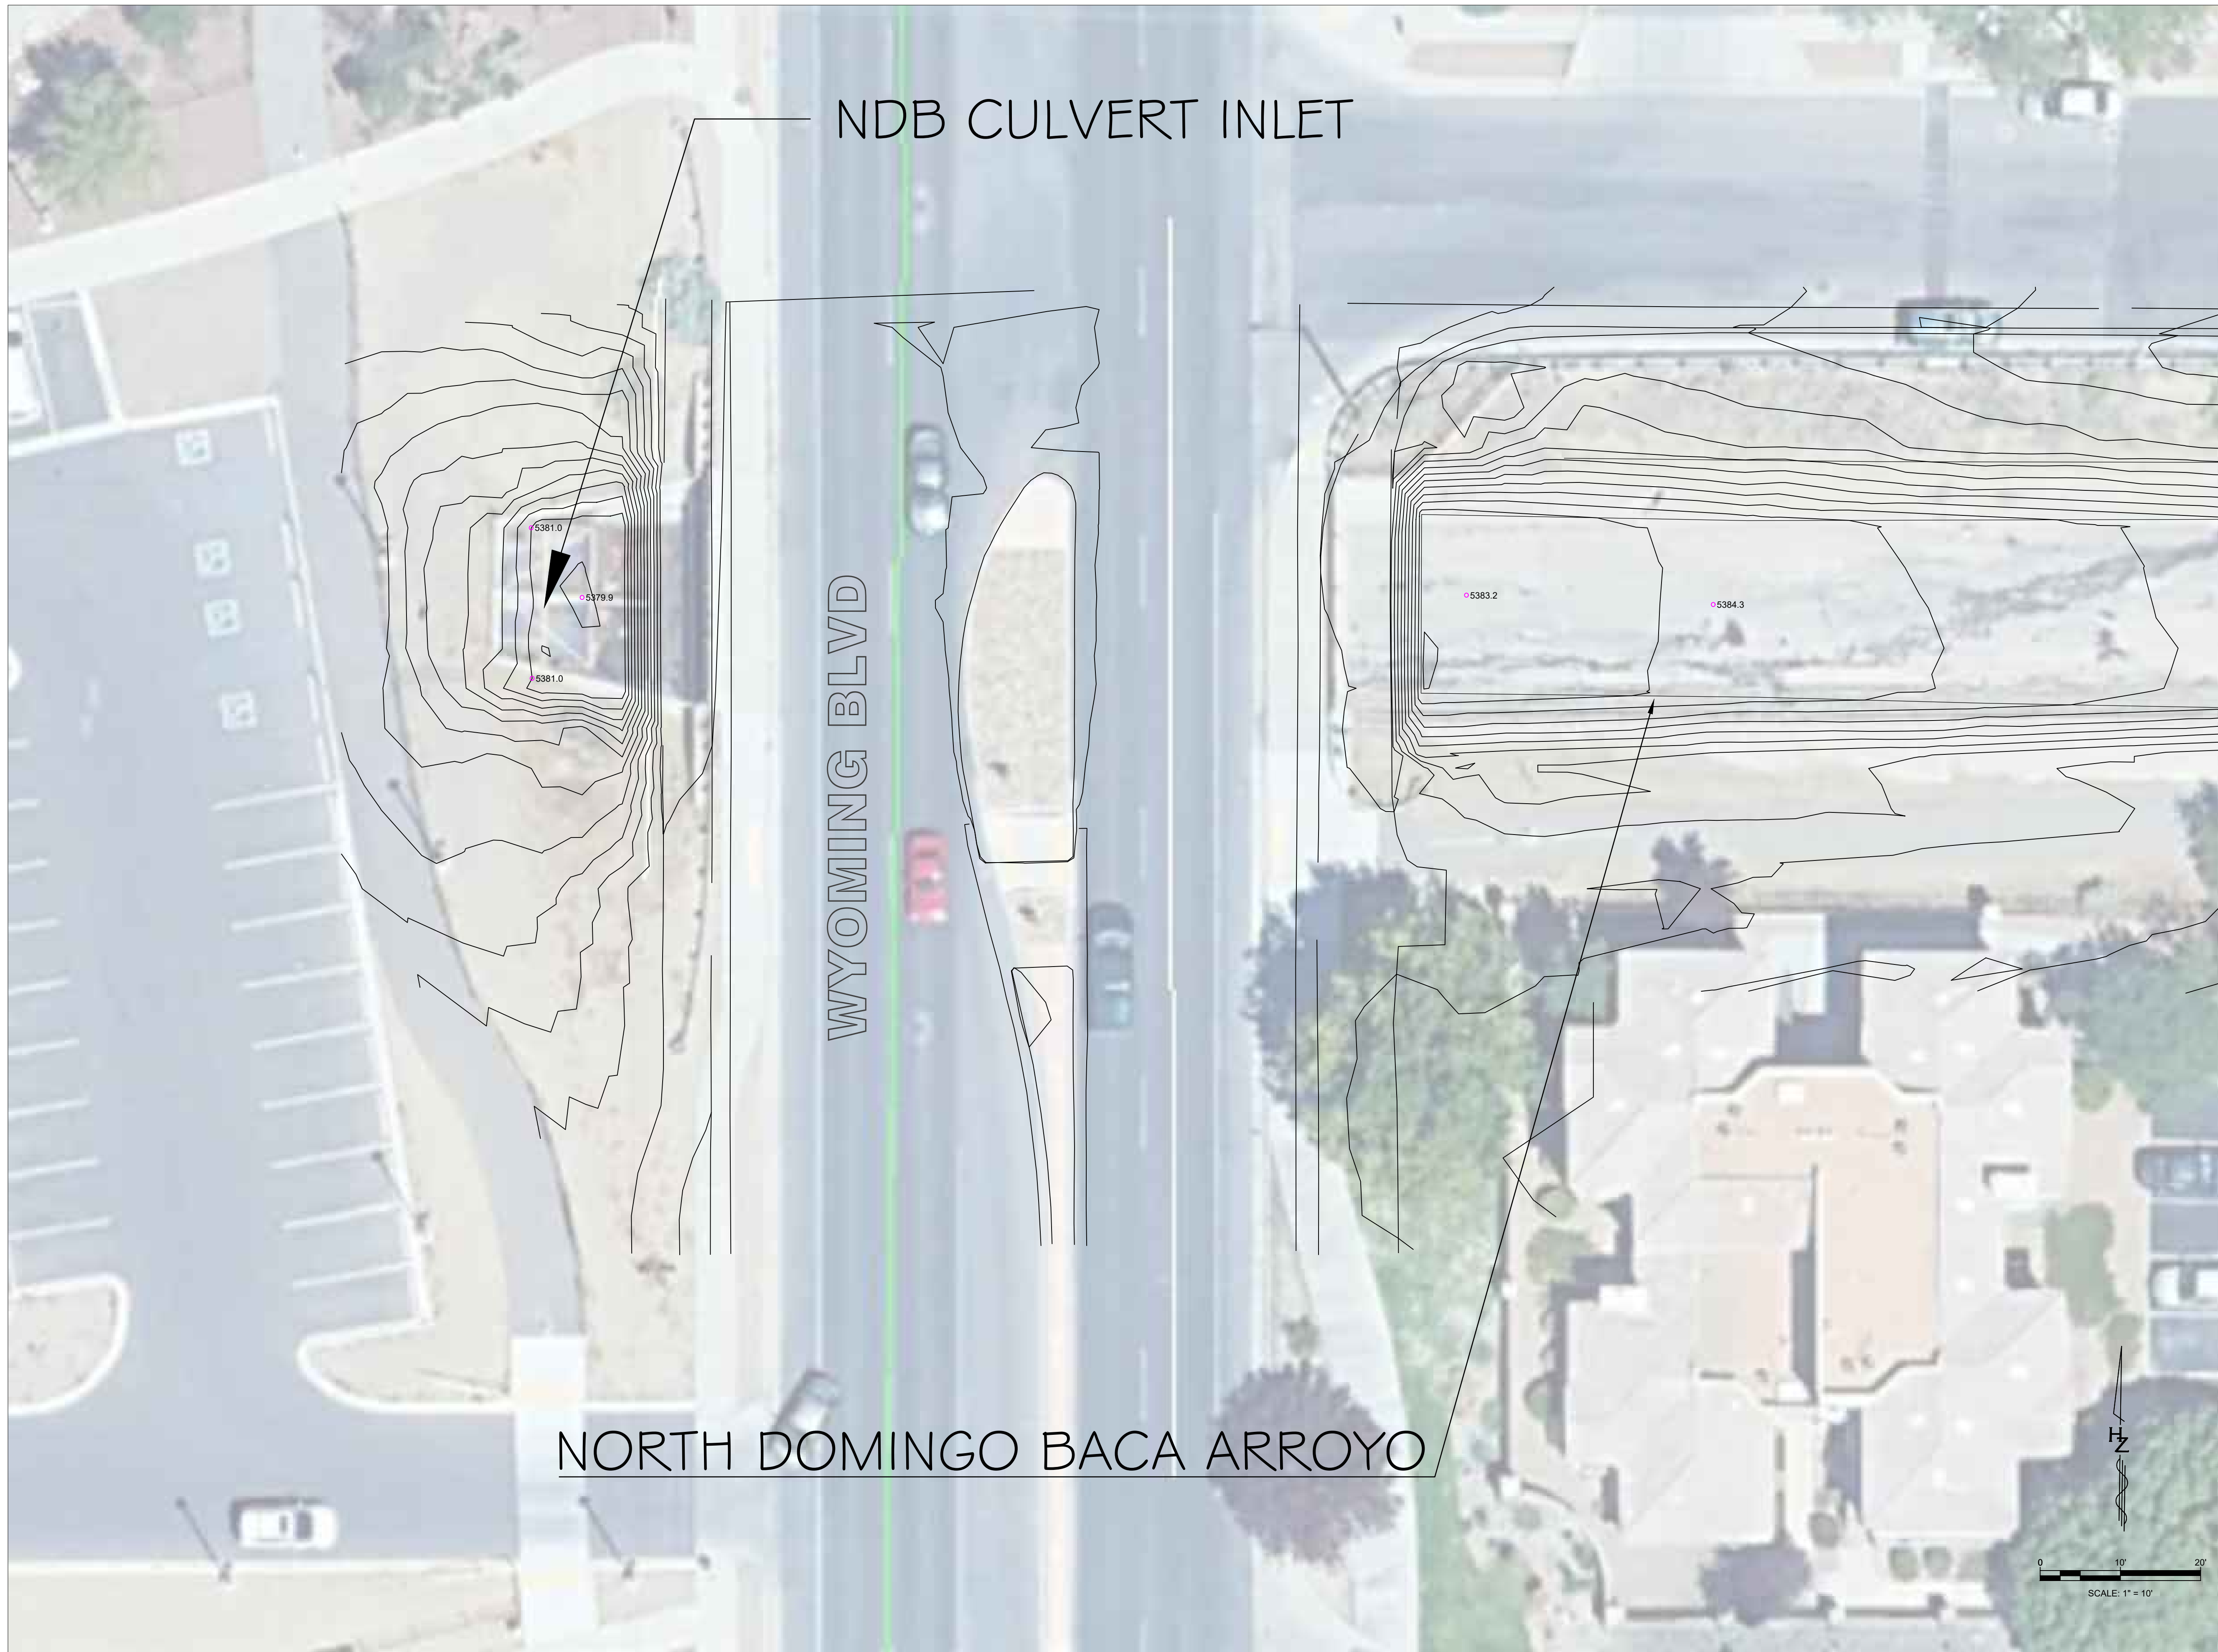

**NORTH
DOMINGO
BACA

LOMR**

PROJECT NO.:

DRAWN BY: STAFF

REVIEWED BY: STAFF

APPROVED BY: STAFF

ISSUE DRAWING LOG:

NO.	DATE	DESCRIPTION

NORTH DOMINGO BACA
CHANNEL

LOMR EXHIBIT

H:\TRANSFER\QUATIC CENTER\NDB LOMR EXHIBIT_RECOVER.DWG

9/22/2023 3:04 PM

Item 5

**National Flood Hazard Layer Firmette
(Existing & Proposed)**

National Flood Hazard Layer FIRMette




106°34'7"W 35°10'58"N



Legend

SEE FIS REPORT FOR DETAILED LEGEND AND INDEX MAP FOR FIRM PANEL LAYOUT

- | | | |
|------------------------------------|----------------------|--|
| SPECIAL FLOOD HAZARD AREAS | | Without Base Flood Elevation (BFE)
<i>Zone A, V, A99</i> |
| | | With BFE or Depth <i>Zone AE, AO, AH, VE, AR</i> |
| | | Regulatory Floodway |
| OTHER AREAS OF FLOOD HAZARD | | 0.2% Annual Chance Flood Hazard, Areas of 1% annual chance flood with average depth less than one foot or with drainage areas of less than one square mile <i>Zone X</i> |
| | | Future Conditions 1% Annual Chance Flood Hazard <i>Zone X</i> |
| | | Area with Reduced Flood Risk due to Levee. See Notes. <i>Zone X</i> |
| | | Area with Flood Risk due to Levee <i>Zone D</i> |
| OTHER AREAS | | NO SCREEN Area of Minimal Flood Hazard <i>Zone X</i> |
| | | Effective LOMRs |
| GENERAL STRUCTURES | | Area of Undetermined Flood Hazard <i>Zone D</i> |
| | | Channel, Culvert, or Storm Sewer |
| OTHER FEATURES | | Levee, Dike, or Floodwall |
| | | 20.2 Cross Sections with 1% Annual Chance |
| MAP PANELS | | 17.5 Water Surface Elevation |
| | | 8 Coastal Transect |
| | | Base Flood Elevation Line (BFE) |
| | | Limit of Study |
| | | Jurisdiction Boundary |
| | | Coastal Transect Baseline |
| | | Profile Baseline |
| | Hydrographic Feature | |
| MAP PANELS | | Digital Data Available |
| | | No Digital Data Available |
| | | Unmapped |
| | | The pin displayed on the map is an approximate point selected by the user and does not represent an authoritative property location. |

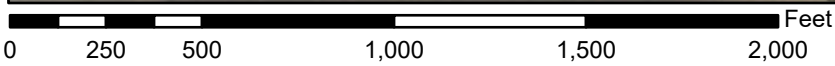

1:6,000 106°33'29"W 35°10'28"N

Basemap Imagery Source: USGS National Map 2023

This map complies with FEMA's standards for the use of digital flood maps if it is not void as described below. The basemap shown complies with FEMA's basemap accuracy standards

The flood hazard information is derived directly from the authoritative NFHL web services provided by FEMA. This map was exported on 6/5/2024 at 6:09 PM and does not reflect changes or amendments subsequent to this date and time. The NFHL and effective information may change or become superseded by new data over time.

This map image is void if the one or more of the following map elements do not appear: basemap imagery, flood zone labels, legend, scale bar, map creation date, community identifiers, FIRM panel number, and FIRM effective date. Map images for unmapped and unmodernized areas cannot be used for regulatory purposes.

NOTES TO USERS

This map is for use in administering the National Flood Insurance Program. It does not necessarily identify all areas subject to flooding, particularly from local drainage sources of small size. The community map repository should be consulted for possible updated or additional flood hazard information.

To obtain more detailed information in areas where Base Flood Elevations (BFEs) and/or floodways have been determined, users are encouraged to consult the Flood Profiles and Floodway Data and/or Summary of Stillwater Elevations tables contained within the Flood Insurance Study (FIS) report that accompanies this FIRM. Users should be aware that BFEs shown on the FIRM represent rounded whole-foot elevations. These BFEs are intended for flood insurance rating purposes only and should not be used as the sole source of flood elevation information. Accordingly, flood elevation data presented in the FIS report should be utilized in conjunction with the FIRM for purposes of construction and/or floodplain management.

Coastal Base Flood Elevations shown on this map apply only landward of 0.0 North American Vertical Datum of 1988 (NAVD 88). Users of this FIRM should be aware that coastal flood elevations are also provided in the summary of Stillwater Elevations table in the Flood Insurance Study Report for this jurisdiction. Elevations shown in the Summary of Stillwater Elevations table should be used for construction and/or floodplain management purposes when they are higher than the elevations shown on this FIRM.

Boundaries of the floodways were computed at cross sections and interpolated between cross sections. The floodways were based on hydraulic considerations with regard to requirements of the National Flood Insurance Program. Floodway widths and other pertinent floodway data are provided in the Flood Insurance Study report for this jurisdiction.

Certain areas not in Special Flood Hazard Areas may be protected by flood control structures. Refer to Section 2.4 "Flood Protection Measures" of the Flood Insurance Study report for information on flood control structures in this jurisdiction.

The projection used in the presentation of this map was New Mexico State Plane, Central Zone. The horizontal datum was NAD 83, GRS80 spheroid. Differences in datum, spheroid, projection or UTM zones used in the production of FIRMs for adjacent jurisdictions may result in slight positional differences in map features across jurisdiction boundaries. These differences do not affect the accuracy of this FIRM.

Flood elevations on this map are referenced to the North American Vertical Datum of 1988. These flood elevations must be compared to structure and ground elevations referenced to the same vertical datum. For information regarding conversion between the National Geodetic Vertical Datum of 1929 and the North American Vertical Datum of 1988, visit the National Geodetic Survey website at <http://www.ngs.noaa.gov> or contact the National Geodetic Survey at the following address:

NGS Information Services
NOAA, NINGS12
National Geodetic Survey, SSMC-3, #9202
1315 East-West Highway
Silver Spring, Maryland 20910-3282
(301) 713-3242

To obtain current elevation, description, and/or location information for bench marks shown on this map, please contact the Information Services Branch of the National Geodetic Survey at (301) 713-3242, or visit their website at <http://www.ngs.noaa.gov>.

Base map information shown on this FIRM was provided in digital format by Bernalillo County produced at a scale of 1:12,000 from photography dated 1999 or later.


Based on updated topographic information, this map reflects more detailed and up-to-date stream channel configurations and floodplain delineations than those shown on the previous FIRM for this jurisdiction. As a result, the Flood Profiles and Floodway Data tables for the Flood Insurance Study report may reflect stream channel distances that differ from what is shown on the map. Also, the road to floodplain relationships for unsewered streams may differ from what is shown on previous maps.

Corporate limits shown on this map are based on the best data available at the time of publication. Because changes due to annexations or de-annexations may have occurred after this map was published, map users should contact appropriate community officials to verify current corporate limit locations.

Please refer to the separately printed Map Index for an overview map of the county showing the layout of map panels; community map repository addresses; and a Listing of Communities table containing National Flood Insurance Program dates for each community as well as a listing of the panels on which each community is located.

Contact the FEMA Map Service Center at 1-800-358-9616 for information on available products associated with this FIRM. Available products may include previously issued Letters of Map Change, a Flood Insurance Study report, and/or digital versions of this map. The FEMA Map Service Center may also be reached by Fax at 1-800-358-9620 and their website at <http://www.msc.fema.gov>.

If you have questions about this map or questions concerning the National Flood Insurance Program in general, please call 1-877-FEMA-MAP (1-877-336-2627) or visit the FEMA website at <http://www.fema.gov/business/nfp>.

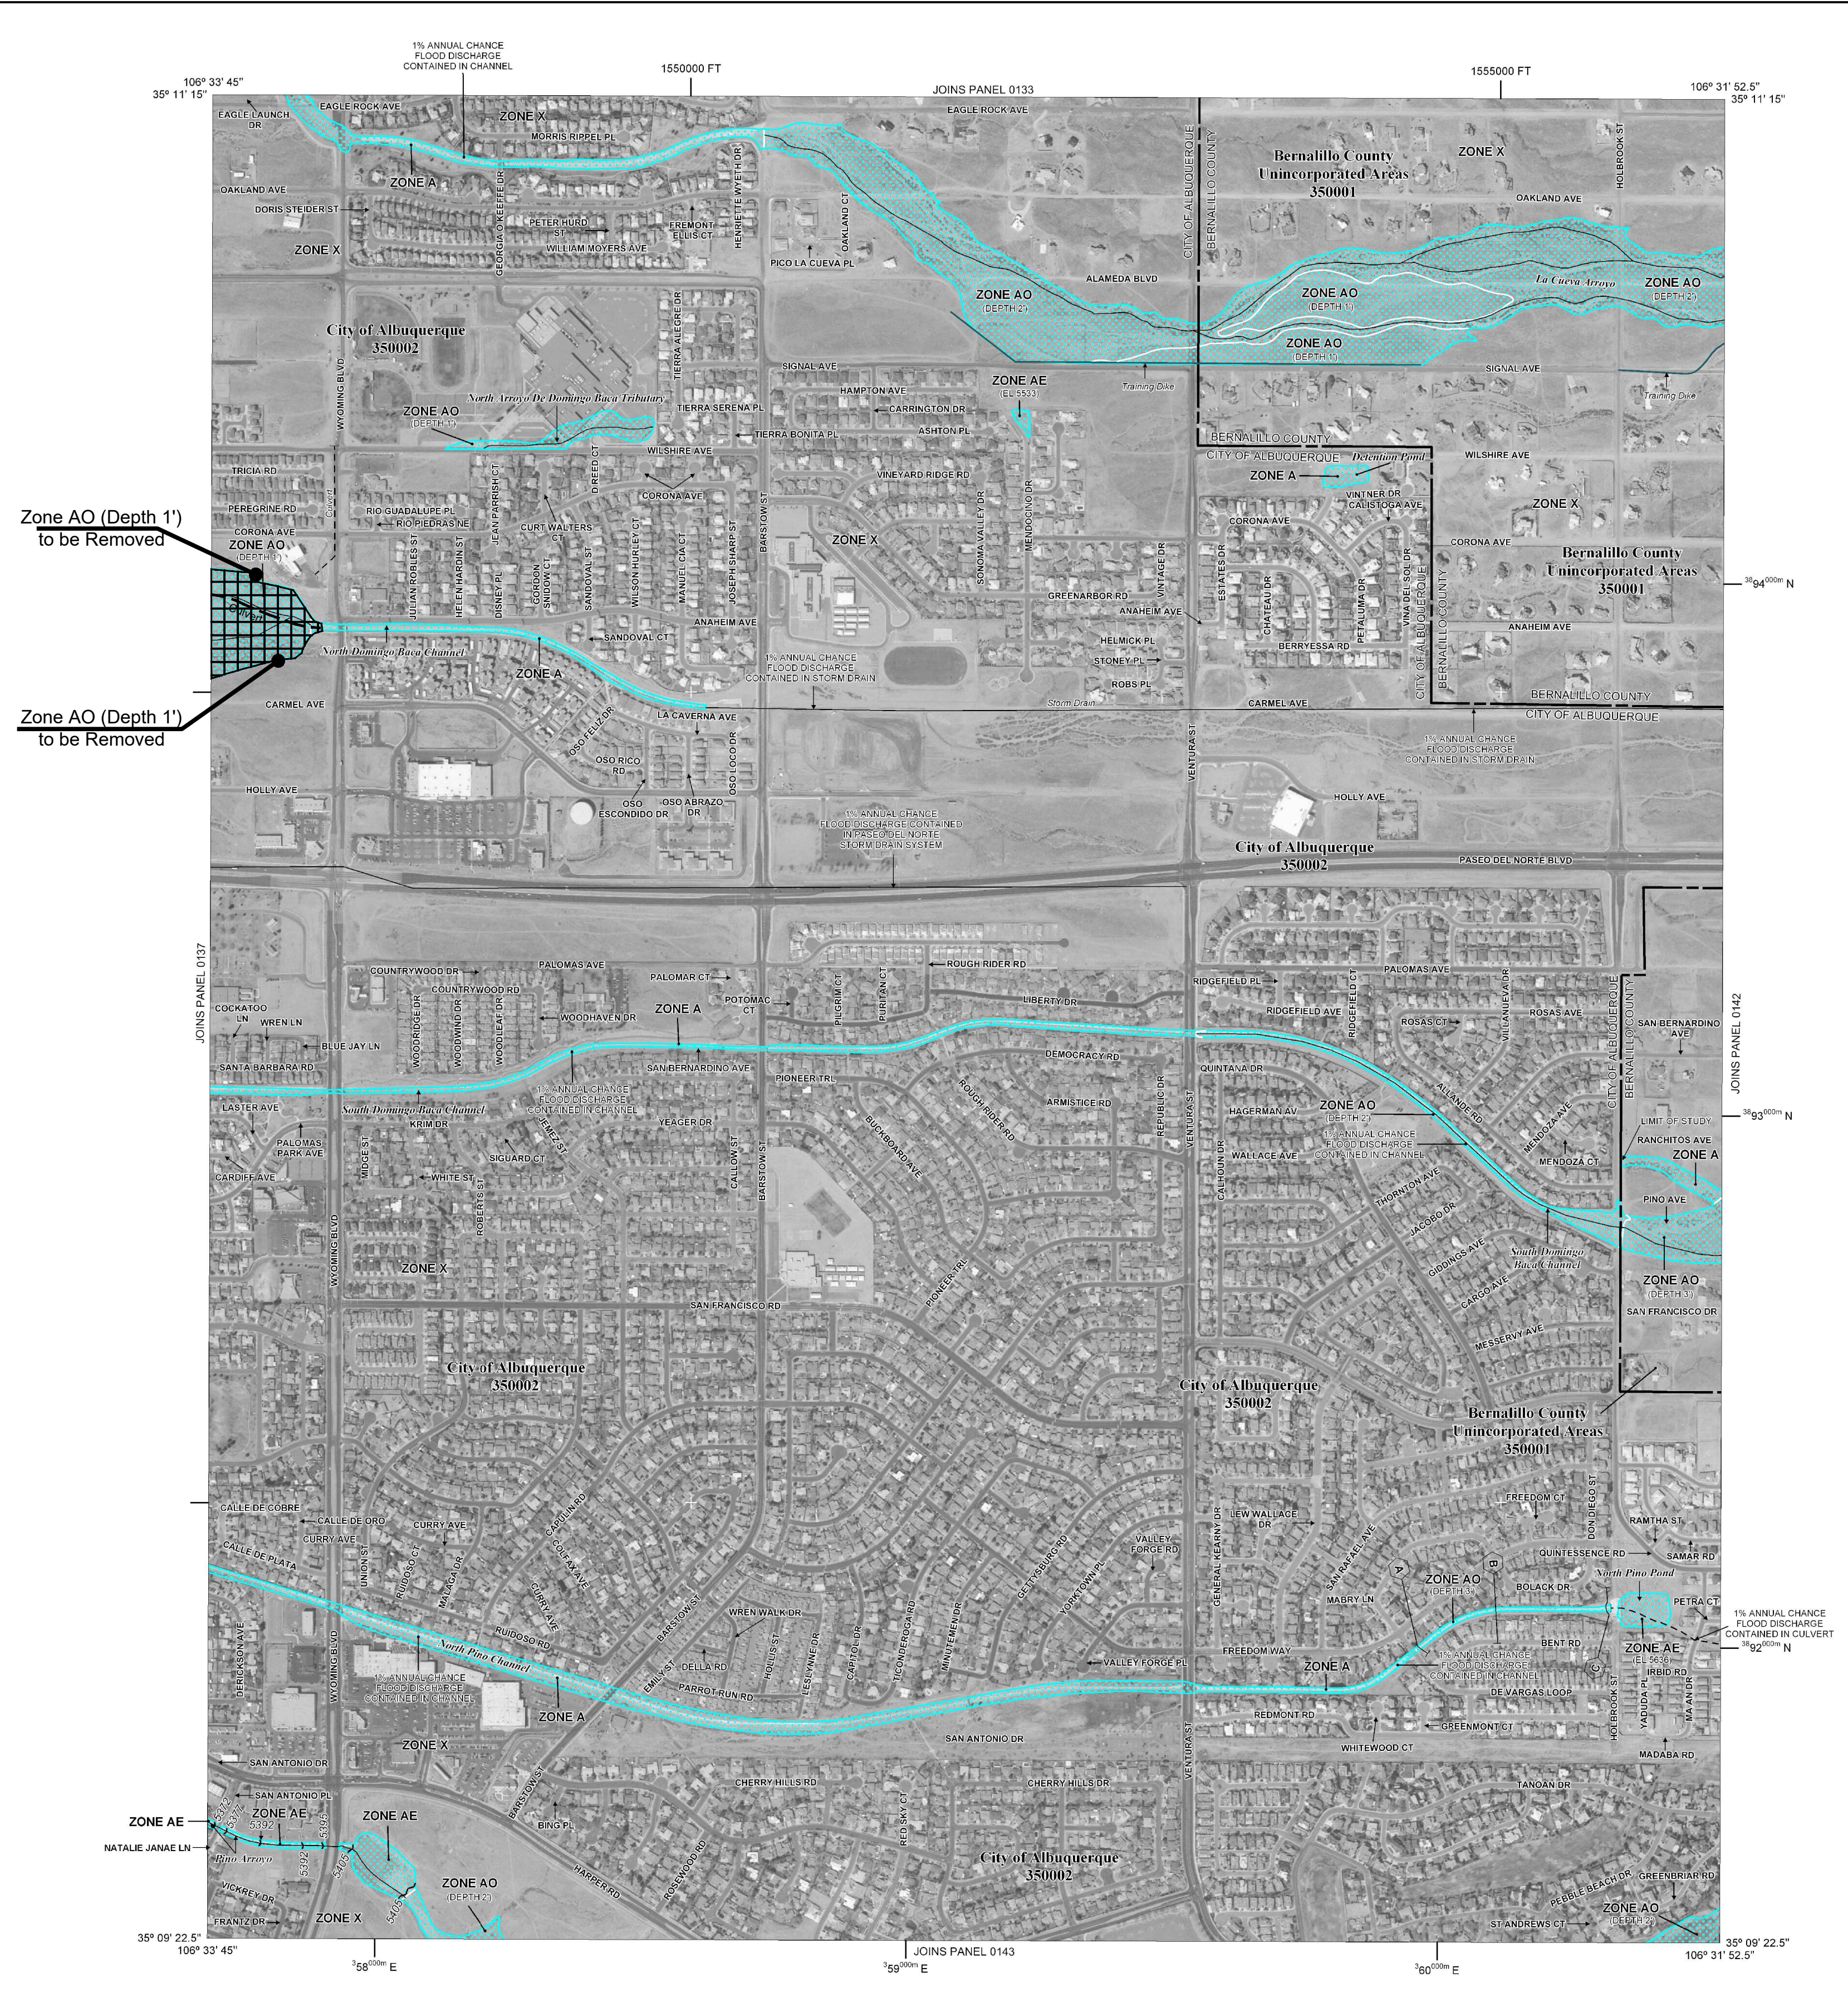

LEGEND

SPECIAL FLOOD HAZARD AREAS (SFHA) SUBJECT TO INUNDATION BY THE 1% ANNUAL CHANCE FLOOD:

The 1% annual chance flood (100-year flood), also known as the base flood, is the flood that has a 1% chance of being equaled or exceeded in any given year. The Special Flood Hazard Area is the area subject to flooding by the 1% annual chance flood. Areas of Special Flood Hazard include Zones A, AE, AH, AO, AR, ASR, V, and VE. The Base Flood Elevation is the water surface elevation of the 1% annual chance flood.

ZONE A
No Base Flood Elevations determined.

ZONE AE
Base Flood Elevations determined.

ZONE AH
Flood depths of 1 to 3 feet (usually areas of ponding); Base Flood Elevations determined.

ZONE AO
Flood depths of 2 to 3 feet (usually sheet flow on sloping terrain); average depths determined. For areas of shallow fine flooding, velocities also determined.

ZONE AR
Special Flood Hazard Area formerly protected from the 1% annual chance flood by a flood control system that was subsequently determined to be inoperable; the former flood control system is being restored to provide protection from the 1% annual chance or greater flood.

ZONE ASR
Areas to be protected from 1% annual chance flood by a Federal flood protection system under construction; no Base Flood Elevations determined.

ZONE VE
Coastal flood zone with velocity hazard (wave action); Base Flood Elevations determined.

FLOODWAY AREAS IN ZONE AE
The floodway is the channel of a stream plus any adjacent floodplain areas that must be kept free of encroachment so that the 1% annual chance flood can be carried without substantial increases in flood heights.

OTHER FLOOD AREAS

ZONE X
Areas of 0.2% annual chance flood; areas of 1% annual chance flood with average depths of less than 1 foot or with drainage areas less than 1 square mile, and areas protected by levees from 1% annual chance flood.

OTHER AREAS
Areas determined to be outside the 0.2% annual chance floodplain. Areas in which flood hazards are undetermined, but possible.

COASTAL BARRIER RESOURCES SYSTEM (CBRS) AREAS

OTHERWISE PROTECTED AREAS (OPAs)
CBRS areas and OPAs are normally located within or adjacent to Special Flood Hazard Areas.

MAP REPOSITORIES
Refer to Map Repositories list on Map Index.

EFFECTIVE DATE OF COUNTYWIDE FLOOD INSURANCE RATE MAP PANEL
SEPTEMBER 20, 1996

EFFECTIVE DATE(S) OF REVISION(S) TO THIS PANEL
April 2, 2002 - to update corporate limits to change Base Flood Elevations and Special Flood Hazard Areas; to add roads and road names; to reflect updated topographic information, and to incorporate previously issued Letters of Map Revision.
November 19, 2003 - to update corporate limits and to incorporate previously issued Letters of Map Revision.
September 26, 2008 - to update corporate limits, to change Special Flood Hazard Areas to add roads and road names; to incorporate previously issued Letters of Map Revision; to reflect updated topographic information; to change Base Flood Elevations; to add Base Flood Elevations.

For community map revision history prior to countywide mapping, refer to the Community Map History table located in the Flood Insurance Study report for this jurisdiction.

To determine if flood insurance is available in this community, contact your insurance agent or call the National Flood Insurance Program at 1-800-638-6620.

MAP SCALE 1" = 600'

250 0 500 1000
150 0 150 300
FEET
METERS

NATIONAL FLOOD INSURANCE PROGRAM

PANEL 0141G

FIRM

FLOOD INSURANCE RATE MAP

BERNALILLO COUNTY, NEW MEXICO

AND INCORPORATED AREAS

PANEL 141 OF 825

(SEE MAP INDEX FOR FIRM PANEL LAYOUT)

CONTAINS	COMMUNITY	NUMBER	PANEL	SUFFIX
	ALBUQUERQUE CITY OF	350002	0141	G
	BERNALILLO COUNTY UNINCORPORATED AREAS	350001	0141	G

Notice to User: The Map Number shown below should be used when placing map orders; the Community Number shown above should be used on insurance applications for the subject community.

MAP NUMBER
35001C0141G

MAP REVISED
SEPTEMBER 26, 2008

Federal Emergency Management Agency

NOTES TO USERS

This map is for use in administering the National Flood Insurance Program. It does not necessarily identify all areas subject to flooding, particularly from local drainage sources of small size. The community map repository should be consulted for possible updated or additional flood hazard information.

To obtain more detailed information in areas where **Base Flood Elevations** (BFEs) and/or **floodways** have been determined, users are encouraged to consult the Flood Profiles and Floodway Data and/or Summary of Stillwater Elevations tables contained within the Flood Insurance Study (FIS) report that accompanies this FIRM. Users should be aware that BFEs shown on the FIRM represent rounded whole-foot elevations. These BFEs are intended for flood insurance rating purposes only and should not be used as the sole source of flood elevation information. Accordingly, flood elevation data presented in the FIS report should be utilized in conjunction with the FIRM for purposes of construction and/or floodplain management.

Coastal Base Flood Elevations shown on this map apply only landward of 0.0 North American Vertical Datum of 1988 (NAVD 88). Users of this FIRM should be aware that coastal flood elevations are also provided in the Summary of Stillwater Elevations table in the Flood Insurance Study Report for this jurisdiction. Elevations shown in the Summary of Stillwater Elevations table should be used for construction, and/or floodplain management purposes when they are higher than the elevations shown on this FIRM.

Boundaries of the **floodways** were computed at cross sections and interpolated between cross sections. The floodways were based on hydraulic considerations with regard to requirements of the National Flood Insurance Program. Floodway widths and other pertinent floodway data are provided in the Flood Insurance Study report for this jurisdiction.

Certain areas not in Special Flood Hazard Areas may be protected by **flood control structures**. Refer to Section 2.4 "Flood Protection Measures" of the Flood Insurance Study report for information on flood control structures in this jurisdiction.

The **projection** used in the preparation of this map was New Mexico State Plane, Central Zone (NAD 83). The horizontal datum was NAD 83, GRS80 spheroid. Differences in datum, spheroid, projection or State Plane zones used in the production of FIRMs for adjacent jurisdictions may result in slight positional differences in map features across jurisdiction boundaries. These differences do not affect the accuracy of this FIRM.

Flood elevations on this map are referenced to the North American Vertical Datum of 1988. These flood elevations must be compared to structure and ground elevations referenced to the same vertical datum. For information regarding conversion between the National Geodetic Vertical Datum of 1929 and the North American Vertical Datum of 1988, visit the National Geodetic Survey website at <http://www.ngs.noaa.gov> or contact the National Geodetic Survey at the following address:

NGS Information Services
 NOAA, NNGS12
 National Geodetic Survey, SSMC-3, #9202
 1315 East-West Highway
 Silver Spring, Maryland 20910-3282
 (301) 713-3242

To obtain current elevation, description, and/or location information for **bench marks** shown on this map, please contact the Information Services Branch of the National Geodetic Survey at (301) 713-3242, or visit their website at <http://www.ngs.noaa.gov/>.

Base map information shown on this FIRM was provided in digital format by City of Albuquerque, 2010, Bernalillo County, 2004, and 2010, Bureau of Land Management, 2003, National Geodetic Survey, 2003, and United States Geological Survey (USGS), 1999. Additional information was photogrammetrically compiled at a scale of 1:12,000 from U.S. Department of Agriculture aerial photography dated 2009.


This map reflects more detailed and up-to-date **stream channel configurations** than those shown on the previous FIRM for this jurisdiction. The floodplains and floodways that were transferred from the previous FIRM may have been adjusted to conform to these new stream channel configurations. As a result, the Flood Profiles and Floodway Data tables in the Flood Insurance Study report (which contains authoritative hydraulic data) may reflect stream channel distances that differ from what is shown on this map.

Corporate limits shown on this map are based on the best data available at the time of publication. Because changes due to annexations or de-annexations may have occurred after this map was published, map users should contact appropriate community officials to verify current corporate limit locations.

Please refer to the separately printed **Map Index** for an overview map of the county showing the layout of map panels; community map repository addresses; and a listing of Communities table containing National Flood Insurance Program dates for each community as well as a listing of the panels on which each community is located.

For information on available products associated with this FIRM visit the **Map Service Center (MSC)** website at <http://msc.fema.gov>. Available products may include previously issued Letters of Map Change, a Flood Insurance Study Report, and/or digital versions of this map. Many of these products can be ordered or obtained directly from the MSC website.

If you have **questions about this map**, how to order products or the National Flood Insurance Program in general, please call the **FEMA Map Information Exchange (FMIX)** at 1-877-FEMA-MAP (1-877-336-2627) or visit the FEMA website at <http://www.fema.gov/business/nfp>.

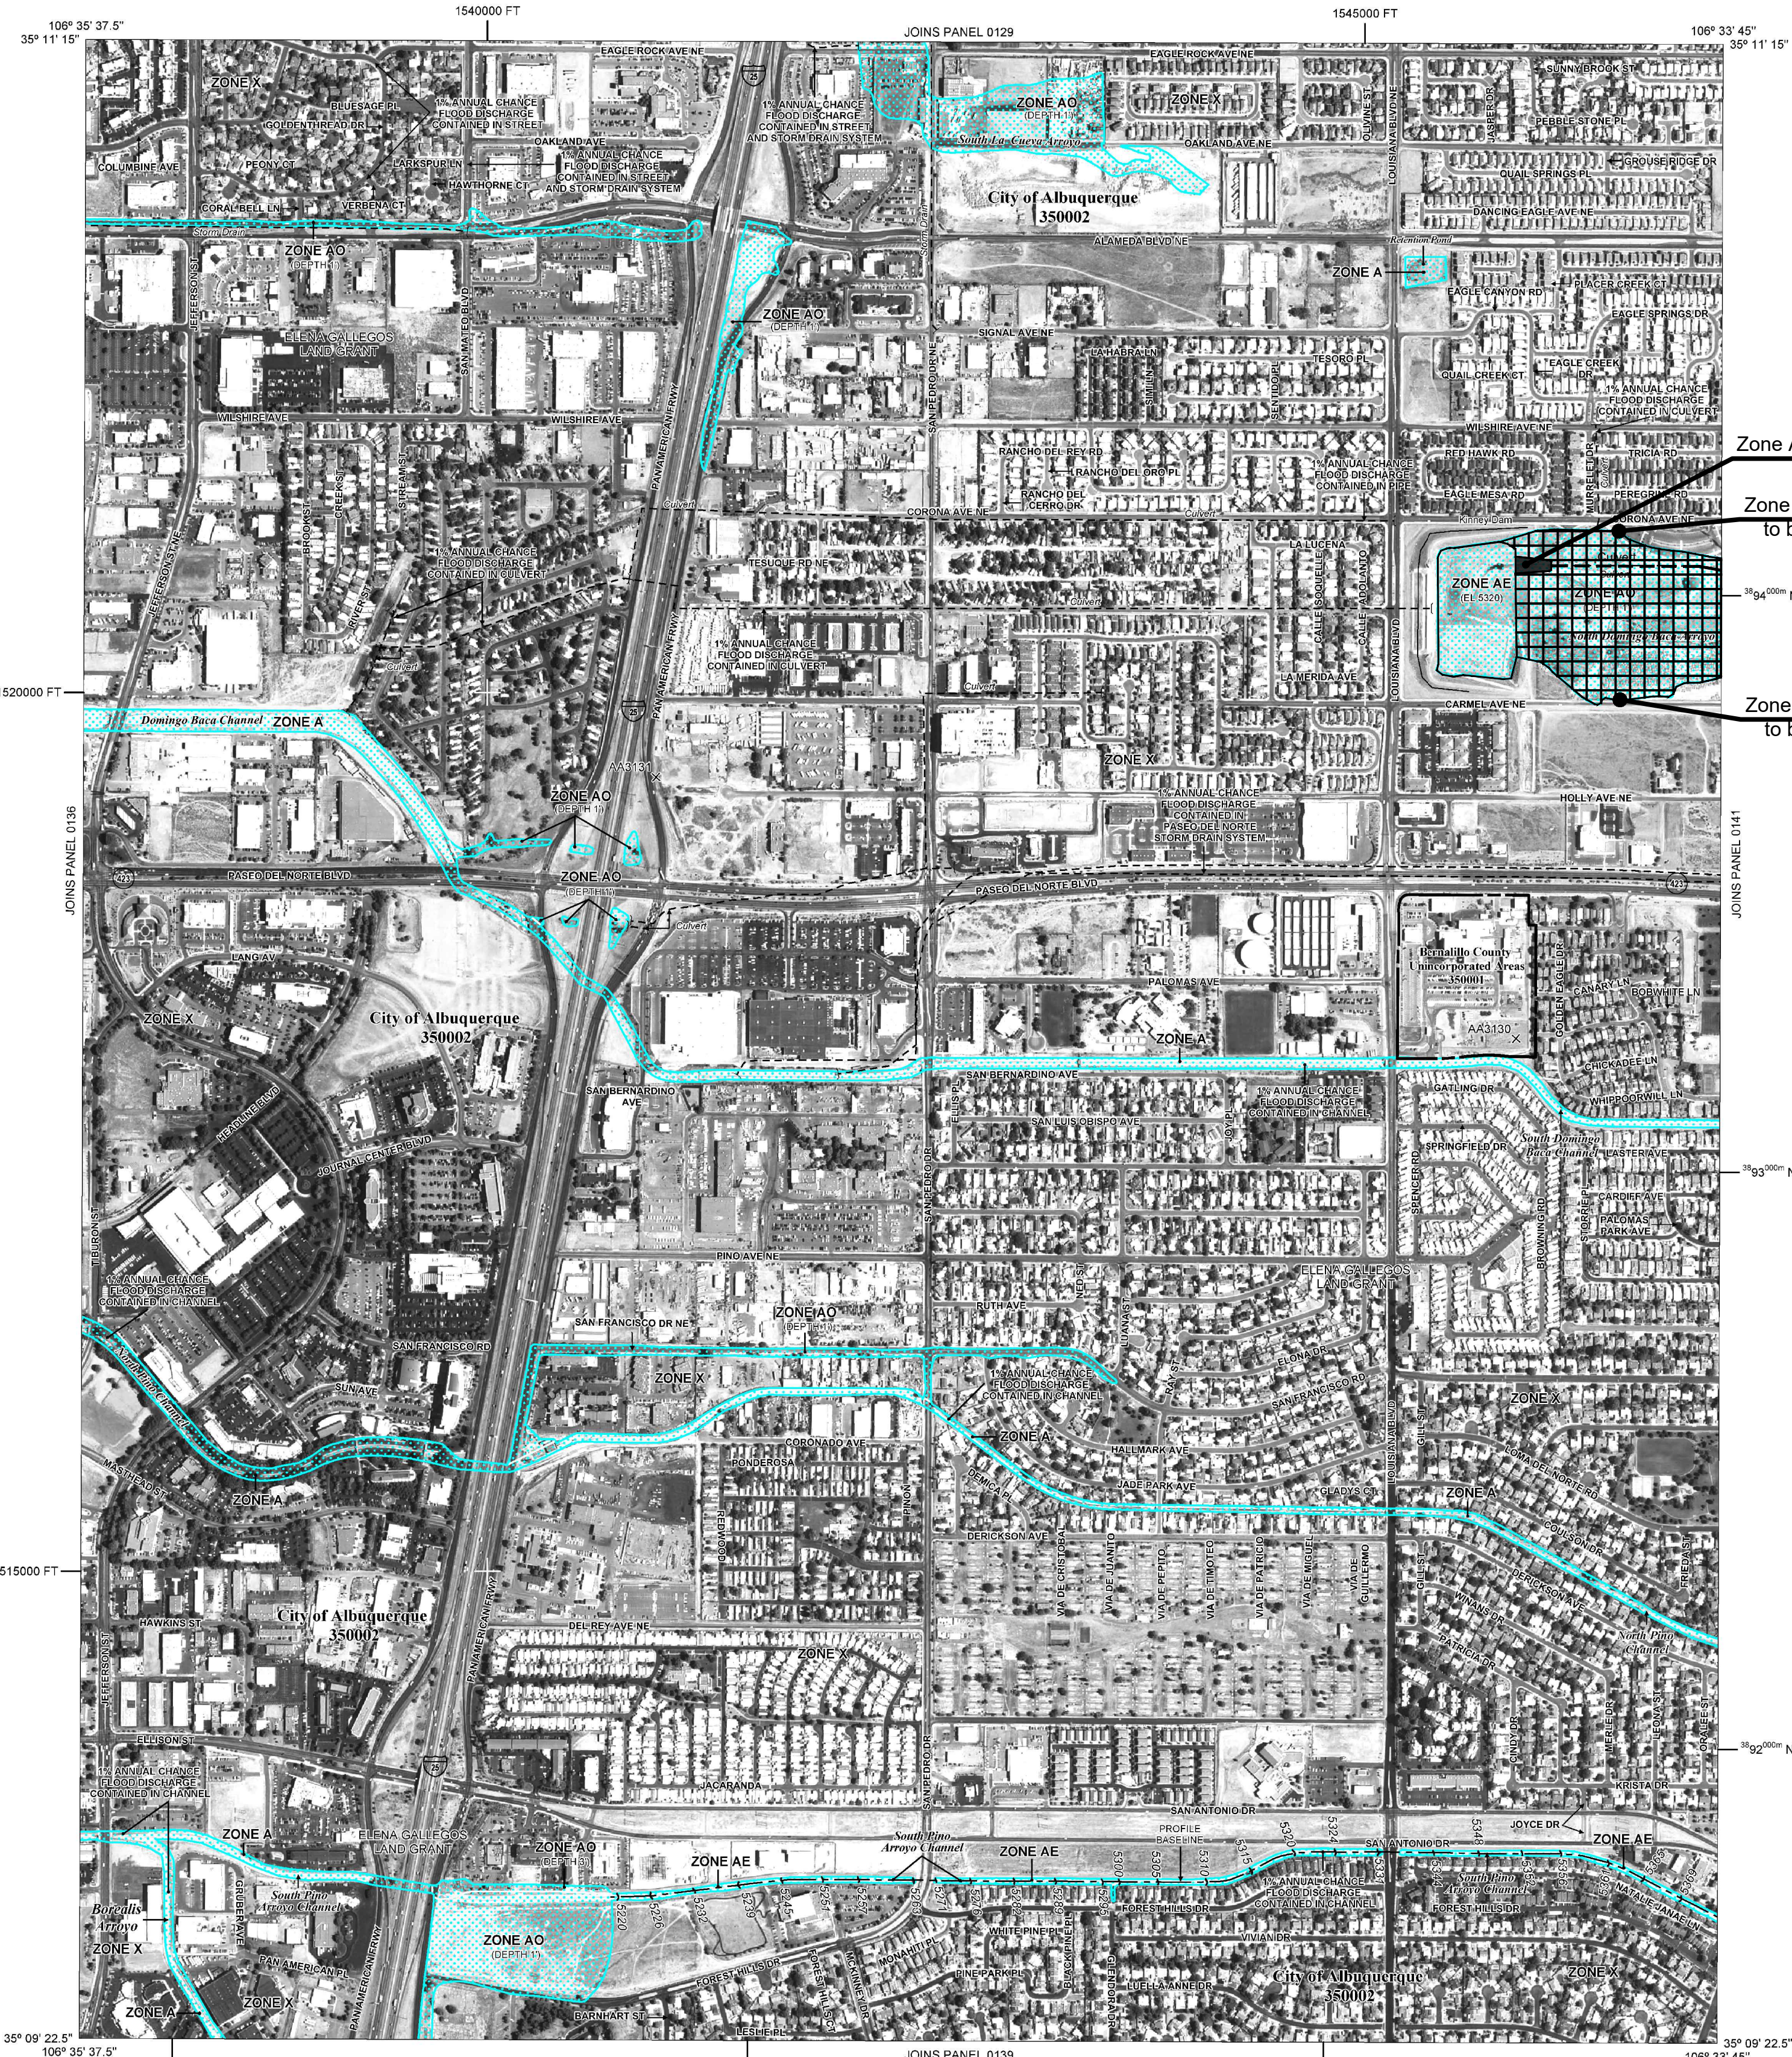

LEGEND

SPECIAL FLOOD HAZARD AREAS (SFHAs) SUBJECT TO INUNDATION BY THE 1% ANNUAL CHANCE FLOOD

The 1% annual chance flood (100-year flood), also known as the base flood, is the flood that has a 1% chance of being equaled or exceeded in any given year. The Special Flood Hazard Area is the area subject to flooding by the 1% annual chance flood. Areas of Special Flood Hazard include Zones A, AE, AH, AO, AR, AV, V, and VE. The Base Flood Elevation is the water surface elevation of the 1% annual chance flood.

ZONE A
 No Base Flood Elevations determined.

ZONE AE
 Base Flood Elevations determined.

ZONE AH
 Flood depths of 1 to 3 feet (usually areas of ponding); Base Flood Elevations determined.

ZONE AO
 Flood depths of 1 to 3 feet (usually sheet flow on sloping terrain); average depths determined. For areas of unusual fan flooding, velocities also determined.

ZONE AR
 Special Flood Hazard Area formerly protected from the 1% annual chance flood by a flood control system that was subsequently determined. Zone AR indicates that the former flood control system is being removed to provide protection from the 1% annual chance or greater flood.

ZONE AV
 Area to be protected from 1% annual chance flood by a Federal flood protection system under construction; no Base Flood Elevations determined.

ZONE VE
 Coastal flood zone with velocity hazard (wave action); Base Flood Elevations determined.

FLOODWAY AREAS IN ZONE AE
 The floodway is the channel of a stream plus any adjacent floodplain areas that must be kept free of encroachment so that the 1% annual chance flood can be carried without substantial increases in flood heights.

OTHER FLOOD AREAS

ZONE X
 Areas of 0.2% annual chance flood; areas of 1% annual chance flood with average depths of less than 1 foot or with drainage areas less than 1 square mile; and areas protected by levees from 1% annual chance flood.

OTHER AREAS
 Areas determined to be outside the 0.2% annual chance floodplain.

COASTAL BARRIER RESOURCES SYSTEM (CBRS) AREAS
 Areas in which flood hazards are understood, but possible.

OTHERWISE PROTECTED AREAS (OPAs)
 CBRS areas and OPAs are normally located within or adjacent to Special Flood Hazard Areas.

1% annual chance floodplain boundary
 0.2% annual chance floodplain boundary
 Floodway boundary
 Zone D boundary
 Zone A boundary
 CBRS and OPA boundary
 Boundary dividing Special Flood Hazard Area Zones and boundary dividing Special Flood Hazard Areas of different Base Flood Elevations, flood depths or flood velocities.
 Base Flood Elevation line and value; elevation in feet.
 Base Flood Elevation value where uniform within zone; elevation in feet.
 *Referenced to the North American Vertical Datum of 1988

Cross section line
 23 - - - - 23
 07° 07' 30", 32° 32' 30"

Transect line
 Geographic coordinates referenced to the North American Datum of 1983 (NAD 83), Western Hemisphere
 1000-meter Universal Transverse Mercator grid values, zone 13
 5000-foot grid ticks: New Mexico State Plane coordinate system, Central zone (NAD 83), Transverse Mercator
 Bench mark (see explanation in Notes to Users section of this FIRM panel)
 11.5

MAP REPOSITORIES
 Refer to Map Repositories list on Map Index.

EFFECTIVE DATE OF COUNTYWIDE FLOOD INSURANCE RATE MAP PANEL
 SEPTEMBER 20, 1996

EFFECTIVE DATE(S) OF REVISION(S) TO THIS PANEL
 April 2, 2002
 November 19, 2003
 September 26, 2008

August 16, 2012 - to update corporate limits to change Base Flood Elevations to add Special Flood Hazard Areas, to change Special Flood Hazard Areas, to add roads and road names, to incorporate previously issued Letters of Map Change.

For community map revision history prior to countywide mapping, refer to the Community Map History table located in the Flood Insurance Study report for this jurisdiction.

To determine if flood insurance is available in this community, contact your insurance agent or call the National Flood Insurance Program at 1-800-638-6620.

MAP SCALE 1" = 500'

200 0 500 1000
 FEET
 100 0 100 200
 METERS

PANEL 0137H

FIRM

FLOOD INSURANCE RATE MAP

BERNALILLO COUNTY, NEW MEXICO AND INCORPORATED AREAS

PANEL 137 OF 825

(SEE MAP INDEX FOR FIRM PANEL LAYOUT)

CONTAINS	COMMUNITY	NUMBER	PANEL	SUFFIX
	ALBUQUERQUE, CITY OF	350002	0137	H
	BERNALILLO COUNTY UNINCORPORATED AREAS	350001	0137	H

Notice to User: The Map Number shown below should be used when citing map indices. Community Number shown below should be used on insurance applications for the subject community.

MAP NUMBER 35001C0137H

MAP REVISED AUGUST 16, 2012

Federal Emergency Management Agency

Item 6
References

Item 6. References

City of Albuquerque. (2012). **Flood Insurance Study Number 35001CV001D** [FIS Report]. Retrieved from FEMA Flood Map Service Center: [FEMA Flood Map Service Center | Welcome!](#)

Final Design Analysis Report for Lower North Domingo Baca Detention Dam (Resource Technology, Inc., 1995)

Item 7

North Domingo Baca Park Phase 4 Construction – Box Culvert Record Drawings



CITY OF ALBUQUERQUE

DEPARTMENT OF MUNICIPAL DEVELOPMENT

PARK DESIGN AND CONSTRUCTION DIVISION

CONSTRUCTION PLANS FOR

NORTH DOMINGO BACA PARK

PHASE 4 CONSTRUCTION - BOX CULVERT

WYOMING BOULEVARD TO KINNEY DAM

JULY 2005

INDEX OF DRAWINGS

SHEET NO.	TITLE
1	TITLE SHEET, VICINITY MAP, INDEX OF DRAWINGS
2	GENERAL NOTES & LEGEND
3	EXISTING SITE & SURVEY DATA
4	REMOVAL PLAN
5	GRADING & DRAINAGE PLAN
6	CBC PLAN & PROFILE STA. 9+65.55 TO STA. 17+00
7	CBC PLAN & PROFILE STA. 17+00 TO STA. 24+00
8	CBC PLAN & PROFILE STA. 24+00 TO 27+99
9	CBC DETAIL - NMDOT SERIAL CB-32-1
10	CBC DETAIL - NMDOT SERIAL CB-32-2
11	CONCRETE BOX CULVERT DETAILS
12	SECTIONS & DETAILS
13	TRANSITION STRUCTURE SECTIONS & DETAILS
14	STEEL GRATE SECTIONS & DETAILS

DISCLOSURE STATEMENT:
 THE SUBJECT PROPERTY IS LOCATED ON/NEAR A FORMER LANDFILL. DUE TO SUBJECT PROPERTY BEING ON/NEAR A FORMER LANDFILL, CERTAIN PRECAUTIONARY MEASURES MAY NEED TO BE TAKEN TO ENSURE THE HEALTH AND SAFETY OF THE PUBLIC. RECOMMENDATIONS MADE BY A PROFESSIONAL ENGINEER WITH EXPERTISE IN LANDFILLS AND LANDFILL GAS ISSUES (AS REQUIRED BY THE MOST CURRENT VERSION OF THE "INTERIM GUIDELINES FOR DEVELOPMENT WITHIN 1000 FEET OF LANDFILLS") SHALL BE CONSULTED PRIOR TO DEVELOPMENT OF THE SITE.

APPROVED FOR CONSTRUCTION


 MARCIA PINCUS, P.E.
 ENVIRONMENTAL HEALTH DEPARTMENT
 CITY OF ALBUQUERQUE
 DATE: August 3, 2005

APPROVED FOR CONSTRUCTION - CITY OF ALBUQUERQUE

 JOHN KELLY, P.E.
 EXECUTIVE ENGINEER
 ALBUQUERQUE METROPOLITAN ARROYO FLOOD CONTROL AUTHORITY
 DATE: 7-19-05

APPROVED FOR CONSTRUCTION WITHIN AMAFCA R.O.W.

 JOHN KELLY, P.E.
 EXECUTIVE ENGINEER
 ALBUQUERQUE METROPOLITAN ARROYO FLOOD CONTROL AUTHORITY
 DATE: 7-19-05

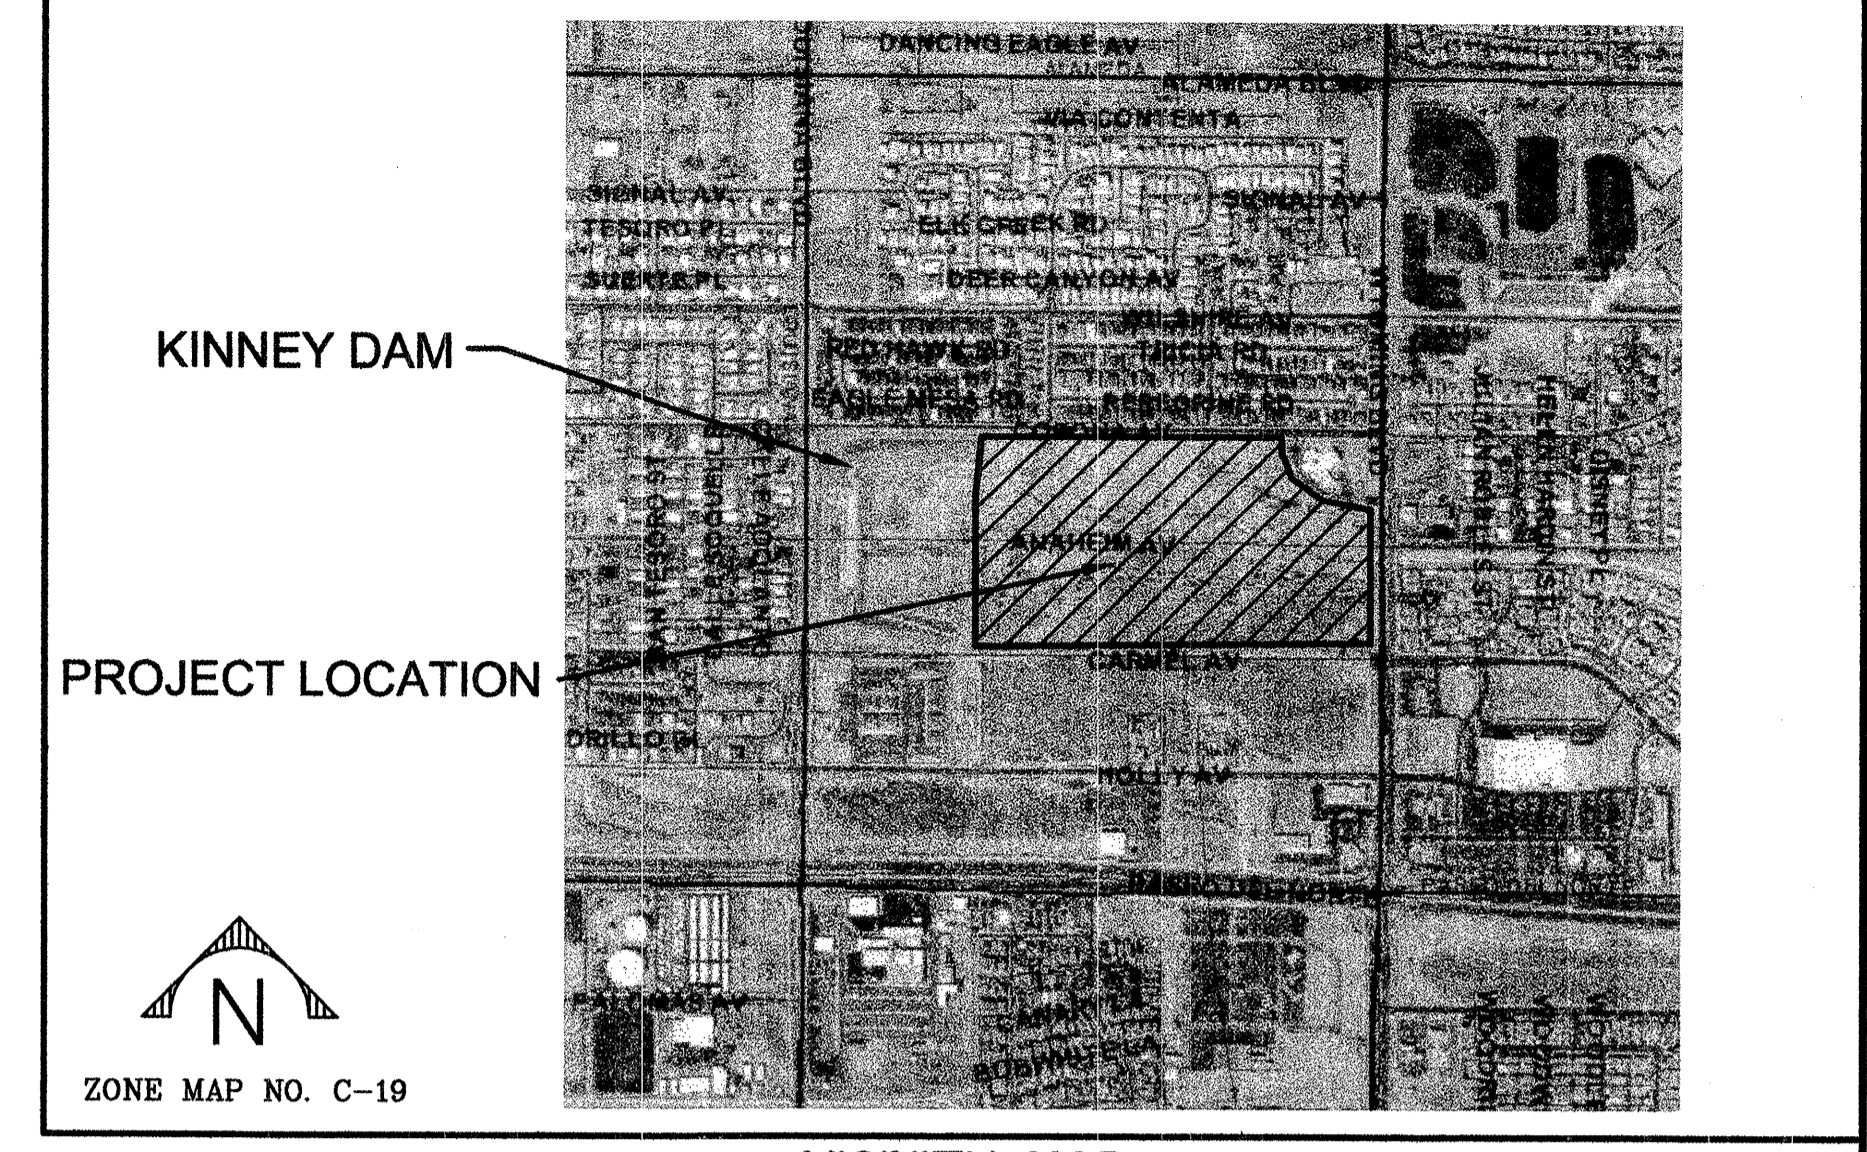

VICINITY MAP

UTILITY COMPANY CONTACTS

<p>CITY OF ALBUQUERQUE (WATER & SEWER) BILL BALCH Engineer/Utility Development P.O. Box 1293 Albuquerque, New Mexico 87103 (505) 768-2729</p>	<p>COMCAST CABLE RITA ERICKSON Planning and Design Supervisor 4611 Montbel Pl. NE Albuquerque, New Mexico 87107 (505) 761-6235</p>	<p>XSPEDIUS MANAGEMENT CO. STEVE BENJAMIN Operations Support Manager 505 Marquette Ave. NW, Suite 1605 Albuquerque, New Mexico 87102 (505) 998-2220</p>
<p>PNM-ELECTRIC JIM HILL Engineering Representative 4201 Edith Blvd., NE MS-ES61 Albuquerque, New Mexico 87107 (505) 241-3581</p>	<p>UNIVERSAL ACCESS JAMIE MARTINEZ Resource Supervisor 505 Marquette Ave. NW, #19A Albuquerque, New Mexico 87102 (505) 328-2675</p>	<p>OSI GRANDE TECHNOLOGIES BUD LENSING 5921 Jefferson St. NE Albuquerque, New Mexico 87109 (505) 345-6555</p>
<p>PNM-GAS CO. JOE DUNLOP Project Engineer 4625 Edith Blvd., NE Albuquerque, New Mexico 87107 (505) 241-7771</p>	<p>E-SPiRE (ACSI) JOHN MARES 505 Marquette Ave. NE, Suite 1605 Albuquerque, New Mexico 87102 (505) 998-2274</p>	
<p>QWEST/US WEST DAVID MULLER Capacity Provisioning Specialist 400 Tijeras Ave. NW, Suite 710 Albuquerque, New Mexico 87102 (505) 245-8706</p>	<p>McLeod USA RICK MUELLER Supervisor of Outside Techs. 505 Marquette Ave. NE, Suite 1600 Albuquerque, New Mexico 87102 (505) 244-3161</p>	<p>CALL BEFORE YOU DIG! STATEWIDE 1-800-321-ALERT ALBUQUERQUE 260-1990</p>
<p>QWEST LONG DISTANCE LARRY KELLY Senior Operations Tech 400 Tijeras Ave. NW, Suite 570 Albuquerque, New Mexico 87102 (505) 246-0501</p>	<p>CityNet TELECOMMUNICATIONS JOSH NELSON Field Representative 13500 Coronado Freeway Albuquerque, New Mexico 87121 (505) 991-2120</p>	
<p>AT&T DAVID CROWEL Resource Supervisor 111 Third St., NW Albuquerque, New Mexico 87103 (505) 842-2911</p>	<p>TIME WARNER TELECOM ROYAL HARRISON Plant Manager 3830 Singer Blvd. NE, Suite 1000 Albuquerque, New Mexico 87109 (505) 938-7339</p>	
<p>MCI WORLDCOM ANDY DARNELL Operation Manager 6001 Midway Park NE Albuquerque, New Mexico 87109 (505) 346-4470</p>	<p>LEVEL 3 COMMUNICATIONS, LLC STEVE GILMAN Resource Supervisor 1025 Eldorado Blvd. Broomfield, Colorado 80021 (720) 888-5920</p>	

REV.	SHEETS	CITY ENGINEER	DATE	USER DEPARTMENT	DATE	USER DEPARTMENT	DATE
ENGINEERS STAMP & SIGNATURE		APPROVED	ENGINEER	DATE	APPROVED FOR CONSTRUCTION		
		ORC Chairman		8-4-05	 JOHN KELLY, P.E. CITY ENGINEER		
		Transportation					
		Water/Wastewater	William J. Baker	8-1-05			
		Hydrology					
		CIP					
		Constr. Coord.		8-4-05			
		Perks					
				PROJECT NUMBER	7138.92	SHEET 1 OF 14	

- 1 THE SPECIFICATIONS USED FOR THIS PROJECT ARE THE CITY OF ALBUQUERQUE STANDARD SPECIFICATIONS FOR PUBLIC WORKS CONSTRUCTION, 1986 EDITION, THROUGH UPDATE NO.7.
- 2 FIVE (5) WORKING DAYS PRIOR TO BEGINNING CONSTRUCTION, THE CONTRACTOR WILL SUBMIT A DETAILED CONSTRUCTION SCHEDULE TO THE CITY CONSTRUCTION COORDINATION DIVISION. TWO (2) DAYS PRIOR TO CONSTRUCTION, THE CONTRACTOR WILL OBTAIN A BARRICADING PERMIT FROM THE CONSTRUCTION COORDINATION DIVISION. CONTRACTOR SHALL NOTIFY BARRICADE ENGINEER (924-3400) PRIOR TO OCCUPYING AN INTERSECTION. REFER TO SECTION 19 OF STANDARD SPECIFICATIONS FOR PUBLIC WORKS.
- 3 THE CONTRACTOR WILL NOTIFY THE FIELD ENGINEER NOT LESS THAN SEVEN (7) DAYS PRIOR TO STARTING WORK, IN ORDER THAT THE CITY SURVEYOR MAY TAKE NECESSARY MEASURES TO INSURE THE PRESERVATION OF CITY AND AMAFCA SURVEY MONUMENTS. THE CONTRACTOR WILL NOTIFY THE ENGINEER IF A MONUMENT IS DISTURBED. REPLACEMENT WILL BE DONE ONLY BY THE CITY SURVEY SECTION. WHEN A CHANGE IS MADE IN THE FINISHED ELEVATION OF THE PAVEMENT OF ANY ROADWAY IN WHICH A PERMANENT SURVEY MONUMENT IS LOCATED, CONTRACTOR WILL, AT HIS OWN EXPENSE, ADJUST THE MONUMENT COVER TO THE NEW GRADE UNLESS OTHERWISE SPECIFIED. REFER TO SECTION 4 OF STANDARD SPECIFICATIONS FOR PUBLIC WORKS.
- 4 ALL NEW MANHOLES SHALL BE TYPE "E" (COA DWG. 2102) UNLESS OTHERWISE NOTED ON THE PLANS.
- 5 THE CONTRACTOR WILL BE RESPONSIBLE FOR DISPOSING OF ALL DEBRIS, INCLUDING, BUT NOT LIMITED TO HAZARDOUS WASTE AT DISPOSAL SITES APPROVED BY GOVERNMENTAL AGENCIES REGULATING THE DISPOSAL OF SUCH MATERIALS.
- 6 ALL WATER VALVE BOXES AND MANHOLES IN THE STREET CONSTRUCTION ARE TO BE ADJUSTED TO FINISH GRADE AND WILL BE MEASURED AND PAID PER EACH.
- 7 SUBGRADE PREPARATION UNDER SIDEWALKS AND DRIVE PADS, AND SUBGRADE AND SUBBASE PREPARATION UNDER CURB AND GUTTER IS CONSIDERED INCIDENTAL TO THE CONSTRUCTION OF SUCH, AND NO DIRECT PAYMENT SHALL BE MADE FOR THOSE ITEMS OF WORK.
- 8 THE WATER SYSTEMS DIVISION (857-8200) WILL BE NOTIFIED BY THE CONTRACTOR SEVEN (7) WORKING DAYS IN ADVANCE OF ANY WORK WHICH MAY AFFECT THE EXISTING PUBLIC WATER FACILITIES. REFER TO SECTION 18 OF STANDARD SPECIFICATIONS.
- 9 ALL EXCAVATION WILL BE GOVERNED BY FEDERAL, STATE AND LOCAL LAWS, RULES, AND REGULATIONS CONCERNING CONSTRUCTION SAFETY AND HEALTH. ALL EXCAVATING, TRENCHING & SHORING ACTIVITIES MUST BE CARRIED-OUT IN ACCORDANCE WITH OSHA 1926.650 SUBPART P.
- 10 ALL SIGNS AND CODING WILL BE IN ACCORDANCE WITH THE "MANUAL OF UNIFORM TRAFFIC CONTROL DEVICES FOR STREETS AND HIGHWAYS" CURRENT EDITION PUBLISHED BY THE U.S. DEPARTMENT OF TRANSPORTATION.
- 11 THE CONTRACTOR IS TO EXERCISE CARE TO AVOID DISTURBING ANY EXISTING UNDERGROUND UTILITIES. IT IS THE CONTRACTOR'S RESPONSIBILITY TO COORDINATE WITH THE UTILITY COMPANIES IN ORDER TO PREVENT ANY SERVICE DISRUPTION. SEE SECTION 18 "UTILITIES", CITY OF ALBUQUERQUE, STANDARD SPECIFICATIONS FOR CONTRACTOR REQUIREMENTS.
- 12 WHEN ABUTTING NEW PAVEMENT TO EXISTING INTERSECTING STREETS, SAW CUT EXISTING PAVEMENT TO A STRAIGHT LINE AND AT RIGHT ANGLES AND REMOVE ANY BROKEN OR CRACKED PAVEMENT. NO DIRECT PAYMENT WILL BE MADE FOR SAW CUTTING.
- 13 ALL GAS VALVES, GAS MANHOLES, ELECTRICAL MANHOLES, TELEPHONE MANHOLES, AND UTILITY POLES WILL BE ADJUSTED TO GRADE BY EACH UTILITY COMPANY. CONTRACTOR WILL COORDINATE THROUGH CITY UTILITY COORDINATOR.
- 14 WHEN REMOVAL OF EXISTING CURB AND GUTTER OR SIDEWALK IS REQUIRED, REMOVE BACK TO NEAREST SUITABLE JOINT UNLESS OTHERWISE DIRECTED BY THE CITY FIELD ENGINEER.
- 15 THE CONTRACTOR WILL NOTIFY NEW MEXICO ONE CALL SYSTEM 280-1990 TWO (2) WORKING DAYS PRIOR TO COMMENCING WORK IN NEW AREAS.
- 16 CONTRACTOR WILL MAKE ALL WATER VALVES AND MANHOLES ACCESSIBLE TO THE CITY AT ALL TIMES.
- 17 CONTRACTOR WILL PLACE BITUMINOUS MATERIAL WITH THE USE OF A LAYDOWN MACHINE WHERE PAVEMENT IS 8 FEET IN WIDTH OR WIDER.
- 18 ALL SUBGRADE AND SUBBASE MATERIAL ENCOUNTERED IN PAVEMENT REMOVAL AND REPLACEMENT THAT IS DETERMINED BY THE FIELD ENGINEER TO MEET THE SPECIFICATIONS, CAN BE REUSED. HOWEVER, THE MATERIAL WILL BE PROCESSED AND COMPACTED TO MEET MOISTURE CONTENT AND PERCENT COMPACTION REQUIRED BY THE SPECIFICATIONS.
- 19 CONTRACTOR WILL NOT PAVE OVER ANY SURFACE FEATURE, I.E., GAS VALVE, MANHOLE COVER, ETC. WITHOUT PRIOR APPROVAL FROM THE CITY FIELD ENGINEER.
- 20 CONTRACTOR WILL CONFINE HIS OR HER WORK WITHIN THE CONSTRUCTION EASEMENT LIMITS AND/OR RIGHT-OF-WAY, OR PROVIDE COPIES OF AGREEMENTS WITH ADJACENT LANDOWNERS TO THE CITY OF ALBUQUERQUE.

- 21 ALL WATER VALVES AND FIRE HYDRANTS REMOVED WILL BE SALVAGED AND RETURNED TO THE C.O.A.
- 22 MINIMUM BOTTOM WIDTH OF TRENCHES FOR RIGID PIPE SHALL BE EQUAL TO THE OUTSIDE DIAMETER PLUS 16 INCHES. BEDDING MATERIAL SHALL BE CLASS II, III, OR IV UNLESS OTHERWISE SPECIFICALLY NOTED ON THE PLANS.
- 23 MINIMUM BOTTOM WIDTH OF TRENCHES FOR NON-RIGID PIPE SHALL BE EQUAL TO THE OUTSIDE DIAMETER PLUS 12 INCHES. BEDDING MATERIAL SHALL BE CLASS I, II, OR III.
- 24 THE CONTRACTOR AGREES TO TAKE NECESSARY SAFETY PRECAUTIONS AS REQUIRED BY FEDERAL, STATE AND LOCAL AUTHORITIES TO PROTECT PEDESTRIAN AND VEHICULAR TRAFFIC IN THE CONSTRUCTION AREA, WHICH INCLUDE BUT ARE NOT LIMITED TO: MAINTAINING ADEQUATE WARNING SIGNS, BARRICADES, LIGHTS, GUARD FENCES, WALKS AND BRIDGES.
- 25 ALL STRUCTURAL CONCRETE TO BE 4000 PSI UNLESS OTHERWISE NOTED ON PLANS.
- 26 ALL REINFORCING STEEL TO BE GRADE 60.
- 27 ALL EXPOSED EDGES ON CAST-IN-PLACE CONCRETE STRUCTURES WILL HAVE A 1" CHAMFER UNLESS OTHERWISE NOTED.
- 28 ALL SPLICES IN REINFORCING STEEL WILL BE 2-FOOT 6-INCH MINIMUM UNLESS OTHERWISE NOTED.
- 29 PRIOR TO CONSTRUCTION, THE CONTRACTOR WILL EXCAVATE AND VERIFY THE HORIZONTAL AND VERTICAL LOCATIONS OF ALL POTENTIAL CONFLICTING UTILITIES. SHOULD A CONFLICT EXIST BETWEEN THE FIELD INFORMATION AND THE PLANS, THE CONTRACTOR WILL NOTIFY THE CITY FIELD ENGINEER SO THE CONFLICT CAN BE RESOLVED WITH MINIMUM AMOUNT OF DELAY.
- 30 THE REPLACEMENT OF EXISTING UTILITIES AND THE INSTALLATION OF NEW UTILITY LINES WILL BE COMPLETED IN ADVANCE OF STARTING THE PAVEMENT WORK. TEMPORARY PAVEMENT WILL BE PLACED IN ALL TRENCHES REQUIRED FOR THE UTILITY REPLACEMENTS IN THOSE AREAS THAT MUST MAINTAIN TRAFFIC UNTIL THE FINAL PAVEMENT WORK STARTS IN EACH AREA. TEMPORARY STRIPING SHALL BE THE CONTRACTOR'S RESPONSIBILITY. MAINTENANCE OF THE TEMPORARY PAVING AND STRIPING WILL BE AT THE CONTRACTOR'S EXPENSE.
- 31 TACK COAT FOR SURFACE COURSE REQUIREMENTS WILL BE DETERMINED BY THE FIELD ENGINEER.
- 32 THE CONTRACTOR WILL CONTACT THE CITY OF ALBUQUERQUE TRAFFIC DIVISION 764-1599, ONE (1) WEEK IN ADVANCE OF ANY CHANGES REQUIRED IN THE TRAFFIC SIGNALIZATION OF THIS PROJECT. ALL WORK ASSOCIATED WITH NEW TRAFFIC SIGNALIZATION SHALL BE THE RESPONSIBILITY OF THE CONTRACTOR.
- 33 ALL NEW STREET PAVING, DRIVEWAYS, SIDEWALKS, AND CURB AND GUTTERS, ABUTTING EXISTING AREAS SHALL MATCH THE ELEVATION OF THOSE AREAS.
- 34 PERMANENT PAVEMENT STRIPING AND MARKINGS WILL BE PLACED BY THE CONTRACTOR. ROAD SHALL NOT BE OPENED TO TRAFFIC UNTIL IT IS STRIPED. ALL STRIPING, PAVEMENT MARKINGS INCLUDING CROSSWALKS, ARROWS AND LINE MARKINGS ARE TO BE CONSTRUCTED OF HOT PLASTIC OR COLD PLASTIC IN ACCORDANCE WITH THE MANUAL OF UNIFORM TRAFFIC CONTROL DEVICES.
- 35 ALL EXCAVATED MATERIAL THAT IS NOT REQUIRED TO BE REUSED MUST BE REMOVED FROM THE PROJECT AREA WITHIN FOUR DAYS OF EXCAVATION. SPOIL PILES WILL BE ALLOWED ONLY AS DIRECTED BY THE CITY FIELD ENGINEER.
- 36 THE CONTRACTOR WILL COORDINATE THE CONSTRUCTION ACTIVITIES WITH ALL OTHER CONTRACTORS AND UTILITY COMPANIES WORKING IN THE SAME AREA. THE CONTRACTOR MAY BE REQUIRED TO RESCHEDULE THEIR ACTIVITIES TO ALLOW UTILITY CREWS TO PERFORM THEIR REQUIRED WORK. NO ADDITIONAL COMPENSATION WILL BE ALLOWED FOR DELAYS OR INCONVENIENCE CAUSED BY UTILITY COMPANY WORK CREWS. THE CONTRACTOR MAY BE ALLOWED AN EXTENSION OF THE CONTRACT TIME, DUE TO DELAYS, AS DELINEATED IN THE CITY OF ALBUQUERQUE STANDARD SPECIFICATIONS, SECTION 12.
- 37 ALL CONSTRUCTION EASEMENTS ON PRIVATE PROPERTY WILL BE OBTAINED BY THE CONTRACTOR PRIOR TO THE BEGINNING OF CONSTRUCTION.
- 38 EXISTING MEDIAN CURB AND GUTTER AND STANDARD CURB AND GUTTER, NOT DISTURBED BY CONTRACTOR, BUT OUT OF ALIGNMENT, DISPLACED VERTICALLY, BADLY BROKEN AND/OR DETERIORATED, WILL BE REPLACED AS DIRECTED BY THE FIELD ENGINEER AND PAID FOR AT CONTRACT UNIT PRICES.
- 39 ALL TRAFFIC CONTROL DEVICES REQUIRED FOR DRIVEWAY CLOSURES, UTILITY CONSTRUCTION OR FOR OTHER REASONS AND NOT SHOWN ON THE SIGNING PLANS WILL BE FURNISHED BY THE CONTRACTOR AND WILL BE PAID AS SPECIFIED IN THE TECHNICAL SPECIFICATIONS AND BID PROPOSAL. PRIOR TO PLACING THE TRAFFIC CONTROL DEVICES, THE CONTRACTOR WILL NOTIFY THE AFFECTED OWNERS IN ACCORDANCE WITH THE SPECIFICATIONS. CONTRACTOR MUST MAKE PROVISIONS TO PROVIDE ACCESS TO PROPERTIES. REFER TO SECTION 19 OF THE STANDARD SPECIFICATIONS.

- 40 ALL UTILITY LINES WHICH ARE NOT SPECIFICALLY DESIGNATED TO BE REMOVED AND REPLACED ON THE PLANS, WILL BE MAINTAINED IN SERVICE. SHORING, SHEETING AND OTHER MEANS OF SUPPORT SHALL BE EMPLOYED BY THE CONTRACTOR TO PREVENT DAMAGE OR LOSS OF THESE EXISTING UTILITIES. BEAM AND CABLE OR OTHER ADEQUATE SUPPORTS WILL BE USED FOR TEMPORARY SUPPORT OF ALL UTILITY LINES WHICH CROSS THE TRENCH. ANY DAMAGE TO EXISTING UTILITIES WILL PROMPTLY BE REPAIRED AT THE CONTRACTOR'S EXPENSE. THE CONTRACTOR WILL NOTIFY THE ENGINEER IMMEDIATELY OF ANY SIGNIFICANT DEVIATION OF EXPOSED UTILITIES FROM THE LOCATIONS SHOWN ON THE PLANS SO THAT CONFLICTS CAN BE RESOLVED IN A TIMELY MANNER.
- 41 THE CONTRACTOR WILL ASSUME RESPONSIBILITY FOR ANY DAMAGE TO EXISTING COA INFRASTRUCTURE (C & G, PAVING, ETC.) DURING CONSTRUCTION, APART FROM THOSE SECTIONS INDICATED FOR REMOVAL ON THE PLANS, AND WILL REPAIR OR REPLACE SAME AT HIS OR HER OWN EXPENSE. HE/SHE WILL SUITABLY PROTECT THE CURB AND GUTTER FROM INCIDENTAL SPLASHING DURING THE TACK COAT APPLICATION AND WILL BE RESPONSIBLE FOR CLEANING SAME AT HIS OWN COST SHOULD SPLASHING OCCUR.
- 42 ALL INTERFERING PORTIONS OF ABANDONED UTILITY LINES WHICH ARE EXPOSED AS A RESULT OF CONSTRUCTION WILL BE REMOVED AND DISPOSED OF BY THE CONTRACTOR.
- 43 STATIONS OF STORM DRAIN INLETS ARE TO THE CENTER OF GRATE. ALL STORM DRAIN INLETS WILL BE TYPE "A" UNLESS OTHERWISE NOTED ON THE PLANS.
- 44 SHORING COSTS WILL BE CONSIDERED INCIDENTAL TO THE TRENCH AND BACKFILL COSTS.
- 45 THE CONTRACTOR WILL BE RESPONSIBLE FOR SECURING NPDES PERMITS REQUIRED BY APPLICABLE CITY, STATE, AND FEDERAL REGULATIONS.
- 46 ALL STORM DRAIN AND CONNECTOR PIPE WILL BE CLASS IV REINFORCED CONCRETE PIPE UNLESS OTHERWISE NOTED ON THE PLANS.
- 47 THE TERM "REMOVE" USED IN THIS PLAN SET INCLUDES THE DISPOSAL OF SAID MATERIAL IN ACCORDANCE WITH CITY OF ALBUQUERQUE STANDARD SPECIFICATIONS, LATEST EDITION.
- 48 CONTRACTOR WILL SURVEY AND LOG EXISTING ELEVATIONS OF CURB-AND-GUTTER, SIDEWALK, AND PAVEMENT WHICH WILL BE REMOVED FOR CONSTRUCTION OF IMPROVEMENTS. CONTRACTOR WILL REPLACE REMOVED CURB-AND-GUTTER, SIDEWALK, DRIVE PADS, AND PAVEMENT TO ELEVATIONS PRIOR TO REMOVAL UNLESS OTHERWISE INDICATED ON THE PLANS.
- 49 CONTRACTOR WILL CONSTRUCT TEMPORARY ASPHALT PAVEMENT AS DIRECTED BY THE COA ENGINEER TO PROVIDE ACCESS TO LOCAL BUSINESS, ETC. TEMPORARY PAVEMENT SHALL BE REMOVED AND DISPOSED OF PRIOR TO PLACEMENT OF FULL WIDTH PAVEMENT SECTION. TEMPORARY PAVING SHALL BE PER COA STD. DWG. 2415 AND PAID FOR PER COA STD. SPECIFICATIONS.
- 50 ALL EXPOSED CONCRETE SURFACES INCLUDING BUT NOT LIMITED TO RETAINING WALLS, SLOPE PAVING, STRUCTURES, AND CHANNEL LINING SHALL BE TINTED CONCRETE. TINTING SHALL BE SAN DIEGO BUFF AT ONE POUND OF COLOR PER SACK OF CEMENT.
- 51 PRE-WETTING OF THE EMBANKMENT FOUNDATION AND KEY TRENCH SHALL BE CONSIDERED INCIDENTAL TO THE CONSTRUCTION OF THE EMBANKMENT. NO ADDITIONAL PAYMENT WILL BE MADE FOR THIS WORK.
- 52 ALL ASPHALTIC CONCRETE SHALL BE MINIMUM 1800 LB. STABILITY AND COMPACTED TO 95% MODIFIED MARSHALL DENSITY UNLESS OTHERWISE NOTED ON THE PLANS.
- 53 ALL RIP-RAP MATERIAL USED ON THIS PROJECT SHALL BE A NATURAL ROCK MATERIAL CONFORMING TO THE SIZE AND MATERIAL PROPERTY REQUIREMENTS SET FORTH IN THE COA STANDARD SPECIFICATIONS. NO BROKEN CONCRETE OR RUBBLE WILL BE ACCEPTED.
- 54 CONTRACTOR SHALL MAINTAIN A GRAFFITI-FREE SITE. CONTRACTOR SHALL PROMPTLY REMOVE ANY AND ALL GRAFFITI FROM EQUIPMENT, WHETHER PERMANENT OR TEMPORARY.
- 55 ALL STRIPING ON C.O.A. STREETS REMOVED OR DAMAGED MUST BE REPLACED WITH PLASTIC. STRIPING ERADICATION SHALL BE ACCOMPLISHED BY WATER BLASTING OR SURFACE PLANING OF THE ROADWAY TO A MAXIMUM DEPTH OF 0.25 INCHES (MAXIMUM) AND FOR A WIDTH EQUAL TO TWO TIMES THE WIDTH OF THE STRIPE OR MARKING TO BE REMOVED.
- 56 FOR STORM DRAIN CONSTRUCTION, RCP JOINTS SHALL NOT BE GROUTED PRIOR TO FINAL INSPECTION WILL DETERMINED JOINTS TO BE GROUTED FOR FULL INSPECTION ACCEPTANCE OF THE CONSTRUCTION.
- 57 THE CONTRACTOR SHALL ABIDE BY ALL LOCAL, STATE, AND FEDERAL LAWS, RULES, AND REGULATIONS WHICH APPLY TO THE CONSTRUCTION, INCLUDING WORKER HEALTH AND SAFETY ASPECTS, OF THESE IMPROVEMENTS.
- 58 DISPOSAL SITE FOR ALL EXCESS EXCAVATION MATERIAL AND UNSUITABLE MATERIAL SHALL BE OBTAINED BY THE CONTRACTOR IN COMPLIANCE WITH APPLICABLE ENVIRONMENTAL REGULATIONS. ALL COSTS INCURRED IN OBTAINING A FULLY REGULATED DISPOSAL SITE AND HAUL THERE TO SHALL BE CONSIDERED INCIDENTAL TO THE PROJECT AND NO SEPARATE MEASUREMENT OF PAYMENT SHALL BE CONSIDERED.
- 59 ALL DISTURBED GROUND AREAS RESULTING FROM CONSTRUCTION ACTIVITIES SHALL BE REVEGETATED IN ACCORDANCE WITH CITY OF ALBUQUERQUE STANDARD SPECIFICATIONS FOR PUBLIC WORKS CONSTRUCTION, SECTION 1012, NATIVE GRASS SEEDING, AS CURRENTLY UPDATED.


EXISTING FEATURES LEGEND:

- X---X---X--- EXISTING CHAIN-LINK FENCE
- 2" HPO--- EXISTING GAS LINE W/ VALVE
- 6" W--- EXISTING WATERLINE W/ VALVE
- 6" SAS--- EXISTING SANITARY SEWER LINE W/ MANHOLE
- EXISTING FIRE HYDRANT
- 36" RCP--- EXISTING STORM DRAIN
- *--- EXISTING UTILITY POLE
- 44--- EXISTING 1' CONTOUR
- 4845--- EXISTING 5' CONTOUR
- === EXISTING CURB & GUTTER
- EXISTING CONCRETE
- EXISTING BUILDING LINE
- EXISTING EDGE OF PAVEMENT

NEW FEATURES LEGEND:

- CONSTRUCTION CENTERLINE
- NEW CBC BOX CULVERT
- NEW RCP STORM DRAIN
- 44--- NEW 1' CONTOUR
- 5345--- NEW 5' CONTOUR
- NEW CONCRETE
- o¹ POT HOLE LOCATION W/ NO.

AS BUILT INFORMATION	CONTRACTOR: Salls & Brn.	DATE: 3/1/07
BENCH MARKS	STATION NAME: 1-B20; STATE: NM; COUNTY: BERNALILLO	DATE: 3/1/07
SURVEY INFORMATION	ESTABLISHING AGENCY: ACS STANDARD BRASS CAP	DATE: 3/1/07
ENGINEER'S SEAL	IN CONCRETE LOCATED IN THE NORTHEAST QUADRANT OF THE INTERSECTION OF BARSTOW ST. AND MODESTO AVE.	DATE: 3/1/07
FIELD NOTES	SPIRIT LEVEL ELEVATION = 5474.533 FT. (NGVD 29)	DATE: 3/1/07
REMARKS	PLANE COORDINATES: N = 1524092.46, E = 410237.56	DATE: 3/1/07
DESIGN	DESIGNED BY: GN	DATE: JULY 2005
REVISIONS	DRAWN BY: KSH	DATE: JULY 2005
DATE	CHECKED BY: GN	DATE: JULY 2005

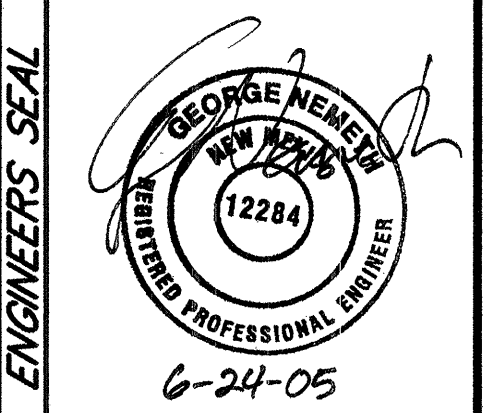


102035B
Smith Engineering Company
 A Full Service Engineering Company
800 West Pueblo Boulevard, K.E. Hagg, P.O. Box 900 Albuquerque, New Mexico 87103


**CITY OF ALBUQUERQUE
DEPARTMENT OF MUNICIPAL DEVELOPMENT**

**TITLE: NORTH DOMINGO BACA PARK
PHASE 4 CONSTRUCTION - BOX CULVERT
GENERAL NOTES & LEGEND**

Design Review Committee	City Engineer Approval	No. / Day / Yr.	No. / Day / Yr.
[Signature]	[Signature]		
City Project No. 7138.92		Zone Map No. C-19	Sheet 2 Of 14

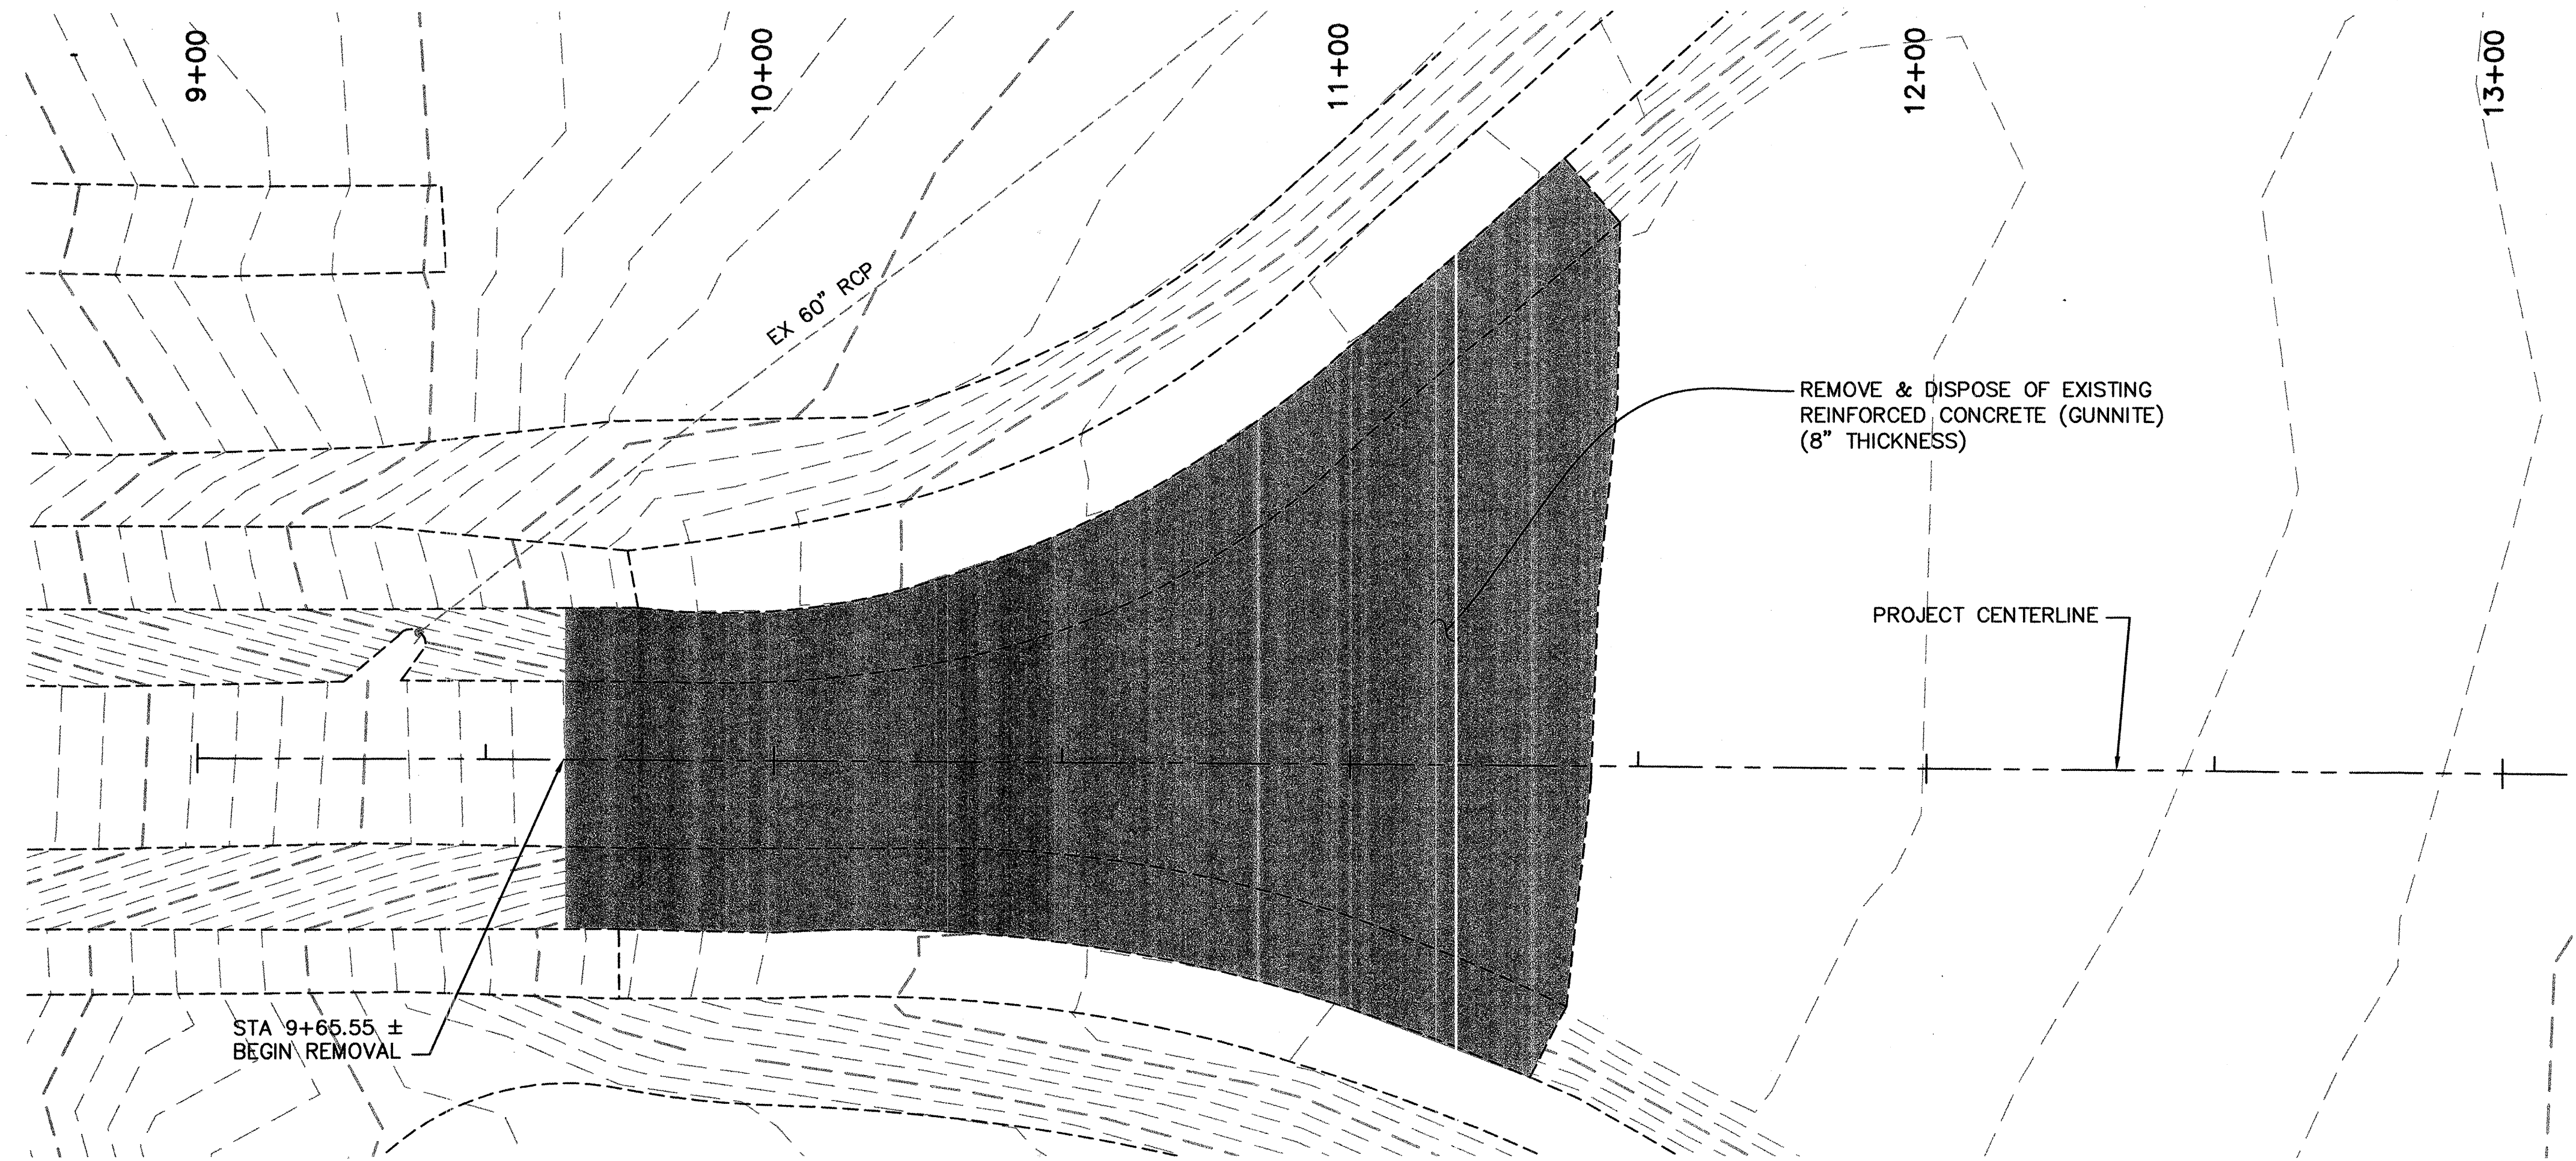

REMOVAL PLAN EAST END OF CHANNEL

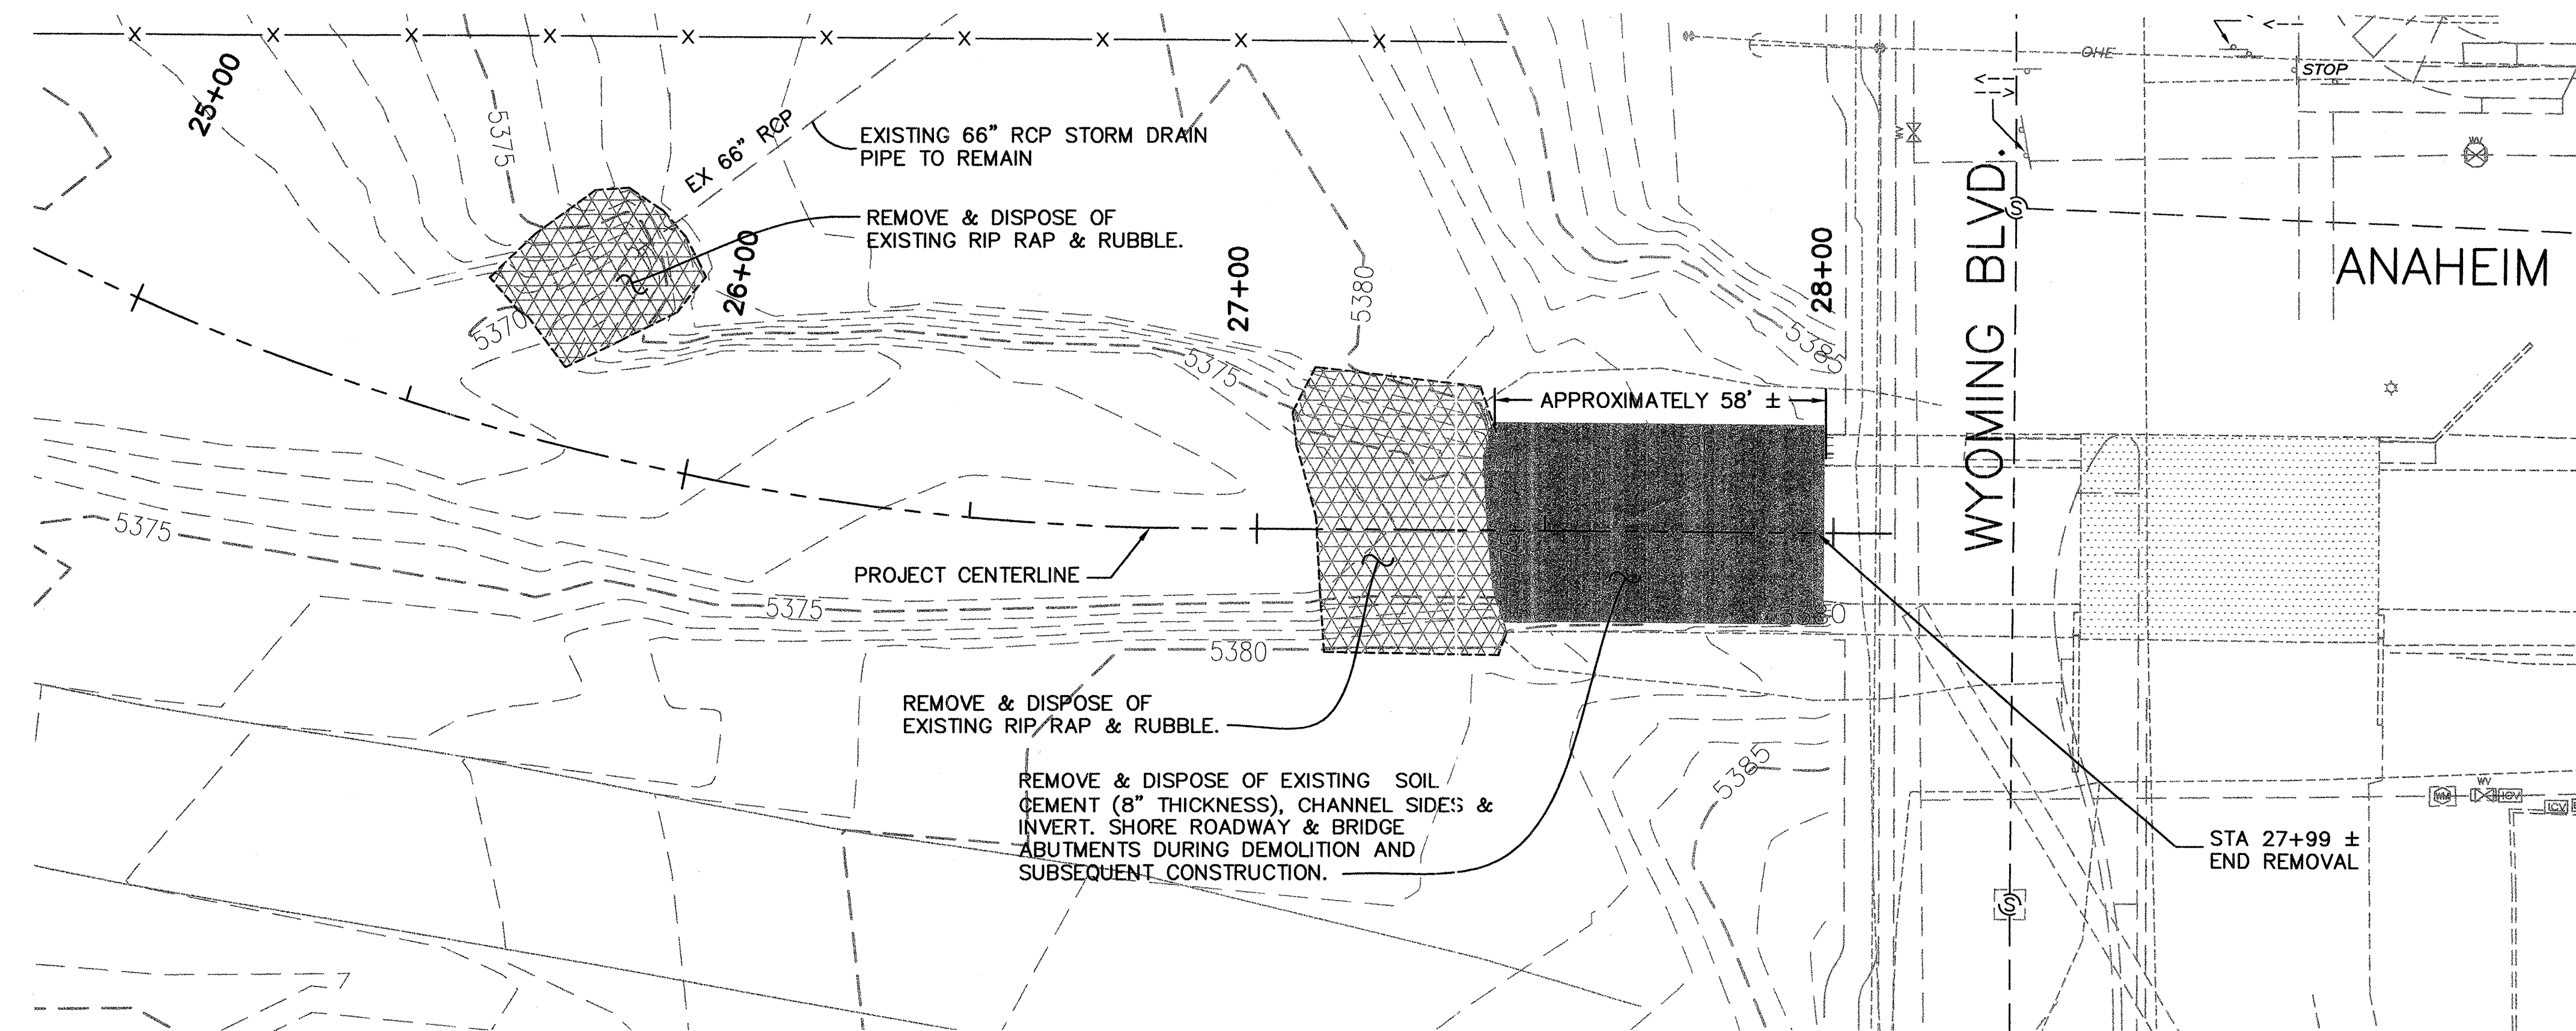

REMOVAL PLAN WEST END OF CHANNEL

GENERAL NOTES:


1. PROVIDE FULL DEPTH SAW CUT ALONG LINE OF REMOVAL OF REINFORCED CONCRETE (GUNNITE).

SURVEY INFORMATION		FIELD NOTES	
NO.	BY	DATE	BY

ENGINEER'S SEAL

6-24-05

NO.	DATE	REVISIONS	BY

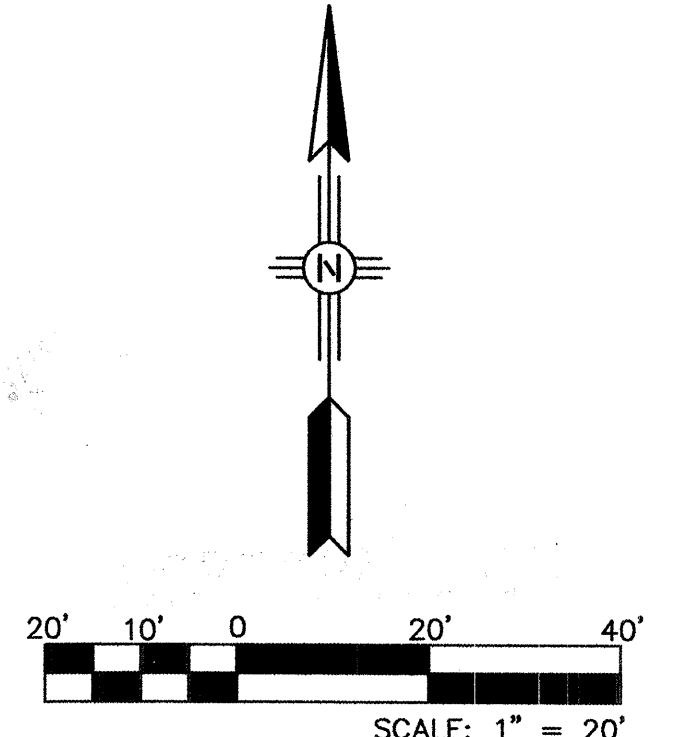


Smith Engineering Company
 102035B
 A Full Service Engineering Company
 2001 San Pedro Boulevard, N.E., Reg. #4, Suite 200 Albuquerque, New Mexico 87110

CITY OF ALBUQUERQUE
 DEPARTMENT OF MUNICIPAL DEVELOPMENT

TITLE: NORTH DOMINGO BACA PARK
 PHASE 4 CONSTRUCTION - BOX CULVERT
 REMOVAL PLAN

Design Review Committee	City Engineer Approval	No. / Day / Yr.	No. / Day / Yr.

City Project No. **7138.92** Zone Map No. **C-19** Sheet **4** of **14**

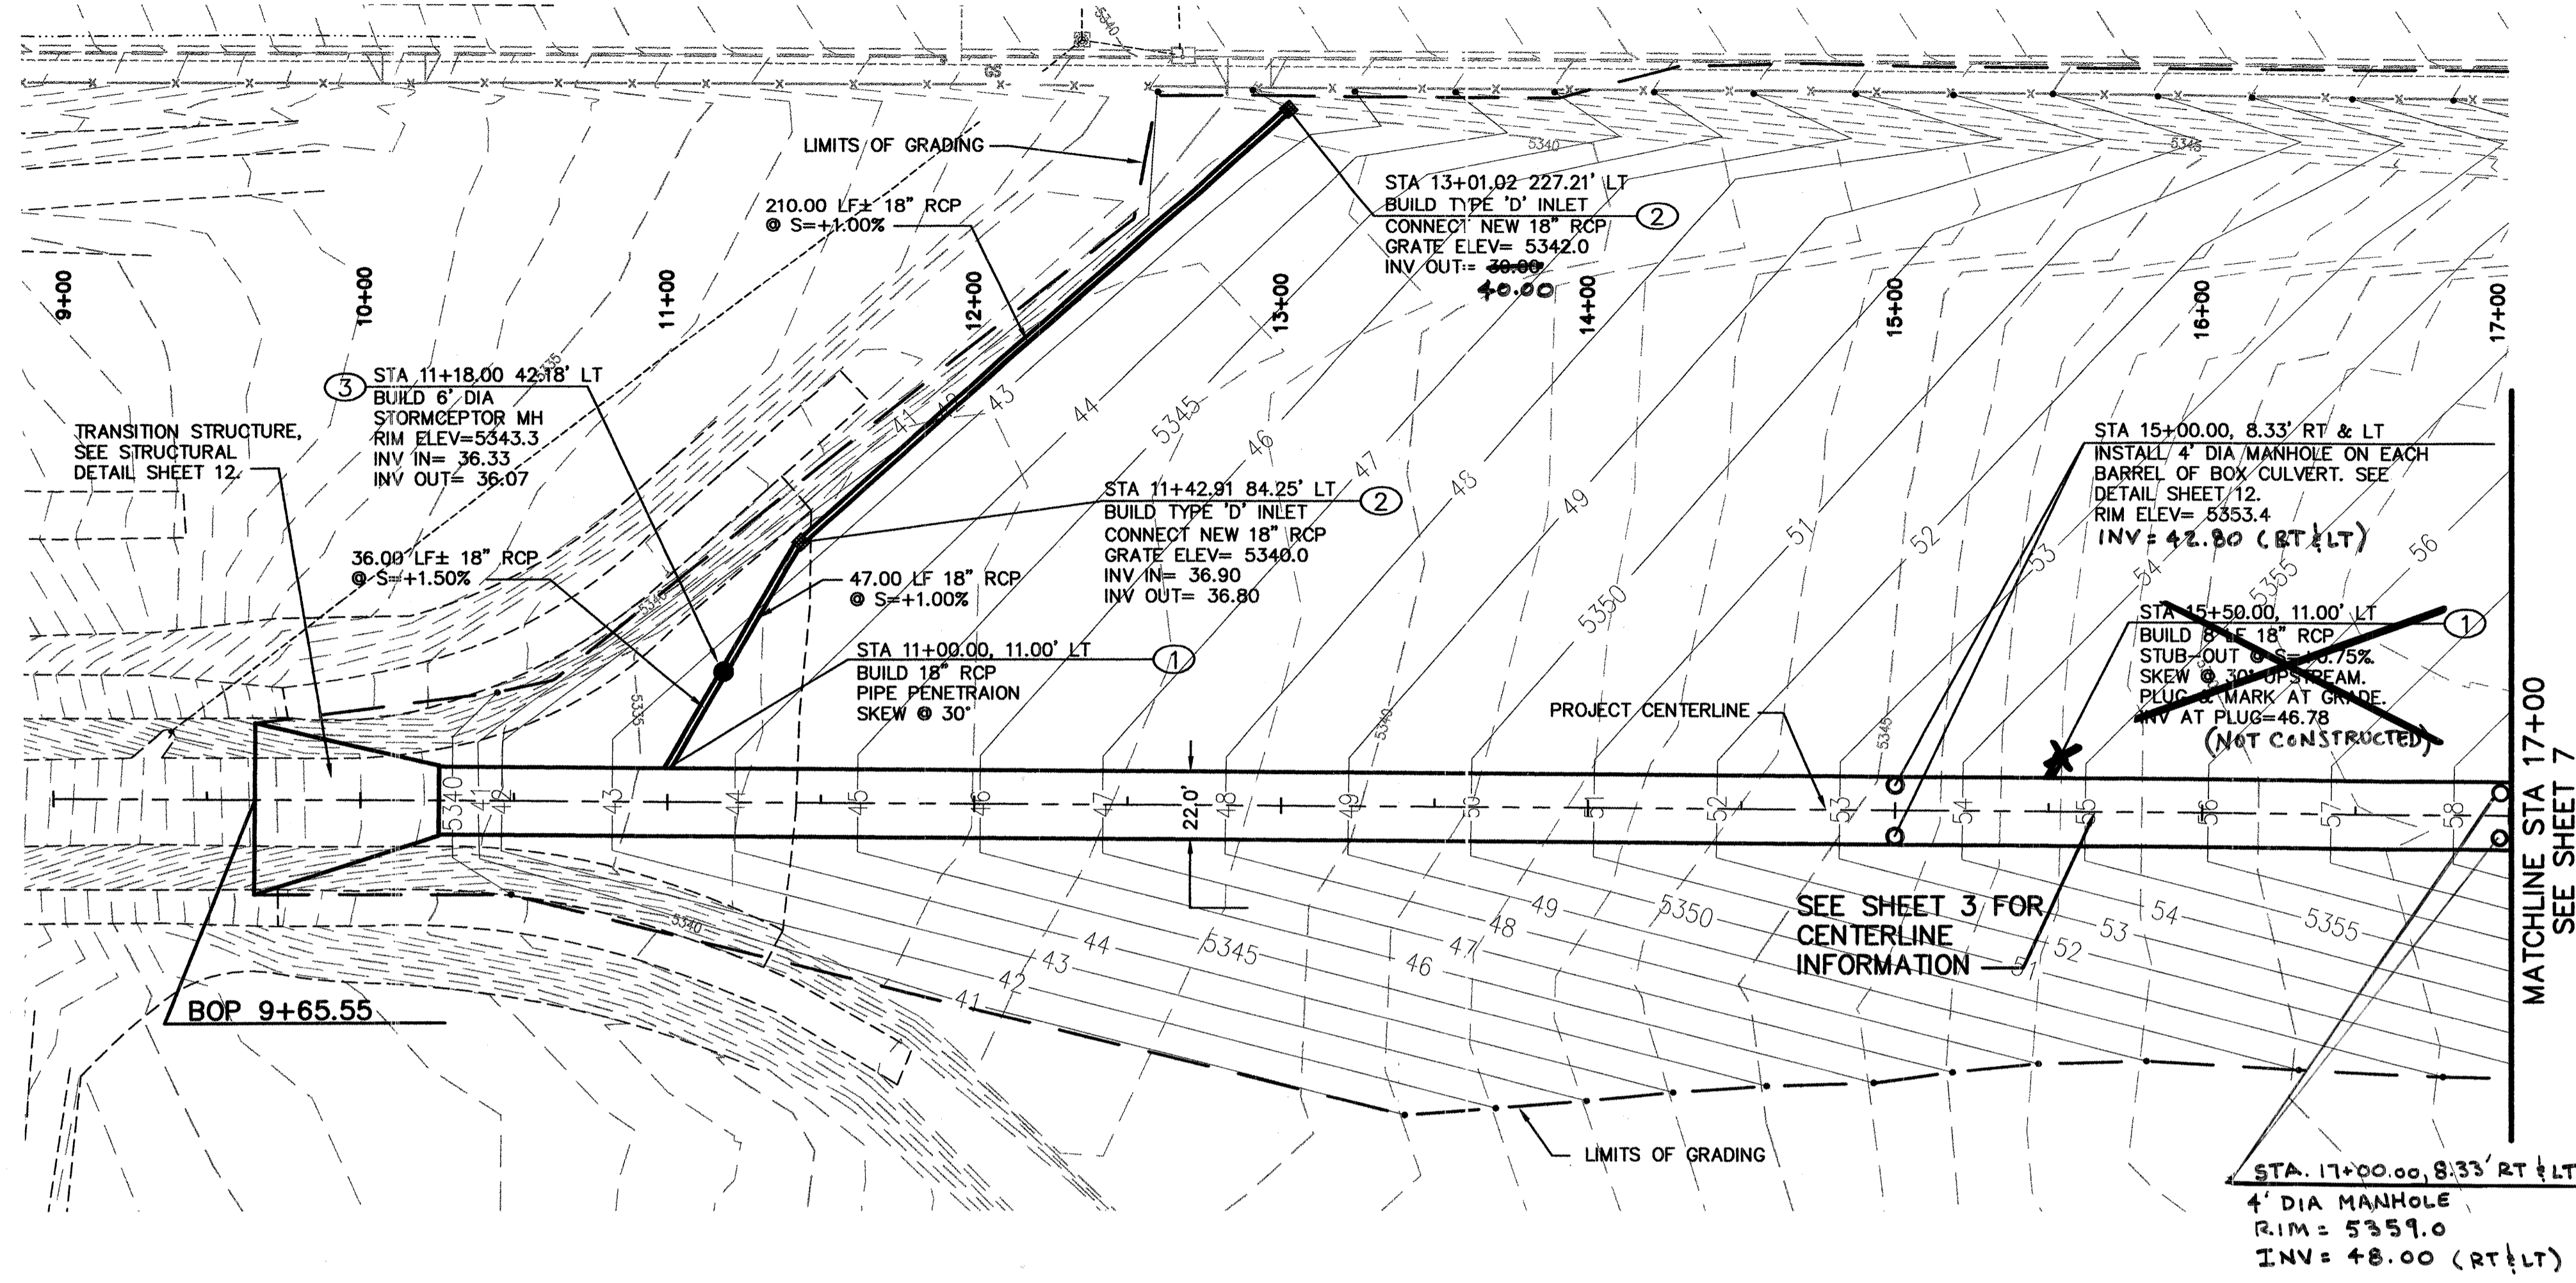


GENERAL NOTES:

- ALL CONCRETE PIPES LARGER THAN 24" SHALL BE CLASS IV.

KEYED NOTES: ○

- 18" PIPE PENETRATION. SEE PIPE PENETRATION DETAIL SHEET 12.
- BUILD TYPE 'D' INLET PER COA STD DWG #2206.
- BUILD 6" DIA STORMCEPTOR MANHOLE. CSR HYDRO CONDUIT, STC 900 PRECAST CONCRETE STORMCEPTOR, (900 GAL. CAPACITY) OR ACCEPTED EQUAL.

AS BUILT INFORMATION	
CONTRACTOR	S&B & B Co.
WORK STARTED BY	C.S.
DATE	3/07
APPROVED BY	C.O.A.
DATE	3/07
FIELD CHECKED BY	C.S.
DATE	3/07
DRAWINGS CORRECTED BY	S.E.C.
DATE	3/07
MICRO-FILM INFORMATION	
RECORDED BY	
DATE	

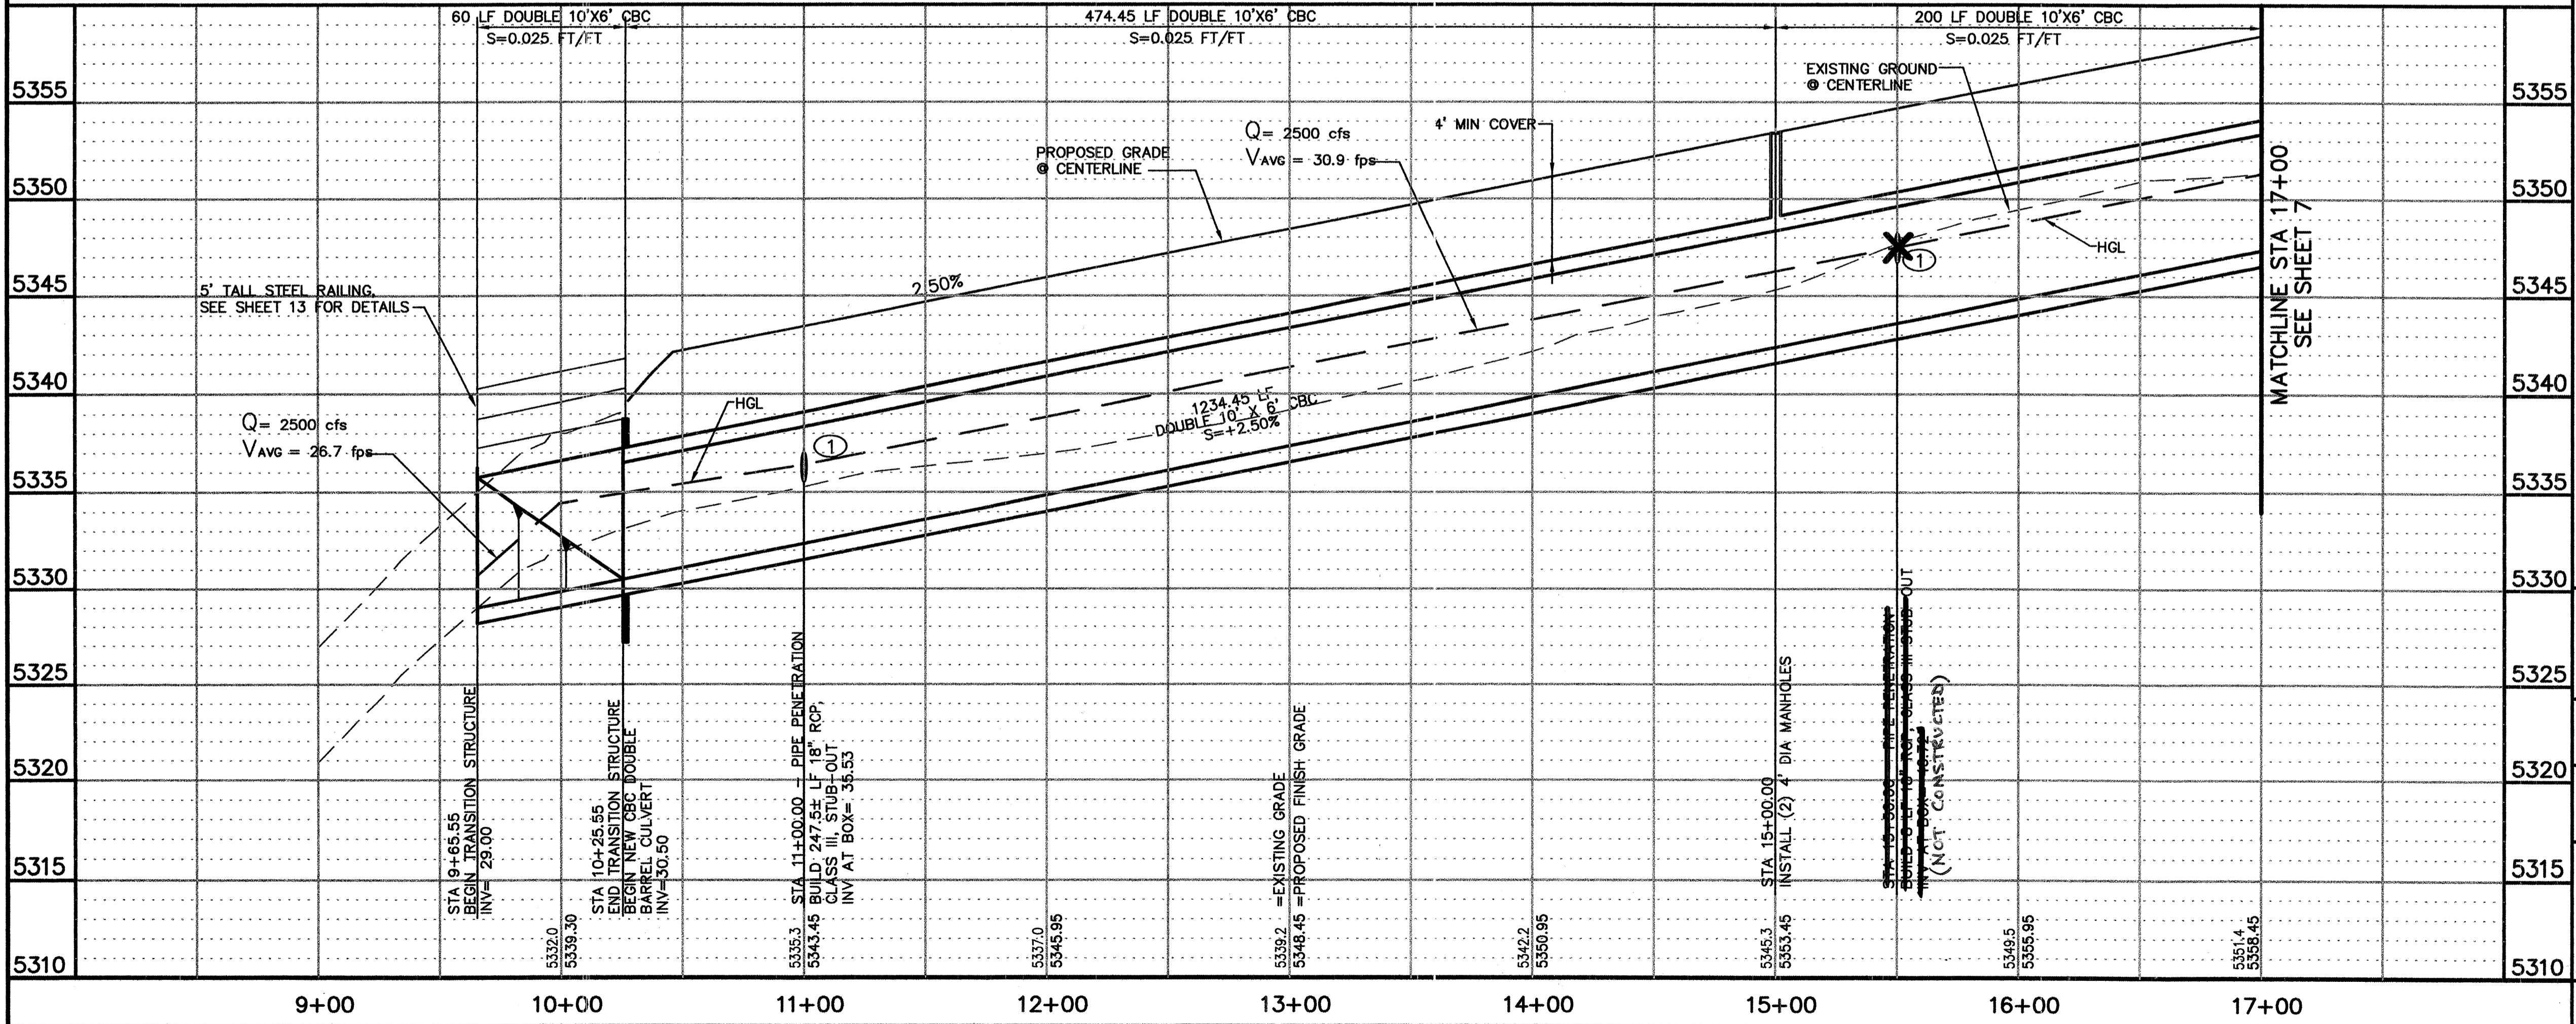

ENGINEER'S SEAL

GEORGE MEMERY
 PROFESSIONAL ENGINEER
 12284
 6-24-05

REVISIONS

NO.	DATE	REMARKS	BY
		DESIGN	

DESIGNED BY: GN
 DRAWN BY: KSH
 CHECKED BY: GN

DATE: JULY 2005
 DATE: JULY 2005
 DATE: JULY 2005

SCALE: 1" = 40'
 SCALE: 1" = 5'


Smith Engineering Company
 102035B
 A Full Service Engineering Company
 2001 San Pedro Boulevard, S.E., 10th Fl., Suite 200, Albuquerque, New Mexico 87102

CITY OF ALBUQUERQUE
 DEPARTMENT OF MUNICIPAL DEVELOPMENT

TITLE: NORTH DOMINGO BACA PARK
 PHASE 4 CONSTRUCTION - BOX CULVERT
 CBC PLAN & PROFILE: STA 9+65.55 TO 17+00

Design Review Committee: [Signature]
 City Engineer Approval: [Signature]

City Project No. 7138.92
 Zone Map No. C-19
 Sheet 6 of 14

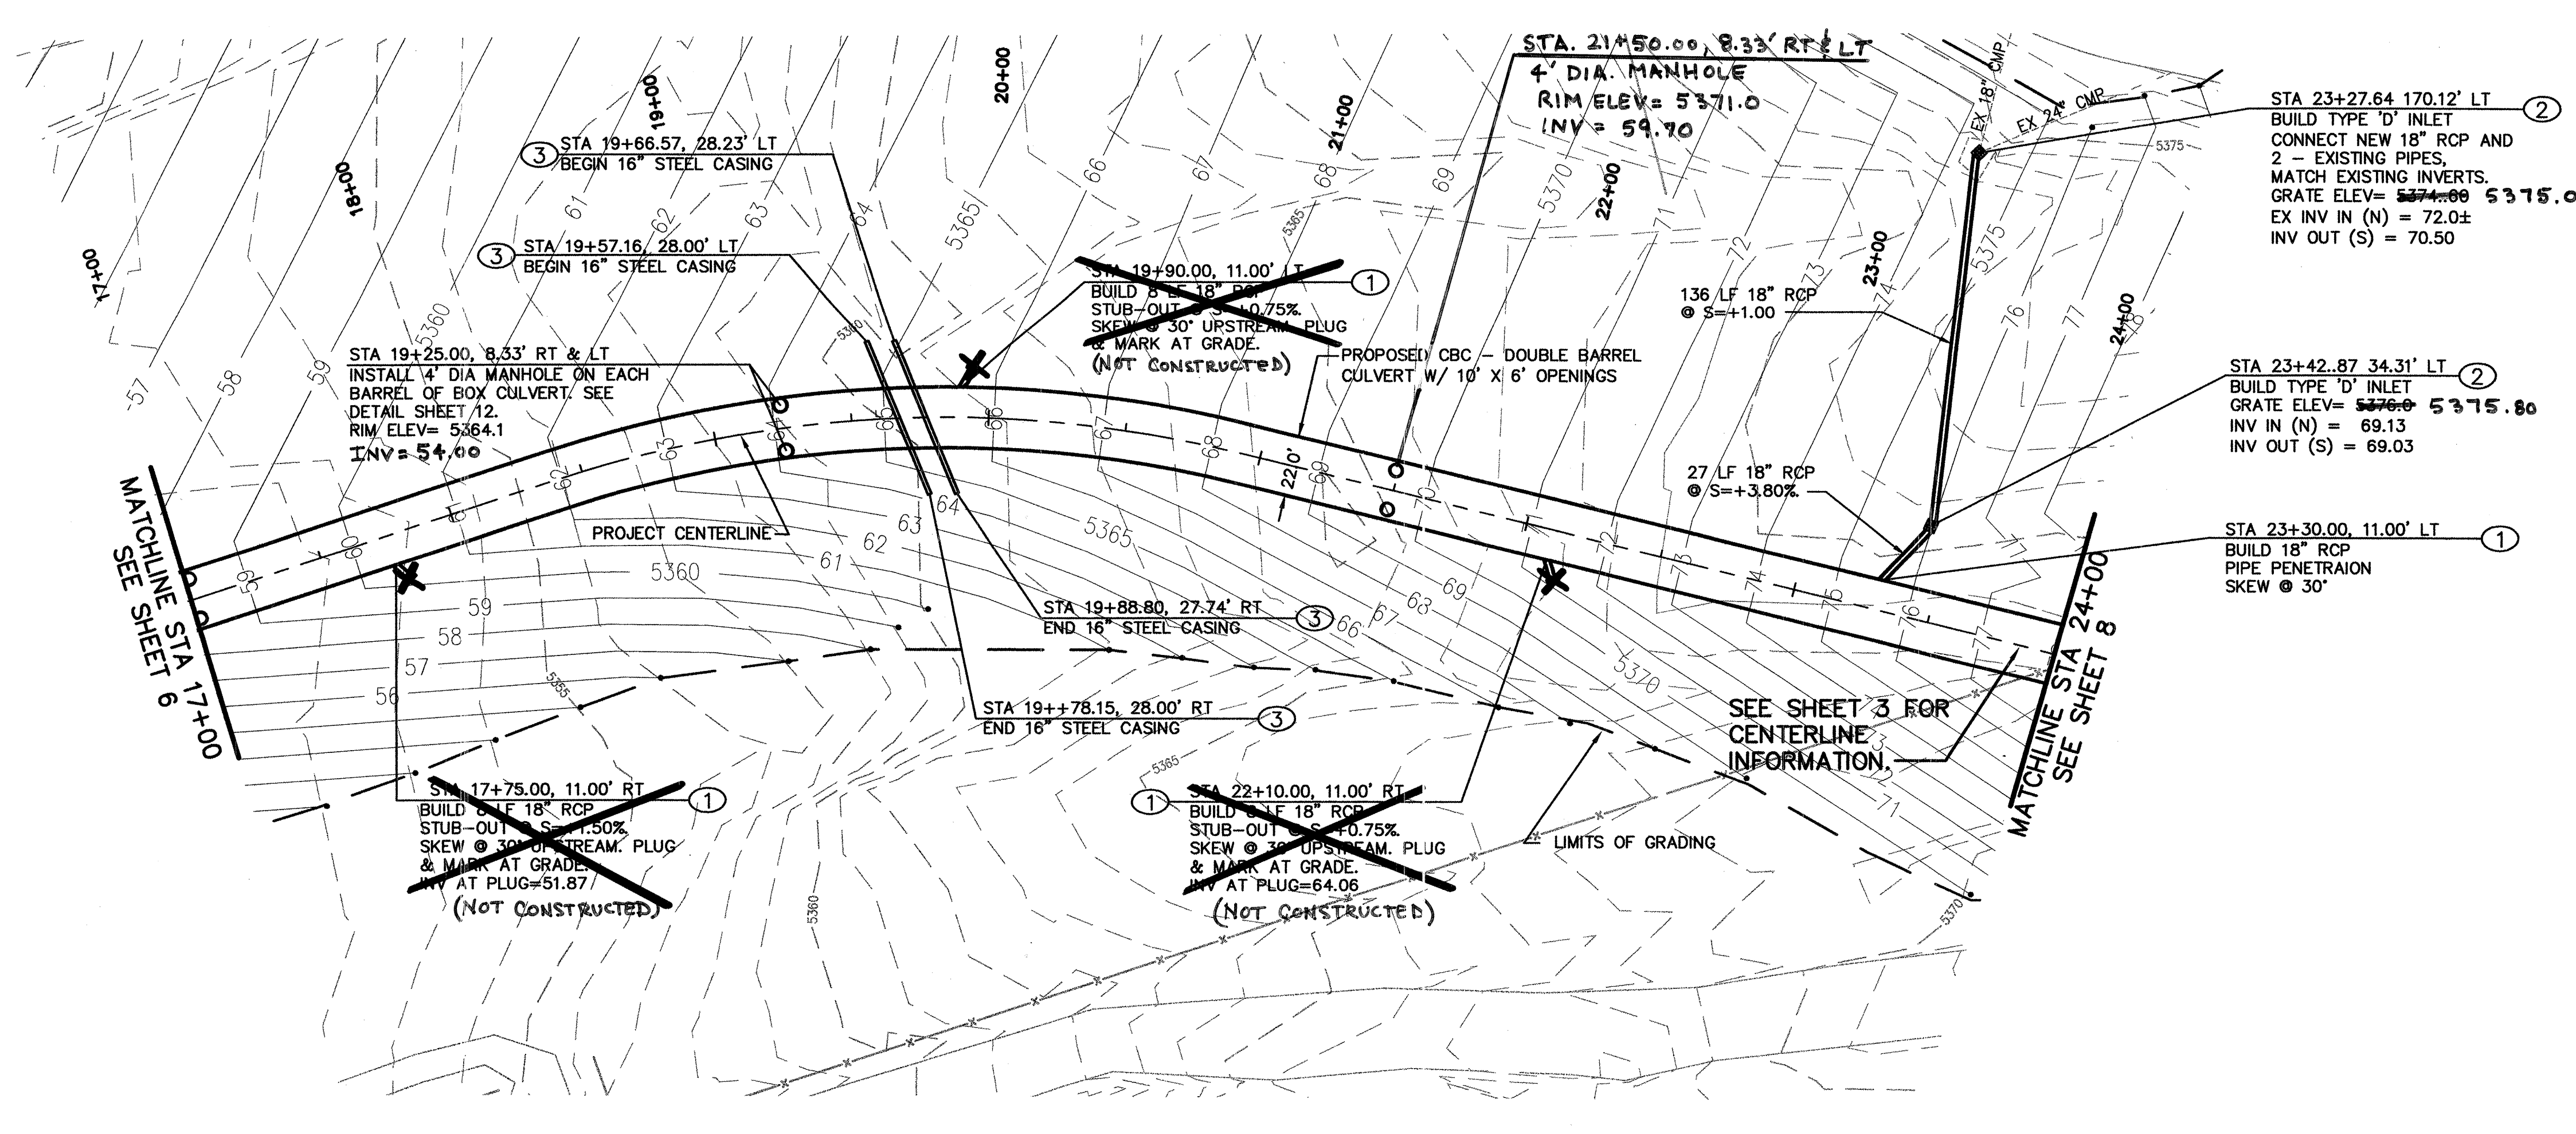

GENERAL NOTES:

- ALL CONCRETE PIPE LARGER THAN 24" SHALL BE CLASS IV.


KEYED NOTES: ○

- 18" PIPE PENETRATION. SEE PIPE PENETRATION DETAIL SHEET 12.
- BUILD TYPE 'D' INLET PER COA STD DWG #2206.
- CAP END AND MARK LOCATION AT GRADE.

AS BUILT INFORMATION	
CONTRACTOR	Salls Bco.
WORKED BY	C.S.
DATE	3/07
FIELD CHECKED BY	COA
DATE	3/07
DESIGNED BY	SEC
DATE	3/07
CORRECTED BY	SEC
DATE	3/07
RECORDED BY	
NO.	

BENCH MARKS	
STATION NAME	1-B20 STATE: NM; COUNTY: BERNALILLO
ESTABLISHING AGENCY	ACS STANDARD BRASS CAP
IN CONCRETE LOCATED IN THE	NORTHEAST QUADRANT
OF THE INTERSECTION OF	BARSTOW ST. AND MODESTO AVE.
SPIRIT LEVEL ELEVATION	= 5474.533 FT. (NGVD 29)
PLANE COORDINATES:	N = 1524092.46, E = 410237.56

SURVEY INFORMATION	
DATE	
BY	
NO.	

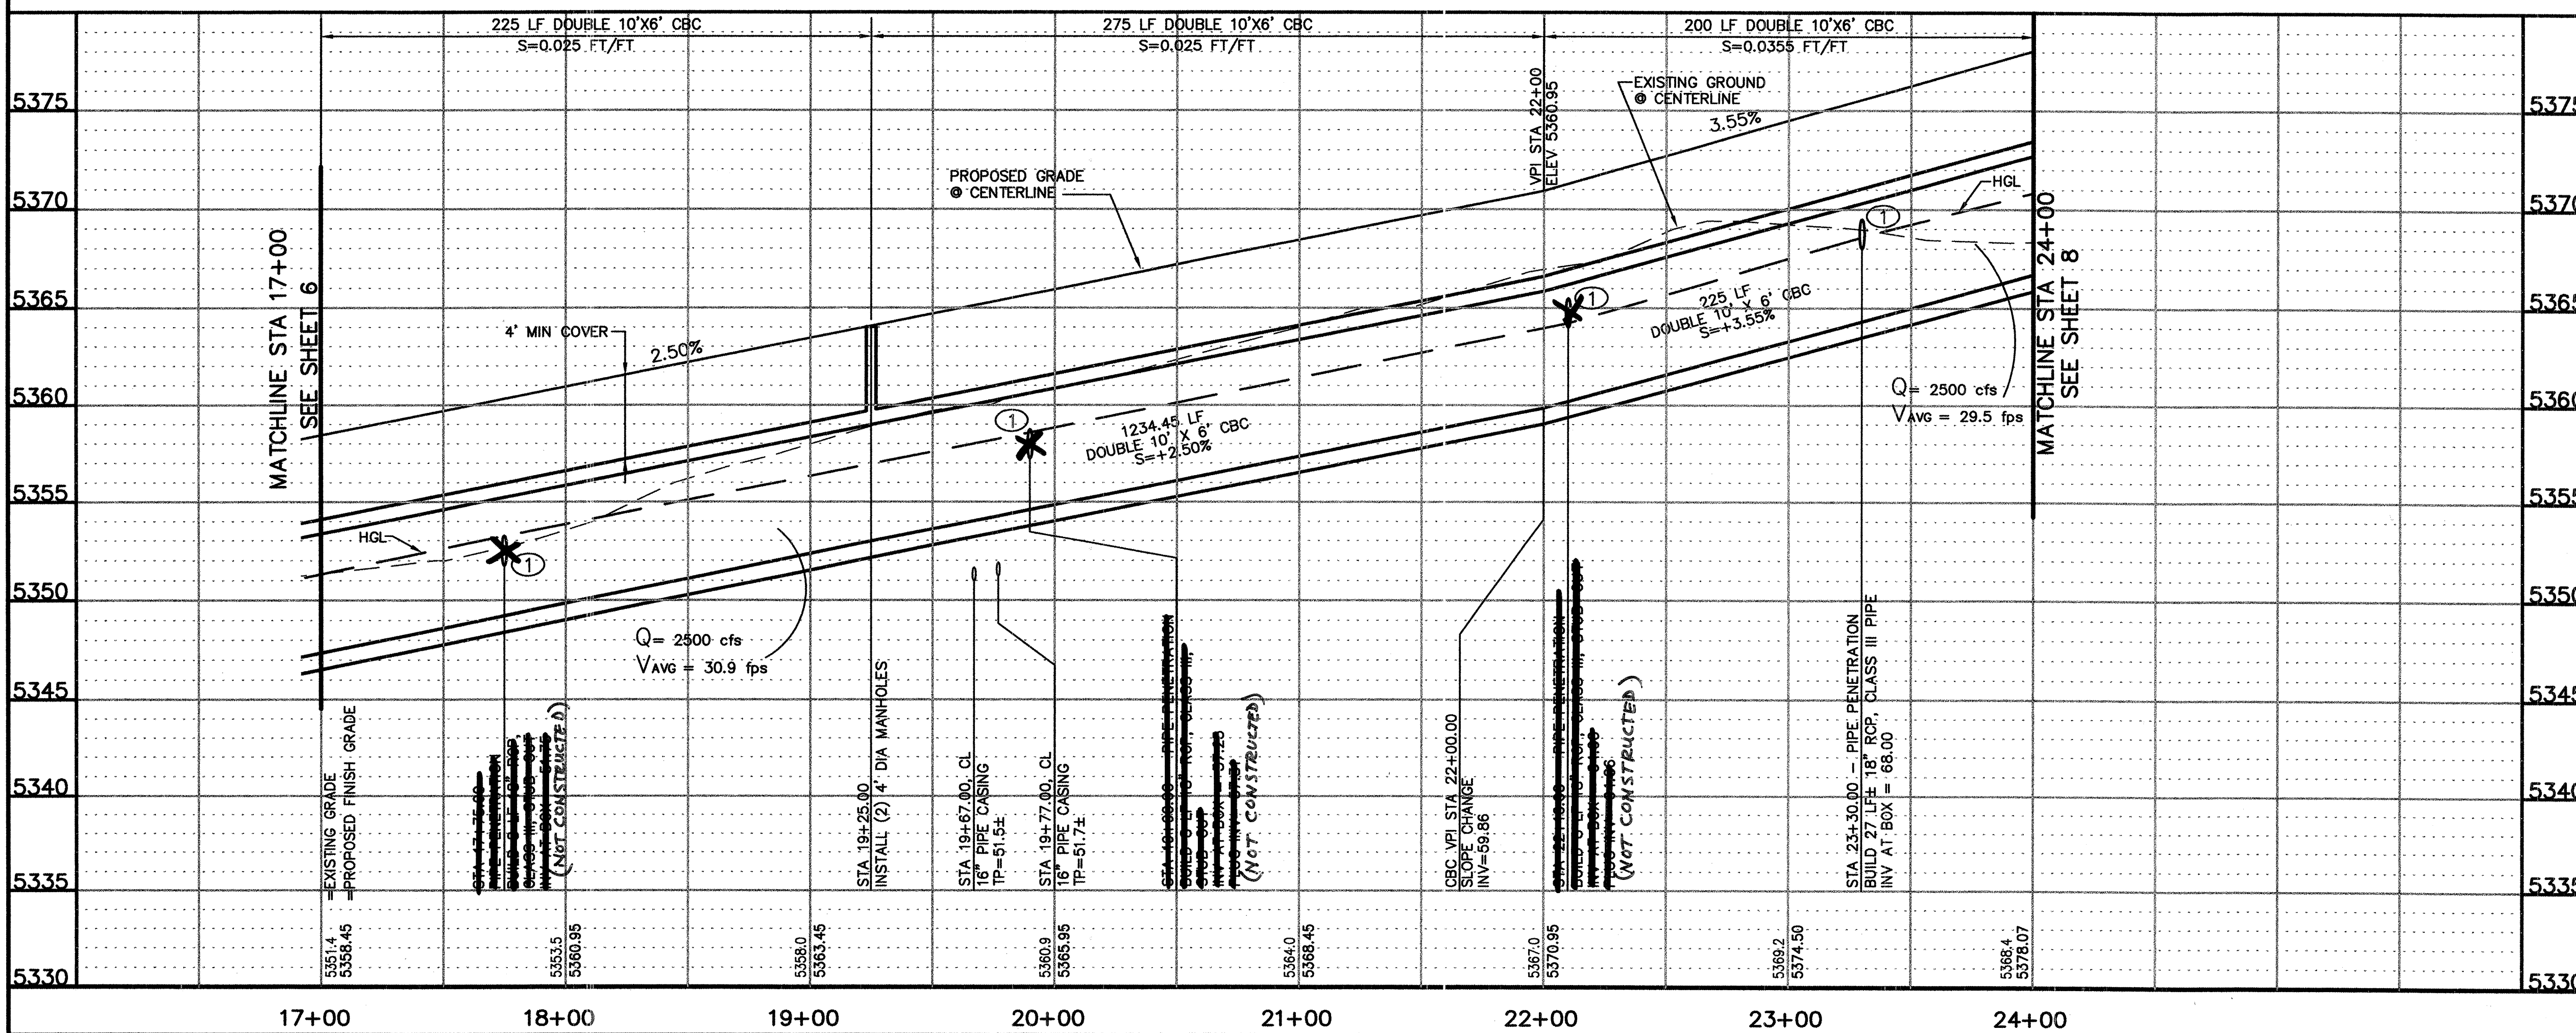

ENGINEERS SEAL

REVISIONS

NO.	DATE	BY	REMARKS
1	JULY 2005	GN	DESIGN
2	JULY 2005	KSH	
3	JULY 2005	GN	

Smith Engineering Company
 102035B
 A Full Service Engineering Company
 2001 San Pedro Southwest, S.E. 24th St., Suite 200 Albuquerque, New Mexico 87102


Station	Description
5351.4	EXISTING GRADE
5358.45	PROPOSED FINISH GRADE
5353.5	INSTALL (2) 4" DIA MANHOLES
5360.95	INSTALL (2) 4" DIA MANHOLES
CITY OF ALBUQUERQUE
DEPARTMENT OF MUNICIPAL DEVELOPMENT

TITLE: NORTH DOMINGO BACA PARK
PHASE 4 CONSTRUCTION - BOX CULVERT
CBC PLAN & PROFILE: STA 17+00 TO 24+00

Design Review Committee	City Engineer Approval
-------------------------	------------------------

City Project No. **7138.92** Zone Map No. **C-19** Sheet **7** of **14**


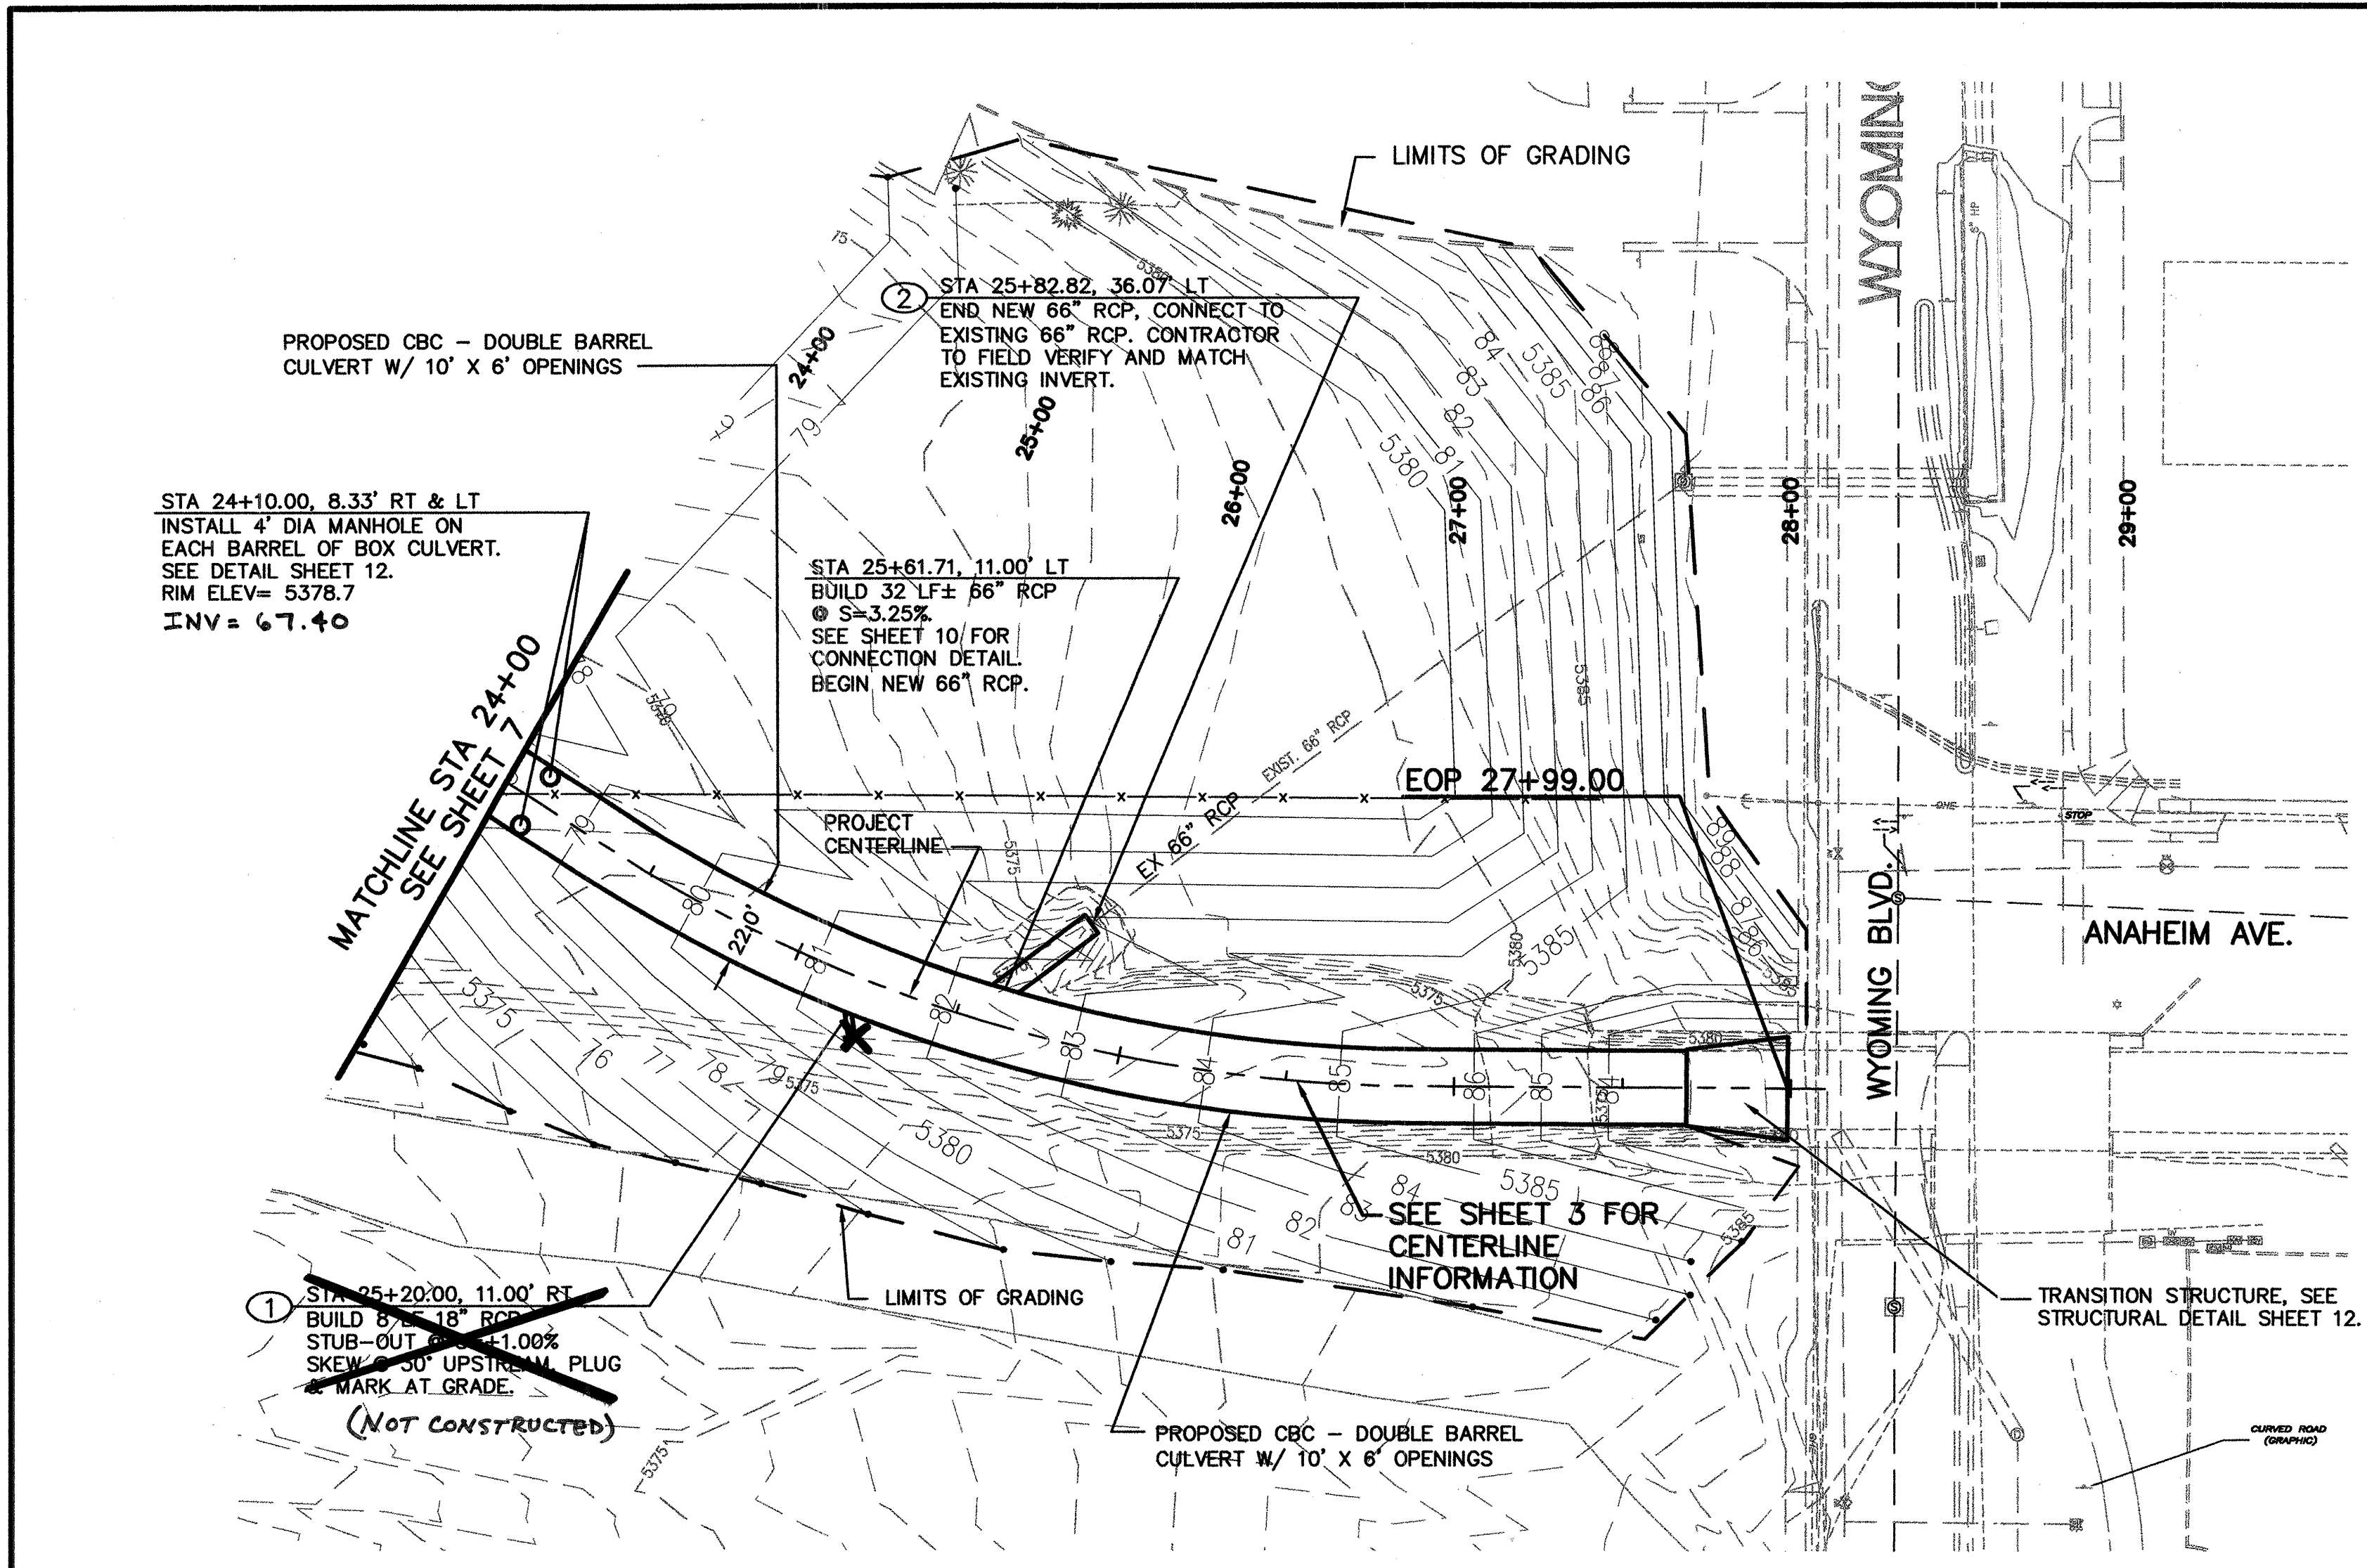


GENERAL NOTES:

- ALL CONCRETE PIPE LARGER THAN 24" SHALL BE CLASS IV.

KEYED NOTES: ○

- 18" PIPE PENETRATION. SEE 18" PIPE PENETRATION DETAIL SHEET 12.
- 66" PIPE CONNECTION. SEE 66" PIPE CONNECTION DETAIL SHEET 12.

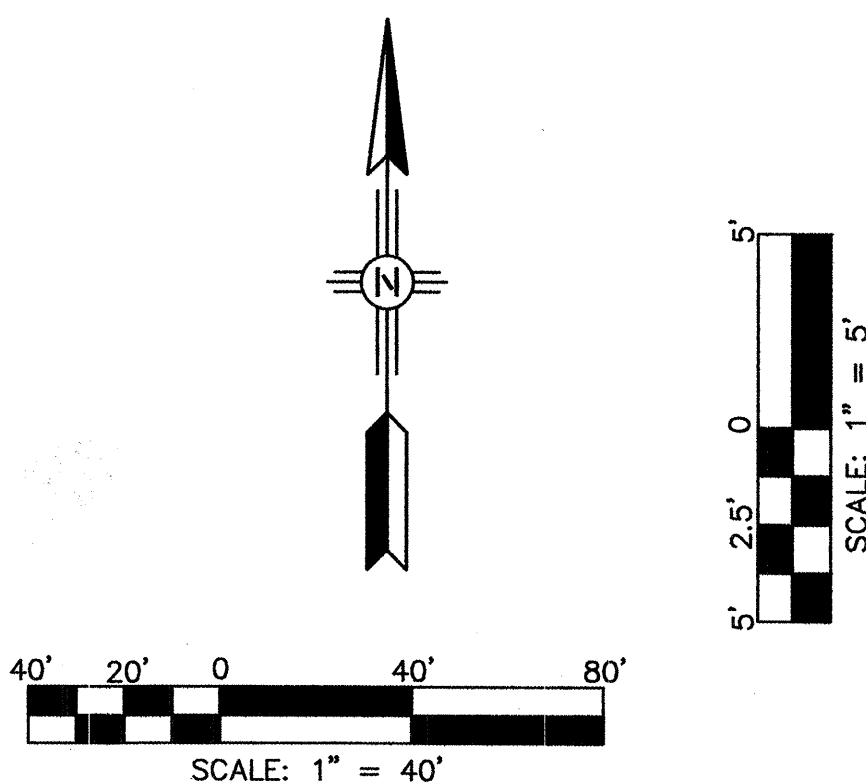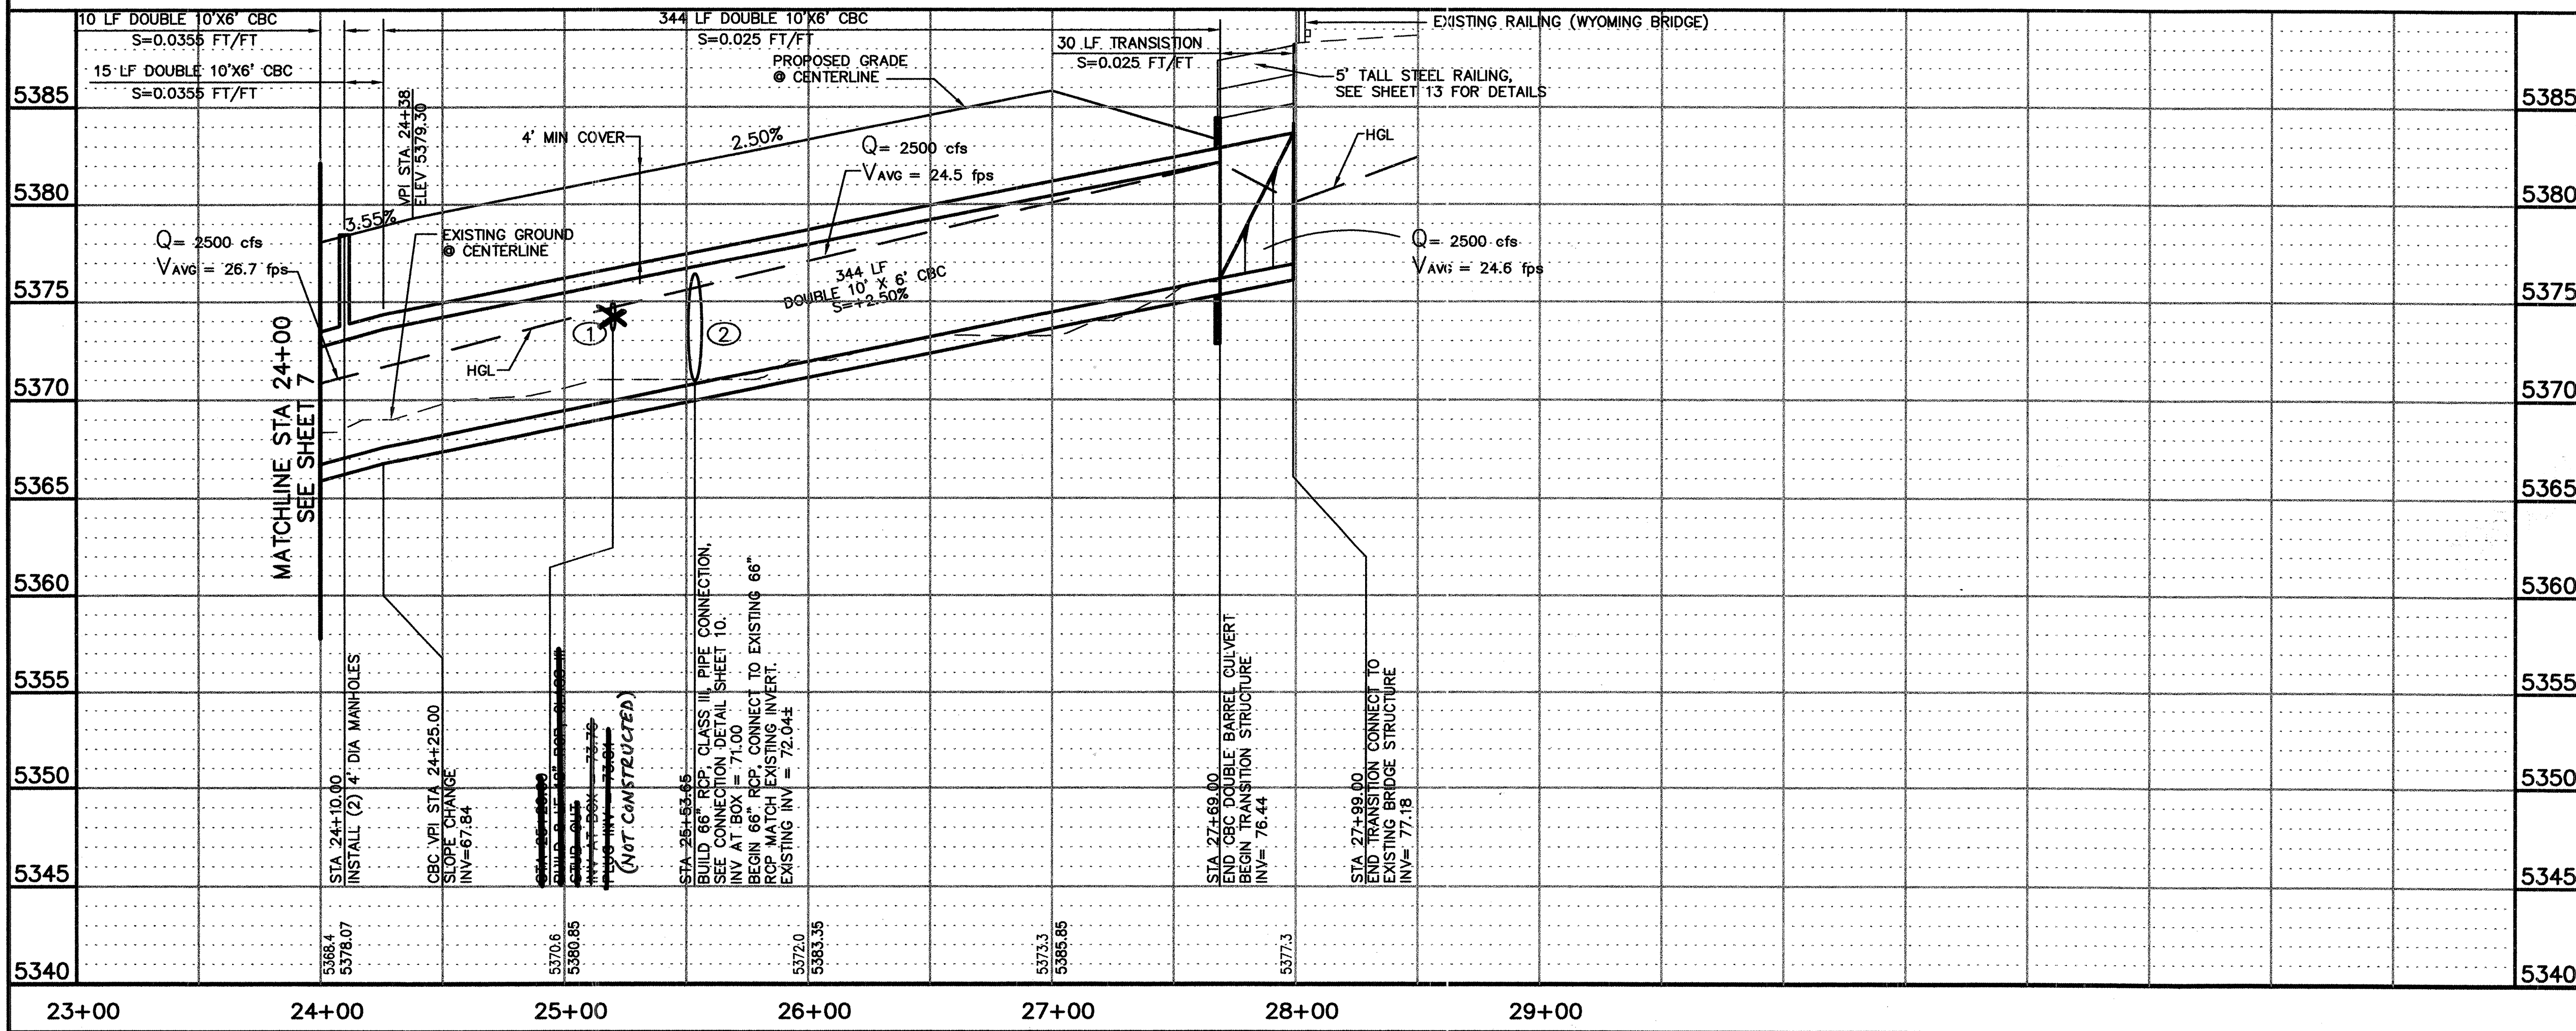

AS-BUILT INFORMATION

CONTRACTOR	Salls Bros.	DATE	3/07
WORKED BY	CS	DATE	3/07
ACCEPTED BY	CS	DATE	3/07
VERIFICATION BY	CS	DATE	3/07
DRAWINGS BY	SEC	DATE	3/07
RECORDING BY	MICRO-FILM	DATE	3/07
RECORDED BY		DATE	

BENCH MARKS

STATION NAME	1-B20	STATE	NM	COUNTY	BERNALILLO
ESTABLISHING AGENCY	ACS	STANDARD	BRASS CAP		
IN CONCRETE	LOCATED IN THE NORTHEAST QUADRANT				
OF THE INTERSECTION	OF BARSTOW ST. AND MODESTO AVE.				
SPIRIT LEVEL ELEVATION	= 5474.533 FT. (NSVD 29)				
PLANE COORDINATES	N = 1524092.46, E = 410237.56				

SURVEY INFORMATION

DATE	
BY	
NO.	

ENGINEERS SEAL

NO.	DATE	REMARKS	BY
		DESIGN	
		REVISIONS	
DESIGNED BY	GN	DATE	JULY 2005
DRAWN BY	KSH	DATE	JULY 2005
CHECKED BY	GN	DATE	JULY 2005


Smith Engineering Company
 102035B
 A Full Service Engineering Company
 2000 San Pedro Boulevard, N.E., 2nd Fl., Suite 200 Albuquerque, New Mexico 87106

CITY OF ALBUQUERQUE
 DEPARTMENT OF MUNICIPAL DEVELOPMENT


TITLE: **NORTH DOMINGO BACA PARK
 PHASE 4 CONSTRUCTION - BOX CULVERT
 CBC PLAN & PROFILE: STA 24+00 TO 27+99**

Design Review Committee	City Engineer Approval


DESIGNED BY: H.I. 10/60 CHECKED BY: R.A. 5/93
 DETAIL BY: J.A.K. 2/93 CHECKED BY: S.J.N. 7/93
 PLOT DATE: 12/93

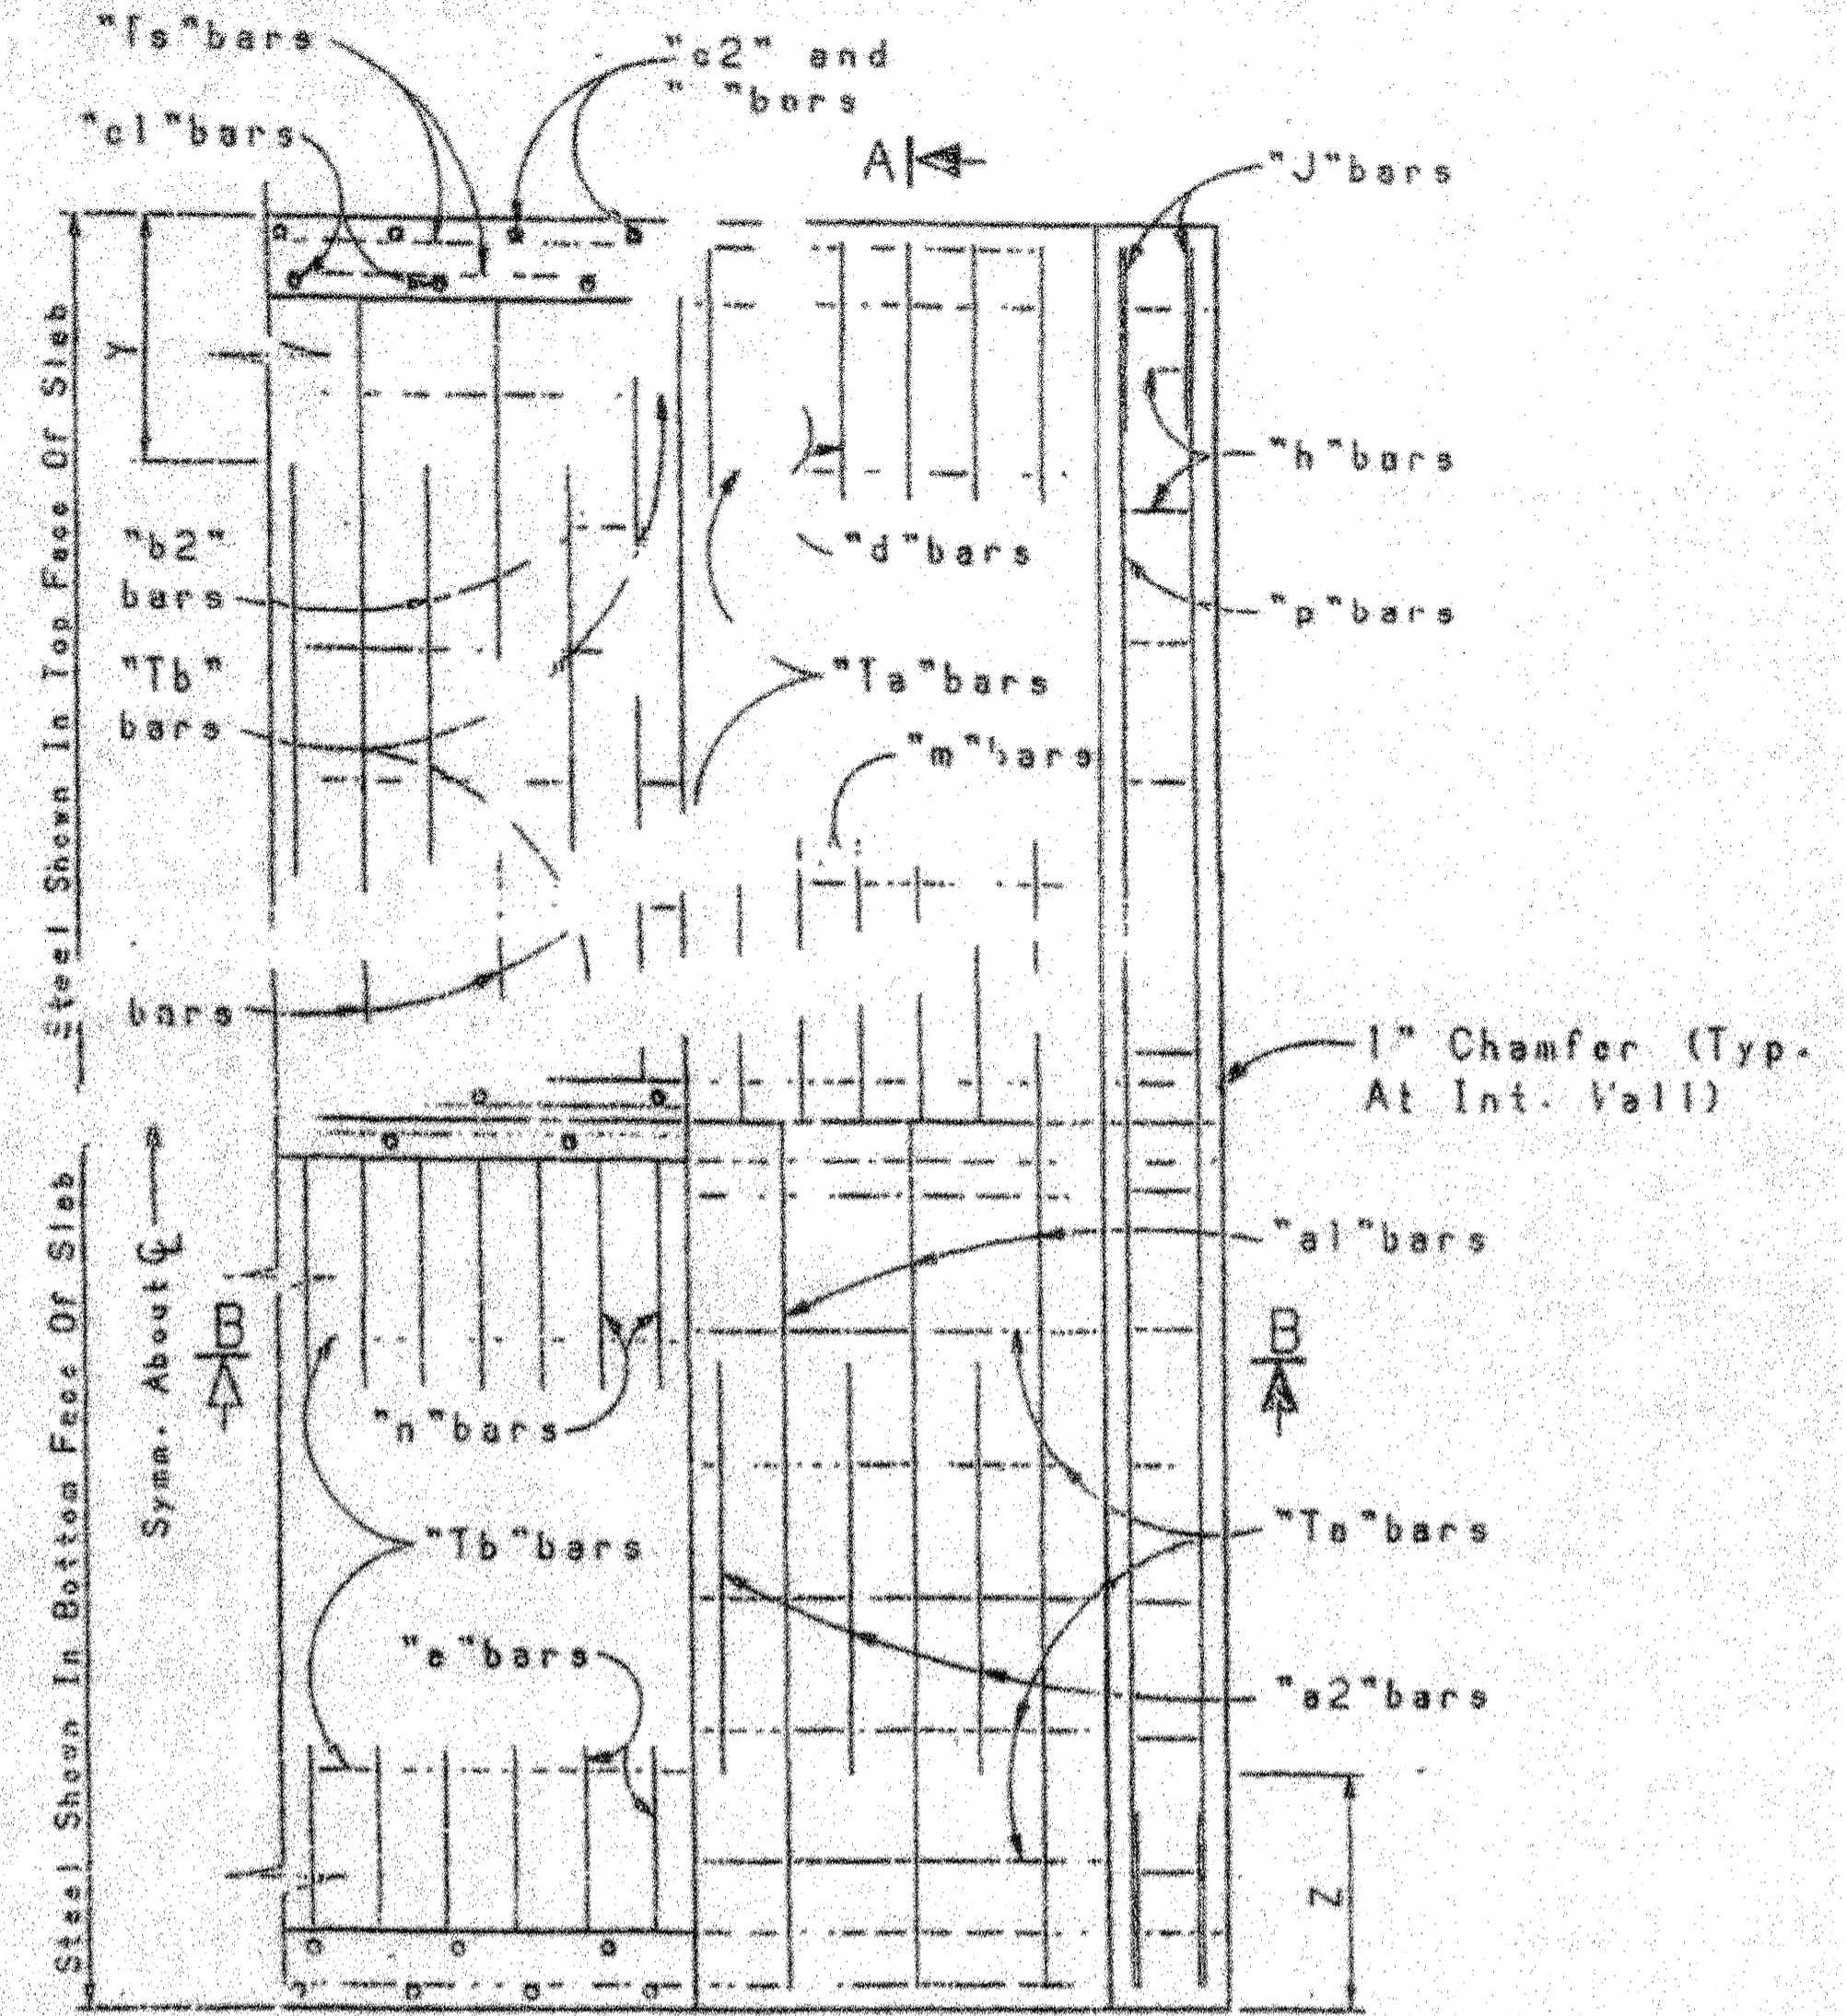

PART PLAN TOP SLAB

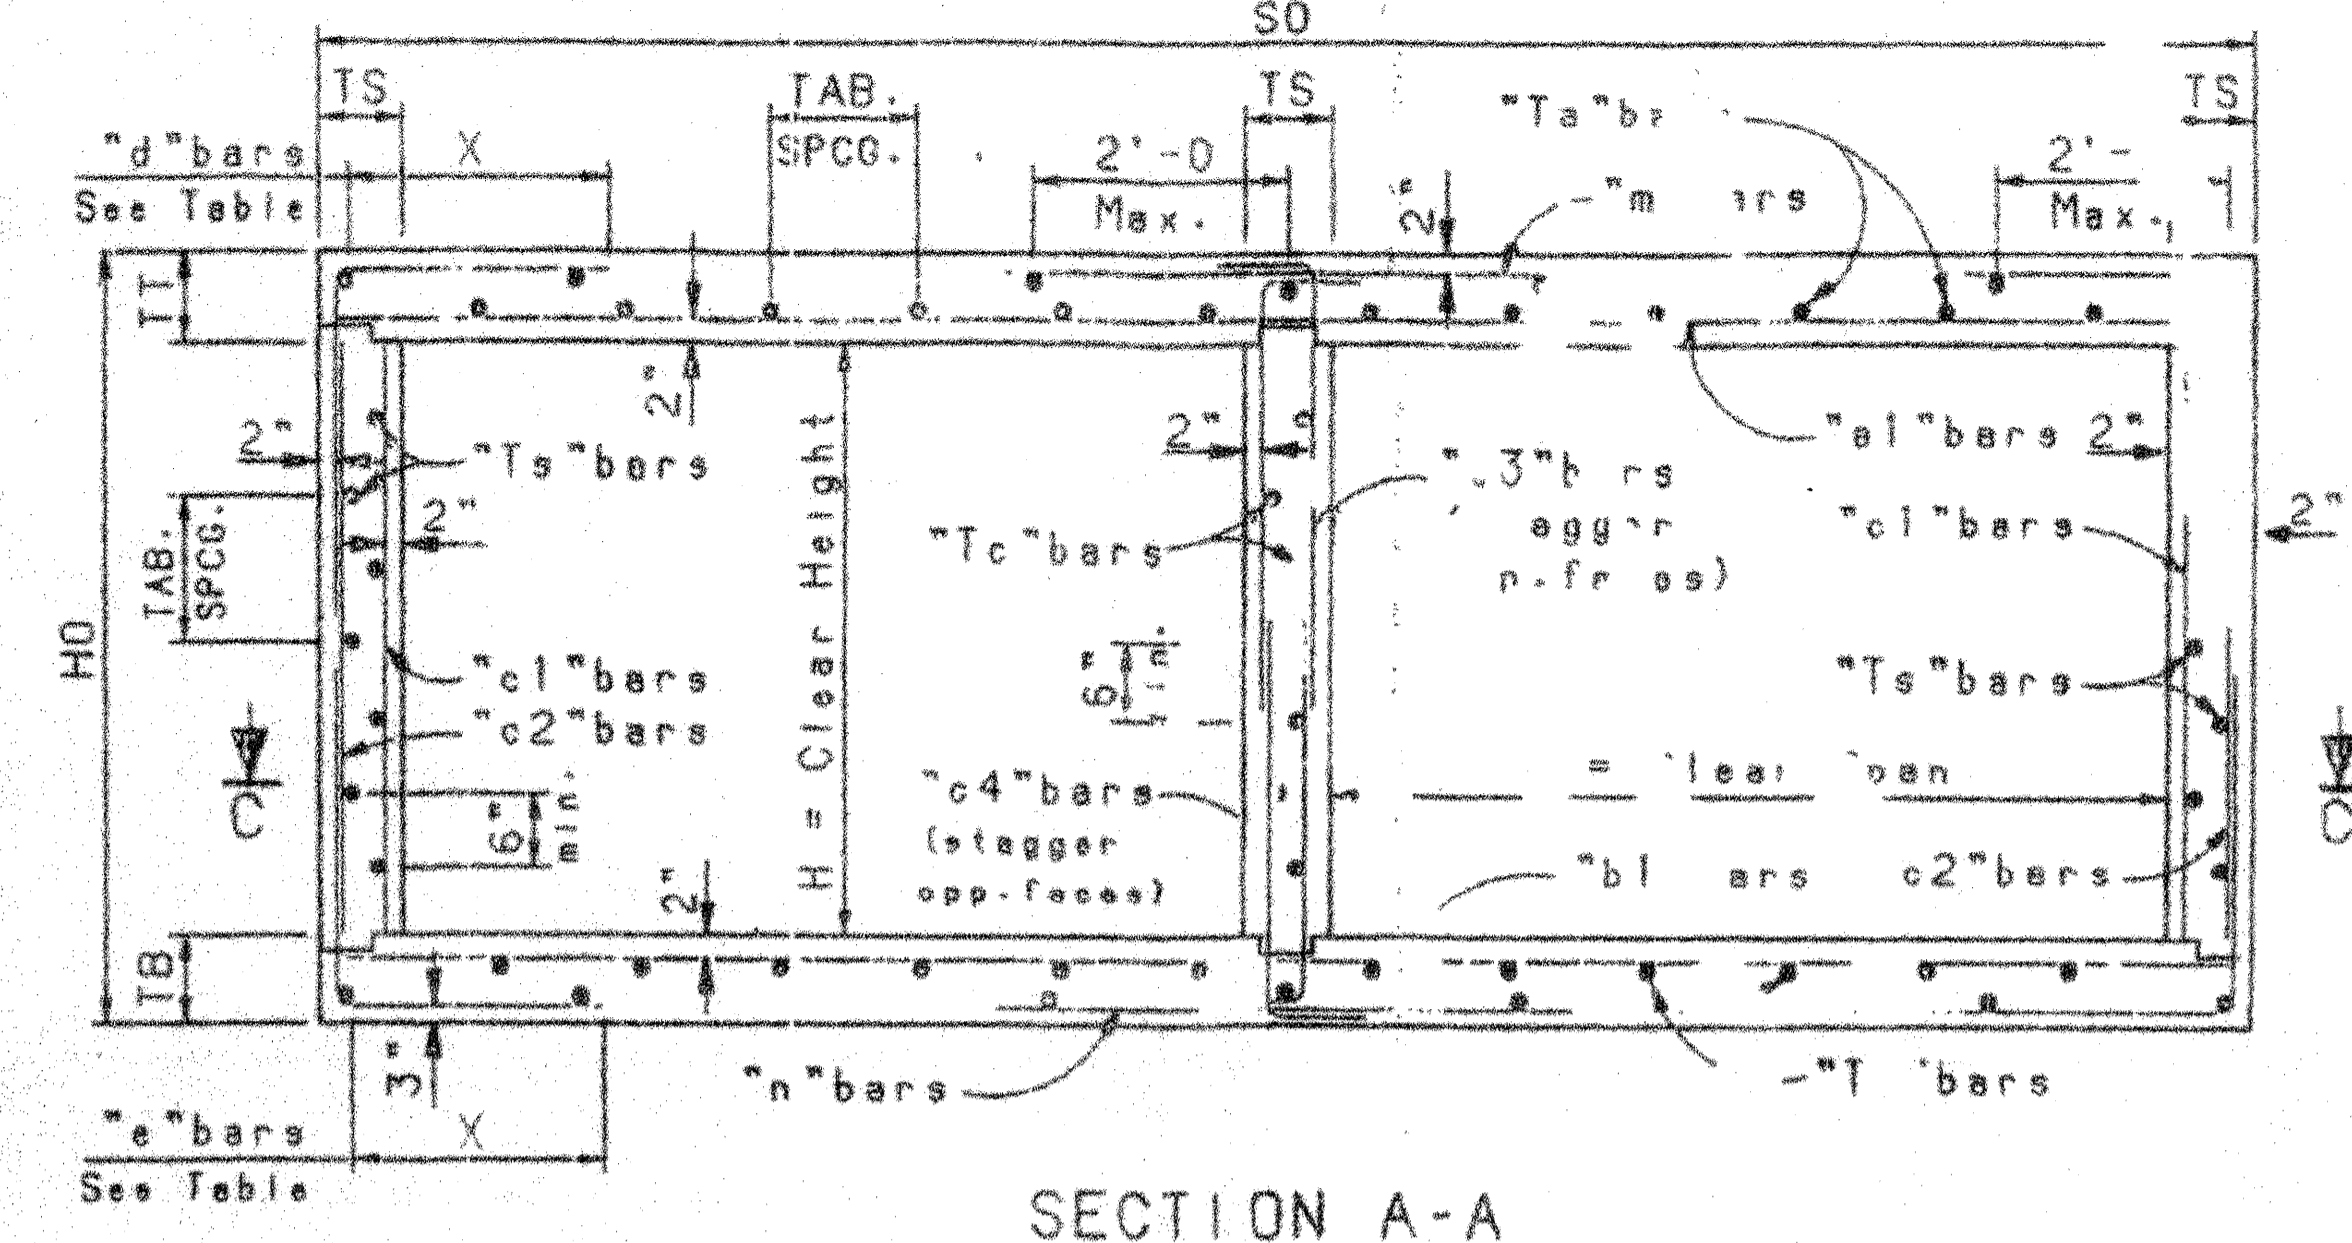


SECTION A-A

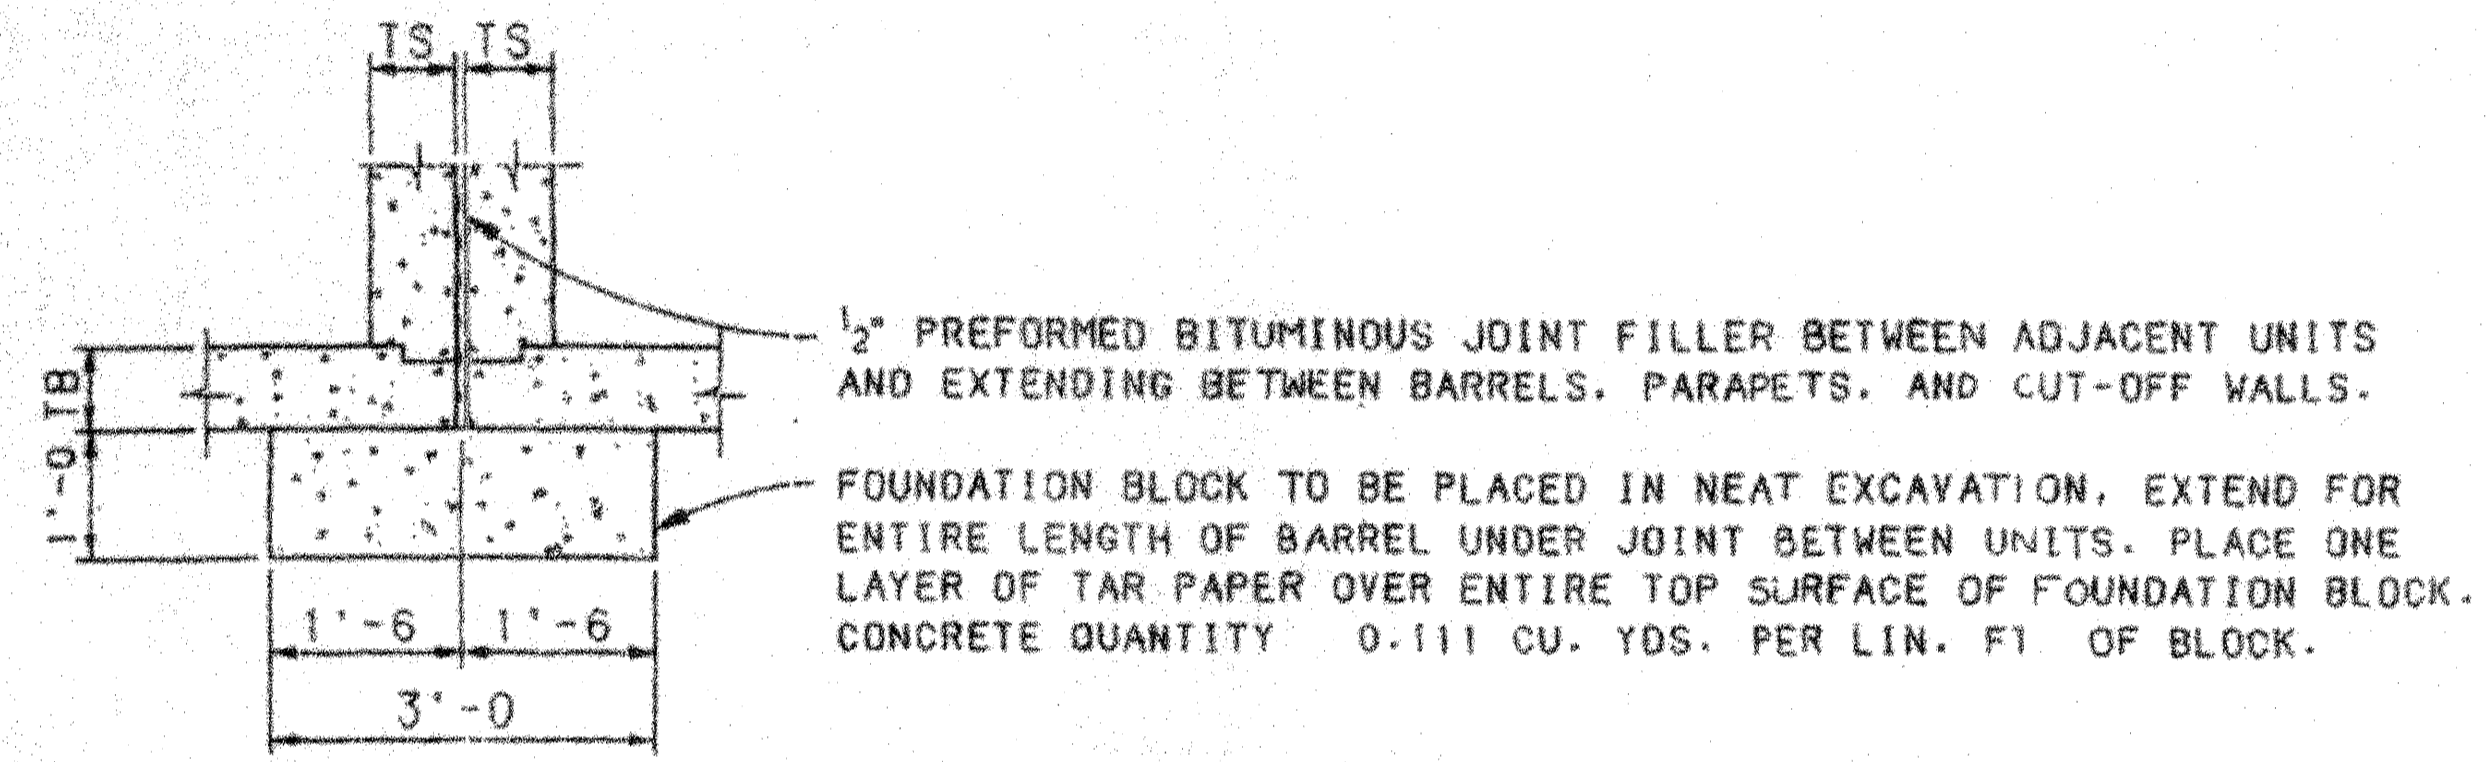


JOINT DETAIL FOR MULTIPLE UNIT BOXES


PART SECTION C-C

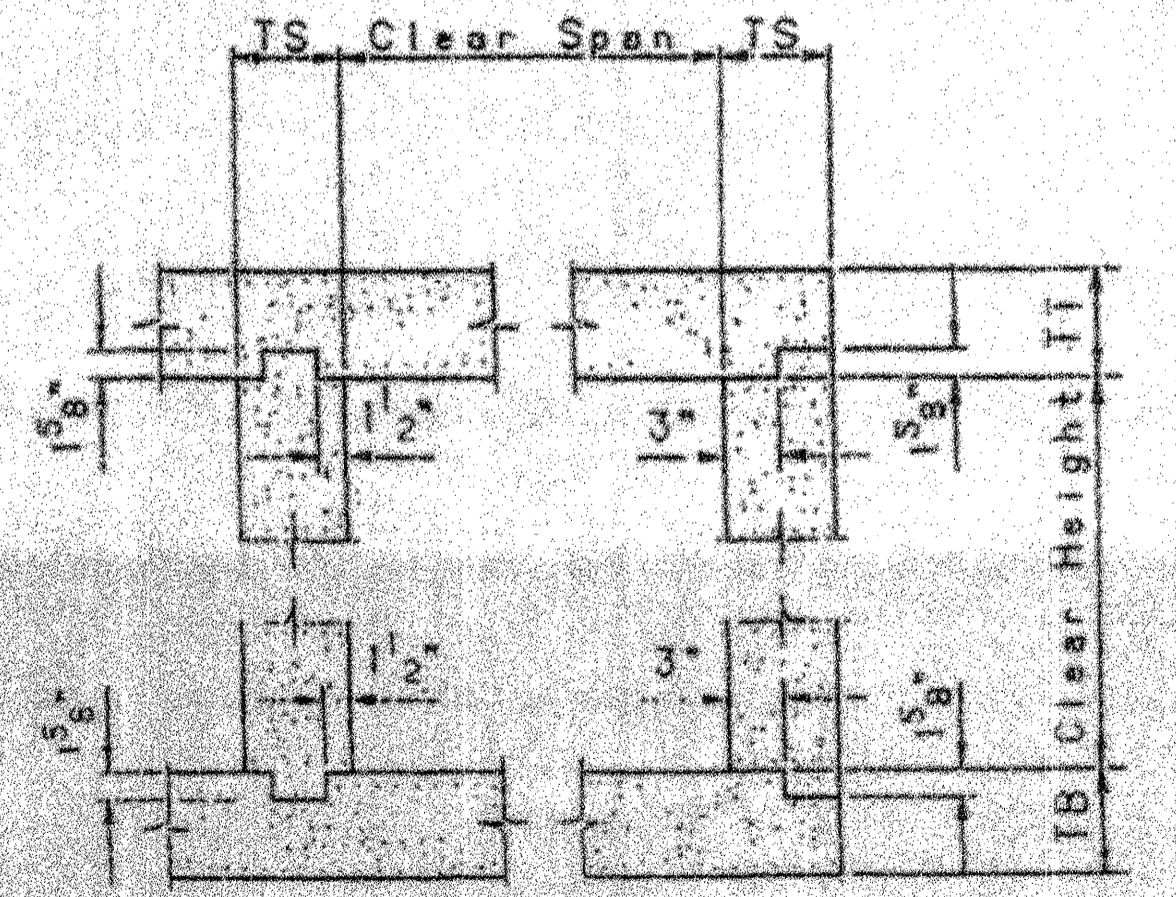

CONSTRUCTION JOINT DETAIL

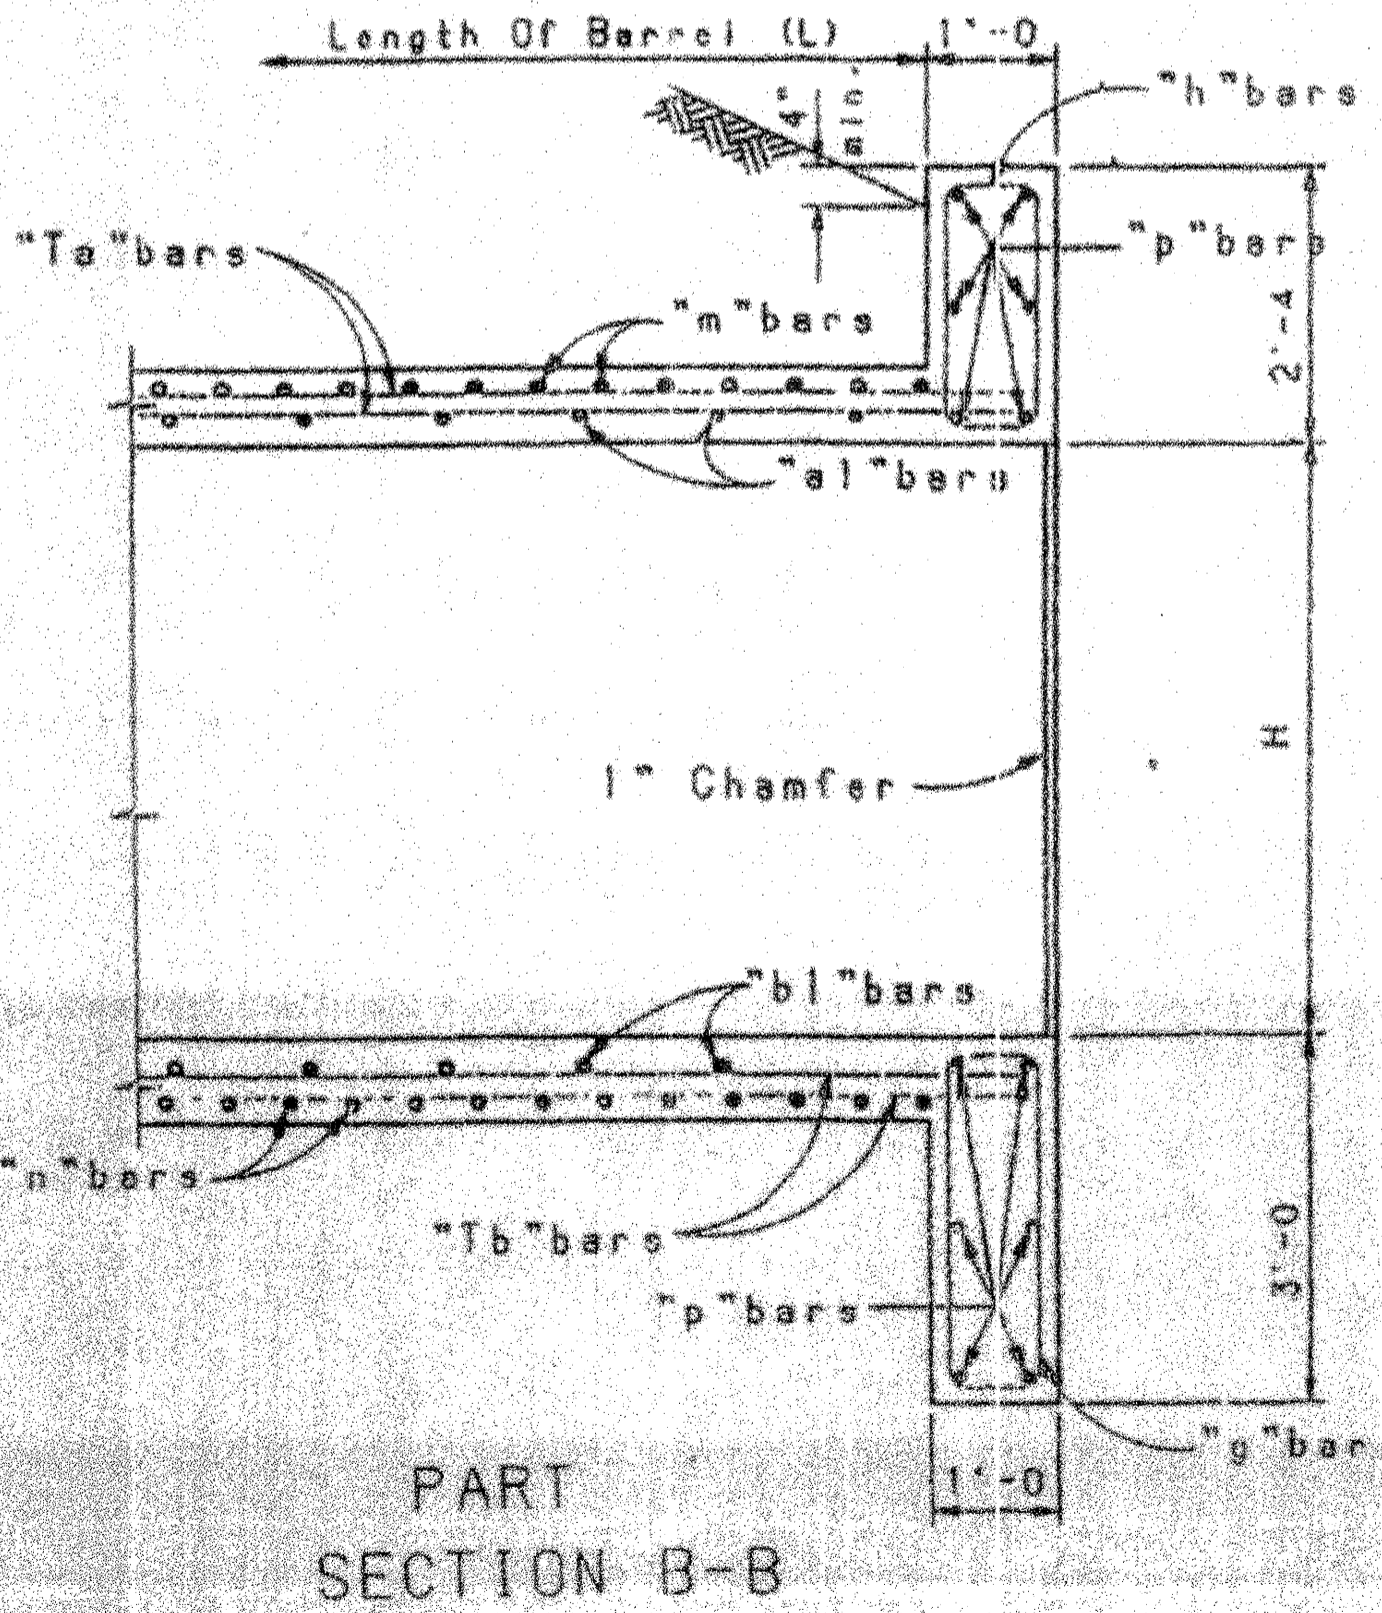

PART SECTION B-B

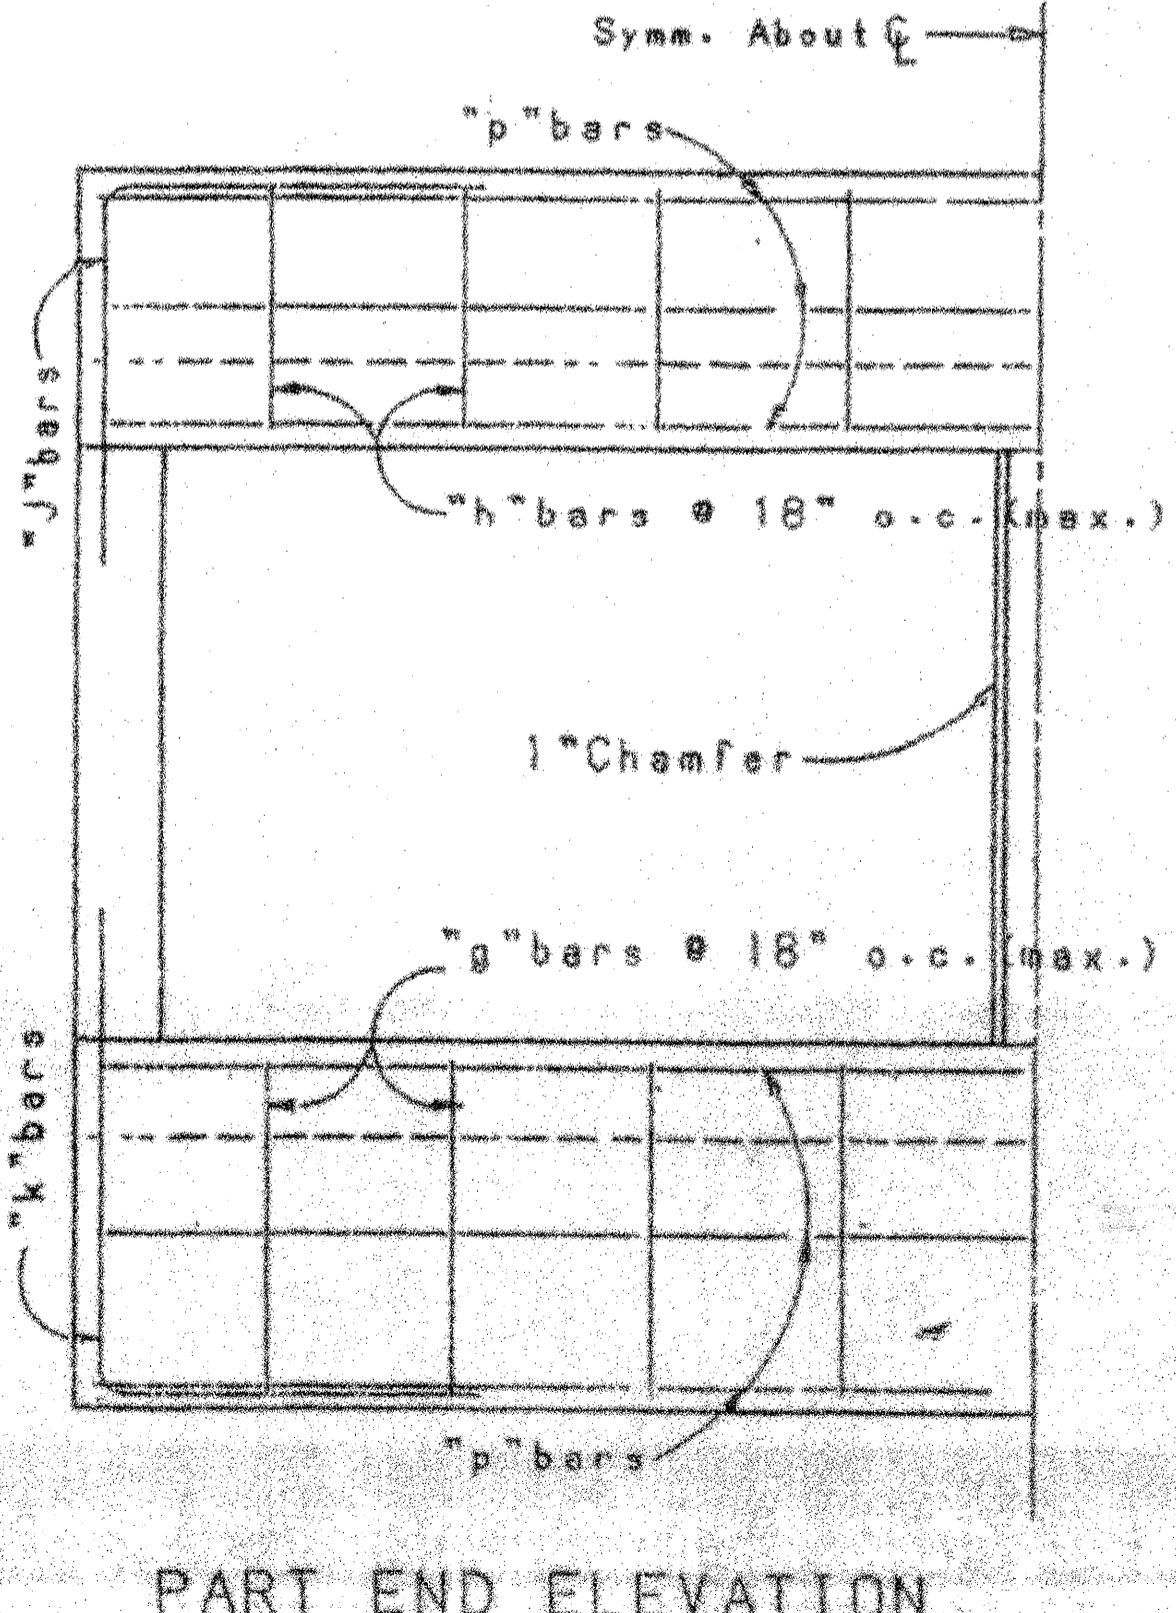

PART END ELEVATION

GENERAL NOTES

1. ALL CONCRETE SHALL BE CLASS "A". CHAMFER ALL EXPOSED EDGES 3/4".
2. ALL REINFORCING STEEL TO BE DEFORMED BARS, CONFORMING TO AASHTO M-31, GRADE 60. ALL DIMENSIONS REFER TO THE CENTERLINE OF BAR.
3. "T" BARS MAY BE SPLICED WHEN NECESSARY BY LAPPING AT LEAST 20 BAR DIAMETERS. PAY WEIGHT FOR REINFORCING STEEL DOES NOT INCLUDE SPLICES. COST OF THE SPLICE MATERIAL TO BE INCLUDED IN UNIT PRICE BID FOR REINFORCING STEEL.
4. VOLUME OF CONCRETE = (L) x (CONCRETE QUANTITY/LIN. FT.) PLUS CONCRETE AT ENDS.
5. WEIGHT OF REINFORCING STEEL = (L) x (WEIGHT OF REINF./LIN.FT.) PLUS WEIGHT AT ENDS.
6. PLACE "Ta" BARS ON "a" BARS AND "Tb" BARS UNDER "b" BARS, SPACED AS SHOWN IN THE TABLE. THE REMAINING "Tc" BARS, AND "Tb" BARS ARE TO BE PLACED ADJACENT TO THE "d", "e", "m", AND "n" BARS AS INDICATED IN "SECTION A-A".
7. PLACE "Tc" BARS NEXT TO "c1" BARS, SPACED AS SHOWN IN THE TABLE. THE REMAINING "Tc" BARS TO BE PLACED IN SIDEWALL NEXT TO "c2", "d", AND "e" BARS. WHEN "c1" BARS ARE NOT REQUIRED PLACE ALL "Tc" BARS NEXT TO "c2", "d", AND "e" BARS.
8. "COVER" IS HEIGHT OF FILL FROM TOP OF BOX TO FINISHED GRADE.

DESIGN DATA

DESIGN ACCORDING TO A.A.S.H.O. SPECIFICATIONS, 1957.
 LIVE LOAD: H20-S16-44 & INTERSTATE ALTERNATE LOADING
 WEIGHT OF FILL ON TOP OF BOX: 84#/CU.FT.
 HORIZONTAL EARTH PRESSURE: 30#/CU.FT., 2' SURCHARGE
 DESIGN STRESSES: $f'_c = 3000$ psi, $f_s = 1200$ psi,
 $f_s = 20,000$ psi, $n = 10$.

6			
5			
4			
3			
2			
1	REVISED NOTE #2	6-7-94	PH
NO.	DESCRIPTION	DATE	BY
REVISIONS (OR CHANGE NOTICES)			
NEW MEXICO STATE HIGHWAY AND TRANSPORTATION DEPARTMENT			
CONCRETE BOX CULVERT BARRELS DOUBLE OPENING - NORMAL ALL DESIGNS			
GENERAL DATA			
LAYOUT BY	APPROVAL		
DRAWN BY	RECORDED		
CHECKED BY	APPROVED		
		7/2/93	
		S.E. 11	
		DIRECTOR OF HIGHWAYS	
SERIAL CB-32			
SHEET 1 OF 5			

DESIGNED BY: H.I. 10/60
 CHECKED BY: J.A.K. 2/93
 R.A. 5/93
 S.J.M. 7/93
 PLOT DATE: 7/20/93


CLEAR SPAN	CLEAR HEIGHT	DIMENSIONS						QUANTITIES		REINFORCING BARS																																																			
		TT	TS	IB	SO	HO	Y	Z	PER L.F. OF BARREL		AT ONE END *		"a1"		"a2"		"b1"		"b2"		"c1"		"c2"		"c3"		"c4"		"d"		"e"		"T _a "		"T _b "		"T _c "		"T _d "		g-h																				
									REINF. STEEL POUNDS PER L.F.	CONCRETE CU. YDS. PER L.F.	REINF. STEEL POUNDS	CONCRETE CU. YDS.	SIZE	LENGTH	SPACING	SIZE	LENGTH	SPACING	SIZE	LENGTH	SPACING	SIZE	LENGTH	SPACING	SIZE	LENGTH	SPACING	SIZE	LENGTH	SPACING	SIZE	LENGTH	SPACING	SIZE	LENGTH	SPACING	SIZE	LENGTH	SPACING	SIZE		LENGTH	SPACING																		
4	2	6 1/2	6	7	9'-6	3'-1 1/2	----	----	77.2	0.507	239	1.99	#6	9'-3	9"	---	NONE	---	#4	9'-3	12"	---	NONE	---	NONE	NONE	#4	2'-3	12"	#4	2'-3	12"	#5	4'-6	9"	#5	4'-6	12"	#5	3'-9	1'-7	12"	#4	4'-3	1'-6	12"	13	#4	18"	13	#4	18"	3	#4	18"	4	#4	16"	6		
	3	7	6	7	9'-6	4'-2	----	----	80.9	0.577	245	2.05	#6	9'-3	9"	---	NONE	---	#4	9'-3	12"	---	NONE	---	NONE	NONE	#4	2'-9	12"	#4	2'-9	12"	#5	4'-6	9"	#5	4'-6	12"	#5	4'-3	1'-7	12"	#4	4'-9	1'-6	12"	13	#4	18"	13	#4	18"	4	#4	22"	6					
	4	7	6	7	9'-6	5'-2	----	----	86.4	0.633	241	2.10	#6	9'-3	9"	---	NONE	---	#4	9'-3	12"	---	NONE	---	NONE	NONE	#4	3'-3	12"	#4	3'-3	12"	#5	4'-6	9"	#5	4'-6	12"	#4	4'-6	1'-7	9"	#4	5'-3	1'-6	9"	13	#4	18"	13	#4	18"	5	#4	10"	6	#4	18"	6		
6	2	7 1/2	6	7 1/2	13'-6	3'-3	1'-4	----	116.2	0.736	316	2.78	#6	13'-3	7 1/2"	---	NONE	---	#4	13'-3	13"	#4	4'-3	13"	NONE	NONE	#5	2'-6	14"	#5	2'-6	14"	#5	4'-3	6 1/2"	#5	5'-3	6 1/2"	#5	3'-9	1'-10	8 1/2"	#4	3'-6	1'-8	8 1/2"	16	#4	18"	16	#4	18"	3	#4	18"	4	#4	18"	8		
	3	7 1/2	6	7 1/2	13'-6	4'-3	1'-4	----	120.3	0.792	322	2.84	#6	13'-3	7 1/2"	---	NONE	---	#4	13'-3	13"	#4	4'-3	13"	NONE	NONE	#5	3'-3	14"	#5	2'-9	14"	#6	4'-3	9 1/2"	#5	5'-6	6 1/2"	#5	4'-3	1'-9	9"	#4	4'-0	1'-8	9"	16	#4	18"	16	#4	18"	4	#4	18"	4	#4	22"	8		
	4	7 1/2	6	7 1/2	13'-6	5'-3	1'-4	----	123.4	0.847	331	2.89	#6	13'-3	7 1/2"	---	NONE	---	#4	13'-3	13"	#4	4'-3	13"	NONE	NONE	#5	4'-3	15"	#5	3'-0	15"	#6	4'-3	10"	#5	5'-6	6 1/2"	#5	4'-9	1'-9	10"	#4	4'-6	1'-8	10"	16	#4	18"	16	#4	18"	5	#4	10"	6	#4	18"	8		
	5	7 1/2	6	7 1/2	13'-6	6'-3	1'-4	----	132.5	0.903	340	2.95	#6	13'-3	7"	---	NONE	---	#4	13'-3	13"	#4	4'-3	13"	NONE	NONE	#5	5'-3	15"	#5	3'-0	15"	#6	4'-3	10"	#5	5'-6	6 1/2"	#5	5'-3	1'-9	10"	#4	5'-3	1'-9	10"	16	#4	18"	16	#4	18"	7	#4	18"	8	#4	18"	8		
	6	7 1/2	6	7 1/2	13'-6	7'-3	1'-4	----	138.4	0.958	374	3.01	#6	13'-3	7"	---	NONE	---	#4	13'-3	13"	#4	4'-3	13"	NONE	NONE	#5	6'-3	15"	#5	3'-0	15"	#6	4'-3	10"	#5	5'-6	6 1/2"	#6	6'-0	1'-9	14"	#5	5'-9	1'-9	14"	16	#4	18"	16	#4	18"	7	#4	18"	8	#4	18"	8		
8	4	8	6	8 1/2	17'-6	5'-4 1/2	1'-6	1'-3	176.5	1.113	553	3.68	#6	17'-3	18"	#8	6'-6	18"	#4	17'-3	11"	#4	6'-0	11"	NONE	NONE	#6	3'-9	16"	#6	3'-9	16"	#6	5'-6	7"	#6	6'-9	7"	#6	5'-6	1'-11	11"	#5	4'-6	1'-10	11"	24	#4	15"	22	#4	15"	5	#4	18"	6	#4	18"	12		
	5	8	6	8 1/2	17'-6	6'-4 1/2	1'-4	0'-9	193.7	1.169	559	3.74	#6	17'-3	14"	#7	7'-6	14"	#4	17'-3	14"	#5	6'-3	14"	NONE	NONE	#5	5'-0	16"	#5	3'-0	16"	#6	6'-3	7 1/2"	#6	7'-9	7"	#6	5'-9	2'-0	11"	#5	5'-9	2'-0	11"	27	#4	15"	25	#4	16"	7	#4	10"	8	#4	18"	12		
	6	8	6	8 1/2	17'-6	7'-4 1/2	1'-4	----	208.3	1.225	571	3.80	#7	17'-3	8"	---	NONE	---	#4	17'-3	10"	#4	6'-6	10"	NONE	NONE	#4	10 1/2"	#5	6'-0	16"	#5	3'-0	16"	#6	7'-0	8"	#6	7'-9	7"	#6	4'-6	2'-1	10 1/2"	#5	4'-0	1'-10	10 1/2"	29	#4	14"	25	#4	16"	9	#4	18"	10	#4	18"	12
	7	8	7	8 1/2	17'-9	8'-4 1/2	1'-6	1'-0	224.5	1.358	608	3.97	#6	17'-6	14"	#7	7'-6	14"	#4	17'-6	14"	#5	6'-3	14"	#4	1E"	#5	15"	#5	7'-0	15"	#5	3'-0	15"	#6	7'-0	7 1/2"	#7	7'-9	9"	#6	5'-3	2'-6	11"	#6	5'-3	2'-6	15"	29	#4	14"	25	#4	16"	9	#4	18"	16	#4	18"	12
	8	8	8	9	18'-0	9'-5	1'-8	1'-5	229.3	1.537	626	4.16	#7	17'-9	18"	#7	6'-6	18"	#4	17'-9	12"	#4	6'-0	12"	#4	1E"	#5	15"	#5	8'-3	12"	#5	3'-0	12"	#6	7'-3	7 1/2"	#6	6'-9	7 1/2"	#6	6'-3	2'-11	12"	#6	6'-3	2'-11	15"	29	#4	14"	25	#4	18"	11	#4	18"	20	#4	18"	12
10	4	9	6 1/2	10	21'-7 1/2	5'-7	1'-8	1'-6	240.9	1.509	796	4.51	#5	21'-3	8 1/2"	#5	8'-0	8 1/2"	#4	21'-3	12"	#5	7'-9	12"	NONE	NONE	#6	4'-9	16"	#6	3'-0	16"	#8	9'-0	10"	#8	8'-6	10"	#6	5'-3	2'-0	10"	#5	5'-3	2'-0	10"	32	#4	12"	32	#4	12"	5	#4	18"	6	#4	18"	14		
	5	9	6	10	21'-6	6'-7	1'-6	1'-6	252.9	1.539	828	4.53	#6	21'-3	12"	#6	8'-0	12"	#4	21'-3	12"	#5	8'-0	12"	NONE	NONE	#5	5'-6	11 1/2"	#5	3'-0	11 1/2"	#7	8'-3	7 1/2"	#7	8'-3	8"	#7	6'-0	2'-3	12"	#6	6'-0	2'-3	12"	32	#4	12"	32	#4	12"	7	#4	18"	8	#4	18"	14		
	6	9	6	10	21'-6	7'-7	1'-6	1'-6	251.9	1.594	827	4.59	#5	21'-3	10 1/2"	#6	8'-0	10 1/2"	#4	21'-3	12"	#5	8'-0	12"	NONE	NONE	#4	6'-0	7 1/2"	#4	3'-0	7 1/2"	#7	8'-3	7 1/2"	#7	8'-3	7 1/2"	#7	5'-3	2'-5	12"	#6	8'-3	2'-6	12"	29	#4	14"	25	#4	18"	9	#4	10"	10	#4	18"	14		
	7	9	7	10	21'-9	8'-7	1'-6	1'-0	285.4	1.729	855	4.76	#6	21'-6	14"	#7	8'-9	14"	#5	21'-6	14"	#5	8'-0	14"	NONE	NONE	#4	12"	#5	7'-3	8 1/2"	#5	3'-0	8 1/2"	#7	8'-9	7 1/2"	#7	7'-9	7 1/2"	#7	7'-0	3'-0	12"	#6	6'-0	2'-9	12"	24	#5	18"	24	#4	18"	9	#4	18"	10	#4	18"	14
	8	9	8	10	22'-0	9'-7	1'-6	----	289.8	1.883	881	4.94	#7	21'-9	9"	---	NONE	---	#5	21'-9	18"	#6	7'-9	18"	#4	1E"	#4	12"	#4	8'-0	8"	#4	3'-0	8"	#7	9'-0	8"	#7	7'-0	8"	#7	7'-6	3'-6	12"	#5	6'-0	2'-9	12"	25	#5	18"	24	#4	18"	11	#4	18"	20	#4	18"	14
	9	9	8	10	22'-0	10'-7	1'-6	----	312.2	1.957	919	5.04	#7	21'-9	9"	---	NONE	---	#5	21'-9	15"	#5	8'-3	15"	#4	17"	#4	13"	#5	9'-3	12"	#5	3'-0	12"	#7	9'-3	8"	#7	7'-9	7 1/2"	#7	7'-6	3'-6	11 1/2"	#7	6'-6	3'-0	13"	25	#5	18"	24	#4	18"	12	#4	18"	24	#4	18"	14
	10	9	9	10	22'-3	11'-7	1'-6	----	325.9	2.138	884	5.23	#7	22'-0	9"	---	NONE	---	#5	22'-0	18"	#6	8'-6	18"	#4	15"	#4	10"	#4	10'-0	9"	#4	3'-0	9"	#8	9'-6	10 1/2"	#8	8'-6	9 1/2"	#6	8'-0	3'-9	9"	#6	7'-0	3'-3	10"	25	#5	18"	24	#4	18"	13	#4	18"	28	#4	18"	14
	11	9	9	10	22'-3	12'-7	1'-6	1'-0	332.7	2.221	953	5.39	#5	22'-0	11"	#6	8'-9	11"	#5	22'-0	14"	#5	8'-3	14"	#4	12"	#4	12"	#5	11'-3	15"	#5	3'-0	15"	#7	10'-0	7 1/2"	#7	8'-3	7"	#7	7'-6	3'-6	12"	#7	6'-9	3'-3	12"	25	#5	18"	24	#4	18"	15	#4	18"	30	#4	18"	14
	12	9 1/2	9	10	22'-3	13'-7 1/2	1'-6	1'-9	373.2	2.339	954	5.54	#5	22'-0	14"	#7	8'-0	14"	#4	22'-0	15"	#6	8'-3	15"	#5	14"	#4	8"	#7	13'-9	14"	#7	3'-3	14"	#7	10'-3	8"	#7	8'-3	7"	#6	7'-3	3'-4	8"	#6	7'-3	3'-4	8"	30	#4	14"	25	#4	18"	15	#4	18"	30	#4	18"	14
12	6	10 1/2	6 1/2	11 1/2	25'-7 1/2	7'-10	2'-2	1'-9	304.7	2.101	1127	5.43	#4	25'-3	9"	#6	9'-6	9"	#5	25'-3	12"	#5	8'-9	12"	NONE	NONE	#6	6'-9	16"	#6	3'-3	16"	#8	9'-6	8"	#8	9'-6	8 1/2"	#6	6'-3	2'-1	8"	#5	6'-6	2'-0	8"	36	#4	12"	32	#4	14"	7	#4	18"	8	#4	18"	16		
	8	10 1/2	8	11 1/2																																																									

GENERAL NOTES:


- REFER TO NMDOT SERIAL CB-32, CONCRETE BOX CULVERT BARRELS DOUBLE OPENING FOR BASIC CONSTRUCTION. CONSTRUCT PER MODIFICATIONS SHOWN SHEETS 9 AND 10.

CBC KEYED NOTES: ○


- NMDOT REFERENCE "TS" (WALL THICKNESS) SHALL BE REVISED TO BE 8" WALL THICKNESS. AS PER SECTION DETAIL, THIS SHEET.
- NMDOT REFERENCE "Te & Tc BARS" (REBAR) SHALL BE REVISED TO USE TWO (2) - #4 BARS @ 9" O.C. EACH FACE AS PER SECTION THIS SHEET.
- EXTEND BARS INTO SPLITTER WALLS AT ENDS OF BOX CULVERT.

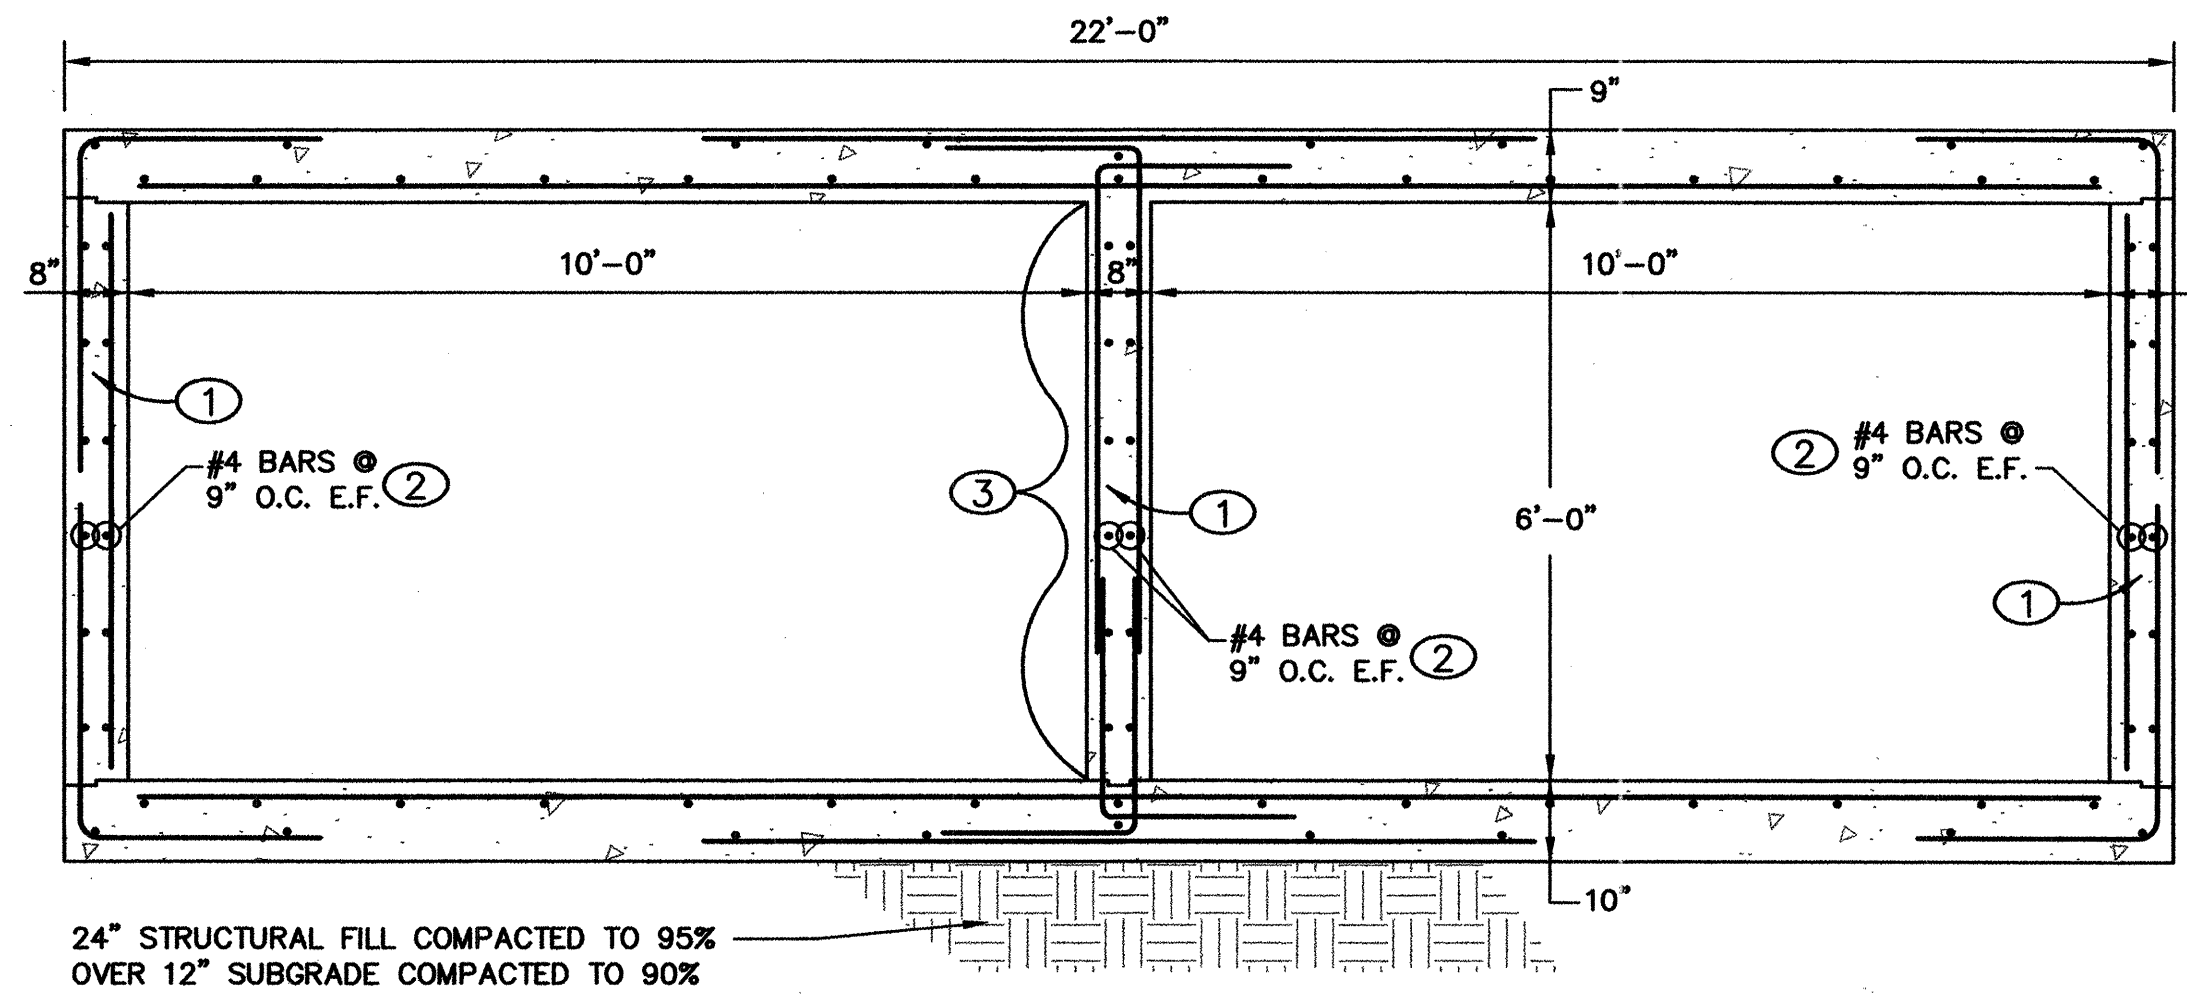

SECTION 1-11

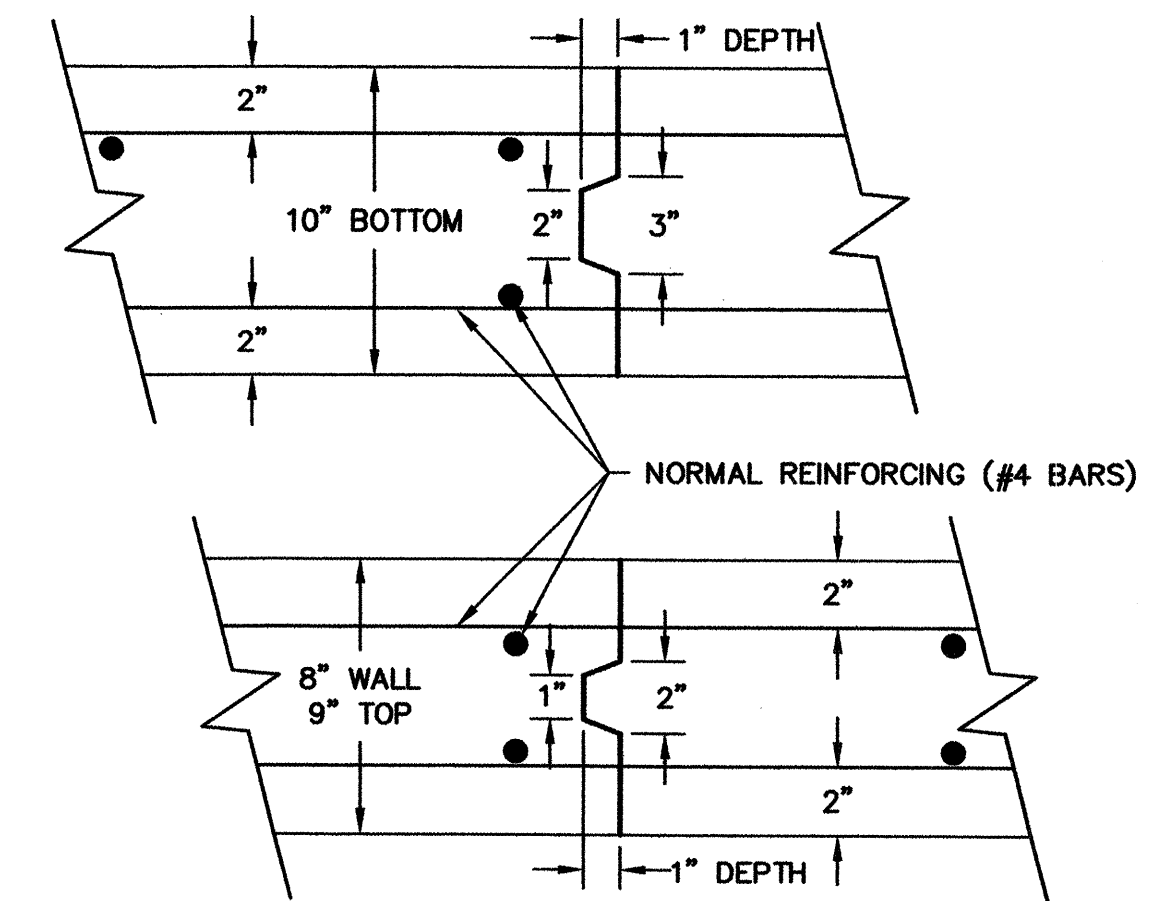

LONGITUDINAL CONSTRUCTION JOINT DETAILS
N.T.S

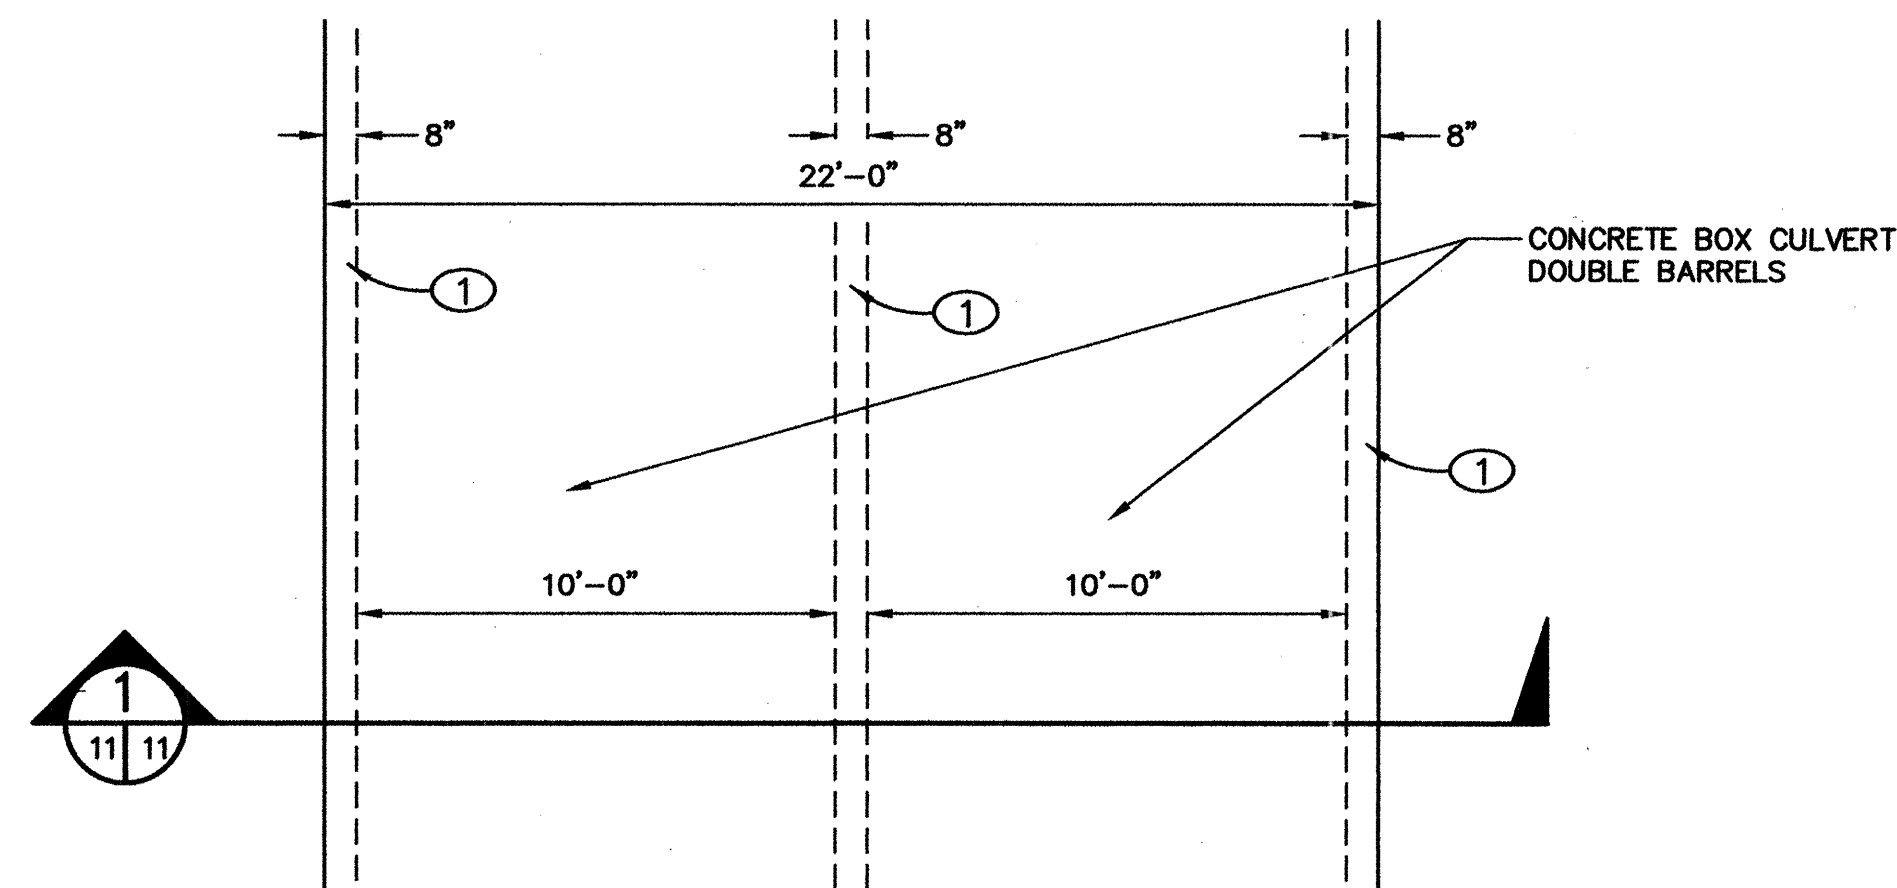

PLAN VIEW

MODIFIED CBC DIMENSIONS
N.T.S

AS BUILT INFORMATION		CONTRACTOR: Salls & Bco.	DATE: 3/07
WORK STARTED BY: C.S.	DATE: 3/07	ACCEPTANCE BY: C.O.A.	DATE: 3/07
FIELD CLERK BY: C.S.	DATE: 3/07	DRAWN BY: SEC.	DATE: 3/07
CORRECTED BY:		RECORDED BY:	
MICRO-FILM INFORMATION		NO.	DATE
ENGINEERS SEAL			
SURVEY INFORMATION		DATE	BY
NO.	DATE	BY	NO.
REVISIONS		DATE	BY
NO.	DATE	BY	NO.
DESIGNED BY: GN	DATE: JULY 2005	DRAWN BY: KSH	DATE: JULY 2005
CHECKED BY: GN	DATE: JULY 2005		

RECORD DRAWING


Smith Engineering Company
102035B
A Full Service Engineering Company
200 San Pedro Boulevard, N.E., 2nd Fl., Suite 200 Albuquerque, New Mexico 87110

CITY OF ALBUQUERQUE
DEPARTMENT OF MUNICIPAL DEVELOPMENT


TITLE: NORTH DOMINGO BACA PARK
PHASE 4 CONSTRUCTION - BOX CULVERT
CONCRETE BOX CULVERT DETAILS

Design Review Committee	City Engineer Approval	No. / Rev. / Yr.	No. / Rev. / Yr.


City Project No. **7138.92** Zone Map No. **C-19** Sheet **11** Of **14**

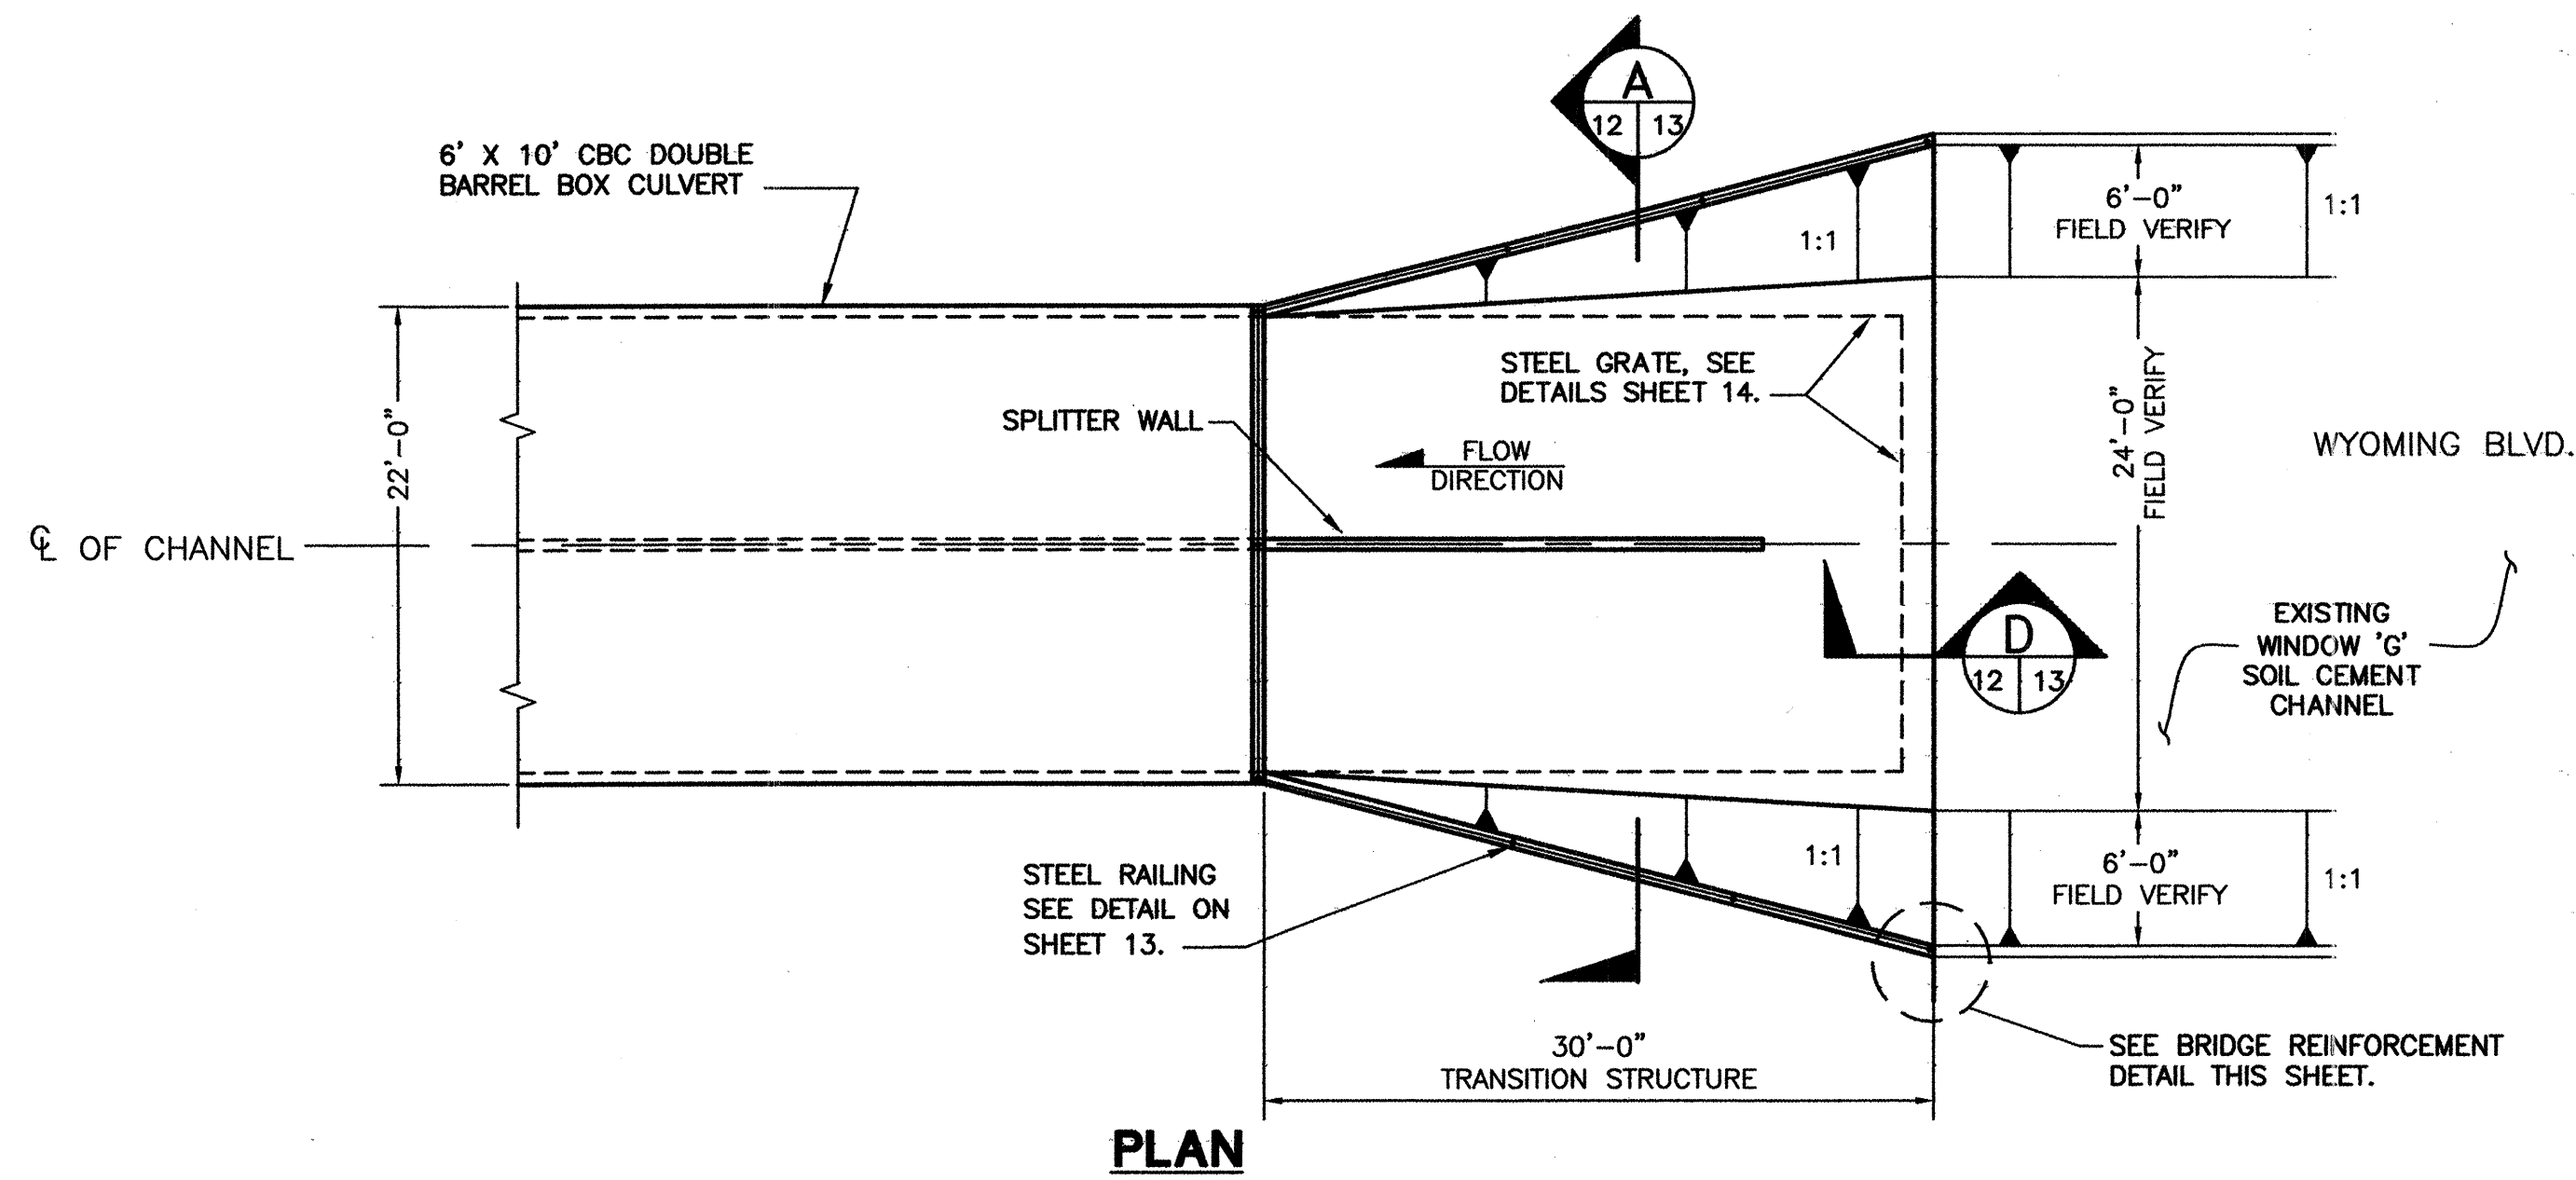


CBC TRANSITION STRUCTURE AT BRIDGE
N.T.S.

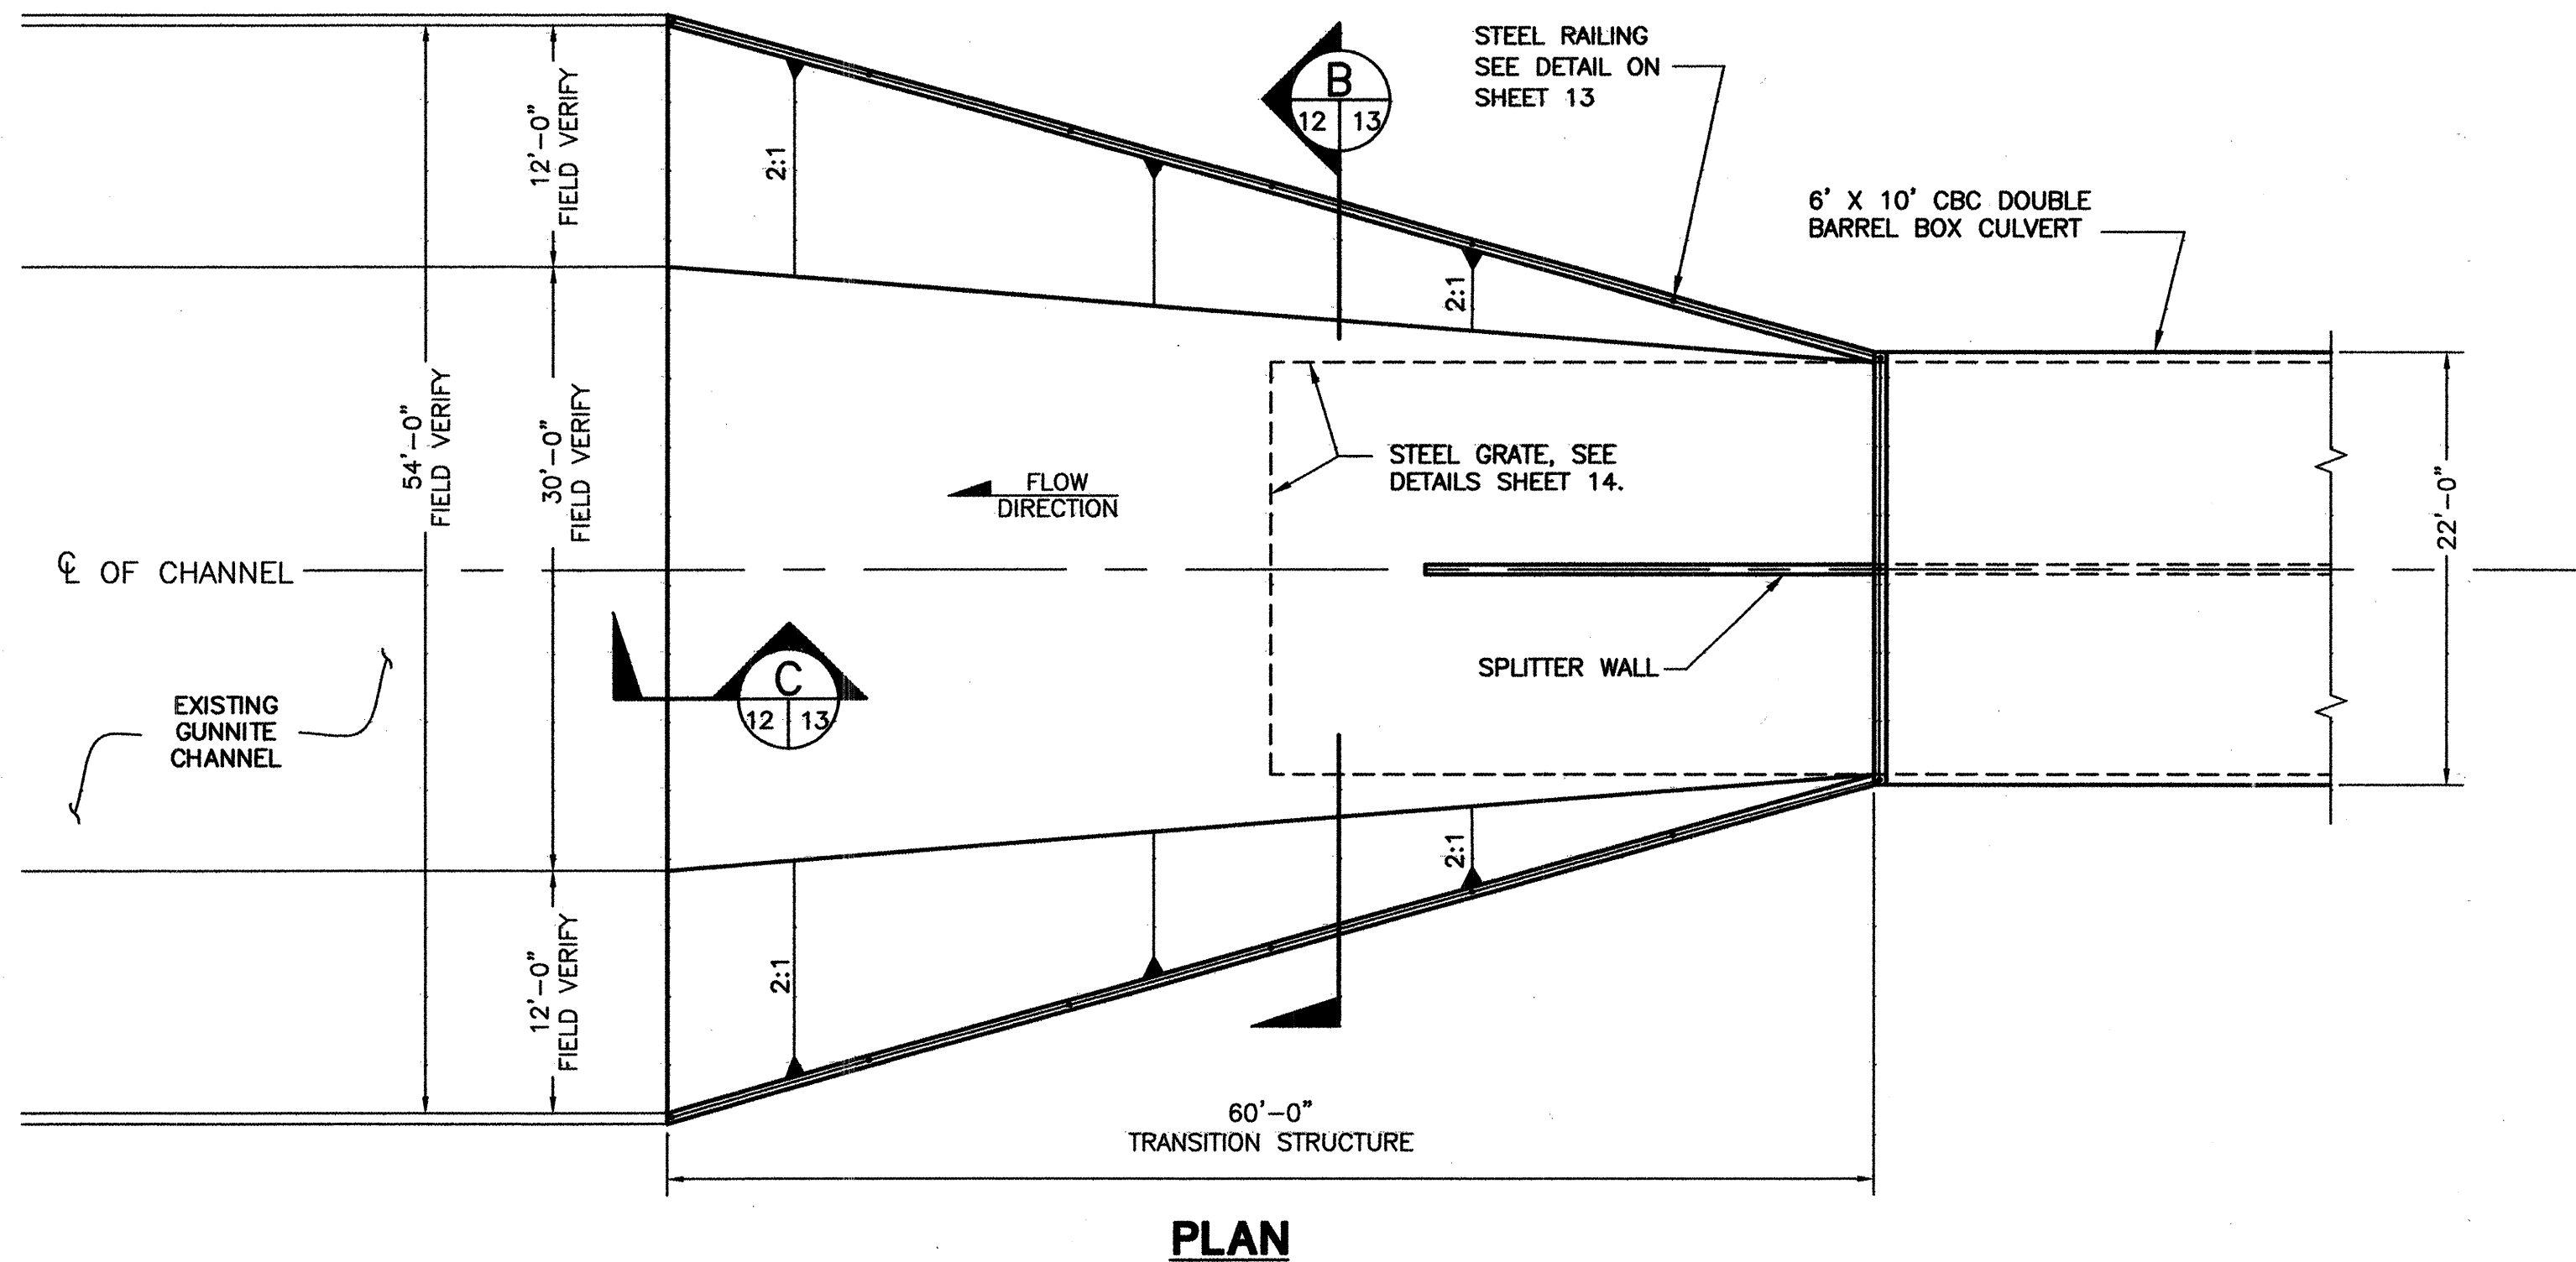


CBC TRANSITION STRUCTURE DOWNSTREAM
N.T.S.

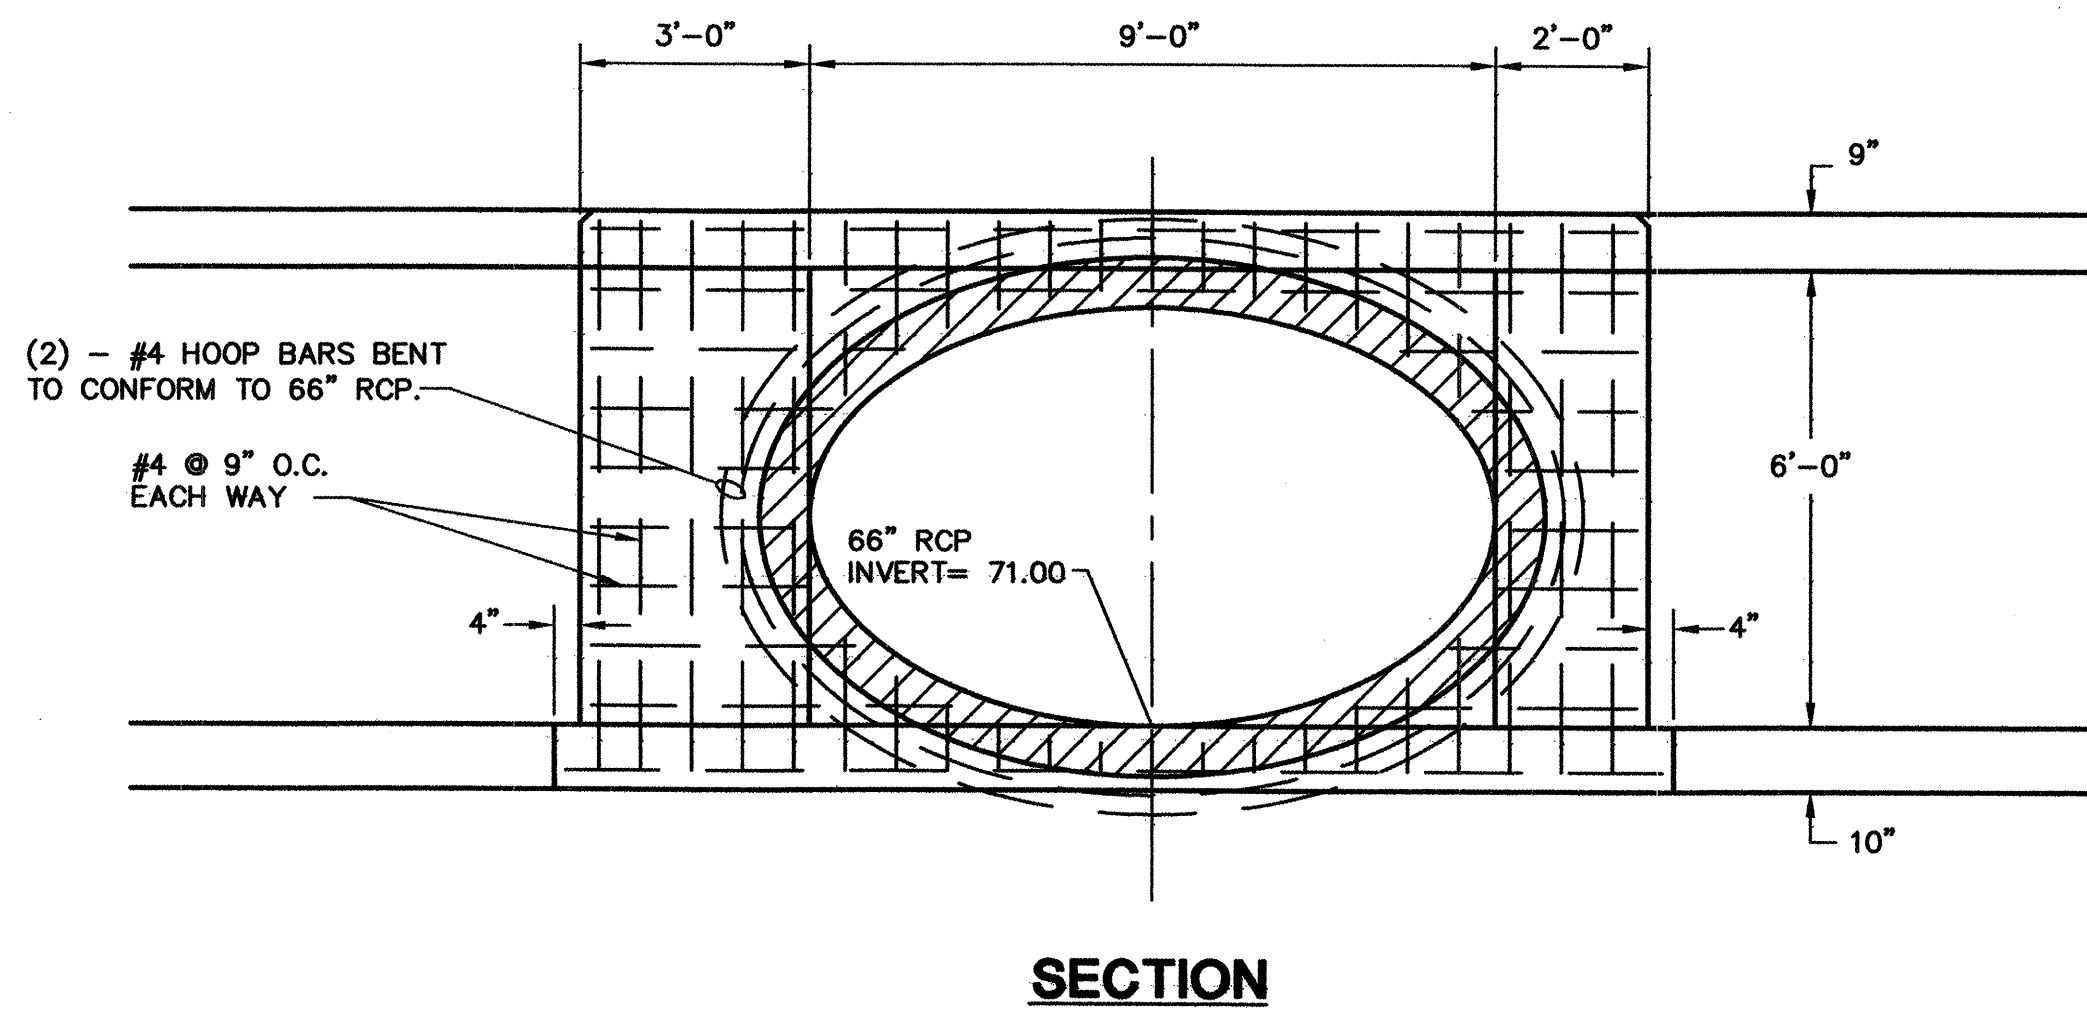


SECTION

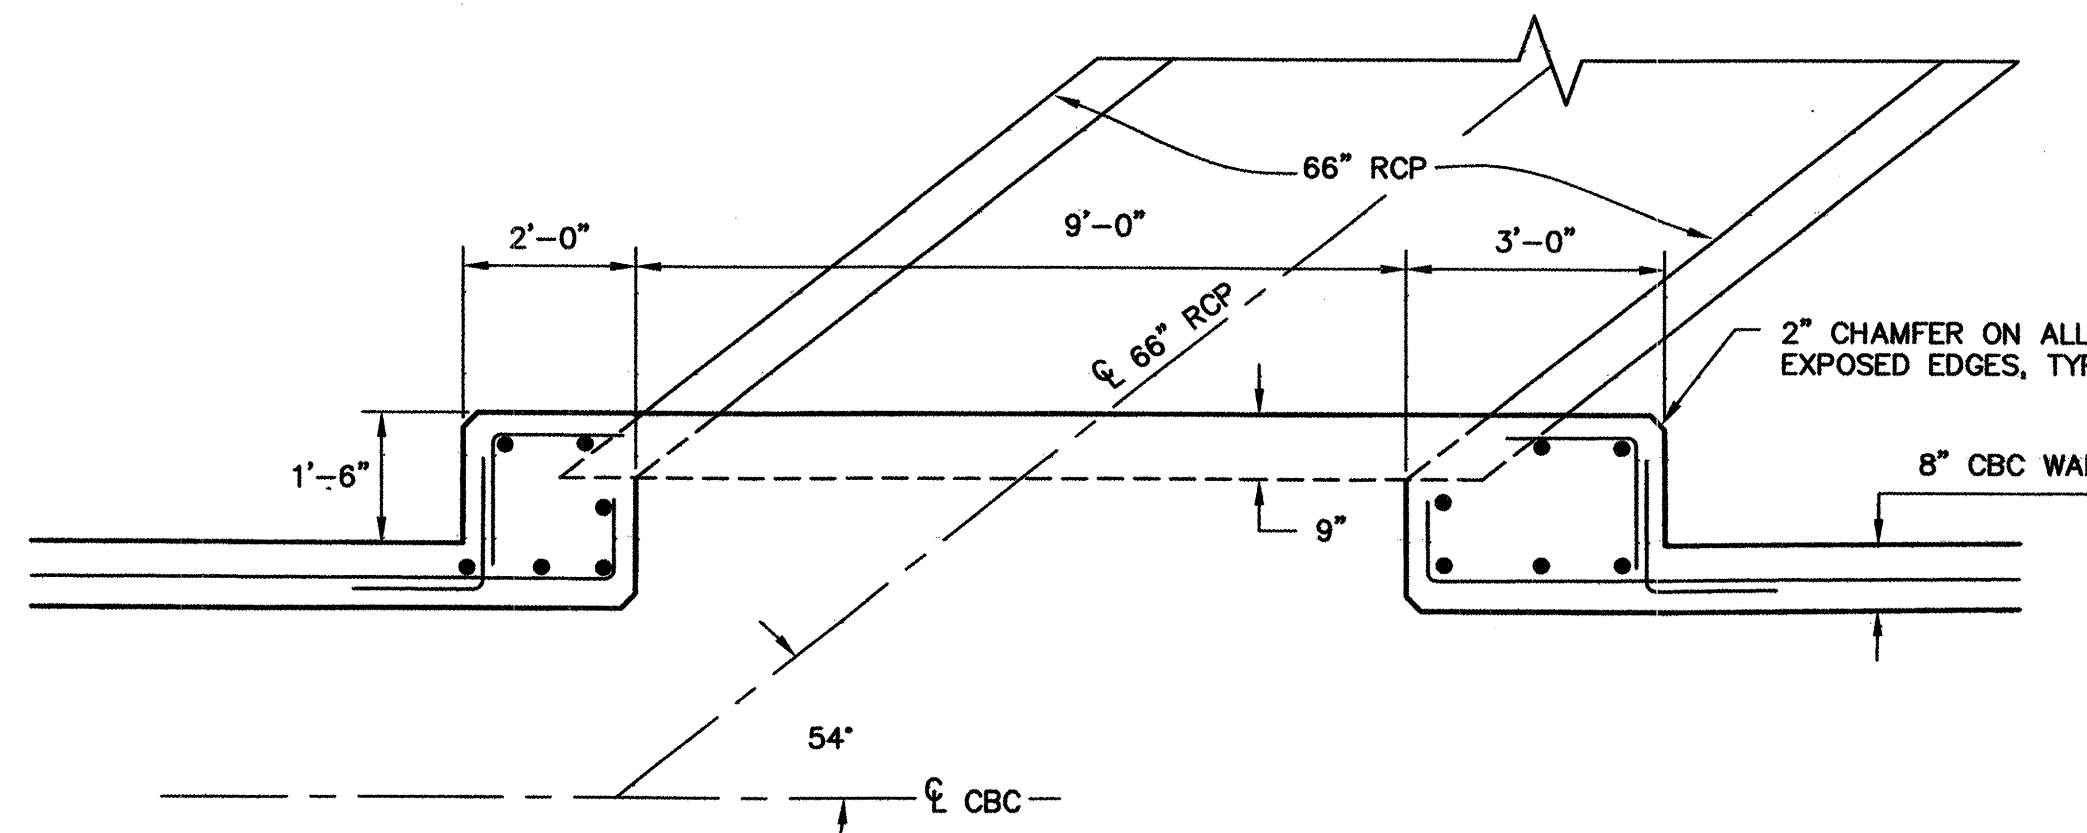


66" PIPE CONNECTION DETAIL
N.T.S.

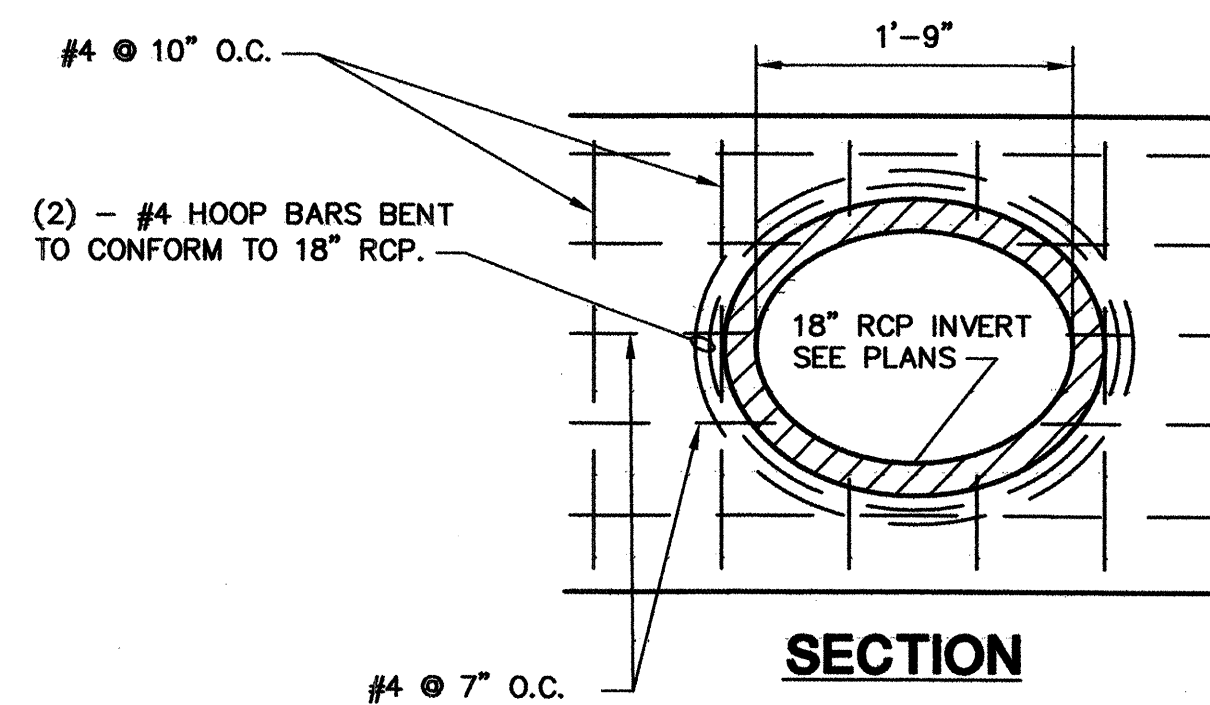

SECTION

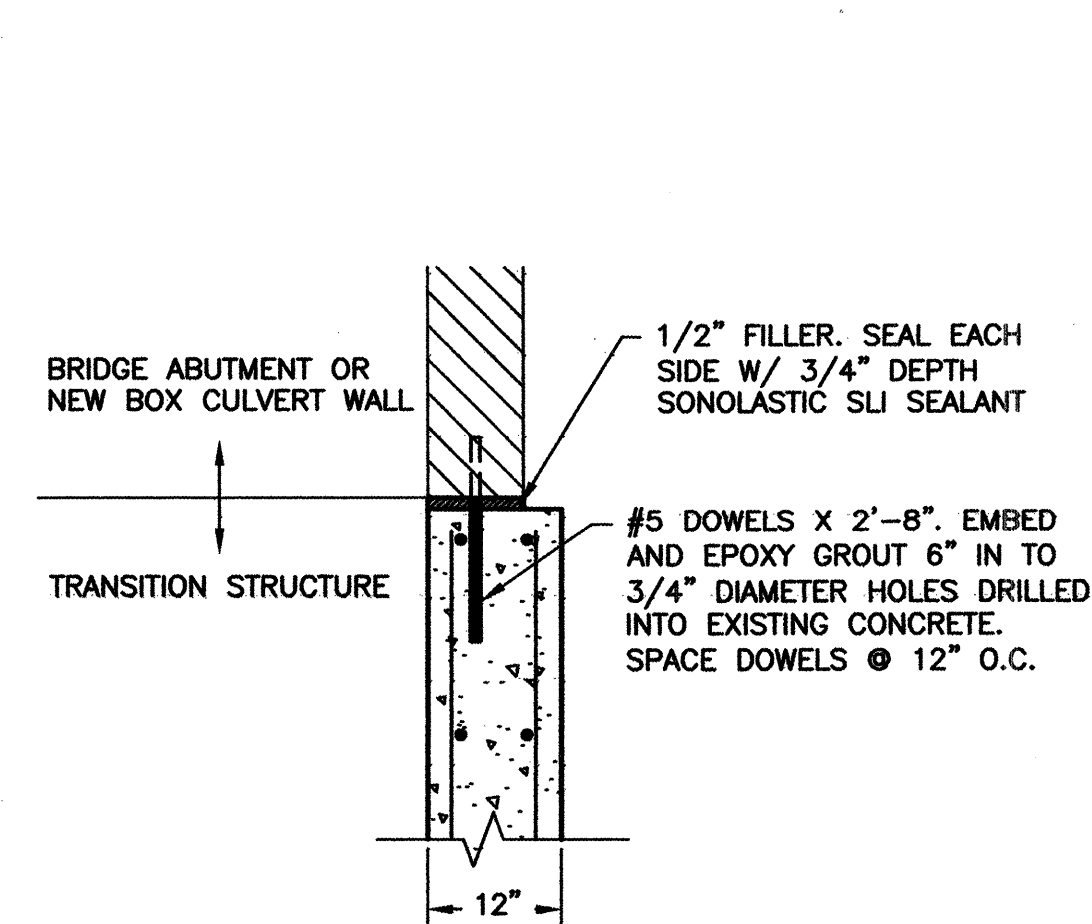


BRIDGE REINFORCEMENT DETAIL
N.T.S.

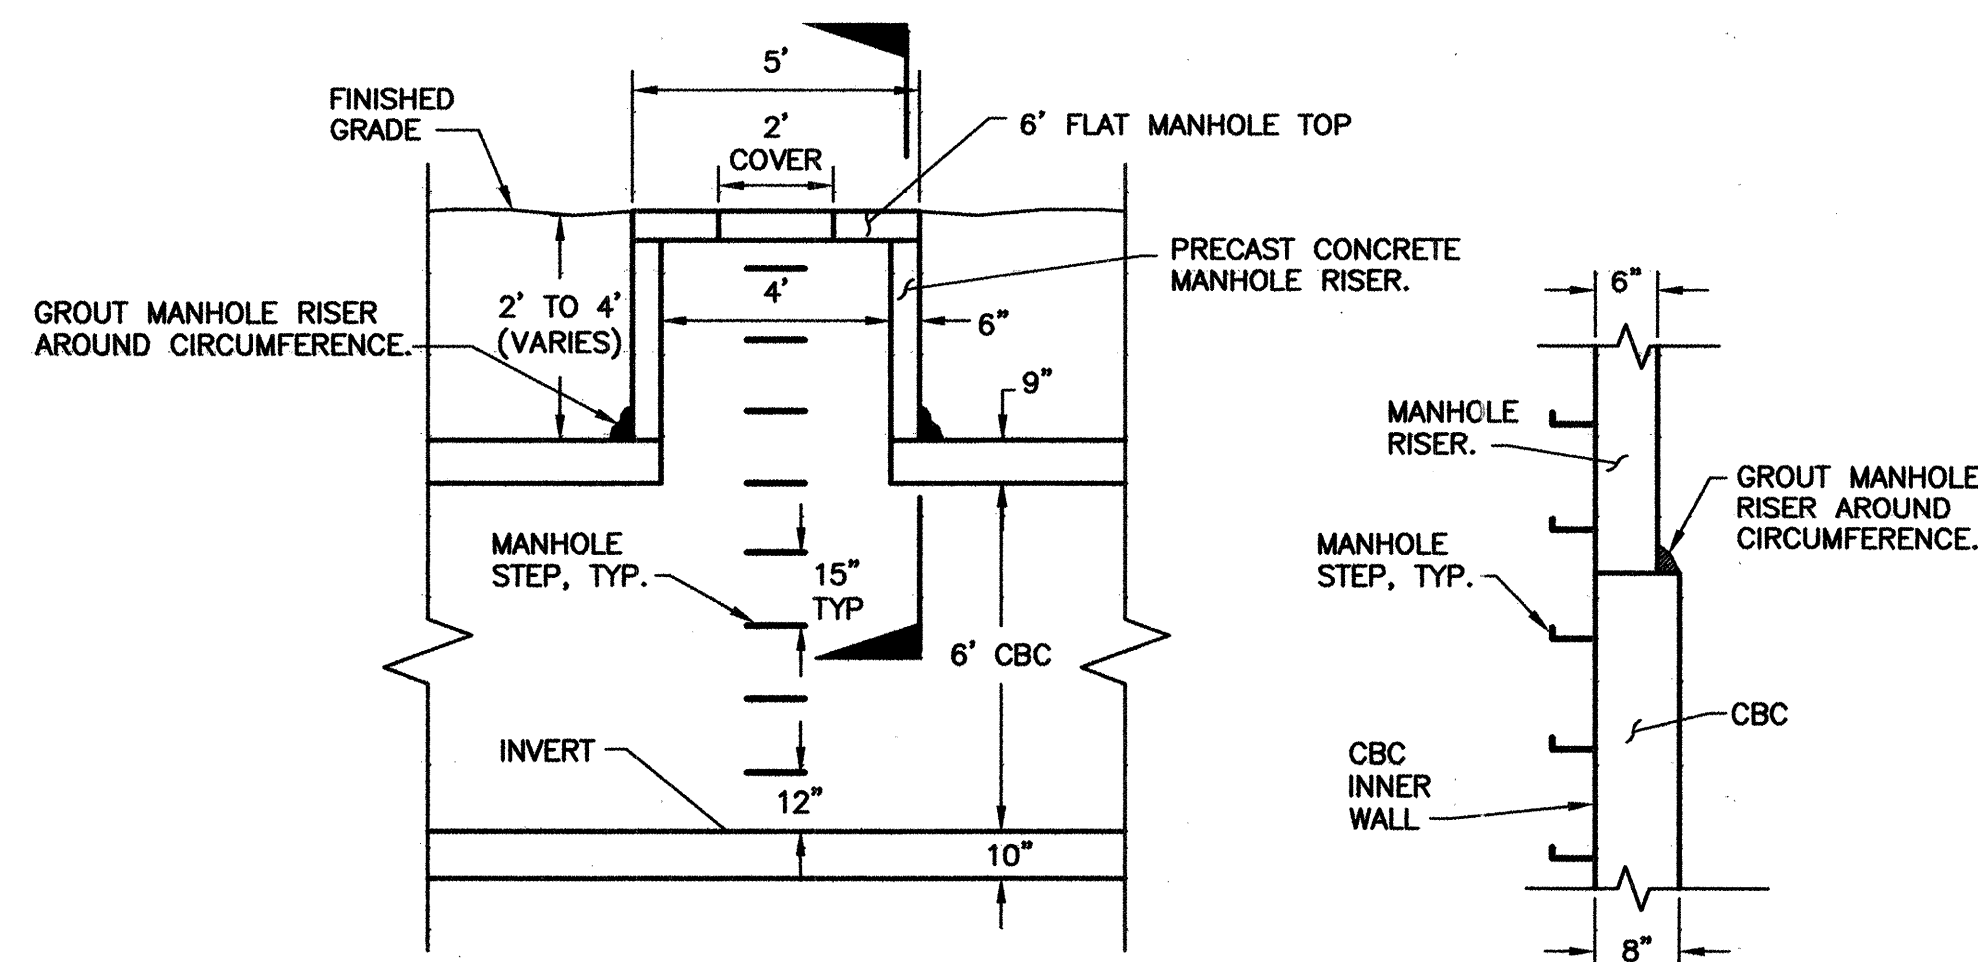

MANHOLE DETAIL
N.T.S.

MANHOLE SECTION
N.T.S.

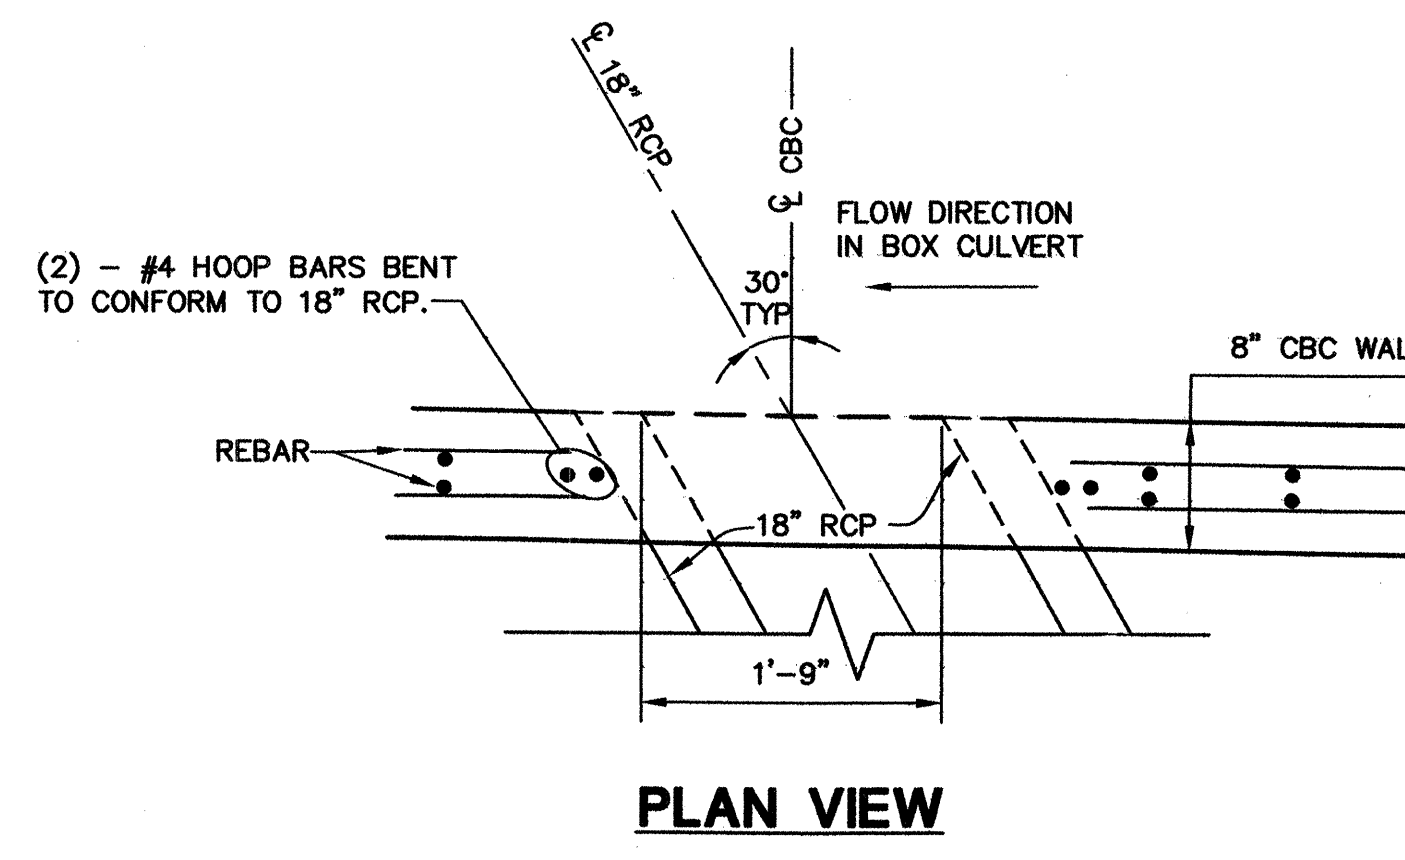

18" PIPE PENETRATION DETAIL
N.T.S.

RECORD DRAWING

1020358
Smith Engineering Company
 A Full Service Engineering Company
 2001 San Pedro Boulevard, N.E., Map #4, Suite 200 Albuquerque, New Mexico 87110

CITY OF ALBUQUERQUE
 DEPARTMENT OF MUNICIPAL DEVELOPMENT

TITLE: **NORTH DOMINGO BACA PARK
 PHASE 4 CONSTRUCTION - BOX CULVERT
 SECTIONS & DETAILS**

Design Review Committee	City Engineer Approval	No. / Day / Yr.	No. / Day / Yr.
AUG - 4 2005	AUG - 4 2005		
City Project No. 7138.92	Zone Map No. C-19	Sheet 12	Of 14








AS BUILT INFORMATION	
CONTRACTOR	Skills Bro. 3/17
WORK STARTED BY	C.S. DATE 3/07
ACCEPTANCE BY	COA DATE 3/07
FIELD OBSERVATION BY	C.S. DATE 3/07
DRAWINGS CORRECTED BY	SEC. DATE 3/07
MICRO-FILM INFORMATION	
SPRIT LEVEL ELEVATION	= 5474.533 FT. (NGVD 29)
PLANE COORDINATES	N = 1524092.46; E = 410237.56
RECORDED BY	NO.

ENGINEERS SEAL

SURVEY INFORMATION		
DATE	BY	
NO.		
FIELD NOTES		
DATE	BY	
NO.		
REVISIONS		
NO.	DATE	BY
	JULY 2005	GN
	JULY 2005	KSH
	JULY 2005	GN

KEYED NOTES: ○

1. PROVIDE A CONTRACTION JOINT ONE (1) FOOT ABOVE THE CHANNEL BOTTOM BEGINNING WHERE SLOPE LENGTH EXCEEDS TWO (2) FEET.

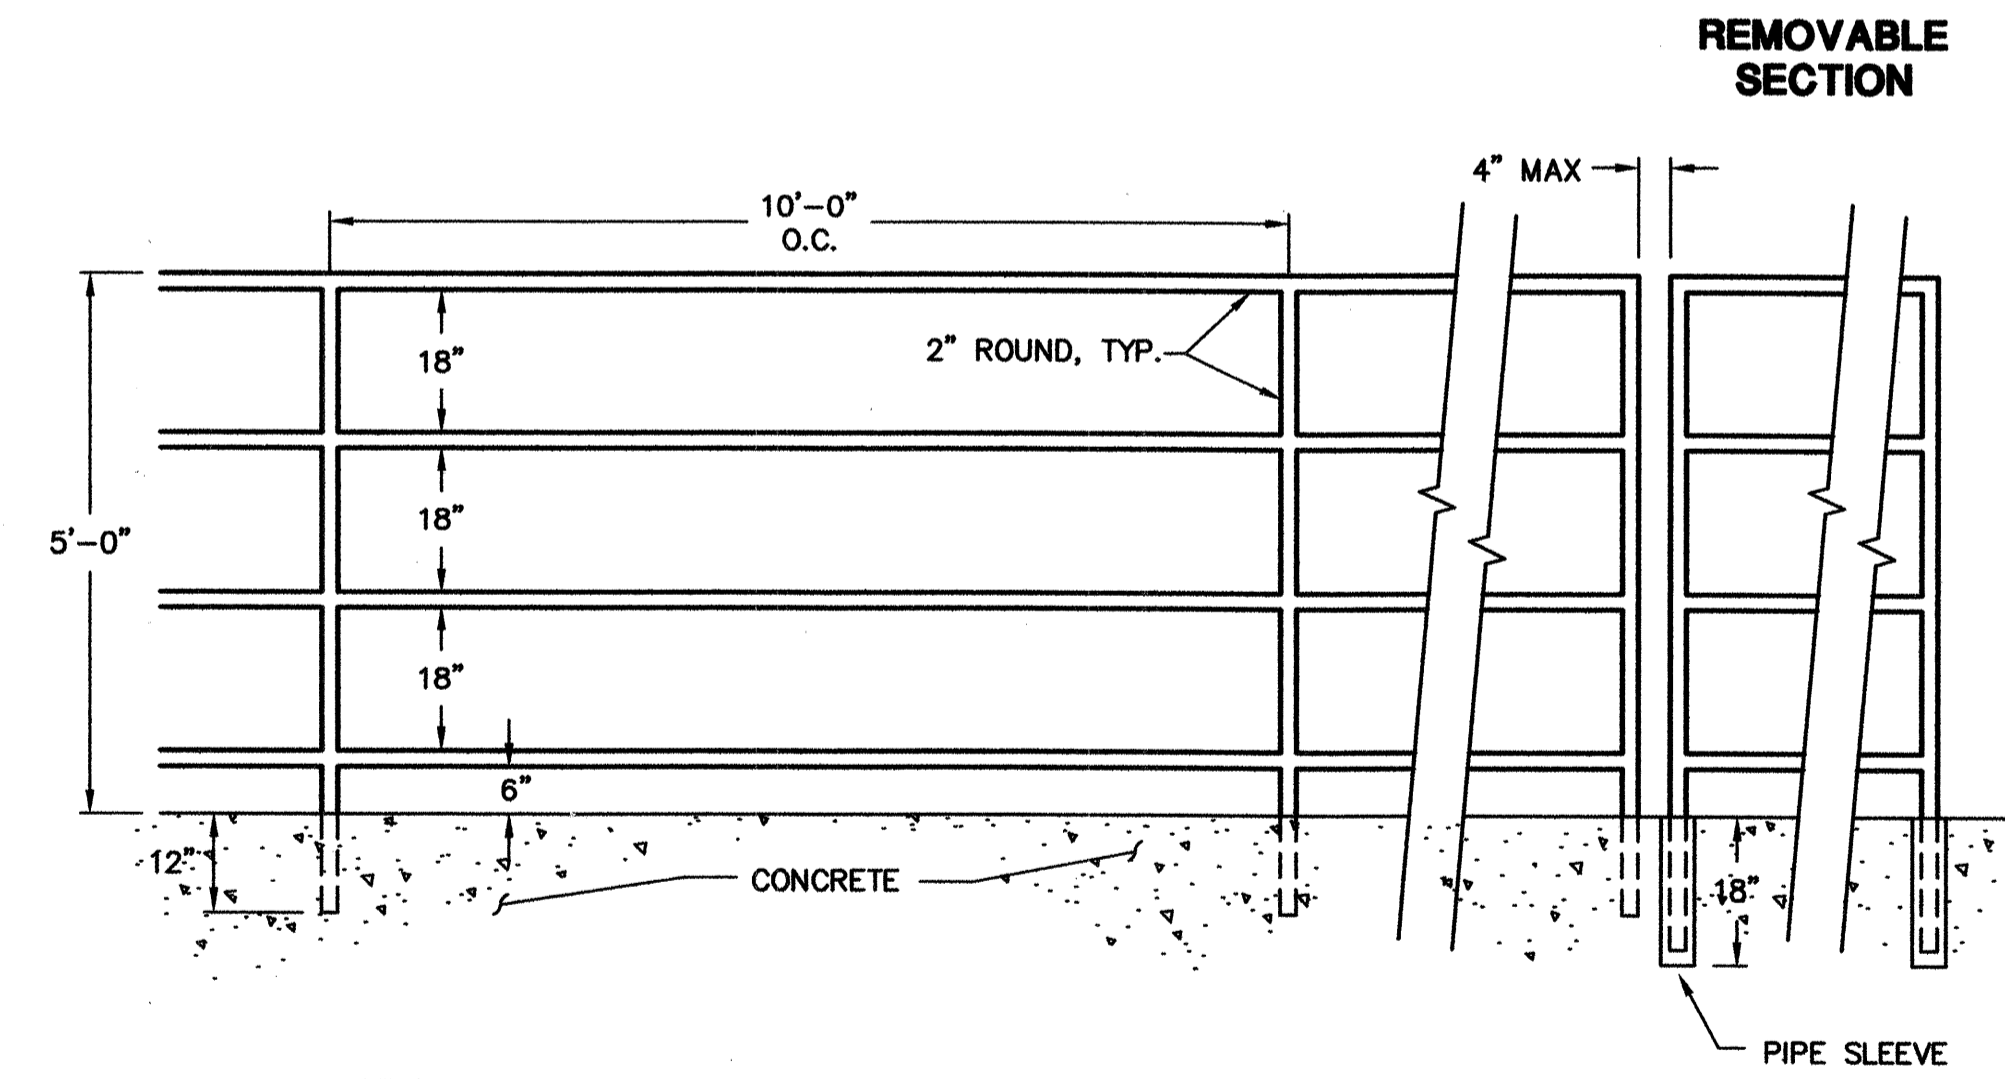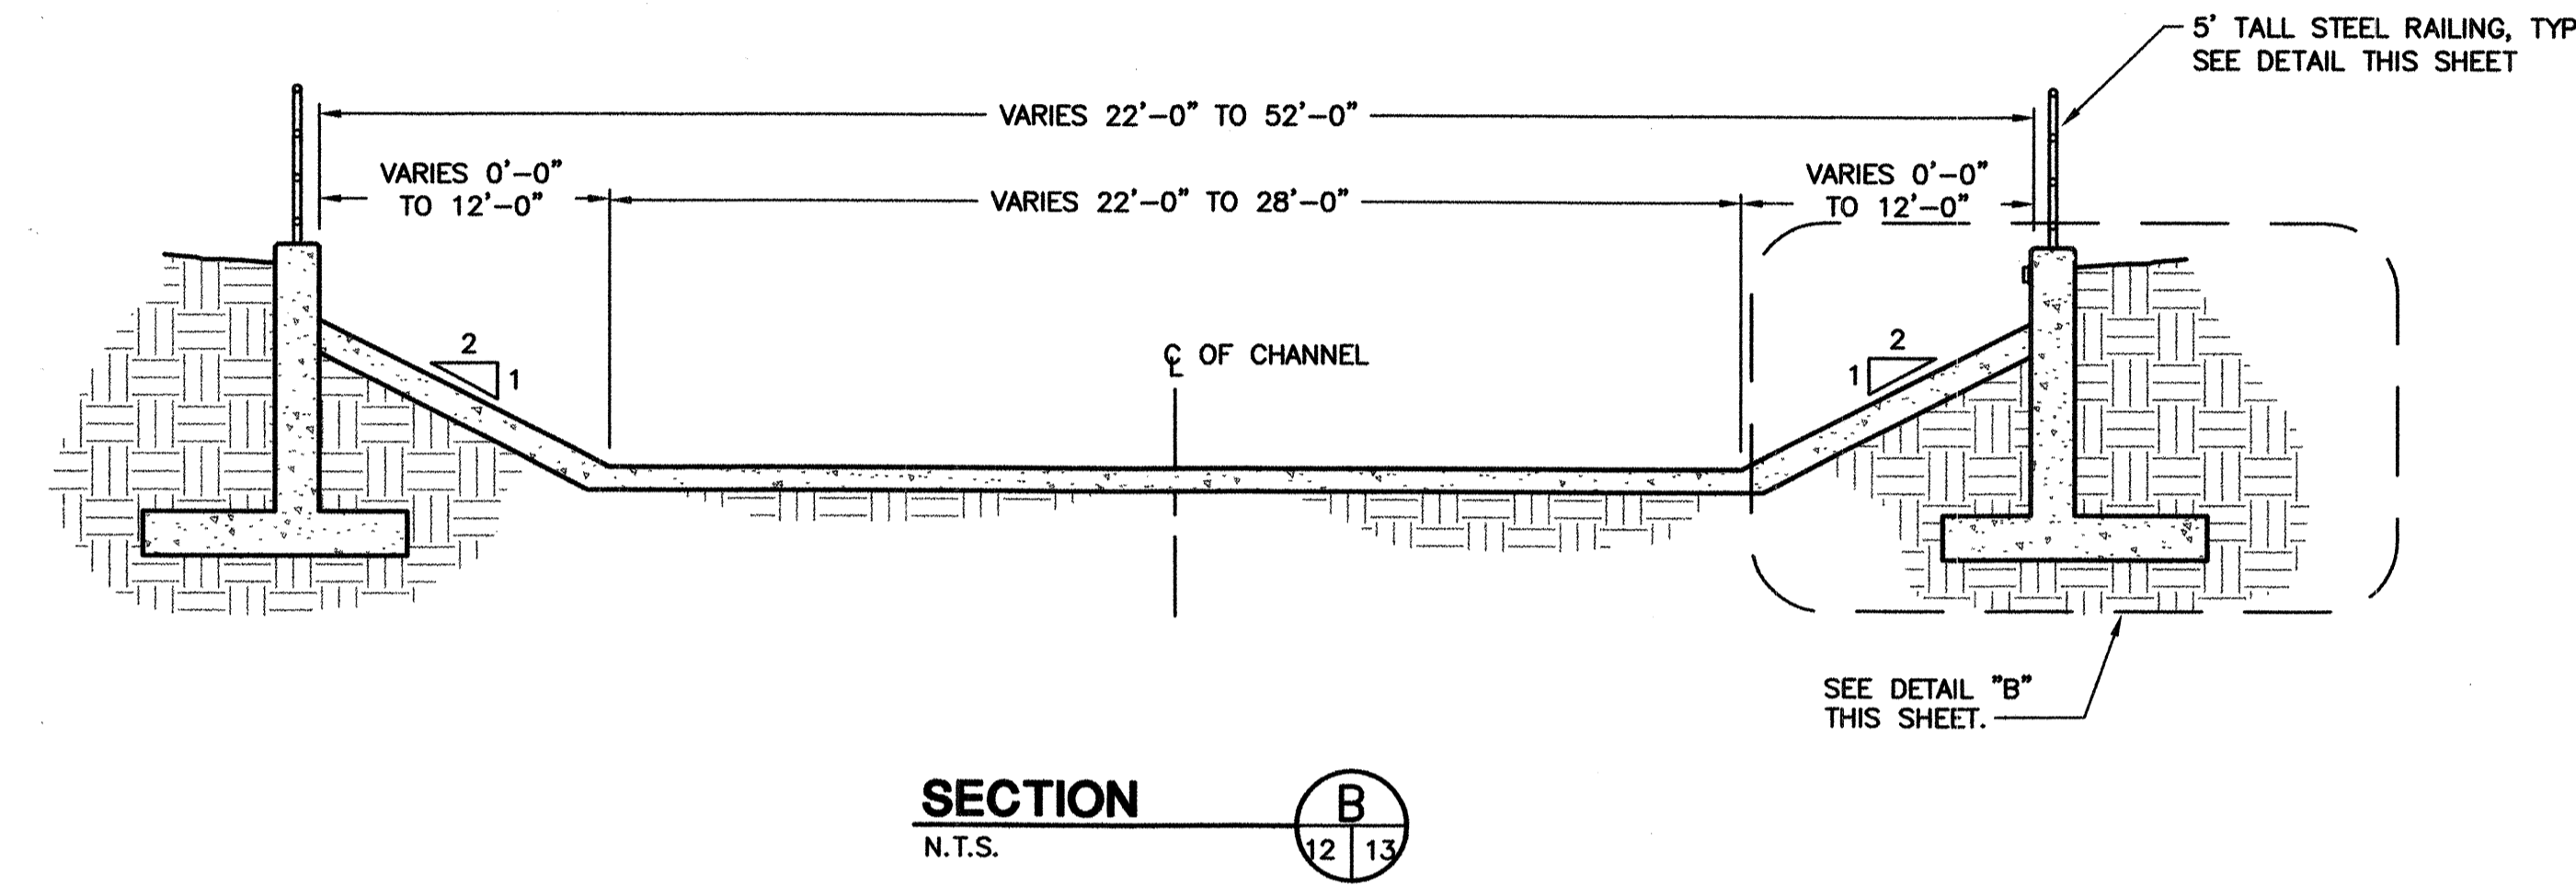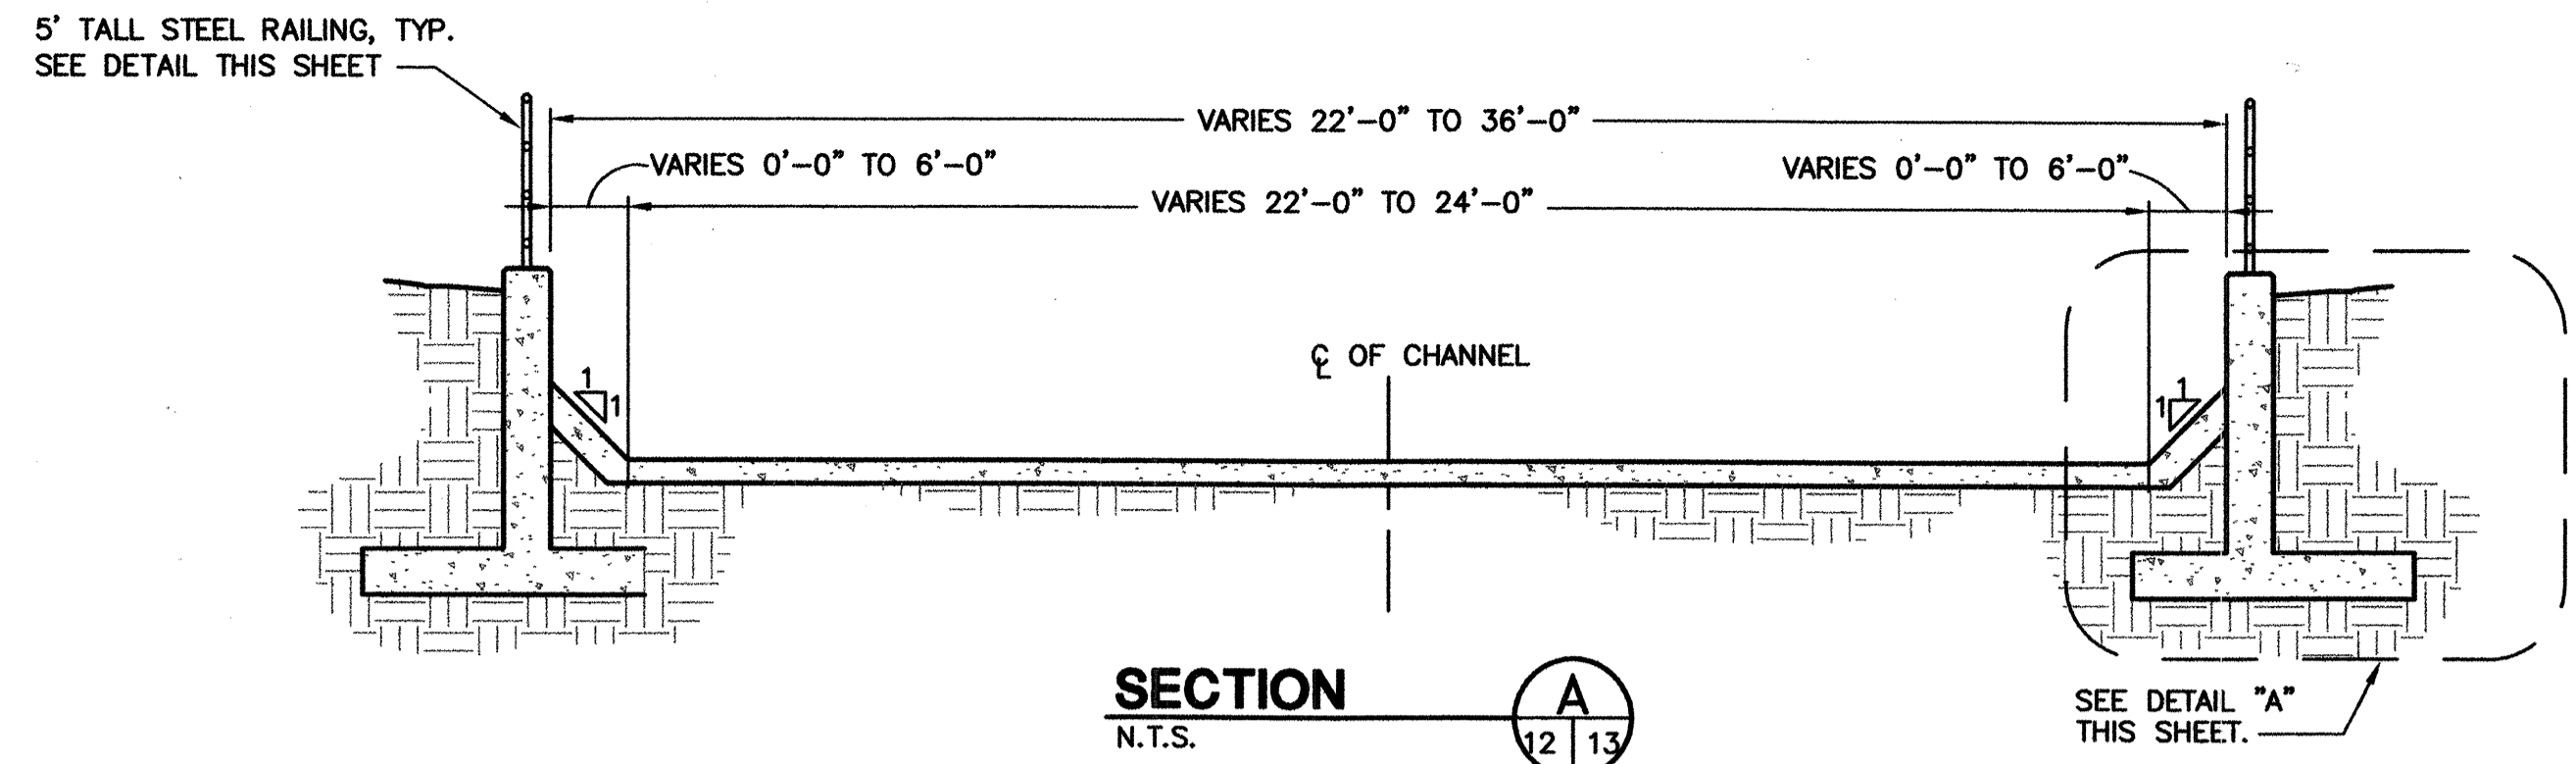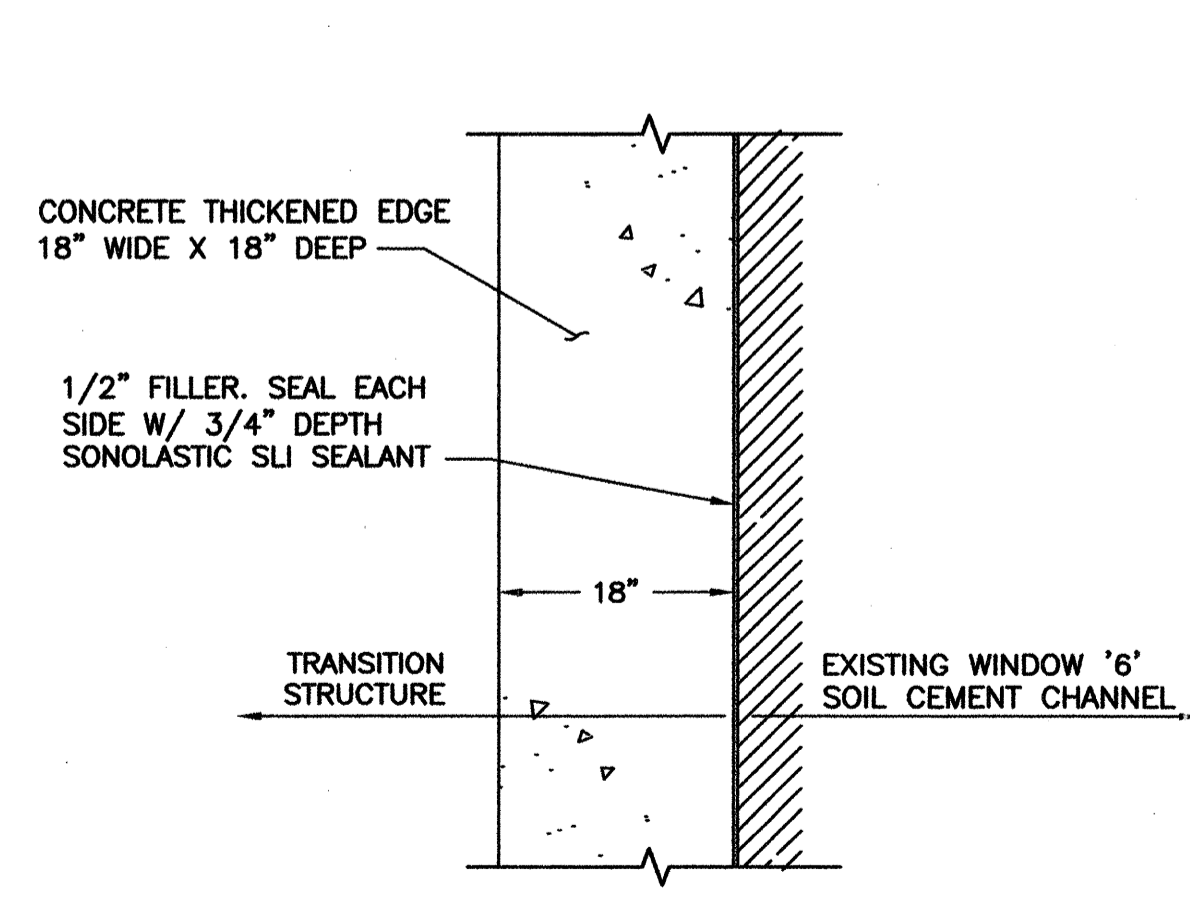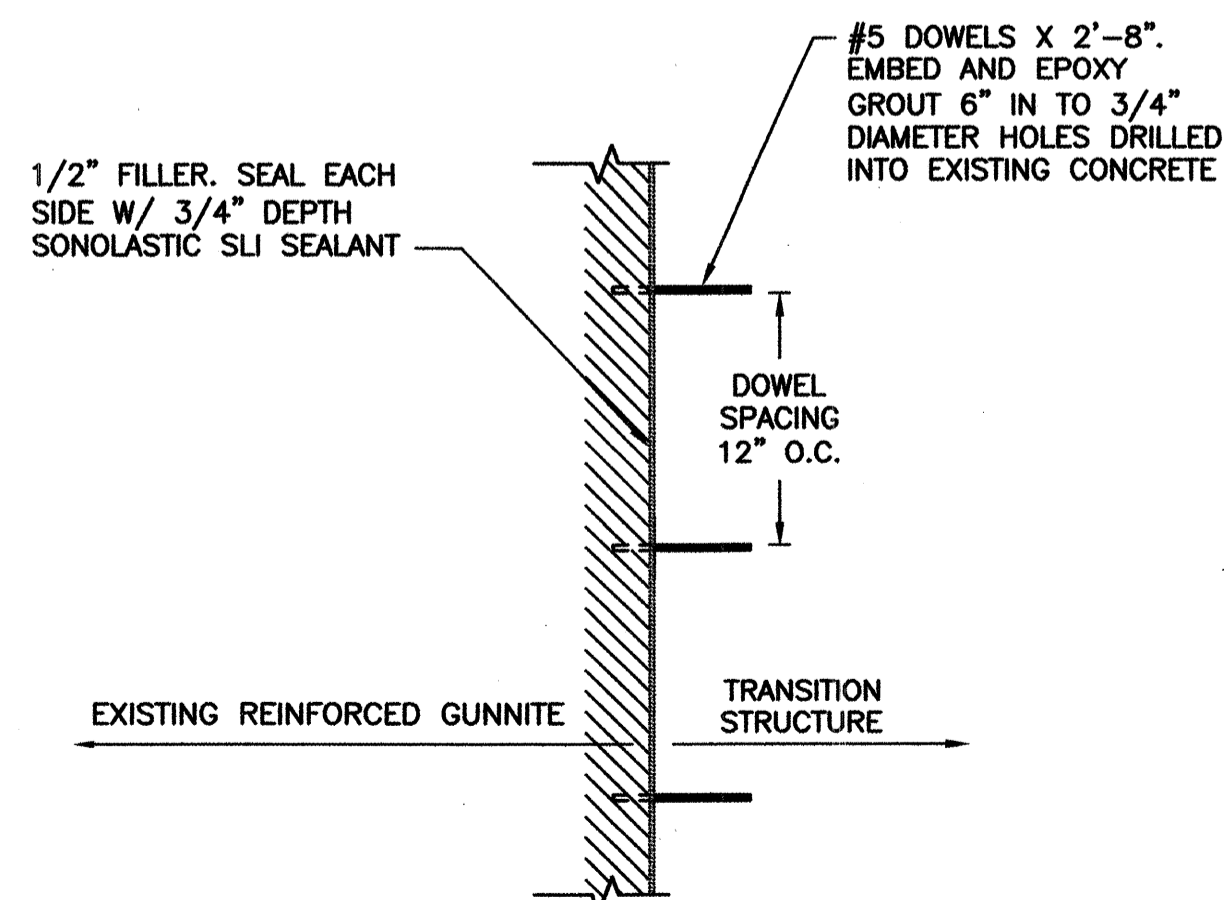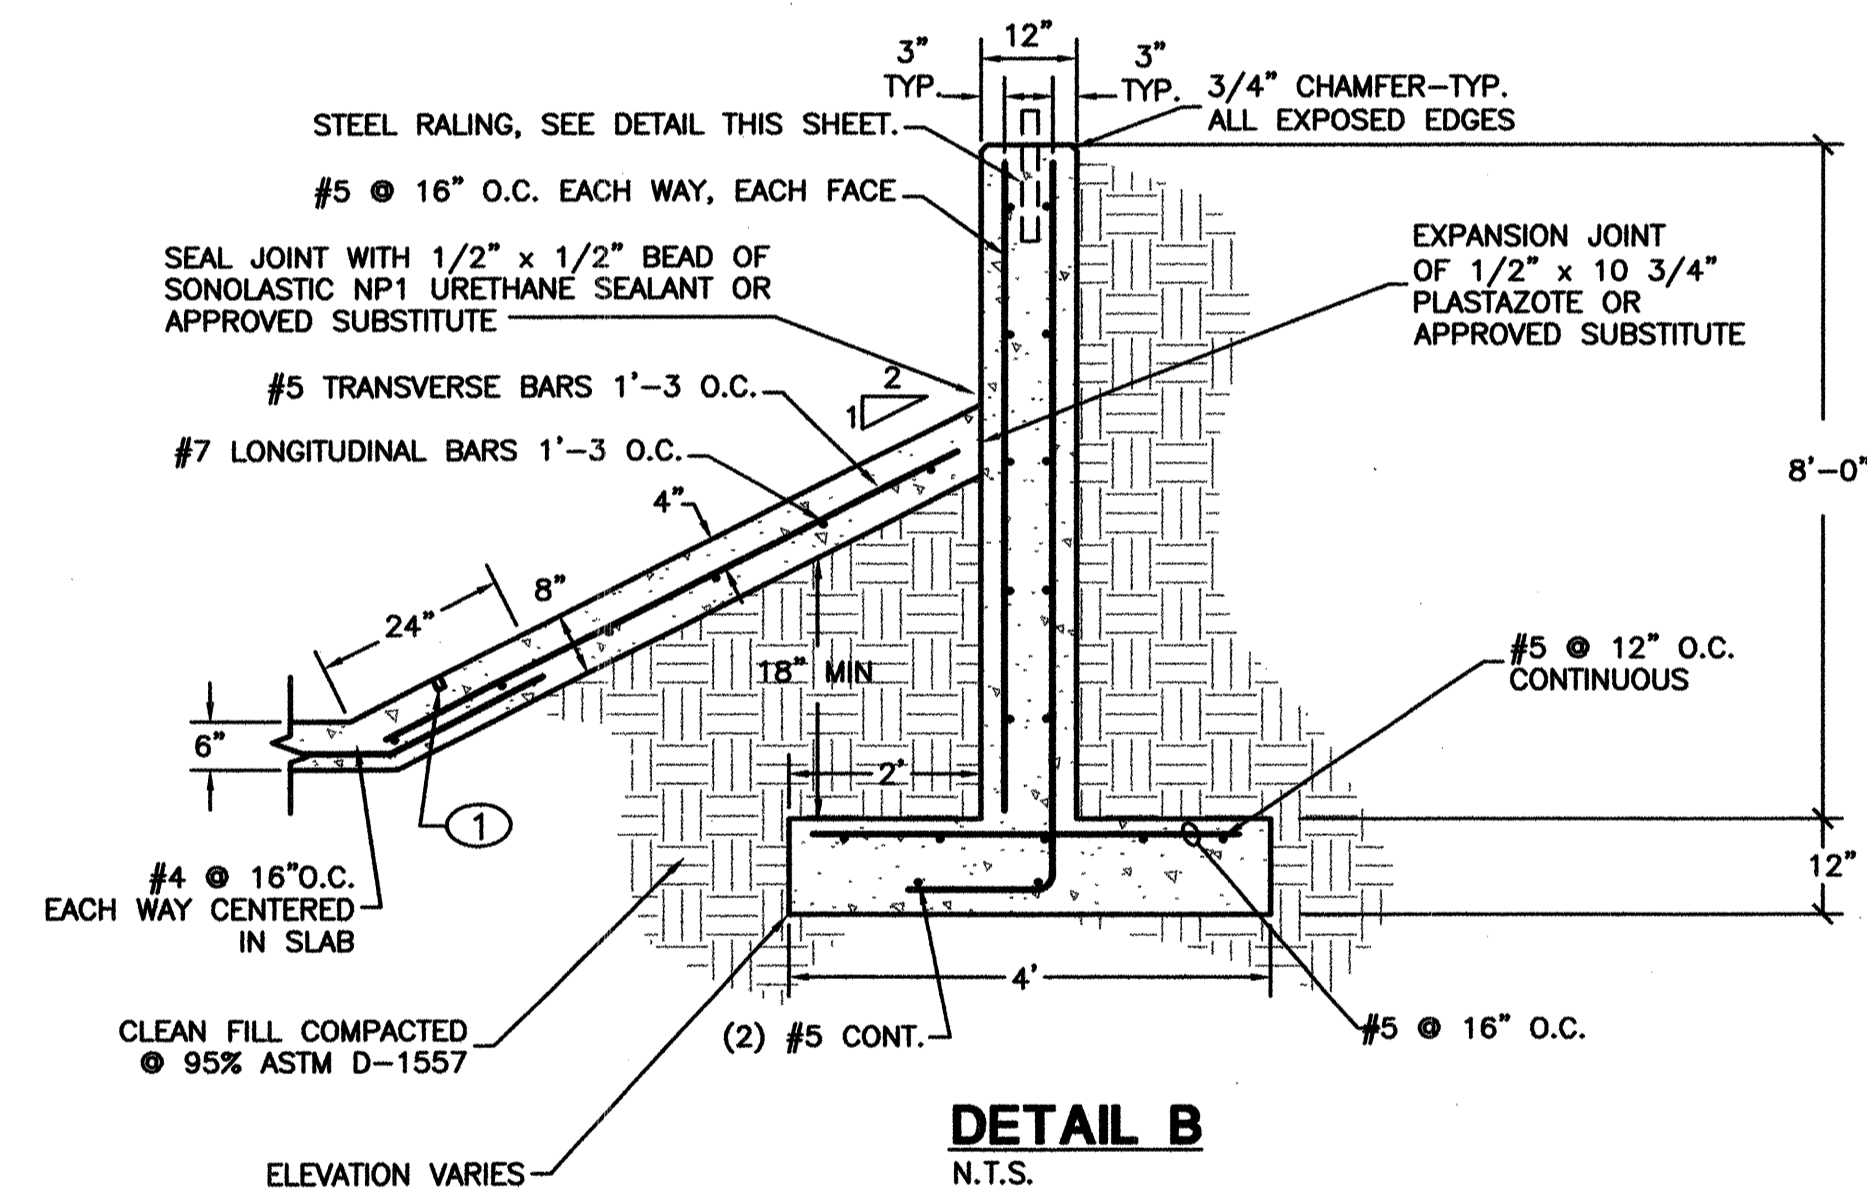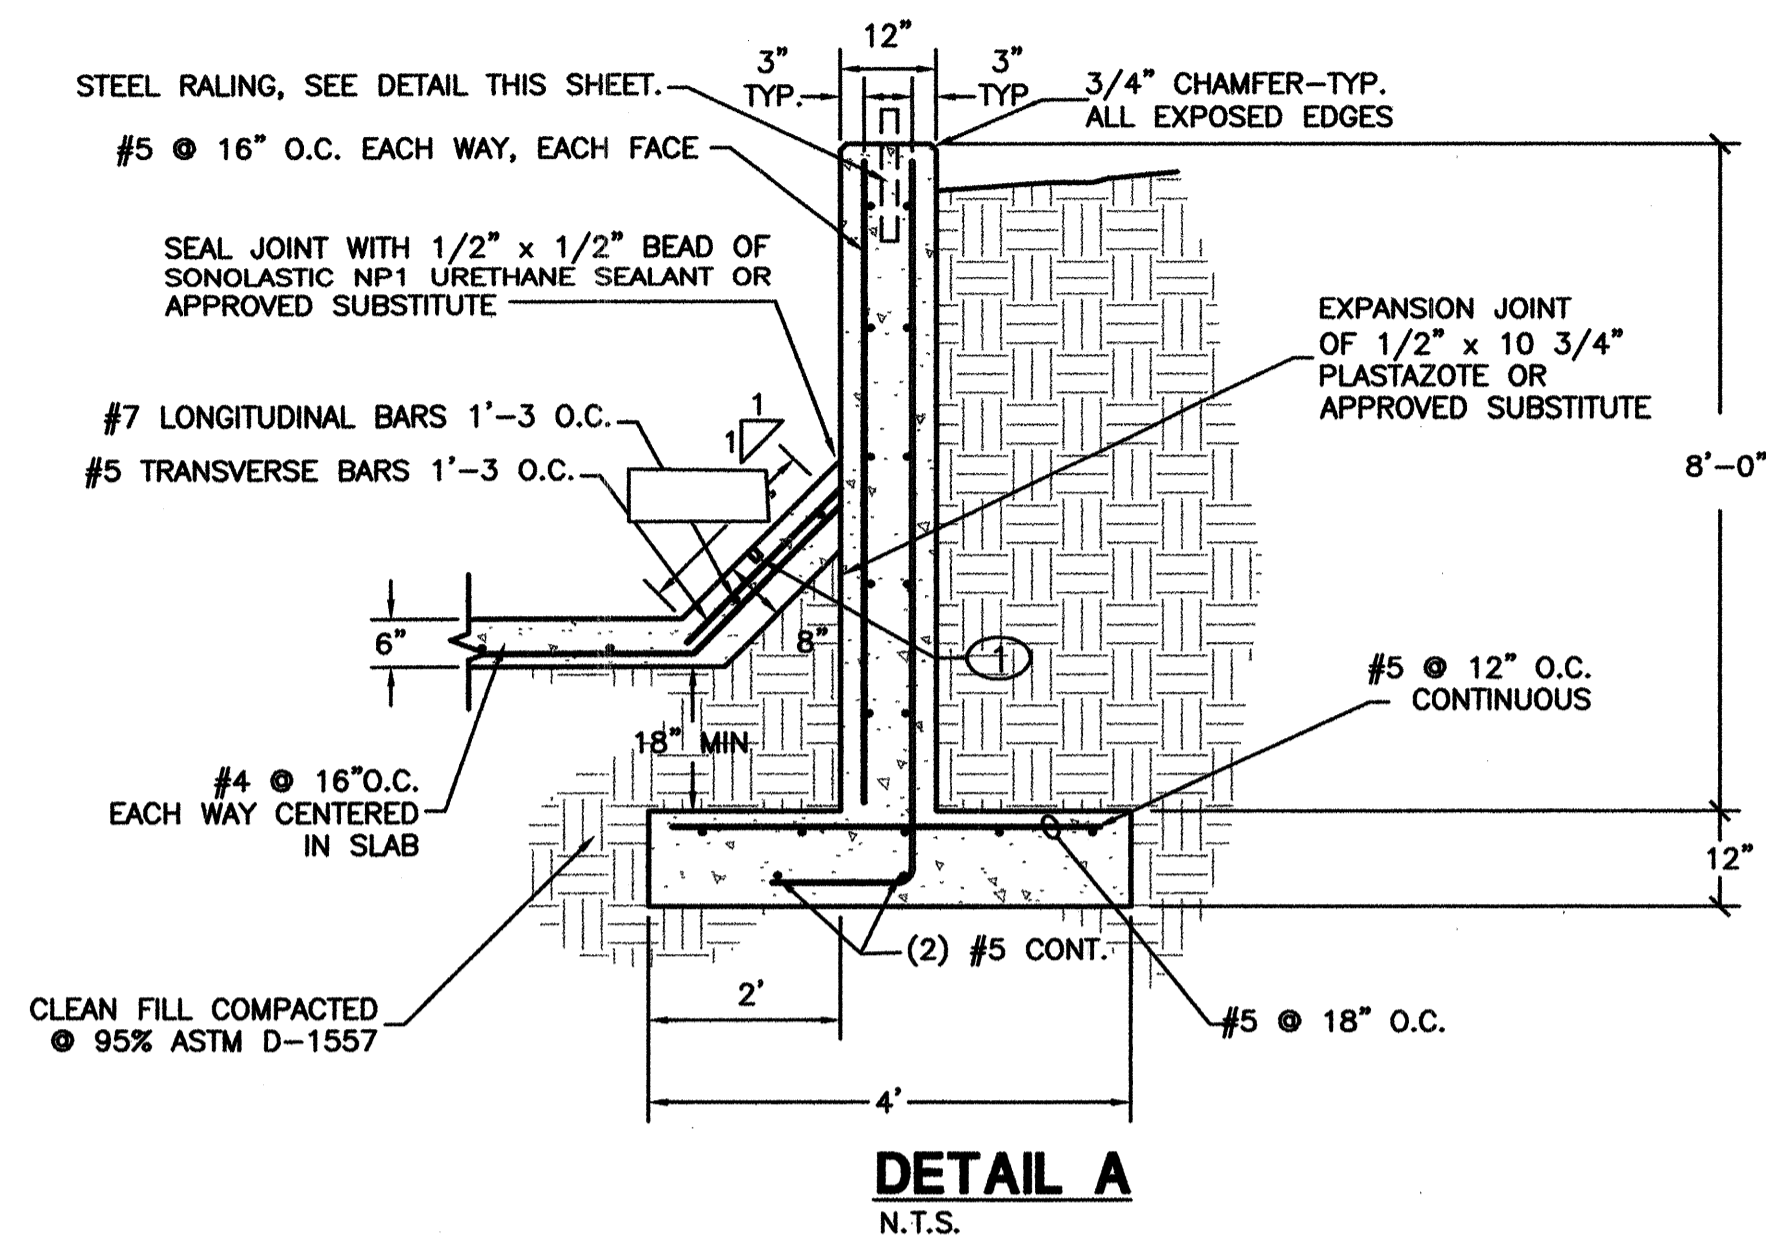

- NOTES:**
1. ALL STEEL FOR RAILING IS 2" ROUND TUBE.
 2. SUBMIT FABRICATION DRAWING OR MANUFACTURER'S CUT SHEET FOR ACCEPTANCE BY COA.
 3. PROVIDE PAINT CHIP COLOR CARD FOR COLOR SELECTION BY COA.

STEEL RAILING DETAIL
N.T.S.

AS-BUILT INFORMATION		ENGINEERS SEAL	
CONTRACTOR	Sells		
WORK SHEET NO.	C.S.		
DATE	3/07	SURVEY INFORMATION	
ACCEPTANCE BY	COA	FIELD NOTES	
DATE	3/07	NO.	
VERIFICATION BY	C.S.	BY	
DATE	3/07	NO.	
CORRECTED BY	SEC	DATE	
DATE	3/07	NO.	
RECORDED BY		DATE	
DATE		NO.	


Smith Engineering Company
102035B
A Full Service Engineering Company
800 San Pedro Blvd., S.E., Ste. 24, Suite 200 Albuquerque, New Mexico 87102

CITY OF ALBUQUERQUE
DEPARTMENT OF MUNICIPAL DEVELOPMENT

TITLE: NORTH DOMINGO BACA PARK
PHASE 4 CONSTRUCTION - BOX CULVERT
TRANSITION STRUCTURE SECTIONS & DETAILS

Design Review Committee	City Engineer Approval
AUG - 4 2005	AUG - 4 2005


City Project No. **7138.92** Zone Map No. **C-19** Sheet **13** Of **14**

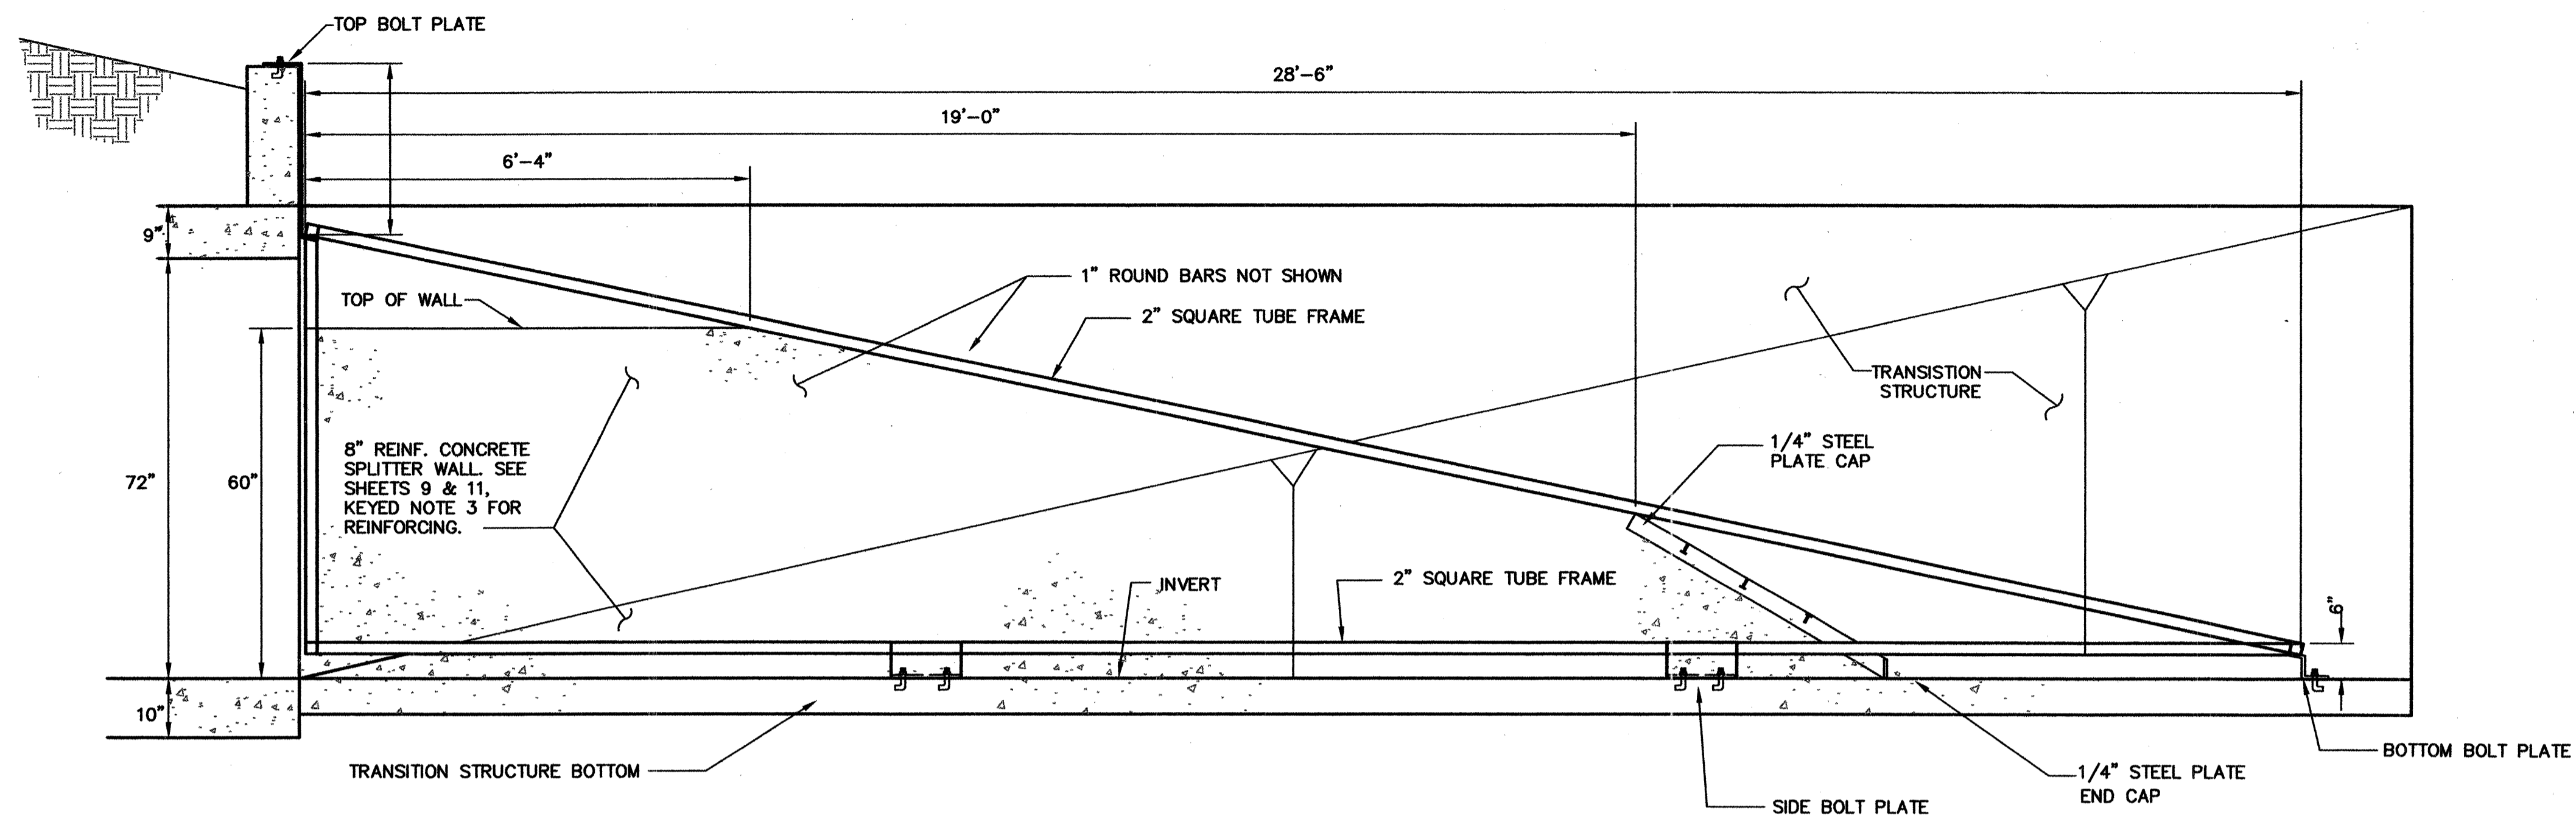

GENERAL NOTES:
 1. THE DETAILS SHOWN ON THIS SHEET ARE FOR INFORMATION ONLY. THE CONTRACTOR MUST PROVIDE DETAILED STRUCTURAL SHOP DRAWINGS FOR ACTUAL GRATE STRUCTURAL DESIGN, FABRICATION AND INSTALLATION.


NOTE: PLACEMENT SHOWN IS FOR UPSTREAM END OF BOX CULVERT. REVERSE PLACEMENT FOR DOWNSTREAM END OF BOX CULVERT.

GRATE PLACEMENT
 SCALE 1:20

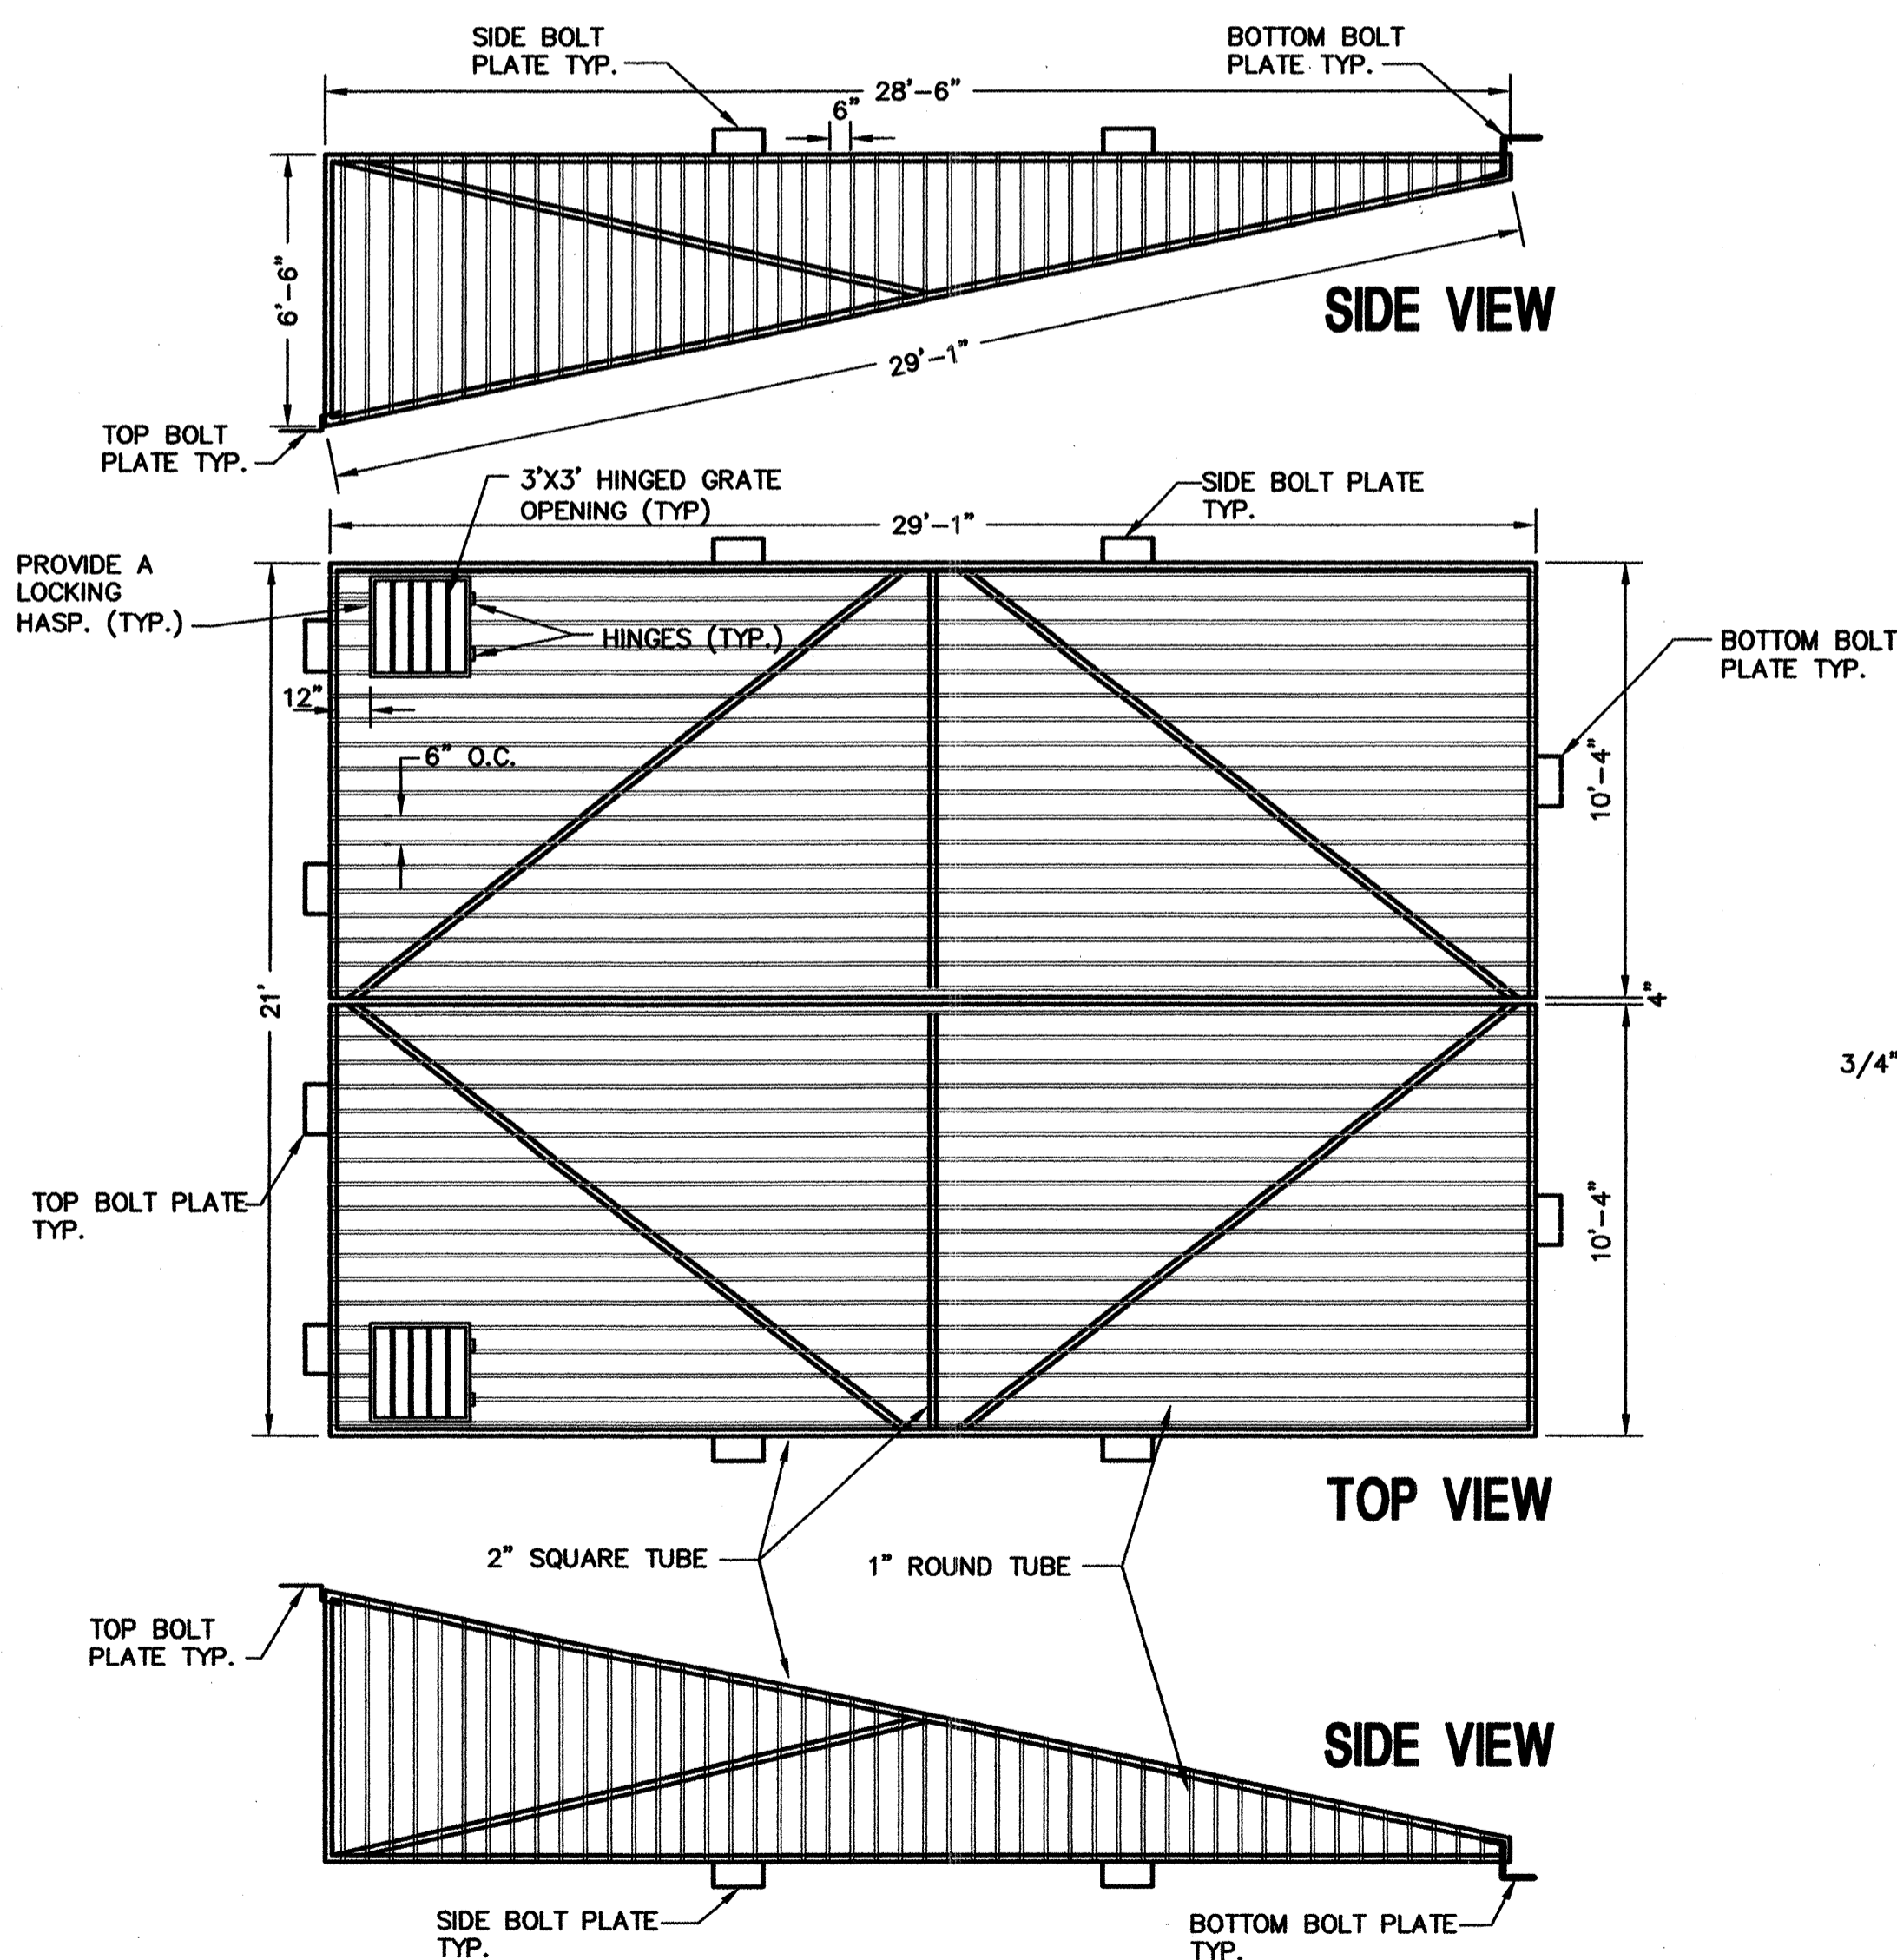



NOTE: FABRICATE GRATE IN TWO PIECES. EACH PIECE CONSISTS ON ONE SIDE PIECE AND ONE-HALF OF THE TOP. (THE TOP VIEW SHOWN ABOVE CONSISTS OF TWO HALVES.)

GRATE DETAIL
 NOT TO SCALE



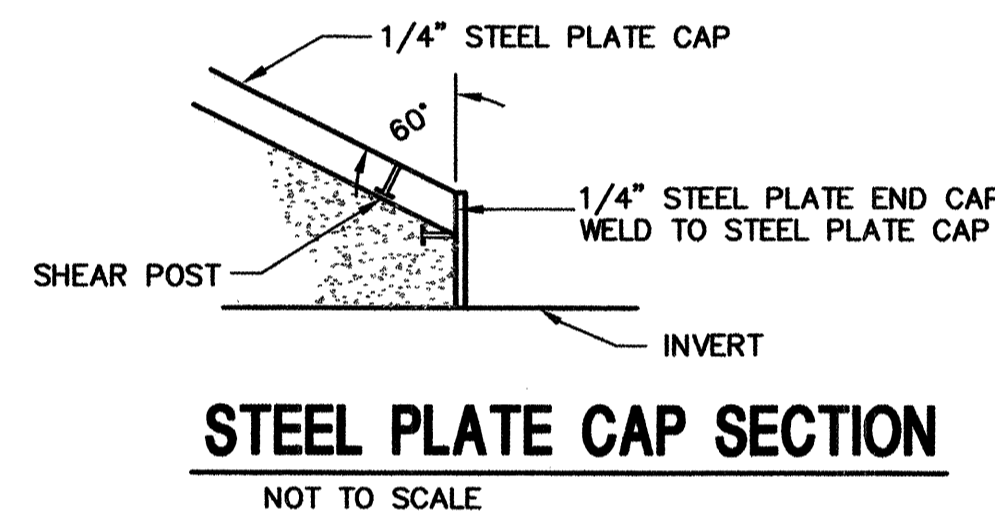


1/2" STEEL PLATE END CAP
 NOT TO SCALE

1/2" STEEL PLATE CAP
 NOT TO SCALE

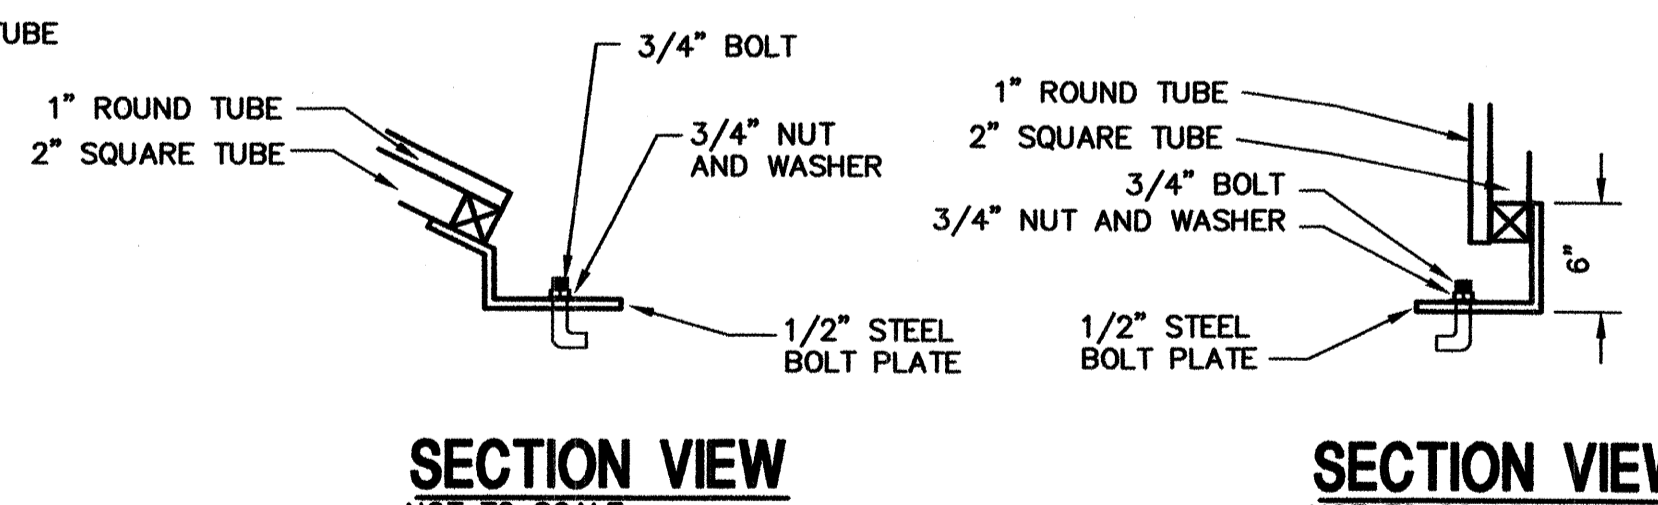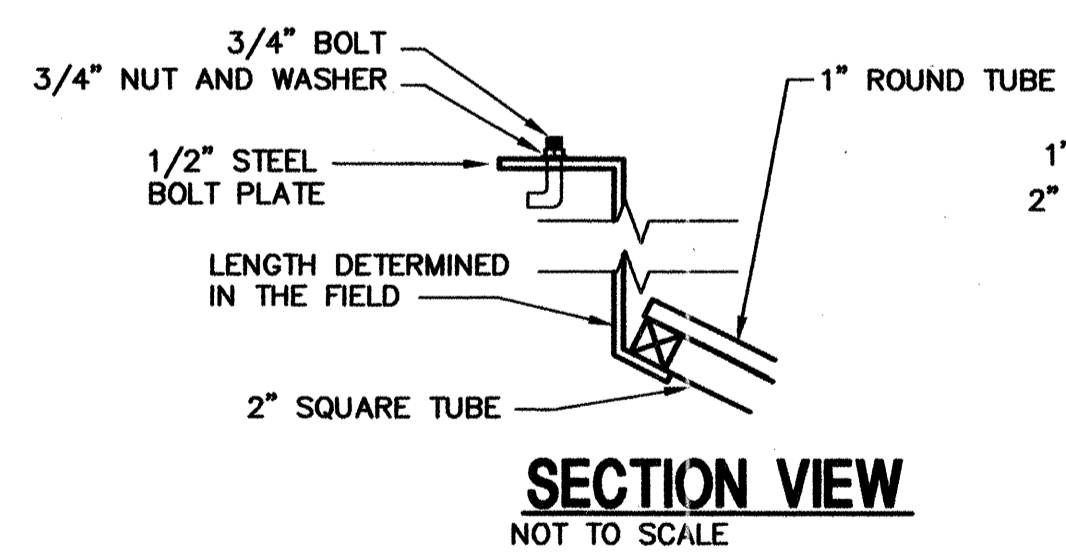

NOTE: WELD BOLT PLATES TO 2" STEEL TUBE FRAME ALONG ALL CONTACT EDGES.

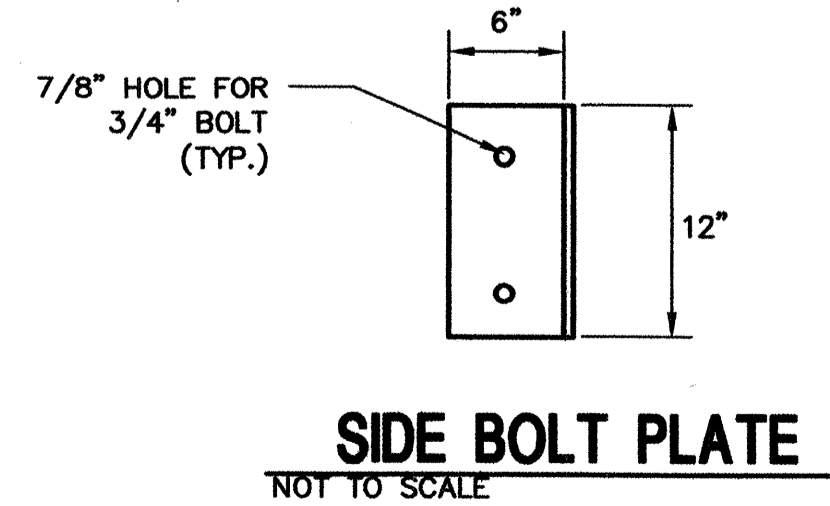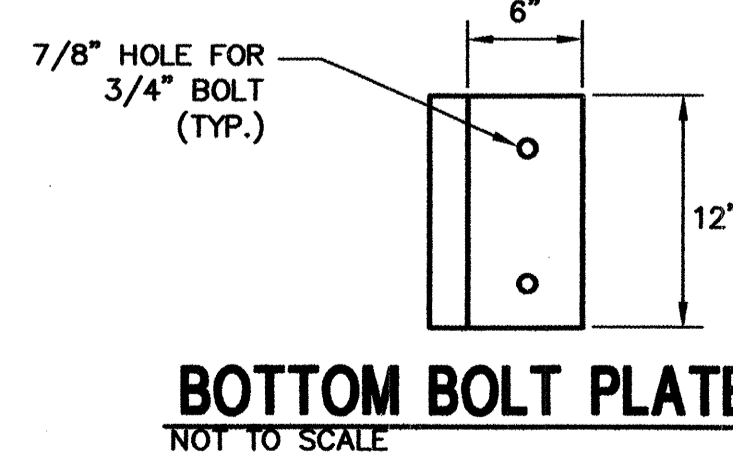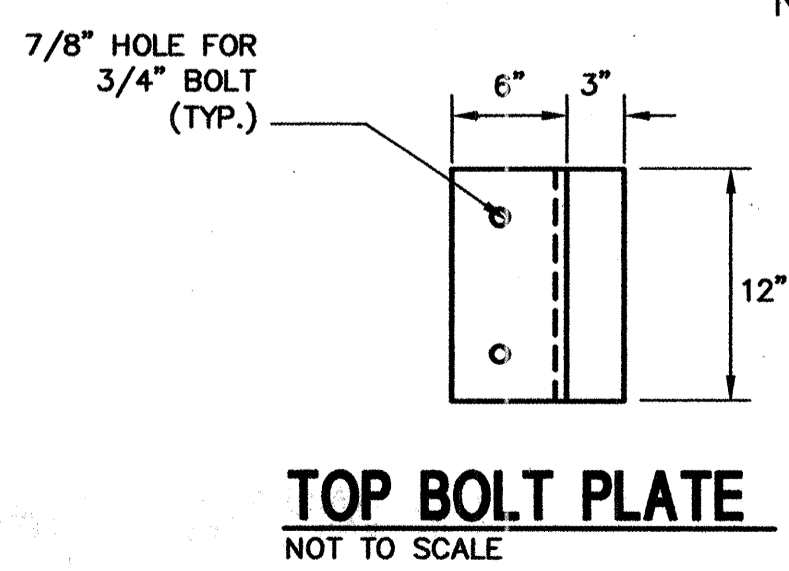

AS-BUILT INFORMATION		CONTRACTOR: Salls, Bro.	DATE: 3/07
WORK BY: CS	DATE: 3/07	FIELD ACCEPTANCE BY: C.O.A.	DATE: 3/07
DESIGNED BY: C.S.	DATE: 3/07	DRAWN BY: SEC.	DATE: 3/07
MICRO-FILM INFORMATION		RECORDED BY:	DATE:
BENCH MARKS		STATION NAME: 1-B20; STATE: NM; COUNTY: BERNALILLO	NO.:
SURVEY INFORMATION		ESTABLISHING AGENCY: ACS STANDARD BRASS CAP	DATE:
FIELD NOTES		IN CONCRETE LOCATED IN THE NORTHEAST QUADRANT OF THE INTERSECTION OF BARSTOW ST. AND MODESTO AVE.	BY:
		SPIRIT LEVEL ELEVATION = 5474.533 FT. (NGVD 29)	NO.:
		PLANE COORDINATES: N = 1524092.46, E = 410237.56	NO.:
ENGINEER'S SEAL			
NO.:	DATE:	REVISIONS	BY:
		DESIGN	GN
		REVISIONS	KSH
		DESIGN	GN
		DATE: JULY 2005	DATE: JULY 2005
		DATE: JULY 2005	DATE: JULY 2005
		DATE: JULY 2005	DATE: JULY 2005

RECORD DRAWING

102035B
Smith Engineering Company
 A Full Service Engineering Company
 2001 San Pedro Boulevard, N.E., Map 64, Suite 200 Albuquerque, New Mexico 87110

CITY OF ALBUQUERQUE
 DEPARTMENT OF MUNICIPAL DEVELOPMENT

TITLE: **NORTH DOMINGO BACA PARK
 PHASE 4 CONSTRUCTION - BOX CULVERT
 STEEL GRATE SECTIONS & DETAILS**

Design Review Committee	City Engineer Approval	No. / Day / Yr.	No. / Day / Yr.
AUG - 4 2005	AUG - 4 2005		
City Project No. 7138.92		Zone Map No. C-19	Sheet 14 Of 14