

# CITY OF ALBUQUERQUE

Planning Department  
Alan Varela, Director



Mayor Timothy M. Keller

August 21, 2025

Nina Villa  
Huitt-Zollars, Inc.  
333 Rio Rancho Drive NE, Suite 101  
Rio Rancho, NM 87124

**RE: North Domingo Baca Aquatic Center  
Grading & Drainage Plan & LOMR  
Engineer's Stamp Date: 5/12/2025  
Hydrology File: C18D043E  
Case # HYDR-2025-00162**

Dear Ms. Villa:

PO Box 1293

Based upon the information provided in your submittal received 08/21/2025, the LOMR Application is approved for submittal to FEMA, the Floodplain Development Permit (FPP# C18F043E) is approved for construction, and the Elevation Certificate is accepted.

Albuquerque

PRIOR TO CERTIFICATE OF OCCUPANCY:

NM 87103

1. Engineer's Certification, per the DPM Part 6-14 (F) : *Engineer's Certification Checklist For Non-Subdivision* is required.
2. A final (as-built) elevation certificate must be submitted and approved by Hydrology prior to issuing approval for Certificate of Occupancy.
3. Approval of the LOMR by FEMA for the map revision.

www.cabq.gov

As a reminder, if the project total area of disturbance (including the staging area and any work within the adjacent Right-of-Way) is 1 acre or more, then an Erosion and Sediment Control (ESC) Plan and Owner's certified Notice of Intent (NOI) is required to be submitted to the Stormwater Quality Engineer (Doug Hughes, PE, [jhughes@cabq.gov](mailto:jhughes@cabq.gov), 924-3420) 14 days prior to any earth disturbance.

If you have any questions, please contact me at 505-924-3314 or [amontoya@cabq.gov](mailto:amontoya@cabq.gov).

Sincerely,

Anthony Montoya, Jr., P.E., C.F.M.  
Senior Engineer, Hydrology  
Planning Department, Development Review Services

# Floodplain Development Permit Application

Planning Dept., City of Albuquerque

## Section 1: General Provisions (Applicant to read and sign)

1. No work of any kind may start in a Special Flood Hazard Area, SFHA, until a permit is issued.
2. Applicant is hereby informed that other permits may be required to fulfill local, state, and federal regulatory requirements.
3. Applicant hereby gives consent to the Floodplain Administrator and his/her representative to make reasonable inspections required to verify compliance.
4. Applicant must provide a Critical Habitat for Threatened & Endangered Species report prior to any work in a SFHA.
5. Applicant must provide the Base Flood Elevation, BFE, and must provide engineering calculations demonstrating that the development will not increase the BFE or result in increased flood risk on any neighboring property.
6. If this application is for a building the floodplain must be removed by first constructing any required storm drain and/or channel modifications and second acquiring a Letter of Map Revision, LOMR, from FEMA before a building permit will be issued. If storm drain and channel modifications are not involved then a draft Elevation Certificate must be submitted prior to Building Permit and a Final Elevation Certificate must be submitted prior to Certificate of Occupancy.
7. A Conditional Letter of Map Revision, CLOMR, is required prior to any work in the FLOODWAY, if applicable.
8. The applicant certifies that all statements herein and in attachments to this application are, to the best of my knowledge, true and accurate.

Applicant Signature *Nina Villa* Date May 13, 2025

Applicant Printed Name Nina Villa, Huitt-Zollars Phone #: 505-892-5141

Owner Signature *JT* Date 8-26-25

Owner Printed Name Jennifer Turner Phone #: 505-768-3830

Applicant is (check one): Owner  Builder  Engineer/Architect

## Section 2: Proposed Development in Special Flood Hazard Area (to be completed by Applicant)

Project address/Legal Disc/Location: North Domingo Baca Aquatic Center

Tract A, Plat of Tract A - North Domingo Park

7521 Carmel Avenue, Albuquerque, NM 87113

**Section 2 (Cont.) - Description of Work in Special Flood Hazard Area (SFHA):**

**A. Building Development and Building Type**

<u>ACTIVITY</u>	<u>STRUCTURE TYPE</u>
<input checked="" type="checkbox"/> New Building	<input type="checkbox"/> Residential (1-4 Family)
<input type="checkbox"/> Addition	<input type="checkbox"/> Residential (More than 4 Family)
<input type="checkbox"/> Alteration	<input checked="" type="checkbox"/> Non Residential (Flood-proofing? <input type="checkbox"/> Yes)
<input type="checkbox"/> Relocation	<input type="checkbox"/> Combined Use (Residential & Commercial)
<input type="checkbox"/> Demolition	<input type="checkbox"/> Manufactured Home (In Mobile Home Park? <input type="checkbox"/> Yes)
<input type="checkbox"/> Replacement	

**If an addition or alteration:**

Estimated Cost of Project \$ 64 Million  
Estimated Value of structure before addition/alteration. \$ 0  
Percent of value (new construction /existing value) 100 %

**B. Other Development Activities**

Clearing       Grading       Utilities       Paving  
 Watercourse Alteration (Bridge or Channel Modification)  
 Drainage Improvements (Storm drain or culverts)  
 Road, Street or Bridge Construction  
 Subdivision  
 Walls or Fences  
 Storage of Materials/Equipment for more than a year. (Materials Volume (cu. Ft.) \_\_\_\_\_)  
Other (Please Specify) \_\_\_\_\_

**Is there a Grading & Drainage Plan associated with this work?** Yes  No

Drainage file Number: C19D043

**Section 3: Floodplain Determination (Completed by the Floodplain Administrator)**

The proposed development is located on FIRM Panel: 0137H and 0141G

The proposed development is located in Zone X and NO FLOODPLAIN DEVELOPMENT PERMIT IS REQUIRED.

A portion of the proposed development is located in a SFHA but not any buildings so an approved G&D Plan is required (Engineer's Stamp Date \_\_\_\_\_) prior to issuance of a Floodplain Development Permit and no Building Permit will be issued for this construction.

A portion of the proposed Building is located in a SFHA but the project does not include any storm drain improvements and/or channel modifications so:

1. Approved G&D Plan is required (Engineer's Stamp Date \_\_\_\_\_) prior to issuance of a Floodplain Development Permit,
2. Draft Elevation Certificate (Date \_\_\_\_\_) is required prior to issuance of a Building Permit, and
3. Final Elevation Certificate and Engineer's Certification is required prior to Certificate of Occupancy.


A portion of the proposed Building is located in a SFHA and the project includes storm drain improvements and/or channel modifications that will change the floodplain location so

1. An Approved Grading and Drainage Plan is required (Engineer's Stamp Date 12/14/23 & 09/18/23) prior to issuing a Flood Plain Development Permit and a Grading Permit and/or a Work Order. HT# C19D043E
2. The improvements must be constructed and an Approved Engineer's Certification (Engineer's Stamp Date 6/24/05) and an Approved LOMR Request (Engineer's Stamp Date 5/12/2025) must be approved by Hydrology prior to approval of the LOMR application to FEMA.
3. The Floodplain must be removed by a LOMR from FEMA (Date N/A) prior to issuance of a Building Permit.

A portion of the proposed development is located in a FLOODWAY so:

1. Approved G&D Plan (Engineer's Stamp Date \_\_\_\_\_) and an Approved CLOMR Request (Date \_\_\_\_\_) is required prior to approval of the application to FEMA, and
2. CLOMR from FEMA (Date \_\_\_\_\_) is required prior to issuance of a Floodplain Development Permit, a Grading Permit, and/or a Work Order.
3. The improvements must be constructed and an Approved Engineer's Certification (Engineer's Stamp Date \_\_\_\_\_) and an Approved LOMR Request (Engineer's Stamp Date \_\_\_\_\_) must be approved by Hydrology prior to approval of the LOMR application to FEMA (Date \_\_\_\_\_).
4. The Floodplain must be removed by a LOMR from FEMA (Date \_\_\_\_\_) prior to issuance of a Building Permit.

Drainage File Number: C19D043E Floodplain Permit Number: C19F043E

Signed:  Date: 8/21/2025

Printed Name: Anthony Montoya, Jr., P.E., C.F.M.

REQUEST FOR LETTER OF MAP REVISION  
NORTH DOMINGO BACA PARK

REQUEST FOR LETTER OF MAP REVISION  
TO FIRM PANEL 35001C0141G & 35001C0137H

PREPARED FOR:



FEMA



PREPARED BY:

HUITT-ZOLIARS

333 RIO RANCHO BLVD., SUITE 101  
RIO RANCHO, NEW MEXICO 87124

MAY 2025

HZI Project R312254.01

City of Albuquerque  
Planning Department  
Development Review Services  
HYDROLOGY SECTION  
**APPROVED**

DATE: 8/21/2025  
BY: *Quetta M. [Signature]*  
HydroTrans # C19D043E

THE APPROVAL OF THESE PLANS/REPORTS SHALL NOT BE CONSTRUED TO PERMIT VIOLATIONS OF ANY CITY ORDINANCE OR STATE LAW, AND SHALL NOT PREVENT THE CITY OF ALBUQUERQUE FROM REQUIRING CORRECTIONS FOR ERRORS OR DIMENSIONS IN PLANS, SPECIFICATIONS, OR CONSTRUCTION DOCUMENTS. SUCH APPROVED PLANS/REPORTS SHALL NOT BE CHANGED, MODIFIED OR ALTERED WITHOUT AUTHORIZATION.

THE APPROVAL OF THESE PLANS/REPORTS SHALL EXPIRE TWO (2) YEARS AFTER THE APPROVAL DATE IF NO BUILDING PERMIT HAS BEEN PULLED ON THE DEVELOPMENT.

## Request for Letter of Map Revision North Domingo Baca Park

*I, Nina Leung-Villa, being first duly sworn upon my oath, state that I am a registered professional engineer, qualified in civil engineering and that the accompanying report was prepared by me or under my supervision and is true and correct to the best of my knowledge and belief.*



*Nina Leung-Villa*  
May 12, 2025

**REQUEST FOR LETTER OF MAP REVISION  
NORTH DOMINGO BACA PARK**

---

**TABLE OF CONTENTS**

	<u>ITEM</u>
Description of the Revision .....	1
FEMA, MT-2 Form 1 .....	2
FEMA, MT-2 Form 2 .....	3
Culvert Analysis (HEC-RAS Output, Upstream Channel) .....	4
National Flood Hazard Layer Firmette (Existing and Proposed) .....	5
References.....	6
NDB Park Phase 4 Construction – Box Culvert Record Drawings .....	7

**Item 1**

**Description of the Revision**

**Item 1. Description of the Revision**

The purpose of the request is to revise the current floodplain mapping for the North Domingo Baca (NDB) Park between Wyoming Blvd NE and Louisiana Blvd NE. The map revision references The FIS report numbered 35001CV001D. This report provides the 1-percent-annual-chance peak discharge for the North Arroyo de Domingo Baca flooding source at Wyoming Boulevard.

The NDB Pool Complex will be the next project to be constructed within the North Domingo Baca development. This will include an indoor and outdoor aquatic center for community engagement. The North Domingo Baca development is currently documented as being within flood zone AO (Depth 1'), however current conditions altered the flood zone and is constrained to a designated area in the development. This report is only providing current conditions in order to update FIRM panels 0141G and 0137H.

The drainage structure that was constructed to direct the stormwater is two 6'x10' box culverts from Wyoming Blvd to the Kinney Dam and acts as the current drainage device that directs the stormwater to the Kinney Dam. Refer to the "Construction Plans for North Domingo Baca Park Phase 4 Construction – Box Culvert", (Smith Engineering, 2005) for culvert details located in Appendix 7. Hydraulic analysis was completed utilizing the HEC-RAS application and indicates the current culvert is efficient and directs the stormwater to Kinney Dam appropriately. The current FEMA flood zone indicates the development is within flood zone AO (Depth 1') and needs to be updated to reflect that the entire development, not including Kinney Dam should not be in a flood zone. See Exhibit 5 for the updated flood zone area (Kinney Dam is the flood zone in the area and will remain zone AE (EL 5320)). For the existing Kinney Dam Design please refer to "Final Design Analysis Report for Lower North Domingo Baca Detention Dam (Resource Technology, Inc., 1995)"

Huitt-Zollars requests that FEMA revise the current Flood Insurance Rate Map of Albuquerque, NM to incorporate and reflect the current flood zone conditions FIRM panels 0141G & 0137H.

**Item 2**

**FEMA MT-2 Form 1  
(OVERVIEW & CONCURRENCE FORM)**

DEPARTMENT OF HOMELAND SECURITY  
Federal Emergency Management Agency  
**OVERVIEW & CONCURRENCE FORM**

OMB Control Number: 1660-0016  
Expiration: 1/31/2024

**PAPERWORK BURDEN DISCLOSURE NOTICE**

Public reporting burden for this form is estimated to average 1 hours per response. The burden estimate includes the time for reviewing instructions, searching existing data sources, gathering and maintaining the needed data, and completing, reviewing, and submitting the form. You are not required to respond to this collection of information unless it displays a valid OMB control number. Send comments regarding the accuracy of the burden estimate and any suggestions for reducing this burden to: Information Collections Management, Department of Homeland Security, Federal Emergency Management Agency, 500 C Street, SW, Washington, DC 20472 , Paperwork Reduction Project (1660-0016). Submission of the form is required to obtain or retain benefits under the National Flood Insurance Program. **Please do not send your completed survey to the above address.**

**PRIVACY ACT STATEMENT**

**AUTHORITY:** The National Flood Insurance Act of 1968, Public Law 90-448, as amended by the Flood Disaster Protection Act of 1973, Public Law 93-234.

**PRINCIPAL PURPOSE(S):** This information is being collected for the purpose of determining an applicant's eligibility to request changes to National Flood Insurance Program (NFIP) Flood Insurance Rate Maps (FIRM).

**ROUTINE USE(S):** The information on this form may be disclosed as generally permitted under 5 U.S.C § 552a(b) of the Privacy Act of 1974, as amended. This includes using this information as necessary and authorized by the routine uses published in DHS/FEMA/NFIP/LOMA-1 National Flood Insurance Program (NFIP); Letter of Map Amendment (LOMA) February 15, 2006, 71 FR 7990.

**DISCLOSURE:** The disclosure of information on this form is voluntary; however, failure to provide the information requested may delay or prevent FEMA from processing a determination regarding a requested change to a (NFIP) Flood Insurance Rate Maps (FIRM).

**A. REQUESTED RESPONSE FROM DHS-FEMA**

This request is for a (check one):

- CLOMR: A letter from DHS-FEMA commenting on whether a proposed project, if built as proposed, would justify a map revision or proposed hydrology changes (See 44 CFR Ch. 1, Parts 60, 65 & 72). All CLOMRs require documentation of compliance with the Endangered Species Act. Refer to the Instructions for details.
- LOMR: A letter from DHS-FEMA officially revising the current NFIP map to show the changes to floodplains, regulatory floodway or flood elevations. (See 44 CFR Ch. 1, Parts 60, 65 & 72).

**B. OVERVIEW**

1. The NFIP map panel(s) affected for all impacted communities is (are):

Community No.	Community Name	State	Map No.	Panel No.	Effective Date
350002	City of Albuquerque	NM	35001C	0137H	8/16/2012
350002	City of Albuquerque	NM	35001C	0141G	9/26/2008

2. a. Flooding Source:

- b. Types of Flooding:  Riverine       Coastal       Shallow Flooding (e.g., Zones AO and AH)  
 Alluvial Fan       Lakes       Other (Attach Description)

3. Project Name/Identifier:

4. FEMA zone designations (choices: A, AH, AO, A1-A30, A99, AE, AR, V, V1-V30, VE, B, C, D, X)

a. Effective:

b. Revised:

5. Basis for Request and Type of Revision:

a. The basis for this revision request is (check all that apply)

- |  |   |   |  |
|--|---|---|--|
| <input checked="" type="checkbox"/> Physical Change      | <input checked="" type="checkbox"/> Improved Methodology/Data | <input type="checkbox"/> Regulatory Floodway Revision | <input checked="" type="checkbox"/> Base Map Changes |
| <input type="checkbox"/> Coastal Analysis                | <input checked="" type="checkbox"/> Hydraulic Analysis        | <input type="checkbox"/> Hydrologic Analysis          | <input type="checkbox"/> Corrections                 |
| <input type="checkbox"/> Weir-Dam Changes                | <input type="checkbox"/> Levee Certification                  | <input type="checkbox"/> Alluvial Fan Analysis        | <input type="checkbox"/> Natural Changes             |
| <input checked="" type="checkbox"/> New Topographic Data | <input type="checkbox"/> Other (Attach Description)           |   |  |

Note: A photograph and narrative description of the area of concern is not required, but is very helpful during review.

b. The area of revision encompasses the following structures (check all that apply)

- Structures:
- |   |  |  |
|---|--|--|
| <input type="checkbox"/> Channelization | <input type="checkbox"/> Levee/Floodwall | <input checked="" type="checkbox"/> Bridge/Culvert             |
| <input type="checkbox"/> Dam            | <input type="checkbox"/> Fill            | <input checked="" type="checkbox"/> Other (Attach Description) |

6.  Documentation of ESA compliance is submitted (required to initiate CLOMR review). Please refer to the instructions for more information.

**C. REVIEW FEE**

Has the review fee for the appropriate request category been included?  Yes      Fee amount: \$ \_\_\_\_\_  
 No, Attach Explanation


- Please see the DHS-FEMA Web site at <http://www.fema.gov/forms-documents-and-software/flood-map-related-fees> for Fee Amounts and Exemptions.

**D. SIGNATURES**

**1. REQUESTOR'S SIGNATURE**


All documents submitted in support of this request are correct to the best of my knowledge. I understand that any false statement may be punishable by fine or imprisonment under Title 18 of the United States Code, Section 1001.

Name: Nina Leung-Villa	Company: Huitt-Zollars, Inc.	
Mailing Address: 333 Rio Rancho Drive NE, Suite 101 Rio Rancho, NM 87124	Daytime Telephone: 505-264-8249	Fax No.:
	E-mail Address: nvilla@huitt-zollars.com	
	Date: May 12, 2025	

Signature of Requestor (required): 

**2. COMMUNITY CONCURRENCE**

As the community official responsible for floodplain management, I hereby acknowledge that we have received and reviewed this Letter of Map Revision (LOMR) or conditional LOMR request. Based upon the community's review, we find the completed or proposed project meets or is designed to meet all of the community floodplain management requirements, including the requirements for when fill is placed in the regulatory floodway, and that all necessary Federal, State, and local permits have been, or in the case of a conditional LOMR, will be obtained. For Conditional LOMR requests, the applicant has documented Endangered Species Act (ESA) compliance to FEMA prior to FEMA's review of the Conditional LOMR application. For LOMR requests, I acknowledge that compliance with Sections 9 and 10 of the ESA has been achieved independently of FEMA's process. For actions authorized, funded, or being carried out by Federal or State agencies, documentation from the agency showing its compliance with Section 7(a)(2) of the ESA will be submitted. In addition, we have determined that the land and any existing or proposed structures to be removed from the SFHA are or will be reasonably safe from flooding as defined in 44CFR 65.2(c), and that we have available upon request by FEMA, all analyses and documentation used to make this determination.

Community Official's Name and Title: Anthony Montoya, Jr., P.E., C.F.M., Senior Engineer		
Mailing Address: PO Box 1293 Albuquerque, NM 87103	Community Name: City of Albuquerque	
	Daytime Telephone: 505-924-3314	Fax No.:
	E-mail Address: amontoya@cabq.gov	
Community Official's Signature (required): 		Date: 8/21/2025

**3. CERTIFICATION BY REGISTERED PROFESSIONAL ENGINEER AND/OR LAND SURVEYOR**

This certification is to be signed and sealed by a licensed land surveyor, registered professional engineer, or architect authorized by law to certify elevation information data, hydrologic and hydraulic analysis, and any other supporting information as per NFIP regulations paragraph 65.2(b) and as described in the MT-2 Forms Instructions. All documents submitted in support of this request are correct to the best of my knowledge. I understand that any false statement may be punishable by fine or imprisonment under Title 18 of the United States Code, Section 1001.

Certifier's Name: Nina Leung-Villa		License No.: 25970	Expiration Date: 12-31-26
Company Name: Huitt-Zollars		Mailing Address: 333 Rio Rancho Dr. NE Rio Rancho, NM 87124	
Telephone No.: 505-892-5141	Fax No.:		
E-mail Address: nvilla@huitt-zollars.com			

Signature: *Nina Leung-Villa* Date: May 12, 2025

**Ensure the forms that are appropriate to your revision request are included in your submittal.**

**Form Name and (Number)**

**Required if ...**

- |  |   |
|--|---|
| <input type="checkbox"/> Riverine Hydrology and Hydraulics Form (Form 2) | New or revised discharges or water-surface elevations   |
| <input type="checkbox"/> Riverine Structures Form (Form 3)               | Channel is modified, addition/revision of bridge/culverts, addition/revision of levee/floodwall, addition/revision of dam |
| <input type="checkbox"/> Coastal Analysis Form (Form 4)                  | New or revised coastal elevations   |
| <input type="checkbox"/> Coastal Structures Form (Form 5)                | Addition/revision of coastal structure  |
| <input type="checkbox"/> Alluvial Fan Flooding Form (Form 6)             | Flood control measures on alluvial fans   |



**Item 3**

**FEMA MT-2 Form 2  
(RIVERINE HYDROLOGY & HYDRAULICS)**

DEPARTMENT OF HOMELAND SECURITY  
Federal Emergency Management Agency  
**RIVERINE HYDROLOGY & HYDRAULICS FORM (FORM 2)**

OMB Control Number: 1660-0016  
Expiration: 1/31/2024

**PAPERWORK BURDEN DISCLOSURE NOTICE**

Public reporting burden for this form is estimated to average 3.5 hours per response. The burden estimate includes the time for reviewing instructions, searching existing data sources, gathering and maintaining the needed data, and completing, reviewing, and submitting the form. You are not required to respond to this collection of information unless it displays a valid OMB control number. Send comments regarding the accuracy of the burden estimate and any suggestions for reducing this burden to: Information Collections Management, Department of Homeland Security, Federal Emergency Management Agency, 500 C Street, SW, Washington, DC 20472, Paperwork Reduction Project (1660-0016). Submission of the form is required to obtain or retain benefits under the National Flood Insurance Program. **Please do not send your completed survey to the above address.**

**PRIVACY ACT STATEMENT**

**AUTHORITY:** The National Flood Insurance Act of 1968, Public Law 90-448, as amended by the Flood Disaster Protection Act of 1973, Public Law 93-234.

**PRINCIPAL PURPOSE(S):** This information is being collected for the purpose of determining an applicant's eligibility to request changes to National Flood Insurance Program (NFIP) Flood Insurance Rate Maps (FIRM).

**ROUTINE USE(S):** The information on this form may be disclosed as generally permitted under 5 U.S.C § 552a(b) of the Privacy Act of 1974, as amended. This includes using this information as necessary and authorized by the routine uses published in DHS/FEMA/NFIP/LOMA-1 National Flood Insurance Program (NFIP); Letter of Map Amendment (LOMA) February 15, 2006, 71 FR 7990.

**DISCLOSURE:** The disclosure of information on this form is voluntary; however, failure to provide the information requested may delay or prevent FEMA from processing a determination regarding a requested change to a (NFIP) Flood Insurance Rate Maps (FIRM).

Flooding Source: North Arroyo de Domingo Baca

**A. HYDROLOGY**

1. Reason for New Hydrologic Analysis (check all that apply):

- Not revised (skip to section B)    
  No existing analysis    
  Improved data  
 Alternative methodology    
  Proposed Conditions (CLOMR)    
  Changed physical condition of watershed

2. Comparison of Representative 1%-Annual-Chance Discharges

Location	Drainage Area (Sq. Mi.)	Effective/FIS (cfs)	Revised (cfs)
----------	-------------------------	---------------------	---------------

3. Methodology for New Hydrologic Analysis (check all that apply)

- Precipitation/Runoff Model → Specify Model: \_\_\_\_\_ Duration: \_\_\_\_\_ Rainfall Amount: \_\_\_\_\_  
 Statistical Analysis of Gage Records  
 Regional Regression Equations    
  Other (please attach description)

Please enclose all relevant models in digital format, maps, computations (including computation of parameters), and documentation to support the new analysis.

4. Review/Approval of Analysis

If your community requires a regional, state, or federal agency to review the hydrologic analysis, please attach evidence of approval/review.     4. HEC-RAS File Description\*\*:

5. Impacts of Sediment Transport on Hydrology

Is the hydrology for the revised flooding source(s) affected by sediment transport?      Yes      No

If yes, then fill out Section F (Sediment Transport) of Form 3. If No, then attach your explanation.

**B. HYDRAULICS**

1. Reach to be Revised

	Description	Cross Section	Water-Surface Elevation (ft.)	
			Effective	Proposed/Revised
Downstream Limit*	Kinney Dam		5320	5320

\*Proposed/Revised elevations must tie-into the Effective elevations within 0.5 foot at the downstream and upstream limits of revision.

2. Hydraulic Method/Model Used: HEC-RAS

Steady State     Unsteady State     One-Dimensional     Two-Dimensional

3. Pre-Submittal Review of Hydraulic Models\*

DHS-FEMA has developed two review programs, CHECK-2 and CHECK-RAS, to aid in the review of HEC-2 and HEC-RAS hydraulic models, respectively. We recommend that you review your HEC-2 and HEC-RAS models with CHECK-2 and CHECK-RAS.

4. HEC-RAS File Description\*\*:

Models Submitted	Natural Run		Floodway Run		Datum
Duplicate Effective Model*	File Name:	Plan Name:	File Name:	Plan Name:	
NONE					
Corrected Effective Model*	File Name:	Plan Name:	File Name:	Plan Name:	
NONE					
Existing or Pre-Project Conditions Model	File Name:	Plan Name:	File Name:	Plan Name:	
North Arroyo de Domingo Baca			North Arroyo de Domingo Baca	Plan 03	
Revised or Post-Project Conditions Model	File Name:	Plan Name:	File Name:	Plan Name:	
NONE					
Other - (attach description)	File Name:	Plan Name:	File Name:	Plan Name:	
NONE					

\* For details, refer to the corresponding section of the instructions.

\*\*See instructions for information about modeling other than HEC-RAS.  Digital Models Submitted? (Required)

**C. MAPPING REQUIREMENTS**

A **certified topographic work map** must be submitted showing the following information (where applicable): the boundaries of the effective, existing, and proposed conditions 1%-annual-chance floodplain (for approximate Zone A revisions) or the boundaries of the 1%- and 0.2%-annual-chance floodplains and regulatory floodway (for detailed Zone AE, AO, and AH revisions); location and alignment of all cross sections with stationing control indicated; stream, road, and other alignments (e.g., dams, levees, etc.); current community easements and boundaries; boundaries of the requester's property; certification of a registered professional engineer registered in the subject State; location and description of reference marks; and the referenced vertical datum (NGVD, NAVD, etc.).

Topographic Information:     Digital Mapping (GIS/CADD) Data Submitted (preferred)

Source:    SURVEY - NDB\_PARK TOPO & NDB\_CHANNEL\_TOPO    Date:    12/6/2024

Vertical Datum:    NAVD 1988    Spatial Projection:    New Mexico State Plane

Accuracy:

Note that the boundaries of the existing or proposed conditions floodplains and regulatory floodway to be shown on the revised FIRM and/or FBFM must tie-in with the effective floodplain and regulatory floodway boundaries. Please attach a **copy of the effective FIRM and/or FBFM**, at the same scale as the original, annotated to show the boundaries of the revised 1%-and 0.2%-annual-chance floodplains and regulatory floodway that tie-in with the boundaries of the effective 1%-and 0.2%-annual-chance floodplain and regulatory floodway at the upstream and downstream limits of the area on revision.

Annotated FIRM and/or FBFM (Required)

**D. COMMON REGULATORY REQUIREMENTS\***

1. For LOMR/CLOMR requests, do Base Flood Elevations (BFEs) or Special Flood Hazard Areas (SFHAs) increase compared to the effective BFEs?  Yes  No
- If Yes, please attach **proof of property owner notification**. Examples of property owner notifications can be found in the MT-2 Form 2 Instructions.
2. For CLOMR requests, if either of the following is true, please submit **evidence of compliance with Section 65.12 of the NFIP regulations**:
- The proposed project encroaches upon a regulatory floodway and would result in increases above 0.00 foot compared to pre-project conditions.
  - The proposed project encroaches upon a SFHA with or without BFEs established and would result in increases above 1.00 foot compared to pre-project conditions.
3. Does the request involve the placement or proposed placement of fill?  Yes  No
- If Yes, the community must be able to certify that the area to be removed from the special flood hazard area, to include any structures or proposed structures, meets all of the standards of the local floodplain ordinances, and is reasonably safe from flooding in accordance with the NFIP regulations set forth at 44 CFR 60.3(A)(3), 65.5(a)(4), and 65.6(a)(14). Please see the MT-2 instructions for more information.
4. Does the request involve the placement or proposed placement of fill?  Yes  No
- If Yes, attach **evidence of regulatory floodway revision notification**. As per Paragraph 65.7(b)(1) of the NFIP Regulations, notification is required for requests involving revisions to the regulatory floodway Elements and examples of regulatory floodway revision notification can be found in the MT-2 Form 2 Instructions.
5. For CLOMR requests, please submit documentation to FEMA and the community to show that you have complied with Sections 9 and 10 of the Endangered Species Act (ESA). For actions authorized, funded, or being carried out by Federal or State agencies, please submit documentation from the agency showing its compliance with Section 7(a)(2) of the ESA. Please see the MT-2 instructions for more detail.

**Item 4**

**Culvert Analysis  
(HEC-RAS, North Arroyo de Domingo Baca)**

**Existing Pond Survey  
&  
Upstream North Domingo Baca Survey**

#### **Item 4. HEC-RAS, North Arroyo de Domingo Baca**

HEC-RAS:

Version: 6.5 Date: 01Feb2024

The analysis for the culvert design utilizes HEC-RAS to assure the design is adequate to handle the peak flow. The culvert cross section was determined by way of new survey. The survey verified that the culvert is two 10' x 6' CBC's located between Wyoming Boulevard and the Kinney Dam entry opening. The cross-section dimensions will be held through the culvert beginning at the Wyoming location down to the outfall into Kinney Dam pond. See the HEC-RAS report for more details.

The peak flow was obtained from the existing Flood Insurance Study, Volume 1 of 2 for the Bernalillo County and Incorporated Areas. The indicated flow for the 1-Percent-Annual-Chance is 658 CFS at Wyoming Boulevard. The peak flow maintains an elevation that is lower than the top of the culvert and will efficiently be directed towards Kinney Dam. These results indicate that the culvert is currently functioning as a sustainable drainage device.

HEC-RAS HEC-RAS 6.5 February 2024  
 U.S. Army Corps of Engineers  
 Hydrologic Engineering Center  
 609 Second Street  
 Davis, California

```

X   X XXXXXX   XXXX   XXXX   XX   XXXX
X   X X       X  X   X  X   X  X   X
X   X X       X     X  X   X  X   X
XXXXXXXX XXXX   X     XXX XXXX XXXXXX XXXX
X   X X       X     X  X   X  X   X
X   X X       X  X   X  X   X  X   X
X   X XXXXXX   XXXX   X  X   X  X   XXXXX
  
```

PROJECT DATA

Project Title: North Arroyo de Domingo Baca  
 Project File : NorthArroyodeDom.prj  
 Run Date and Time: 12/9/2024 11:48:04 AM

Project in English units

PLAN DATA

Plan Title: Plan 03  
 Plan File : h:\Transfer\Corie\NorthArroyodeDom.p03

Geometry Title: NORTH DOMINGO BACA  
 Geometry File : h:\Transfer\Corie\NorthArroyodeDom.g02

Flow Title : NDB Flow  
 Flow File : h:\Transfer\Corie\Aquatic Center\HEC-RAS\NorthArroyodeDom.f12

Plan Summary Information:

Number of: Cross Sections = 4 Multiple Openings = 0  
 Culverts = 1 Inline Structures = 0  
 Bridges = 0 Lateral Structures = 0

Computational Information

Water surface calculation tolerance = 0.01  
 Critical depth calculation tolerance = 0.01  
 Maximum number of iterations = 20  
 Maximum difference tolerance = 0.3  
 Flow tolerance factor = 0.001

Computation Options

Critical depth computed only where necessary  
 Conveyance Calculation Method: At breaks in n values only  
 Friction Slope Method: Average Conveyance  
 Computational Flow Regime: Subcritical Flow

FLOW DATA

Flow Title: NDB Flow  
 Flow File : h:\Transfer\Corie\Aquatic Center\HEC-RAS\NorthArroyodeDom.f12

Flow Data (cfs)

River	Reach	RS	PF 1
NDB	1	1900	658

Boundary Conditions

River	Reach	Profile	Upstream	Downstream
NDB	1	PF 1	Normal S = 0.025	Known WS = 5320

CROSS SECTION

RIVER: NDB  
 REACH: 1 RS: 1900

CROSS SECTION OUTPUT Profile #PF 1

E.G. Elev (ft)	5385.14	Element	Left OB	Channel	Right OB
Vel Head (ft)	0.42	Wt. n-Val.		0.013	
W.S. Elev (ft)	5384.72	Reach Len. (ft)	10.00	10.00	10.00
Crit W.S. (ft)		Flow Area (sq ft)		126.13	
E.G. Slope (ft/ft)	0.000382	Area (sq ft)		126.13	
Q Total (cfs)	658.00	Flow (cfs)		658.00	
Top Width (ft)	31.44	Top Width (ft)		31.44	
Vel Total (ft/s)	5.22	Avg. Vel. (ft/s)		5.22	
Max Chl Dpth (ft)	4.72	Hydr. Depth (ft)		4.01	
Conv. Total (cfs)	33660.6	Conv. (cfs)		33660.6	
Length Wtd. (ft)	10.00	Wetted Per. (ft)		35.35	
Min Ch El (ft)	5380.00	Shear (lb/sq ft)		0.09	
Alpha	1.00	Stream Power (lb/ft s)		0.44	
Frctn Loss (ft)	0.00	Cum Volume (acre-ft)		1.04	
C & E Loss (ft)	0.01	Cum SA (acres)		1.37	

Profile #PF 1

	Pos	Left Sta (ft)	Right Sta (ft)	Flow (cfs)	Area (sq ft)	W.P. (ft)	Percent Conv	Hydr Depth(ft)	Velocity (ft/s)	Shear (lb/sq ft)	Power (lb/ft s)
1	Chan	0.00	6.80	48.88	14.92	7.48	7.43	2.70	3.28	0.05	0.16
2	Chan	6.80	13.60	186.75	32.10	6.80	28.38	4.72	5.82	0.11	0.66
3	Chan	13.60	20.40	186.75	32.10	6.80	28.38	4.72	5.82	0.11	0.66
4	Chan	20.40	27.20	186.74	32.10	6.80	28.38	4.72	5.82	0.11	0.66
5	Chan	27.20	34.00	48.88	14.92	7.48	7.43	2.70	3.28	0.05	0.16

CROSS SECTION


RIVER: NDB  
 REACH: 1 RS: 1890

CROSS SECTION OUTPUT Profile #PF 1

E.G. Elev (ft)	5385.13	Element	Left OB	Channel	Right OB
Vel Head (ft)	0.38	Wt. n-Val.		0.013	
W.S. Elev (ft)	5384.75	Reach Len. (ft)	1880.00	1880.00	1880.00
Crit W.S. (ft)	5382.69	Flow Area (sq ft)		133.33	
E.G. Slope (ft/ft)	0.000325	Area (sq ft)		133.33	
Q Total (cfs)	658.00	Flow (cfs)		658.00	
Top Width (ft)	31.90	Top Width (ft)		31.90	
Vel Total (ft/s)	4.94	Avg. Vel. (ft/s)		4.94	
Max Chl Dpth (ft)	4.95	Hydr. Depth (ft)		4.18	
Conv. Total (cfs)	36484.9	Conv. (cfs)		36484.9	
Length Wtd. (ft)	1880.00	Wetted Per. (ft)		35.99	
Min Ch El (ft)	5379.80	Shear (lb/sq ft)		0.08	
Alpha	1.00	Stream Power (lb/ft s)		0.37	
Frctn Loss (ft)		Cum Volume (acre-ft)		1.01	
C & E Loss (ft)		Cum SA (acres)		1.36	

Profile #PF 1

	Pos	Left Sta (ft)	Right Sta (ft)	Flow (cfs)	Area (sq ft)	W.P. (ft)	Percent Conv	Hydr Depth(ft)	Velocity (ft/s)	Shear (lb/sq ft)	Power (lb/ft s)
1	Chan	0.00	6.80	50.18	16.20	7.80	7.63	2.82	3.10	0.04	0.13
2	Chan	6.80	13.60	185.88	33.64	6.80	28.25	4.95	5.52	0.10	0.56
3	Chan	13.60	20.40	185.88	33.64	6.80	28.25	4.95	5.52	0.10	0.56
4	Chan	20.40	27.20	185.88	33.64	6.80	28.25	4.95	5.52	0.10	0.56
5	Chan	27.20	34.00	50.18	16.20	7.80	7.63	2.82	3.10	0.04	0.13

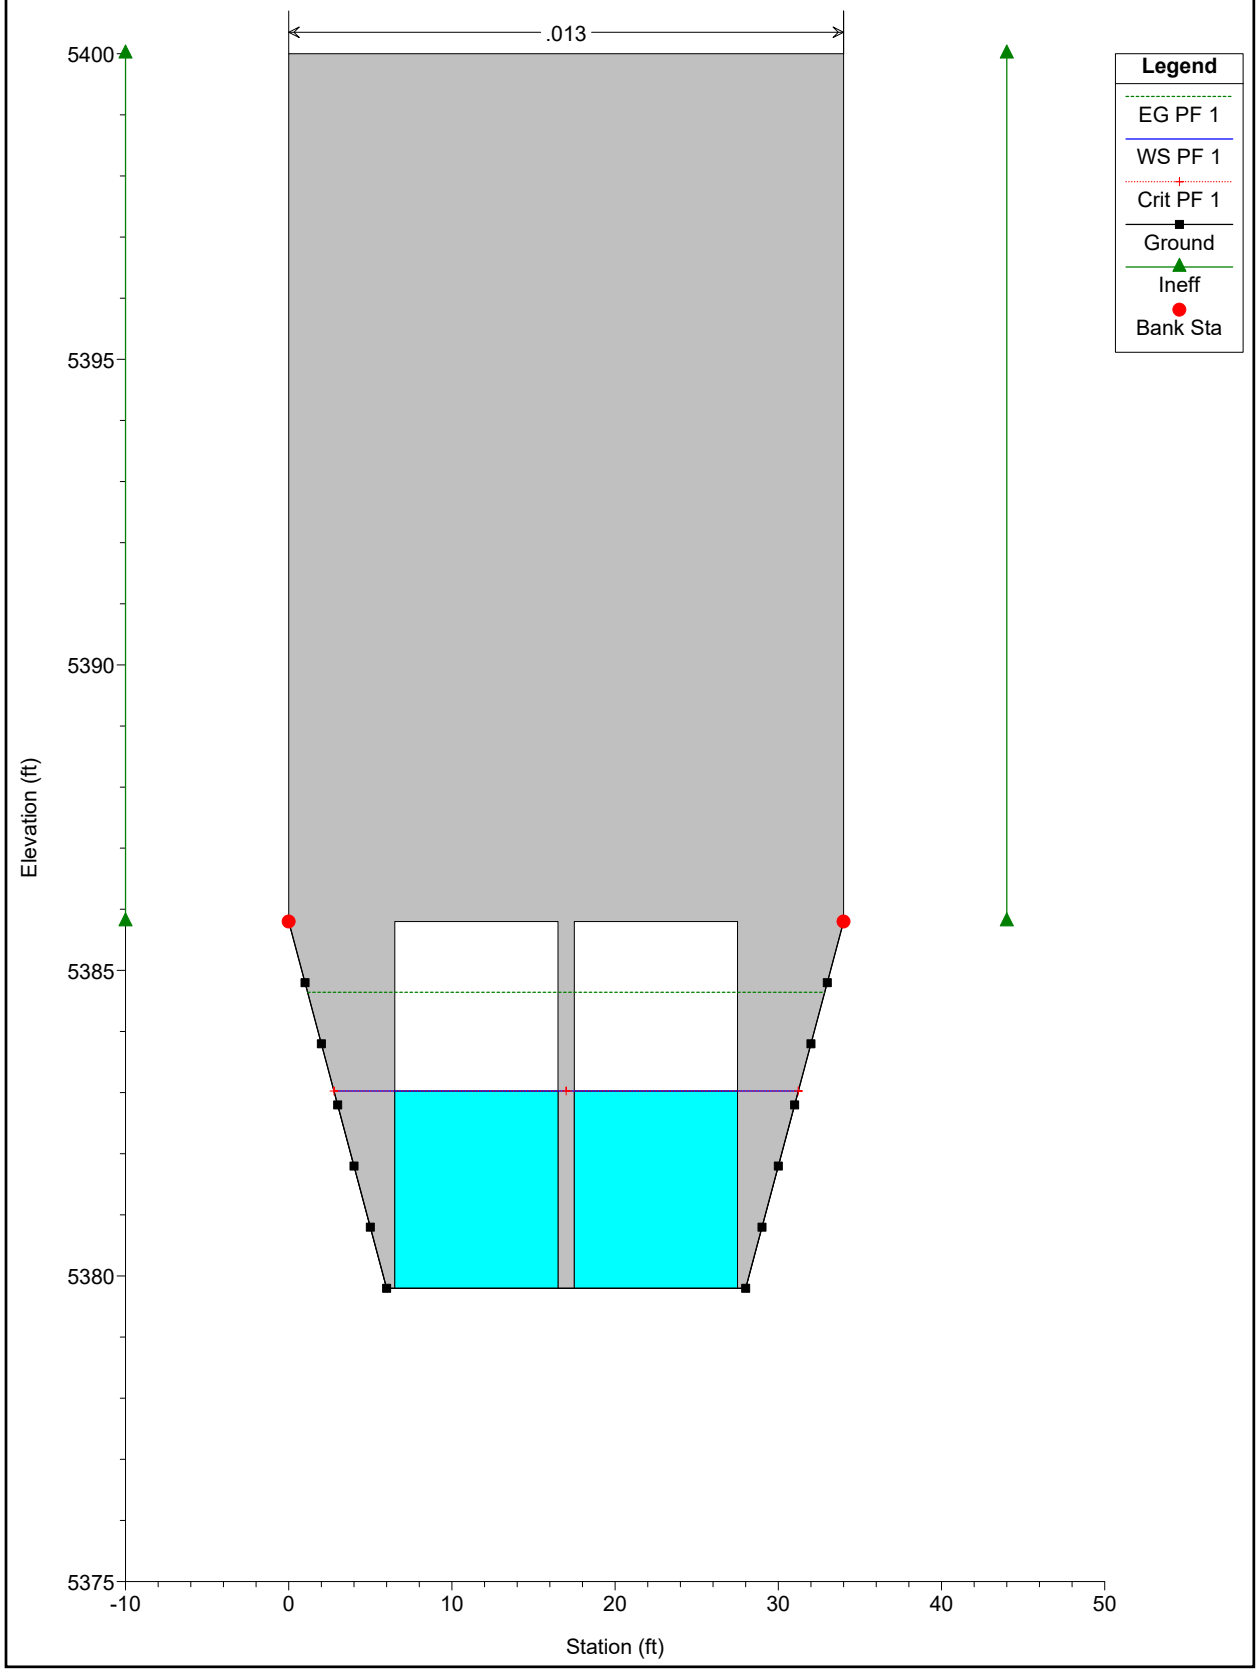

1

2

3

4


5

D

C

B

A

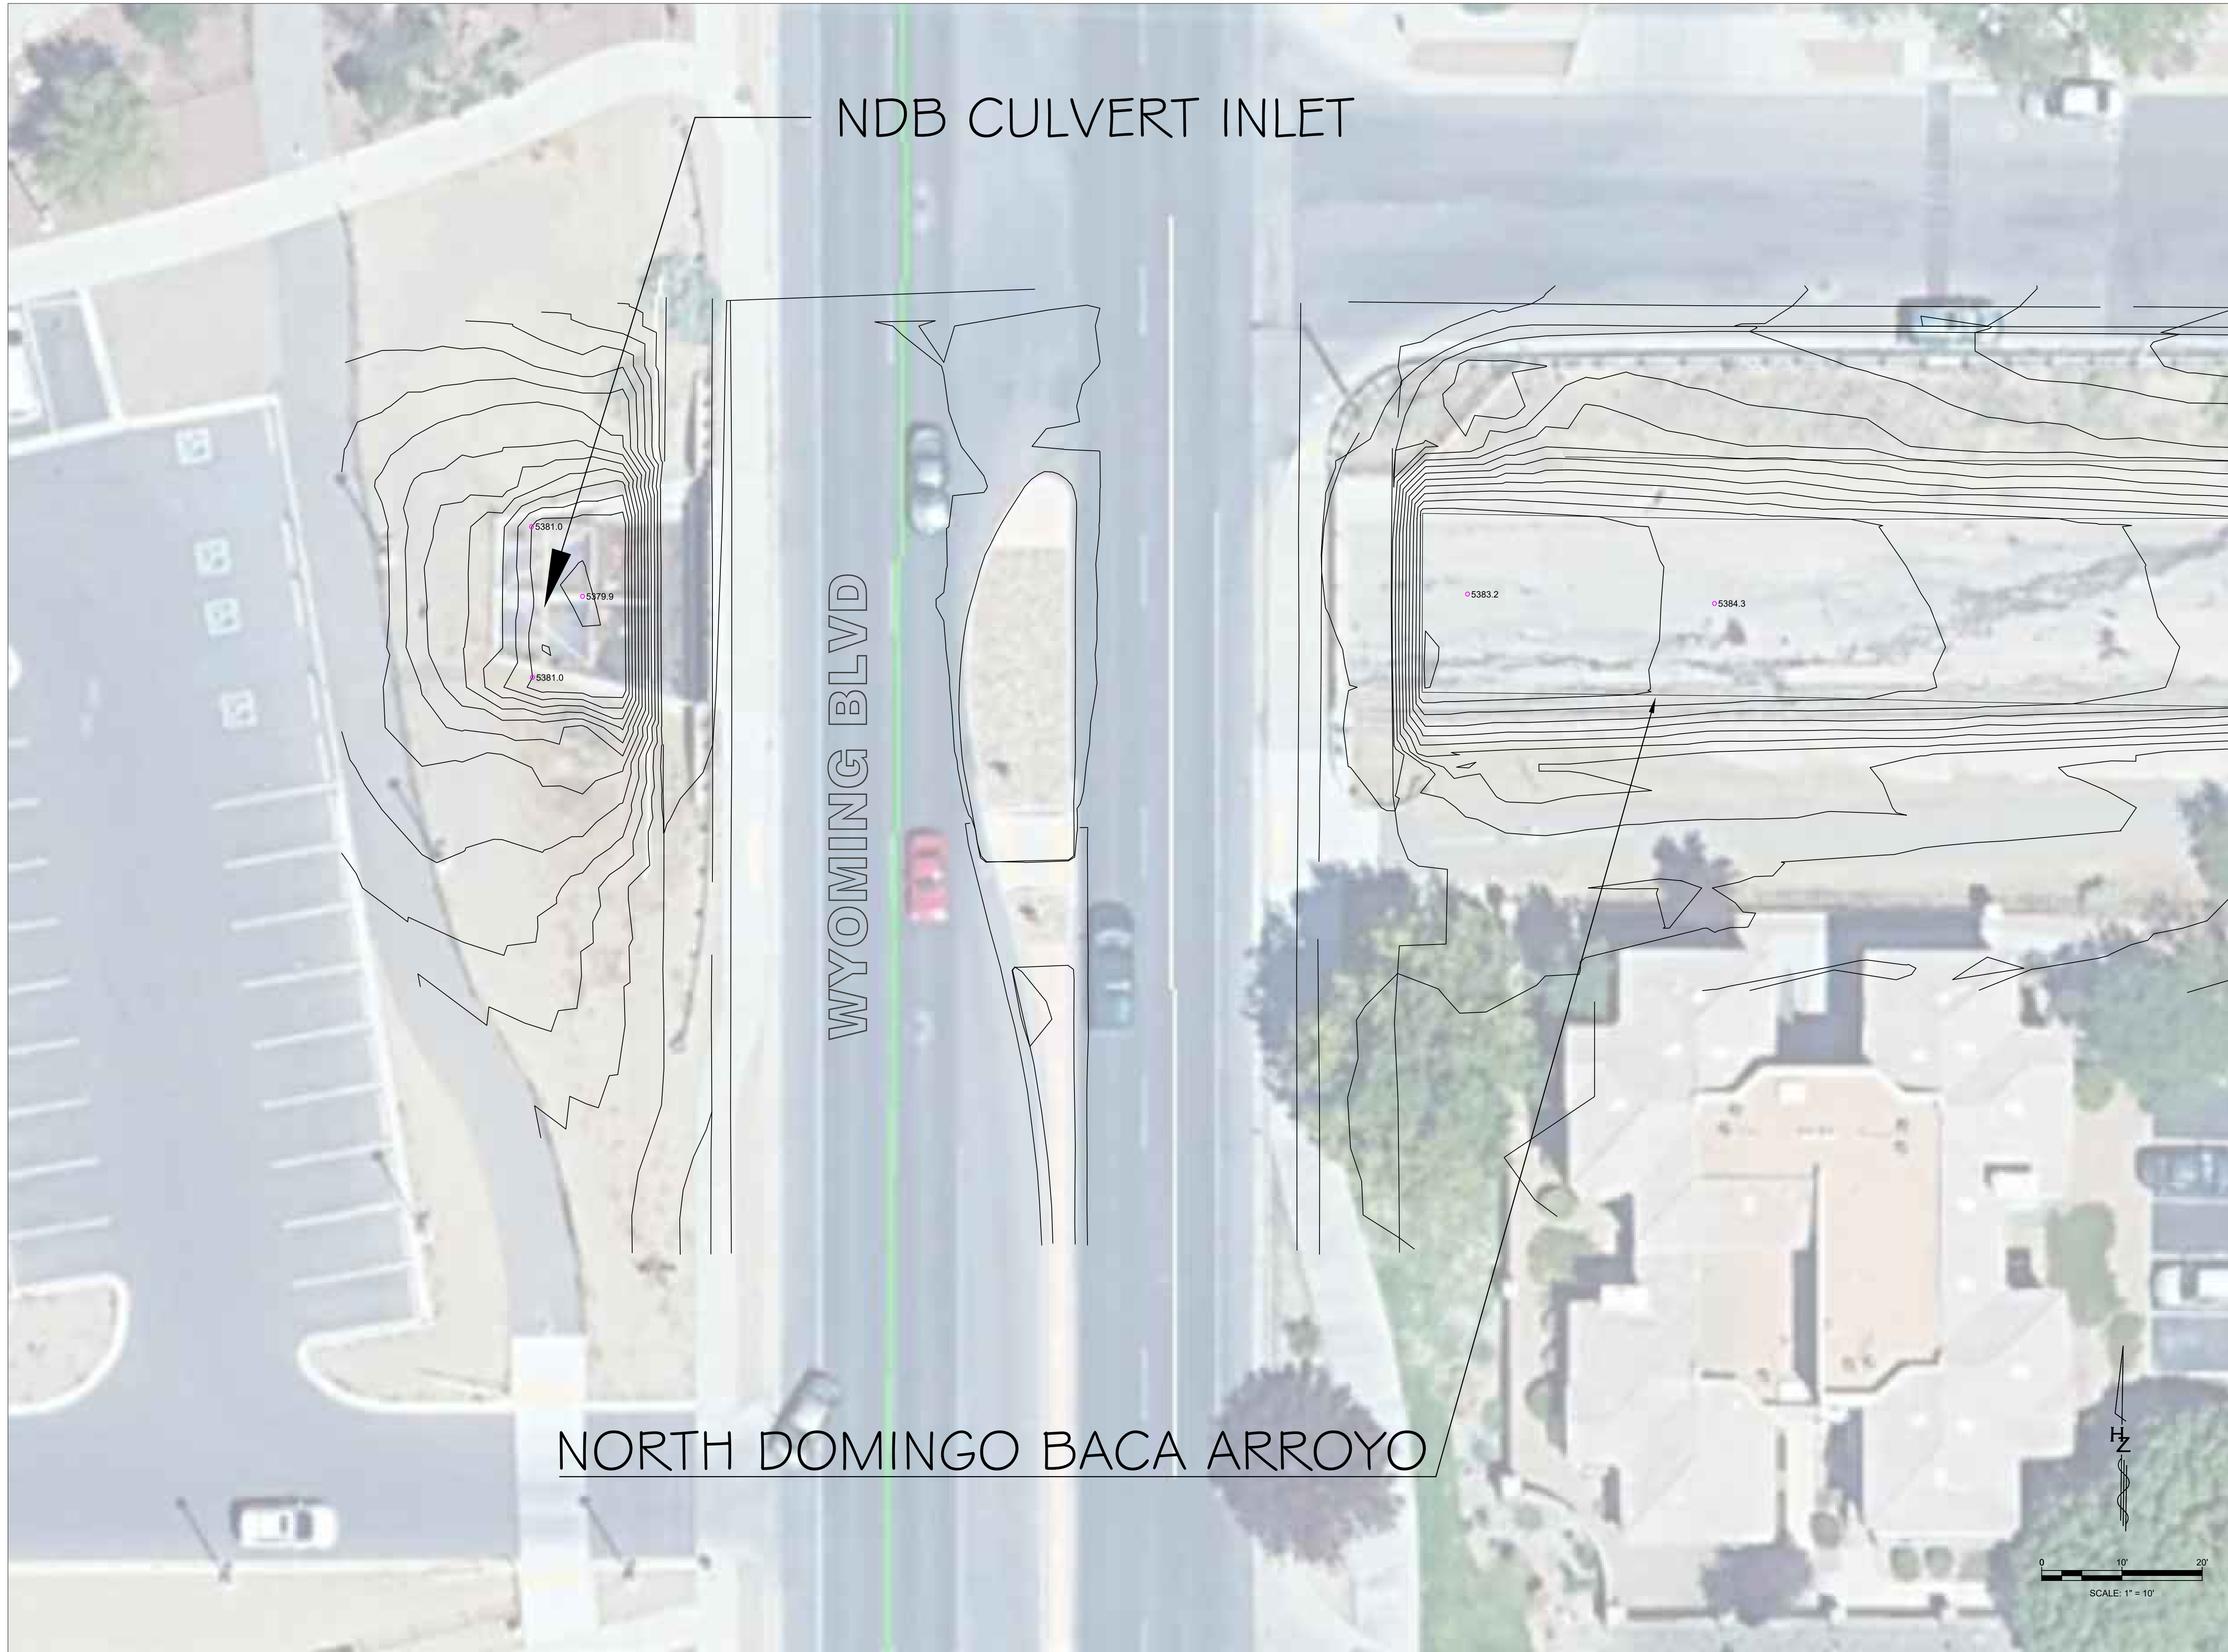

H:\TRANSFER\QUATIC CENTER\NDB LOMR EXHIBIT\_RECOVER.DWG

9/22/2023 3:04 PM



333 Rio Rancho Dr. NE, Suite 101  
 Rio Rancho, New Mexico 87124  
 505.892.5141  
 www.huitt-zollars.com

**NORTH  
 DOMINGO  
 BACA  
 LOMR**

PROJECT NO.:  
 DRAWN BY: STAFF  
 REVIEWED BY: STAFF  
 APPROVED BY: STAFF

ISSUE DRAWING LOG:


NORTH DOMINGO BACA  
 CHANNEL

LOMR EXHIBIT

1

2

3

4

5

D

C

B

A



H:\TRANSFER\CORNER\QUATIC CENTER\NOB LOMR EXHIBIT\_RECOVER.DWG

9/12/2023 3:04 PM



333 Rio Rancho Dr. NE, Suite 101  
 Rio Rancho, New Mexico 87124  
 505.892.5141  
 www.huitt-zollars.com

**NORTH  
 DOMINGO  
 BACA  
 LOMR**

PROJECT NO.:

DRAWN BY: STAFF

REVIEWED BY: STAFF

APPROVED BY: STAFF

ISSUE DRAWING LOG:

NO.	DATE	DESCRIPTION

KINNEY DAM

LOMR EXHIBIT

COPYRIGHT 2024 HUITT-ZOLLARS INC.


**Item 5**

**National Flood Hazard Layer Firmette  
(Existing & Proposed)**

# National Flood Hazard Layer FIRMMette



106°34'7"W 35°10'58"N

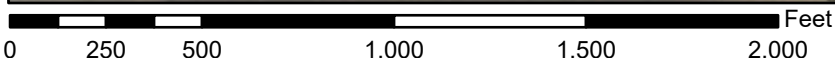

1:6,000

106°33'29"W 35°10'28"N

Basemap Imagery Source: USGS National Map 2023

## Legend

SEE FIS REPORT FOR DETAILED LEGEND AND INDEX MAP FOR FIRM PANEL LAYOUT

SPECIAL FLOOD HAZARD AREAS		Without Base Flood Elevation (BFE) <i>Zone A, V, A99</i>
		With BFE or Depth <i>Zone AE, AO, AH, VE, AR</i>
		Regulatory Floodway
OTHER AREAS OF FLOOD HAZARD		0.2% Annual Chance Flood Hazard, Areas of 1% annual chance flood with average depth less than one foot or with drainage areas of less than one square mile <i>Zone X</i>
		Future Conditions 1% Annual Chance Flood Hazard <i>Zone X</i>
		Area with Reduced Flood Risk due to Levee. See Notes. <i>Zone X</i>
		Area with Flood Risk due to Levee <i>Zone D</i>
OTHER AREAS		NO SCREEN Area of Minimal Flood Hazard <i>Zone X</i>
		Effective LOMRs
GENERAL STRUCTURES		Area of Undetermined Flood Hazard <i>Zone D</i>
		Channel, Culvert, or Storm Sewer
OTHER FEATURES		Levee, Dike, or Floodwall
		20.2 Cross Sections with 1% Annual Chance Water Surface Elevation
		17.5 Cross Sections with 1% Annual Chance Water Surface Elevation
		Coastal Transect
		Base Flood Elevation Line (BFE)
		Limit of Study
		Jurisdiction Boundary
		Coastal Transect Baseline
		Profile Baseline
		Hydrographic Feature
MAP PANELS		Digital Data Available
		No Digital Data Available
		Unmapped



The pin displayed on the map is an approximate point selected by the user and does not represent an authoritative property location.

This map complies with FEMA's standards for the use of digital flood maps if it is not void as described below. The basemap shown complies with FEMA's basemap accuracy standards

The flood hazard information is derived directly from the authoritative NFHL web services provided by FEMA. This map was exported on 6/5/2024 at 6:09 PM and does not reflect changes or amendments subsequent to this date and time. The NFHL and effective information may change or become superseded by new data over time.

This map image is void if the one or more of the following map elements do not appear: basemap imagery, flood zone labels, legend, scale bar, map creation date, community identifiers, FIRM panel number, and FIRM effective date. Map images for unmapped and unmodernized areas cannot be used for regulatory purposes.

**NOTES TO USERS**

This map is for use in administering the National Flood Insurance Program. It does not necessarily identify all areas subject to flooding, particularly from local drainage sources of small size. The community map repository should be consulted for possible updated or additional flood hazard information.

To obtain more detailed information in areas where Base Flood Elevations (BFEs) and/or floodways have been determined, users are encouraged to consult the Flood Profiles and Floodway Data and/or Summary of Stillwater Elevations tables contained within the Flood Insurance Study (FIS) report that accompanies this FIRM. Users should be aware that BFEs shown on the FIRM represent rounded whole-foot elevations. These BFEs are intended for flood insurance rating purposes only and should not be used as the sole source of flood elevation information. Accordingly, flood elevation data presented in the FIS report should be utilized in conjunction with the FIRM for purposes of construction and/or floodplain management.

Coastal Base Flood Elevations shown on this map apply only landward of 0.0 North American Vertical Datum of 1988 (NAVD 88). Users of this FIRM should be aware that coastal flood elevations are also provided in the summary of Stillwater Elevations table in the Flood Insurance Study Report for this jurisdiction. Elevations shown in the Summary of Stillwater Elevations table should be used for construction and/or floodplain management purposes when they are higher than the elevations shown on this FIRM.

Boundaries of the floodways were computed at cross sections and interpolated between cross sections. The floodways were based on hydraulic considerations with regard to requirements of the National Flood Insurance Program. Floodway widths and other pertinent floodway data are provided in the Flood Insurance Study report for this jurisdiction.

Certain areas not in Special Flood Hazard Areas may be protected by flood control structures. Refer to Section 2.4 "Flood Protection Measures" of the Flood Insurance Study report for information on flood control structures in this jurisdiction.

The projection used in the preparation of this map was New Mexico State Plane, Central Zone. The horizontal datum was NAD 83, GRS80 spheroid. Differences in datum, spheroid, projection or UTM zones used in the production of FIRMs for adjacent jurisdictions may result in slight positional differences in map features across jurisdiction boundaries. These differences do not affect the accuracy of this FIRM.

Flood elevations on this map are referenced to the North American Vertical Datum of 1988. These flood elevations must be compared to structure and ground elevations referenced to the same vertical datum. For information regarding conversion between the National Geodetic Vertical Datum of 1929 and the North American Vertical Datum of 1988, visit the National Geodetic Survey website at <http://www.ngs.noaa.gov> or contact the National Geodetic Survey at the following address:

NGS Information Services  
NOAA, NGS12  
National Geodetic Survey, SSMC-3, #9202  
1315 East-West Highway  
Silver Spring, Maryland 20910-3282  
(301) 713-3242

To obtain current elevation, description, and/or location information for bench marks shown on this map, please contact the Information Services Branch of the National Geodetic Survey at (301) 713-3242, or visit their website at <http://www.ngs.noaa.gov>.

Base map information shown on this FIRM was provided in digital format by Bernalillo County produced at a scale of 1:12,000 from photography dated 1999 or later.


Based on updated topographic information, this map reflects more detailed and up-to-date stream channel configurations and floodplain delineations than those shown on the previous FIRM for this jurisdiction. As a result, the Flood Profiles and Floodway Data tables for the Flood Insurance Study report may reflect stream channel distances that differ from what is shown on the map. Also, the road to floodplain relationships for unsewered streams may differ from what is shown on previous maps.

Corporate limits shown on this map are based on the best data available at the time of publication. Because changes due to annexations or de-annexations may have occurred after this map was published, map users should contact appropriate community officials to verify current corporate limit locations.

Please refer to the separately printed Map Index for an overview map of the county showing the layout of map panels; community map repository addresses; and a Listing of Communities table containing National Flood Insurance Program dates for each community as well as a listing of the panels on which each community is located.

Contact the FEMA Map Service Center at 1-800-358-9616 for information on available products associated with this FIRM. Available products may include previously issued Letters of Map Change, a Flood Insurance Study report, and/or digital versions of this map. The FEMA Map Service Center may also be reached by Fax at 1-800-358-9620 and their website at <http://www.msc.fema.gov>.

If you have questions about this map or questions concerning the National Flood Insurance Program in general, please call 1-877-FEMA-MAP (1-877-336-2627) or visit the FEMA website at <http://www.fema.gov/businessinfo>.

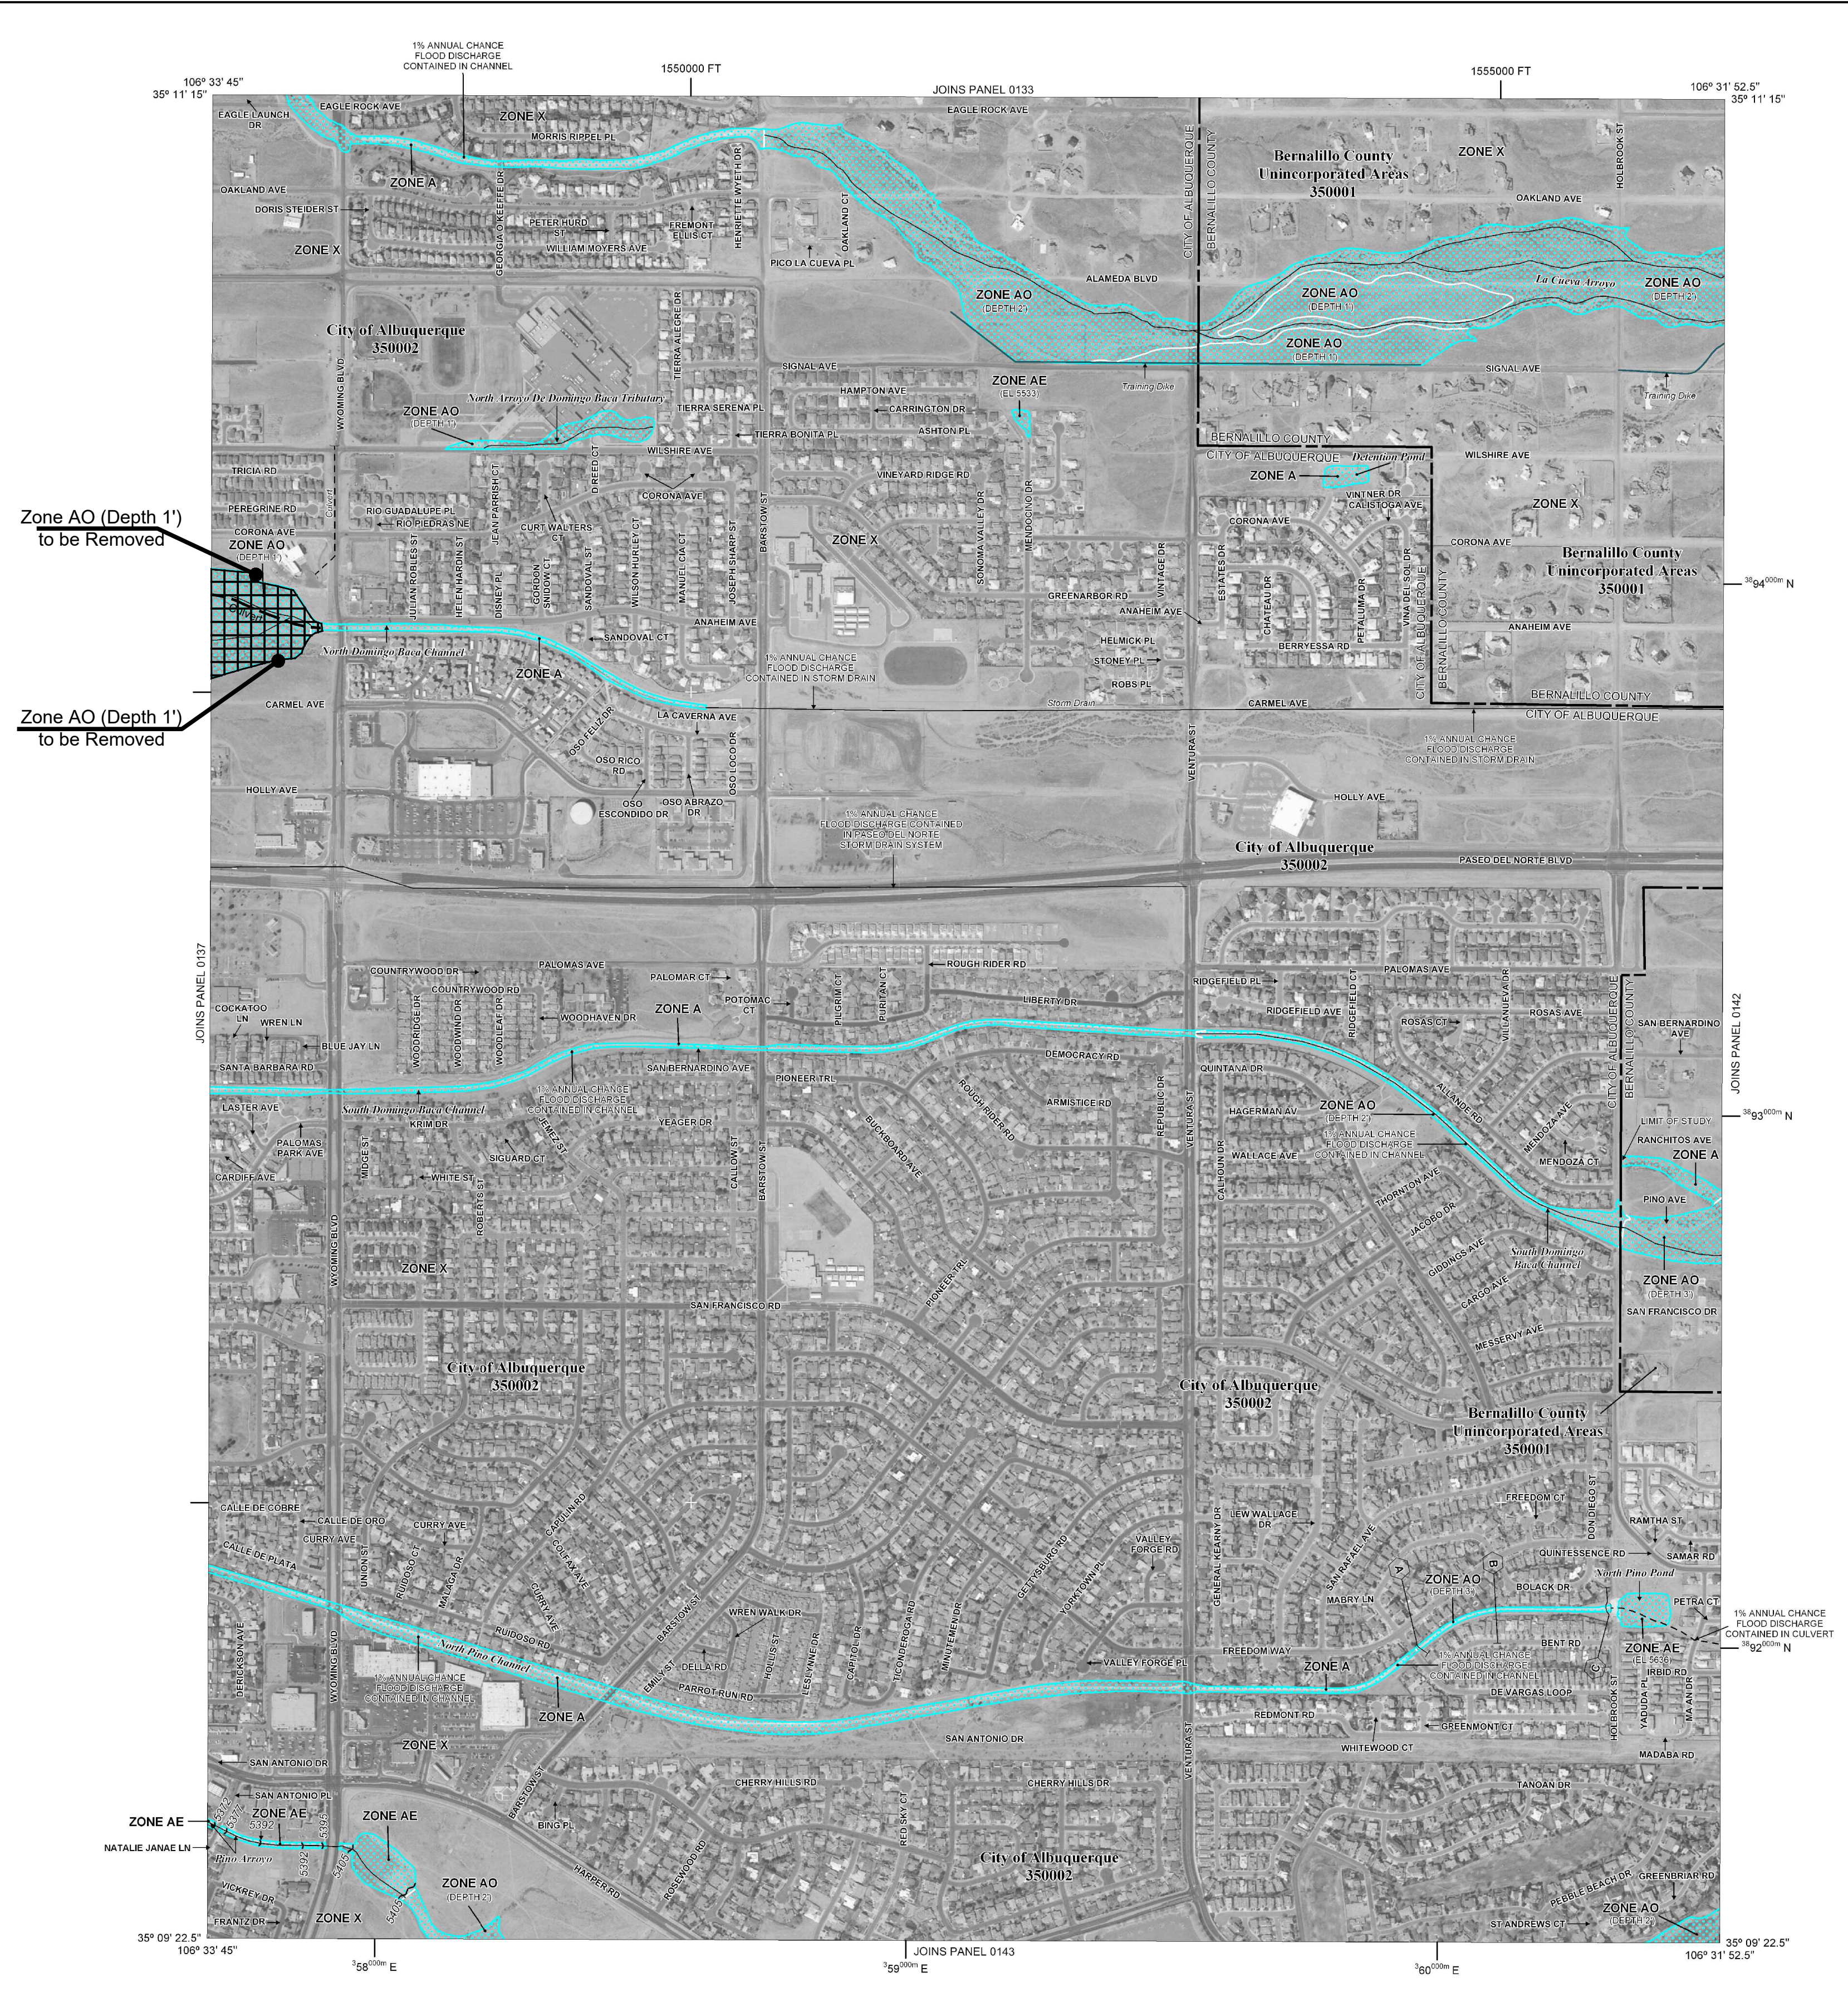

**LEGEND**

**SPECIAL FLOOD HAZARD AREAS (SFHA) SUBJECT TO INUNDATION BY THE 1% ANNUAL CHANCE FLOOD:**

The 1% annual chance flood (100-year flood), also known as the base flood, is the flood that has a 1% chance of being equaled or exceeded in any given year. The Special Flood Hazard Area is the area subject to flooding by the 1% annual chance flood. Areas of Special Flood Hazard include Zones A, AE, AH, AO, AR, AV, and VE. The Base Flood Elevation is the water surface elevation of the 1% annual chance flood.

**ZONE A**  
No Base Flood Elevations determined.

**ZONE AE**  
Base Flood Elevations determined.

**ZONE AH**  
Flood depths of 1 to 3 feet (usually areas of ponding); Base Flood Elevations determined.

**ZONE AO**  
Flood depths of 2 to 3 feet (usually sheet flow on sloping terrain); average depths determined. For areas of shallow fine flooding, velocities also determined.

**ZONE AR**  
Special Flood Hazard Area formerly protected from the 1% annual chance flood by a flood control system that was subsequently determined to be inoperable; the former flood control system is being restored to provide protection from the 1% annual chance or greater flood.

**ZONE AV**  
Areas to be protected from 1% annual chance flood by a Federal flood protection system under construction; no Base Flood Elevations determined.

**ZONE VE**  
Coastal flood zone with velocity hazard (wave action); Base Flood Elevations determined.

**FLOODWAY AREAS IN ZONE AE**  
The floodway is the channel of a stream plus any adjacent floodplain areas that must be kept free of encroachment so that the 1% annual chance flood can be carried without substantial increases in flood heights.

**OTHER FLOOD AREAS**

**ZONE X**  
Areas of 0.2% annual chance flood; areas of 1% annual chance flood with average depths of less than 1 foot or with drainage areas less than 1 square mile, and areas protected by levees from 1% annual chance flood.

**OTHER AREAS**  
Areas determined to be outside the 0.2% annual chance floodplain. Areas in which flood hazards are undetermined, but possible.

**COASTAL BARRIER RESOURCES SYSTEM (CBRS) AREAS**

**OTHERWISE PROTECTED AREAS (OPAs)**  
CBRS areas and OPAs are normally located within or adjacent to Special Flood Hazard Areas.

**MAP REPOSITORIES**  
Refer to Map Repositories list on Map Index.

**EFFECTIVE DATE OF COUNTYWIDE FLOOD INSURANCE RATE MAP PANEL**  
SEPTEMBER 20, 1996

**EFFECTIVE DATE(S) OF REVISION(S) TO THIS PANEL**  
April 2, 2002 - to update corporate limits to change Base Flood Elevations and Special Flood Hazard Areas; to add roads and road names; to reflect updated topographic information, and to incorporate previously issued Letters of Map Revision.  
November 19, 2003 - to update corporate limits and to incorporate previously issued Letters of Map Revision.  
September 26, 2008 - to update corporate limits, to change Special Flood Hazard Areas to add roads and road names; to incorporate previously issued Letters of Map Revision; to reflect updated topographic information; to change Base Flood Elevations; to add Base Flood Elevations.

For community map revision history prior to countywide mapping, refer to the Community Map History table located in the Flood Insurance Study report for this jurisdiction.

To determine if flood insurance is available in this community, contact your insurance agent or call the National Flood Insurance Program at 1-800-638-6620.

**MAP SCALE 1" = 600'**

250 0 500 1000  
150 0 150 300  
FEET  
METERS

**NATIONAL FLOOD INSURANCE PROGRAM**

**PANEL 0141G**

**FIRM**

**FLOOD INSURANCE RATE MAP**

**BERNALILLO COUNTY, NEW MEXICO**

**AND INCORPORATED AREAS**

**PANEL 141 OF 825**

(SEE MAP INDEX FOR FIRM PANEL LAYOUT)

CONTAINS	COMMUNITY	NUMBER	PANEL	SUFFIX
	ALBUQUERQUE CITY OF	350002	0141	G
	BERNALILLO COUNTY UNINCORPORATED AREAS	350001	0141	G

Notice to User: The Map Number shown below should be used when placing map orders; the Community Number shown above should be used on insurance applications for the subject community.

**MAP NUMBER**  
35001C0141G

**MAP REVISED**  
SEPTEMBER 26, 2008

**Federal Emergency Management Agency**

**NOTES TO USERS**

This map is for use in administering the National Flood Insurance Program. It does not necessarily identify all areas subject to flooding, particularly from local drainage sources of small size. The community map repository should be consulted for possible updated or additional flood hazard information.

To obtain more detailed information in areas where **Base Flood Elevations** (BFEs) and/or **floodways** have been determined, users are encouraged to consult the Flood Profiles and Floodway Data and/or Summary of Stillwater Elevations tables contained within the Flood Insurance Study (FIS) report that accompanies this FIRM. Users should be aware that BFEs shown on the FIRM represent rounded whole-foot elevations. These BFEs are intended for flood insurance rating purposes only and should not be used as the sole source of flood elevation information. Accordingly, flood elevation data presented in the FIS report should be utilized in conjunction with the FIRM for purposes of construction and/or floodplain management.

**Coastal Base Flood Elevations** shown on this map apply only landward of 0.0 North American Vertical Datum of 1988 (NAVD 88). Users of this FIRM should be aware that coastal flood elevations are also provided in the Summary of Stillwater Elevations table in the Flood Insurance Study Report for this jurisdiction. Elevation shown in the Summary of Stillwater Elevations table should be used for construction, and/or floodplain management purposes when they are higher than the elevations shown on this FIRM.

Boundaries of the **floodways** were computed at cross sections and interpolated between cross sections. The floodways were based on hydraulic considerations with regard to requirements of the National Flood Insurance Program. Floodway widths and other pertinent floodway data are provided in the Flood Insurance Study report for this jurisdiction.

Certain areas not in Special Flood Hazard Areas may be protected by **flood control structures**. Refer to Section 2.4 "Flood Protection Measures" of the Flood Insurance Study report for information on flood control structures in this jurisdiction.

The **projection** used in the preparation of this map was New Mexico State Plane, Central Zone (NAD 83). The horizontal datum was NAD 83, GRS80 spheroid. Differences in datum, spheroid, projection or State Plane zones used in the production of FIRMs for adjacent jurisdictions may result in slight positional differences in map features across jurisdiction boundaries. These differences do not affect the accuracy of this FIRM.

Flood elevations on this map are referenced to the North American Vertical Datum of 1988. These flood elevations must be compared to structure and ground elevations referenced to the same vertical datum. For information regarding conversion between the National Geodetic Vertical Datum of 1929 and the North American Vertical Datum of 1988, visit the National Geodetic Survey website at <http://www.ngs.noaa.gov> or contact the National Geodetic Survey at the following address:

NGS Information Services  
 NOAA, NNGS12  
 National Geodetic Survey, SSMC-3, #9202  
 1315 East-West Highway  
 Silver Spring, Maryland 20910-3282  
 (301) 713-3242

To obtain current elevation, description, and/or location information for **bench marks** shown on this map, please contact the Information Services Branch of the National Geodetic Survey at (301) 713-3242, or visit their website at <http://www.ngs.noaa.gov/>.

**Base map** information shown on this FIRM was provided in digital format by City of Albuquerque, 2010, Bernalillo County, 2004, and 2010, Bureau of Land Management, 2003, National Geodetic Survey, 2003, and United States Geological Survey (USGS), 1999. Additional information was photogrammetrically compiled at a scale of 1:12,000 from U.S. Department of Agriculture aerial photography dated 2009.


This map reflects more detailed and up-to-date **stream channel configurations** than those shown on the previous FIRM for this jurisdiction. The floodplains and floodways that were transferred from the previous FIRM may have been adjusted to conform to these new stream channel configurations. As a result, the Flood Profiles and Floodway Data tables in the Flood Insurance Study report (which contains authoritative hydraulic data) may reflect stream channel distances that differ from what is shown on this map.

**Corporate limits** shown on this map are based on the best data available at the time of publication. Because changes due to annexations or de-annexations may have occurred after this map was published, map users should contact appropriate community officials to verify current corporate limit locations.

Please refer to the separately printed **Map Index** for an overview map of the county showing the layout of map panels; community map repository addresses; and a listing of Communities table containing National Flood Insurance Program dates for each community as well as a listing of the panels on which each community is located.

For information on available products associated with this FIRM visit the **Map Service Center (MSC)** website at <http://msc.fema.gov>. Available products may include previously issued Letters of Map Change, a Flood Insurance Study Report, and/or digital versions of this map. Many of these products can be ordered or obtained directly from the MSC website.

If you have **questions about this map**, how to order products or the National Flood Insurance Program in general, please call the **FEMA Map Information Exchange (FMIX)** at 1-877-FEMA-MAP (1-877-336-2627) or visit the FEMA website at <http://www.fema.gov/business/nfp>.

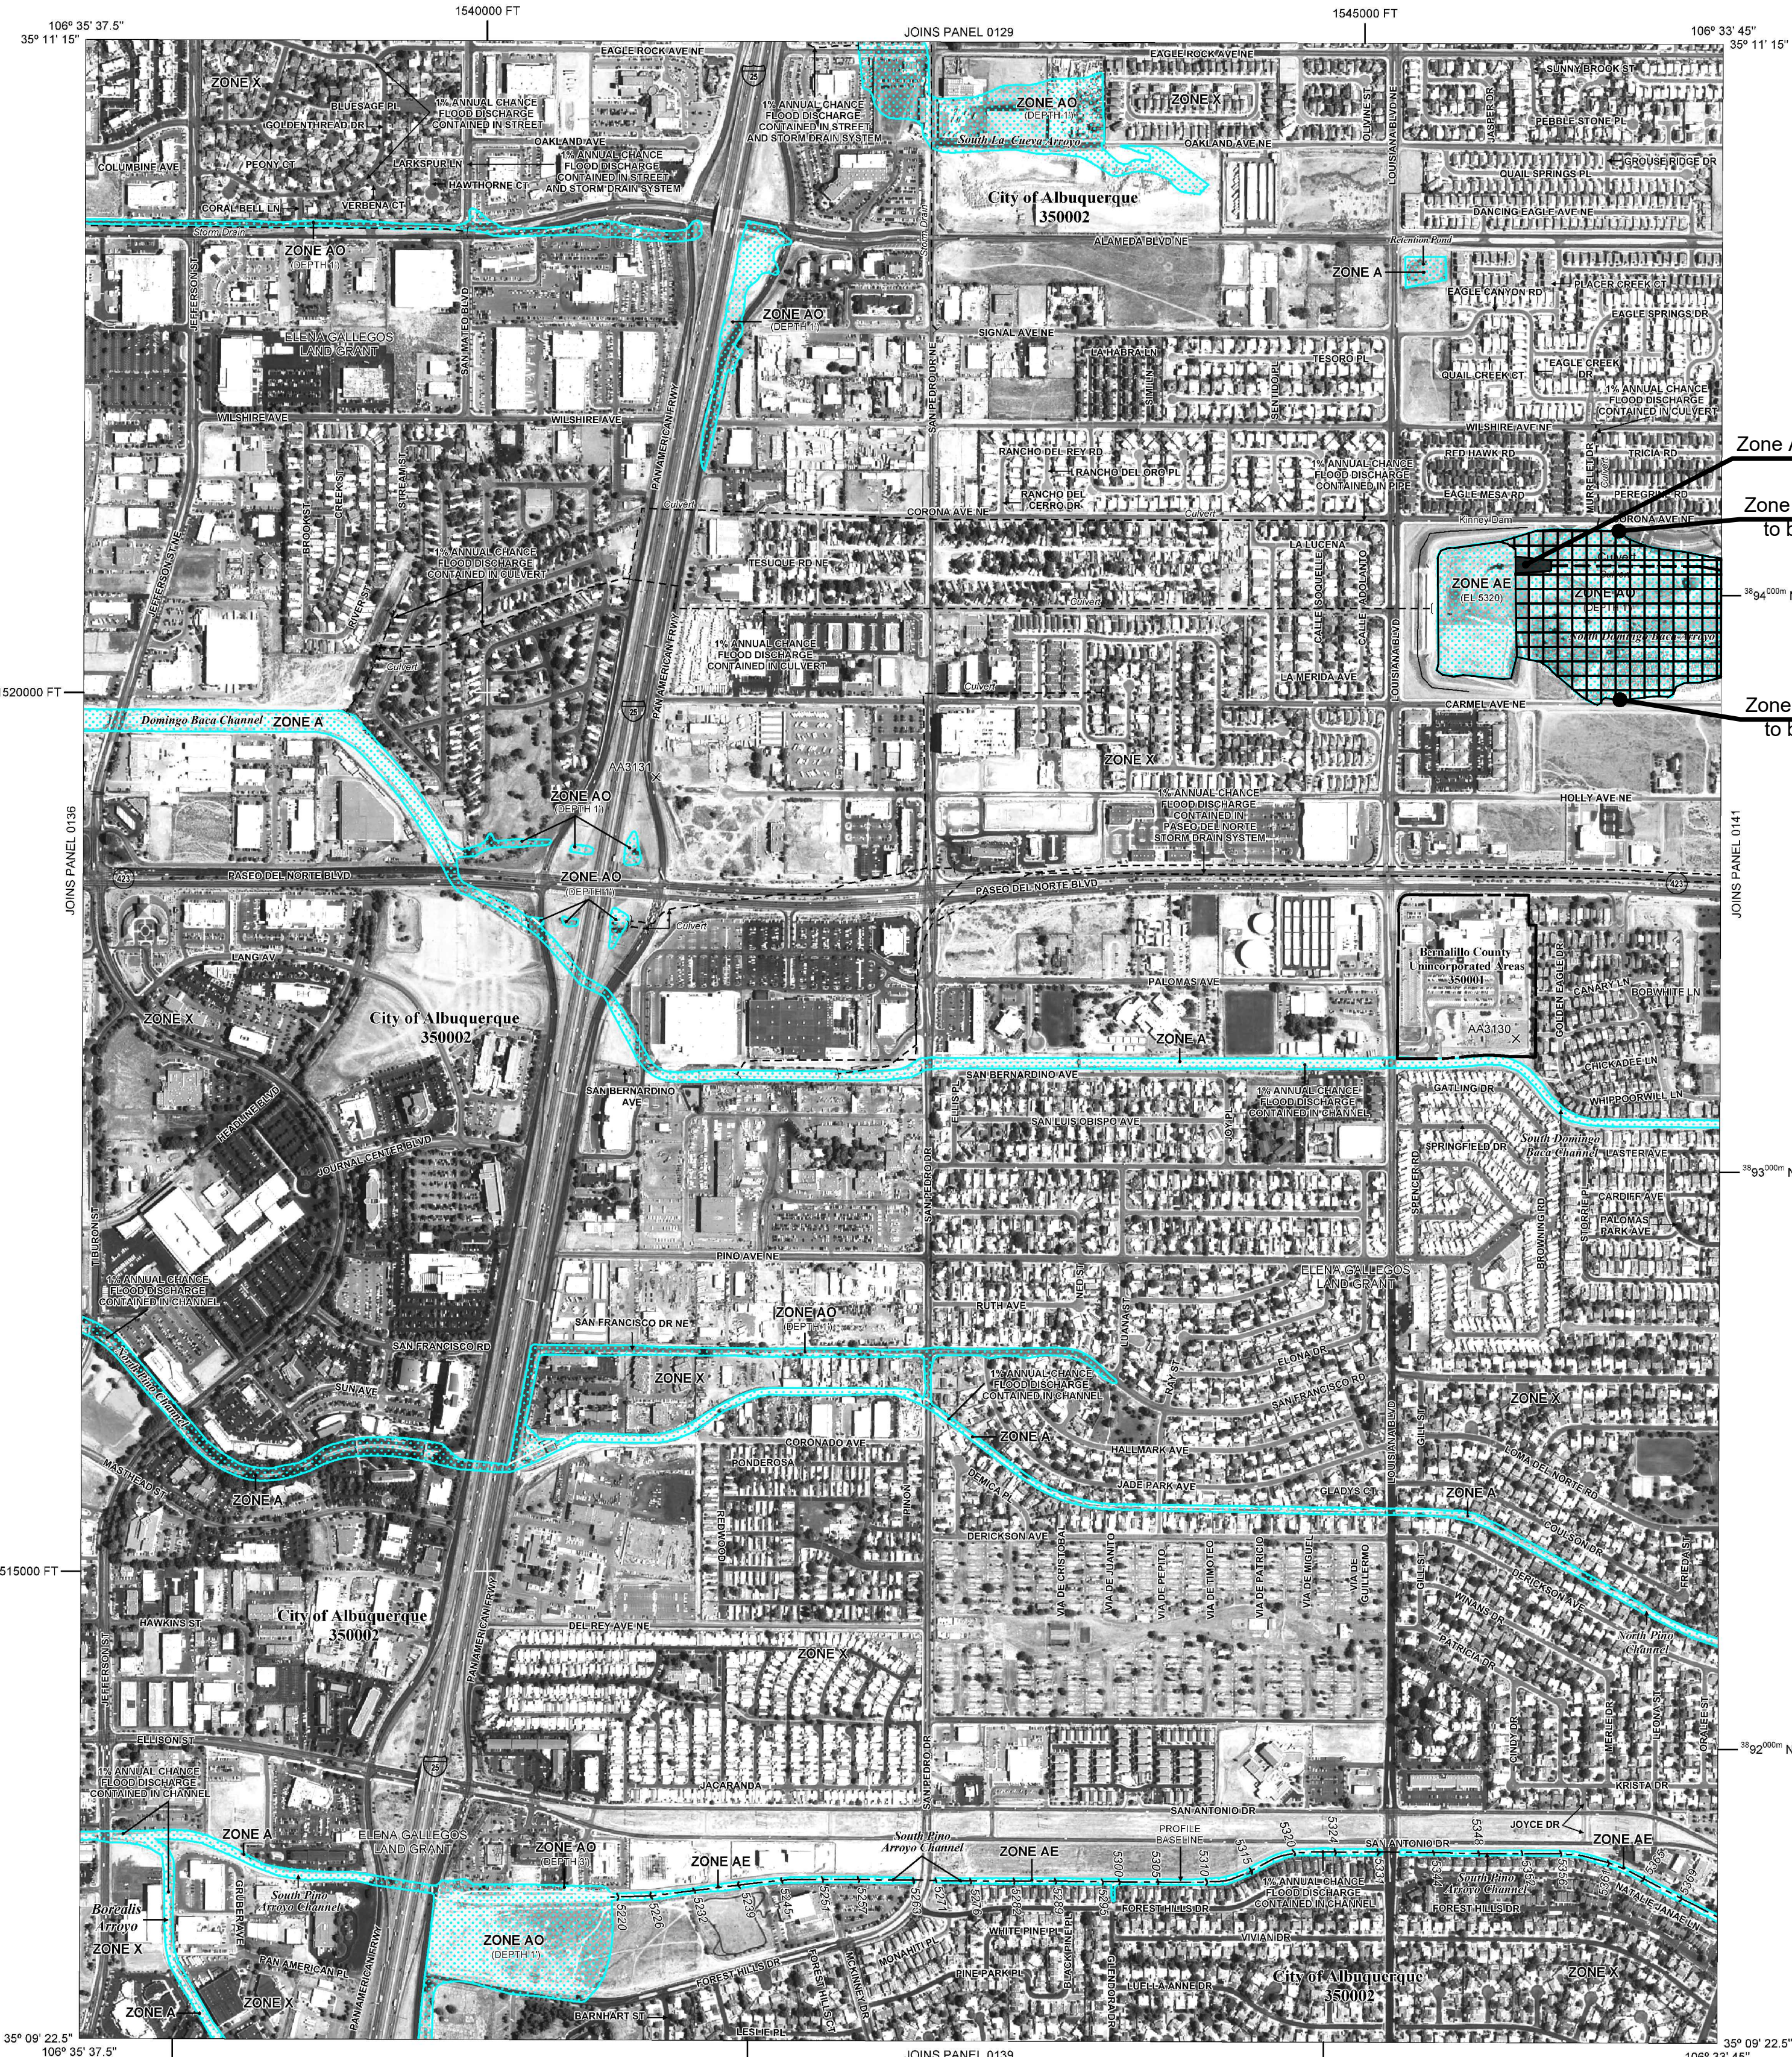

**LEGEND**

**SPECIAL FLOOD HAZARD AREAS (SFHAs) SUBJECT TO INUNDATION BY THE 1% ANNUAL CHANCE FLOOD**

The 1% annual chance flood (100-year flood), also known as the base flood, is the flood that has a 1% chance of being equaled or exceeded in any given year. The Special Flood Hazard Area is the area subject to flooding by the 1% annual chance flood. Areas of Special Flood Hazard include Zones A, AE, AH, AO, AR, AV, V, and VE. The Base Flood Elevation is the water surface elevation of the 1% annual chance flood.

**ZONE A**  
 No Base Flood Elevations determined.

**ZONE AE**  
 Base Flood Elevations determined.

**ZONE AH**  
 Flood depths of 1 to 3 feet (usually areas of ponding); Base Flood Elevations determined.

**ZONE AO**  
 Flood depths of 1 to 3 feet (usually sheet flow on sloping terrain); average depths determined. For areas of unusual fan flooding, velocities also determined.

**ZONE AR**  
 Special Flood Hazard Area formerly protected from the 1% annual chance flood by a flood control system that was subsequently determined. Zone AR indicates that the former flood control system is being removed to provide protection from the 1% annual chance or greater flood.

**ZONE AV**  
 Area to be protected from 1% annual chance flood by a Federal flood protection system under construction; no Base Flood Elevations determined.

**ZONE VE**  
 Coastal flood zone with velocity hazard (wave action); Base Flood Elevations determined.

**FLOODWAY AREAS IN ZONE AE**  
 The floodway is the channel of a stream plus any adjacent floodplain areas that must be kept free of encroachment so that the 1% annual chance flood can be carried without substantial increases in flood heights.

**OTHER FLOOD AREAS**

**ZONE X**  
 Areas of 0.2% annual chance flood; areas of 1% annual chance flood with average depths of less than 1 foot or with drainage areas less than 1 square mile; and areas protected by levees from 1% annual chance flood.

**OTHER AREAS**  
 Areas determined to be outside the 0.2% annual chance floodplain.

**COASTAL BARRIER RESOURCES SYSTEM (CBRS) AREAS**  
 Areas in which flood hazards are understood, but possible.

**OTHERWISE PROTECTED AREAS (OPAs)**  
 CBRS areas and OPAs are normally located within or adjacent to Special Flood Hazard Areas.

1% annual chance floodplain boundary  
 0.2% annual chance floodplain boundary  
 Floodway boundary  
 Zone D boundary  
 CBRS and OPA boundary  
 Boundary dividing Special Flood Hazard Area Zones and boundary dividing Special Flood Hazard Areas of different Base Flood Elevations, flood depths or flood velocities.  
 Base Flood Elevation line and value; elevation in feet.  
 Base Flood Elevation value where uniform within zone; elevation in feet.  
 \*Referenced to the North American Vertical Datum of 1988

**Cross section line**  
 A --- A

**Traverse line**  
 23 --- 23  
 97° 07' 30", 32° 32' 30"  
 76 m/e

600000 FT  
 DMS10 X  
 1:50,000

**MAP REPOSITORIES**  
 Refer to Map Repositories list on Map Index.

**EFFECTIVE DATE OF COUNTYWIDE FLOOD INSURANCE RATE MAP PANEL**  
 SEPTEMBER 20, 1996

**EFFECTIVE DATE(S) OF REVISION(S) TO THIS PANEL**  
 April 2, 2002  
 November 19, 2003  
 September 26, 2008

August 16, 2012 - to update corporate limits to change Base Flood Elevations to add Special Flood Hazard Areas, to change Special Flood Hazard Areas, to add roads and road names, to incorporate previously issued Letters of Map Change.

For community map revision history prior to countywide mapping, refer to the Community Map History table located in the Flood Insurance Study report for this jurisdiction.

To determine if flood insurance is available in this community, contact your insurance agent or call the National Flood Insurance Program at 1-800-638-6620.

**MAP SCALE 1" = 500'**

0 500 1000  
 FEET  
 0 500 1000  
 METERS

**PANEL 0137H**

**FIRM**

**FLOOD INSURANCE RATE MAP**

**BERNALILLO COUNTY, NEW MEXICO AND INCORPORATED AREAS**

**PANEL 137 OF 825**

(SEE MAP INDEX FOR FIRM PANEL LAYOUT)

CONTAINS	COMMUNITY	NUMBER	PANEL	SUFFIX
	ALBUQUERQUE, CITY OF	350002	0137	H
	BERNALILLO COUNTY UNINCORPORATED AREAS	350001	0137	H

Notice to User: The Map Number shown below should be used when citing map orders. The Community Number shown below should be used on insurance applications for the subject community.

**MAP NUMBER 35001C0137H**

**MAP REVISED AUGUST 16, 2012**

Federal Emergency Management Agency

**Item 6**  
**References**

**Item 6. References**

City of Albuquerque. (2012). **Flood Insurance Study Number 35001CV001D** [FIS Report]. Retrieved from FEMA Flood Map Service Center: [FEMA Flood Map Service Center | Welcome!](#)

**Final Design Analysis Report for Lower North Domingo Baca Detention Dam** (Resource Technology, Inc., 1995)

**Item 7**

**North Domingo Baca Park Phase 4 Construction – Box Culvert Record Drawings**



# CITY OF ALBUQUERQUE

## DEPARTMENT OF MUNICIPAL DEVELOPMENT

### PARK DESIGN AND CONSTRUCTION DIVISION

# CONSTRUCTION PLANS FOR

# NORTH DOMINGO BACA PARK

# PHASE 4 CONSTRUCTION - BOX CULVERT

## WYOMING BOULEVARD TO KINNEY DAM

JULY 2005

### INDEX OF DRAWINGS


SHEET NO.	TITLE
1	TITLE SHEET, VICINITY MAP, INDEX OF DRAWINGS
2	GENERAL NOTES & LEGEND
3	EXISTING SITE & SURVEY DATA
4	REMOVAL PLAN
5	GRADING & DRAINAGE PLAN
6	CBC PLAN & PROFILE STA. 9+65.55 TO STA. 17+00
7	CBC PLAN & PROFILE STA. 17+00 TO STA. 24+00
8	CBC PLAN & PROFILE STA. 24+00 TO 27+99
9	CBC DETAIL - NMDOT SERIAL CB-32-1
10	CBC DETAIL - NMDOT SERIAL CB-32-2
11	CONCRETE BOX CULVERT DETAILS
12	SECTIONS & DETAILS
13	TRANSITION STRUCTURE SECTIONS & DETAILS
14	STEEL GRATE SECTIONS & DETAILS

**DISCLOSURE STATEMENT:**  
 THE SUBJECT PROPERTY IS LOCATED ON/NEAR A FORMER LANDFILL. DUE TO SUBJECT PROPERTY BEING ON/NEAR A FORMER LANDFILL, CERTAIN PRECAUTIONARY MEASURES MAY NEED TO BE TAKEN TO ENSURE THE HEALTH AND SAFETY OF THE PUBLIC. RECOMMENDATIONS MADE BY A PROFESSIONAL ENGINEER WITH EXPERTISE IN LANDFILLS AND LANDFILL GAS ISSUES (AS REQUIRED BY THE MOST CURRENT VERSION OF THE "INTERIM GUIDELINES FOR DEVELOPMENT WITHIN 1000 FEET OF LANDFILLS") SHALL BE CONSULTED PRIOR TO DEVELOPMENT OF THE SITE.

APPROVED FOR CONSTRUCTION  
  
 MARCIA PINCUS, P.E.  
 ENVIRONMENTAL HEALTH DEPARTMENT  
 CITY OF ALBUQUERQUE  
 DATE: August 3, 2005

APPROVED FOR CONSTRUCTION - CITY OF ALBUQUERQUE  
  
 JOHN KELLY, P.E.  
 EXECUTIVE ENGINEER  
 ALBUQUERQUE METROPOLITAN ARROYO FLOOD CONTROL AUTHORITY  
 DATE: 7-19-05

APPROVED FOR CONSTRUCTION WITHIN AMAFCA R.O.W.  
  
 JOHN KELLY, P.E.  
 EXECUTIVE ENGINEER  
 ALBUQUERQUE METROPOLITAN ARROYO FLOOD CONTROL AUTHORITY  
 DATE: 7-19-05

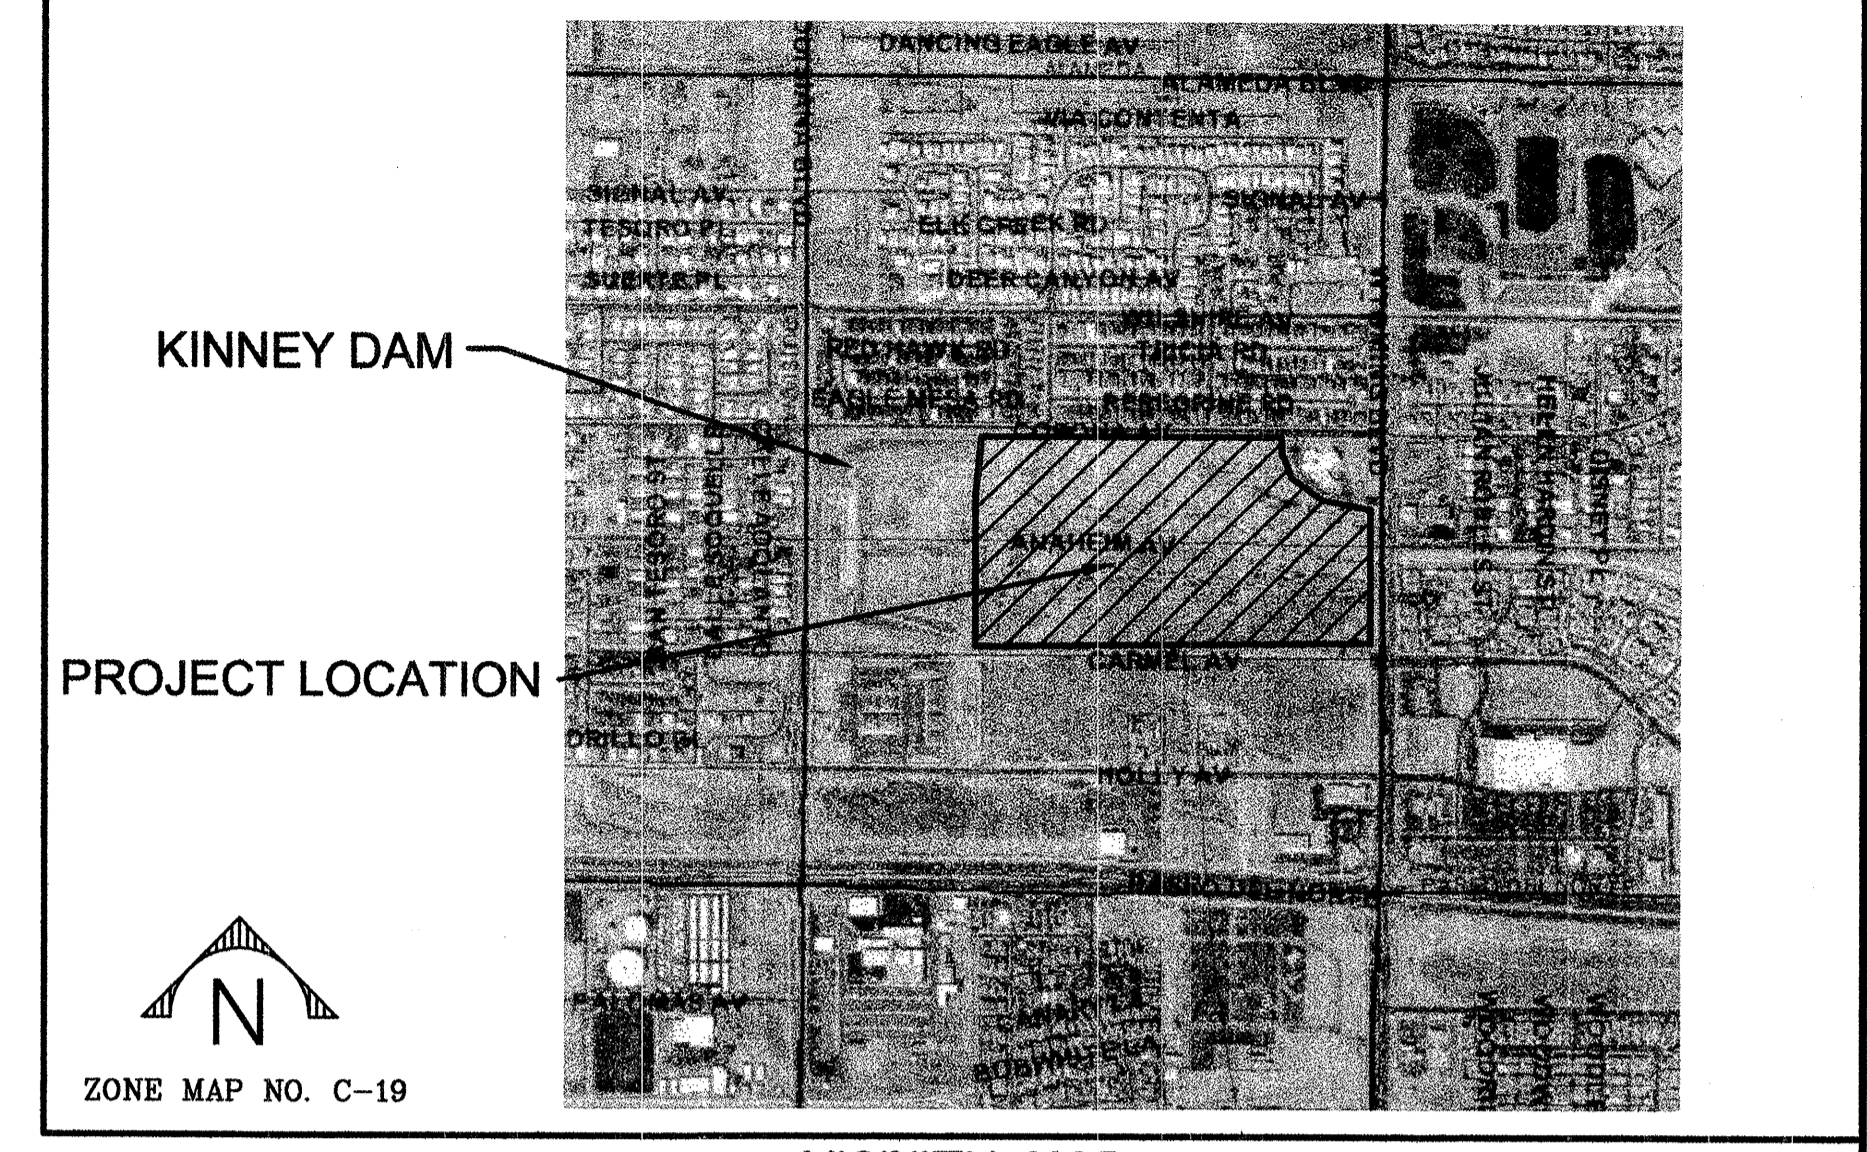

VICINITY MAP

#### UTILITY COMPANY CONTACTS

<b>CITY OF ALBUQUERQUE (WATER &amp; SEWER)</b> BILL BALCH Engineer/Utility Development P.O. Box 1293 Albuquerque, New Mexico 87103 (505) 768-2729	<b>COMCAST CABLE</b> RITA ERICKSON Planning and Design Supervisor 4611 Montbel Pl. NE Albuquerque, New Mexico 87107 (505) 761-6235	<b>XSPEDIUS MANAGEMENT CO.</b> STEVE BENJAMIN Operations Support Manager 505 Marquette Ave. NW, Suite 1605 Albuquerque, New Mexico 87102 (505) 998-2220
<b>PNM-ELECTRIC</b> JIM HILL Engineering Representative 4201 Edith Blvd., NE MS-ES61 Albuquerque, New Mexico 87107 (505) 241-3581	<b>UNIVERSAL ACCESS</b> JAMIE MARTINEZ Resource Supervisor 505 Marquette Ave. NW, #19A Albuquerque, New Mexico 87102 (505) 328-2675	<b>OSI GRANDE TECHNOLOGIES</b> BUD LENSING 5921 Jefferson St. NE Albuquerque, New Mexico 87109 (505) 345-6555
<b>PNM-GAS CO.</b> JOE DUNLOP Project Engineer 4625 Edith Blvd., NE Albuquerque, New Mexico 87107 (505) 241-7771	<b>E-SPiRE (ACSI)</b> JOHN MARES 505 Marquette Ave. NE, Suite 1605 Albuquerque, New Mexico 87102 (505) 998-2274	<b>McLeod USA</b> RICK MUELLER Supervisor of Outside Techs. 505 Marquette Ave. NE, Suite 1600 Albuquerque, New Mexico 87102 (505) 244-3161
<b>QWEST/US WEST</b> DAVID MULLER Capacity Provisioning Specialist 400 Tijeras Ave. NW, Suite 710 Albuquerque, New Mexico 87102 (505) 245-8706	<b>CityNet TELECOMMUNICATIONS</b> JOSH NELSON Field Representative 13500 Coronado Freeway Albuquerque, New Mexico 87121 (505) 991-2120	<b>TIME WARNER TELECOM</b> ROYAL HARRISON Plant Manager 3830 Singer Blvd. NE, Suite 1000 Albuquerque, New Mexico 87109 (505) 938-7339
<b>QWEST LONG DISTANCE</b> LARRY KELLY Senior Operations Tech 400 Tijeras Ave. NW, Suite 570 Albuquerque, New Mexico 87102 (505) 246-0501	<b>LEVEL 3 COMMUNICATIONS, LLC</b> STEVE GILMAN Resource Supervisor 1025 Eldorado Blvd. Broomfield, Colorado 80021 (720) 888-5920	<b>Smith Engineering Company</b> SEC JOB # 1020358 A Full Service Engineering Company 888 San Pablo Dam Blvd., Bldg. #1, Bldg. 200, Albuquerque, New Mexico 87102
<b>AT&amp;T</b> DAVID CROWEL Resource Supervisor 111 Third St., NW Albuquerque, New Mexico 87103 (505) 842-2911	<b>MCI WORLDCOM</b> ANDY DARNELL Operation Manager 6001 Midway Park NE Albuquerque, New Mexico 87109 (505) 346-4470	



REV.	SHEETS	CITY ENGINEER	DATE	USER DEPARTMENT	DATE	USER DEPARTMENT	DATE
ENGINEERS STAMP & SIGNATURE		APPROVED	ENGINEER	DATE	APPROVED FOR CONSTRUCTION		
		ORC Chairman		8-4-05	 JOHN KELLY, P.E. CITY ENGINEER DATE: 8-4-05		
		Transportation					
		Water/Wastewater	William J. Baker	8-4-05			
		Hydrology					
		CIP					
		Constr. Coord.		8-4-05			
		Perks					
		PROJECT NUMBER		7138.92	SHEET 1 OF 14		

- 1 THE SPECIFICATIONS USED FOR THIS PROJECT ARE THE CITY OF ALBUQUERQUE STANDARD SPECIFICATIONS FOR PUBLIC WORKS CONSTRUCTION, 1986 EDITION, THROUGH UPDATE NO.7.
- 2 FIVE (5) WORKING DAYS PRIOR TO BEGINNING CONSTRUCTION, THE CONTRACTOR WILL SUBMIT A DETAILED CONSTRUCTION SCHEDULE TO THE CITY CONSTRUCTION COORDINATION DIVISION. TWO (2) DAYS PRIOR TO CONSTRUCTION, THE CONTRACTOR WILL OBTAIN A BARRICADING PERMIT FROM THE CONSTRUCTION COORDINATION DIVISION. CONTRACTOR SHALL NOTIFY BARRICADE ENGINEER (924-3400) PRIOR TO OCCUPYING AN INTERSECTION. REFER TO SECTION 19 OF STANDARD SPECIFICATIONS FOR PUBLIC WORKS.
- 3 THE CONTRACTOR WILL NOTIFY THE FIELD ENGINEER NOT LESS THAN SEVEN (7) DAYS PRIOR TO STARTING WORK, IN ORDER THAT THE CITY SURVEYOR MAY TAKE NECESSARY MEASURES TO INSURE THE PRESERVATION OF CITY AND AMAFCA SURVEY MONUMENTS. THE CONTRACTOR WILL NOTIFY THE ENGINEER IF A MONUMENT IS DISTURBED. REPLACEMENT WILL BE DONE ONLY BY THE CITY SURVEY SECTION. WHEN A CHANGE IS MADE IN THE FINISHED ELEVATION OF THE PAVEMENT OF ANY ROADWAY IN WHICH A PERMANENT SURVEY MONUMENT IS LOCATED, CONTRACTOR WILL, AT HIS OWN EXPENSE, ADJUST THE MONUMENT COVER TO THE NEW GRADE UNLESS OTHERWISE SPECIFIED. REFER TO SECTION 4 OF STANDARD SPECIFICATIONS FOR PUBLIC WORKS.
- 4 ALL NEW MANHOLES SHALL BE TYPE "E" (COA DWG. 2102) UNLESS OTHERWISE NOTED ON THE PLANS.
- 5 THE CONTRACTOR WILL BE RESPONSIBLE FOR DISPOSING OF ALL DEBRIS, INCLUDING, BUT NOT LIMITED TO HAZARDOUS WASTE AT DISPOSAL SITES APPROVED BY GOVERNMENTAL AGENCIES REGULATING THE DISPOSAL OF SUCH MATERIALS.
- 6 ALL WATER VALVE BOXES AND MANHOLES IN THE STREET CONSTRUCTION ARE TO BE ADJUSTED TO FINISH GRADE AND WILL BE MEASURED AND PAID PER EACH.
- 7 SUBGRADE PREPARATION UNDER SIDEWALKS AND DRIVE PADS, AND SUBGRADE AND SUBBASE PREPARATION UNDER CURB AND GUTTER IS CONSIDERED INCIDENTAL TO THE CONSTRUCTION OF SUCH, AND NO DIRECT PAYMENT SHALL BE MADE FOR THOSE ITEMS OF WORK.
- 8 THE WATER SYSTEMS DIVISION (857-8200) WILL BE NOTIFIED BY THE CONTRACTOR SEVEN (7) WORKING DAYS IN ADVANCE OF ANY WORK WHICH MAY AFFECT THE EXISTING PUBLIC WATER FACILITIES. REFER TO SECTION 18 OF STANDARD SPECIFICATIONS.
- 9 ALL EXCAVATION WILL BE GOVERNED BY FEDERAL, STATE AND LOCAL LAWS, RULES, AND REGULATIONS CONCERNING CONSTRUCTION SAFETY AND HEALTH. ALL EXCAVATING, TRENCHING & SHORING ACTIVITIES MUST BE CARRIED-OUT IN ACCORDANCE WITH OSHA 1926.650 SUBPART P.
- 10 ALL SIGNS AND CODING WILL BE IN ACCORDANCE WITH THE "MANUAL OF UNIFORM TRAFFIC CONTROL DEVICES FOR STREETS AND HIGHWAYS" CURRENT EDITION PUBLISHED BY THE U.S. DEPARTMENT OF TRANSPORTATION.
- 11 THE CONTRACTOR IS TO EXERCISE CARE TO AVOID DISTURBING ANY EXISTING UNDERGROUND UTILITIES. IT IS THE CONTRACTOR'S RESPONSIBILITY TO COORDINATE WITH THE UTILITY COMPANIES IN ORDER TO PREVENT ANY SERVICE DISRUPTION. SEE SECTION 18 "UTILITIES", CITY OF ALBUQUERQUE, STANDARD SPECIFICATIONS FOR CONTRACTOR REQUIREMENTS.
- 12 WHEN ABUTTING NEW PAVEMENT TO EXISTING INTERSECTING STREETS, SAW CUT EXISTING PAVEMENT TO A STRAIGHT LINE AND AT RIGHT ANGLES AND REMOVE ANY BROKEN OR CRACKED PAVEMENT. NO DIRECT PAYMENT WILL BE MADE FOR SAW CUTTING.
- 13 ALL GAS VALVES, GAS MANHOLES, ELECTRICAL MANHOLES, TELEPHONE MANHOLES, AND UTILITY POLES WILL BE ADJUSTED TO GRADE BY EACH UTILITY COMPANY. CONTRACTOR WILL COORDINATE THROUGH CITY UTILITY COORDINATOR.
- 14 WHEN REMOVAL OF EXISTING CURB AND GUTTER OR SIDEWALK IS REQUIRED, REMOVE BACK TO NEAREST SUITABLE JOINT UNLESS OTHERWISE DIRECTED BY THE CITY FIELD ENGINEER.
- 15 THE CONTRACTOR WILL NOTIFY NEW MEXICO ONE CALL SYSTEM 280-1990 TWO (2) WORKING DAYS PRIOR TO COMMENCING WORK IN NEW AREAS.
- 16 CONTRACTOR WILL MAKE ALL WATER VALVES AND MANHOLES ACCESSIBLE TO THE CITY AT ALL TIMES.
- 17 CONTRACTOR WILL PLACE BITUMINOUS MATERIAL WITH THE USE OF A LAYDOWN MACHINE WHERE PAVEMENT IS 8 FEET IN WIDTH OR WIDER.
- 18 ALL SUBGRADE AND SUBBASE MATERIAL ENCOUNTERED IN PAVEMENT REMOVAL AND REPLACEMENT THAT IS DETERMINED BY THE FIELD ENGINEER TO MEET THE SPECIFICATIONS, CAN BE REUSED. HOWEVER, THE MATERIAL WILL BE PROCESSED AND COMPACTED TO MEET MOISTURE CONTENT AND PERCENT COMPACTION REQUIRED BY THE SPECIFICATIONS.
- 19 CONTRACTOR WILL NOT PAVE OVER ANY SURFACE FEATURE, I.E., GAS VALVE, MANHOLE COVER, ETC. WITHOUT PRIOR APPROVAL FROM THE CITY FIELD ENGINEER.
- 20 CONTRACTOR WILL CONFINE HIS OR HER WORK WITHIN THE CONSTRUCTION EASEMENT LIMITS AND/OR RIGHT-OF-WAY, OR PROVIDE COPIES OF AGREEMENTS WITH ADJACENT LANDOWNERS TO THE CITY OF ALBUQUERQUE.

- 21 ALL WATER VALVES AND FIRE HYDRANTS REMOVED WILL BE SALVAGED AND RETURNED TO THE C.O.A.
- 22 MINIMUM BOTTOM WIDTH OF TRENCHES FOR RIGID PIPE SHALL BE EQUAL TO THE OUTSIDE DIAMETER PLUS 16 INCHES. BEDDING MATERIAL SHALL BE CLASS II, III, OR IV UNLESS OTHERWISE SPECIFICALLY NOTED ON THE PLANS.
- 23 MINIMUM BOTTOM WIDTH OF TRENCHES FOR NON-RIGID PIPE SHALL BE EQUAL TO THE OUTSIDE DIAMETER PLUS 12 INCHES. BEDDING MATERIAL SHALL BE CLASS I, II, OR III.
- 24 THE CONTRACTOR AGREES TO TAKE NECESSARY SAFETY PRECAUTIONS AS REQUIRED BY FEDERAL, STATE AND LOCAL AUTHORITIES TO PROTECT PEDESTRIAN AND VEHICULAR TRAFFIC IN THE CONSTRUCTION AREA, WHICH INCLUDE BUT ARE NOT LIMITED TO: MAINTAINING ADEQUATE WARNING SIGNS, BARRICADES, LIGHTS, GUARD FENCES, WALKS AND BRIDGES.
- 25 ALL STRUCTURAL CONCRETE TO BE 4000 PSI UNLESS OTHERWISE NOTED ON PLANS.
- 26 ALL REINFORCING STEEL TO BE GRADE 60.
- 27 ALL EXPOSED EDGES ON CAST-IN-PLACE CONCRETE STRUCTURES WILL HAVE A 1" CHAMFER UNLESS OTHERWISE NOTED.
- 28 ALL SPLICES IN REINFORCING STEEL WILL BE 2-FOOT 6-INCH MINIMUM UNLESS OTHERWISE NOTED.
- 29 PRIOR TO CONSTRUCTION, THE CONTRACTOR WILL EXCAVATE AND VERIFY THE HORIZONTAL AND VERTICAL LOCATIONS OF ALL POTENTIAL CONFLICTING UTILITIES. SHOULD A CONFLICT EXIST BETWEEN THE FIELD INFORMATION AND THE PLANS, THE CONTRACTOR WILL NOTIFY THE CITY FIELD ENGINEER SO THE CONFLICT CAN BE RESOLVED WITH MINIMUM AMOUNT OF DELAY.
- 30 THE REPLACEMENT OF EXISTING UTILITIES AND THE INSTALLATION OF NEW UTILITY LINES WILL BE COMPLETED IN ADVANCE OF STARTING THE PAVEMENT WORK. TEMPORARY PAVEMENT WILL BE PLACED IN ALL TRENCHES REQUIRED FOR THE UTILITY REPLACEMENTS IN THOSE AREAS THAT MUST MAINTAIN TRAFFIC UNTIL THE FINAL PAVEMENT WORK STARTS IN EACH AREA. TEMPORARY STRIPING SHALL BE THE CONTRACTOR'S RESPONSIBILITY. MAINTENANCE OF THE TEMPORARY PAVING AND STRIPING WILL BE AT THE CONTRACTOR'S EXPENSE.
- 31 TACK COAT FOR SURFACE COURSE REQUIREMENTS WILL BE DETERMINED BY THE FIELD ENGINEER.
- 32 THE CONTRACTOR WILL CONTACT THE CITY OF ALBUQUERQUE TRAFFIC DIVISION 764-1599, ONE (1) WEEK IN ADVANCE OF ANY CHANGES REQUIRED IN THE TRAFFIC SIGNALIZATION OF THIS PROJECT. ALL WORK ASSOCIATED WITH NEW TRAFFIC SIGNALIZATION SHALL BE THE RESPONSIBILITY OF THE CONTRACTOR.
- 33 ALL NEW STREET PAVING, DRIVEWAYS, SIDEWALKS, AND CURB AND GUTTERS, ABUTTING EXISTING AREAS SHALL MATCH THE ELEVATION OF THOSE AREAS.
- 34 PERMANENT PAVEMENT STRIPING AND MARKINGS WILL BE PLACED BY THE CONTRACTOR. ROAD SHALL NOT BE OPENED TO TRAFFIC UNTIL IT IS STRIPED. ALL STRIPING, PAVEMENT MARKINGS INCLUDING CROSSWALKS, ARROWS AND LINE MARKINGS ARE TO BE CONSTRUCTED OF HOT PLASTIC OR COLD PLASTIC IN ACCORDANCE WITH THE MANUAL OF UNIFORM TRAFFIC CONTROL DEVICES.
- 35 ALL EXCAVATED MATERIAL THAT IS NOT REQUIRED TO BE REUSED MUST BE REMOVED FROM THE PROJECT AREA WITHIN FOUR DAYS OF EXCAVATION. SPOIL PILES WILL BE ALLOWED ONLY AS DIRECTED BY THE CITY FIELD ENGINEER.
- 36 THE CONTRACTOR WILL COORDINATE THE CONSTRUCTION ACTIVITIES WITH ALL OTHER CONTRACTORS AND UTILITY COMPANIES WORKING IN THE SAME AREA. THE CONTRACTOR MAY BE REQUIRED TO RESCHEDULE THEIR ACTIVITIES TO ALLOW UTILITY CREWS TO PERFORM THEIR REQUIRED WORK. NO ADDITIONAL COMPENSATION WILL BE ALLOWED FOR DELAYS OR INCONVENIENCE CAUSED BY UTILITY COMPANY WORK CREWS. THE CONTRACTOR MAY BE ALLOWED AN EXTENSION OF THE CONTRACT TIME, DUE TO DELAYS, AS DELINEATED IN THE CITY OF ALBUQUERQUE STANDARD SPECIFICATIONS, SECTION 12.
- 37 ALL CONSTRUCTION EASEMENTS ON PRIVATE PROPERTY WILL BE OBTAINED BY THE CONTRACTOR PRIOR TO THE BEGINNING OF CONSTRUCTION.
- 38 EXISTING MEDIAN CURB AND GUTTER AND STANDARD CURB AND GUTTER, NOT DISTURBED BY CONTRACTOR, BUT OUT OF ALIGNMENT, DISPLACED VERTICALLY, BADLY BROKEN AND/OR DETERIORATED, WILL BE REPLACED AS DIRECTED BY THE FIELD ENGINEER AND PAID FOR AT CONTRACT UNIT PRICES.
- 39 ALL TRAFFIC CONTROL DEVICES REQUIRED FOR DRIVEWAY CLOSURES, UTILITY CONSTRUCTION OR FOR OTHER REASONS AND NOT SHOWN ON THE SIGNING PLANS WILL BE FURNISHED BY THE CONTRACTOR AND WILL BE PAID AS SPECIFIED IN THE TECHNICAL SPECIFICATIONS AND BID PROPOSAL. PRIOR TO PLACING THE TRAFFIC CONTROL DEVICES, THE CONTRACTOR WILL NOTIFY THE AFFECTED OWNERS IN ACCORDANCE WITH THE SPECIFICATIONS. CONTRACTOR MUST MAKE PROVISIONS TO PROVIDE ACCESS TO PROPERTIES. REFER TO SECTION 19 OF THE STANDARD SPECIFICATIONS.

- 40 ALL UTILITY LINES WHICH ARE NOT SPECIFICALLY DESIGNATED TO BE REMOVED AND REPLACED ON THE PLANS, WILL BE MAINTAINED IN SERVICE. SHORING, SHEETING AND OTHER MEANS OF SUPPORT SHALL BE EMPLOYED BY THE CONTRACTOR TO PREVENT DAMAGE OR LOSS OF THESE EXISTING UTILITIES. BEAM AND CABLE OR OTHER ADEQUATE SUPPORTS WILL BE USED FOR TEMPORARY SUPPORT OF ALL UTILITY LINES WHICH CROSS THE TRENCH. ANY DAMAGE TO EXISTING UTILITIES WILL PROMPTLY BE REPAIRED AT THE CONTRACTOR'S EXPENSE. THE CONTRACTOR WILL NOTIFY THE ENGINEER IMMEDIATELY OF ANY SIGNIFICANT DEVIATION OF EXPOSED UTILITIES FROM THE LOCATIONS SHOWN ON THE PLANS SO THAT CONFLICTS CAN BE RESOLVED IN A TIMELY MANNER.
- 41 THE CONTRACTOR WILL ASSUME RESPONSIBILITY FOR ANY DAMAGE TO EXISTING COA INFRASTRUCTURE (C & G, PAVING, ETC.) DURING CONSTRUCTION, APART FROM THOSE SECTIONS INDICATED FOR REMOVAL ON THE PLANS, AND WILL REPAIR OR REPLACE SAME AT HIS OR HER OWN EXPENSE. HE/SHE WILL SUITABLY PROTECT THE CURB AND GUTTER FROM INCIDENTAL SPLASHING DURING THE TACK COAT APPLICATION AND WILL BE RESPONSIBLE FOR CLEANING SAME AT HIS OWN COST SHOULD SPLASHING OCCUR.
- 42 ALL INTERFERING PORTIONS OF ABANDONED UTILITY LINES WHICH ARE EXPOSED AS A RESULT OF CONSTRUCTION WILL BE REMOVED AND DISPOSED OF BY THE CONTRACTOR.
- 43 STATIONS OF STORM DRAIN INLETS ARE TO THE CENTER OF GRATE. ALL STORM DRAIN INLETS WILL BE TYPE "A" UNLESS OTHERWISE NOTED ON THE PLANS.
- 44 SHORING COSTS WILL BE CONSIDERED INCIDENTAL TO THE TRENCH AND BACKFILL COSTS.
- 45 THE CONTRACTOR WILL BE RESPONSIBLE FOR SECURING NPDES PERMITS REQUIRED BY APPLICABLE CITY, STATE, AND FEDERAL REGULATIONS.
- 46 ALL STORM DRAIN AND CONNECTOR PIPE WILL BE CLASS IV REINFORCED CONCRETE PIPE UNLESS OTHERWISE NOTED ON THE PLANS.
- 47 THE TERM "REMOVE" USED IN THIS PLAN SET INCLUDES THE DISPOSAL OF SAID MATERIAL IN ACCORDANCE WITH CITY OF ALBUQUERQUE STANDARD SPECIFICATIONS, LATEST EDITION.
- 48 CONTRACTOR WILL SURVEY AND LOG EXISTING ELEVATIONS OF CURB-AND-GUTTER, SIDEWALK, AND PAVEMENT WHICH WILL BE REMOVED FOR CONSTRUCTION OF IMPROVEMENTS. CONTRACTOR WILL REPLACE REMOVED CURB-AND-GUTTER, SIDEWALK, DRIVE PADS, AND PAVEMENT TO ELEVATIONS PRIOR TO REMOVAL UNLESS OTHERWISE INDICATED ON THE PLANS.
- 49 CONTRACTOR WILL CONSTRUCT TEMPORARY ASPHALT PAVEMENT AS DIRECTED BY THE COA ENGINEER TO PROVIDE ACCESS TO LOCAL BUSINESS, ETC. TEMPORARY PAVEMENT SHALL BE REMOVED AND DISPOSED OF PRIOR TO PLACEMENT OF FULL WIDTH PAVEMENT SECTION. TEMPORARY PAVING SHALL BE PER COA STD. DWG. 2415 AND PAID FOR PER COA STD. SPECIFICATIONS.
- 50 ALL EXPOSED CONCRETE SURFACES INCLUDING BUT NOT LIMITED TO RETAINING WALLS, SLOPE PAVING, STRUCTURES, AND CHANNEL LINING SHALL BE TINTED CONCRETE. TINTING SHALL BE SAN DIEGO BUFF AT ONE POUND OF COLOR PER SACK OF CEMENT.
- 51 PRE-WETTING OF THE EMBANKMENT FOUNDATION AND KEY TRENCH SHALL BE CONSIDERED INCIDENTAL TO THE CONSTRUCTION OF THE EMBANKMENT. NO ADDITIONAL PAYMENT WILL BE MADE FOR THIS WORK.
- 52 ALL ASPHALTIC CONCRETE SHALL BE MINIMUM 1800 LB. STABILITY AND COMPACTED TO 95% MODIFIED MARSHALL DENSITY UNLESS OTHERWISE NOTED ON THE PLANS.
- 53 ALL RIP-RAP MATERIAL USED ON THIS PROJECT SHALL BE A NATURAL ROCK MATERIAL CONFORMING TO THE SIZE AND MATERIAL PROPERTY REQUIREMENTS SET FORTH IN THE COA STANDARD SPECIFICATIONS. NO BROKEN CONCRETE OR RUBBLE WILL BE ACCEPTED.
- 54 CONTRACTOR SHALL MAINTAIN A GRAFFITI-FREE SITE. CONTRACTOR SHALL PROMPTLY REMOVE ANY AND ALL GRAFFITI FROM EQUIPMENT, WHETHER PERMANENT OR TEMPORARY.
- 55 ALL STRIPING ON C.O.A. STREETS REMOVED OR DAMAGED MUST BE REPLACED WITH PLASTIC. STRIPING ERADICATION SHALL BE ACCOMPLISHED BY WATER BLASTING OR SURFACE PLANING OF THE ROADWAY TO A MAXIMUM DEPTH OF 0.25 INCHES (MAXIMUM) AND FOR A WIDTH EQUAL TO TWO TIMES THE WIDTH OF THE STRIPE OR MARKING TO BE REMOVED.
- 56 FOR STORM DRAIN CONSTRUCTION, RCP JOINTS SHALL NOT BE GROUTED PRIOR TO FINAL INSPECTION WILL DETERMINED JOINTS TO BE GROUTED FOR FULL INSPECTION ACCEPTANCE OF THE CONSTRUCTION.
- 57 THE CONTRACTOR SHALL ABIDE BY ALL LOCAL, STATE, AND FEDERAL LAWS, RULES, AND REGULATIONS WHICH APPLY TO THE CONSTRUCTION, INCLUDING WORKER HEALTH AND SAFETY ASPECTS, OF THESE IMPROVEMENTS.
- 58 DISPOSAL SITE FOR ALL EXCESS EXCAVATION MATERIAL AND UNSUITABLE MATERIAL SHALL BE OBTAINED BY THE CONTRACTOR IN COMPLIANCE WITH APPLICABLE ENVIRONMENTAL REGULATIONS. ALL COSTS INCURRED IN OBTAINING A FULLY REGULATED DISPOSAL SITE AND HAUL THERETO SHALL BE CONSIDERED INCIDENTAL TO THE PROJECT AND NO SEPARATE MEASUREMENT OF PAYMENT SHALL BE CONSIDERED.
- 59 ALL DISTURBED GROUND AREAS RESULTING FROM CONSTRUCTION ACTIVITIES SHALL BE REVEGETATED IN ACCORDANCE WITH CITY OF ALBUQUERQUE STANDARD SPECIFICATIONS FOR PUBLIC WORKS CONSTRUCTION, SECTION 1012, NATIVE GRASS SEEDING, AS CURRENTLY UPDATED.


**EXISTING FEATURES LEGEND:**

- X---X---X--- EXISTING CHAIN-LINK FENCE
- 2" HPO--- EXISTING GAS LINE W/ VALVE
- 6" W--- EXISTING WATERLINE W/ VALVE
- 6" SAS--- EXISTING SANITARY SEWER LINE W/ MANHOLE
- EXISTING FIRE HYDRANT
- 36" RCP--- EXISTING STORM DRAIN
- \*--- EXISTING UTILITY POLE
- 44--- EXISTING 1' CONTOUR
- 4845--- EXISTING 5' CONTOUR
- === EXISTING CURB & GUTTER
- EXISTING CONCRETE
- EXISTING BUILDING LINE
- EXISTING EDGE OF PAVEMENT

**NEW FEATURES LEGEND:**

- CONSTRUCTION CENTERLINE
- NEW CBC BOX CULVERT
- NEW RCP STORM DRAIN
- 44--- NEW 1' CONTOUR
- 5345--- NEW 5' CONTOUR
- NEW CONCRETE
- o<sup>1</sup> POT HOLE LOCATION W/ NO.

AS BUILT INFORMATION	CONTRACTOR: SALL & BROS. 3/07
BENCH MARKS	STATION NAME: 1-B20; STATE: NM; COUNTY: BERNALILLO
SURVEY INFORMATION	DATE: 3/07
ENGINEER'S SEAL	BY: [Signature]
REVISIONS	NO. DATE
DESIGN	DATE: JULY 2005
DRAWN	DATE: JULY 2005
CHECKED	DATE: JULY 2005

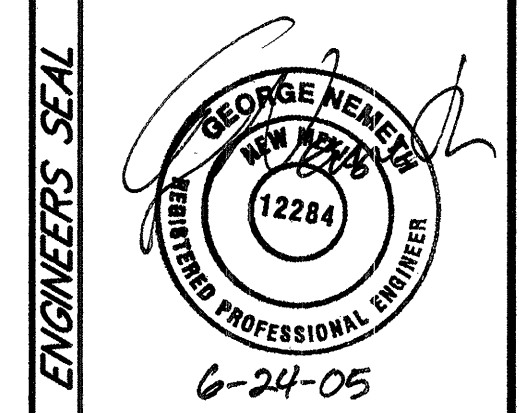


102035B  
**Smith Engineering Company**  
 A Full Service Engineering Company  
800 West Pueblo Boulevard, K.E. Mag. Pl. Suite 100 Albuquerque, New Mexico 87102

**CITY OF ALBUQUERQUE  
DEPARTMENT OF MUNICIPAL DEVELOPMENT**


**TITLE: NORTH DOMINGO BACA PARK  
PHASE 4 CONSTRUCTION - BOX CULVERT  
GENERAL NOTES & LEGEND**

Design Review Committee	City Engineer Approval	No. / Day / Yr.	No. / Day / Yr.
[Signature]	[Signature]		
City Project No. <b>7138.92</b>		Zone Map No. <b>C-19</b>	Sheet <b>2</b> Of <b>14</b>



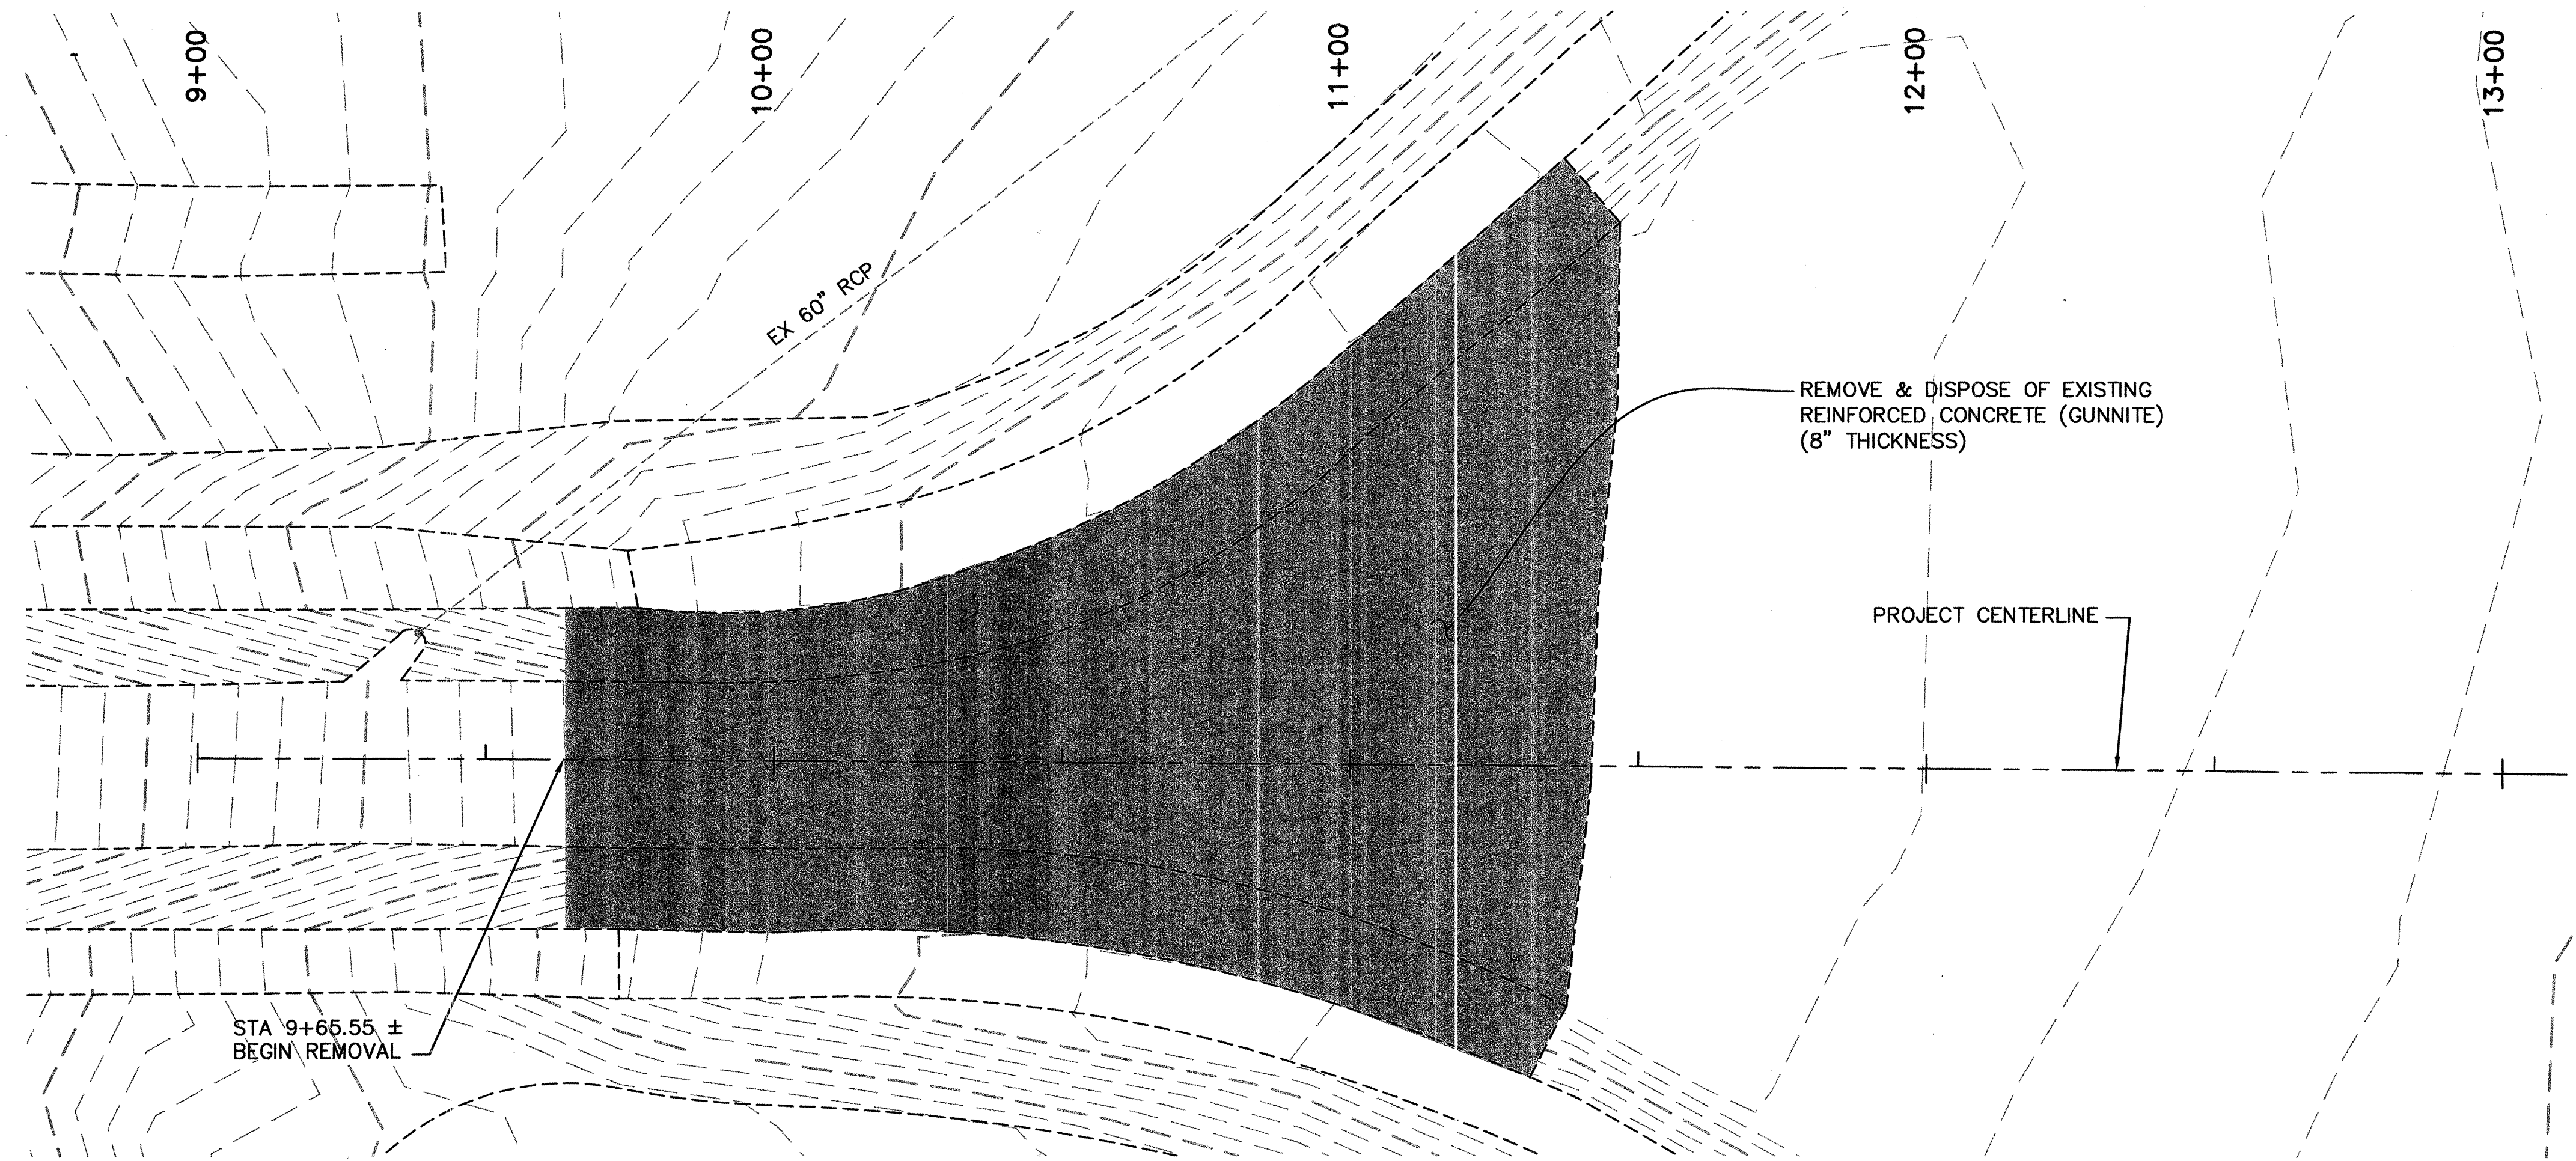

**REMOVAL PLAN EAST END OF CHANNEL**

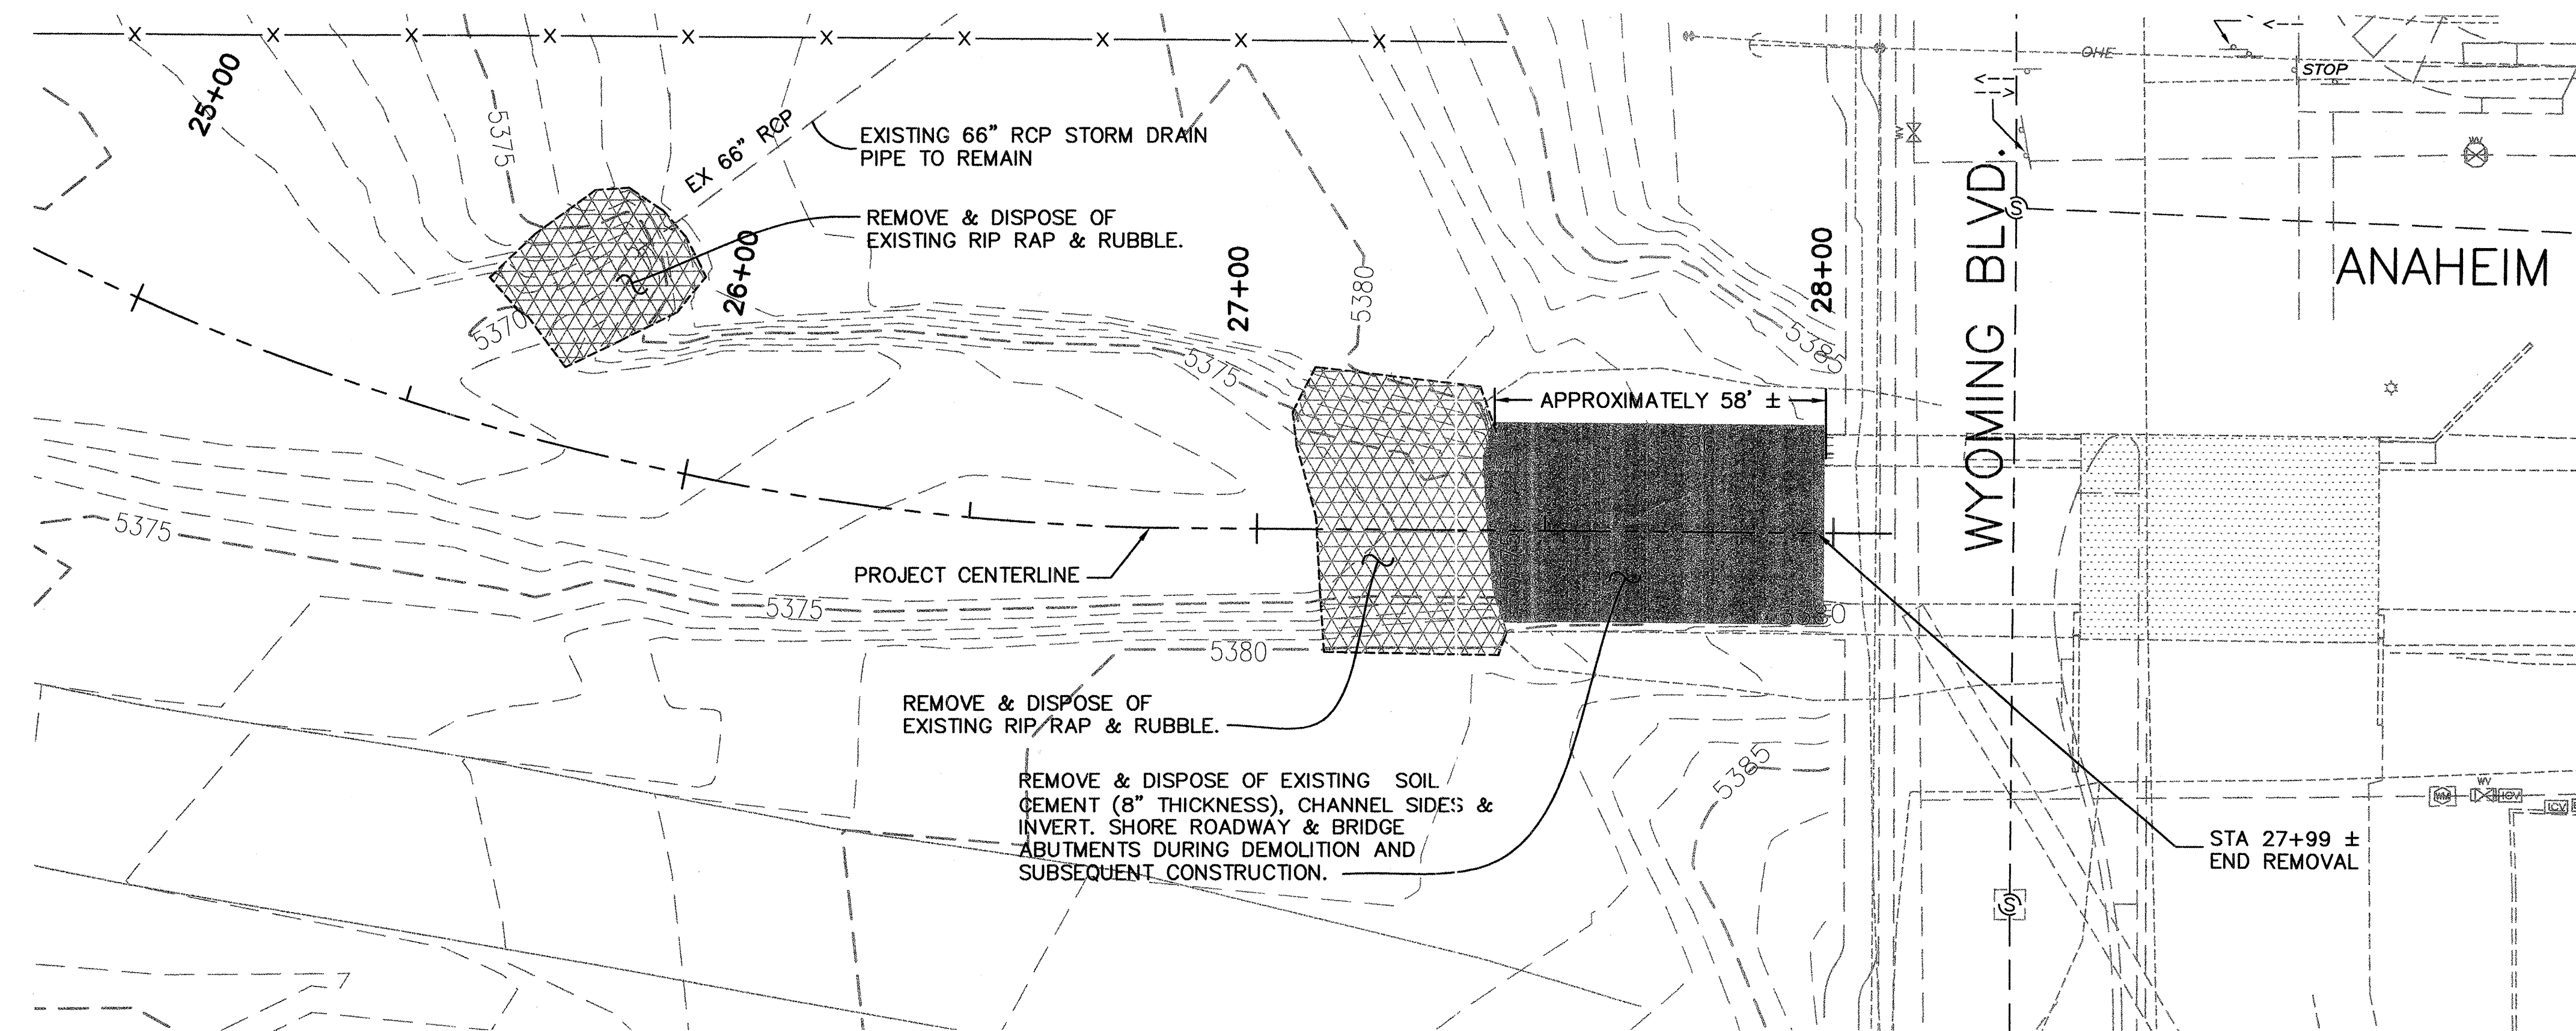

**REMOVAL PLAN WEST END OF CHANNEL**


**GENERAL NOTES:**

1. PROVIDE FULL DEPTH SAW CUT ALONG LINE OF REMOVAL OF REINFORCED CONCRETE (GUNNITE).

SURVEY INFORMATION		FIELD NOTES	
NO.	BY	NO.	BY

**ENGINEER'S SEAL**

NO.	DATE	REVISIONS	BY

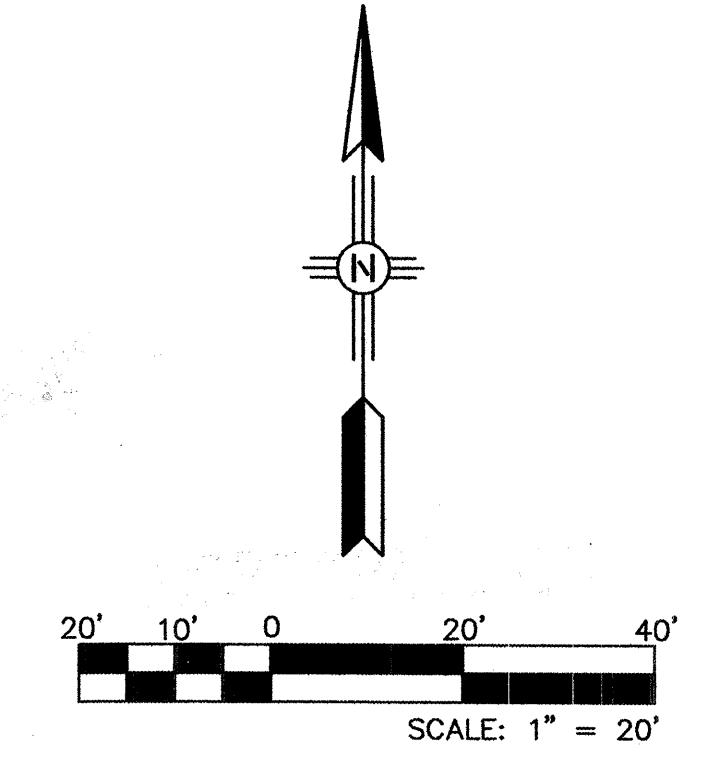



**Smith Engineering Company**  
 102035B  
 A Full Service Engineering Company  
 2001 San Pedro Boulevard, N.E., Reg. #4, Suite 200 Albuquerque, New Mexico 87110

**CITY OF ALBUQUERQUE**  
 DEPARTMENT OF MUNICIPAL DEVELOPMENT


**TITLE:**  
 NORTH DOMINGO BACA PARK  
 PHASE 4 CONSTRUCTION - BOX CULVERT  
 REMOVAL PLAN

Design Review Committee	City Engineer Approval	No. / Day / Yr.	No. / Day / Yr.

City Project No. **7138.92**      Zone Map No. **C-19**      Sheet **4** of **14**

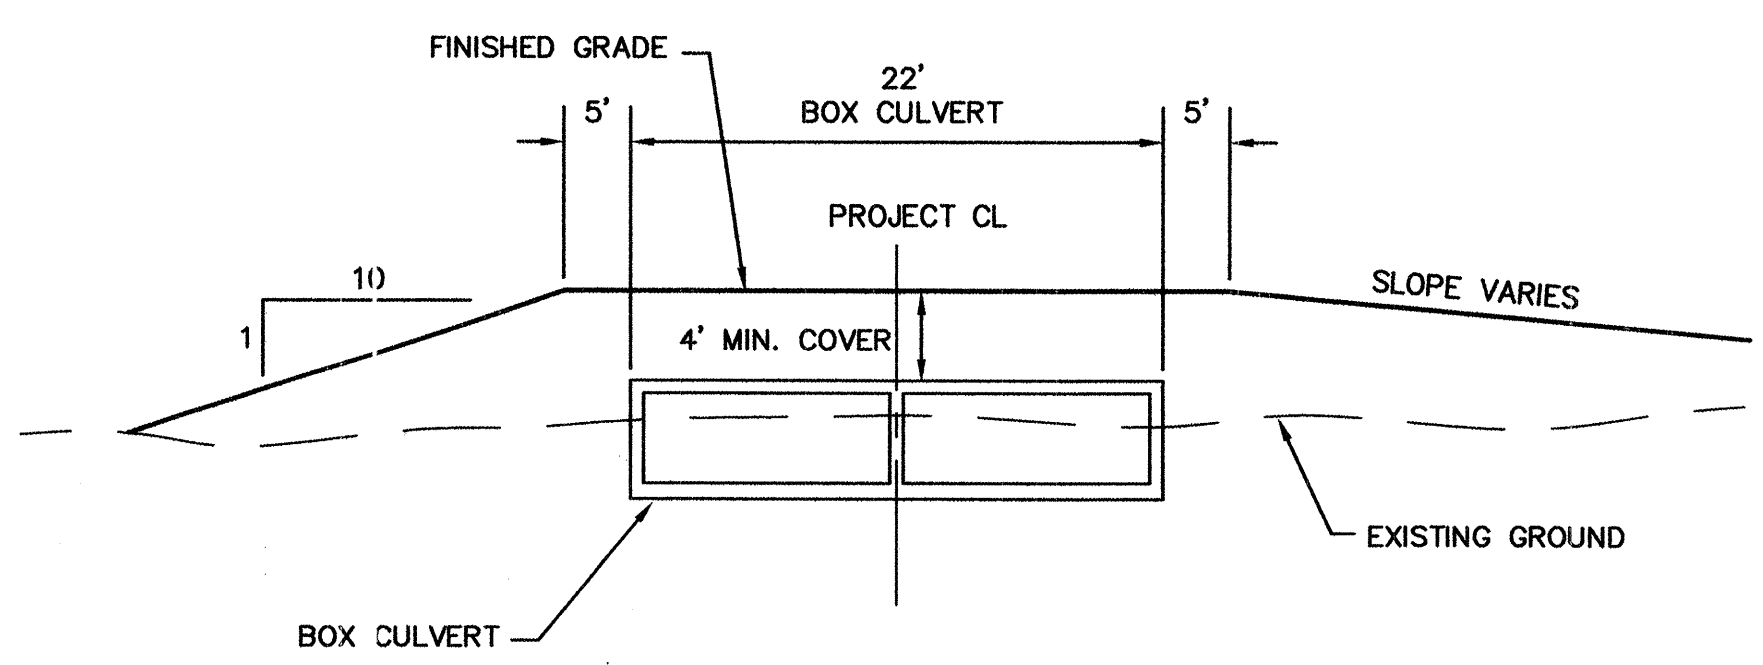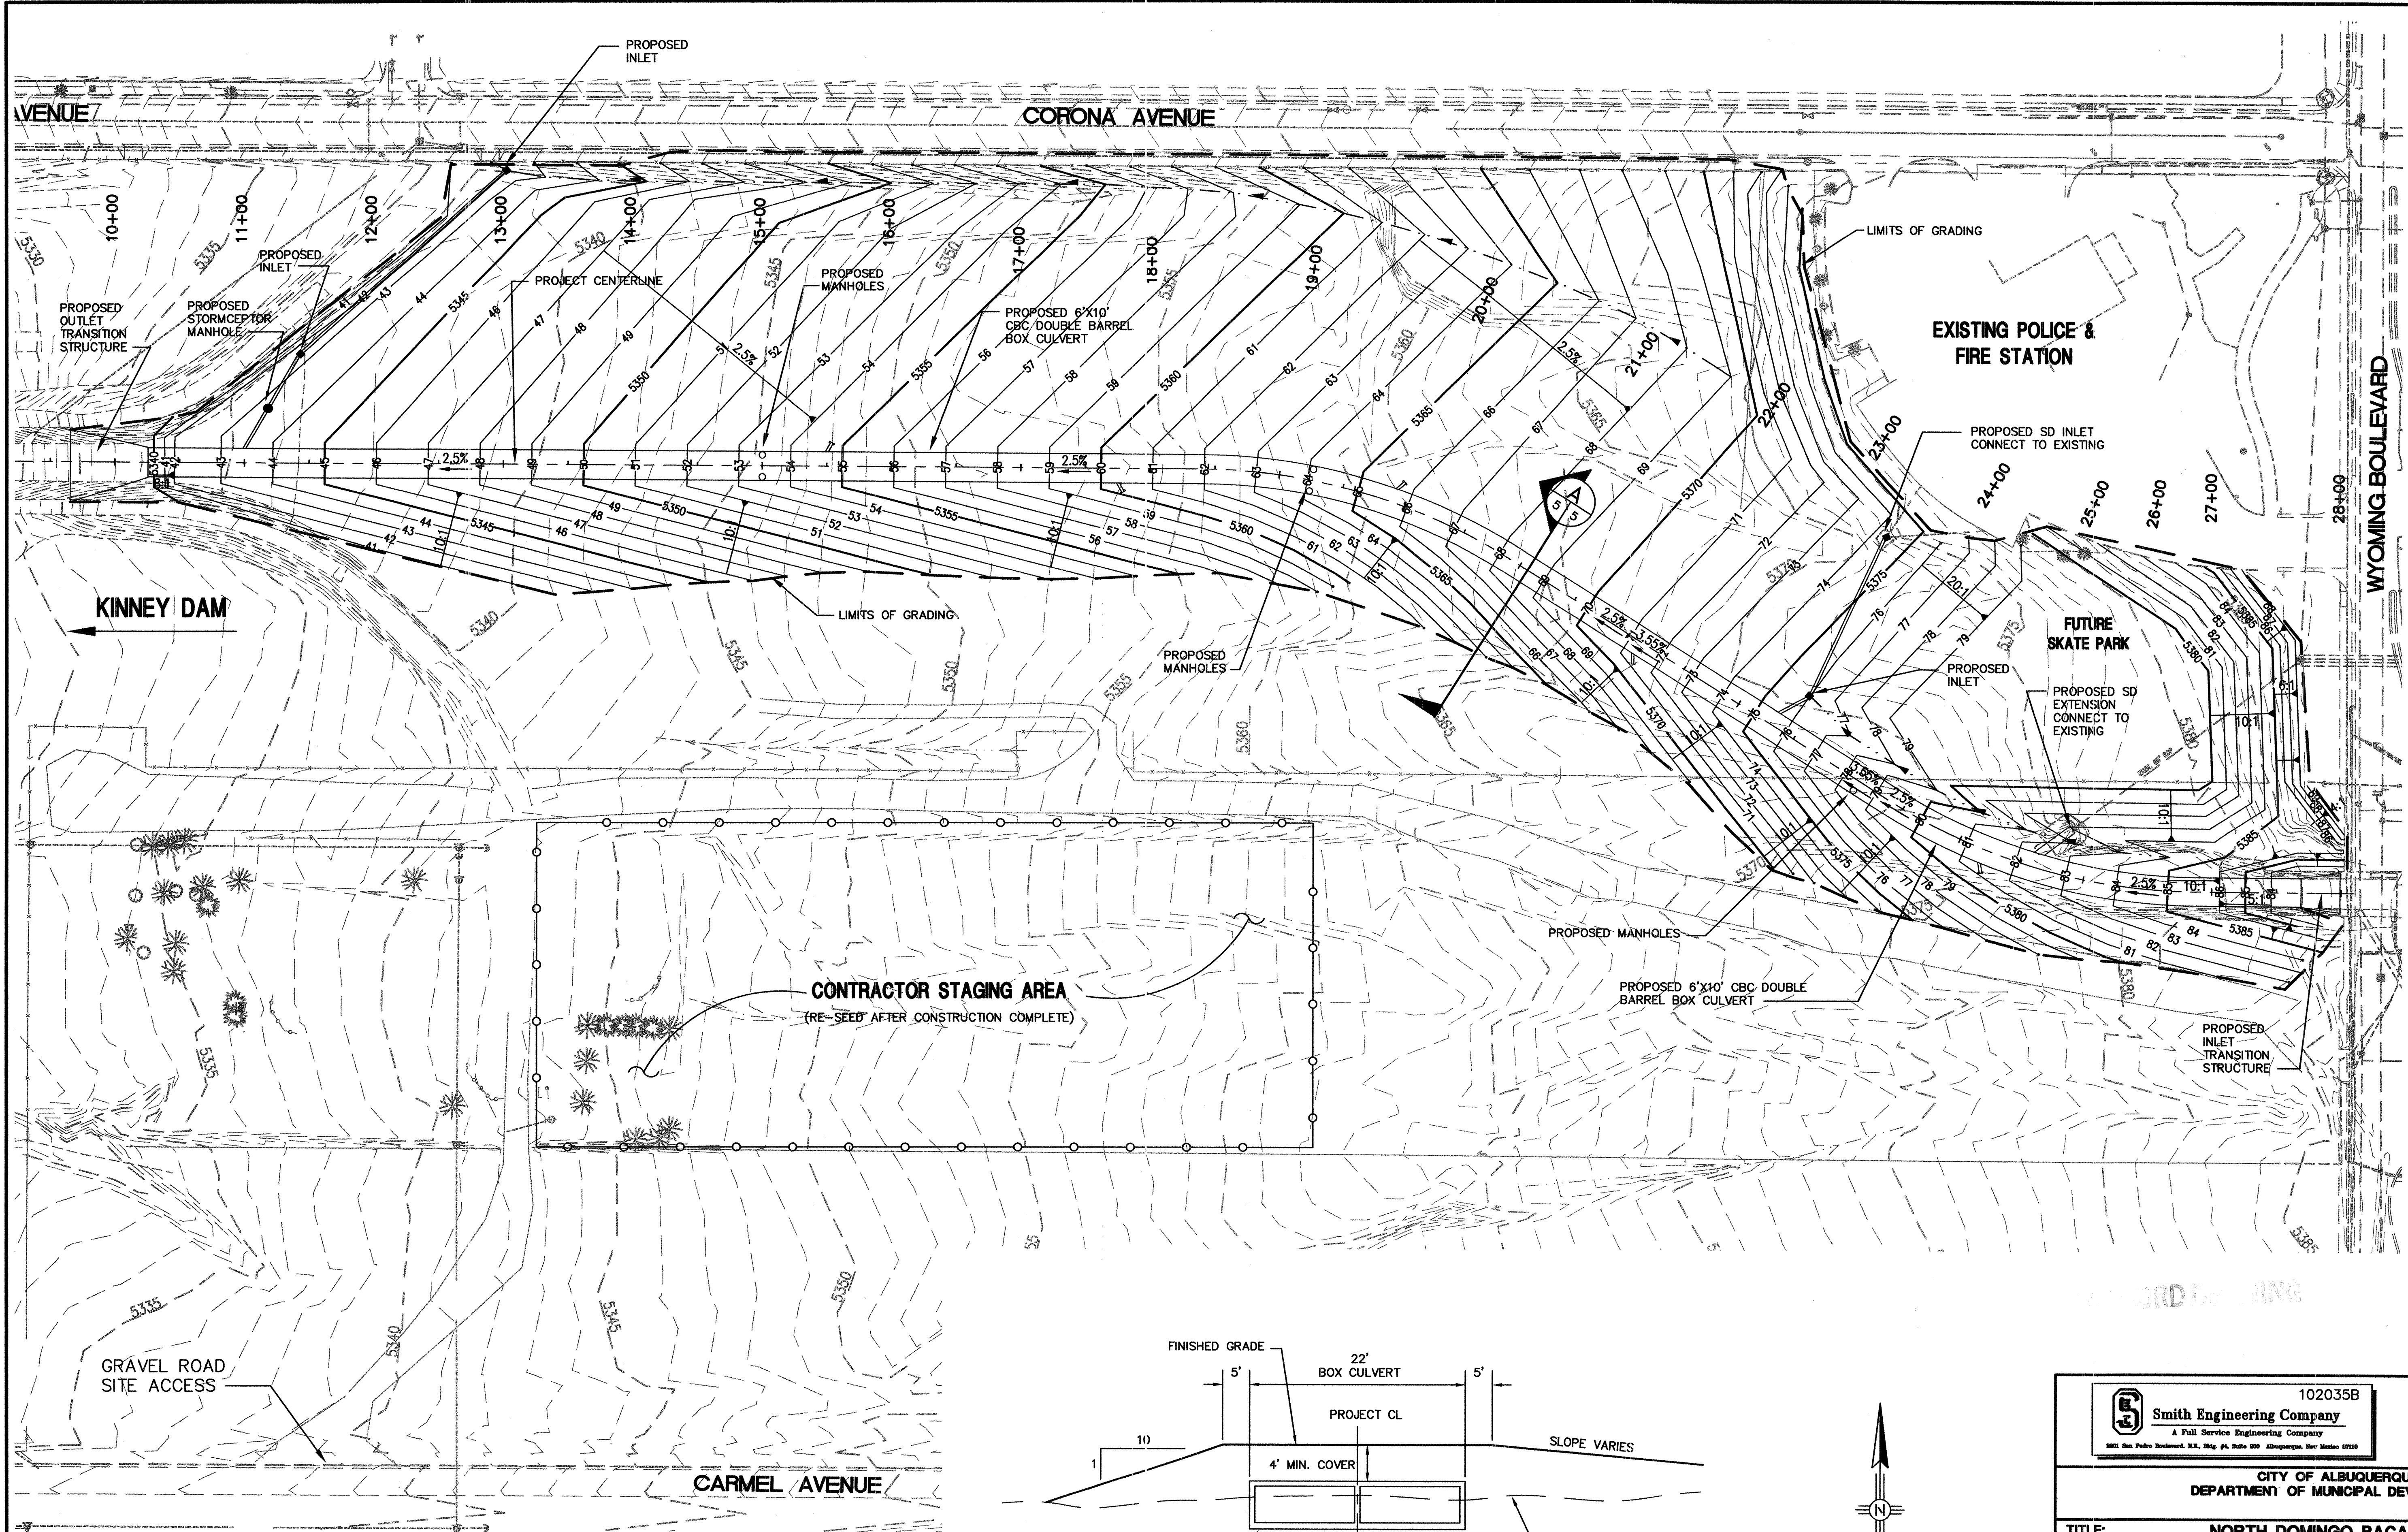

**TYPICAL GRADING SECTION (A)**  
N.T.S.

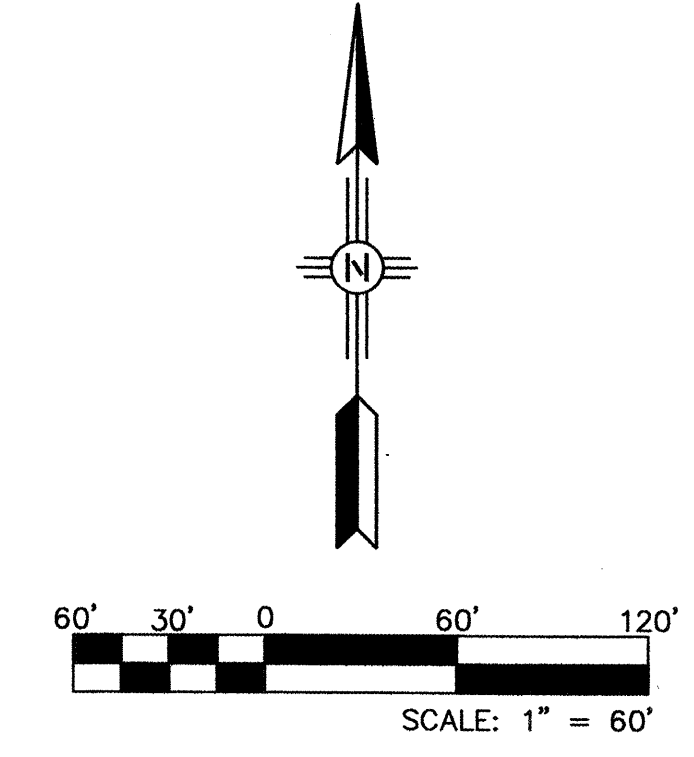

102035B  
**Smith Engineering Company**  
 A Full Service Engineering Company  
2001 San Pedro Boulevard, N.E., Stop #4, Suite 200 Albuquerque, New Mexico 87102


CITY OF ALBUQUERQUE  
 DEPARTMENT OF MUNICIPAL DEVELOPMENT

**TITLE:** NORTH DOMINGO BACA PARK  
 PHASE 4 CONSTRUCTION - BOX CULVERT  
 GRADING & DRAINAGE PLAN

Design Review Committee	City Engineer Approval	No. / Day / Yr.	No. / Day / Yr.
Last Design Update			

City Project No. **7138.92** Zone Map No. **C-19** Sheet **5** of **14**

AS BUILT INFORMATION		BENCH MARKS		SURVEY INFORMATION		ENGINEER'S SEAL		
CONTRACTOR	SALLS	DATE	3/07	NO.			DESIGNED BY	GN
STARTED BY	C.S.	DATE	3/07	BY			DATE	JULY 2005
APPROVED BY	COA	DATE	3/07	REVISIONS			DRAWN BY	KSH
FIELD NOTES BY	C.S.	DATE	3/07	DESIGN			CHECKED BY	GN
ORGANIZED BY	SEC	DATE	3/07					
CORRECTED BY	SEC	DATE	3/07					
RECORDED BY		DATE						

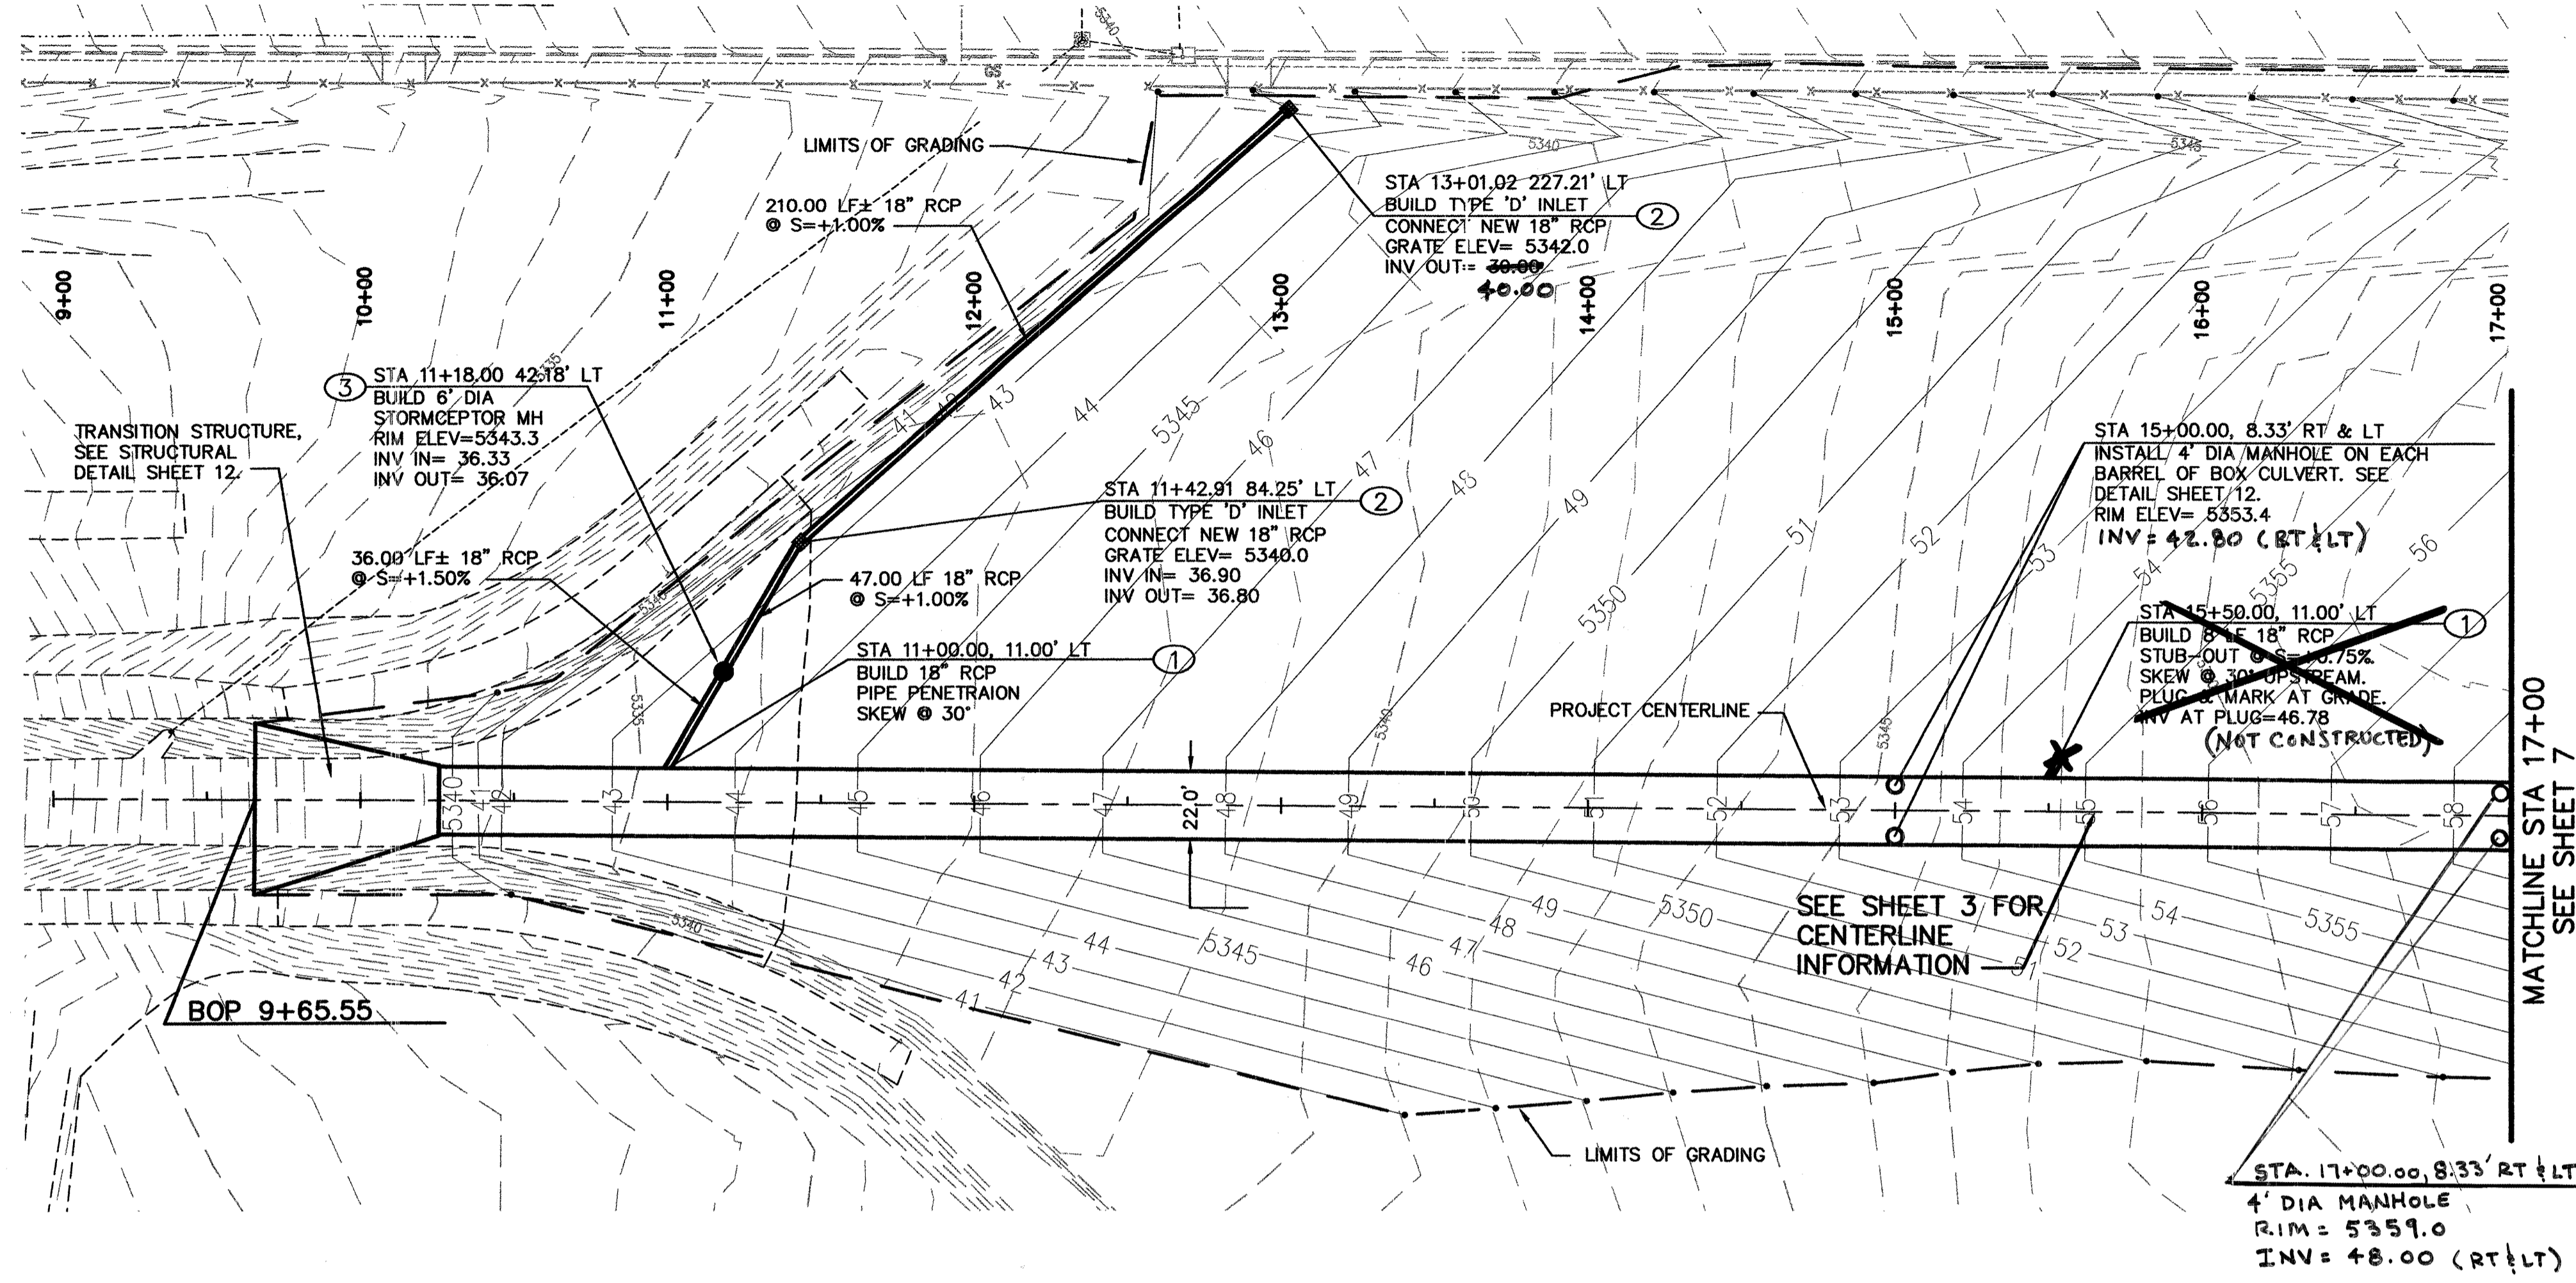


**GENERAL NOTES:**

- ALL CONCRETE PIPES LARGER THAN 24" SHALL BE CLASS IV.

**KEYED NOTES:** ○

- 18" PIPE PENETRATION. SEE PIPE PENETRATION DETAIL SHEET 12.
- BUILD TYPE 'D' INLET PER COA STD DWG #2206.
- BUILD 6' DIA STORMCEPTOR MANHOLE. CSR HYDRO CONDUIT, STC 900 PRECAST CONCRETE STORMCEPTOR, (900 GAL. CAPACITY) OR ACCEPTED EQUAL.

AS BUILT INFORMATION	
CONTRACTOR	S&B & B Co.
WORK STARTED BY	C.S.
DATE	3/07
APPROVED BY	C.O.A.
DATE	3/07
FIELD CHECKED BY	C.S.
DATE	3/07
DRAWINGS CORRECTED BY	S.E.C.
DATE	3/07
MICRO-FILM INFORMATION	
RECORDED BY	
DATE	
NO.	

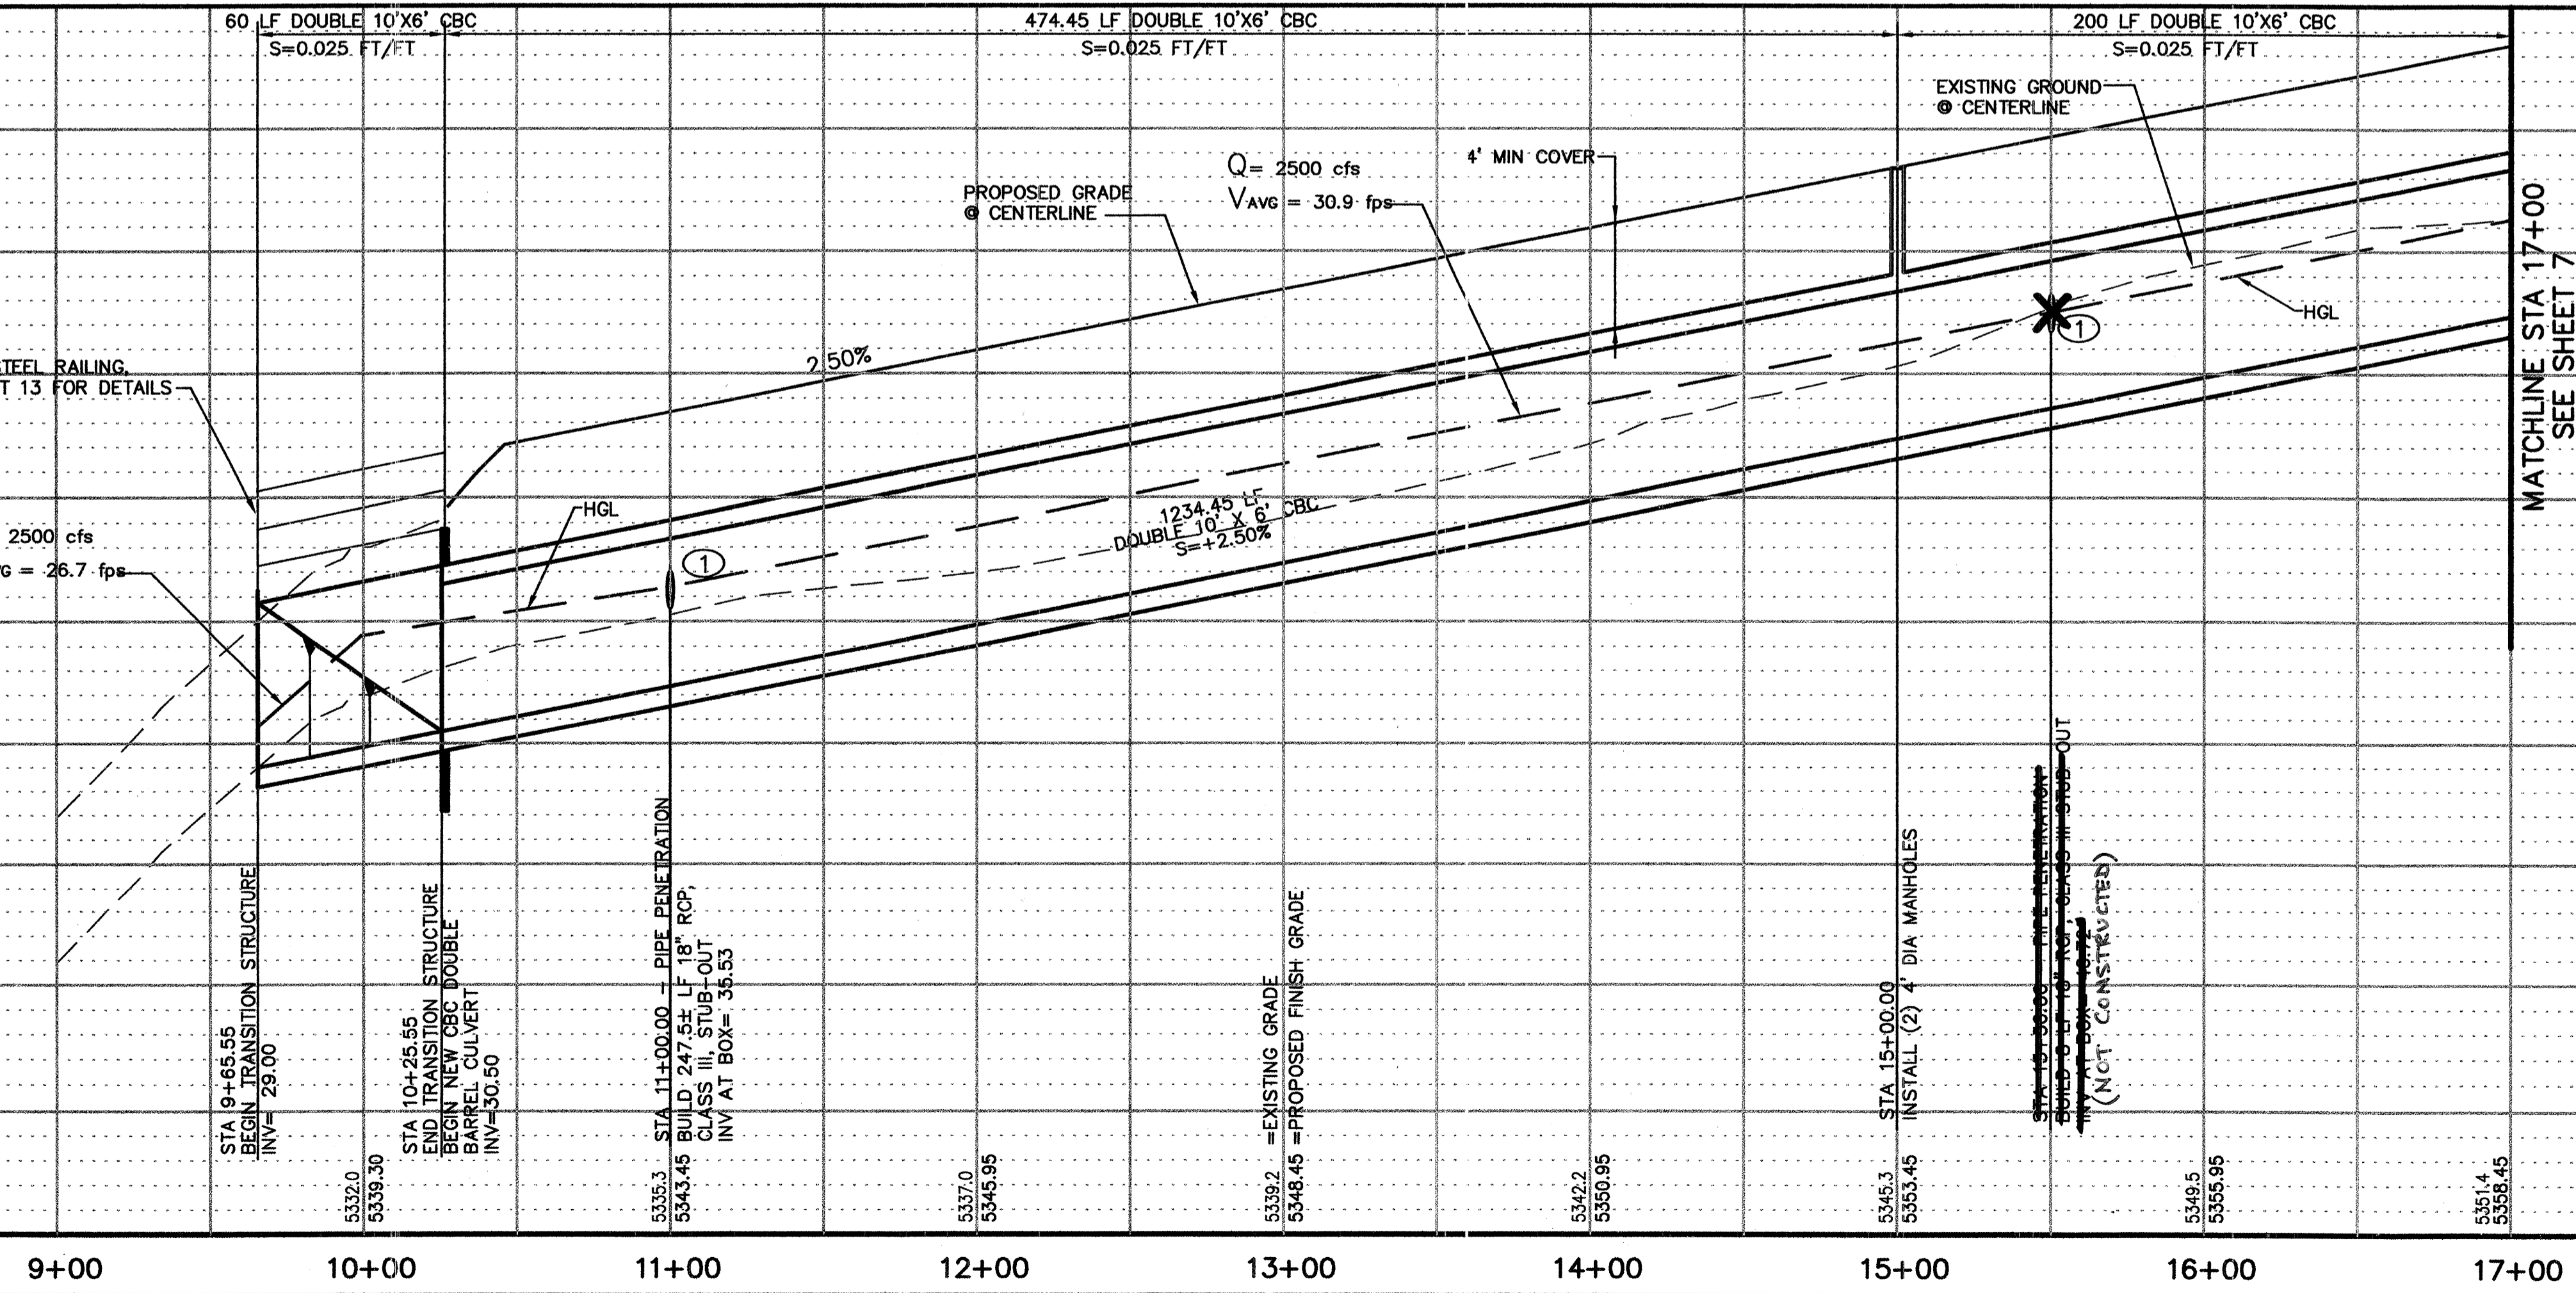

**ENGINEER'S SEAL**

**REVISIONS**

NO.	DATE	REVISIONS	BY
		DESIGN	

DESIGNED BY: GN  
DRAWN BY: KSH  
CHECKED BY: GN

DATE: JULY 2005  
DATE: JULY 2005  
DATE: JULY 2005


SCALE: 1" = 40'  
SCALE: 1" = 5'

102035B  
**Smith Engineering Company**  
A Full Service Engineering Company  
2001 San Pedro Boulevard, S.E., 10th Fl., Suite 200, Albuquerque, New Mexico 87102

**CITY OF ALBUQUERQUE**  
**DEPARTMENT OF MUNICIPAL DEVELOPMENT**

TITLE: **NORTH DOMINGO BACA PARK**  
**PHASE 4 CONSTRUCTION - BOX CULVERT**  
**CBC PLAN & PROFILE: STA 9+65.55 TO 17+00**

City Project No. **7138.92**      Zone Map No. **C-19**      Sheet **6** of **14**

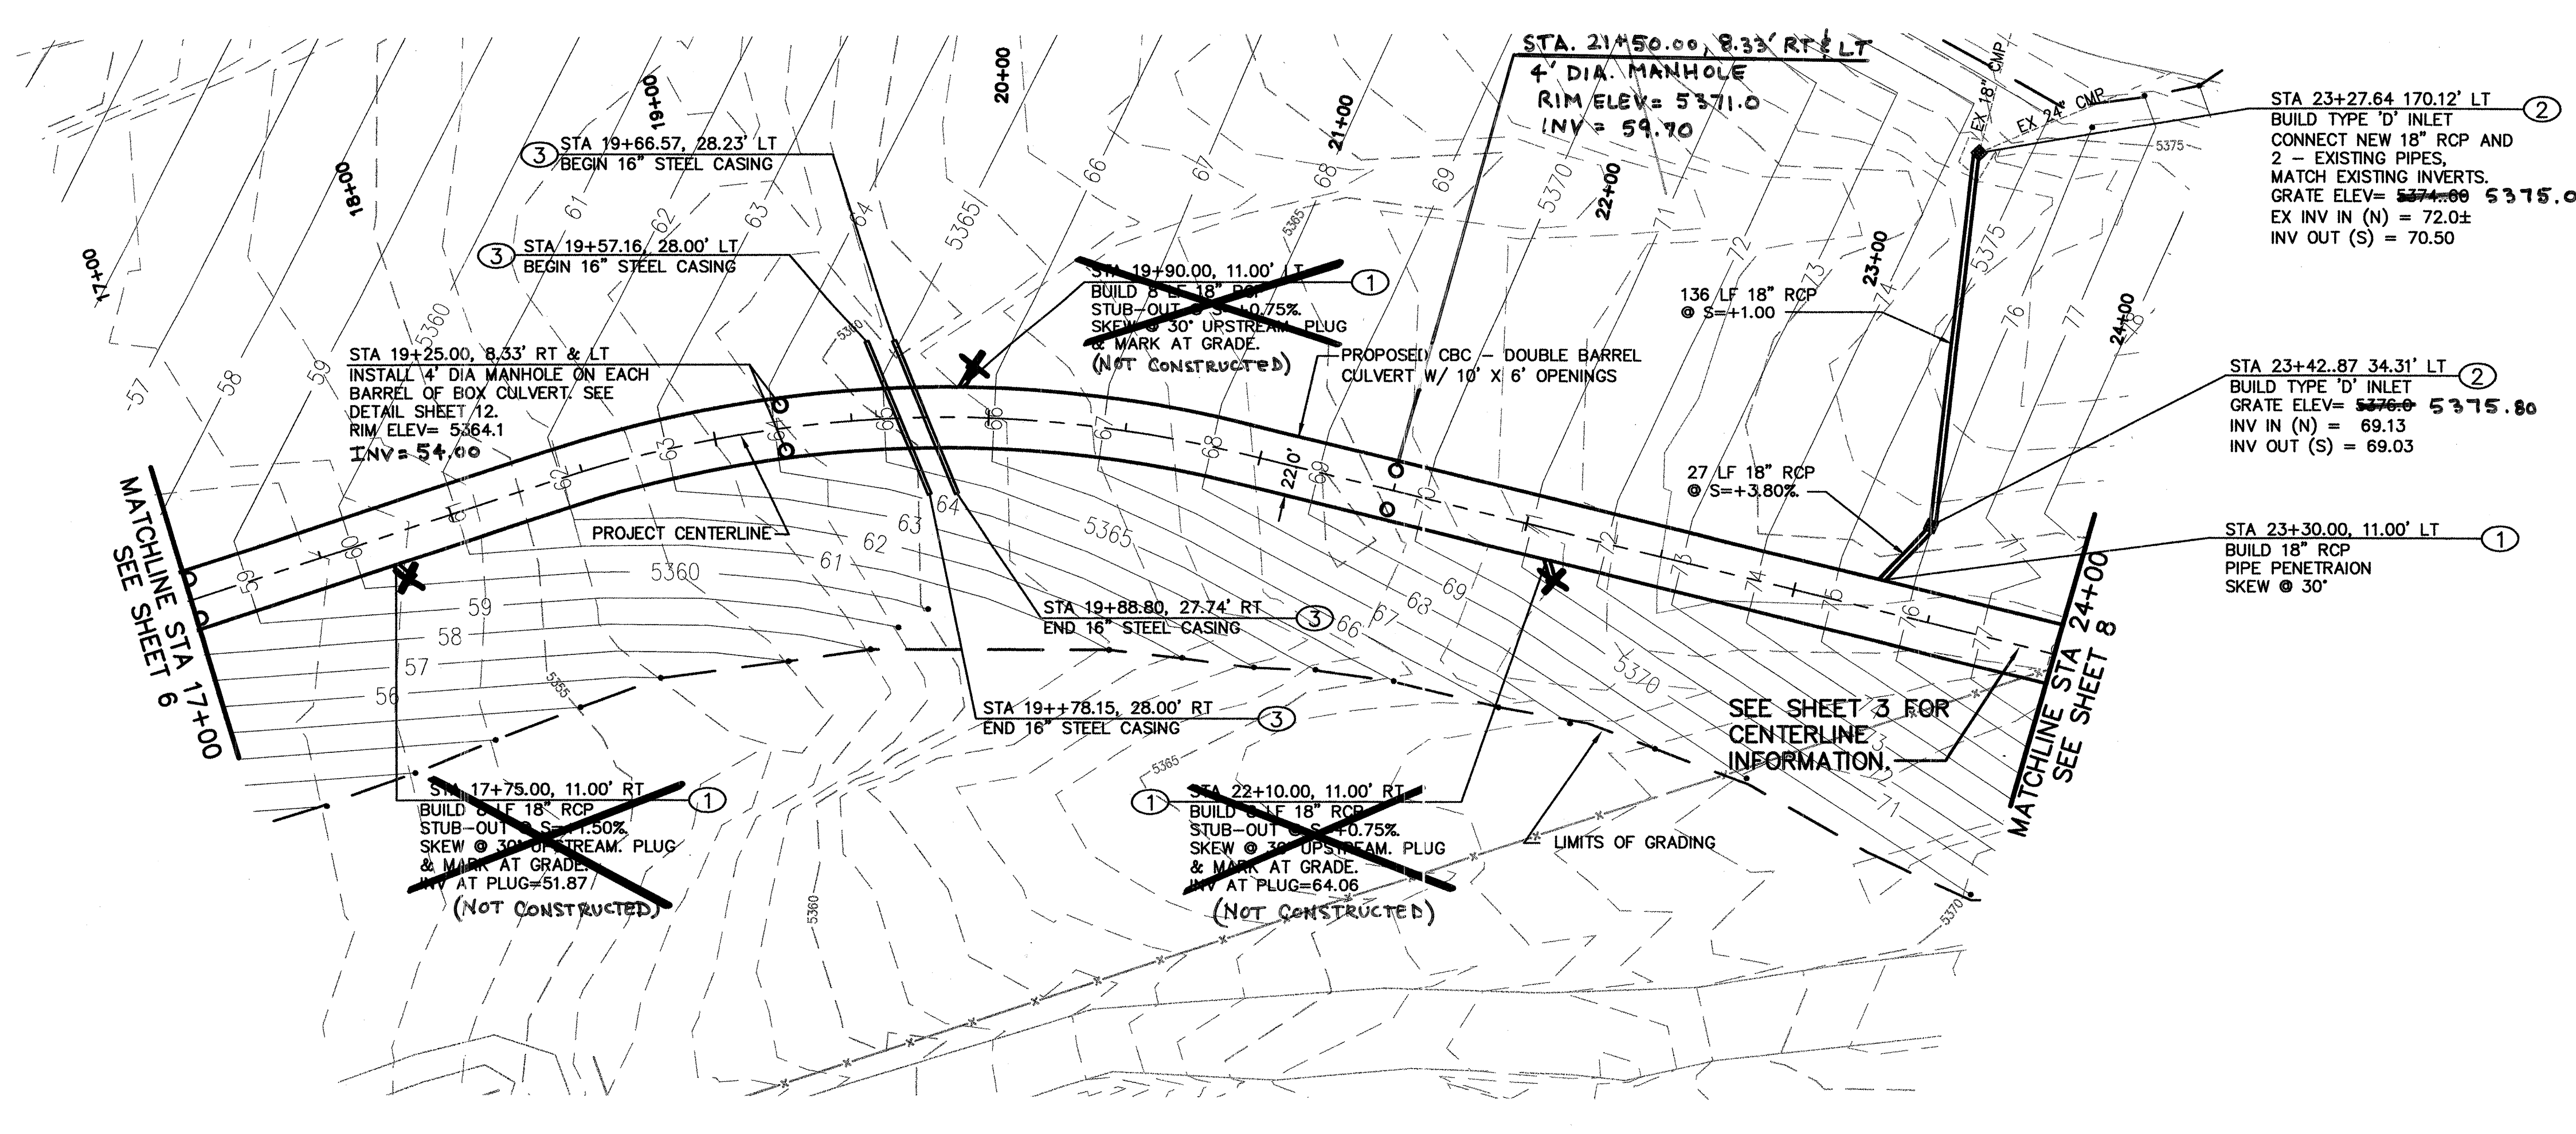


**GENERAL NOTES:**

- ALL CONCRETE PIPE LARGER THAN 24" SHALL BE CLASS IV.

**KEYED NOTES:** ○

- 18" PIPE PENETRATION. SEE PIPE PENETRATION DETAIL SHEET 12.
- BUILD TYPE 'D' INLET PER COA STD DWG #2206.
- CAP END AND MARK LOCATION AT GRADE.

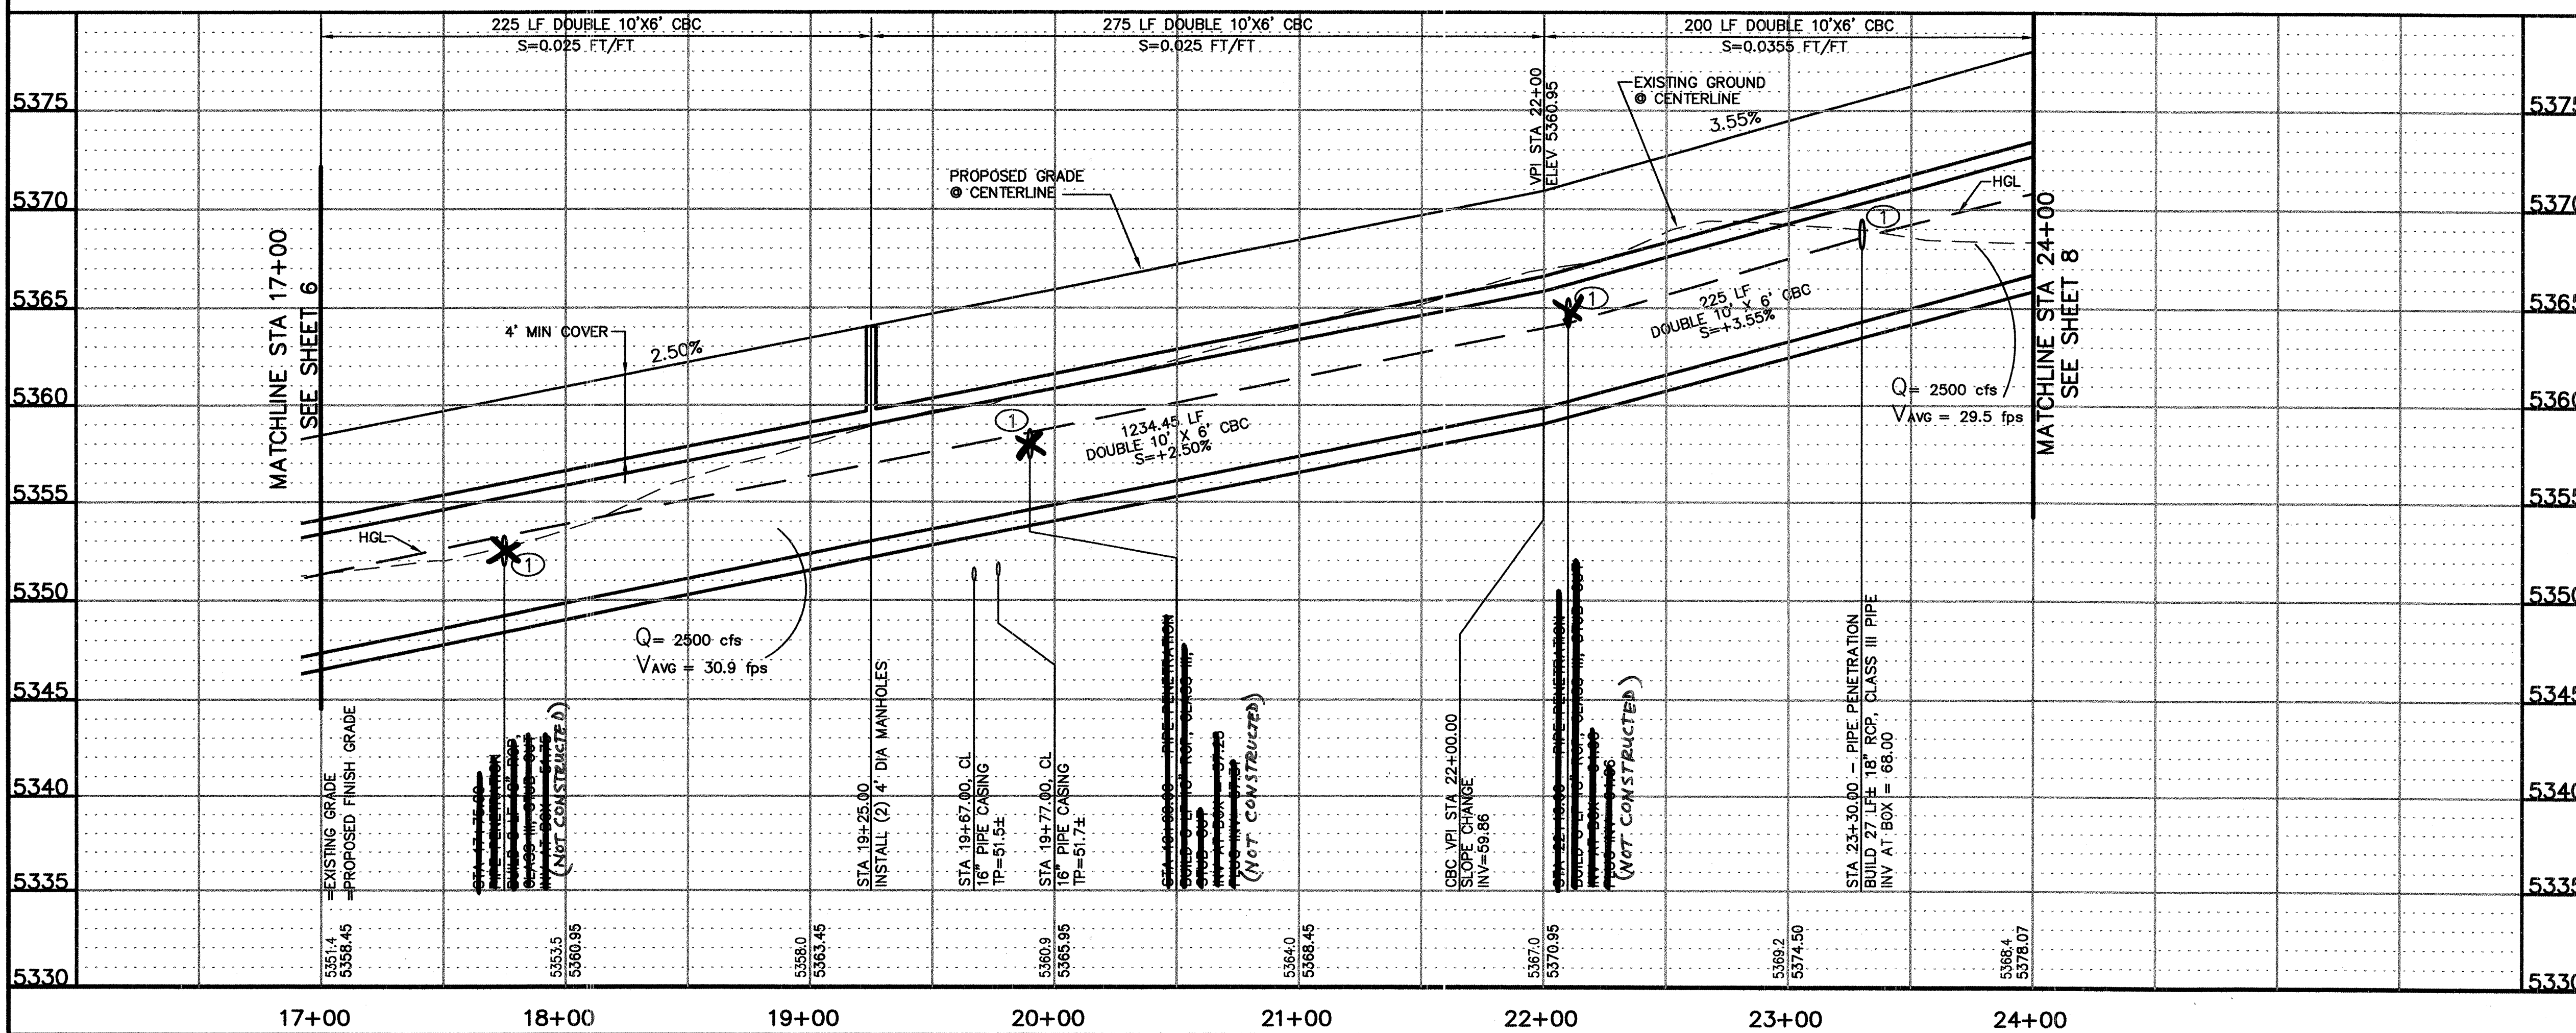

AS BUILT INFORMATION	
CONTRACTOR	Salls Bco.
WORKED BY	C.S.
DATE	3/07
BENCH MARKS	
STATION NAME	1-B20 STATE: NM; COUNTY: BERNALILLO
ESTABLISHING AGENCY	ACS STANDARD BRASS CAP
IN CONCRETE LOCATED IN THE NORTHEAST QUADRANT OF THE INTERSECTION OF BARSTOW ST. AND MODESTO AVE.	
SPIRIT LEVEL ELEVATION	= 5474.533 FT. (NGVD 29)
PLANE COORDINATES:	N = 1524092.46, E = 410237.56
SURVEY INFORMATION	
DATE	
BY	
NO.	

**ENGINEERS SEAL**

6-24-05

**REVISIONS**

NO.	DATE	REVISIONS	BY
		DESIGN	

DESIGNED BY: GN  
 DRAWN BY: KSH  
 CHECKED BY: GN

DATE: JULY 2005  
 DATE: JULY 2005  
 DATE: JULY 2005

SCALE: 1" = 5'


SCALE: 1" = 40'

**CITY OF ALBUQUERQUE**  
 DEPARTMENT OF MUNICIPAL DEVELOPMENT

**TITLE:** NORTH DOMINGO BACA PARK  
 PHASE 4 CONSTRUCTION - BOX CULVERT  
 CBC PLAN & PROFILE: STA 17+00 TO 24+00

Design Review Committee City Engineer Approval

City Project No. **7138.92** Zone Map No. **C-19** Sheet **7** Of **14**


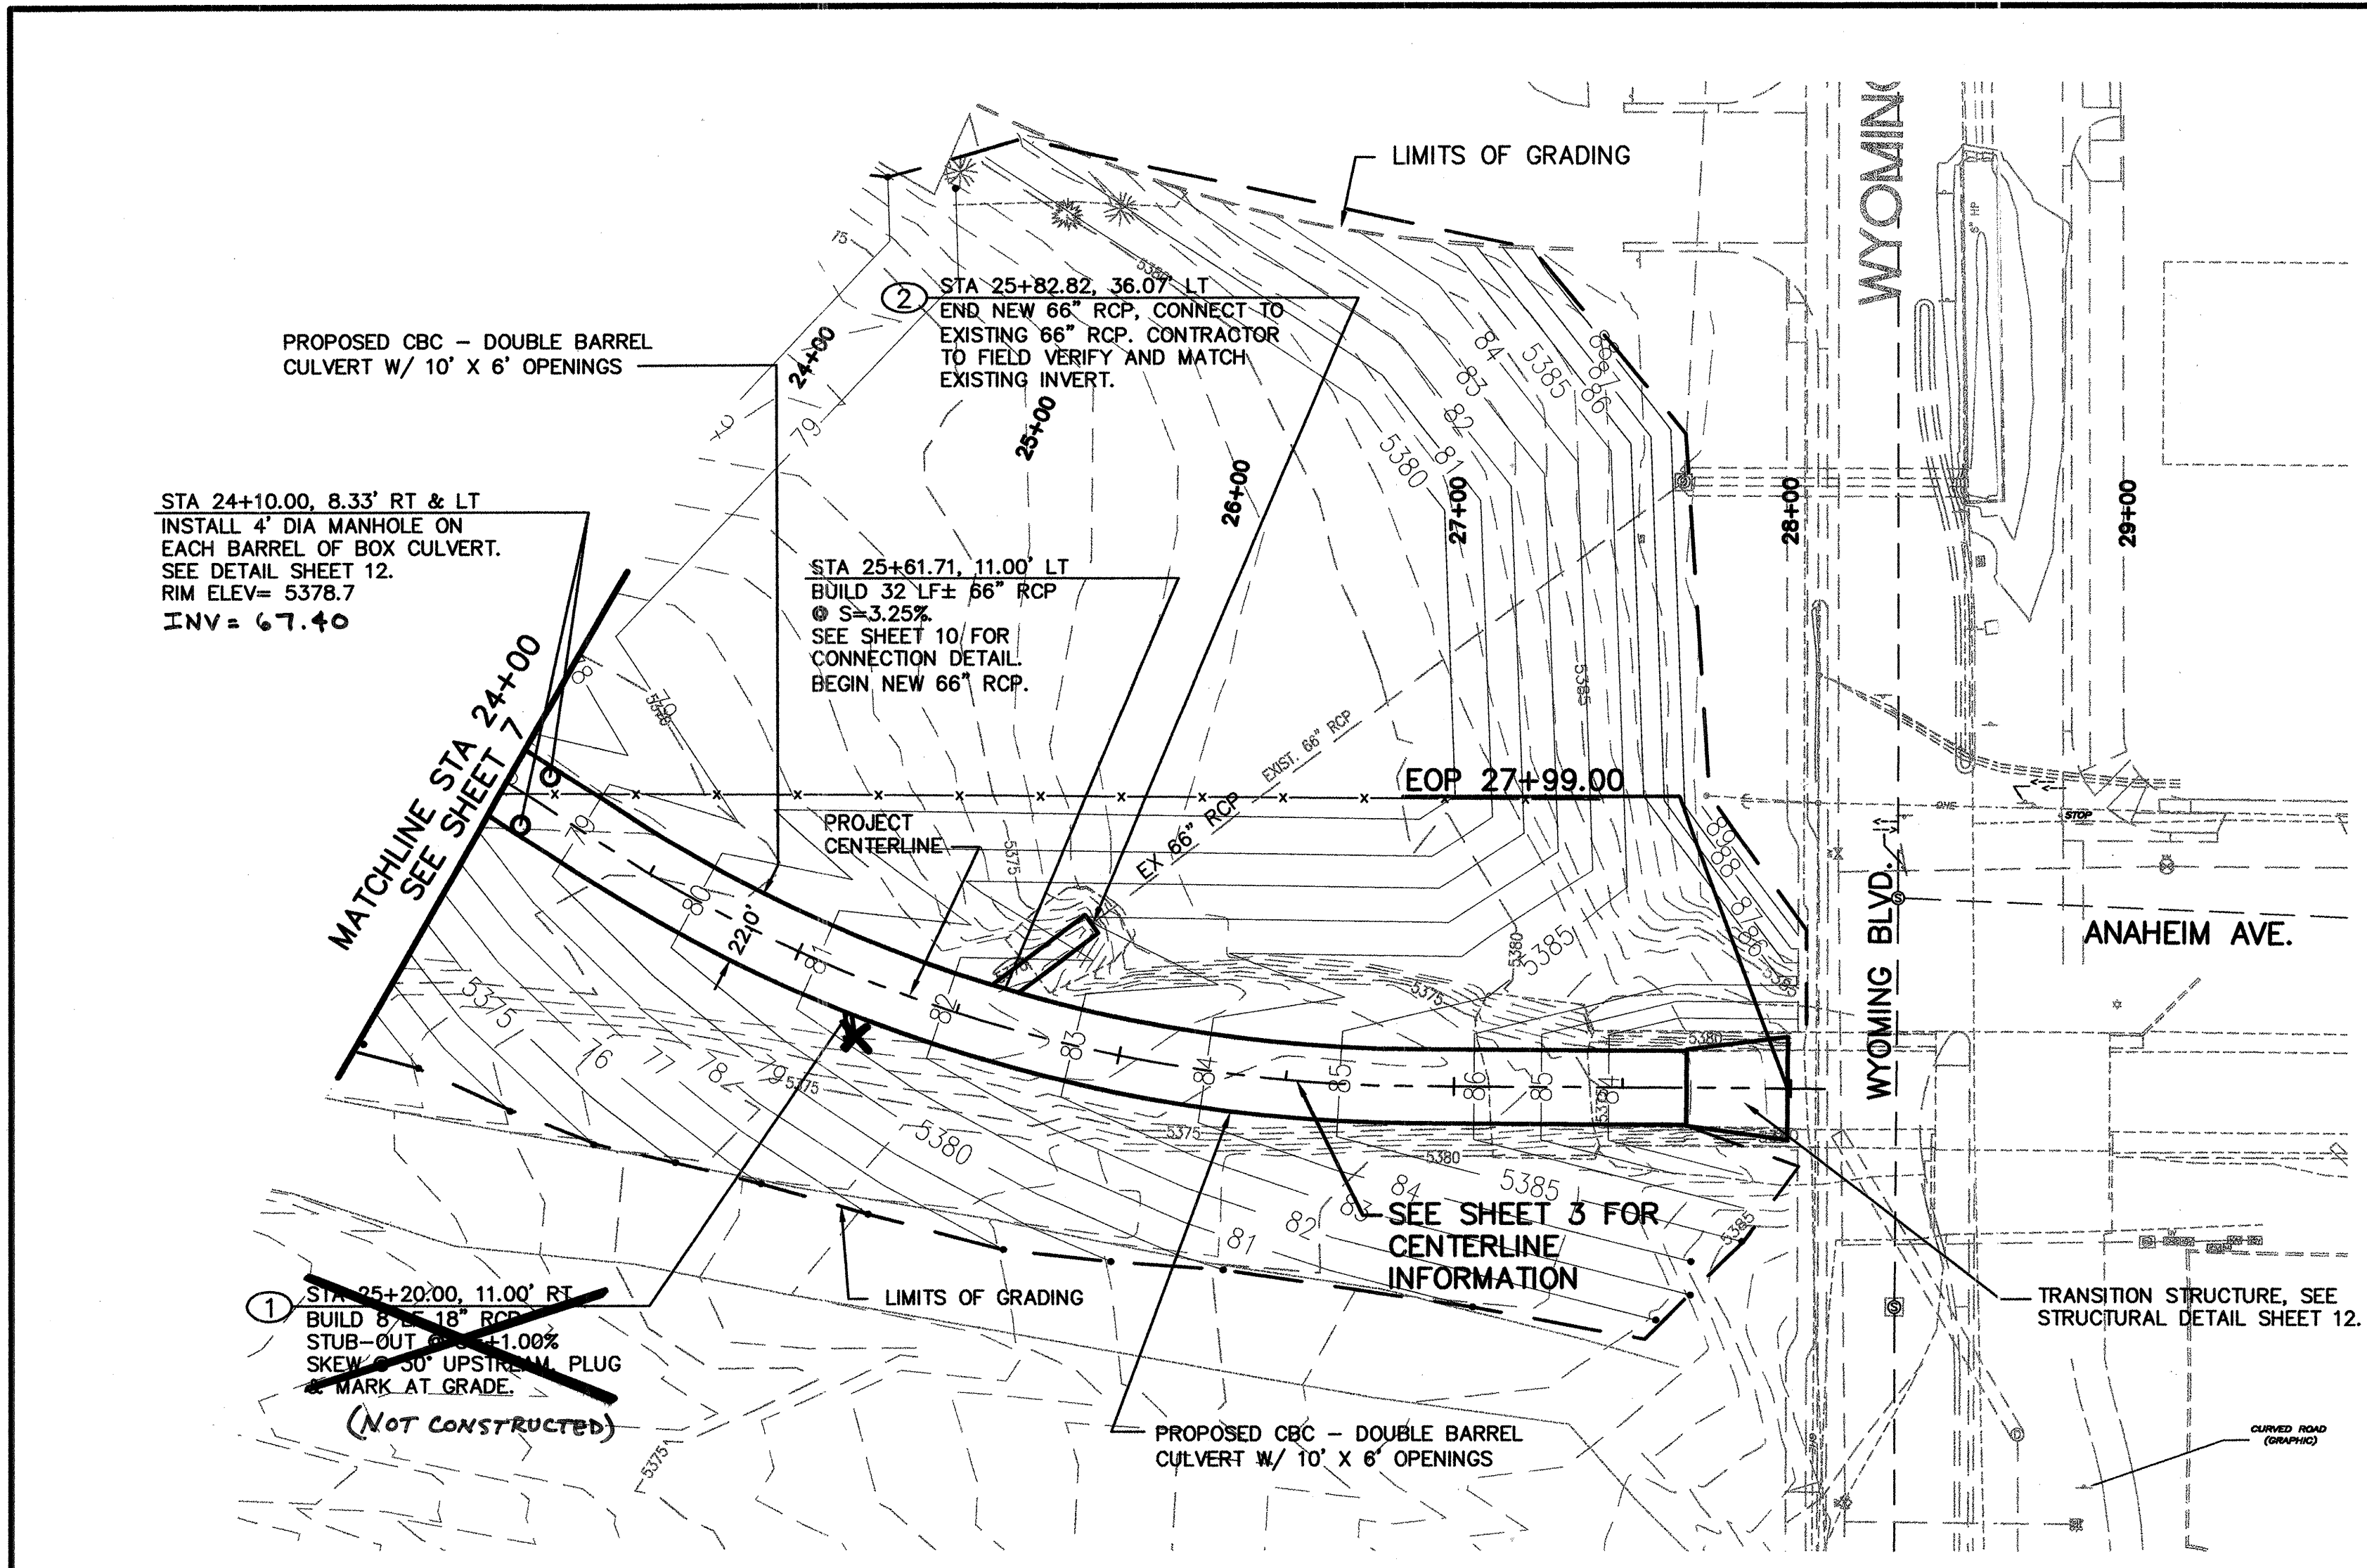


**GENERAL NOTES:**

- ALL CONCRETE PIPE LARGER THAN 24" SHALL BE CLASS IV.

**KEYED NOTES:** ○

- 18" PIPE PENETRATION. SEE 18" PIPE PENETRATION DETAIL SHEET 12.
- 66" PIPE CONNECTION. SEE 66" PIPE CONNECTION DETAIL SHEET 12.

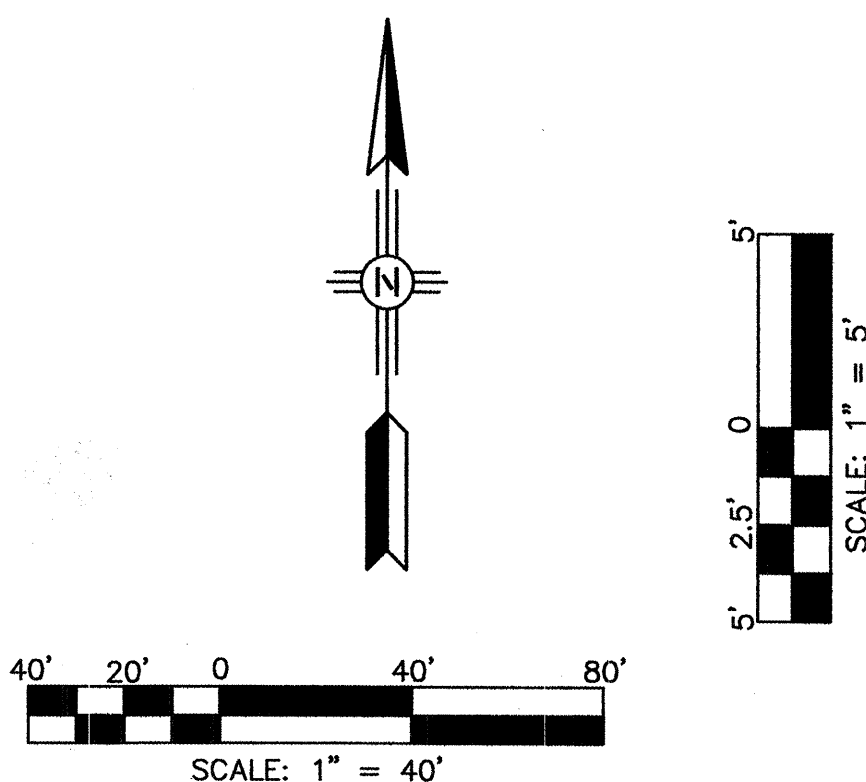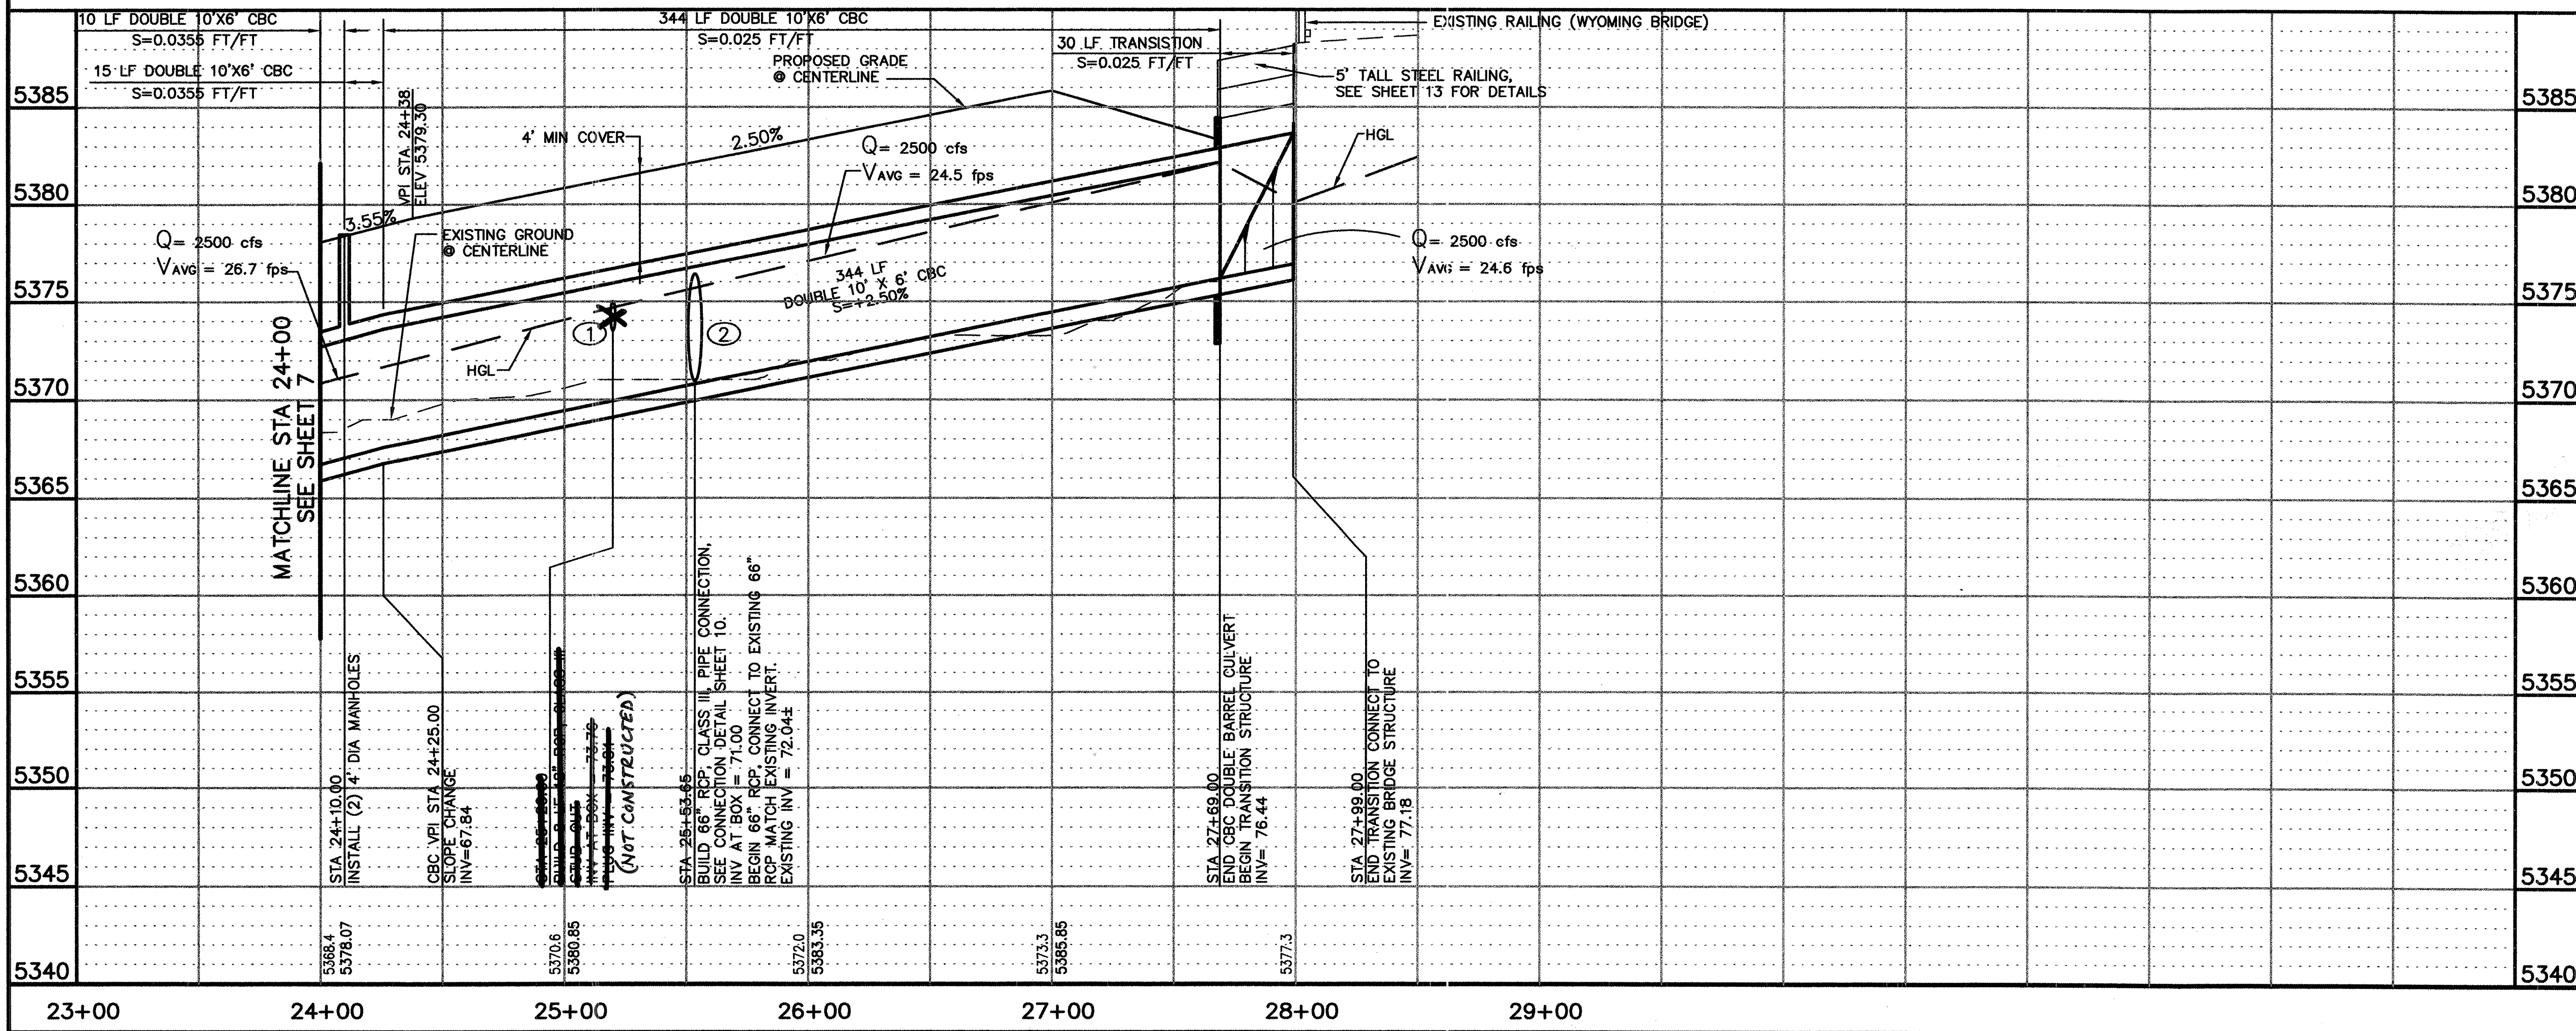

**AS-BUILT INFORMATION**

CONTRACTOR	Salls Bros.	DATE	3/07
WORKED BY	CS	DATE	3/07
ACCEPTED BY	CS	DATE	3/07
VERIFICATION BY	COA	DATE	3/07
DRAWINGS BY	SEC	DATE	3/07
RECORDED BY	MICRO-FILM INFORMATION	DATE	

**BENCH MARKS**

STATION NAME	1-B20	STATE	NM	COUNTY	BERNALILLO
ESTABLISHING AGENCY	ACS	STANDARD	BRASS CAP		
IN CONCRETE	LOCATED IN THE NORTHEAST QUADRANT				
OF THE INTERSECTION	OF BARSTOW ST. AND MODESTO AVE.				
SPIRIT LEVEL ELEVATION	= 5474.533 FT. (NSVD 29)				
PLANE COORDINATES	N = 1524092.46, E = 410237.56				

**SURVEY INFORMATION**

DATE	
BY	
NO.	

**ENGINEERS SEAL**

NO.	DATE	REMARKS	BY
		DESIGN	
		REVISIONS	
DESIGNED BY	GN	DATE	JULY 2005
DRAWN BY	KSH	DATE	JULY 2005
CHECKED BY	GN	DATE	JULY 2005


**Smith Engineering Company**  
 102035B  
 A Full Service Engineering Company  
 2000 Sun Pedro Boulevard, N.E., 2nd Fl., Suite 200 Albuquerque, New Mexico 87109

CITY OF ALBUQUERQUE  
 DEPARTMENT OF MUNICIPAL DEVELOPMENT


TITLE: **NORTH DOMINGO BACA PARK  
 PHASE 4 CONSTRUCTION - BOX CULVERT  
 CBC PLAN & PROFILE: STA 24+00 TO 27+99**

Design Review Committee	City Engineer Approval


DESIGNED BY: H.I. 10/60 CHECKED BY: R.A. 5/93  
 DETAIL BY: J.A.K. 2/93 CHECKED BY: S.J.N. 7/93  
 PLOT DATE: 12/93

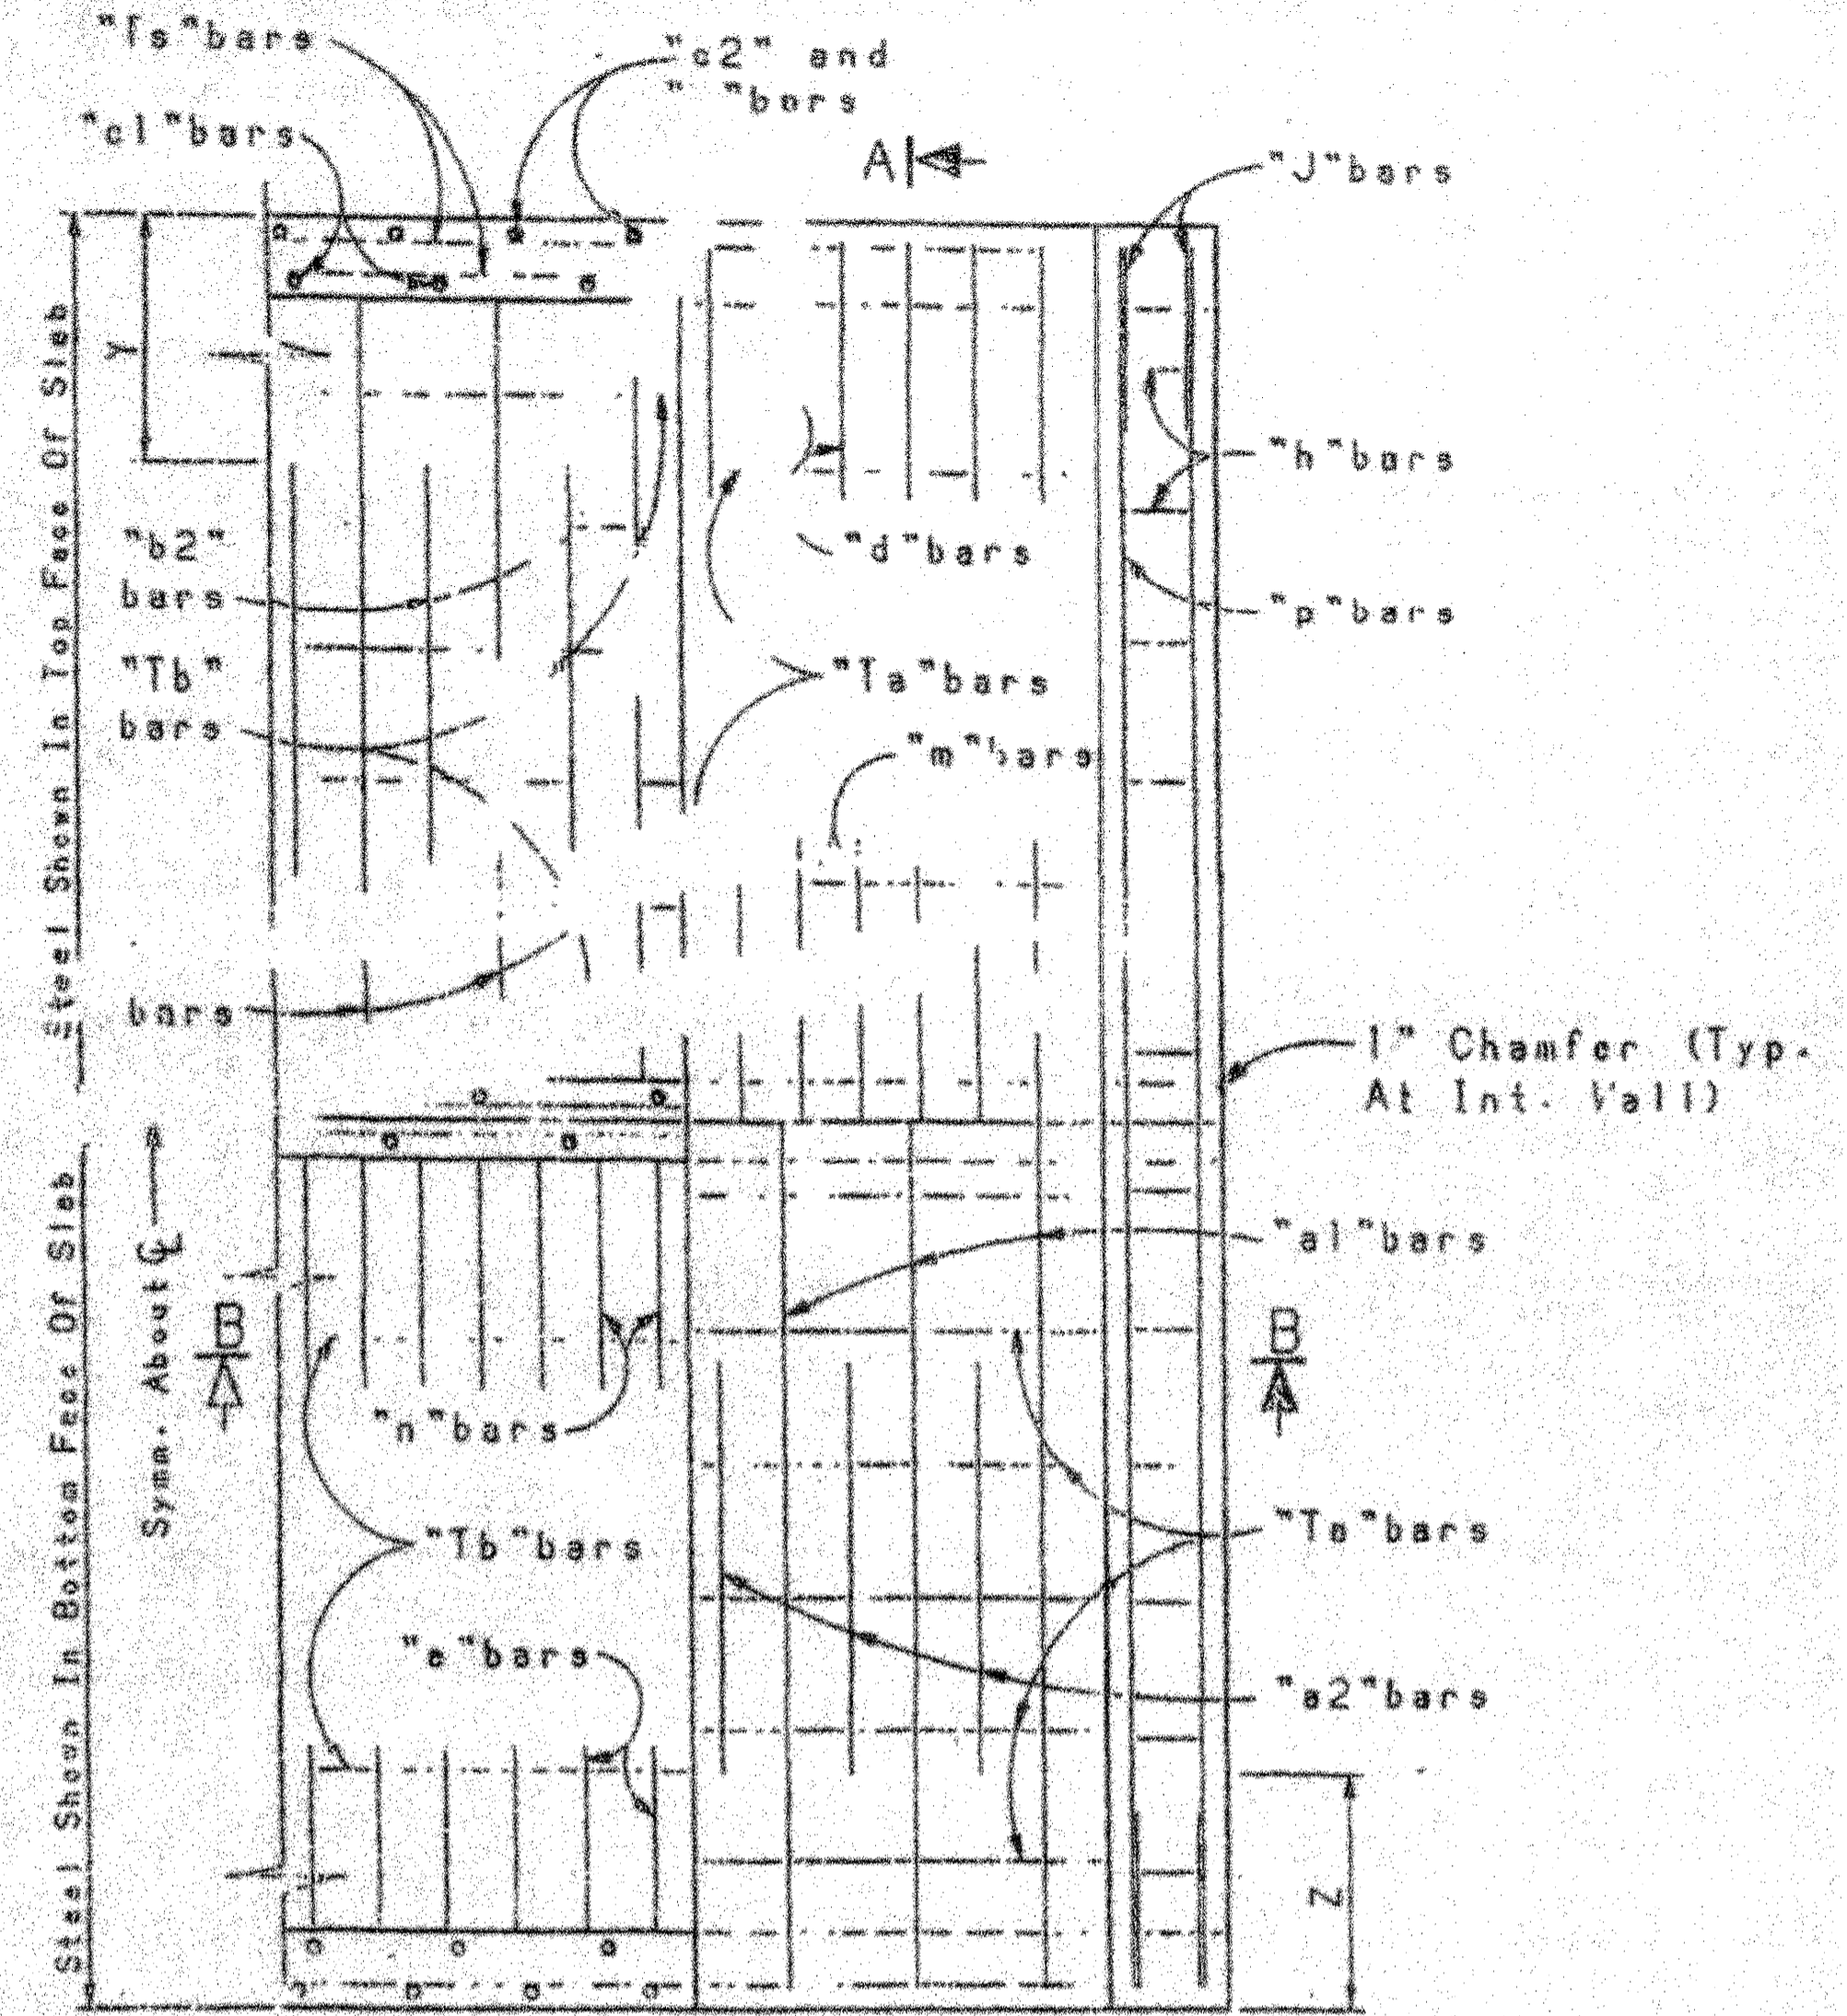

PART PLAN TOP SLAB

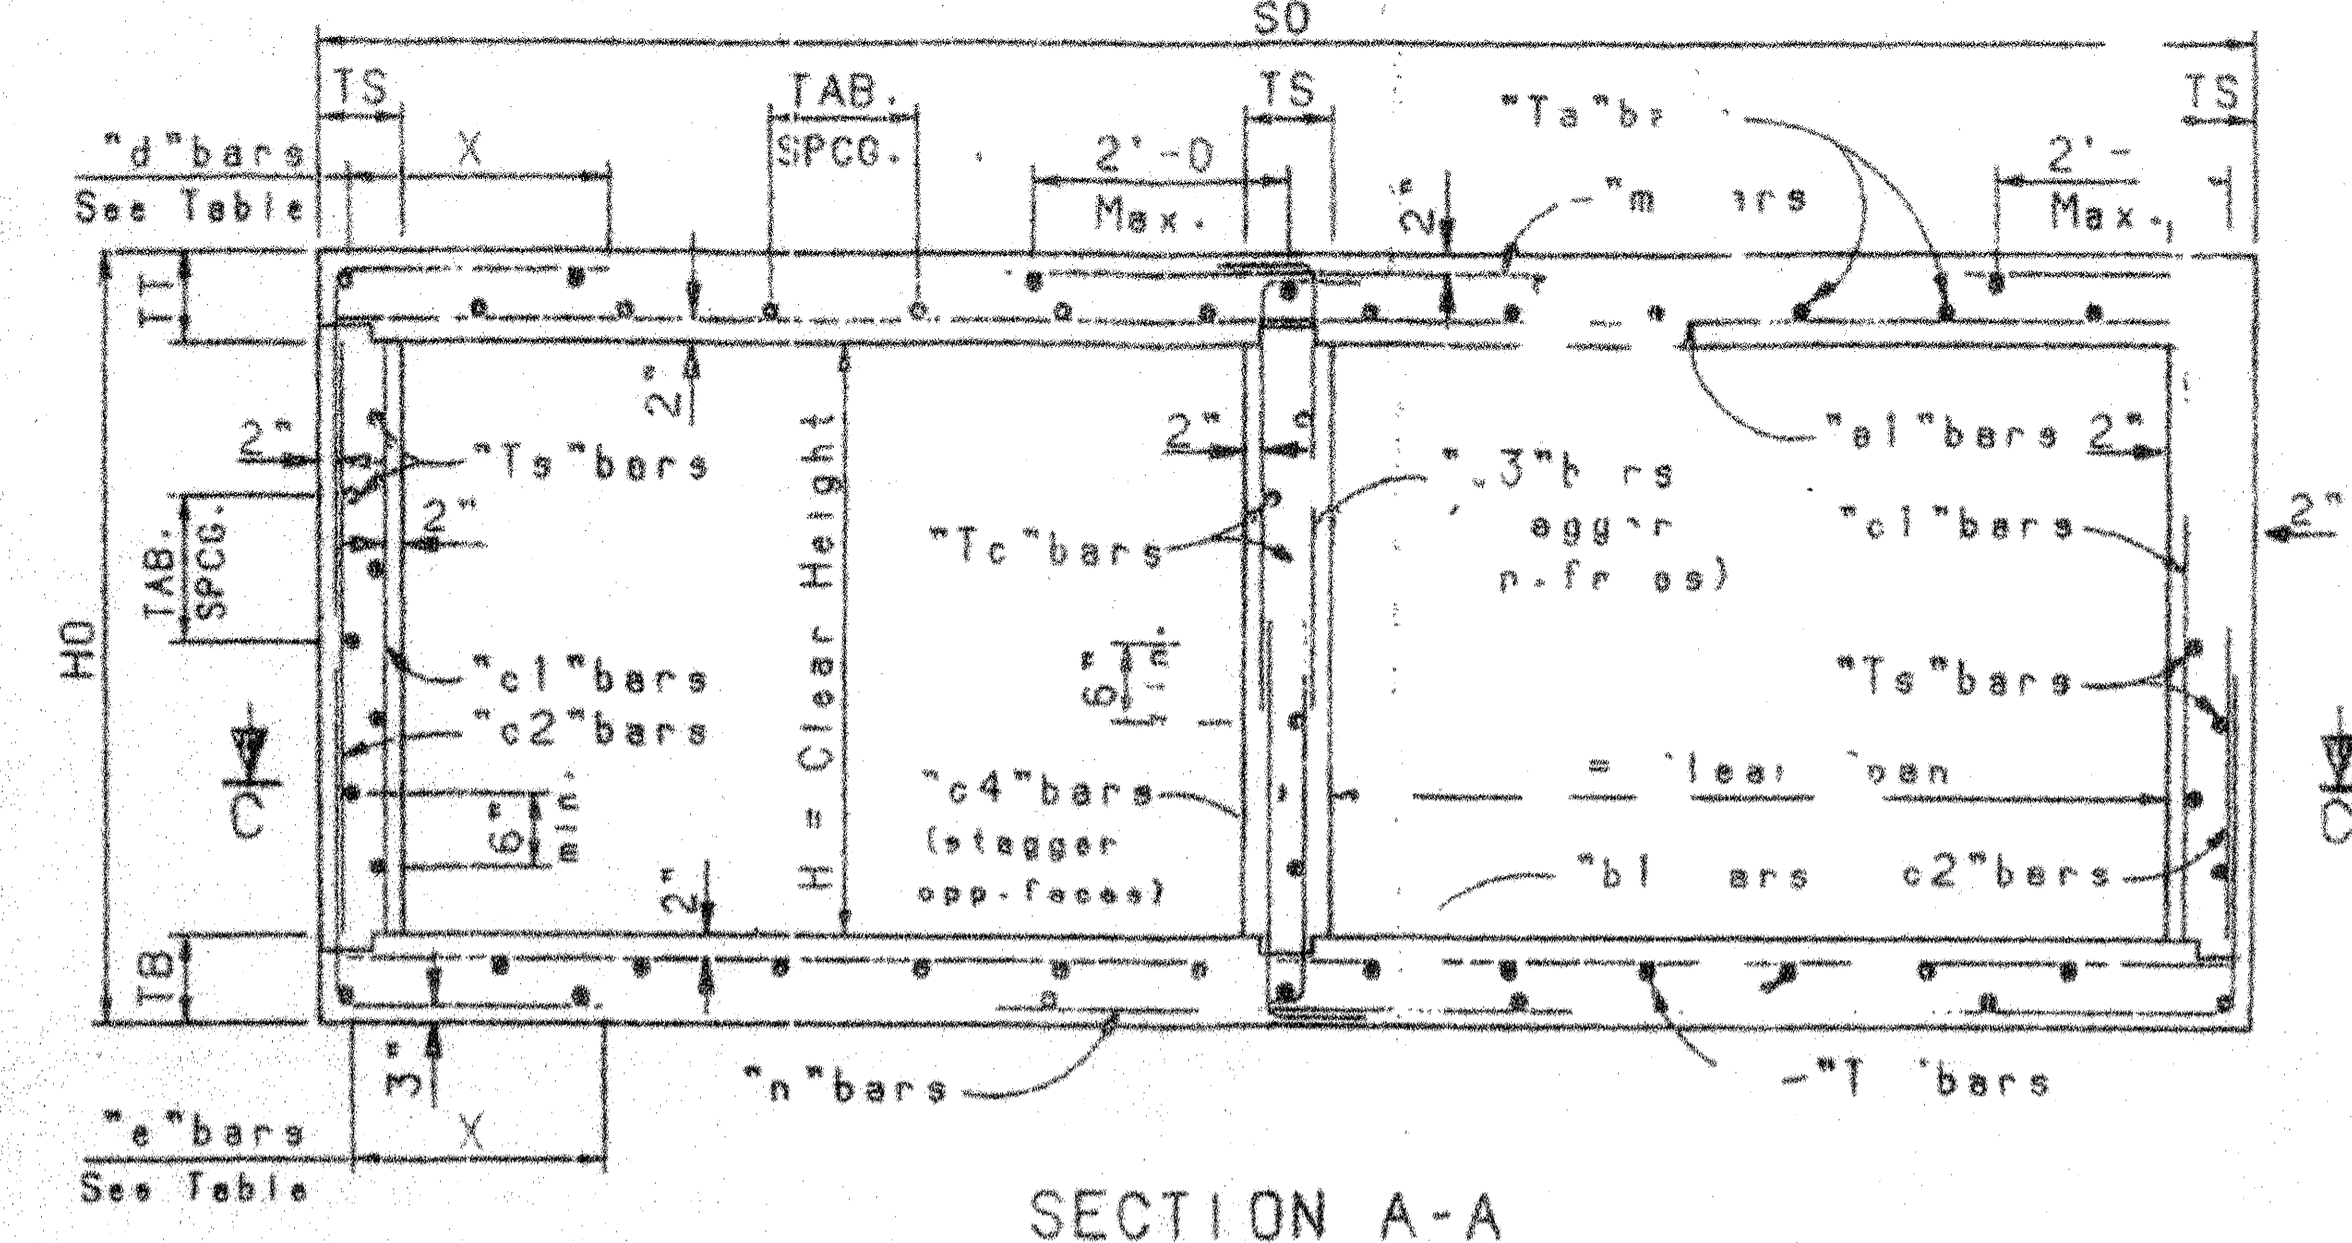


SECTION A-A

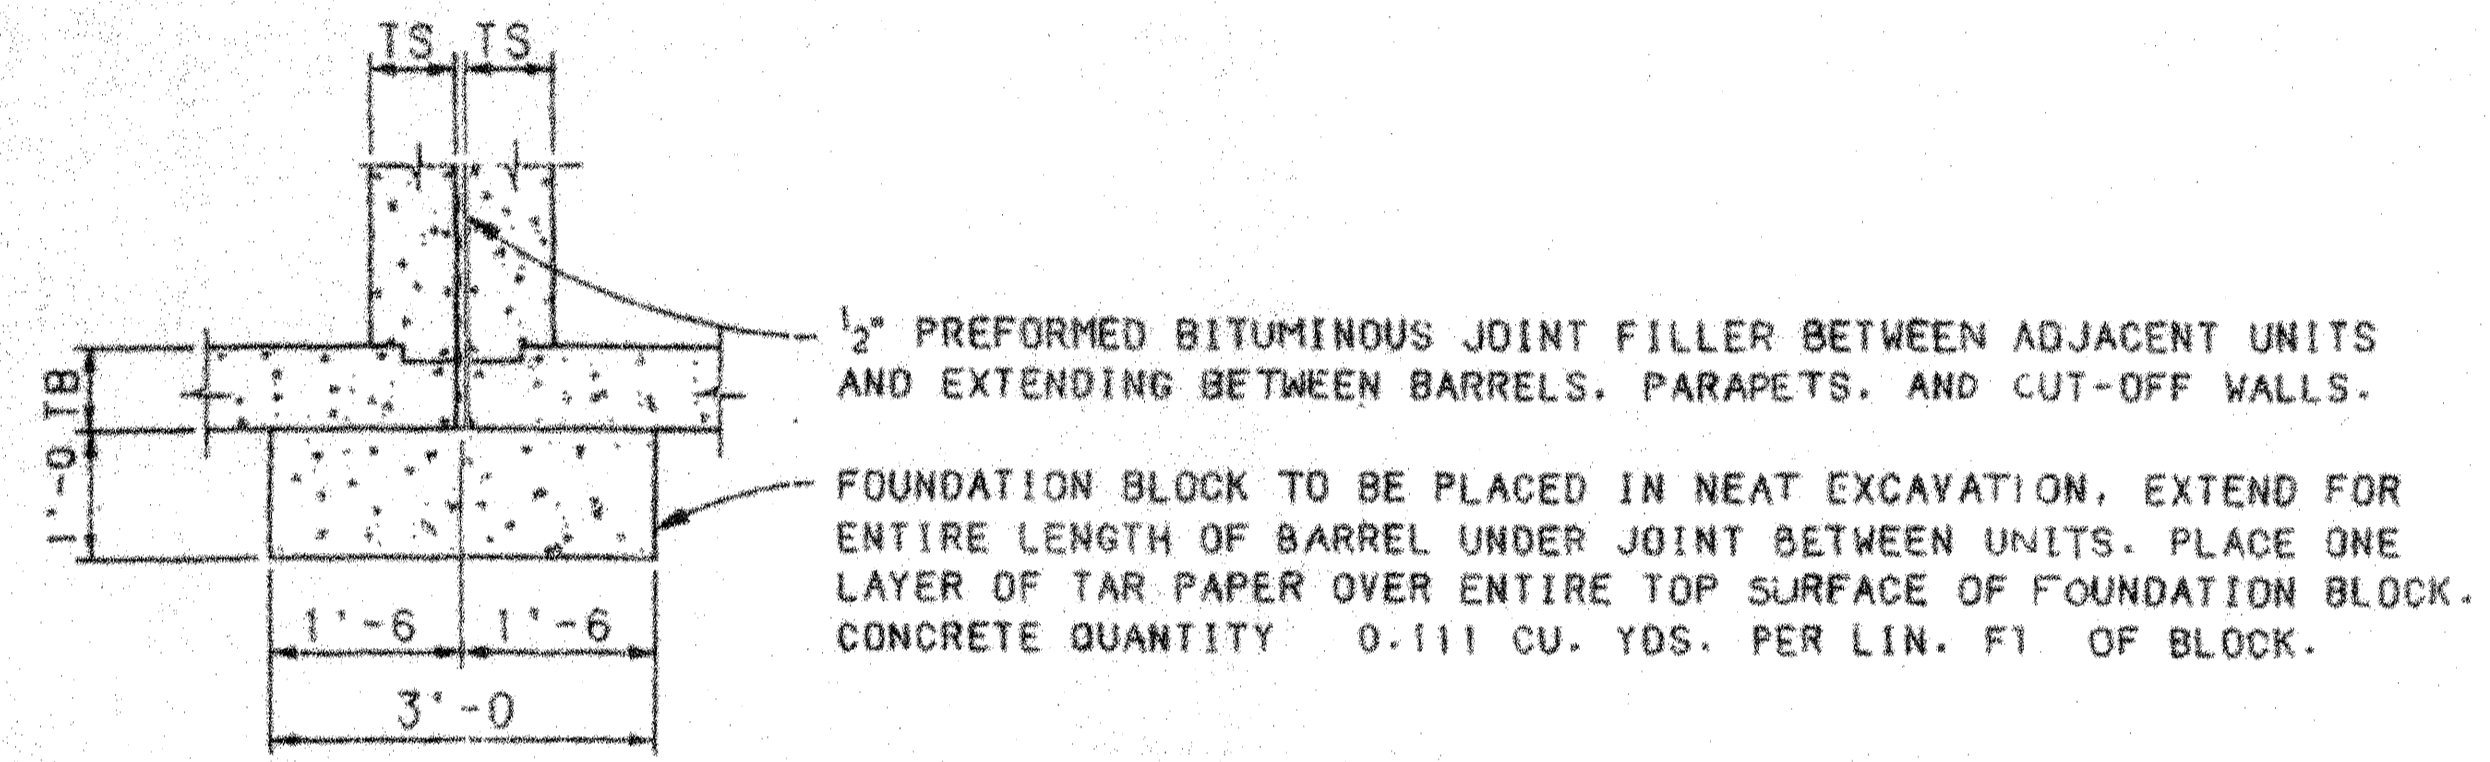


JOINT DETAIL FOR MULTIPLE UNIT BOXES


PART SECTION C-C

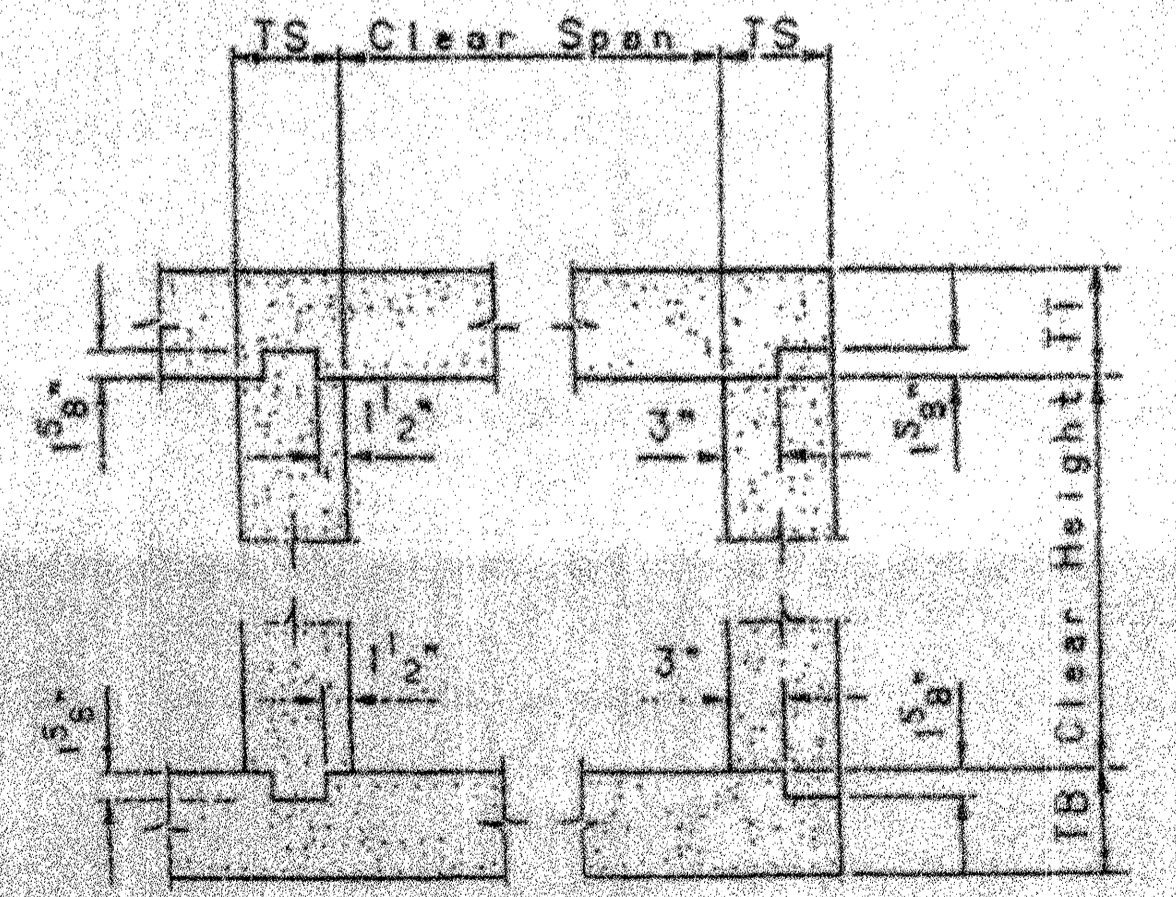

CONSTRUCTION JOINT DETAIL

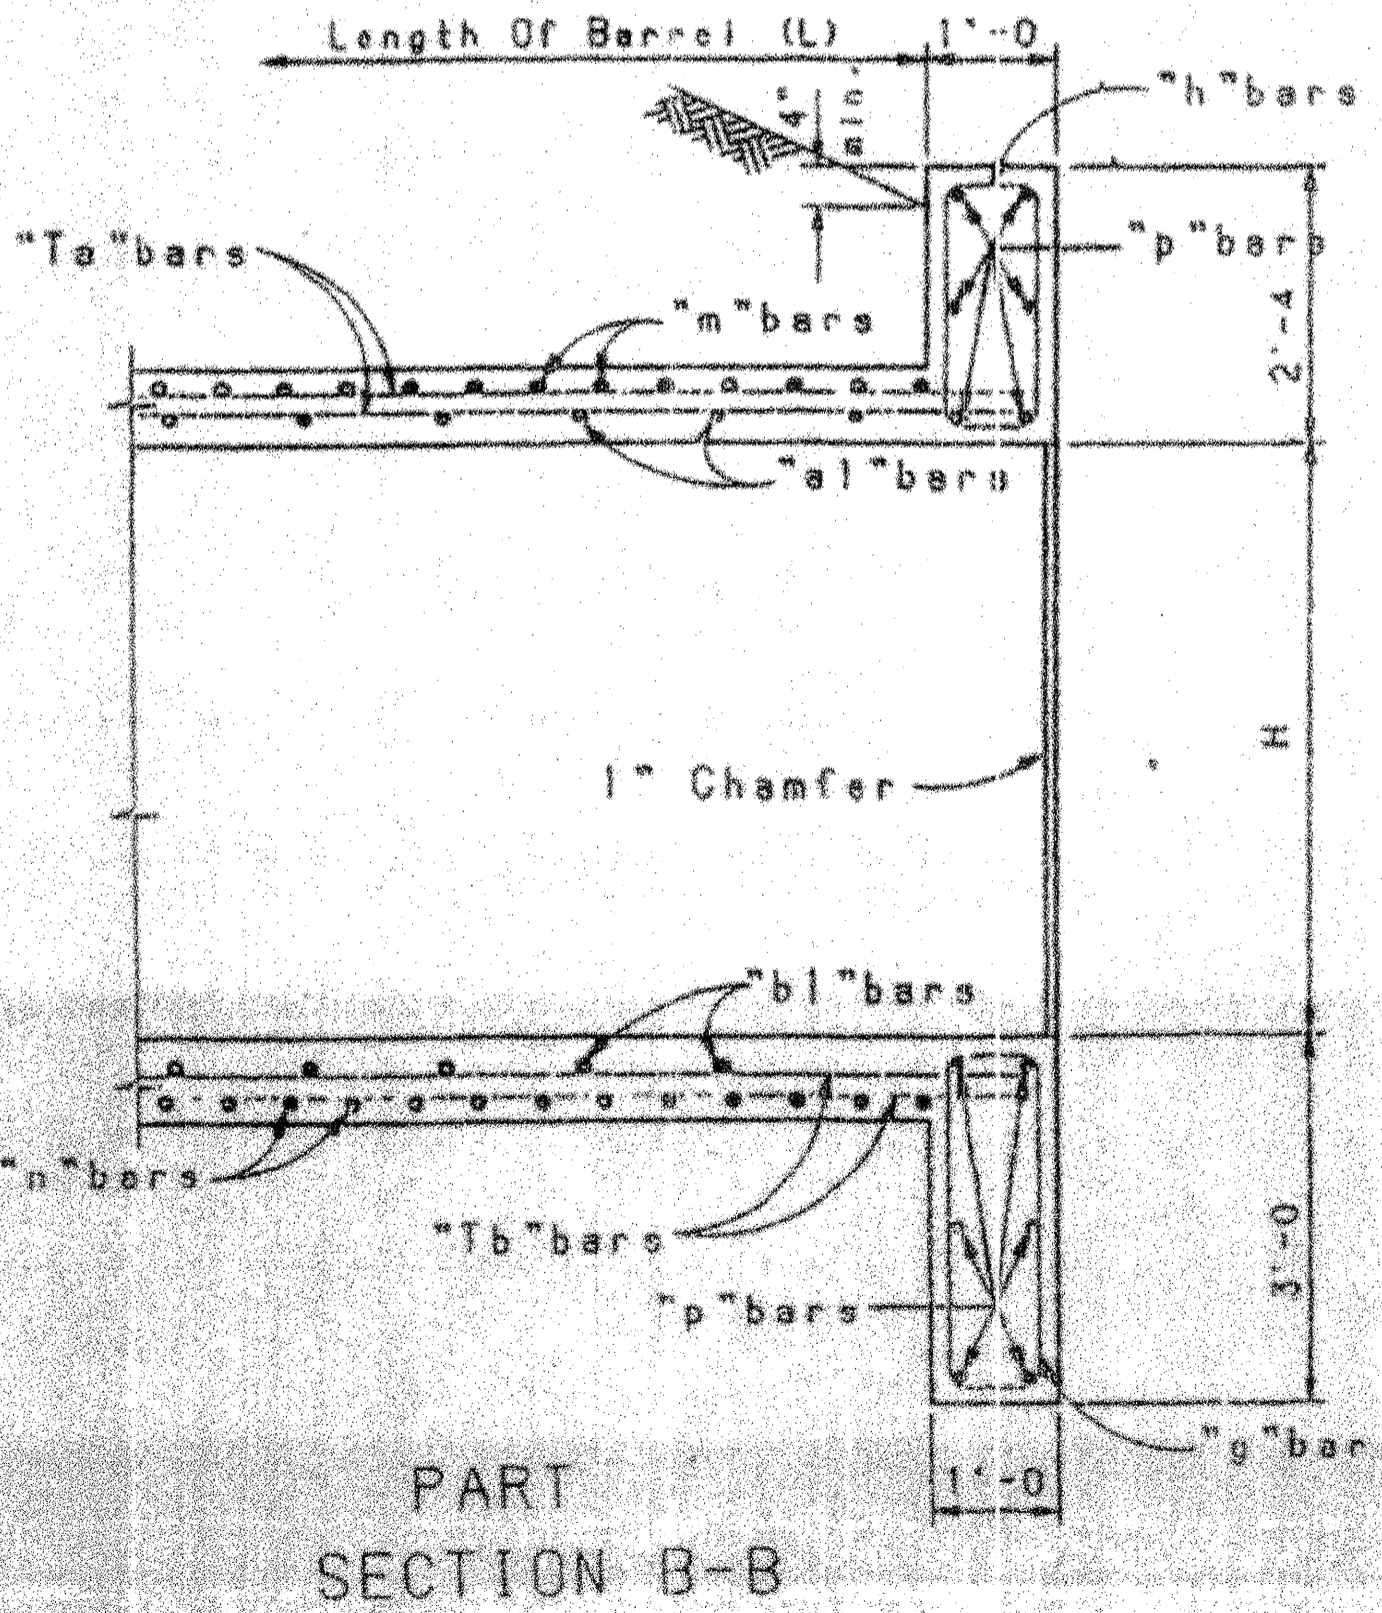

PART SECTION B-B

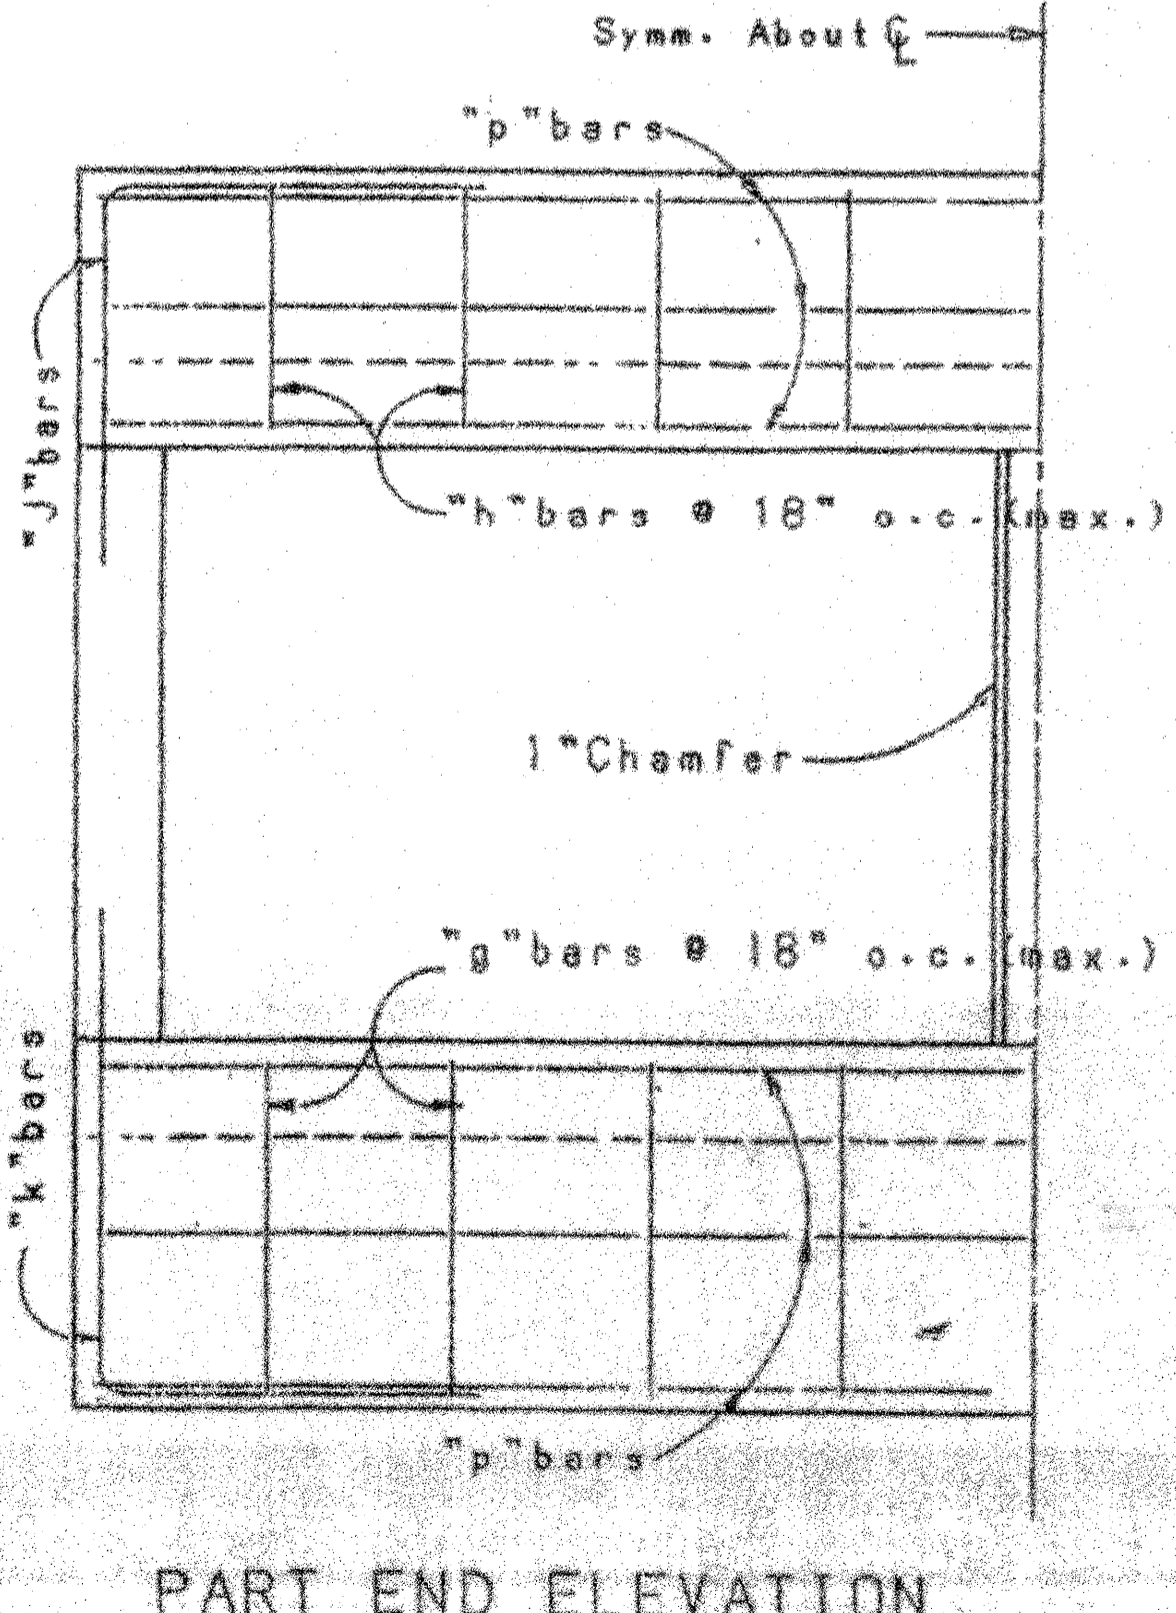

PART END ELEVATION

GENERAL NOTES

- ALL CONCRETE SHALL BE CLASS "A". CHAMFER ALL EXPOSED EDGES 3/4".
- ALL REINFORCING STEEL TO BE DEFORMED BARS, CONFORMING TO AASHTO M-31, GRADE 60. ALL DIMENSIONS REFER TO THE CENTERLINE OF BAR.
- "T" BARS MAY BE SPLICED WHEN NECESSARY BY LAPPING AT LEAST 20 BAR DIAMETERS. PAY WEIGHT FOR REINFORCING STEEL DOES NOT INCLUDE SPLICES. COST OF THE SPLICE MATERIAL TO BE INCLUDED IN UNIT PRICE BID FOR REINFORCING STEEL.
- VOLUME OF CONCRETE = (L) x (CONCRETE QUANTITY/LIN. FT.) PLUS CONCRETE AT ENDS.
- WEIGHT OF REINFORCING STEEL = (L) x (WEIGHT OF REINF./LIN.FT.) PLUS WEIGHT AT ENDS.
- PLACE "Ta" BARS ON "a" BARS AND "Tb" BARS UNDER "b" BARS, SPACED AS SHOWN IN THE TABLE. THE REMAINING "Tb" BARS, AND "Tc" BARS ARE TO BE PLACED ADJACENT TO THE "d", "e", "m", AND "n" BARS AS INDICATED IN "SECTION A-A".
- PLACE "Tc" BARS NEXT TO "c1" BARS, SPACED AS SHOWN IN THE TABLE. THE REMAINING "Tc" BARS TO BE PLACED IN SIDEWALL NEXT TO "c2", "d", AND "e" BARS. WHEN "c1" BARS ARE NOT REQUIRED PLACE ALL "Tc" BARS NEXT TO "c2", "d", AND "e" BARS.
- "COVER" IS HEIGHT OF FILL FROM TOP OF BOX TO FINISHED GRADE.

DESIGN DATA

DESIGN ACCORDING TO A.A.S.H.O. SPECIFICATIONS, 1957.  
 LIVE LOAD: H20-S16-44 & INTERSTATE ALTERNATE LOADING  
 WEIGHT OF FILL ON TOP OF BOX: 84#/CU.FT.  
 HORIZONTAL EARTH PRESSURE: 30#/CU.FT., 2' SURCHARGE  
 DESIGN STRESSES:  $f'_c = 3000$  psi,  $f_s = 1200$  psi,  
 $f_s = 20,000$  psi,  $n = 10$ .


6			
5			
4			
3			
2			
1	REVISED NOTE #2	6-7-94	PH
NO.	DESCRIPTION	DATE	BY
REVISIONS (OR CHANGE NOTICES)			
NEW MEXICO STATE HIGHWAY AND TRANSPORTATION DEPARTMENT			
CONCRETE BOX CULVERT BARRELS DOUBLE OPENING - NORMAL ALL DESIGNS			
GENERAL DATA			
LAYOUT BY	APPROVAL	DATE	
DRAWN BY	RECORDED	ENGINEER	7/2/93
CHECKED BY	APPROVED	DIRECTOR OF HIGHWAYS	
SERIAL CB-32			
SHEET 1 OF 5			

DESIGNED BY: H.I. 10/60  
 CHECKED BY: J.A.K. 2/93  
 R.A. 5/93  
 S.J.M. 7/93  
 PLOT DATE: 7/20/93

CLEAR SPAN	CLEAR HEIGHT	DIMENSIONS						QUANTITIES		REINFORCING BARS																																																	
		TT	TS	IB	SO	HO	Y	Z	PER L.F. OF BARREL		AT ONE END *		"a1"		"a2"		"b1"		"b2"		"c1"		"c2"		"c3"		"c4"		"d"		"e"		"T <sub>a</sub> "		"T <sub>b</sub> "		"T <sub>c</sub> "		"T <sub>d</sub> "		g.h																		
									REINF. STEEL POUNDS PER L.F.	CONCRETE CU. YDS. PER L.F.	REINF. STEEL POUNDS	CONCRETE CU. YDS.	SIZE	LENGTH	SPACING	SIZE	LENGTH	SPACING	SIZE	LENGTH	SPACING	SIZE	LENGTH	SPACING	SIZE	LENGTH	SPACING	SIZE	LENGTH	SPACING	SIZE	LENGTH	SPACING	SIZE	LENGTH	SPACING	SIZE	LENGTH	SPACING	SIZE		LENGTH	SPACING	SIZE	LENGTH	SPACING													
4	2	6 1/2	6	7	9'-6	3'-1 1/2	----	----	77.2	0.507	239	1.99	#6	9'-3	9"	---	NONE	---	#4	9'-3	12"	---	NONE	---	NONE	NONE	#4	2'-3	12"	#4	2'-3	12"	#5	4'-6	9"	#5	4'-6	12"	#5	3'-9	1'-7	12"	#4	4'-3	1'-6	12"	13	#4	18"	13	#4	18"	3	#4	18"	4	#4	18"	6

\* NOTE: "QUANTITIES AT ONE END" INCLUDE PARAPET, CUT-OFF WALL, AND BARREL BEYOND LENGTH "L". WINGWALL QUANTITIES ARE NOT INCLUDED.

p-BARS						
CLEAR SPAN	4'	6'	8'	10'	12'	14'
SIZE	#5	#5	#6	#7	#8	#9

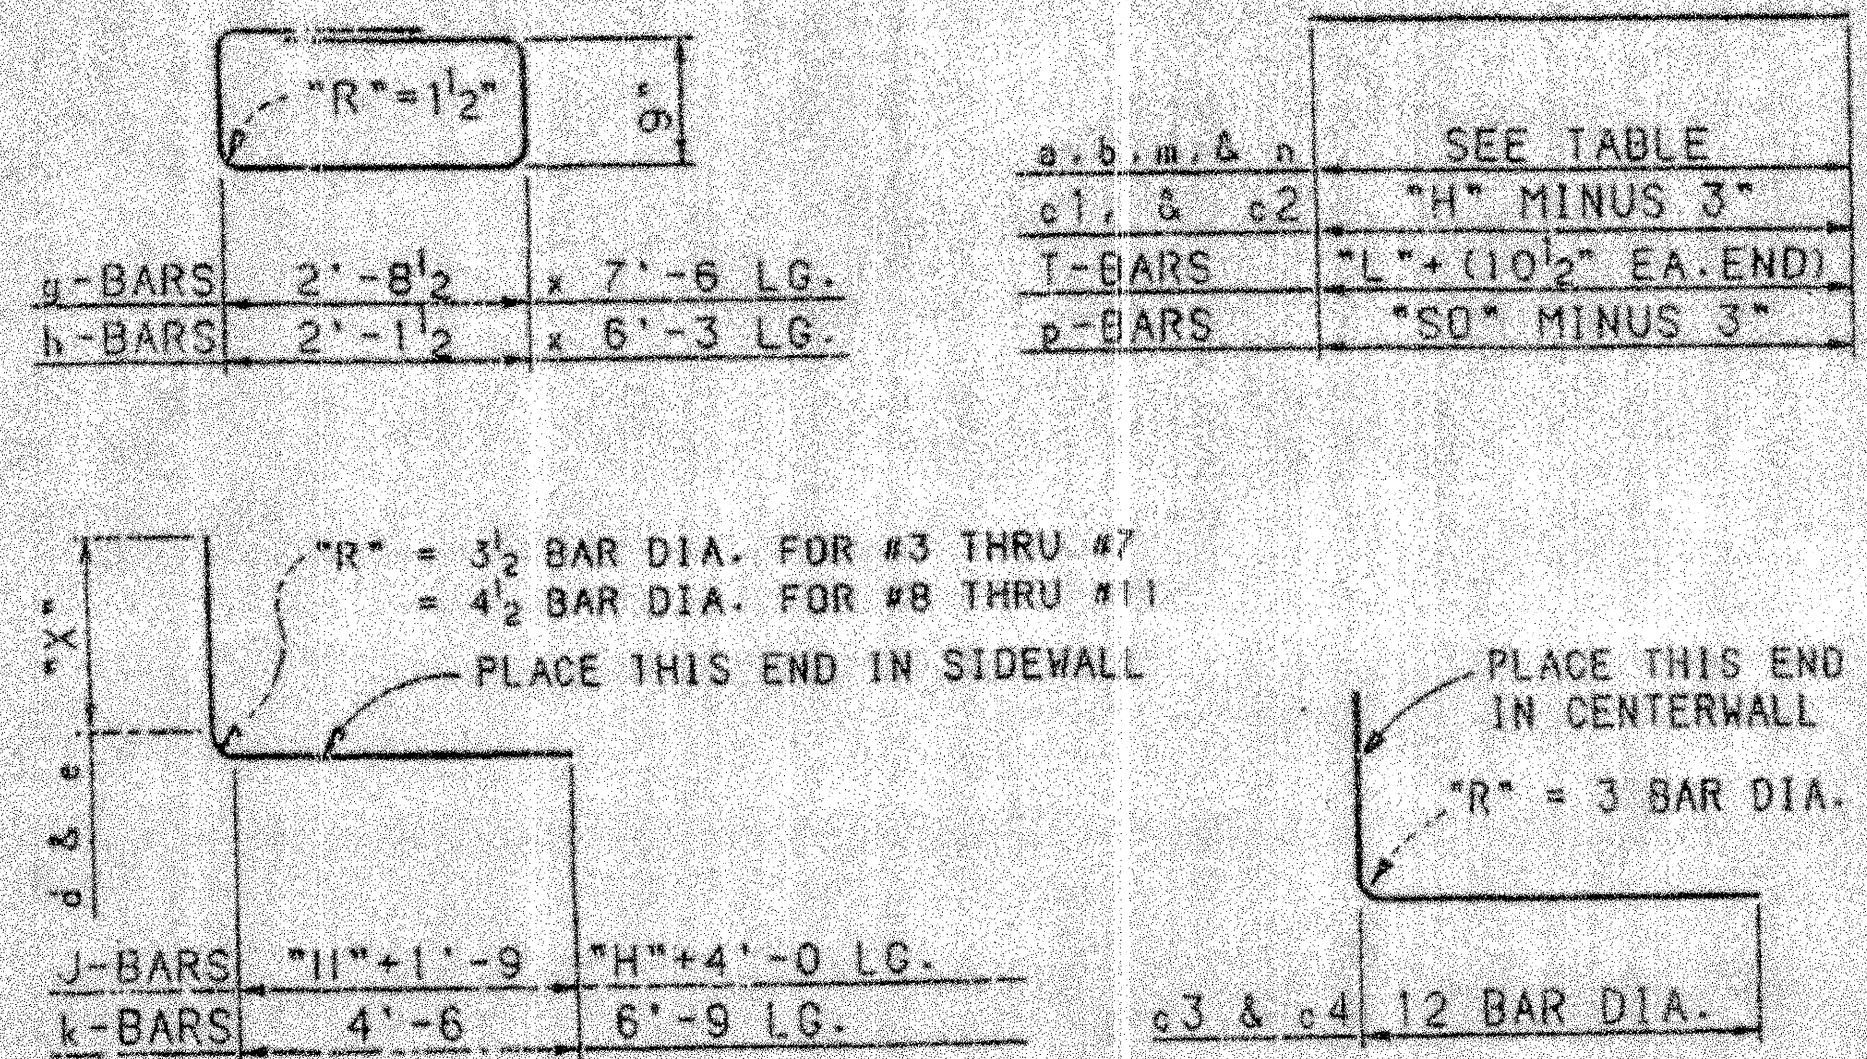

### NUMBER OF BARS REQUIRED

a1, b1, m, & n-BARS: 12L ÷ SPACING  
 a2, b2, c2, d, & e-BARS: 24L ÷ SPACING  
 p-BARS: 12 FOR CUT-OFF & PARAPET AT EACH END  
 c1, c3, & c4-BARS: (24L ÷ SPACING) PLUS 2 AT EACH END  
 j-BARS, & k-BARS: 4 OF EACH AT EACH END  
 OTHER BARS: SEE TABLE  
 "L" = LENGTH OF BARREL IN FEET  
 "E" = 10 1/2" FOR EACH END

NOTE: J-BARS SAME SIZE AS "d-BARS".  
K-BARS SAME SIZE AS "e-BARS".


### REINFORCING STEEL DIAGRAM

NO.	DESCRIPTION	DATE	BY
REVISIONS FOR CHANGE (NOTICES)			
<b>NEW MEXICO STATE HIGHWAY AND TRANSPORTATION DEPARTMENT</b>			
<b>CONCRETE BOX CULVERT BARRELS DOUBLE OPENING - NORMAL DESIGN No. 1</b>			
LAYOUT BY	APPROVED	DATE	
DRAWN BY			
CHECKED BY			
SERIAL CB-32 SHEET 2 OF 3			








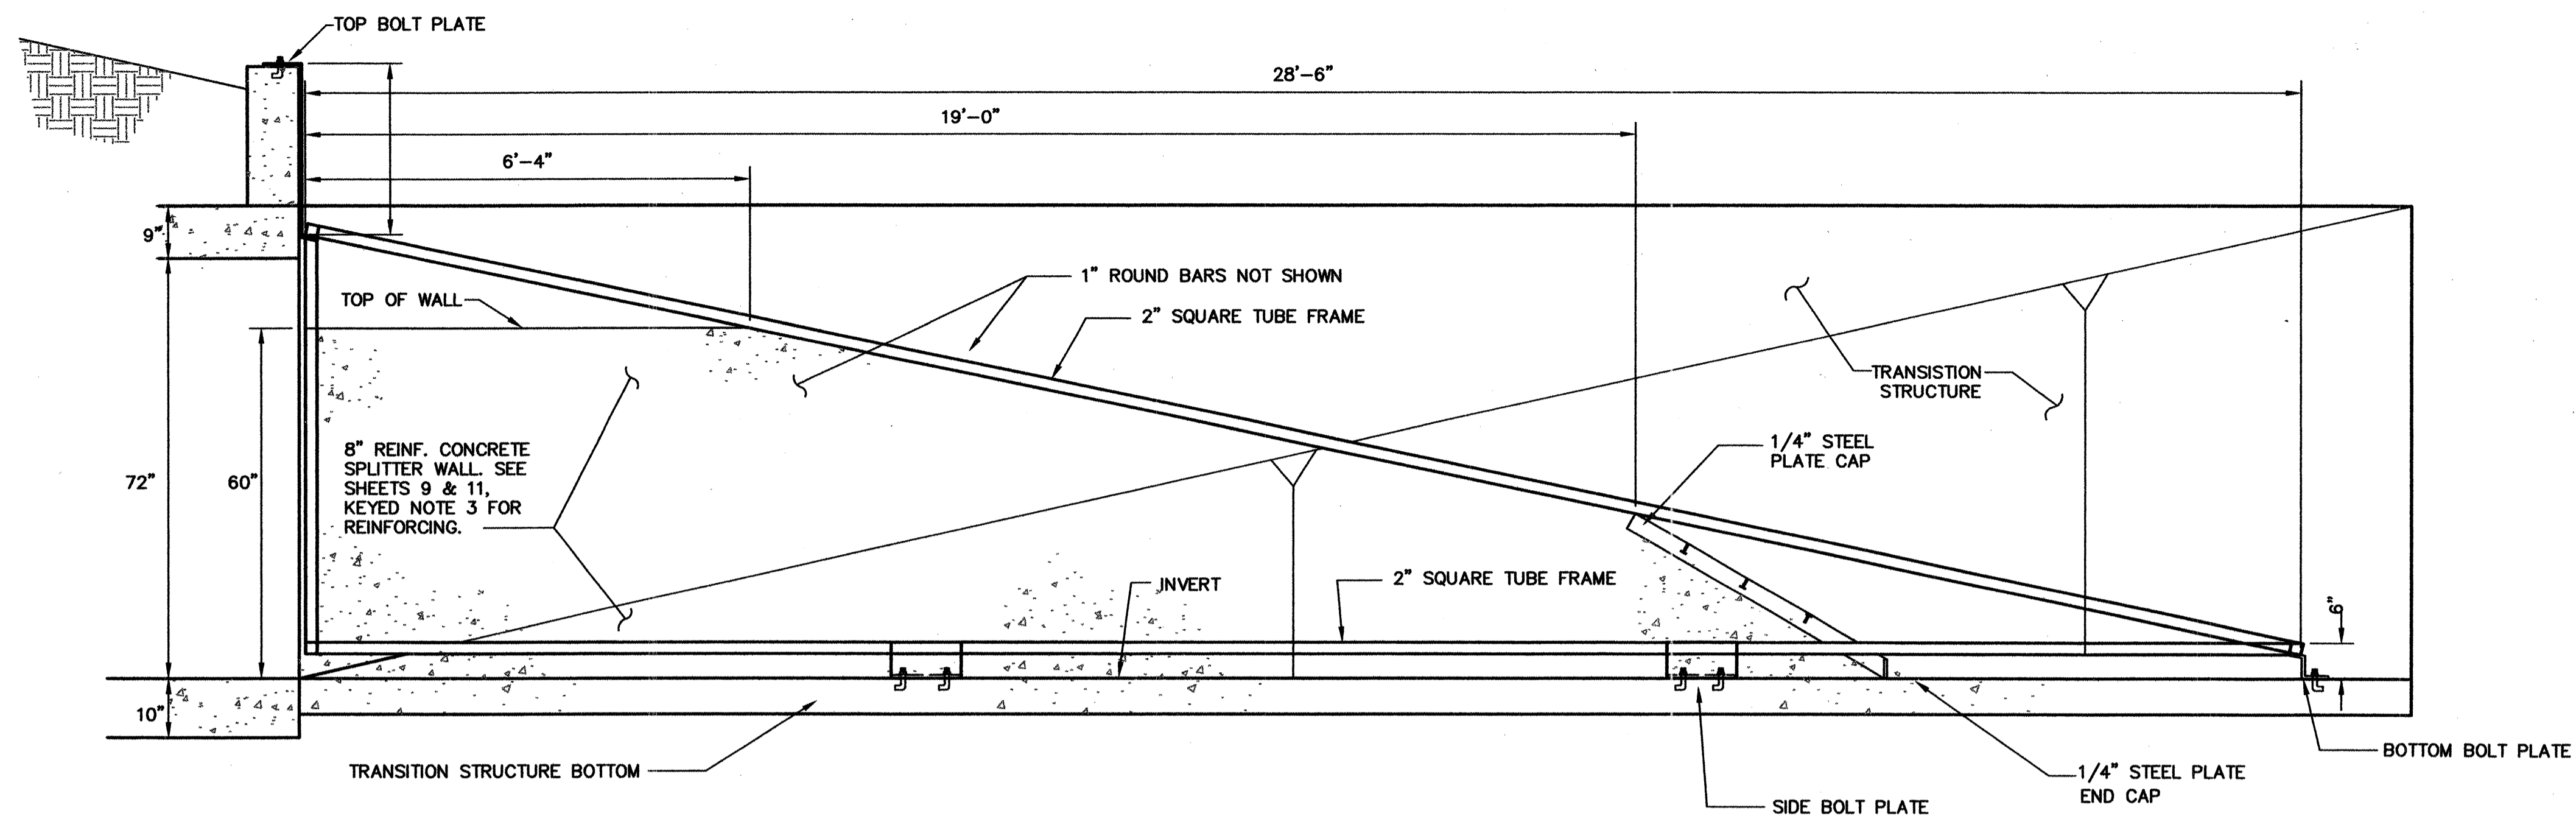

**GENERAL NOTES:**  
 1. THE DETAILS SHOWN ON THIS SHEET ARE FOR INFORMATION ONLY. THE CONTRACTOR MUST PROVIDE DETAILED STRUCTURAL SHOP DRAWINGS FOR ACTUAL GRATE STRUCTURAL DESIGN, FABRICATION AND INSTALLATION.






NOTE: PLACEMENT SHOWN IS FOR UPSTREAM END OF BOX CULVERT. REVERSE PLACEMENT FOR DOWNSTREAM END OF BOX CULVERT.

**GRATE PLACEMENT**  
 SCALE 1:20



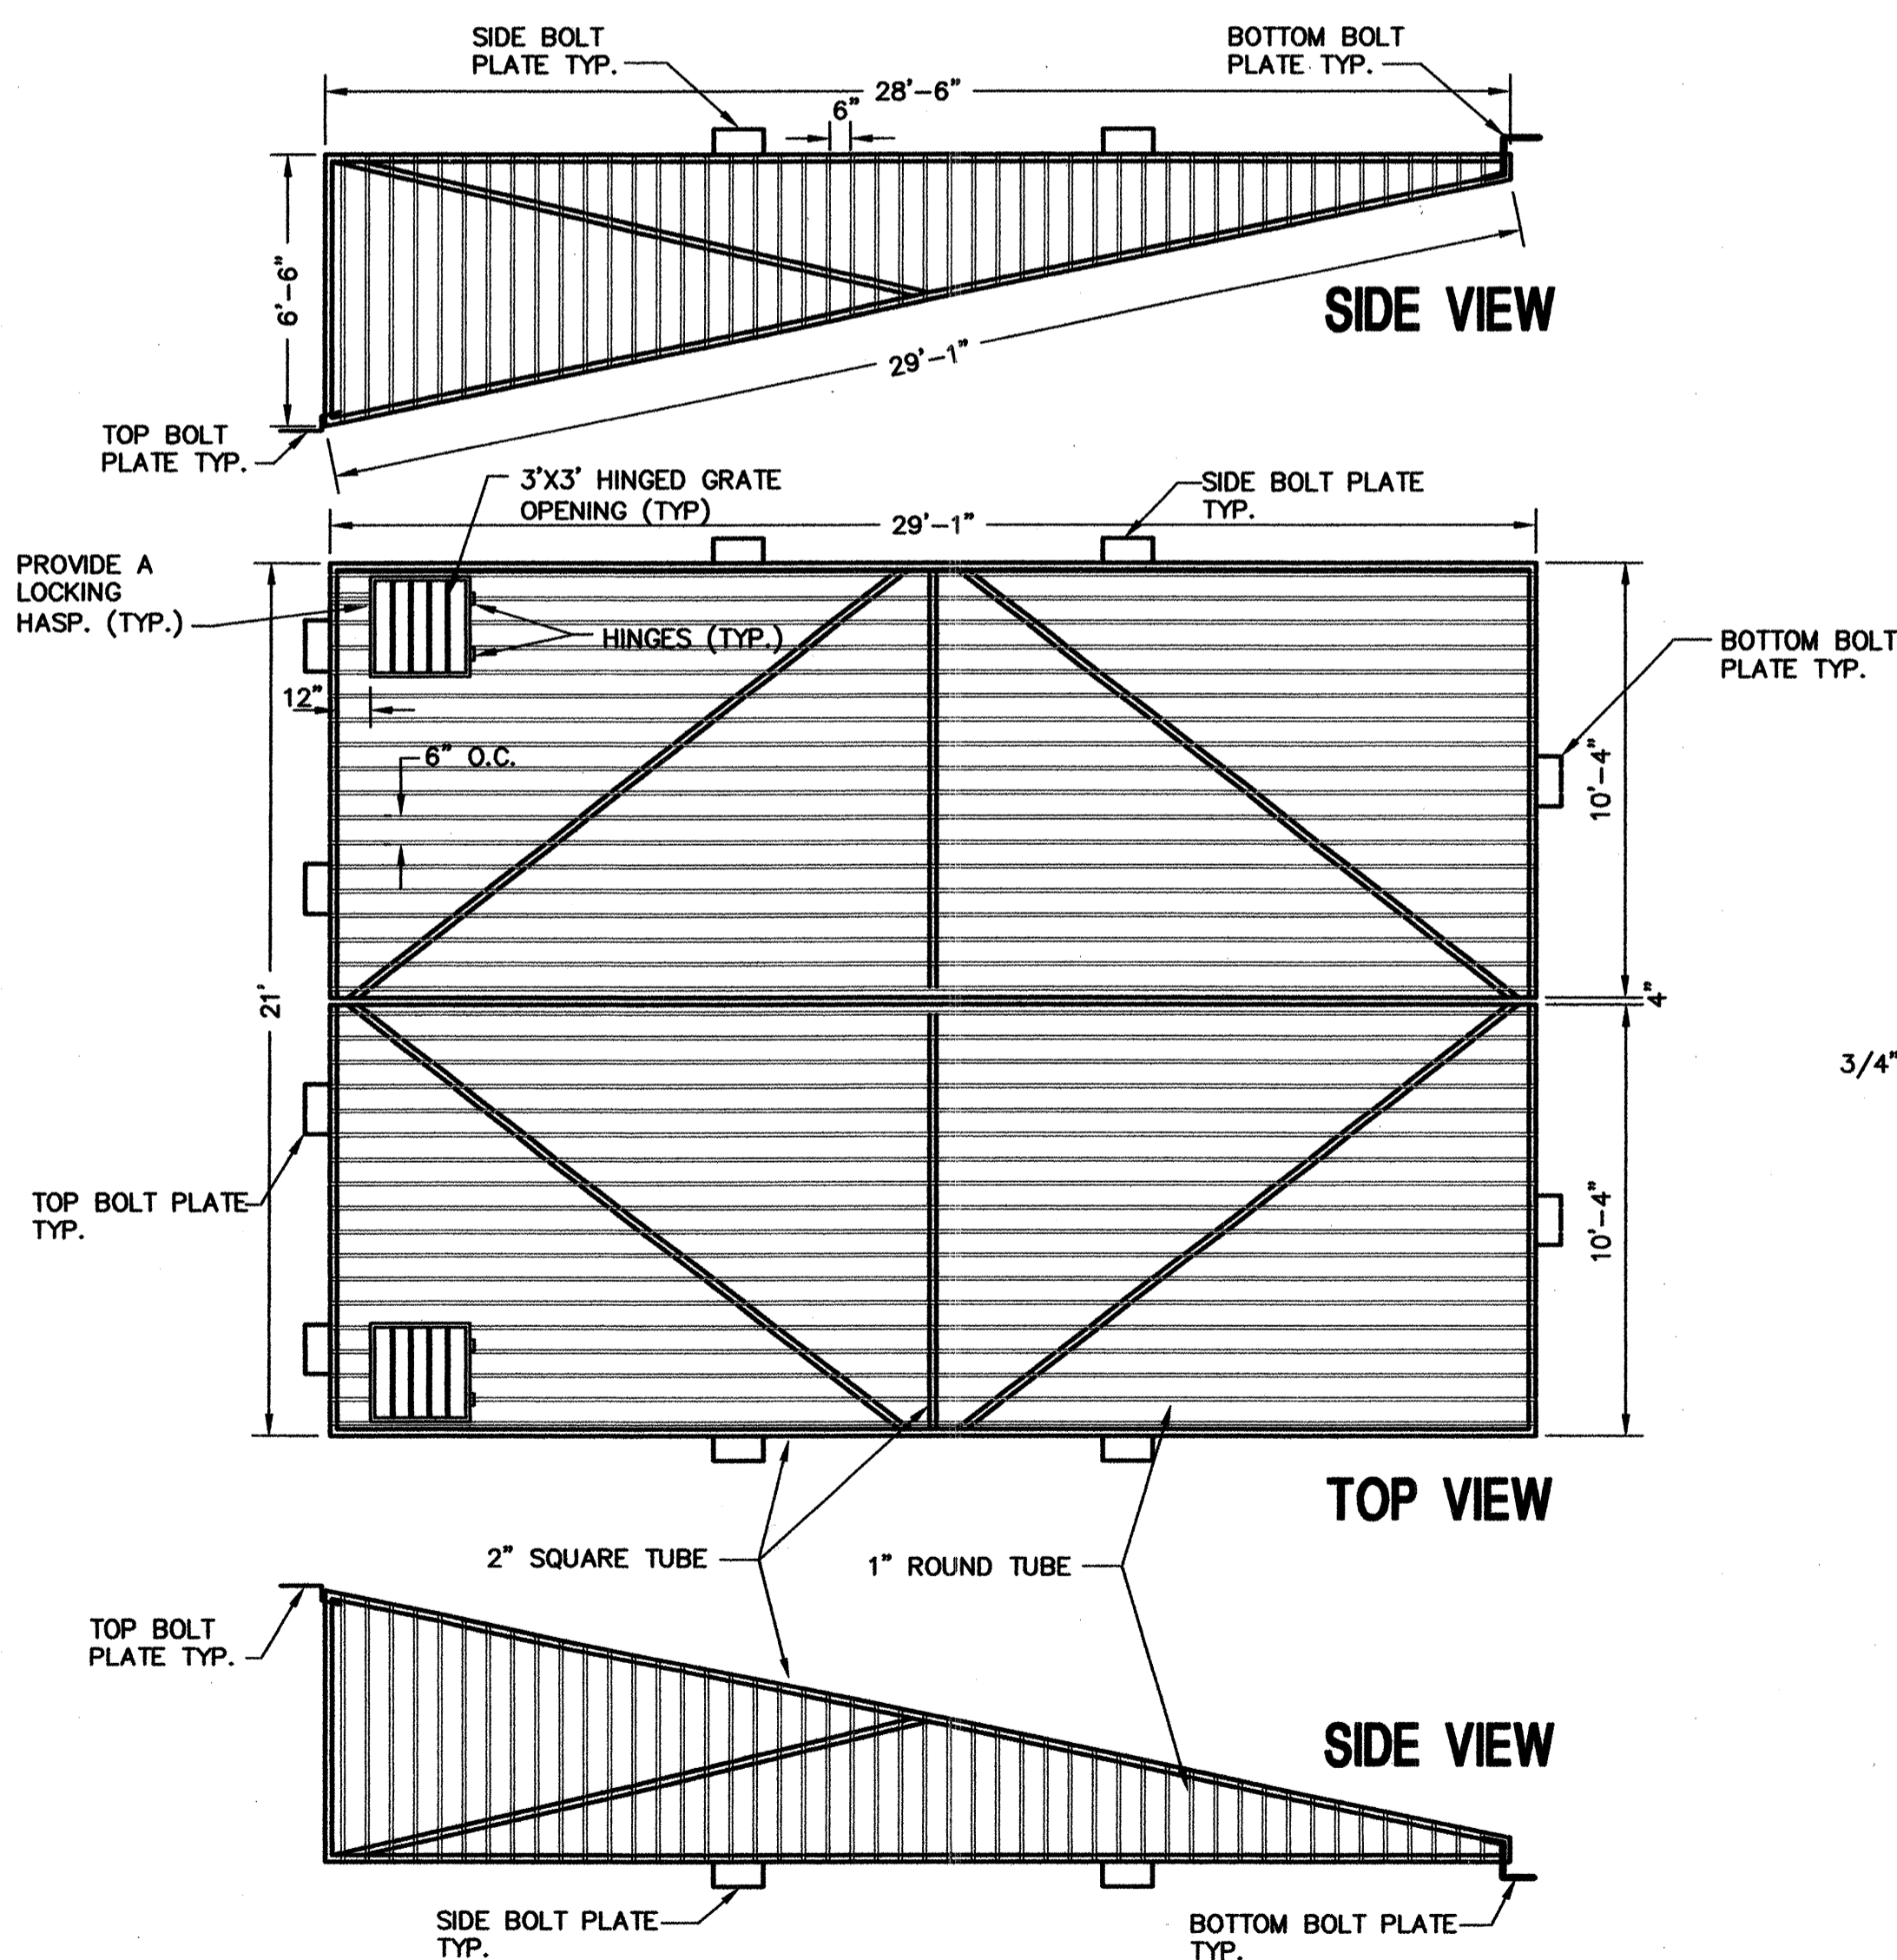


NOTE: FABRICATE GRATE IN TWO PIECES. EACH PIECE CONSISTS ON ONE SIDE PIECE AND ONE-HALF OF THE TOP. (THE TOP VIEW SHOWN ABOVE CONSISTS OF TWO HALVES.)

**GRATE DETAIL**  
 NOT TO SCALE

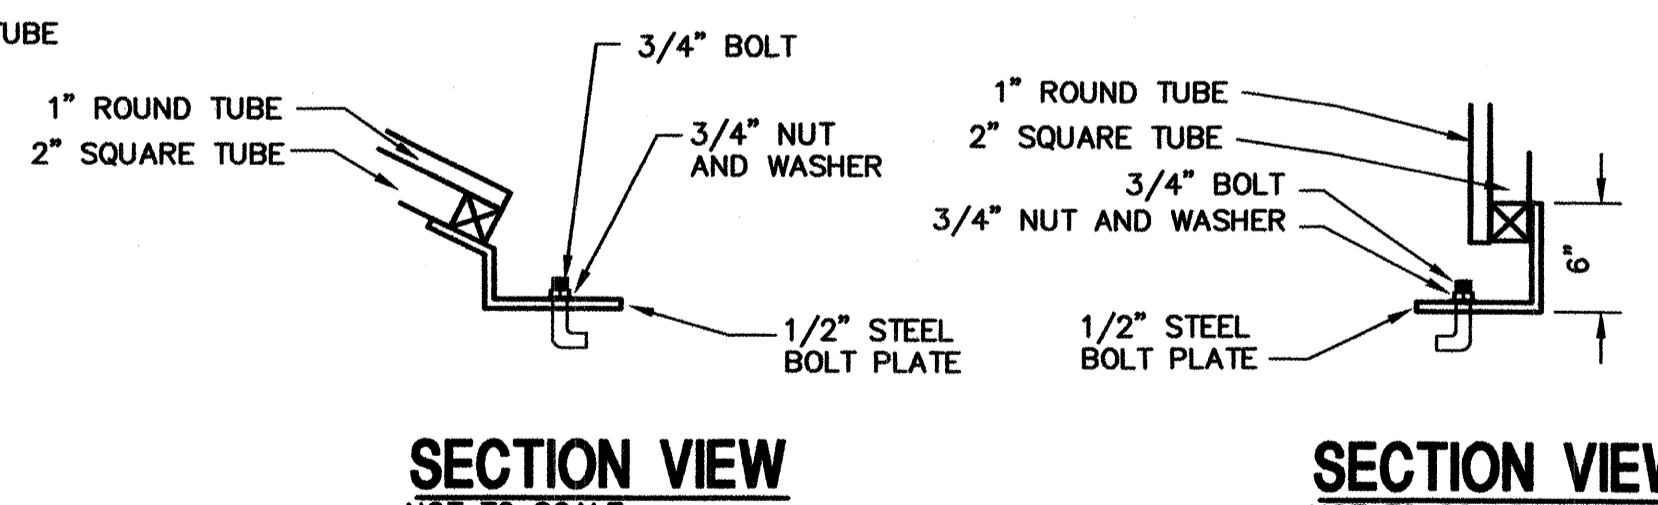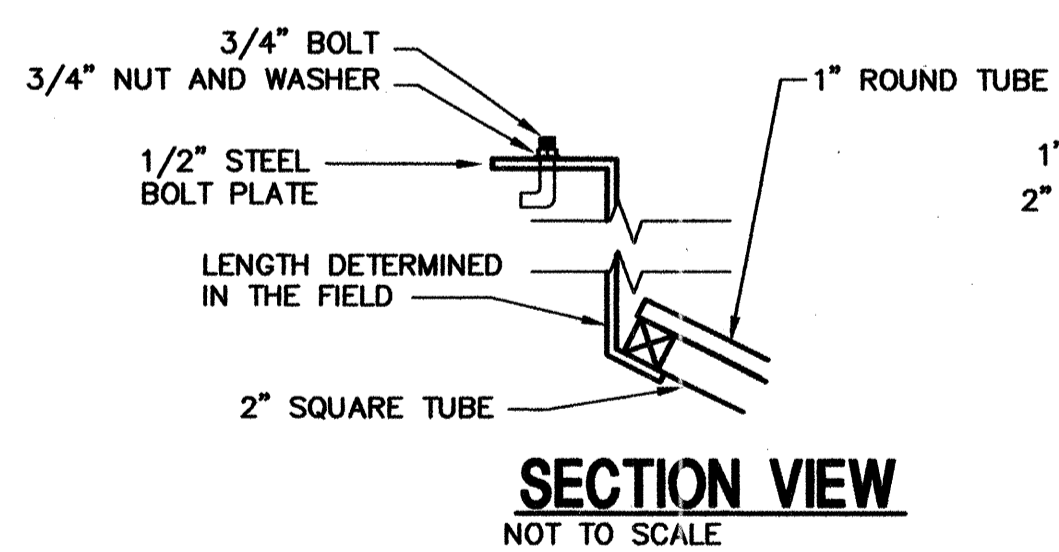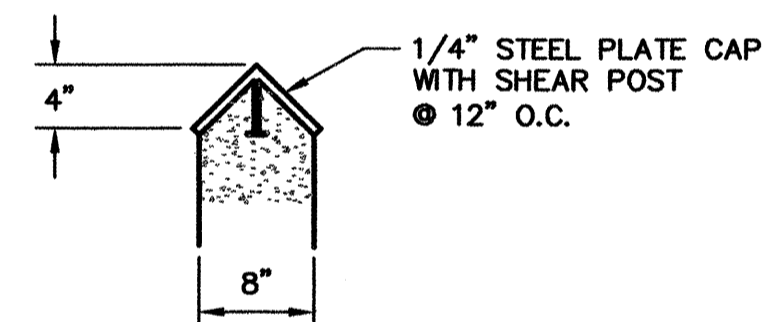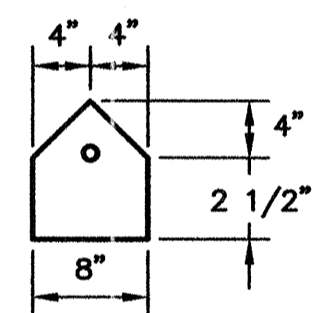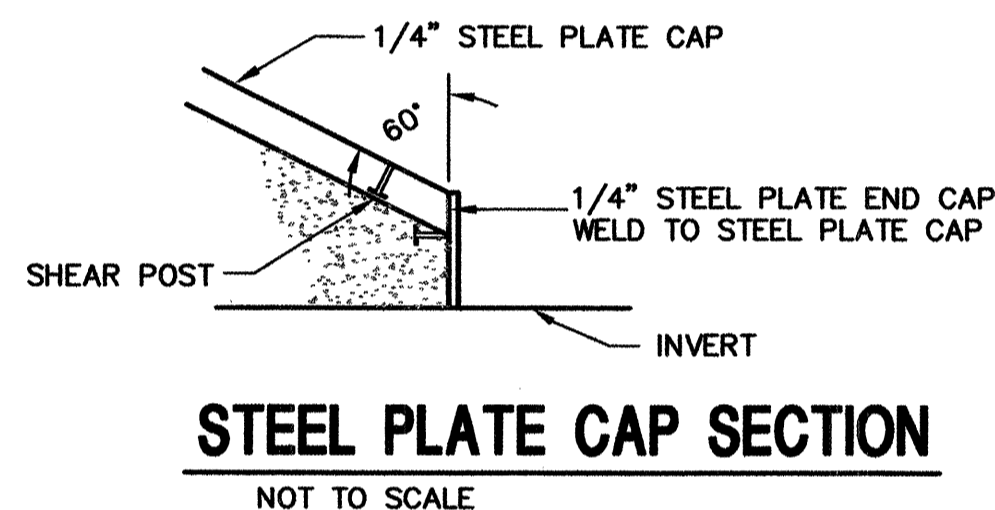

NOTE: WELD BOLT PLATES TO 2" STEEL TUBE FRAME ALONG ALL CONTACT EDGES.

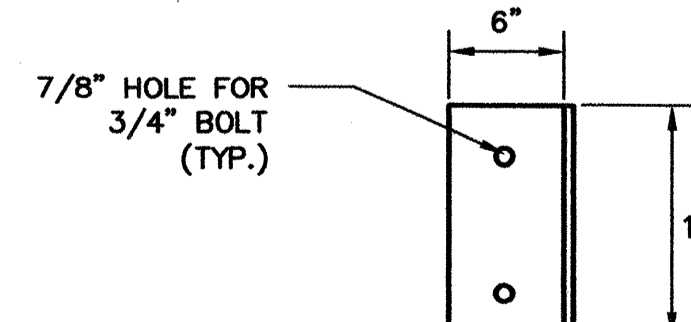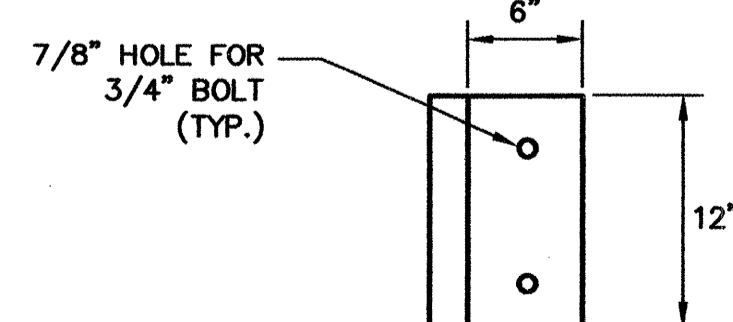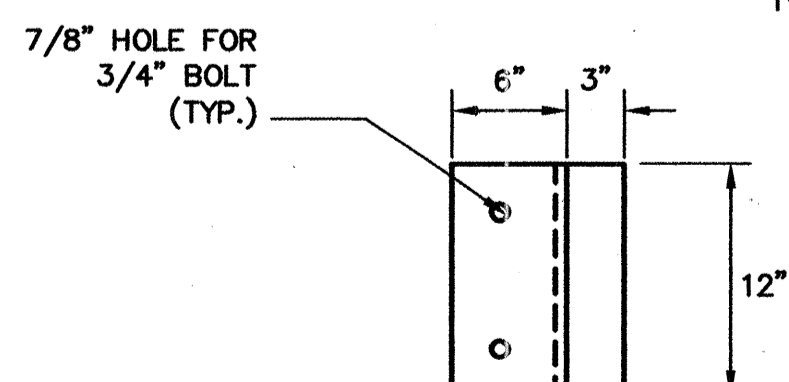

<b>AS-BUILT INFORMATION</b>		CONTRACTOR: Salls, Bro.	DATE: 3/07
WORK STARTED BY: CS	DATE: 3/07	FIELD ACCEPTANCE BY: COA	DATE: 3/07
DESIGNED BY: CS	DATE: 3/07	DRAWN BY: SEC	DATE: 3/07
<b>MICRO-FILM INFORMATION</b>		RECORDED BY:	DATE:
<b>BENCH MARKS</b>		STATION NAME: 1-B20: STATE: NM; COUNTY: BERNALILLO	NO.:
<b>SURVEY INFORMATION</b>		ESTABLISHING AGENCY: ACS STANDARD BRASS CAP	DATE:
<b>FIELD NOTES</b>		IN CONCRETE LOCATED IN THE NORTHEAST QUADRANT OF THE INTERSECTION OF BARSTOW ST. AND MODESTO AVE.	BY:
		SPRIT LEVEL ELEVATION = 5474.533 FT. (NGVD 29)	NO.:
		PLANE COORDINATES: N = 1524092.46, E = 410237.56	NO.:
<b>ENGINEER'S SEAL</b>			
NO.	DATE	BY	REVISIONS
			DESIGN
	JULY 2005	GN	
	JULY 2005	KSH	
	JULY 2005	GN	

RECORD DRAWING

102035B  
**Smith Engineering Company**  
 A Full Service Engineering Company  
 2001 San Pedro Boulevard, N.E., Map 64, Suite 200 Albuquerque, New Mexico 87110

CITY OF ALBUQUERQUE  
 DEPARTMENT OF MUNICIPAL DEVELOPMENT

TITLE: **NORTH DOMINGO BACA PARK  
 PHASE 4 CONSTRUCTION - BOX CULVERT  
 STEEL GRATE SECTIONS & DETAILS**

Design Review Committee	City Engineer Approval	No. / Day / Yr.	No. / Day / Yr.
AUG - 4 2005	AUG - 4 2005		
City Project No. <b>7138.92</b>		Zone Map No. <b>C-19</b>	Sheet <b>14</b> Of <b>14</b>