



CITY OF ALBUQUERQUE
DEPARTMENT OF MUNICIPAL DEVELOPMENT
PLANS FOR CONSTRUCTION

AS BUILT

SAN PEDRO STORM DRAIN

PROJECT #5304.91

PH 1


SURVEYOR'S CERTIFICATE
I, Andrew S. Medina, a duly qualified Licensed Professional Surveyor under the laws of the State of New Mexico, do hereby certify that the "as-built" information shown on these drawings was obtained from field construction and "as-built" surveys performed by me or under my supervision that the "as-built" information shown on these drawings was added by me under my supervision; and that this "as-built" information is true and correct to the best of my knowledge and belief. I am not responsible for any of the design concepts, calculations, engineering, or intent of the record drawings.

Andrew S. Medina
SANDIA LAND SURVEYING LLC
15 CASA TERRENOS
PLACITAS, N.M. 87043
505-867-1241
N.M.P.S. 12649

VICINITY
MAP
NTS



MAP NO. C-18

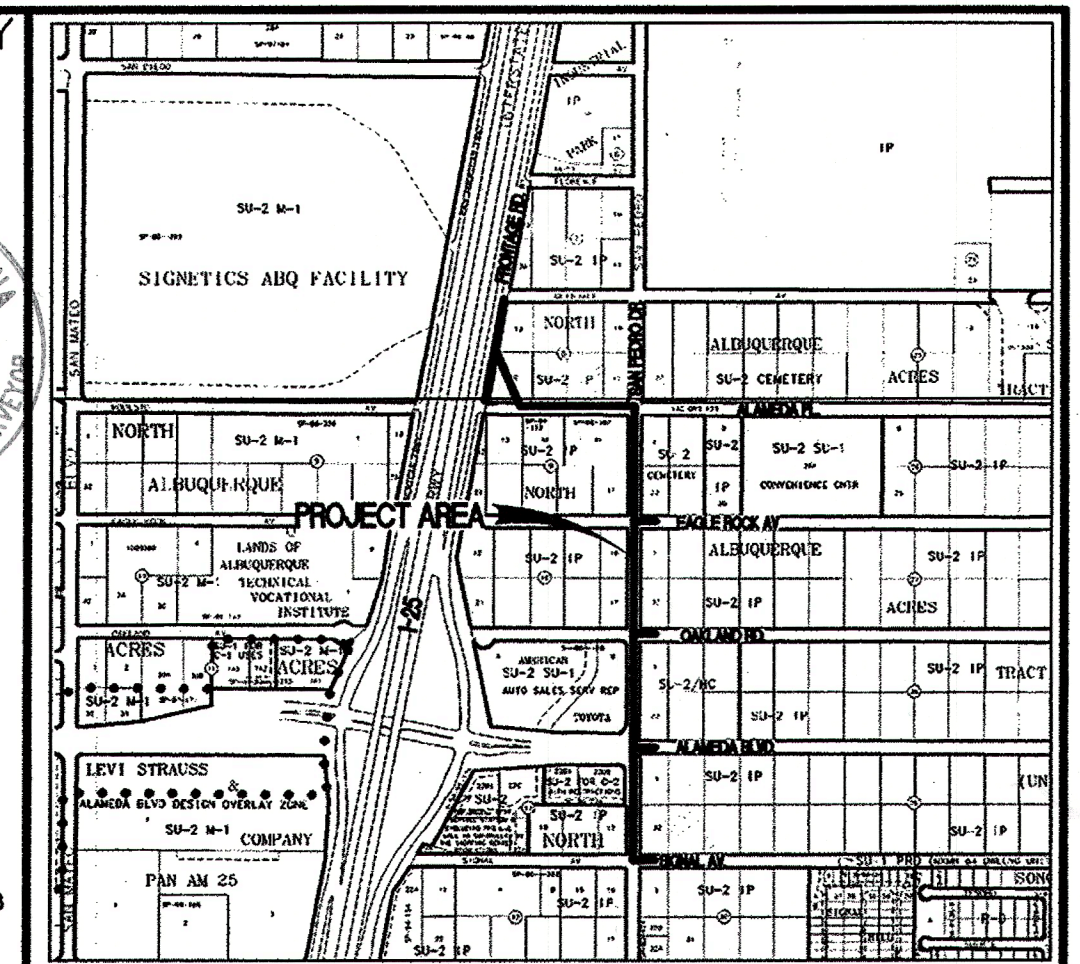

ZONE ATLAS MAP C-18-Z

INDEX OF SHEETS

- | | | | |
|----|--|----|---|
| 1 | TITLE SHEET | 23 | EAGLE ROCK AVE. PLAN & PROFILE 60" RCP |
| 2 | GENERAL NOTES & LEGEND | 24 | SIGNAL AVE. PLAN & PROFILE NORTH 48" RCP |
| 3 | OVERALL LAYOUT | 25 | SIGNAL AVE. PLAN & PROFILE SOUTH 48" RCP |
| 4 | REMOVAL AND PAVING SHEET ALAMEDA PLACE | 26 | T-MANHOLE & STORM INLET DETAILS |
| 5 | REMOVAL AND PAVING SHEET SAN PEDRO DR. | 27 | LANDFILL GAS DETAIL SHEET |
| 6 | REMOVAL AND PAVING SHEET SAN PEDRO DR. | 28 | WATER SHUT-OFF PLAN |
| 7 | REMOVAL AND PAVING SHEET SAN PEDRO DR. | 29 | SAN PEDRO DR. PLAN & PROFILE UTILITY LOWERING |
| 8 | TYPICAL STREET SECTIONS & PAVEMENT SECTIONS | 30 | EAGLE ROCK RD. PLAN & PROFILE UTILITY LOWERING |
| 9 | DRAINAGE EASEMENT PLAN & PROFILE | 31 | OAKLAND AVE. PLAN & PROFILE UTILITY LOWERING |
| 10 | ALAMEDA PLACE PLAN & PROFILE STA. 51+76.70 TO STA. 54+40 | 32 | SIGNAL AVE PLAN & PROFILE UTILITY LOWERING |
| 11 | ALAMEDA PLACE PLAN & PROFILE STA. 54+40 TO STA. 57+28.91 | 33 | JUNCTION BOX #1 DETAIL SHEET |
| 12 | SAN PEDRO DR. PLAN & PROFILE STA. 100+33.79 TO STA. 104+40 | 34 | JUNCTION BOX #2 DETAIL SHEET |
| 13 | SAN PEDRO DR. PLAN & PROFILE 60" RCP AT ALAMEDA PLACE | 35 | JUNCTION BOX #3 DETAIL SHEET |
| 14 | SAN PEDRO DR. PLAN & PROFILE STA. 104+40 TO STA. 106+01.69 | 36 | JUNCTION BOX #4 DETAIL SHEET |
| 15 | SAN PEDRO DR. PLAN & PROFILE 60" RCP AT EAGLE ROCK | 37 | SUGGESTED TRAFFIC CONTROL PLAN PHASE 1 (FOR INFO. ONLY) |
| 16 | SAN PEDRO DR. PLAN & PROFILE STA. 105+33.00 TO STA. 108+00 | 38 | SUGGESTED TRAFFIC CONTROL PLAN PHASE 2 (FOR INFO. ONLY) |
| 17 | SAN PEDRO DR. PLAN & PROFILE STA. 108+00 TO STA. 111+80 | 39 | SUGGESTED TRAFFIC CONTROL PLAN PHASE 3 (FOR INFO. ONLY) |
| 18 | SAN PEDRO DR. PLAN & PROFILE STA. 111+80 TO STA. 115+80 | 40 | SUGGESTED TRAFFIC CONTROL PLAN PHASE 4 (FOR INFO. ONLY) |
| 19 | SAN PEDRO DR. PLAN & PROFILE STA. 115+80 TO STA. 120+00 | 41 | SUGGESTED TRAFFIC CONTROL PLAN PHASE 5 (FOR INFO. ONLY) |
| 20 | SAN PEDRO DR. PLAN & PROFILE STA. 120+00 TO STA. 121+82.86 | 42 | SUGGESTED TRAFFIC CONTROL PLAN PHASE 6 (FOR INFO. ONLY) |
| 21 | SAN PEDRO DR. PLAN & PROFILE 48" RCP AT SIGNAL AVENUE | 43 | SUGGESTED TRAFFIC CONTROL PLAN PHASE 7 (FOR INFO. ONLY) |
| 22 | EAGLE ROCK AVE. PLAN & PROFILE 30" RCP | 44 | SUGGESTED TRAFFIC CONTROL PLAN PHASE 8 (FOR INFO. ONLY) |

UTILITY COMPANY CONTACTS

PNM-ELECTRIC
ANTHONY KOZLOWSKI
Project Manager
4625 Edith Blvd., NE
Albuquerque, New Mexico 87107
(505) 241-3637

AT&T
DAVID STOCKTON
AREA MANAGER-GNFO
DENVER, CO.
(303) 620-2254

QWEST/US WEST
NATALIA ANTONIO
Sr. Designer Engineer
201 3rd Street NW Room 700
Albuquerque, New Mexico 87102
(505) 245-6846

XSPEDIUS
STEVE BENJAMIN
505 Marquette NE, Suite 1605
Albuquerque, New Mexico 87102
(505) 998-2220

MCJ WORLDCOM
ANDY DARNELL
Operation Manager
6001 Midway Park, NE
Albuquerque, NM 87107
(505) 346-4470

TIME WARNER TELECOM
ROYAL HARRISON
Plant Manager
3830 Singer Blvd. NE, Suite 1000
Albuquerque, NM 87109
(505) 938-7339

NEW MEXICO GAS CO.
JOE DUNLOP
MAIL STOP C S66
4625 Edith Blvd., NE
Albuquerque, New Mexico 87107
(505) 697-3156



COMCAST CABLE
MIKE MORTUS
Construction Coordinator
4611 Montbel Pl., NE
Albuquerque, New Mexico 87107
(505) 761-6252

ABCWUA (WATER & SEWER)
ANTHONY MONTOYA, PE.
SENIOR ENGINEER
P.O. Box 1293
Albuquerque, New Mexico 87103
(505) 768-2713

McLeodUSA
RICK MUELLER
Supervisor of Outside Techs.
505 Marquette NE, Suite 1600
Albuquerque, New Mexico 87102
(505) 217-0038

QWEST LONG DISTANCE
LARRY KELLY
400 TIJERAS AVE. NW
SUITE 570
Albuquerque, New Mexico 87102
(505) 246-0501

RED FLEX
BRIAN KORITA
23751 N 23RD AVE.
PHOENIX, AZ 85085
(480) 226-7725

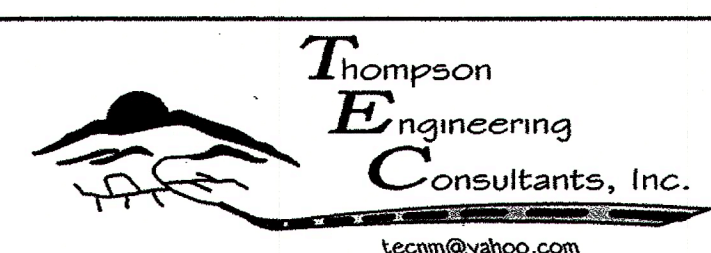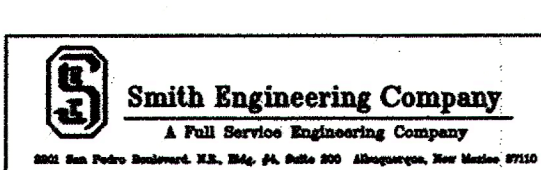

P.O. BOX 65760
ALBUQUERQUE, NM 87193
PHONE: (505) 271-2199
FAX: (505) 830-9246

NOTES:

- CONTRACTOR SHALL WORK CONTINUOUSLY, 24-HOURS PER DAY, ON ALL ARTERIAL ROADWAYS WHEN TRAFFIC LANES ARE CLOSED TO TRAFFIC UNLESS THE WORK VIOLATES THE CITY'S NOISE ORDINANCE.
- IF THE CONTRACTOR IS NOT ALLOWED TO WORK AT NIGHT DUE TO NOISE ORDINANCE VIOLATIONS, THE CONTRACTOR SHALL OPEN ALL TRAFFIC LANES TO TRAFFIC WITH THE PROPER USE OF TRENCH PLATES DURING NON-WORKING HOURS, AND MUST WORK MINIMUM HOURS FROM 7:00 A.M. TO 10:00 P.M. MONDAY THROUGH SATURDAYS.
- ARTERIAL STREETS ARE AS INDICATED IN THE "LONG RANGE ROADWAY SYSTEM" MAP PUBLISHED BY THE MID-REGION COUNCIL OF GOVERNMENTS (MRCOG).

DISCLOSURE STATEMENT:



"THE SUBJECT PROPERTY IS LOCATED NEAR, A FORMER, LANDFILL. DUE TO THE SUBJECT PROPERTY BEING NEAR, A FORMER LANDFILL, CERTAIN PRECAUTIONARY MEASURES MAY NEED TO BE TAKEN TO ENSURE THE HEALTH AND SAFETY OF THE PUBLIC. RECOMMENDATIONS MADE BY A PROFESSIONAL ENGINEER WITH EXPERTISE IN LANDFILLS AND LANDFILL GAS ISSUES (AS REQUIRED BY THE MOST CURRENT VERSION OF THE "INTERIM GUIDELINES FOR DEVELOPMENT WITHIN 1000 FEET OF LANDFILLS") SHALL BE CONSULTED PRIOR TO DEVELOPMENT OF THE SITE."

APPROVED FOR CONSTRUCTION

Suzanne Busch
ENVIRONMENTAL HEALTH DEPARTMENT
CITY OF ALBUQUERQUE

9/30/09
DATE

REV.	SHEETS	CITY ENGINEER	DATE	USER DEPARTMENT	DATE	USER DEPARTMENT	DATE
ENGINEERS STAMP & SIGNATURE		APPROVED	ENGINEER	DATE	APPROVED FOR CONSTRUCTION		
		DRC Chairman		3/11/10			
		Transportation		9/30/09			
		Water/Wastewater		3-4-10			
		Hydrology		3/1/10			
		G&P E&H	Suzanne Busch	9/30/09			
		AMAFCA					
		Constr. Coord.			CITY ENGINEER DATE		
PROJECT NUMBER		Zone Map No.		DRAWING NO. 1 OF 44			
5304.91		C-18-Z					

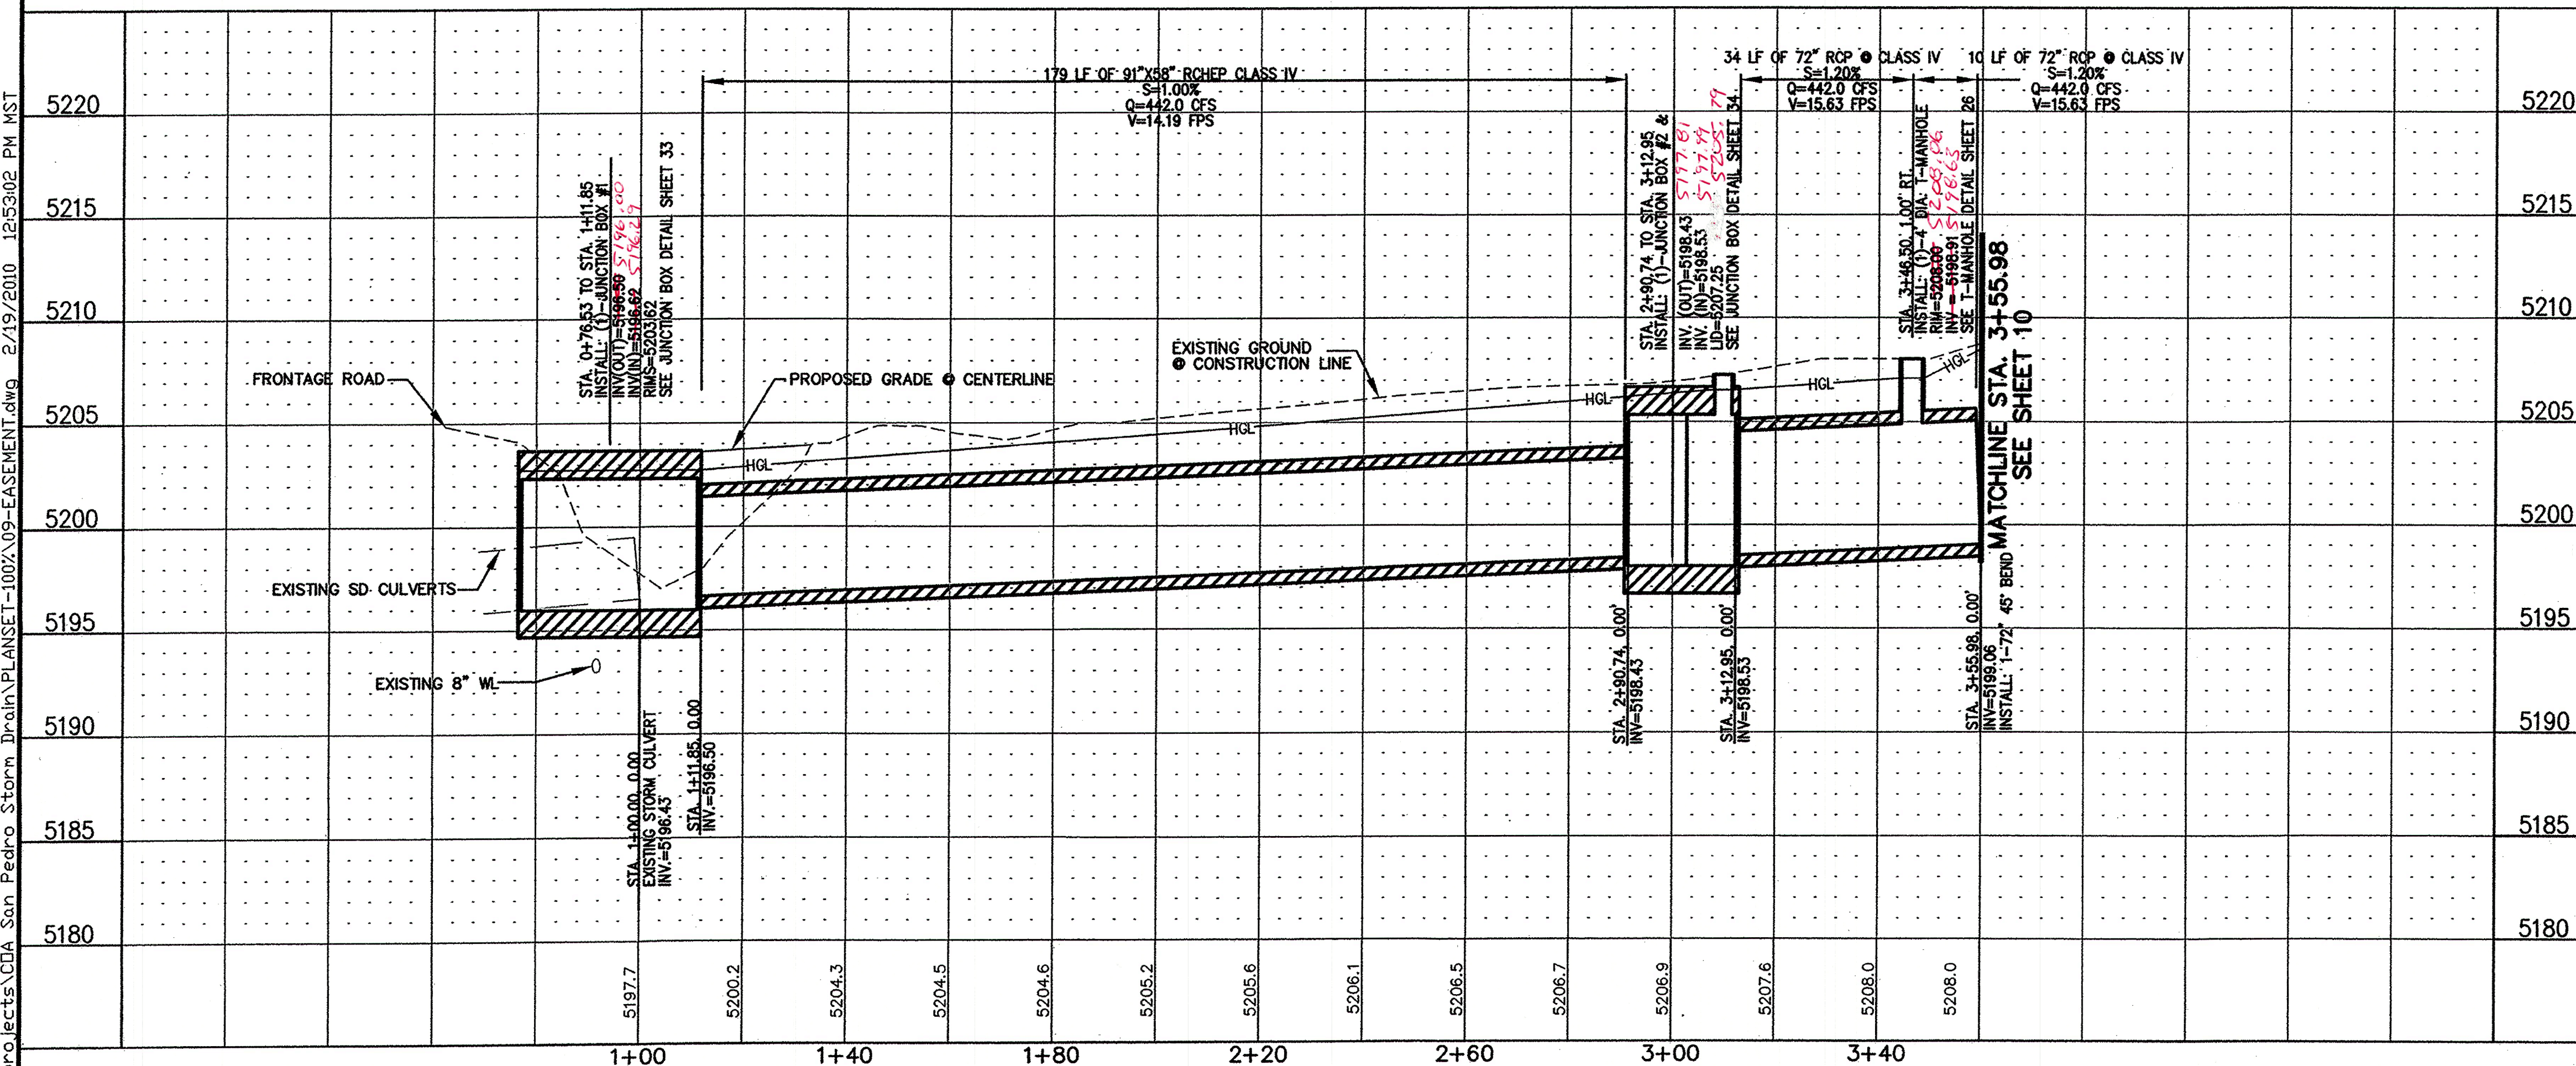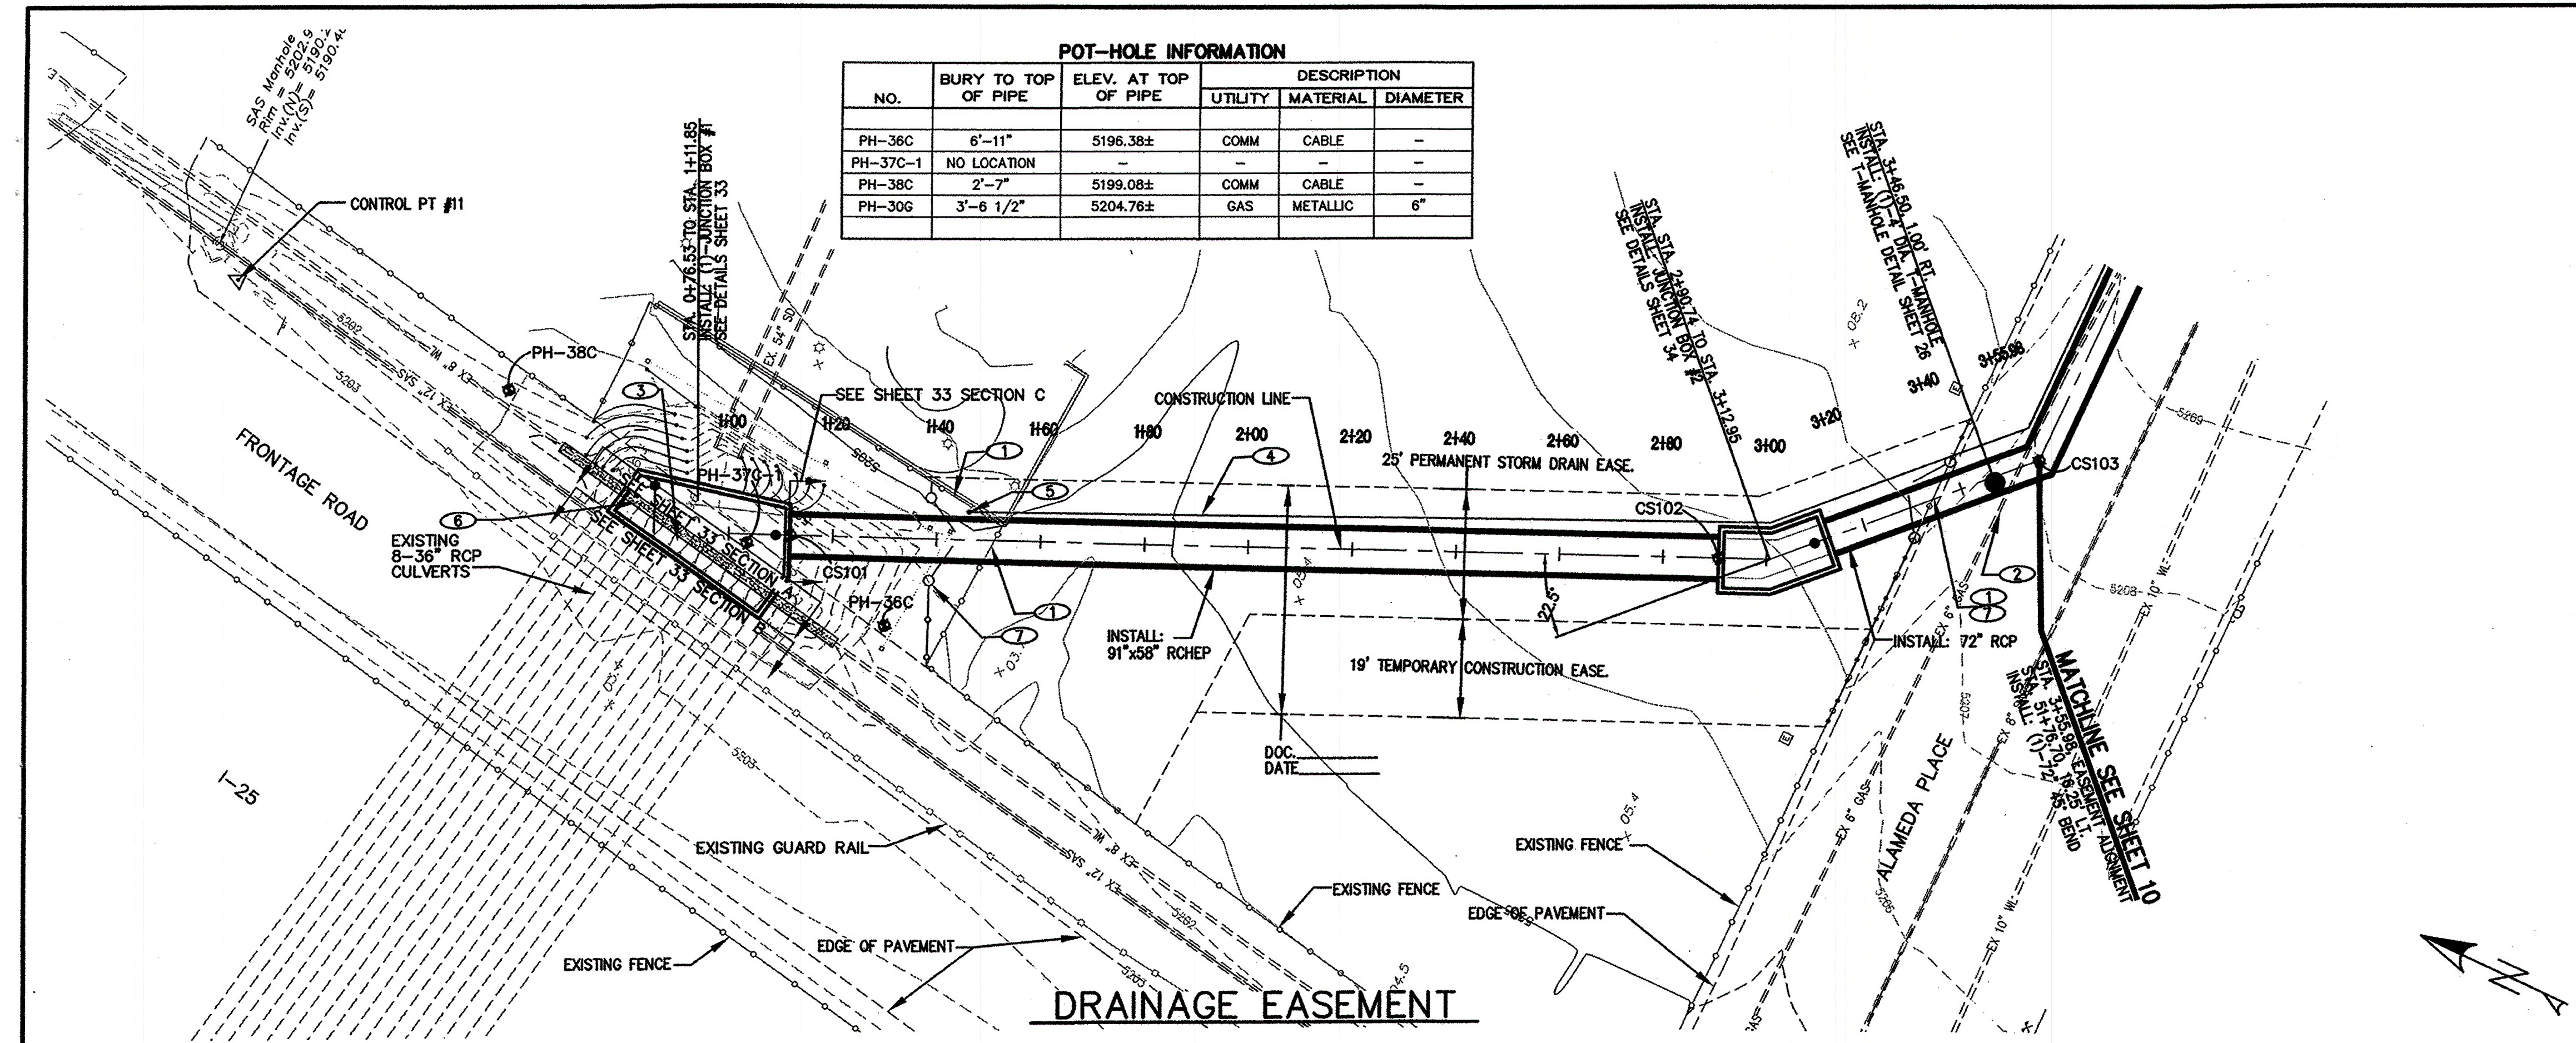

KEYED NOTES:



- 1 REMOVE AND REPLACE CHAIN LINK FENCE PER COA STD DWG 2252
- 2 EXISTING 8" GAS LINE TO BE REMOVED & RELOCATED (BY OTHERS)
- 3 REMOVE AND DISPOSE 8-36" CMP ENDS AND CONCRETE SLOPE PAVEMENT SEE SHEET 4
- 4 CONTRACTOR TO INSTALL: 4" PERFORATED PIPE, FILTER FABRIC, AND 3/4" ROUND ROCK, SEE DETAIL SHEET 27
- 5 CONTRACTOR TO INSTALL 4" DUCTILE IRON GAS VENT, SEE DETAIL SHEET 27
- 6 ENCASE 65 LF OF EXISTING 8" WL W/CONCRETE. PER COA STD DWG 2140 CONTRACTOR TO FIELD VERIFY LOCATION OF 8" WL
- 7 INSTALL CHAIN LINK FENCE AND 16' WIDE GATE PER COA STD DWG 2252

NOTES:

1. IF TRASH IS ENCOUNTERED DURING THE INSTALLATION OF THE PROPOSED STORM DRAIN FACILITIES OR WATER LINE FACILITIES THE CONTRACTOR SHALL REMOVE AND DISPOSE OF ALL TRASH WITHIN THE TRENCH PRISM / AREA. ALL TRASH MUST BE DISPOSED OF AT A LANDFILL REGISTERED / LICENSED WITH THE STATE OF NEW MEXICO.
2. IF TRASH IS ENCOUNTERED, CONTRACTOR SHALL REMOVE AND DISPOSE OF ALL TRASH LOCATED UNDER ANY PROPOSED PIPING (STORM DRAIN OR WATERLINE). CONTRACTOR SHALL REPLACE THE VOIDED AREA LEFT FROM THE TRASH REMOVAL WITH SUITABLE MATERIAL. THE SUITABLE MATERIAL SHALL BE COMPACTED IN EIGHT (8) INCH LIFTS TO 95% PER ASTM D-1557. PLACEMENT AND COMPACTION OF THE SUITABLE MATERIAL UNDER THE PROPOSED PIPES SHALL BE CONSIDERED INCIDENTAL TO TRASH REMOVAL AND DISPOSAL AND NO SEPARATE OR ADDITIONAL PAYMENT WILL BE MADE. IF TRASH IS FOUND TO EXIST DEEPER THAN THE FIVE(5) FEET MENTIONED ABOVE, THE CONTRACTOR SHALL COORDINATE WITH SCS FIELD SERVICES (505-349-8060) TO INSTALL MONITORING WELLS.

CONSTRUCTION SURVEY POINTS

PT #	Northing	Easting
CS101	1524915.673	1542393.974
CS102	1524751.885	1542455.456
CS103	1524703.687	1542508.546

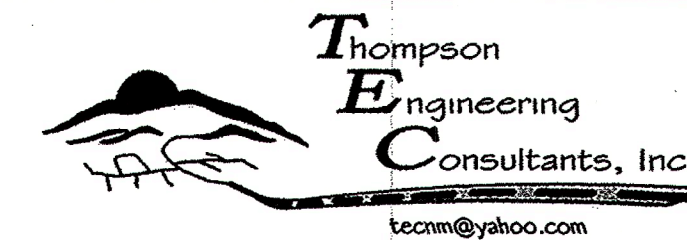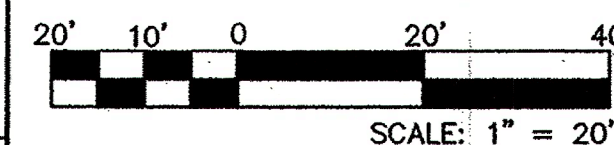

P.O. BOX 65760
ALBUQUERQUE, NM 87193
PHONE: (505) 271-2199
FAX: (505) 830-9248

CITY OF ALBUQUERQUE
DEPARTMENT OF MUNICIPAL DEVELOPMENT
ENGINEERING DIVISION


TITLE: **SAN PEDRO STORM DRAIN
DRAINAGE EASEMENT PLAN & PROFILE**

Design Review Committee APPROVED MAR 11 2010 DESIGN REVIEW COMMITTEE	City Engineer Approval APPROVED MAR 11 2010 CITY ENGINEER
--	---

No. / Day / Yr.	No. / Day / Yr.


City Project No. 5304.91	Zone Map No. C-18-Z	Sheet 9 Of 44
---------------------------------	----------------------------	-----------------------------

Q:\Projects\CDAs San Pedro Storm Drain\PLANSET-100%10-ALAMEDA PL-01.dwg 2/19/2010 12:53:25 PM MST

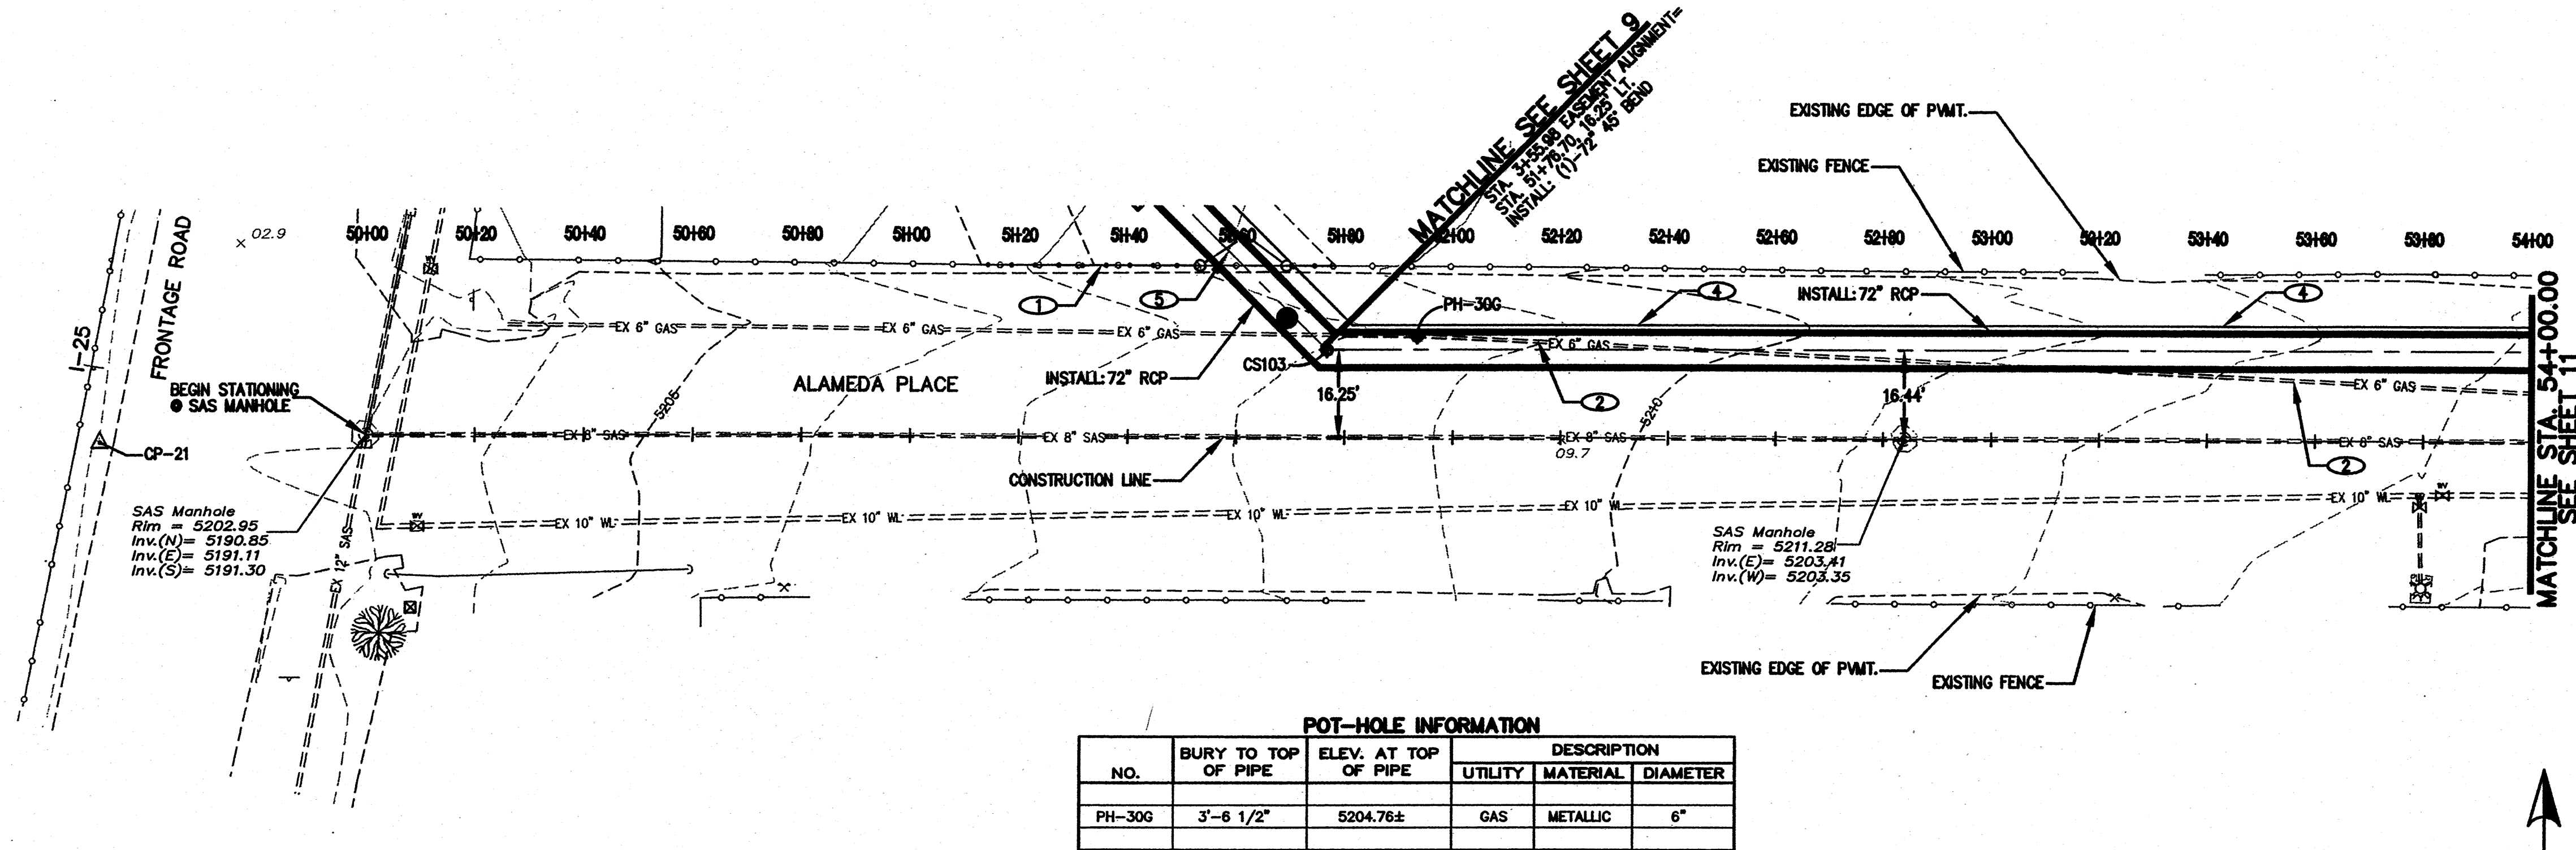

POT-HOLE INFORMATION					
NO.	BURY TO TOP OF PIPE	ELEV. AT TOP OF PIPE	DESCRIPTION		
			UTILITY	MATERIAL	DIAMETER
PH-306	3'-6 1/2"	5204.76±	GAS	METALLIC	6"

ALAMEDA PLACE

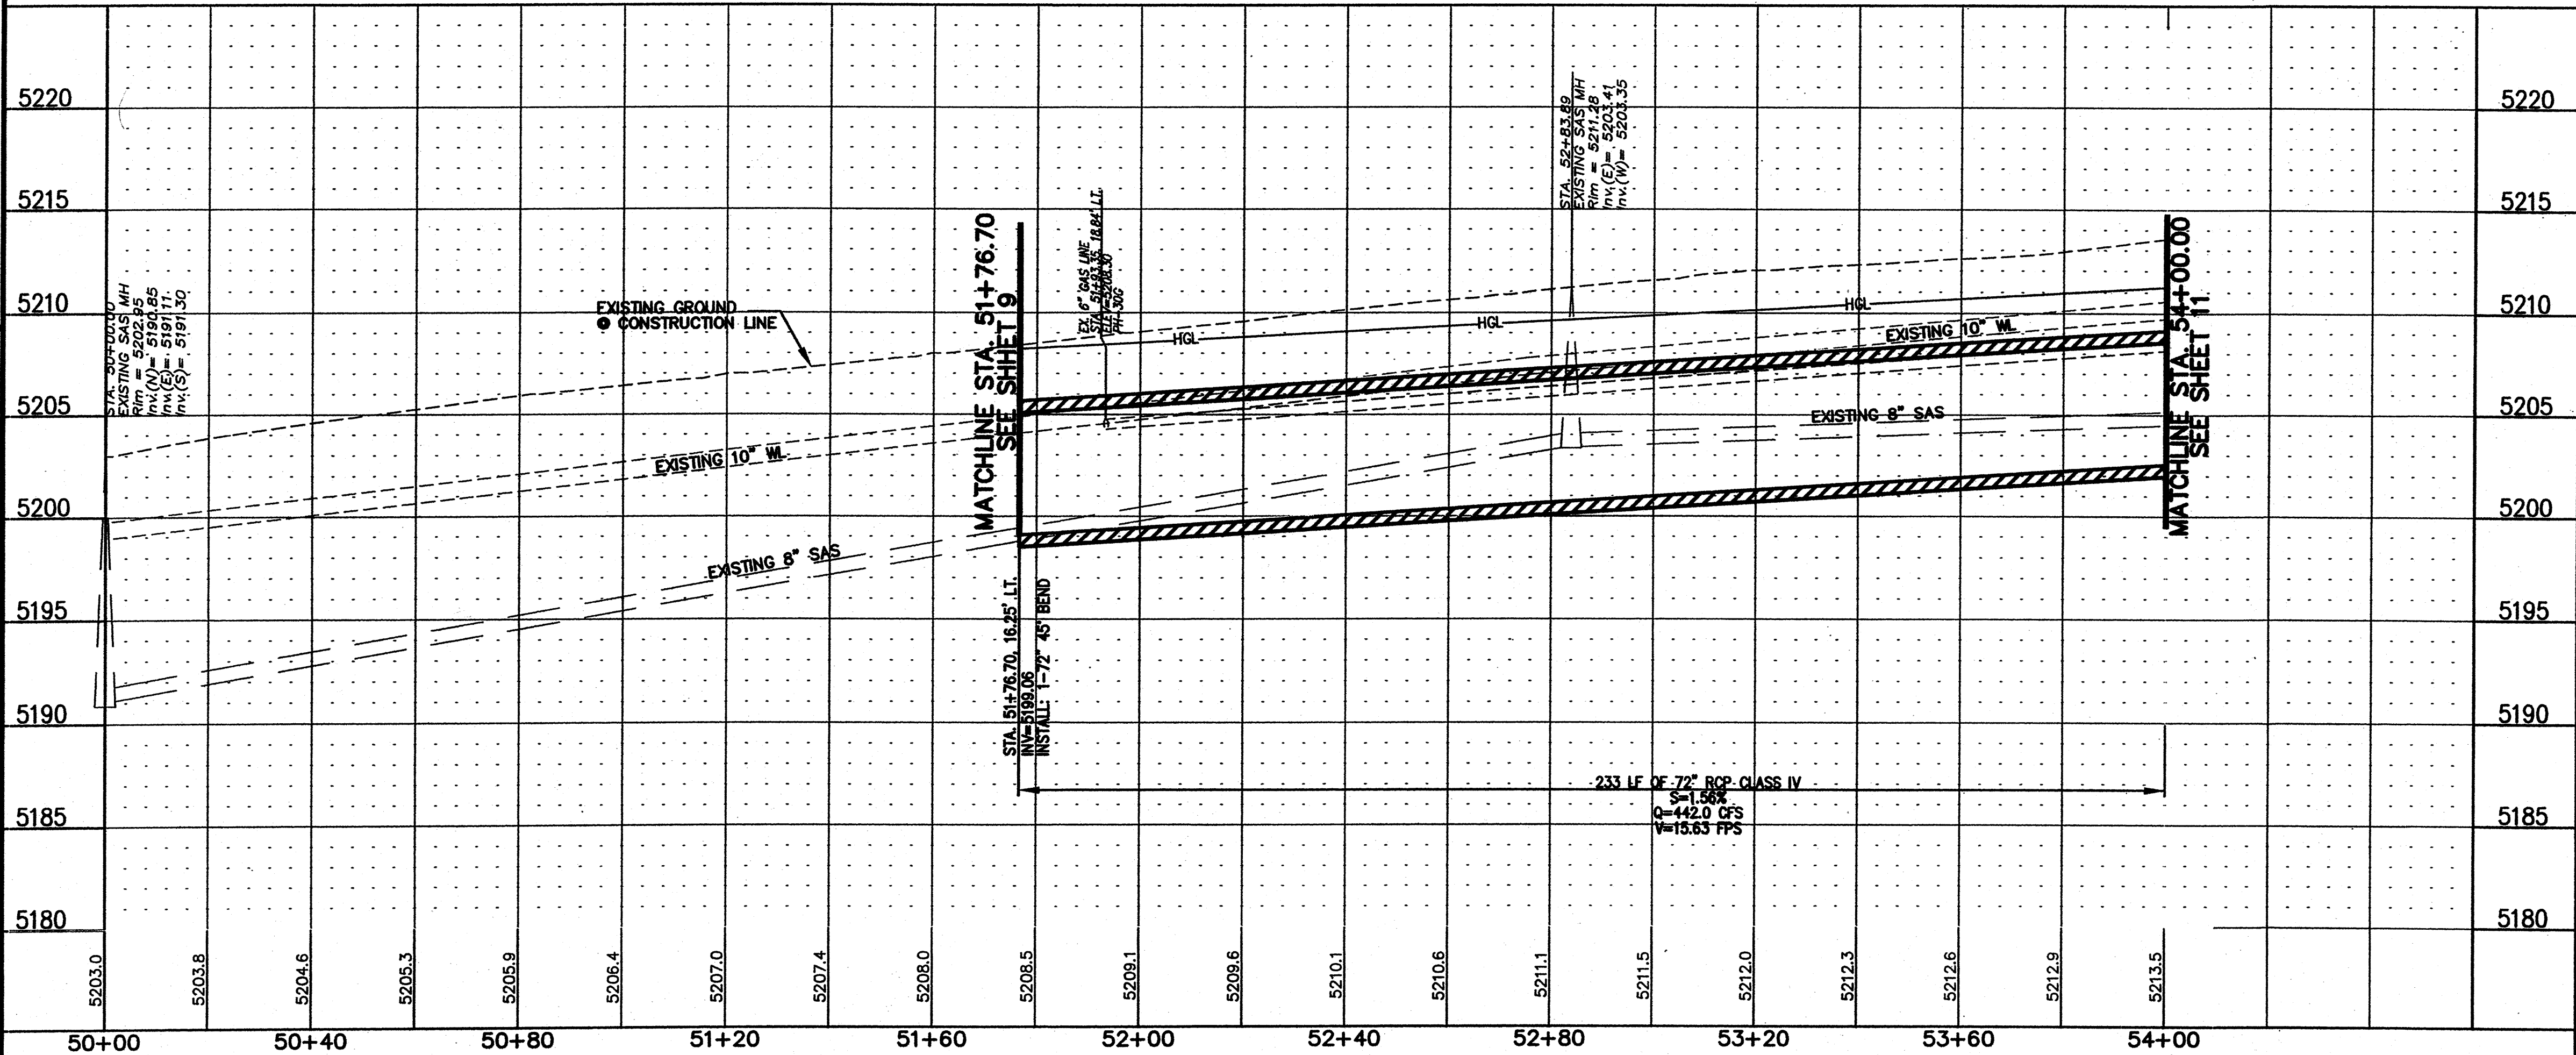

KEYED NOTES:



- REMOVE AND REPLACE CHAIN LINK FENCE PER COA STD DWG 2252
- EXISTING 6" GAS LINE TO BE REMOVED & RELOCATED (BY OTHERS)
- NOT USED
- CONTRACTOR TO INSTALL: 4" PERFORATED PIPE, FILTER FABRIC, AND 3/4" ROUND ROCK, SEE DETAIL SHEET 27
- INSTALL CHAIN LINK FENCE AND 16" WIDE GATE PER COA STD DWG 2252

NOTES:

- IF TRASH IS ENCOUNTERED DURING THE INSTALLATION OF THE PROPOSED STORM DRAIN FACILITIES OR WATER LINE FACILITIES THE CONTRACTOR SHALL REMOVE AND DISPOSE OF ALL TRASH WITHIN THE TRENCH PRISM / AREA. ALL TRASH MUST BE DISPOSED OF AT A LANDFILL REGISTERED / LICENSED WITH THE STATE OF NEW MEXICO.
- IF TRASH IS ENCOUNTERED, CONTRACTOR SHALL REMOVE AND DISPOSE OF ALL TRASH LOCATED UNDER ANY PROPOSED PIPING (STORM DRAIN OR WATERLINE). CONTRACTOR SHALL REPLACE THE VOIDED AREA LEFT FROM THE TRASH REMOVAL WITH SUITABLE MATERIAL. THE SUITABLE MATERIAL SHALL BE COMPACTED IN EIGHT (8) INCH LIFTS TO 95% PER ASTM D-1557. PLACEMENT AND COMPACTION OF THE SUITABLE MATERIAL UNDER THE PROPOSED PIPES SHALL BE CONSIDERED INCIDENTAL TO TRASH REMOVAL AND DISPOSAL AND NO SEPARATE OR ADDITIONAL PAYMENT WILL BE MADE. IF TRASH IS FOUND TO EXIST DEEPER THAN THE FIVE(5) FEET MENTIONED ABOVE, THE CONTRACTOR SHALL COORDINATE WITH SCS FIELD SERVICES (505-349-8060) TO INSTALL MONITORING WELLS.

RECORD DRAWING


CONSTRUCTION SURVEY POINTS		
CS103	1524703.687	1542508.546

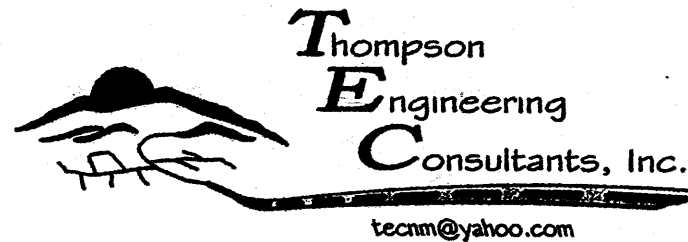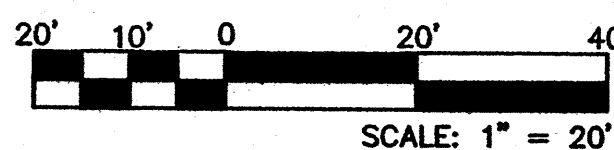

P.O. BOX 65760 ALBUQUERQUE, NM 87193 PHONE: (505) 271-2199 FAX: (505) 830-9246

CITY OF ALBUQUERQUE
DEPARTMENT OF MUNICIPAL DEVELOPMENT
ENGINEERING DIVISION

TITLE: **SAN PEDRO STORM DRAIN
ALAMEDA PLACE PLAN & PROFILE
STA. 51+76.70 TO STA. 54+40**

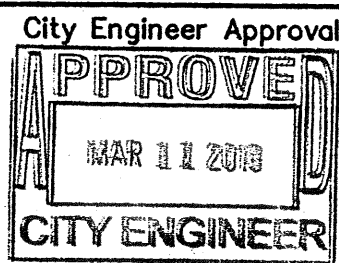

City Project No.

5304.91

Zone Map No.

C-18-Z


Sheet

10


of

44

AS BUILT INFORMATION			
CONTRACTOR	STATION STAMPED	DATE	DATE
WORKED BY	CITY OF ALBUQUERQUE SURVEY 3 1/4"	10-C18 1985	DATE 1/2010
ISSUED BY	ALUMINUM DISK RIVETED TO PIPE LOCATED	DATE 1/2010	DATE 1/2010
ACCEPTANCE BY	BETWEEN ALAMEDA PL & EAGLE ROCK RD	DATE 1/2010	DATE 1/2010
VERIFICATION BY	ON SAN PEDRO BLVD. EAST SIDE OF ROAD	DATE 1/2010	DATE 1/2010
DRAWINGS	X=1524123.885 Y=1542565.263	DATE 1/2010	DATE 1/2010
CORRECTED BY	G-C-0.99965042	DATE 1/2010	DATE 1/2010
MICRO-FILM INFORMATION	AX=0' 11" 19.43"	DATE 1/2010	DATE 1/2010
RECORDED BY	ELEVATION=5222.08 (NAD 1983)	DATE 1/2010	DATE 1/2010
NO.			

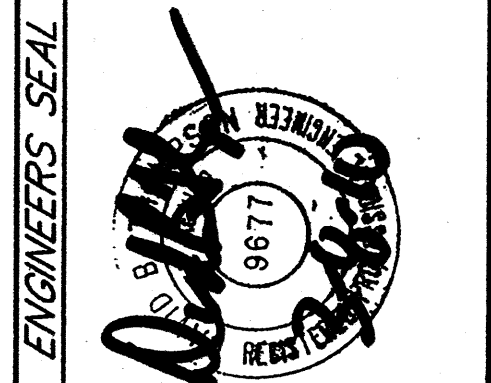


SURVEY INFORMATION		ENGINEER'S SEAL	
FIELD NOTES	NO.	REMARKS	BY
DATE	DATE	REVISIONS	DATE
BY	DATE	DESIGN	DATE
NO.	DATE	D.E.M.	DATE
NO.	DATE	D.E.M.	DATE
NO.	DATE	D.B.T.	DATE

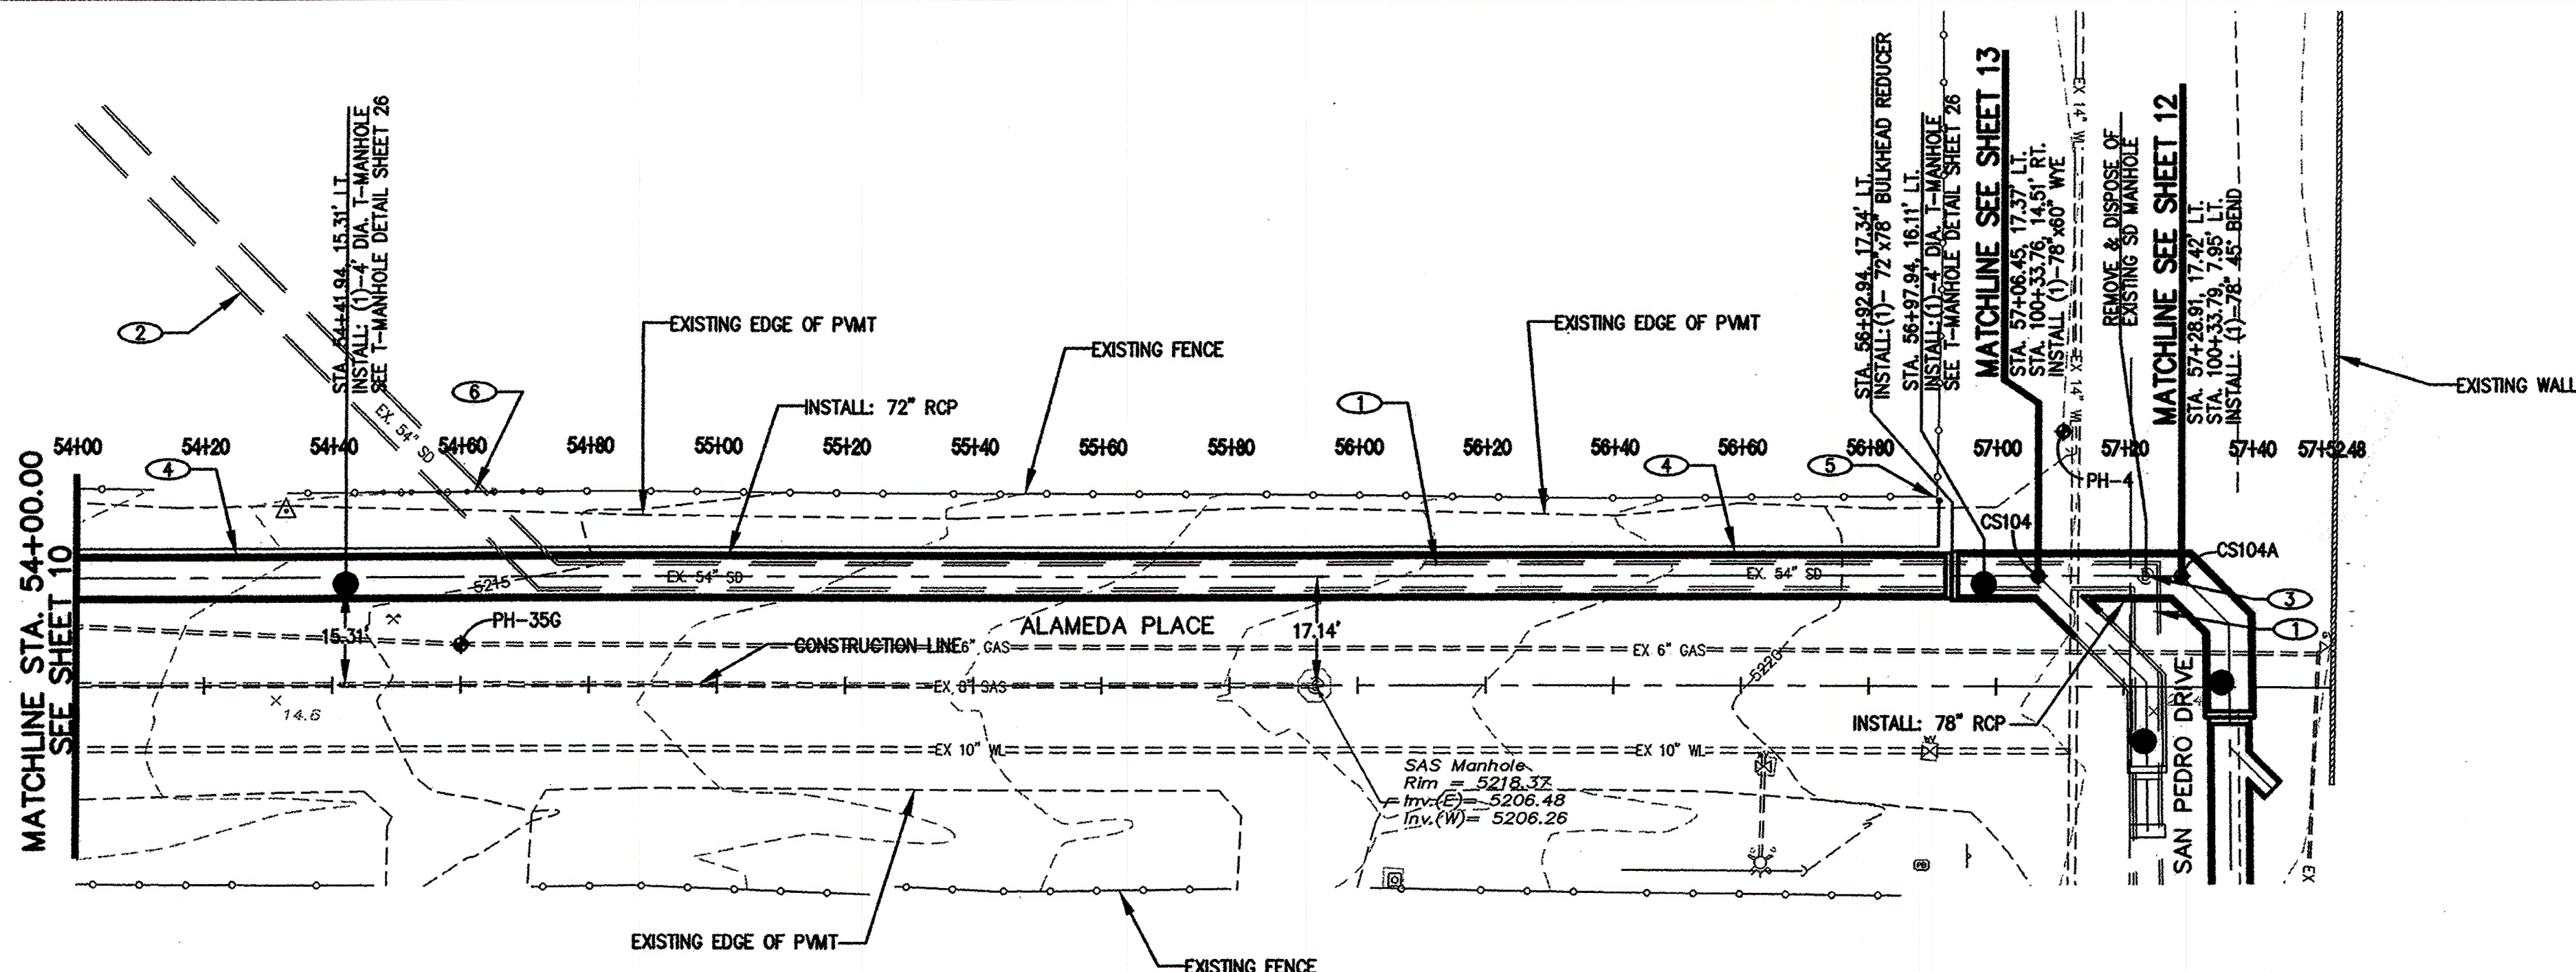

POT-HOLE INFORMATION					
NO.	BURY TO TOP OF PIPE	ELEV. AT TOP OF PIPE	UTILITY	DESCRIPTION	DIAMETER
PH-35G	5'-7"	5209.77±	GAS	METALLIC	6"
PH-28G	5'-1"	5215.98±	GAS	METALLIC	6"
PH-29W	3'-6"	5217.64±	WATER	PVC	14"
PH-27G	2'-9"	5218.83±	GAS	METALLIC	6"
PH-26G	3'-9"	5218.51±	GAS	METALLIC	4"
PH-4	3'-5"	5217.75±	WATER	PVC	14"

ALAMEDA PLACE

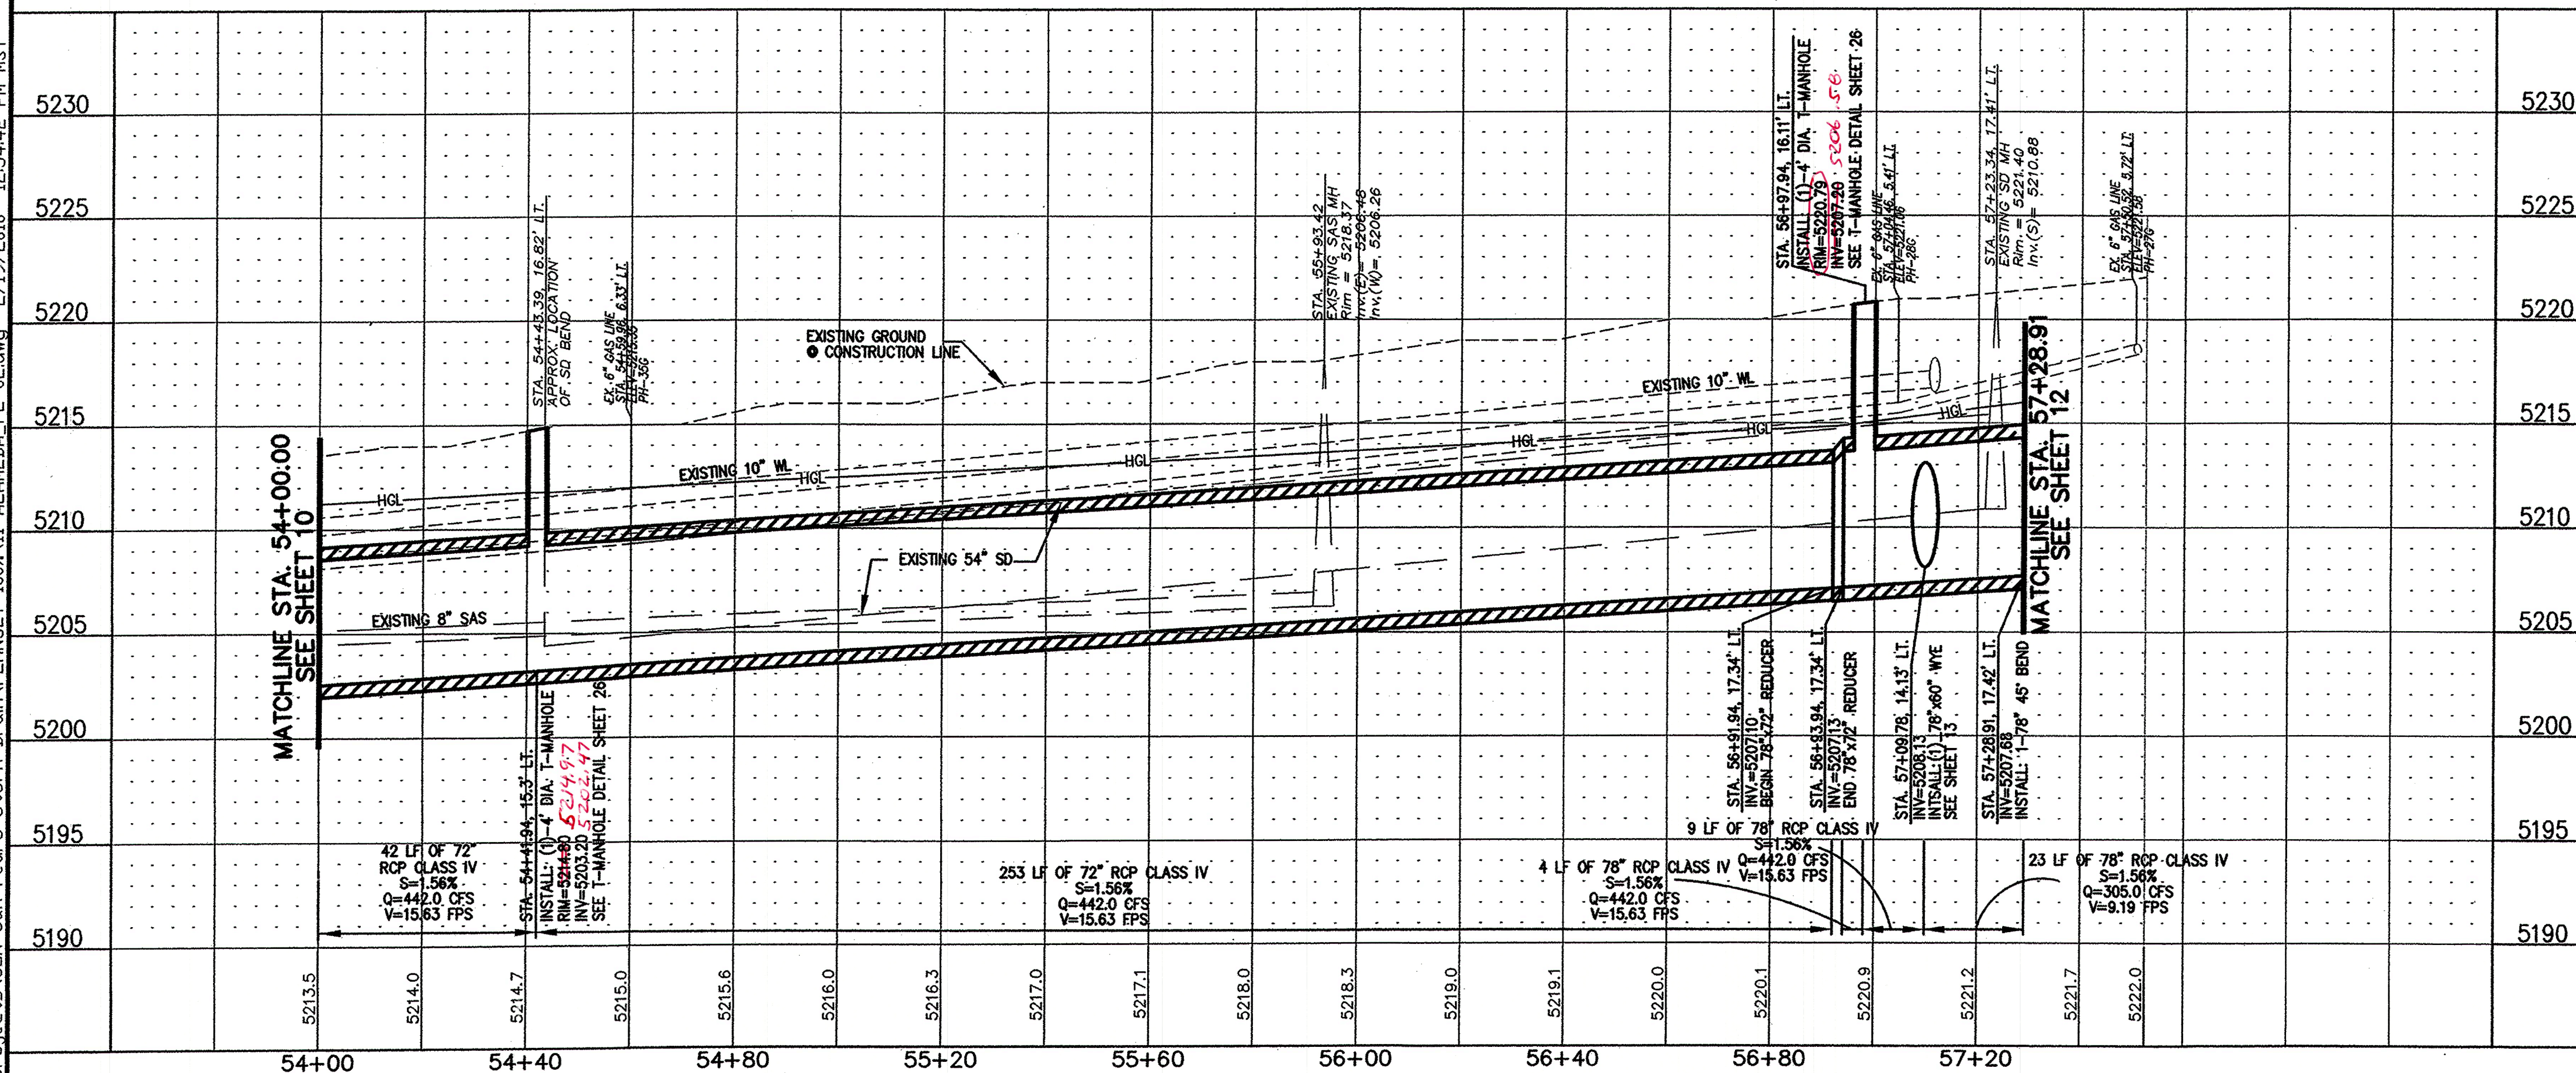

KEYED NOTES:



- 1 REMOVE AND DISPOSE OF 54" RCP STORM DRAIN
- 2 EXISTING 54" STORM DRAIN TO BE ABANDONED IN PLACE
- 3 REMOVE AND DISPOSE EXISTING MANHOLE
- 4 CONTRACTOR TO INSTALL: 4" PERFORATED PIPE, FILTER FABRIC, AND 3/4" ROUND ROCK, SEE DETAIL SHEET 27
- 5 CONTRACTOR TO INSTALL 4" DUCTILE IRON GAS VENT. SEE DETAIL SHEET 27
- 6 REMOVE AND REPLACE CHAIN LINK FENCE PER COA STD DWG 2252

NOTES:

1. IF TRASH IS ENCOUNTERED DURING THE INSTALLATION OF THE PROPOSED STORM DRAIN FACILITIES OR WATER LINE FACILITIES THE CONTRACTOR SHALL REMOVE AND DISPOSE OF ALL TRASH WITHIN THE TRENCH PRISM / AREA. ALL TRASH MUST BE DISPOSED OF AT A LANDFILL REGISTERED / LICENSED WITH THE STATE OF NEW MEXICO.
2. IF TRASH IS ENCOUNTERED, CONTRACTOR SHALL REMOVE AND DISPOSE OF ALL TRASH LOCATED UNDER ANY PROPOSED PIPING (STORM DRAIN OR WATERLINE). CONTRACTOR SHALL REPLACE THE VOIDED AREA LEFT FROM THE TRASH REMOVAL WITH SUITABLE MATERIAL. THE SUITABLE MATERIAL SHALL BE COMPACTED IN EIGHT (8) INCH LIFTS TO 95% PER ASTM D-1557. PLACEMENT AND COMPACTION OF THE SUITABLE MATERIAL UNDER THE PROPOSED PIPES SHALL BE CONSIDERED INCIDENTAL TO TRASH REMOVAL AND DISPOSAL AND NO SEPARATE OR ADDITIONAL PAYMENT WILL BE MADE. IF TRASH IS FOUND TO EXIST DEEPER THAN THE FIVE(S) FEET MENTIONED ABOVE, THE CONTRACTOR SHALL COORDINATE WITH SCS FIELD SERVICES (505-349-8060) TO INSTALL MONITORING WELLS.

CONSTRUCTION SURVEY POINTS


PT #	Northing	Easting
CS104	1524703.687	1543038.295
CS104A	1524703.687	1543060.757

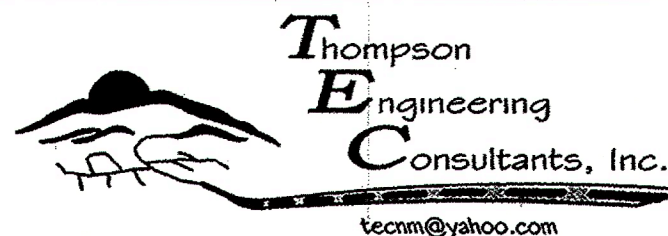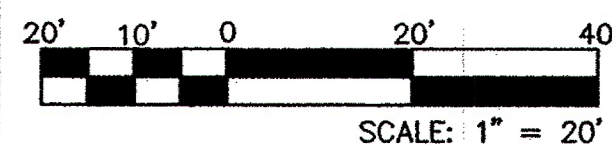

P.O. BOX 65760
ALBUQUERQUE, NM 87193
PHONE: (505) 271-2199
FAX: (505) 830-9248

CITY OF ALBUQUERQUE
DEPARTMENT OF MUNICIPAL DEVELOPMENT
ENGINEERING DIVISION

TITLE: SAN PEDRO STORM DRAIN
ALAMEDA PLACE PLAN & PROFILE
STA. 54+40 TO STA. 57+28.91

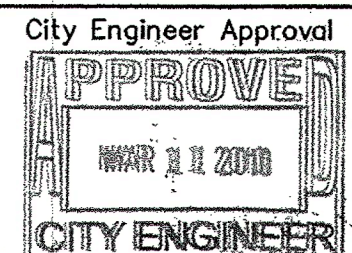

City Project No.

5304.91

Zone Map No.

C-18-Z

Sheet

11

Of

44



REVISIONS		BY	
NO.	DATE	NO.	DATE
1	DESIGN		
2			
3			
4			
5			
6			
7			
8			
9			
10			


SURVEY INFORMATION		FIELD NOTES	
NO.	DATE	NO.	DATE
1		1	
2		2	
3		3	
4		4	
5		5	
6		6	
7		7	
8		8	
9		9	
10		10	



REVISIONS		BY	
NO.	DATE	NO.	DATE
1	DESIGN		
2			
3			
4			
5			
6			
7			
8			
9			
10			

CITY OF ALBUQUERQUE
DEPARTMENT OF MUNICIPAL DEVELOPMENT
ENGINEERING DIVISION

TITLE: SAN PEDRO STORM DRAIN
ALAMEDA PLACE PLAN & PROFILE
STA. 54+40 TO STA. 57+28.91

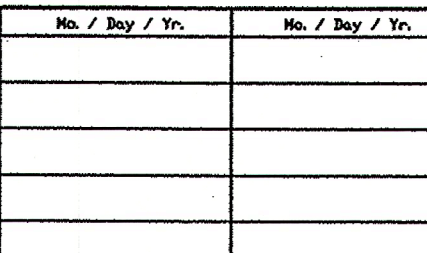

City Project No.

5304.91

Zone Map No.

C-18-Z


Sheet

11

Of

44

Q:\projects\CDM San Pedro Storm Drain\PLANSET-100+33.79-SAN PEDRO-01.dwg 2/19/2010 12:56:53 PM MST

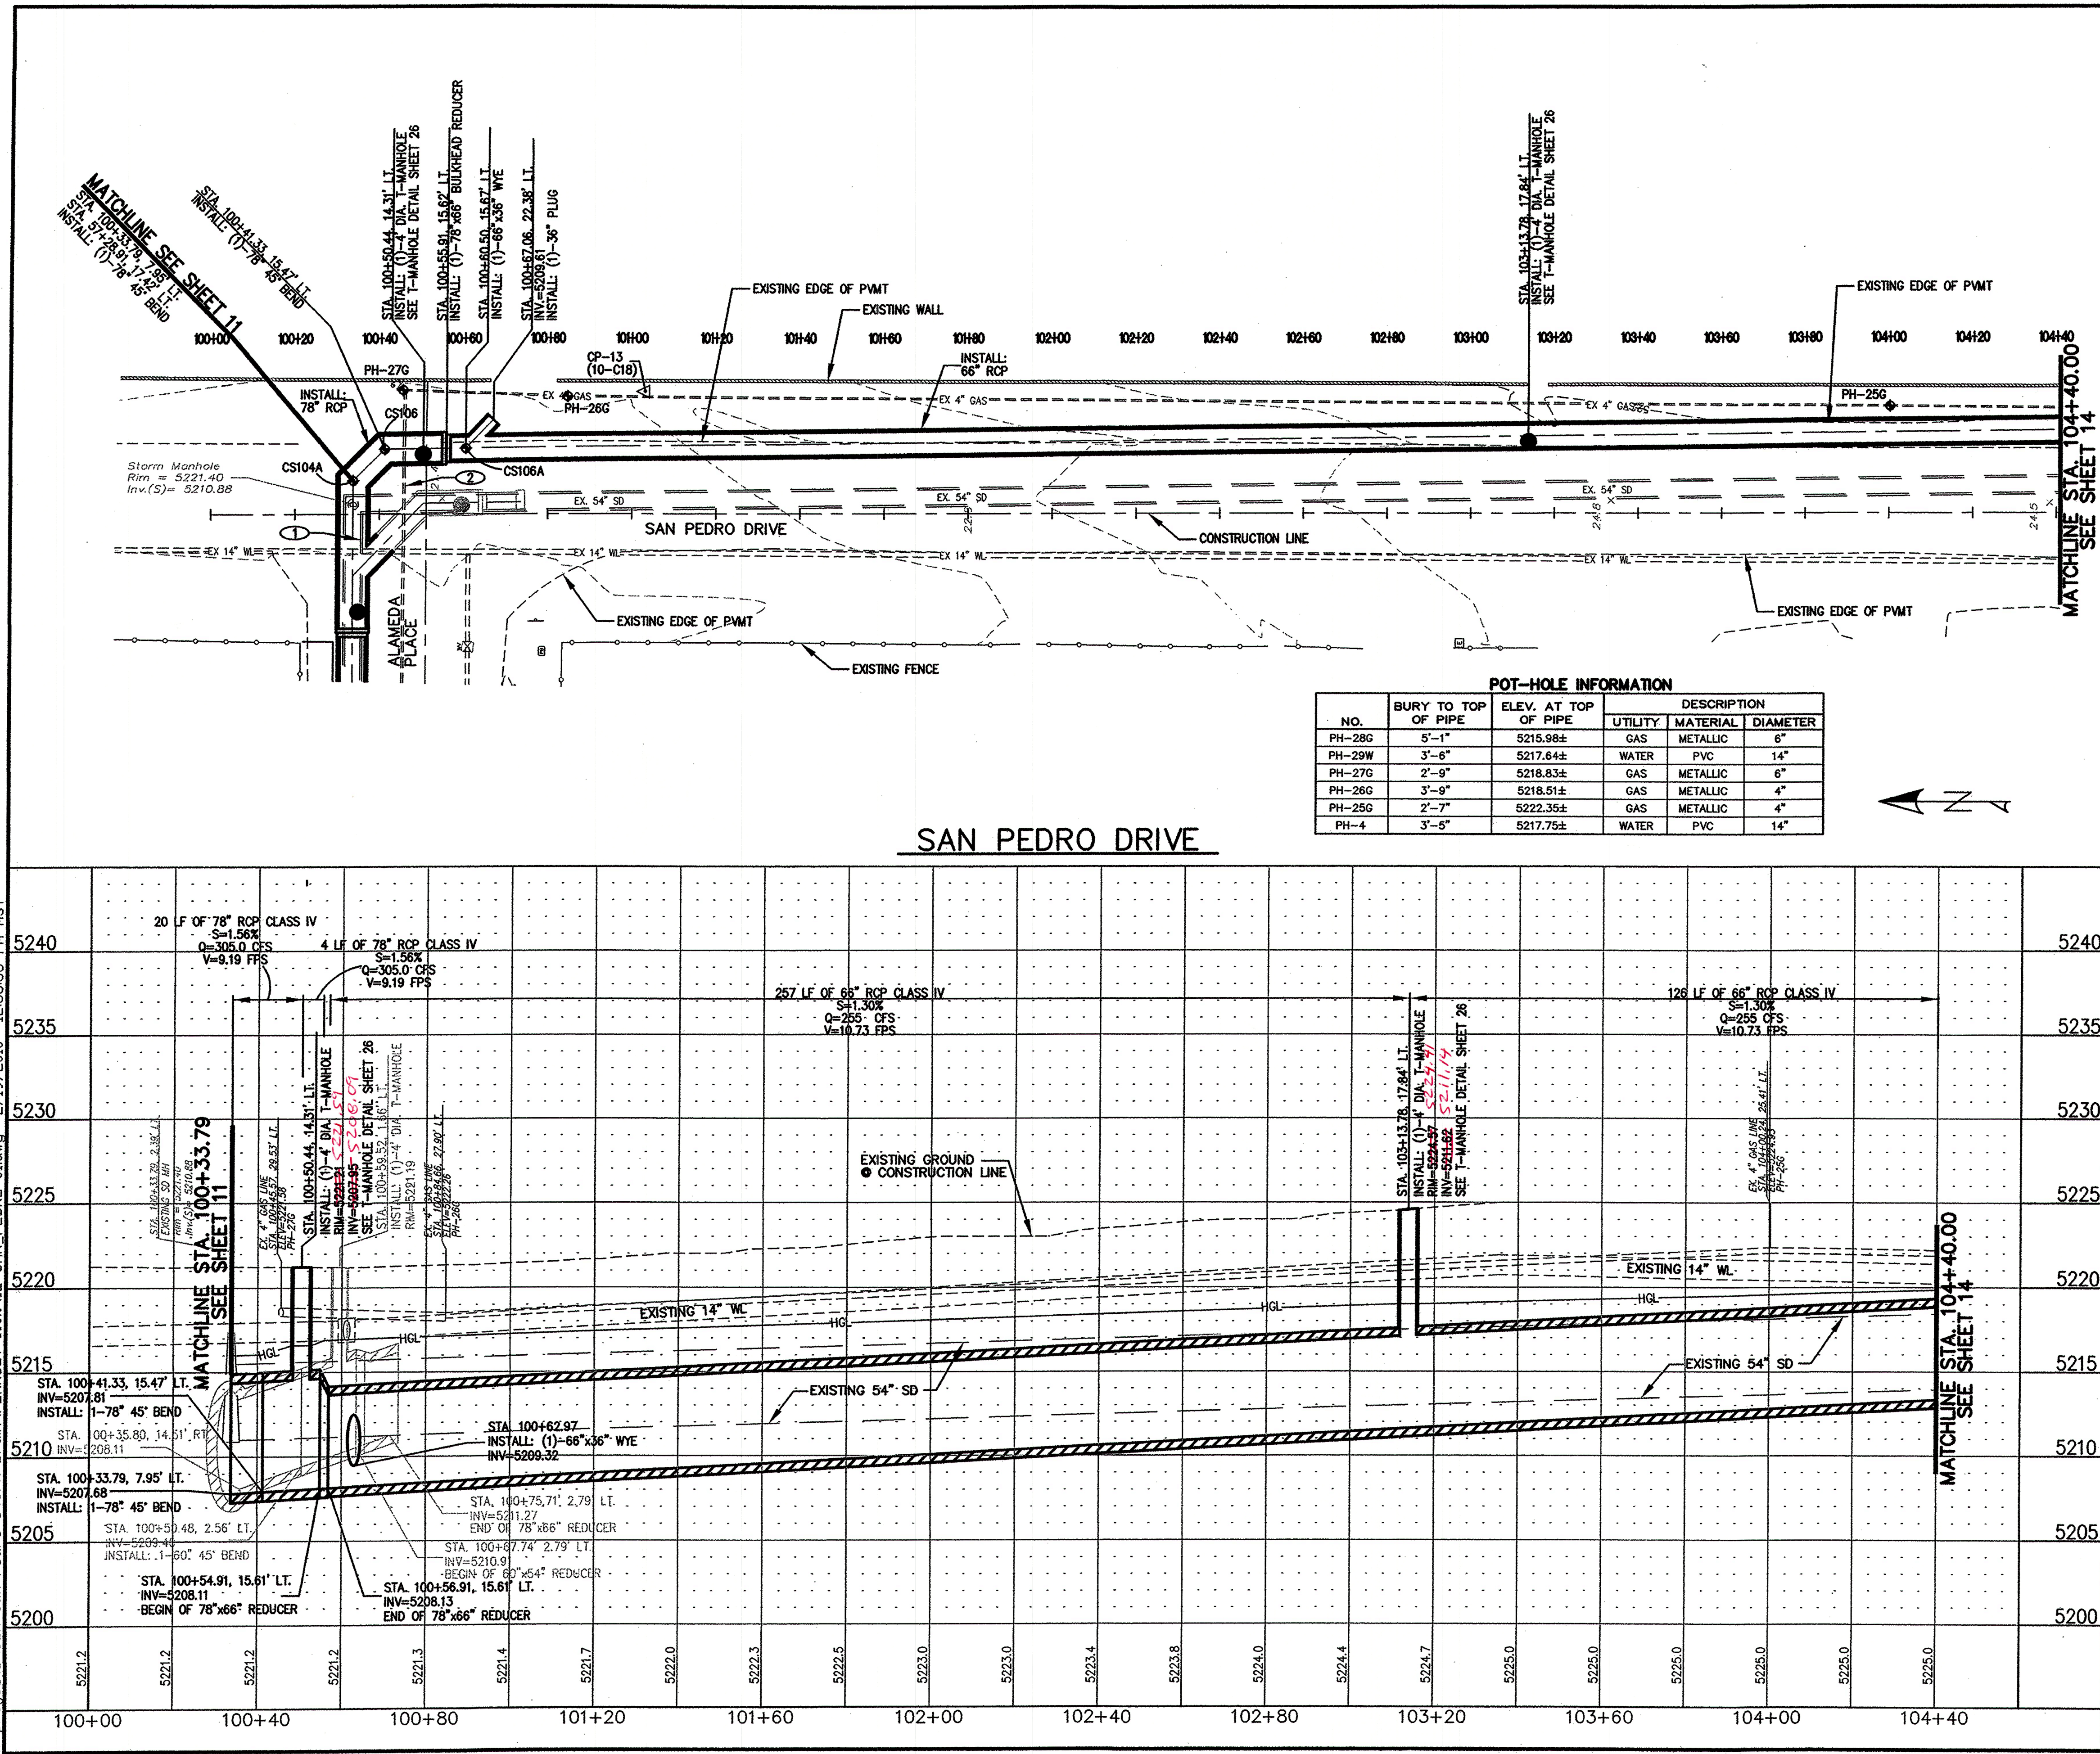

AS BUILT INFORMATION

CONTRACTOR	DATE	DATE	DATE
CITY OF ALBUQUERQUE SURVEY 3 1/4"			
WORK STARTED BY			
APPROVED BY			
FIELD CHECKED BY			
REVISIONS			
NO.	DATE	DATE	DATE
1	3-10	3-10	3-10

ENGINEER'S SEAL

REVISIONS

NO.	DATE	REMARKS
1	3-10	DESIGN

DESIGNED BY D.E.M. **DRAWN BY** D.E.M. **CHECKED BY** D.B.T.


Thompson Engineering Consultants, Inc.
P.O. BOX 65760 ALBUQUERQUE, NM 87193 PHONE: (505) 271-2199 FAX: (505) 630-9246

CITY OF ALBUQUERQUE DEPARTMENT OF MUNICIPAL DEVELOPMENT ENGINEERING DIVISION


TITLE: SAN PEDRO STORM DRAIN
SAN PEDRO DR. PLAN & PROFILE 66" RCP
STA. 100+33.79 TO STA. 104+40

Design Review Committee APPROVED MAR 11 2010 **City Engineer Approval APPROVED** MAR 11 2010

City Project No. **5304.91** Zone Map No. **C-18-Z** Sheet **12** Of **44**

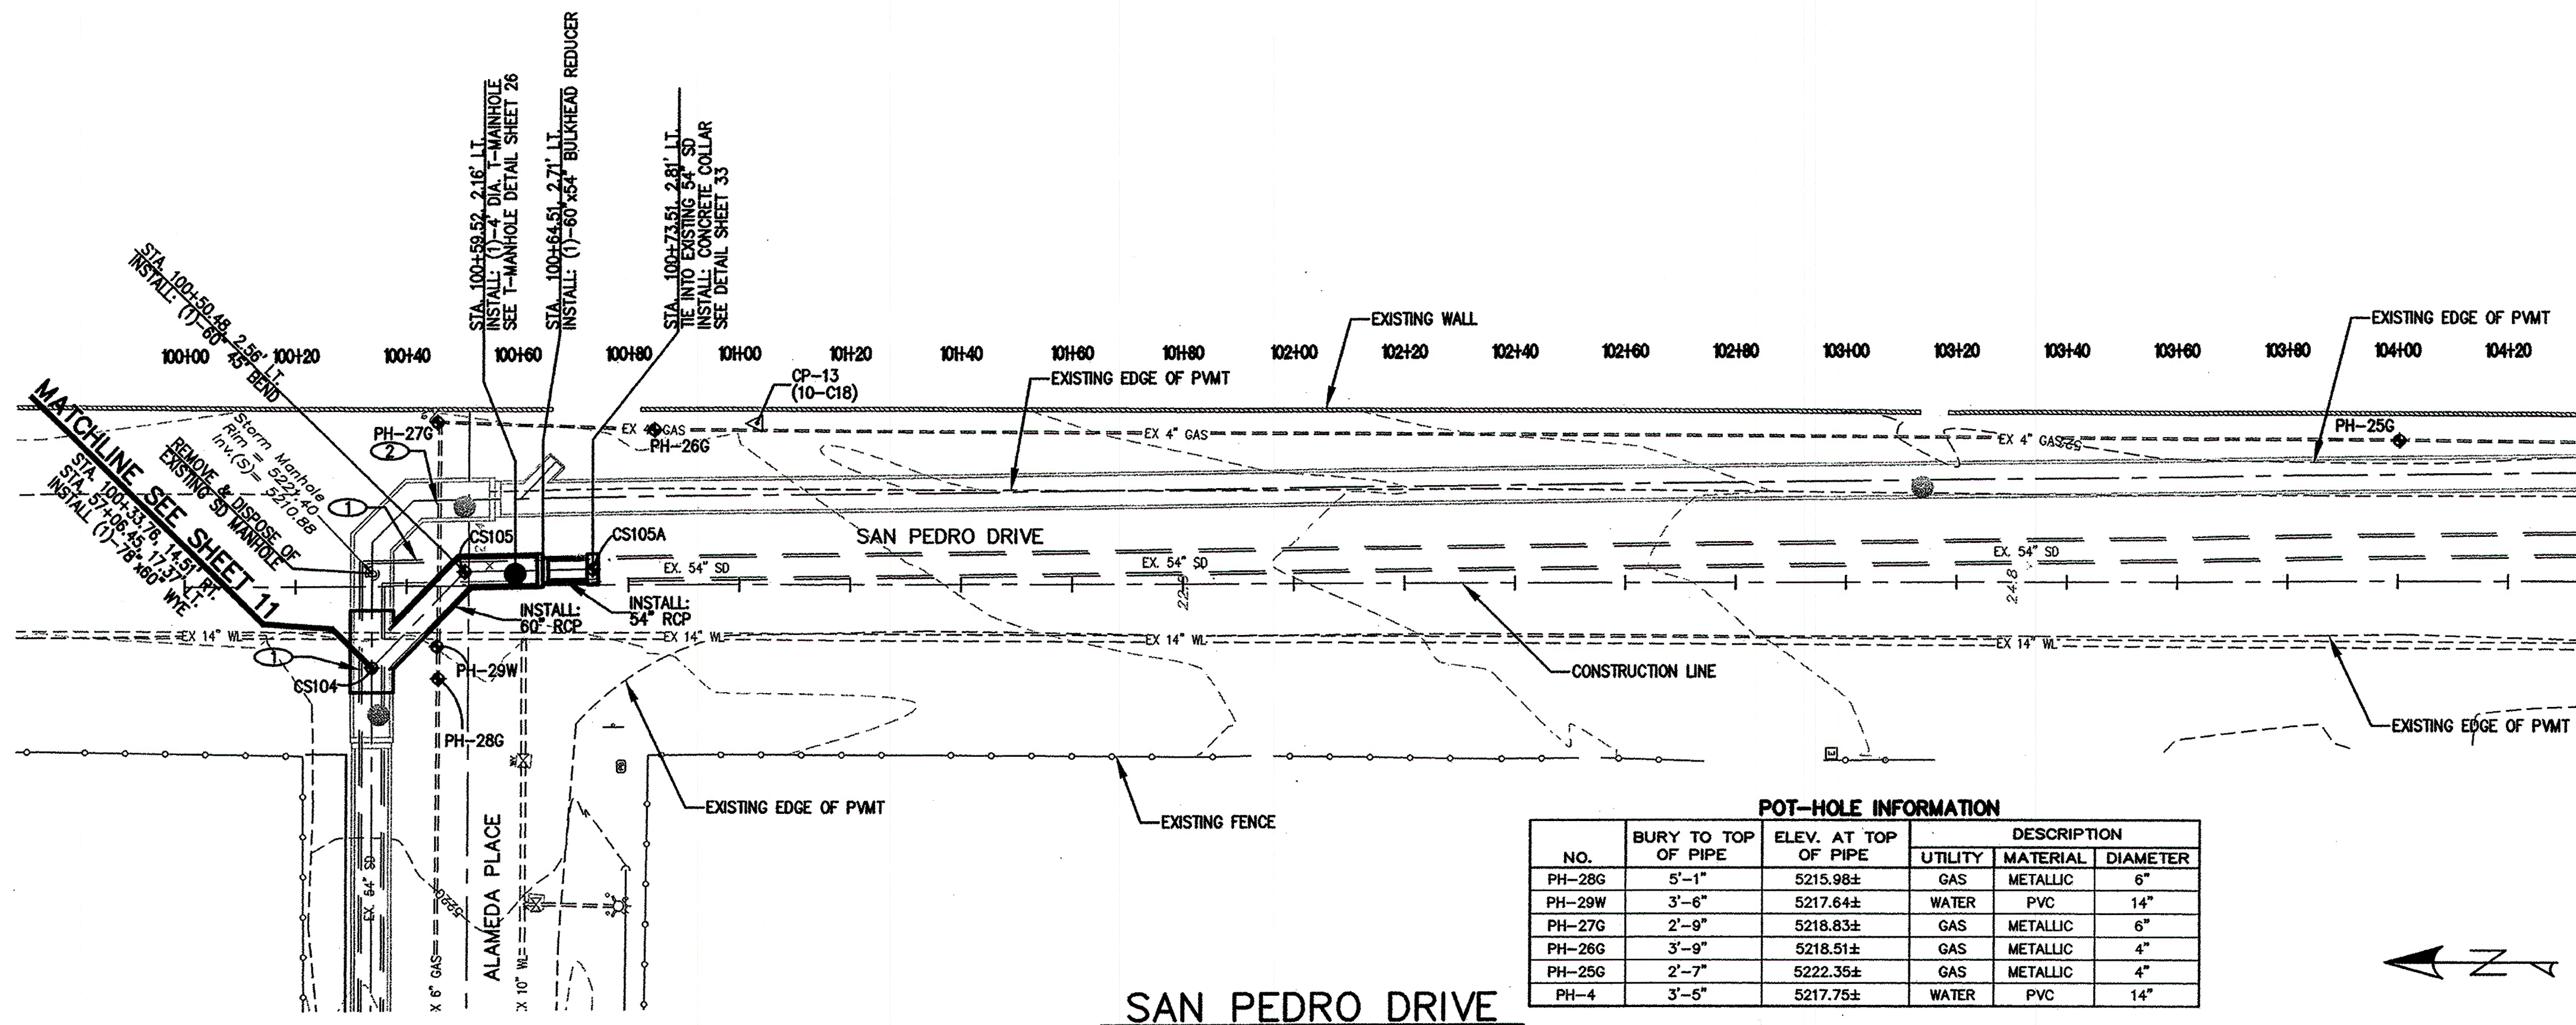

POT-HOLE INFORMATION					
NO.	BURY TO TOP OF PIPE	ELEV. AT TOP OF PIPE	DESCRIPTION		
			UTILITY	MATERIAL	DIAMETER
PH-28G	5'-1"	5215.98±	GAS	METALLIC	6"
PH-29W	3'-6"	5217.64±	WATER	PVC	14"
PH-27G	2'-9"	5218.83±	GAS	METALLIC	6"
PH-26G	3'-9"	5218.51±	GAS	METALLIC	4"
PH-25G	2'-7"	5222.35±	GAS	METALLIC	4"
PH-4	3'-5"	5217.75±	WATER	PVC	14"

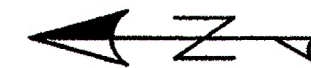

KEYED NOTES:




① REMOVE AND DISPOSE OF
54" RCP STORM DRAIN

② EXISTING GAS LINE TO BE
REMOVED AND RELOCATED
(BY OTHERS)

SURVEY INFORMATION			BENCH MARKS		AS BUILT INFORMATION		
FIELD NOTES			STATION STAMPED (10-018 1985)	CONTRACTOR			
NO.	BY	DATE		WORK STARTED BY	INSPECTORS	DATE	DATE
			CITY OF ALBUQUERQUE SURVEY 3 1/4"		FIELD CHANGE BY		
			ALUMINUM DISK RIVETED TO PIPE LOCATED BETWEEN ALAMEDA PL. & EAGLE ROCK RD		VERIFICATION BY		
			ON SAN PEDRO BLVD. EAST SIDE OF ROAD		CORRECTED BY		
			X=1,524,123.885 Y=1,542,565.263		MICRO-FILM INFORMATION		
			G-C=0.999665042		RECORDED BY		
			4 X=0" 11' 19.43"		NO.		
			ELEVATION=5222.09 (NAVD. 1988)				

[illegible][illegible]

DEVELOPMENT		
RAIN PROFILE PLACE		
No. / Day / Yr.	No. / Day / Yr.	
Sheet	Of	
13		44

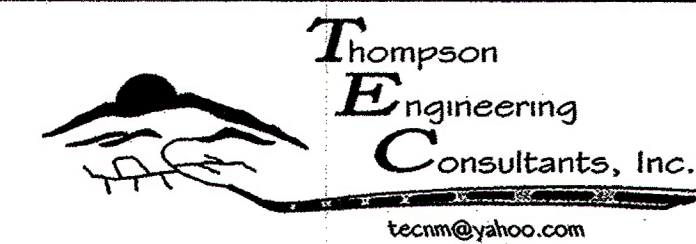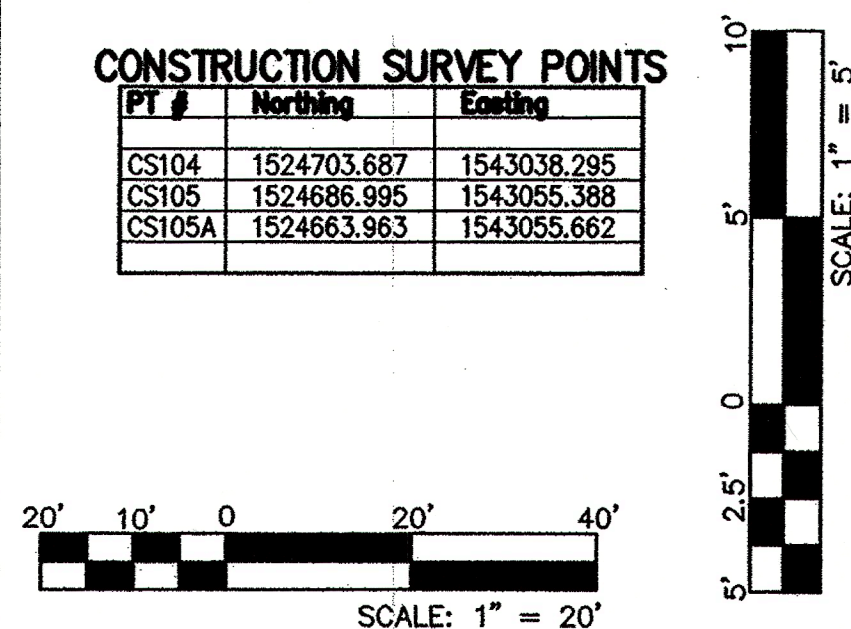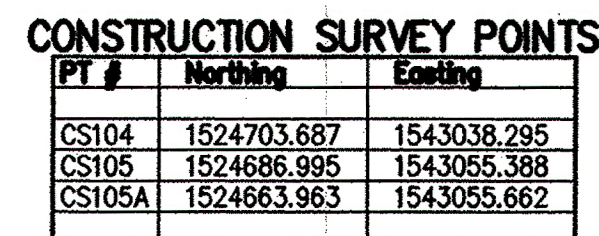

P.O. BOX 65760 PHONE: (505) 271-2199
ALBUQUERQUE, NM 87193 FAX: (505) 830-9248

CITY OF ALBUQUERQUE

CITY OF ALBUQUERQUE
DEPARTMENT OF MUNICIPAL DEVELOPMENT
ENGINEERING DIVISION

TITLE: **SAN PEDRO STORM DRAIN
SAN PEDRO DR. PLAN & PROFILE
60" RCP AT ALAMEDA PLACE**

Design Review Committee

APPROVED

MAR 11 2010

DESIGN
REVIEW COMMITTEE

City Engineer Approval

APPROVED

MAR 11 2010

CITY ENGINEER

City Engineer Approval

APPROVED

MAR 11 2010

CITY ENGINEER

Last Design Update	
--------------------	--

City Project No.	5304.91
------------------	---------

Zone Map No.
C-18-Z

Sheet	13	Of	44
-------	----	----	----



44

DEVELOPMENT N													
BRAIN PROFILE 108+00.00													
<table border="1" style="width: 100%; border-collapse: collapse;"> <tr> <th style="padding: 5px;">Mo. / Day / Yr.</th> </tr> <tr><td style="height: 30px;"></td></tr> <tr><td style="height: 30px;"></td></tr> <tr><td style="height: 30px;"></td></tr> <tr><td style="height: 30px;"></td></tr> <tr><td style="height: 30px;"></td></tr> </table>	Mo. / Day / Yr.						<table border="1" style="width: 100%; border-collapse: collapse;"> <tr> <th style="padding: 5px;">Mo. / Day / Yr.</th> </tr> <tr><td style="height: 30px;"></td></tr> <tr><td style="height: 30px;"></td></tr> <tr><td style="height: 30px;"></td></tr> <tr><td style="height: 30px;"></td></tr> <tr><td style="height: 30px;"></td></tr> </table>	Mo. / Day / Yr.					
Mo. / Day / Yr.													
Mo. / Day / Yr.													
No. Z	Sheet 16 Of 44												