CITY OF ALBUQUERQUE



September 2, 2016

Reza Afaghpour, PE SBS Construction and Engineering, LLC 10209 Snowflake Ct NW Albuquerque, NM 87114

Re:

Lot15, Block 2, Tract, 3, NAA

9000 Eagle Rock NE

Request Permanent C.O. - Accepted

Engineer's Stamp dated: 5-12-15 (C20D056B)

Certification dated: 8-21-16

Dear Mr. Afaghpour,

Based on the Certification received 8/25/2016, the site is acceptable for release of Certificate of Occupancy by Hydrology.

PO Box 1293

It is understood the ponds will be stabilized with landscaping within 90 days from the date of this letter.

Albuquerque

It was made clear to the home owner that they are responsible for maintenance and monitoring of the condition of the improvements built through the SO-19 process (drainage structure). However, please ensure that the City of Albuquerque is coordinated with if any issues ensue in the future.

New Mexico 87103 If you have any questions, you can contact me at 924-3686 or Totten Elliott at 924-3982.

www.cabq.gov

Abiel Carrillo, P.E.

Sincerely,

Principal Engineer, Planning Department


Development and Review Services

TE/AC

C: email.

Cordova, Camille C.; Miranda, Rachel; Sandoval, Darlene M.; Blocker,

Lois

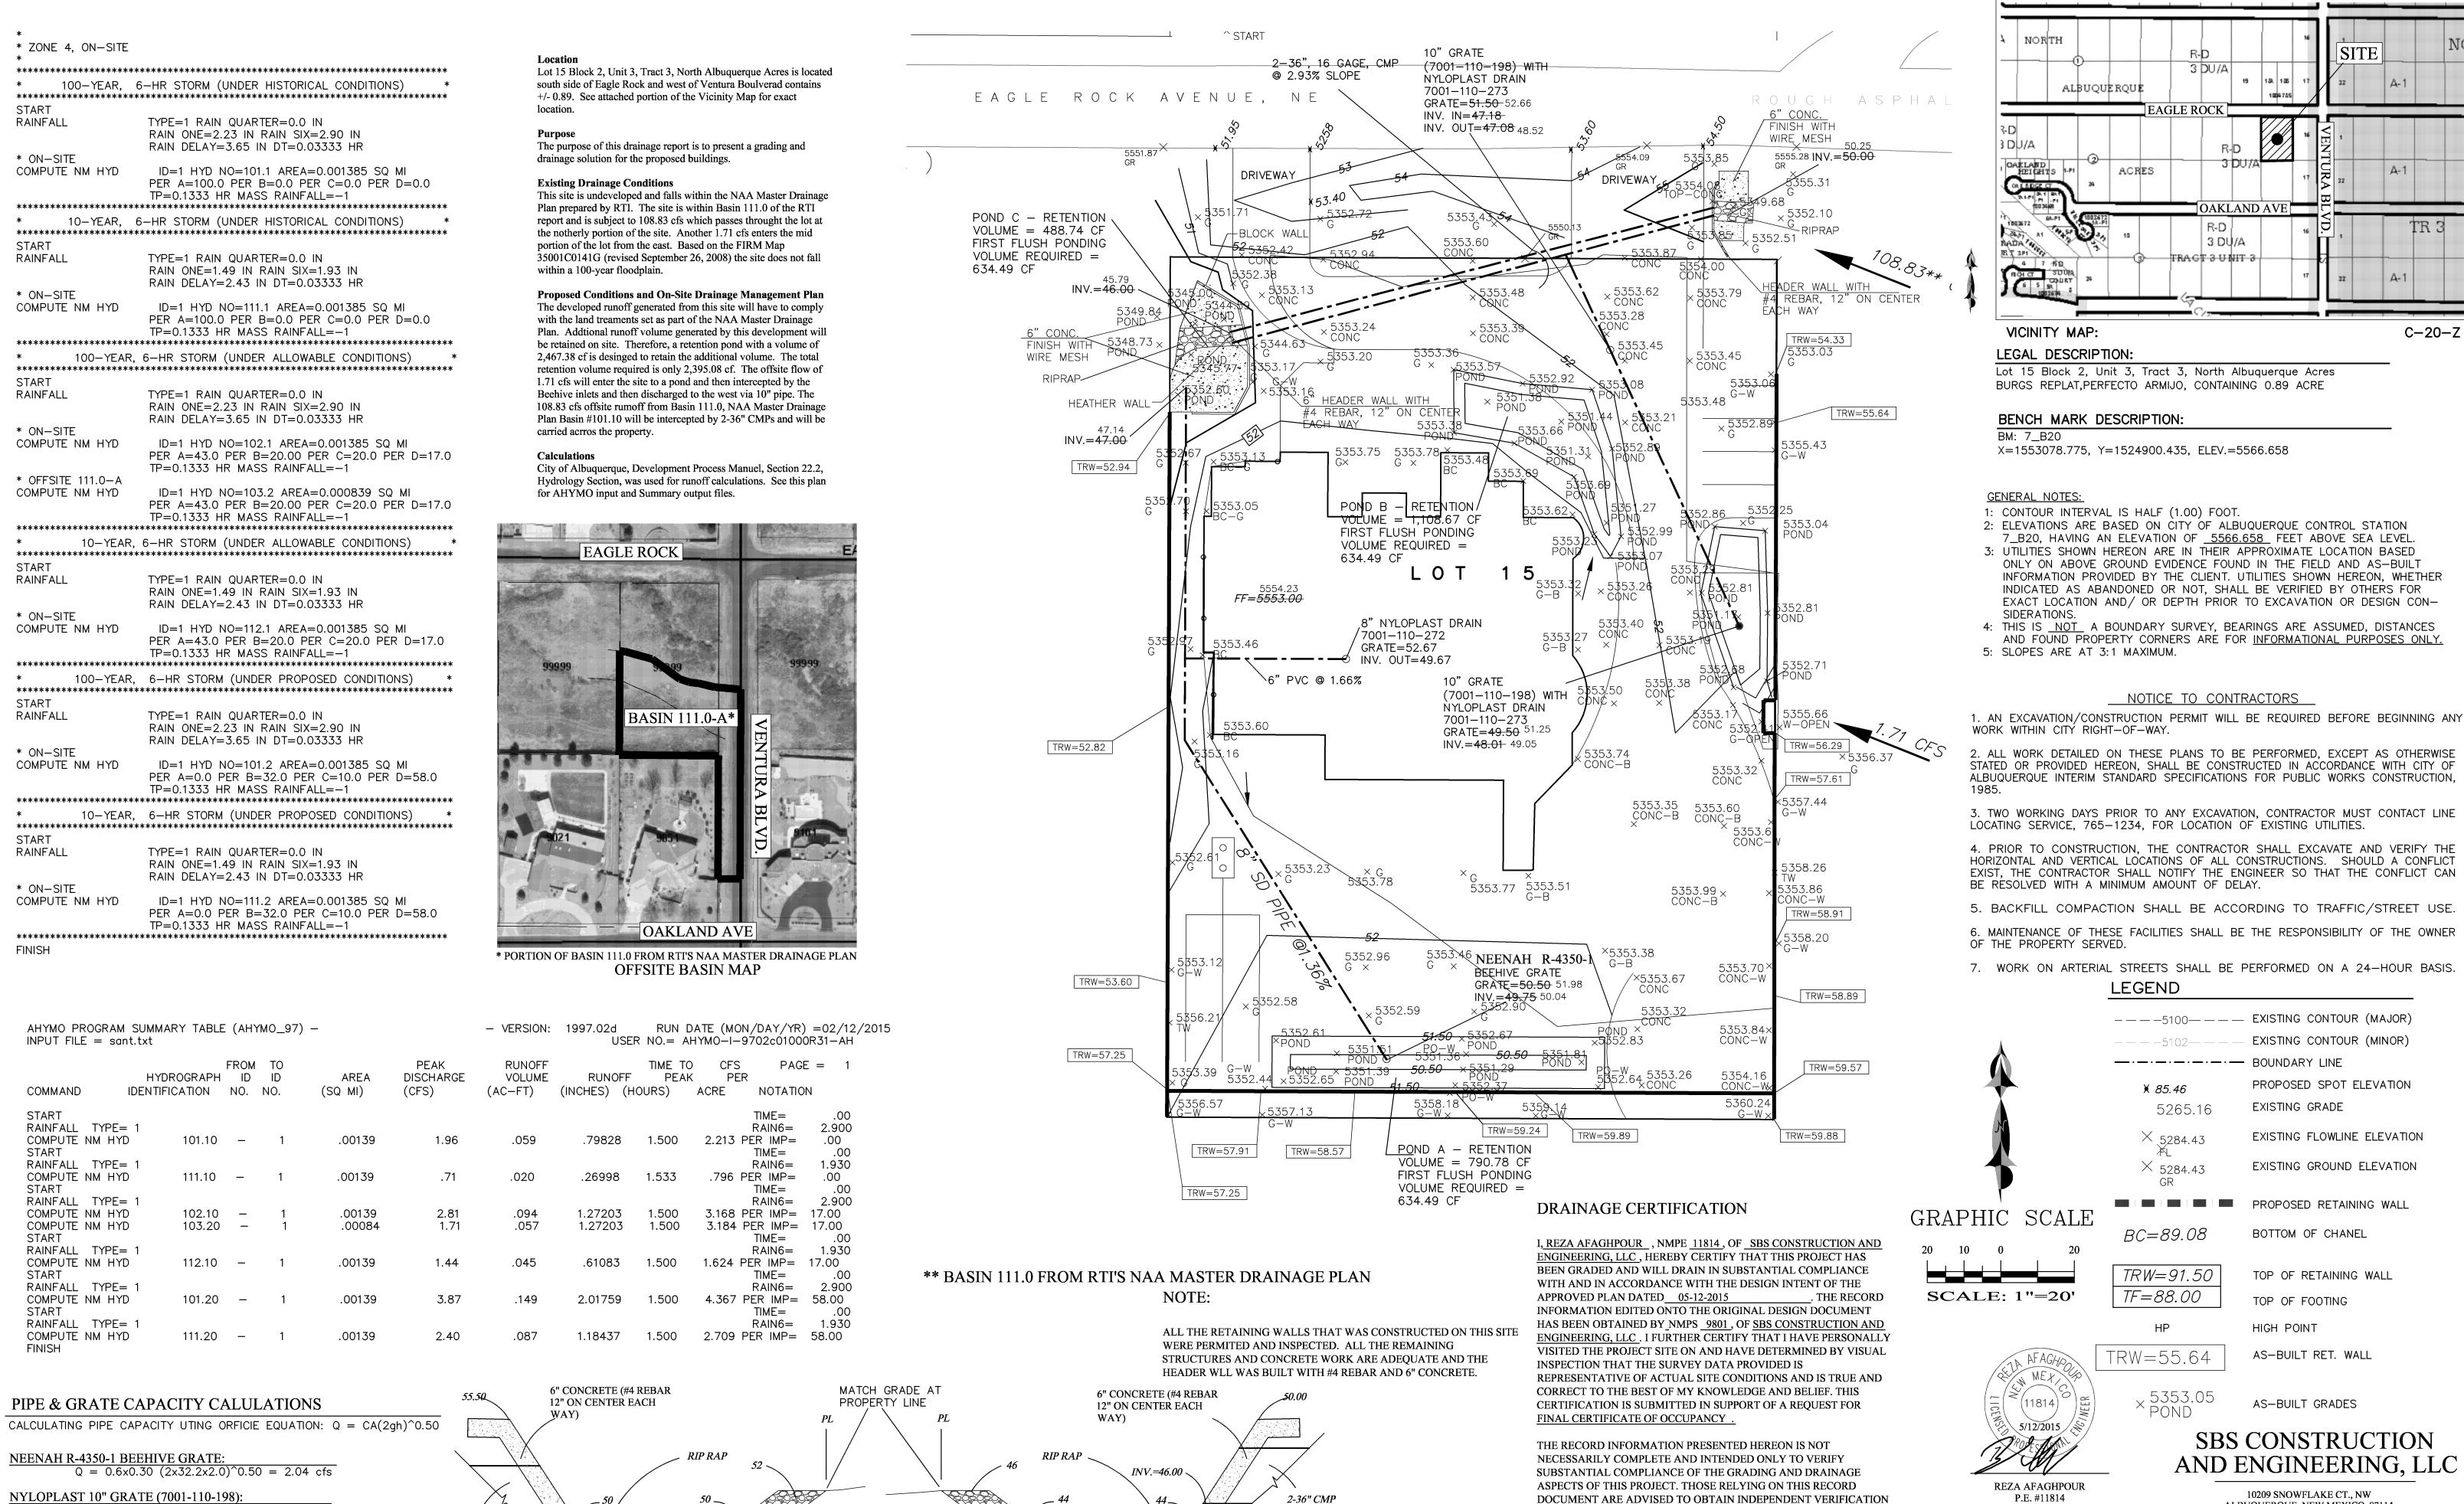

BEDDING

SECTION B-B

NTS

 $Q = 0.6 \times 0.20 (2 \times 32.2 \times 1.0)^{0.50} = 0.95 \text{ cfs}$

 $Q = 0.6 \times 0.35 (2 \times 32.2 \times 1.50)^{0.50} = 2.06 \text{ cfs}$

 $Q = 2 \times 0.6 \times 0.55 (2 \times 32.2 \times 2.0)^{0.50} = 3.79 \text{ cfs}$

 $Q = 2 \times 0.6 \times 7.07 (2 \times 32.2 \times 4.0)^{0.50} = 136.07 \text{ cfs}$

2-36" PVC:

2-36" CMP

GRANULAR

BEDDING

SECTION A-A

NTS

AND ENGINEERING, LLC 10209 SNOWFLAKE CT., NW P.E. #11814 ALBUQUERQUE, NEW MEXICO 87114 (505)899-5570 LOT 15, BLOCK 2, UNIT3, TRACT 3, NAA **GRADING AND DRAINAGE PLAN** DRAWN BY: DRAWING: DATE: SHEET#

2-16-2015

----- EXISTING CONTOUR (MAJOR)

EXISTING CONTOUR (MINOR)

PROPOSED SPOT ELEVATION

EXISTING FLOWLINE ELEVATION

EXISTING GROUND ELEVATION

PROPOSED RETAINING WALL

BOTTOM OF CHANEL

TOP OF FOOTING

HIGH POINT

TOP OF RETAINING WALL

AS-BUILT RET. WALL

AS-BUILT GRADES

SBS CONSTRUCTION

EXISTING GRADE

3 DU/A

R-D

3 DU//

NOTICE TO CONTRACTORS

LEGEND

¥ *85.46*

5265.16

 \times 5284.43

 \times 5284.43

BC=89.08

TRW=91.50

TF=88.00

TRW=55.64

SH-B

201423-GR.DWG

LAST REVISION: 5/12/201

OF ITS ACCURACY BEFORE USING IT FOR ANY OTHER PURPOSE.

REZA AFAGHPOUR, NMPE 11814

× 5353.05 POND

OAKLAND AVE

C-20-Z

EAGLE ROCK

ALBUQUERQUE

ACRES





