



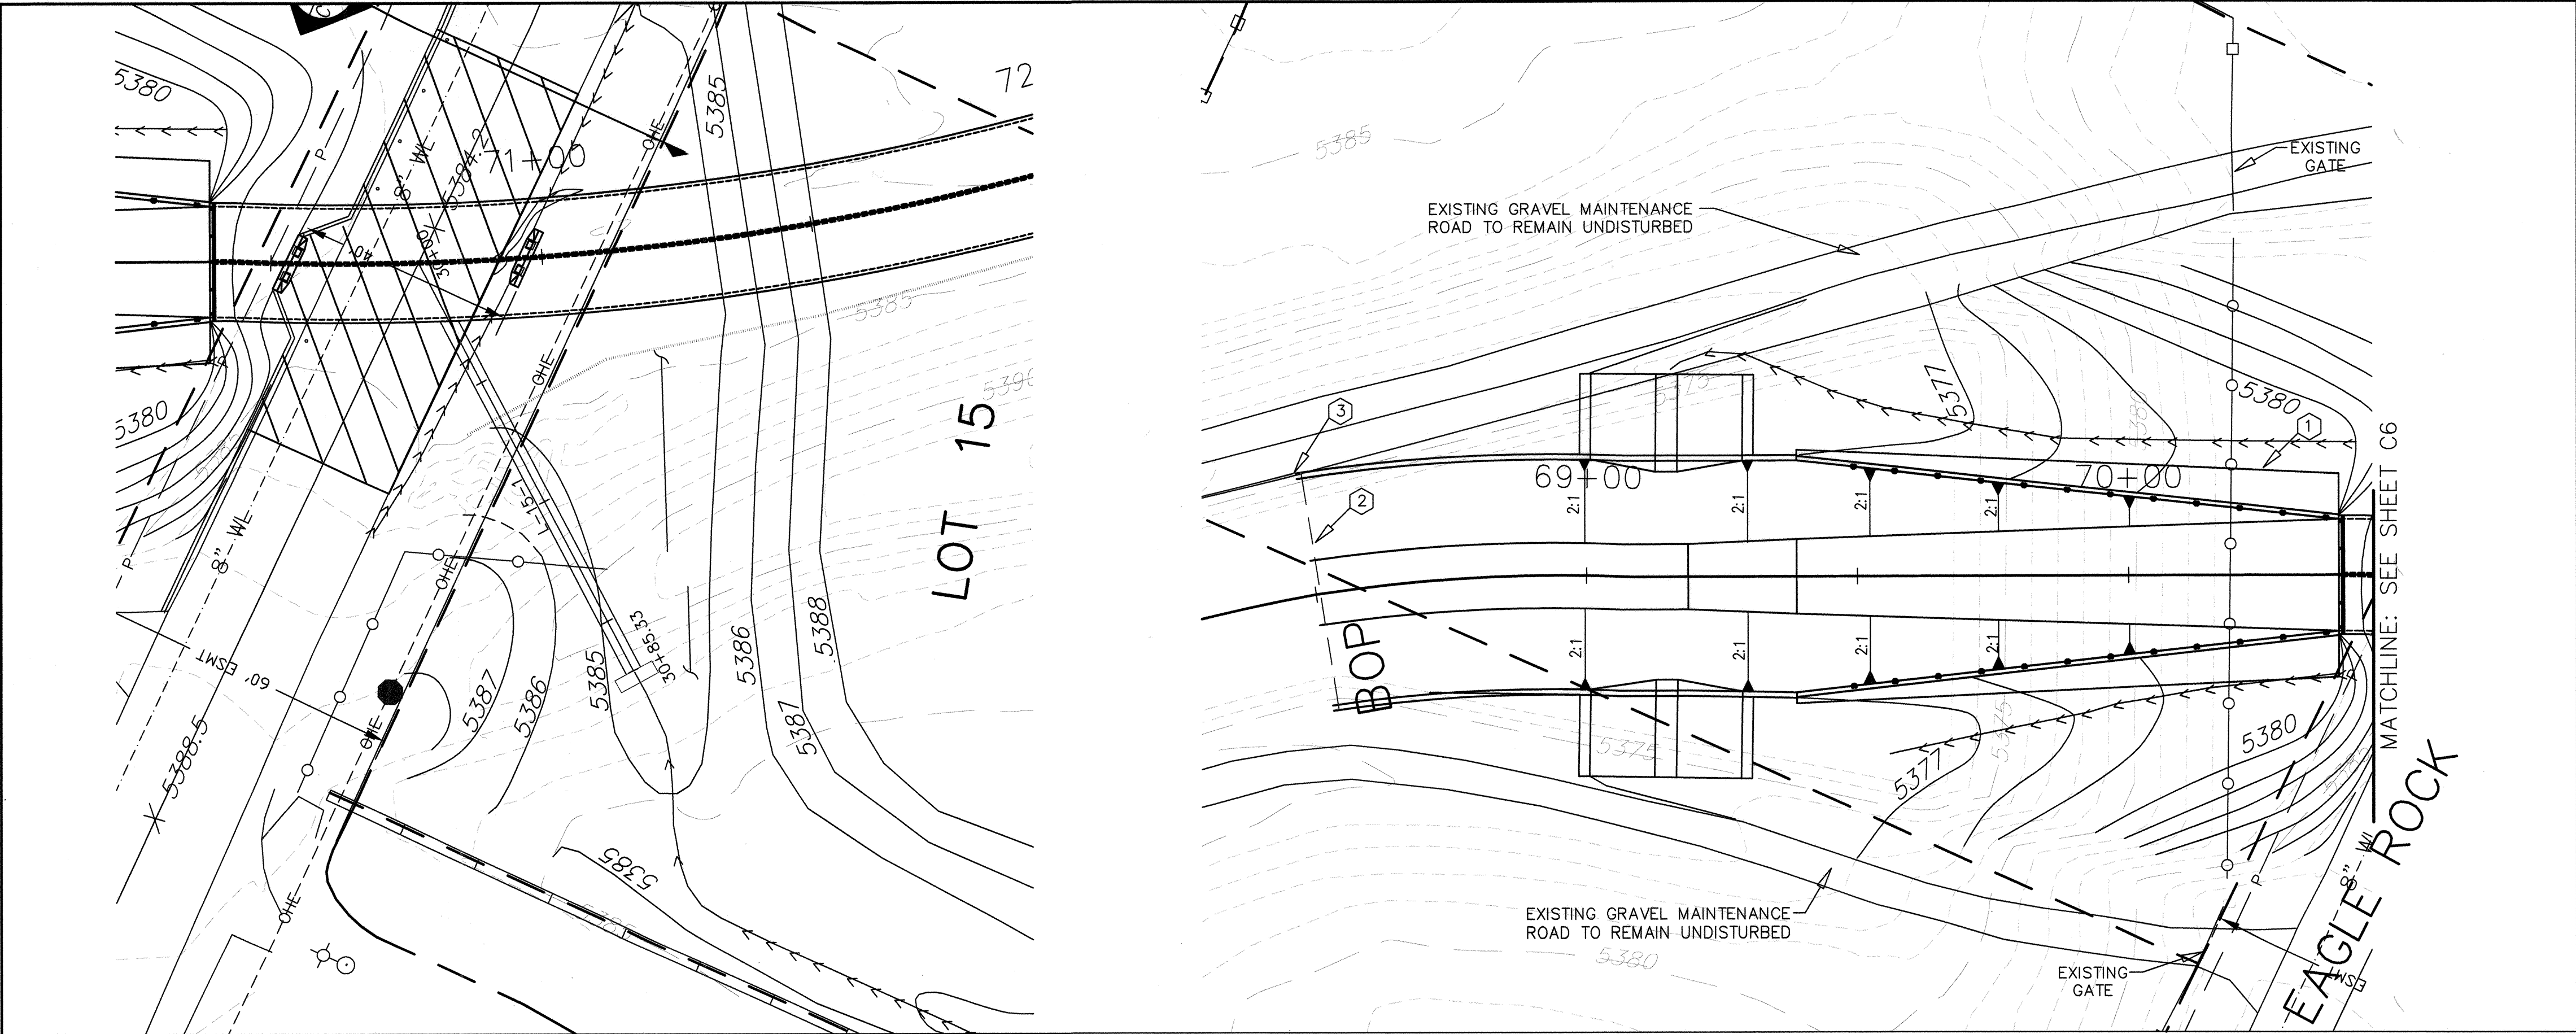

LOT 15 STORM DRAIN

LA CUEVA ARROYO

INTERIM NAVD88

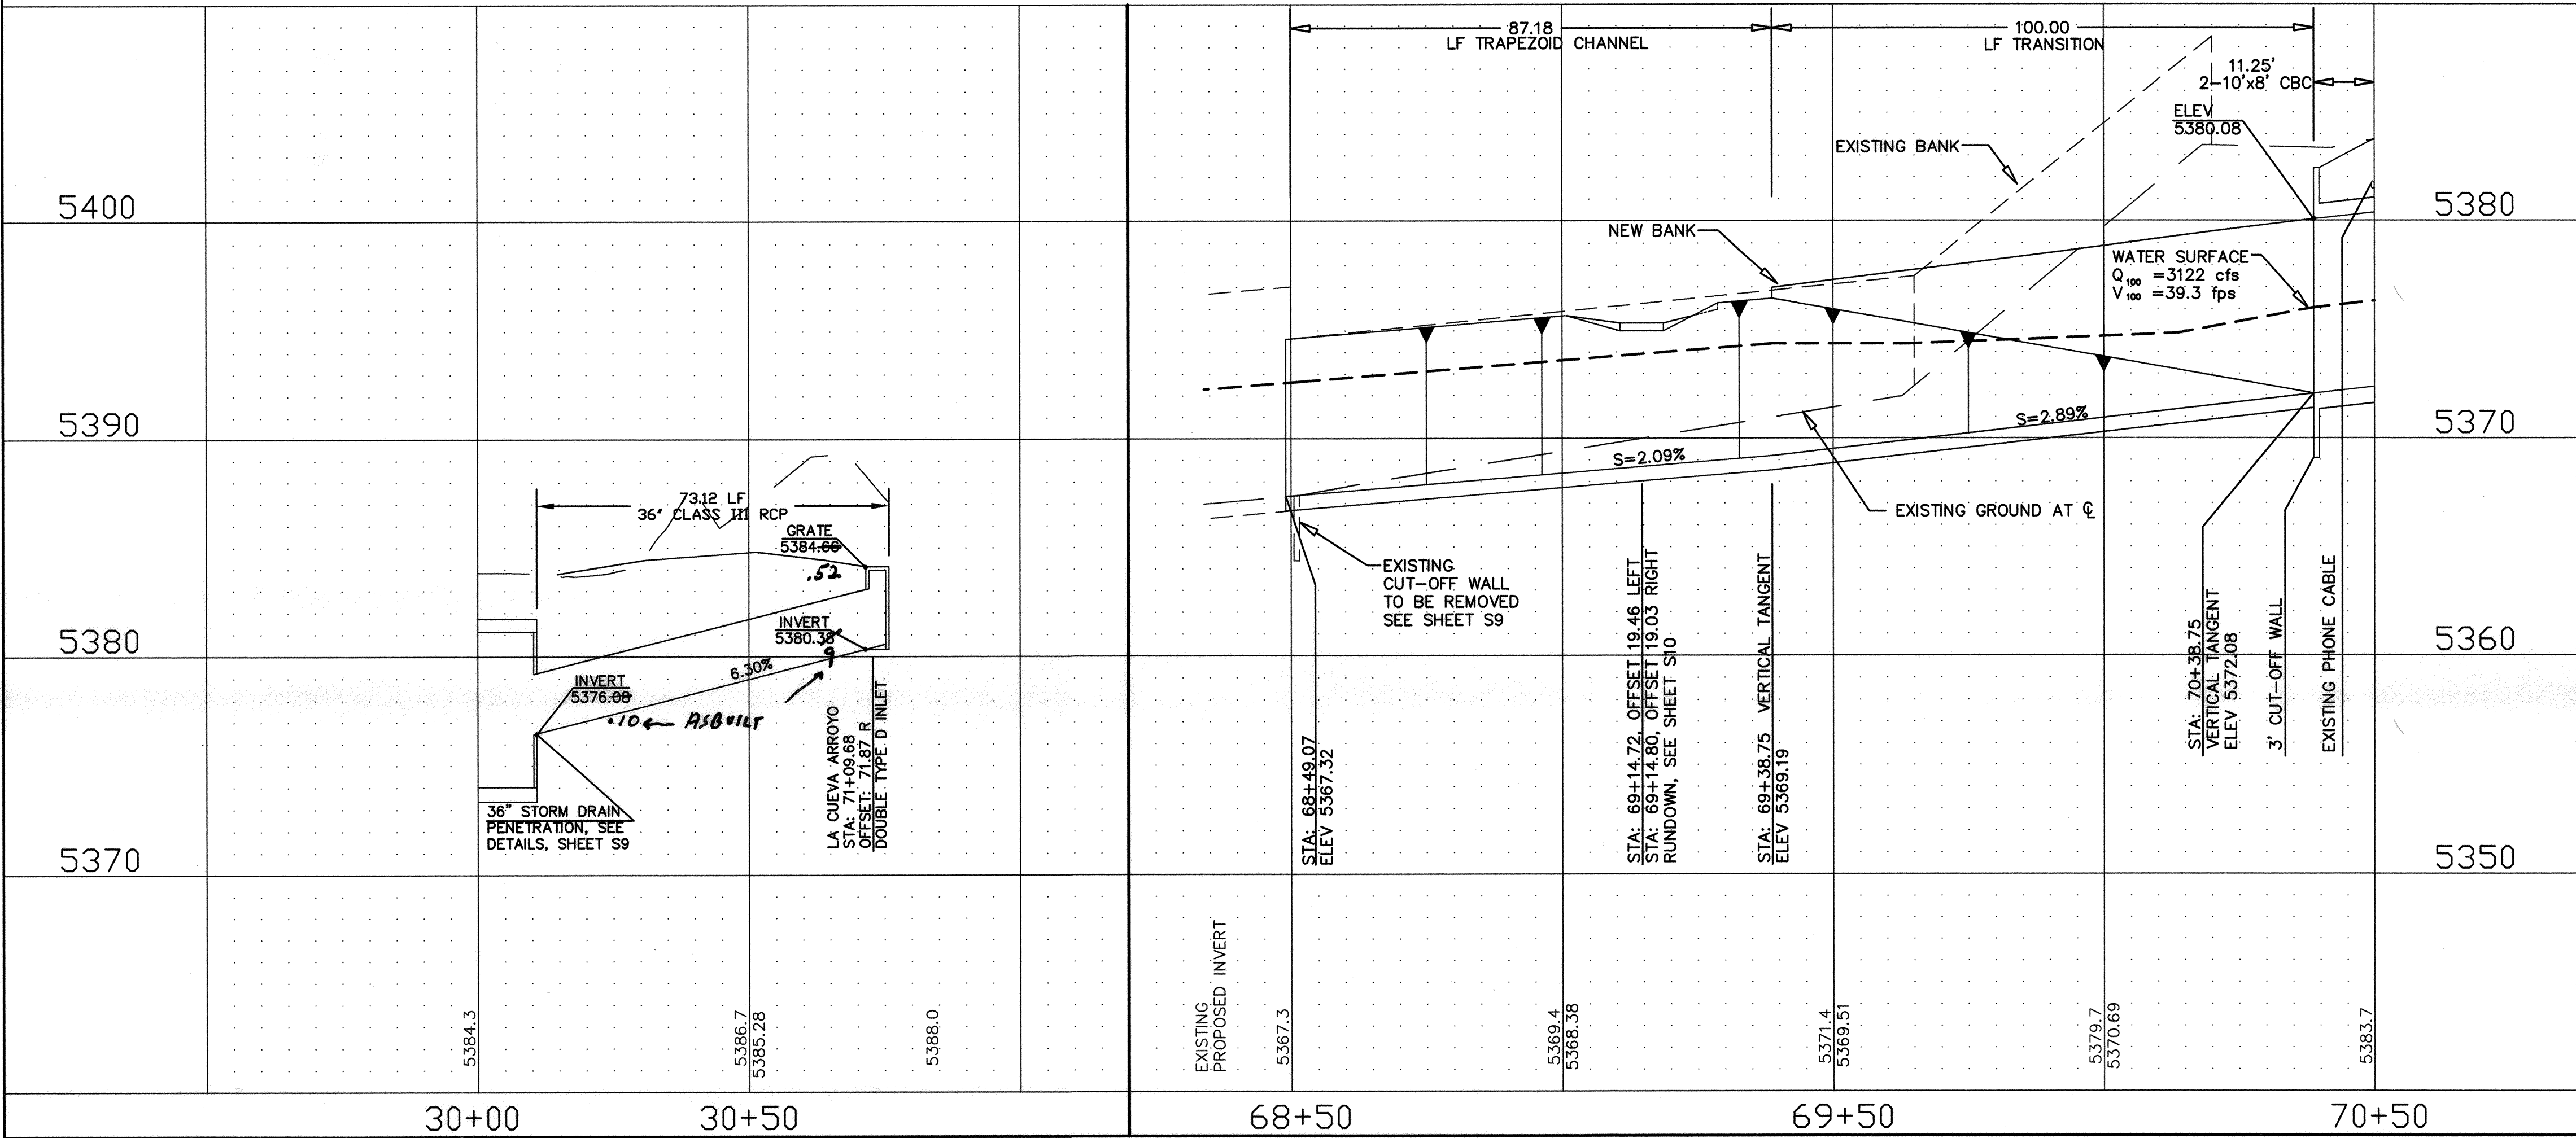

- GENERAL NOTES
- SEE SHEET S6-S7 FOR CBC DETAILS
 - SEE SHEET S2 FOR EXIT TRANSITION DETAILS
 - SEE SHEET S2 FOR TRAPEZOIDAL CHANNEL DETAILS
 - SEE SHEET C10 FOR EAGLE ROCK DETAILS
 - SEE SHEET S2 FOR RAILING LOCATION
 - SEE SHEET C3 FOR LINE AND CURB DETAILS

NOTE: AS-BUILT INFORMATION SHOWN HEREIN IS BASED UPON INFORMATION PROVIDED BY THE CONTRACTOR AFTER COMPLETION OF THE PROJECT. NO ADDITIONAL MEASUREMENTS OR VERIFICATION HAS BEEN PERFORMED, AND NO CERTIFICATION IS MADE AS TO THE ACCURACY OR COMPLETENESS OF THAT INFORMATION.

NUMBERED NOTES

- FOOTING - SEE STRUCTURAL SHEETS FOR DETAILS
- EXISTING CUT-OFF WALL TO BE REMOVED, SEE SHEET S9
- EXISTING SILL WALL

SCALE: 1" = 5' VERTICAL
1" = 20' HORIZONTAL

Resource Technology, Inc.

Civil Engineering
Environmental Sciences
Water Resources
Landscape Architecture
Planning

5501 Jefferson Blvd. NE, Suite 200
Albuquerque, New Mexico 87109
E-mail: rti@rti.net
Telephone: (505) 243-7300
Facsimile: (505) 243-7400

CITY OF ALBUQUERQUE
DEPARTMENT OF MUNICIPAL DEVELOPMENT

LA CUEVA ARROYO DIP REPLACEMENT
LA CUEVA ARROYO 68+50 TO 70+50 & LOT 15 SD

Design Review Committee APPROVED OCT 17 2007
City Engineer Approval APPROVED OCT 17 2007
Last Design Update

City Project No. 7848.02
Zone Map No. C-19
Sheet C5 Of 25

SURVEY INFORMATION		BENCH MARKS		AS-BUILT INFORMATION	
NO.	BY	DATE	ACS BRASS TABLET, STAMPED "1-B20"	CONTRACTOR	DATE
			INTERSECTION OF MODESTO AVE & BARSTOW ST. IN FEET	WORK STAMPED BY	DATE
			NM STATE PLANE COORDINATES (CENTRAL ZONE)	REVISIONS	DATE
			X=410,237.56 Y=1,524,092.46	DATE	DATE
			ELEV=5474.51 NAVD83 IN FEET	DATE	DATE
			INTERIM NAVD83 IN FEET {X=1,550,483.08 Y=1,524,155.51}	DATE	DATE
			G.T.G. FACTOR 0.99964740 {ELEV=5477.18 INTERIM NAVD88}	DATE	DATE
			TRANSFORMED TO INTERIM NAVD88 BY CORPSON V 6.0.1	DATE	DATE

ENGINEER'S SEAL

DANIEL D. SMITH
REGISTERED PROFESSIONAL ENGINEER
NO. 16060
EXPIRATION DATE 8-24-09

REMARKS

DESIGN

Revisions

No. Date

Designed By: MDS DATE: 08/2007
Drawn By: RAO, MDS DATE: 08/2007
Checked By: EVD DATE: 08/2007