


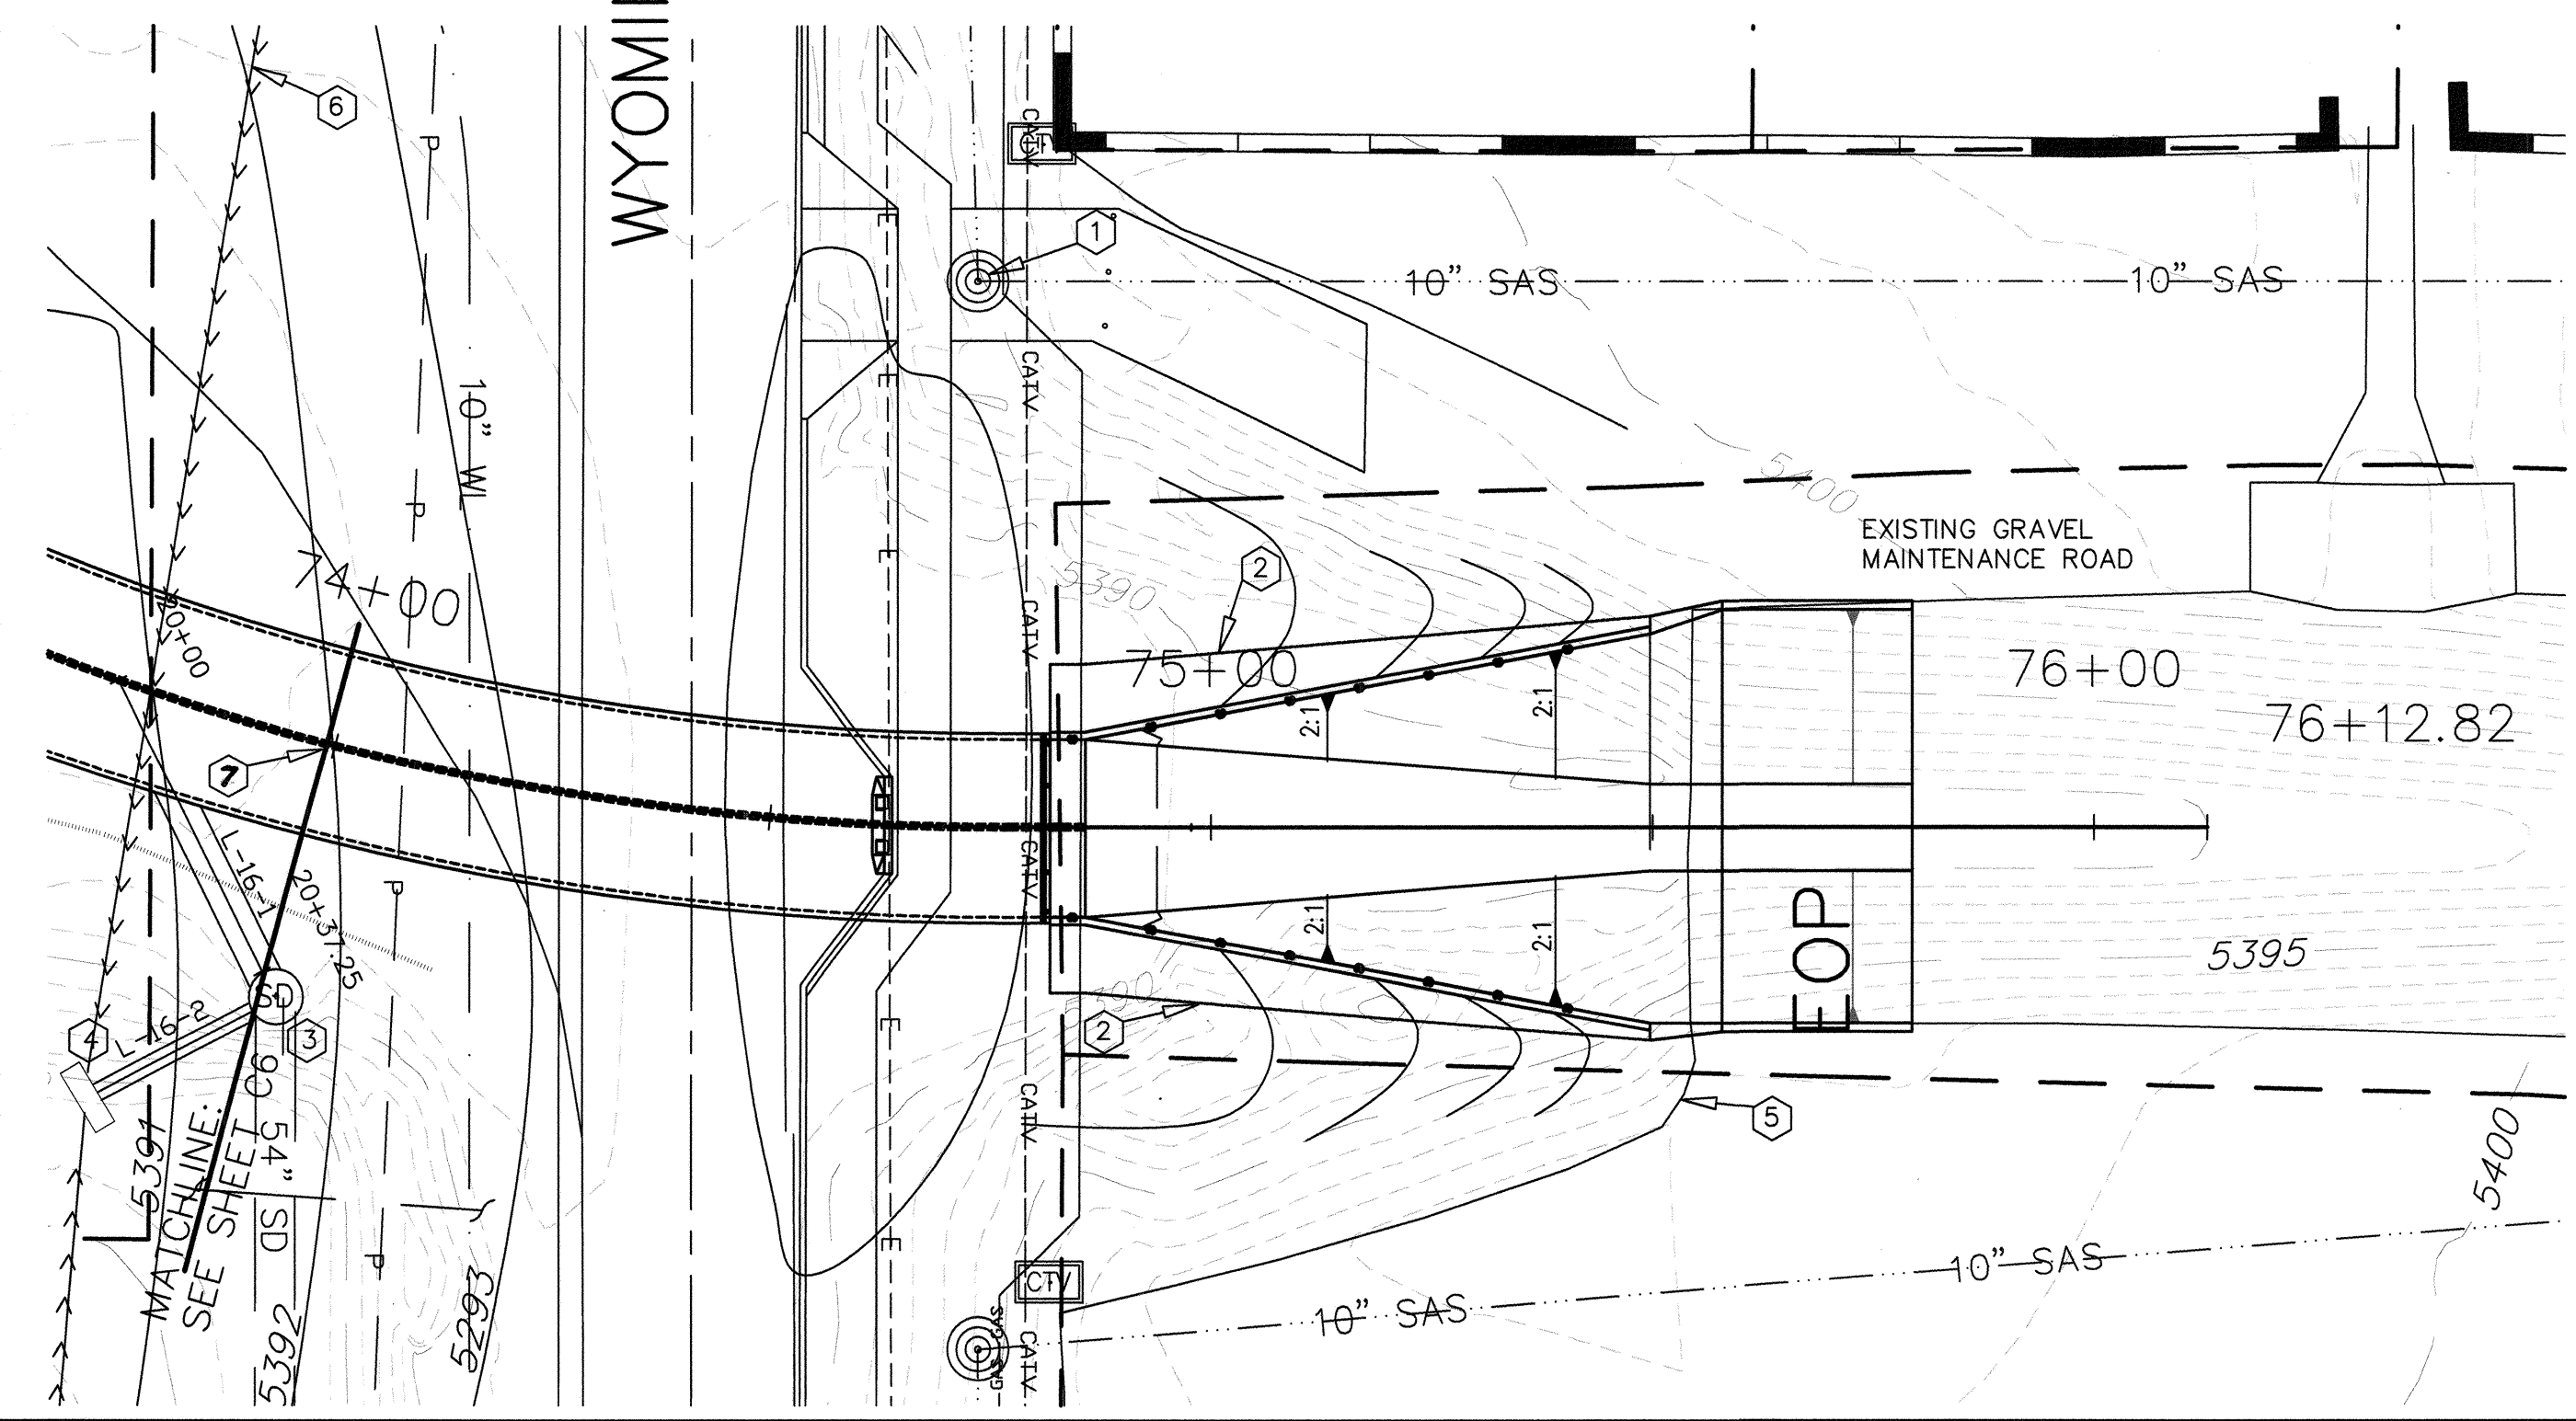


WYOMING

LA CUEVA ARROYO

LOT 16 STORM DRAIN

INTERIM NAVD88

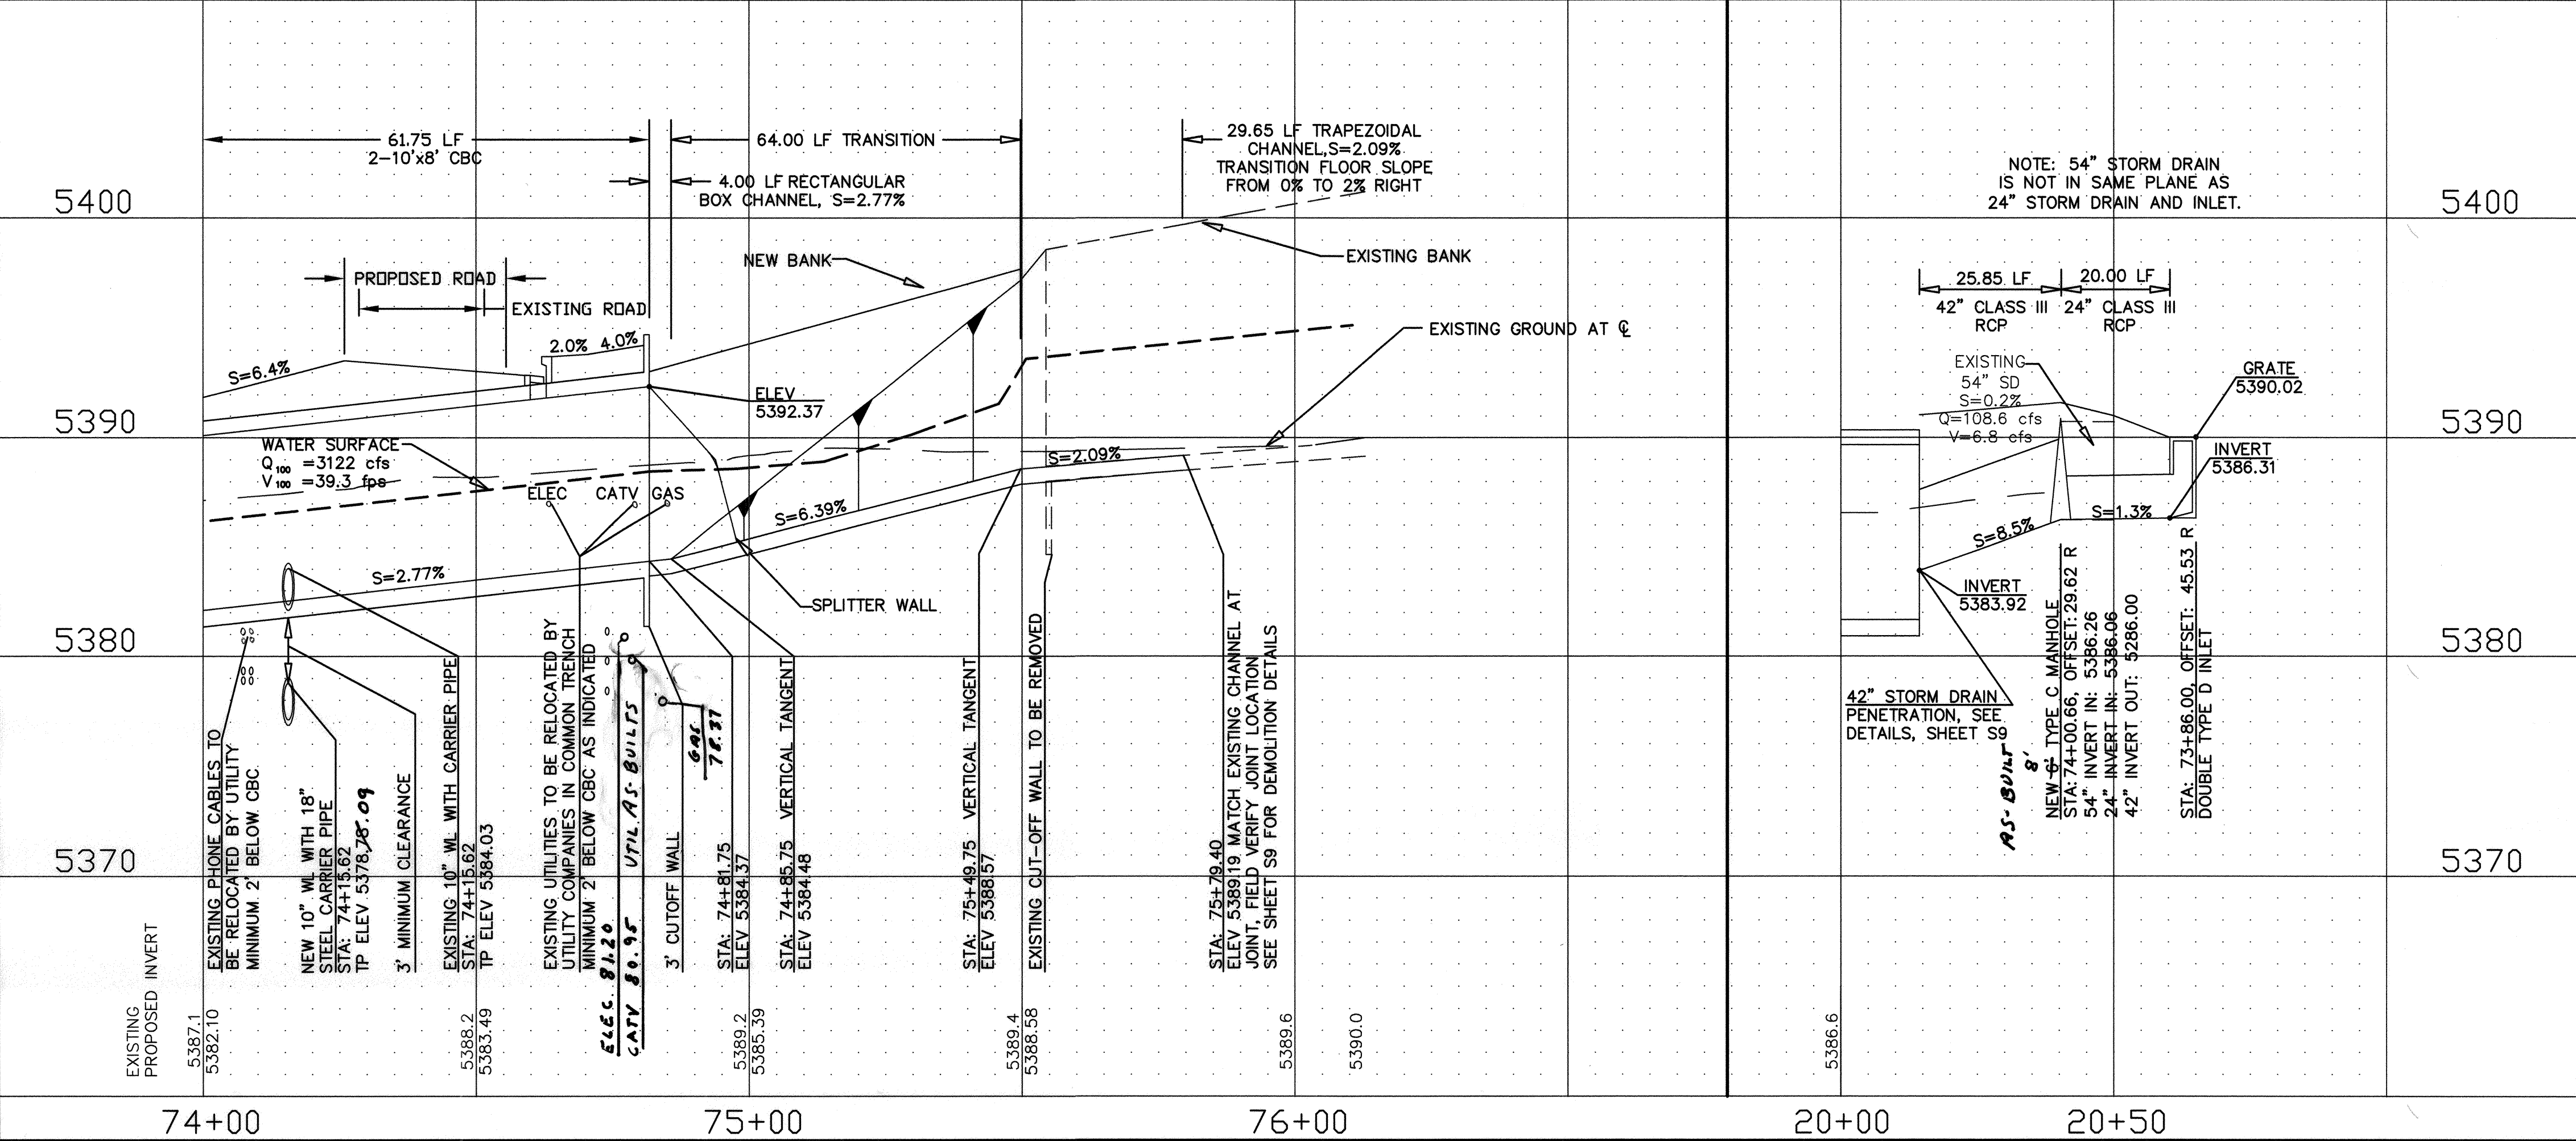



- GENERAL NOTES
- SEE SHEETS S6-S7 FOR CBC DETAILS
 - SEE SHEET S3 FOR ENTRANCE TRANSITION DETAILS
 - SEE SHEET S3 FOR TRAPEZOIDAL CHANNEL DETAILS
 - SEE SHEETS C8-C9 FOR WYOMING DETAILS
 - SEE SHEET S2 FOR RAILING LOCATION
 - SEE SHEET C11 FOR DRIVEPAD DETAILS
 - SEE SHEET C3 FOR LINE AND CURVE DETAILS

NOTE: AS-BUILT INFORMATION SHOWN HEREIN IS BASED UPON INFORMATION PROVIDED BY THE CONTRACTOR AFTER COMPLETION OF THE PROJECT. NO ADDITIONAL MEASUREMENTS OR VERIFICATION WERE PERFORMED. ACCURACY OF INFORMATION IS MADE AS TO THE ACCURACY OR COMPLETENESS OF THAT INFORMATION.

DATE: 1-1-08

NUMBERED NOTES

- ADJUST MANHOLE ELEVATION TO NEW GRADE
- FOOTING
- TYPE C 6" MANHOLE
- DOUBLE TYPE D INLET
- HEADER CURB TO REMAIN
- SWALE, GRADE TO DRAIN
- APPROXIMATE LOCATION OF JOINT FOR TRAFFIC CONTROL PHASE 2, SWITCHING WYOMING TRAFFIC ONTO TEMPORARY BYPASS. SEE SHEET T2.

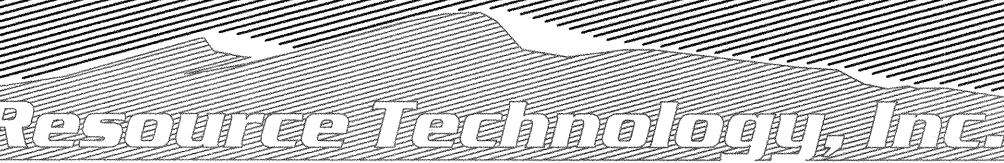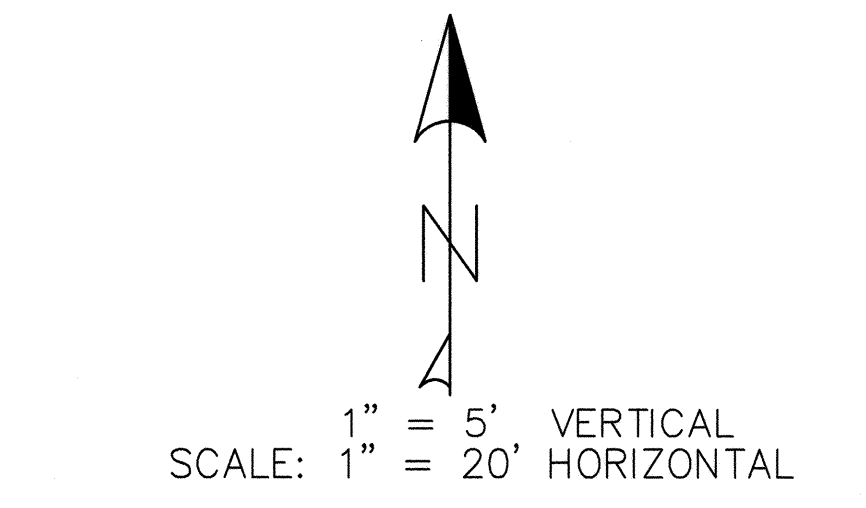

Civil Engineering
Environmental Sciences
Water Resources
Landscape Architecture
Planning

5501 Jefferson Blvd. NE, Suite 200
Albuquerque, New Mexico 87109
E-mail: rti@rm.net
Telephone: (505) 243-7300
Facsimile: (505) 243-7400

CITY OF ALBUQUERQUE
DEPARTMENT OF MUNICIPAL DEVELOPMENT

LA CUEVA ARROYO DIP REPLACEMENT
LA CUEVA ARROYO 74+00 TO 76+00 & LOT 16 SD

Design Review Committee	City Engineer Approval	Mo./Day/Yr.	Mo./Day/Yr.
APPROVED OCT 17 2007 DESIGN REVIEW COMMITTEE	APPROVED OCT 17 2007 CITY ENGINEER		
City Project No.	Zone Map No.	Sheet	Of
7848.02	C-19	C7	25

SURVEY INFORMATION		BENCH MARKS		AS-BUILT INFORMATION	
NO.	BY	DATE	ACS BRASS TABLE, STAMPED "1-B20"	CONTRACTOR	DATE
			INTERSECTION OF MODESTO AVE & BARSTOW ST.	WORKED BY	DATE
			GEOGRAPHIC POSITION (NAD 1927), IN FEET	ACCEPTANCE BY	DATE
			NM STATE PLANE COORDINATES (CENTRAL ZONE)	VERIFICATION BY	DATE
			X=410,237.56 Y=1,524,092.46	DRAWING BY	DATE
			ELEV=5474.51 NGVD29, IN FEET	MICRO-FILM INFORMATION	
			INTERIM NAD83, IN FEET {X=1,550,483.09 Y=1,524,155.5}		
			G.T.G. FACTOR: 0.99964740; ELEV=5477.18 INTERIM NAVD88	RECORDED BY	DATE
			TRANSFORMED TO INTERIM NAVD88 BY CORPSON V 6.0.1		