
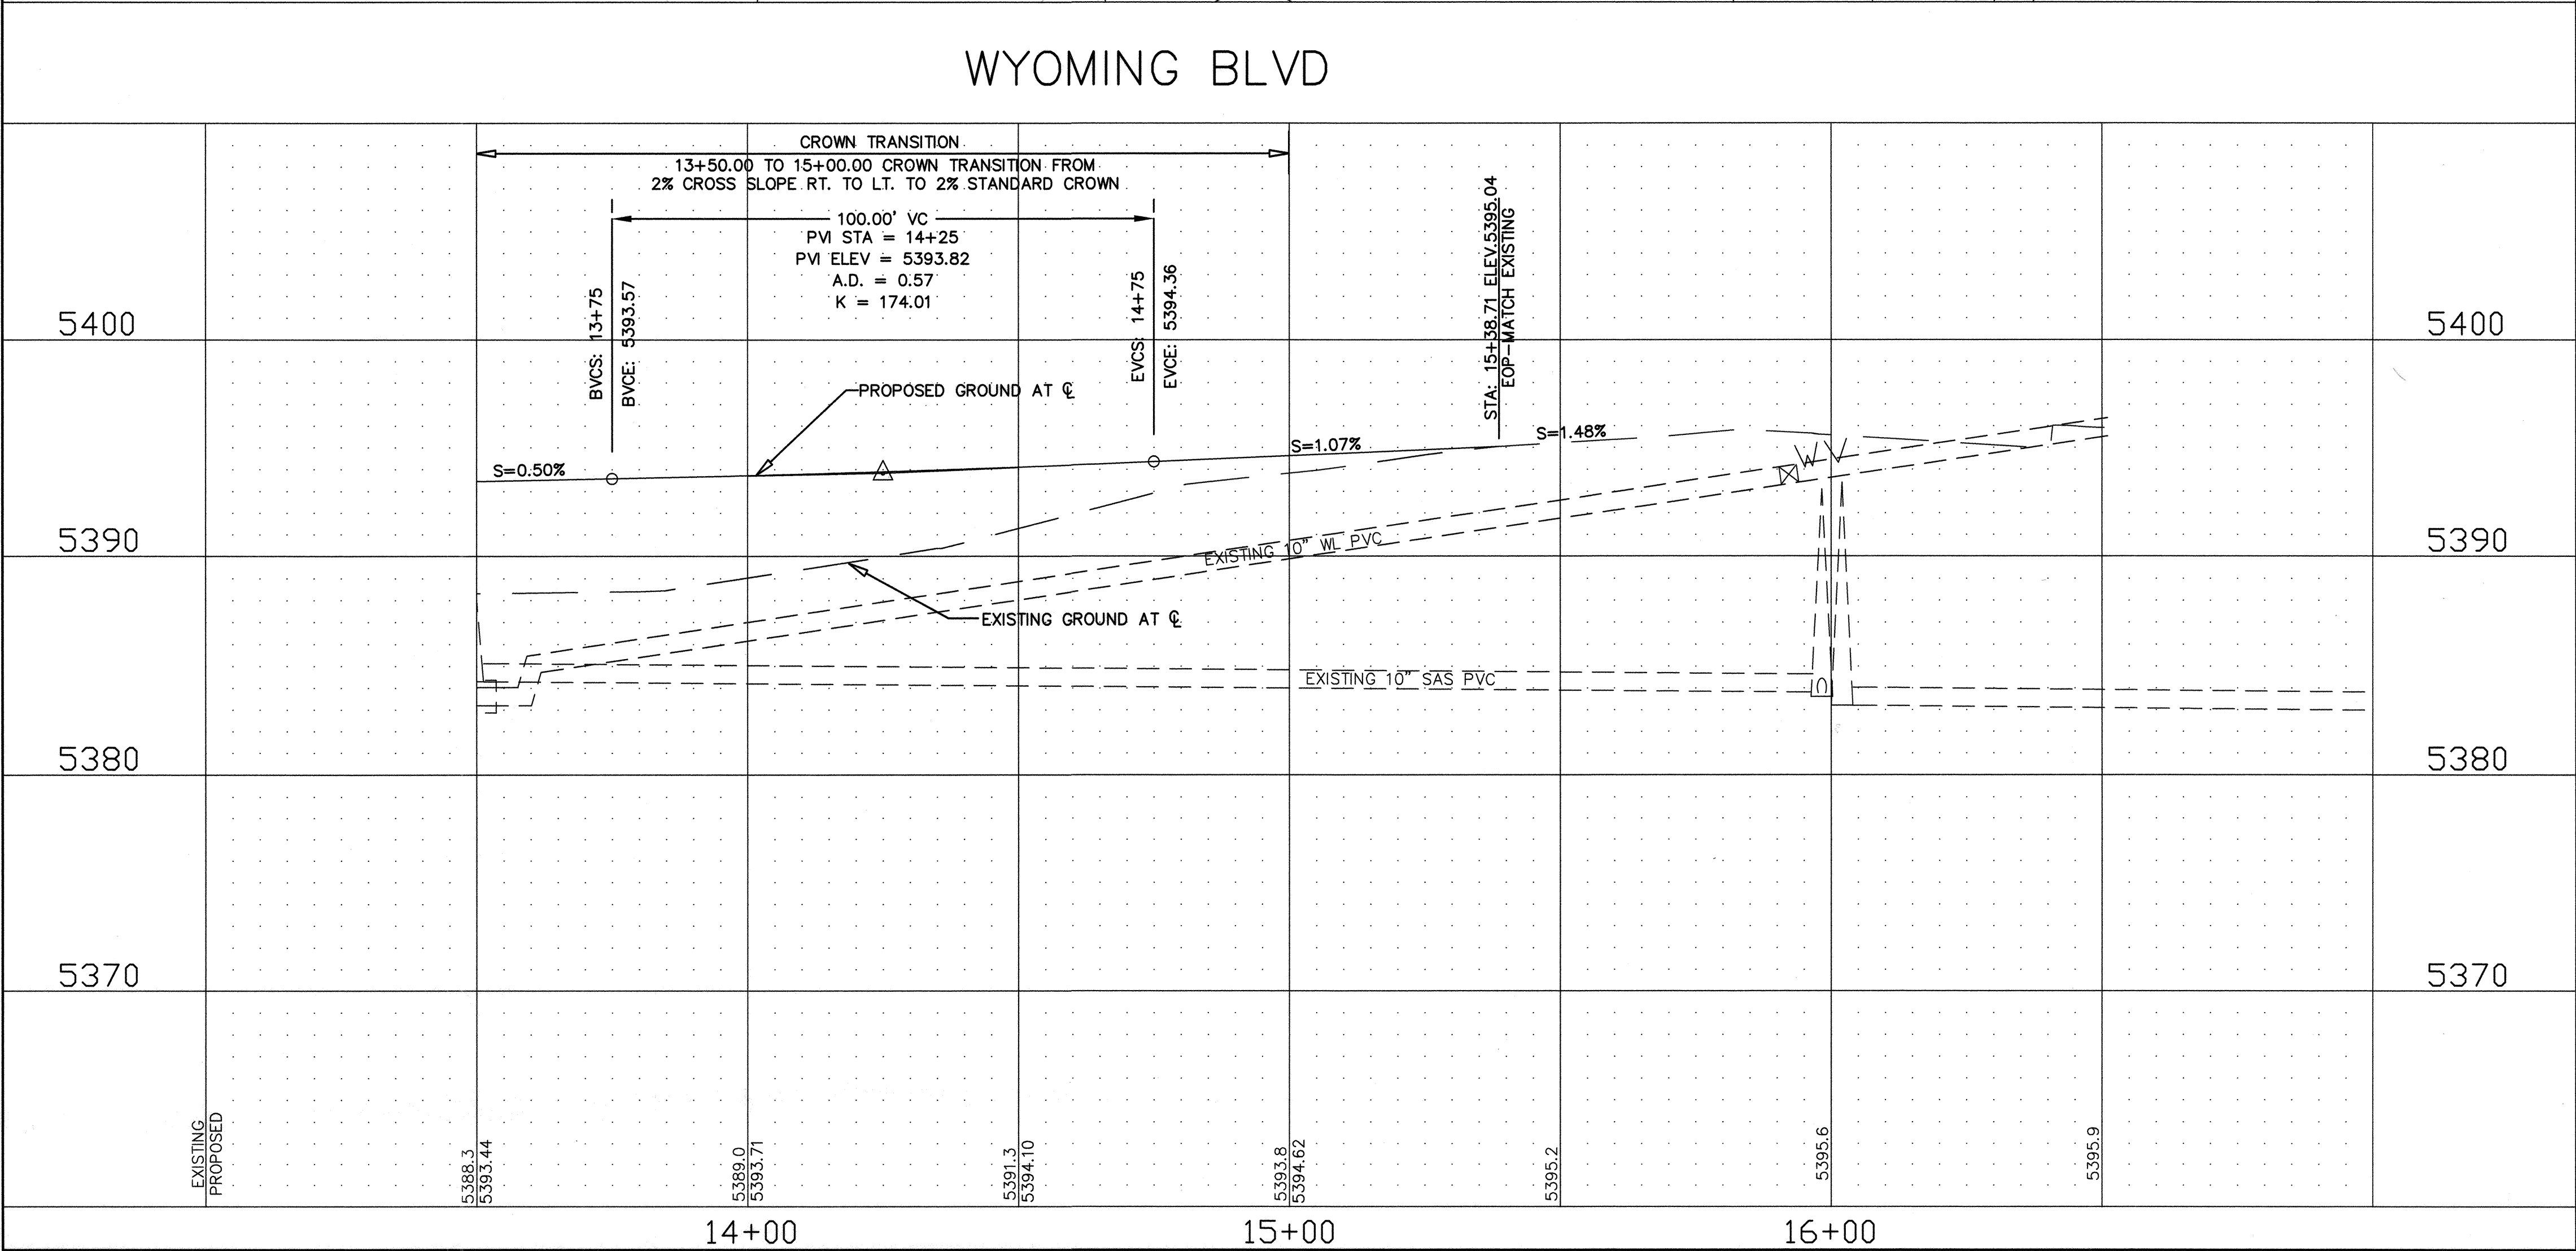


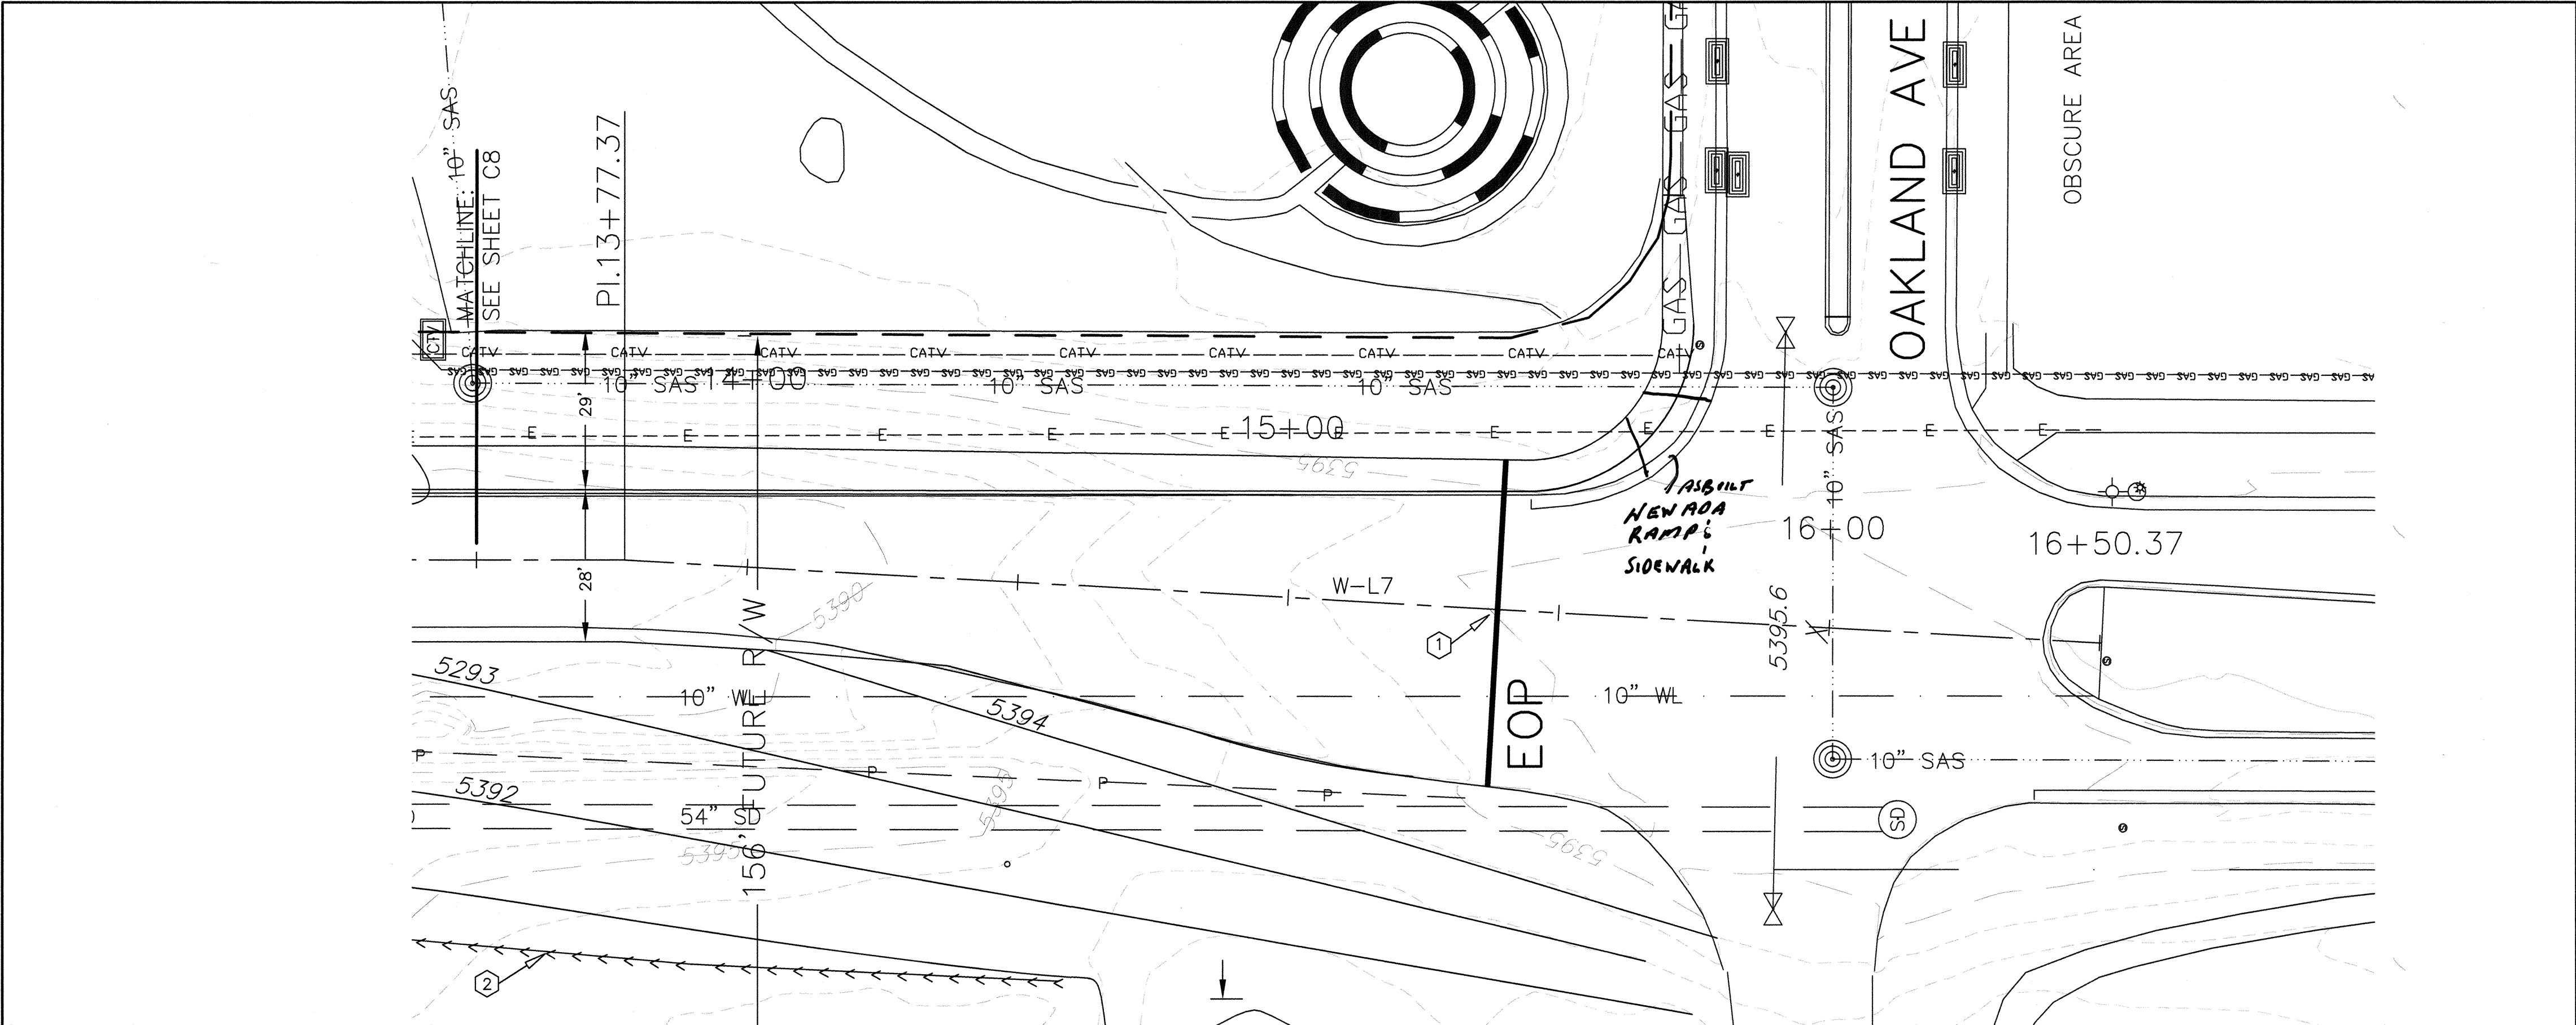

GENERAL NOTES

- SEE SHEET C11 FOR DETAILS ON PAVEMENT, SIDEWALKS AND WATER SHUT-OFF PLAN
- WATERLINE IN PROFILE SHOWN FOR INFORMATIONAL PURPOSES

NOTE:
AS-BUILT INFORMATION SHOWN HEREIN IS BASED UPON INFORMATION PROVIDED BY THE CONTRACTOR AFTER COMPLETION OF THE PROJECT. NO ADDITIONAL MEASUREMENTS OR VERIFICATIONS WERE PERFORMED, AND NO CERTIFICATION IS MADE AS TO THE ACCURACY OR COMPLETENESS OF THAT INFORMATION.

M. Smith DATE: 1-9-09

EAST FLOW LINE/CURB LEFT

LINE	LENGTH	BEARING
L1	47.80	S00°20'36"E
L2	47.06	S00°03'20"W
L3	13.41	S49°55'40"E
L4	15.00	S00°02'31"W
L5	13.42	S50°00'43"W
L6	27.52	S00°03'20"W
L7	16.05	S36°58'12"E
L8	11.18	S00°02'31"W
L9	16.08	S37°01'16"W
L10	204.68	S00°08'56"W
L11	12.12	S00°02'17"W

WEST EDGE OF PAVEMENT RIGHT

LINE	LENGTH	BEARING
W-L1	21.67	S11°42'00"W
W-L2	7.24	S00°46'24"W
W-L3	68.22	S00°07'09"W
W-L4	191.72	S00°02'31"W
W-L5	28.88	S03°13'22"W
W-L6	31.25	S05°03'24"W
W-L7	45.69	S14°44'12"W

CURVE TABLE

CURVE	LENGTH	RADIUS	TANGENT	CHORD	CHORD DIRECTION
C1	14.53	25.00	7.48	14.33	N15°52'53"W
C2	42.78	200.00	21.47	42.70	S11°56'04"W

NUMBERED NOTES

- SAWCUT PAVEMENT STA: 15+38.71
OFFSET LT 20.98 FT
OFFSET RT 32.69 FT
- SWALE, GRADE TO DRAIN

SCALE: 1" = 5' VERTICAL
1" = 20' HORIZONTAL

Resource Technology, Inc.
Civil Engineering
Environmental Sciences
Water Resources
Landscape Architecture
Planning
5501 Jefferson Blvd. NE, Suite 200
Albuquerque, New Mexico 87109
E-mail: rti@rti.net
Telephone: (505) 243-7300
Facsimile: (505) 243-7400

**CITY OF ALBUQUERQUE
DEPARTMENT OF MUNICIPAL DEVELOPMENT**

**LA CUEVA ARROYO DIP REPLACEMENT
WYOMING BLVD 13+50 TO 16+50**

Design Review Committee	City Engineer Approval	Mo./Day/Yr.	Mo./Day/Yr.
APPROVED OCT 17 2007 DESIGN REVIEW COMMITTEE	APPROVED OCT 17 2007 CITY ENGINEER		

City Project No. 7848.02 Zone Map No. C-19 Sheet C9 Of 25

ENGINEER'S SEAL

AS-BUILT INFORMATION

CONTRACTOR	DATE

SURVEY INFORMATION

NO.	BY	DATE

FIELD NOTES

NO.	BY	DATE

BENCH MARKS

ACS BRASS TABLE, STAMPED "1-B20"	DATE

REVISIONS

No.	Date	By

DESIGN

Designed By:	DATE:
MDS	08/2007

RAO, MDS

Drawn By:	DATE:
RAO, MDS	08/2007

EVD

Checked By:	DATE:
EVD	08/2007