



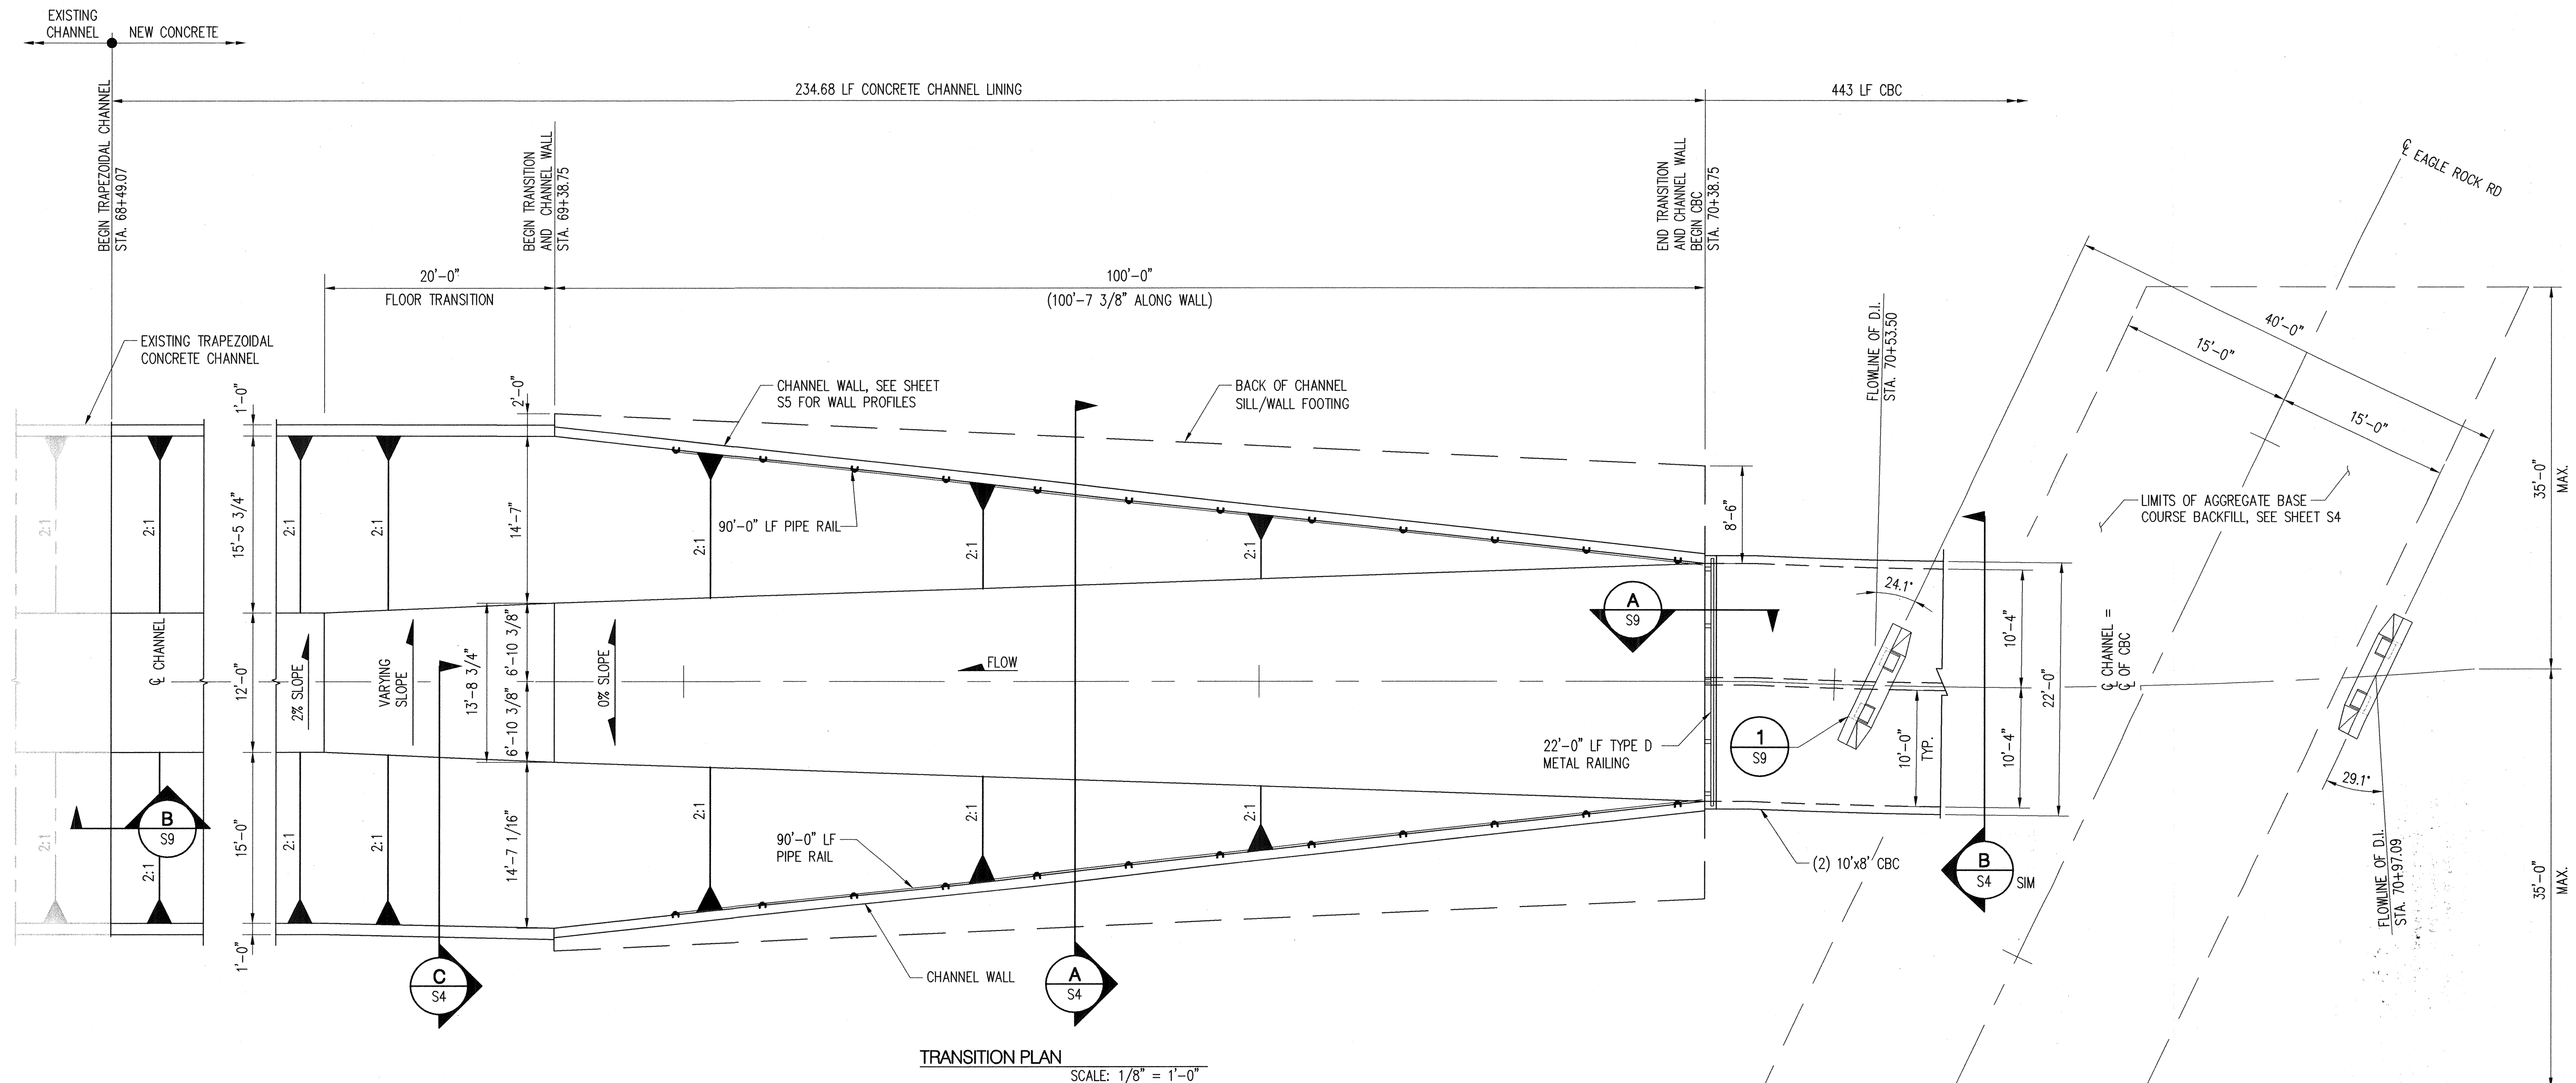

TRANSITION PLAN
SCALE: 1/8" = 1'-0"

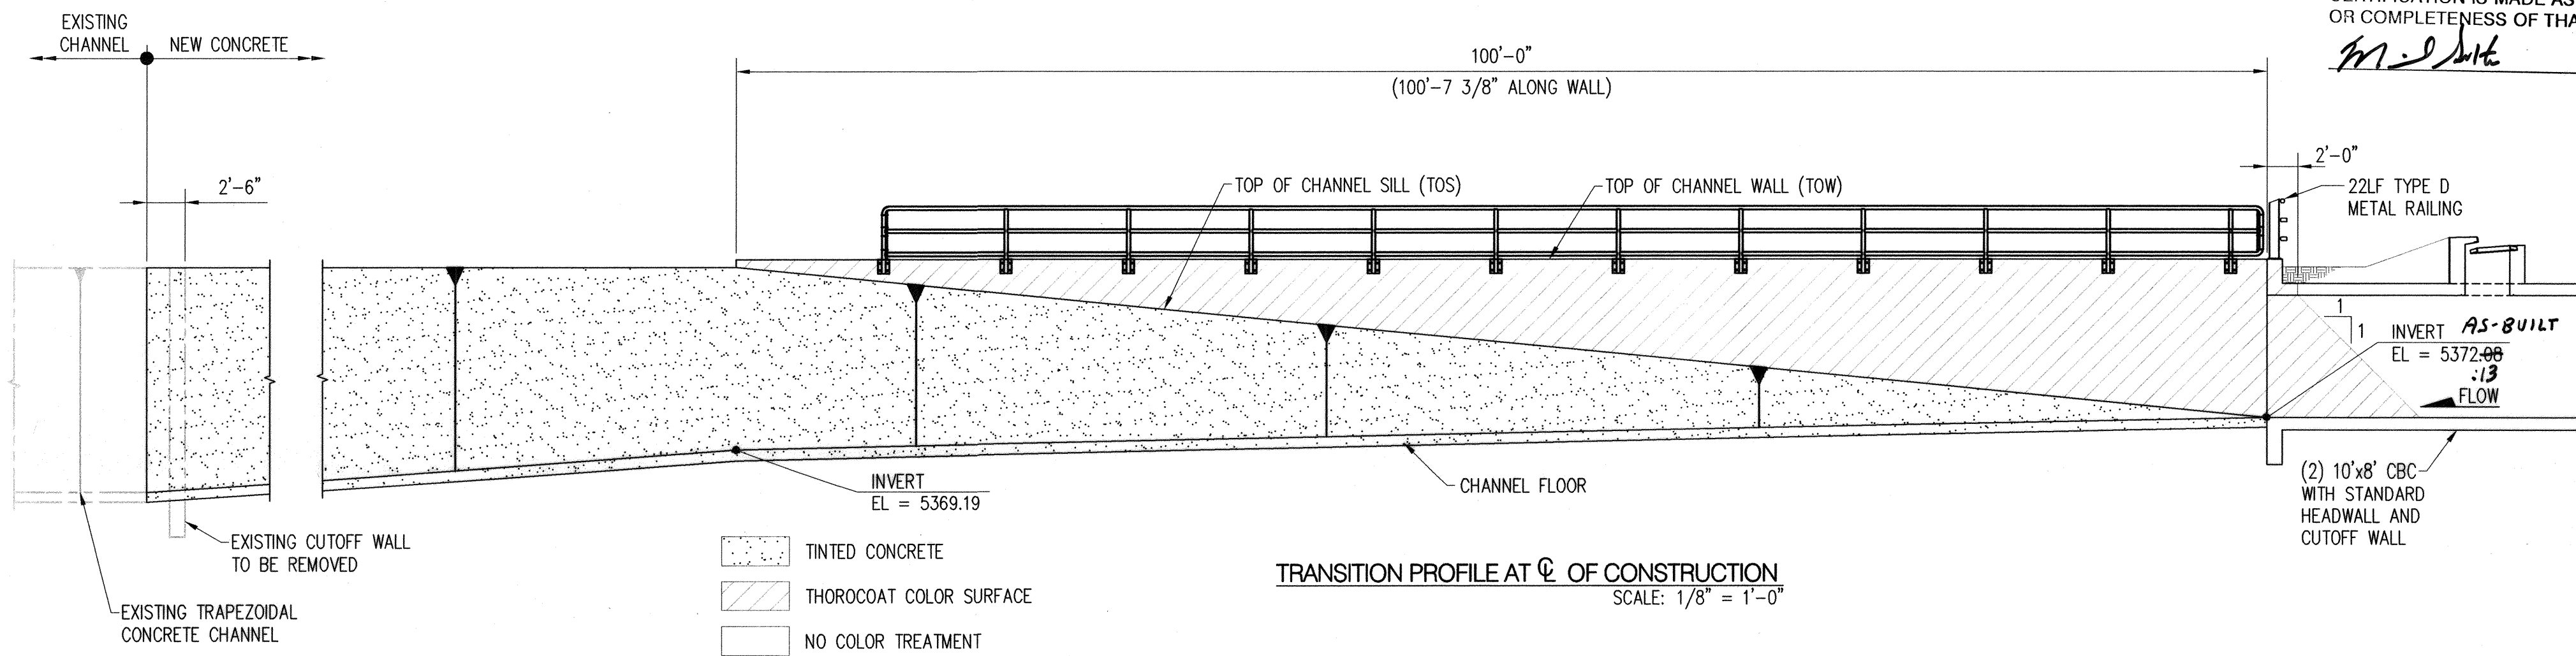

TRANSITION PROFILE AT C OF CONSTRUCTION
SCALE: 1/8" = 1'-0"

NOTE:
AS-BUILT INFORMATION SHOWN HEREIN IS
BASED UPON INFORMATION PROVIDED BY THE
CONTRACTOR AFTER COMPLETION OF THE
PROJECT. NO ADDITIONAL MEASUREMENTS OR
VERIFICATIONS WERE PERFORMED, AND NO
CERTIFICATION IS MADE AS TO THE ACCURACY
OR COMPLETENESS OF THAT INFORMATION.

M. J. D. H. DATE: 1-9-09

Bohannon & Huston
Courtney I 7600 Jefferson St. NE Albuquerque, NM 87109-4395
ENGINEERING • SPATIAL DATA • ADVANCED TECHNOLOGIES

Resource Technology, Inc.
Civil Engineering 5501 Jefferson Blvd. NE, Suite 200
Environmental Sciences Albuquerque, New Mexico 87109
Water Resources E-mail: rti@nm.net
Landscape Architecture Telephone: (505) 243-7300
Planning Facsimile: (505) 243-7400

CITY OF ALBUQUERQUE
DEPARTMENT OF MUNICIPAL DEVELOPMENT

LA CUEVA ARROYO DIP REPLACEMENT
EAGLE ROCK STRUCTURE PLAN AND PROFILE

Design Review Committee	City Engineer Approval	Mo./Day/Yr.	Mo./Day/Yr.
APPROVED OCT 17 2007 DESIGN REVIEW COMMITTEE	APPROVED OCT 17 2007 CITY ENGINEER		
City Project No.	Zone Map No.	Sheet	Of
7848.02	C-19	S2	25

Designed By: RND
Drawn By: MAG
Checked By: SMM

DATE: 8/2007
DATE: 8/2007
DATE: 8/2007