



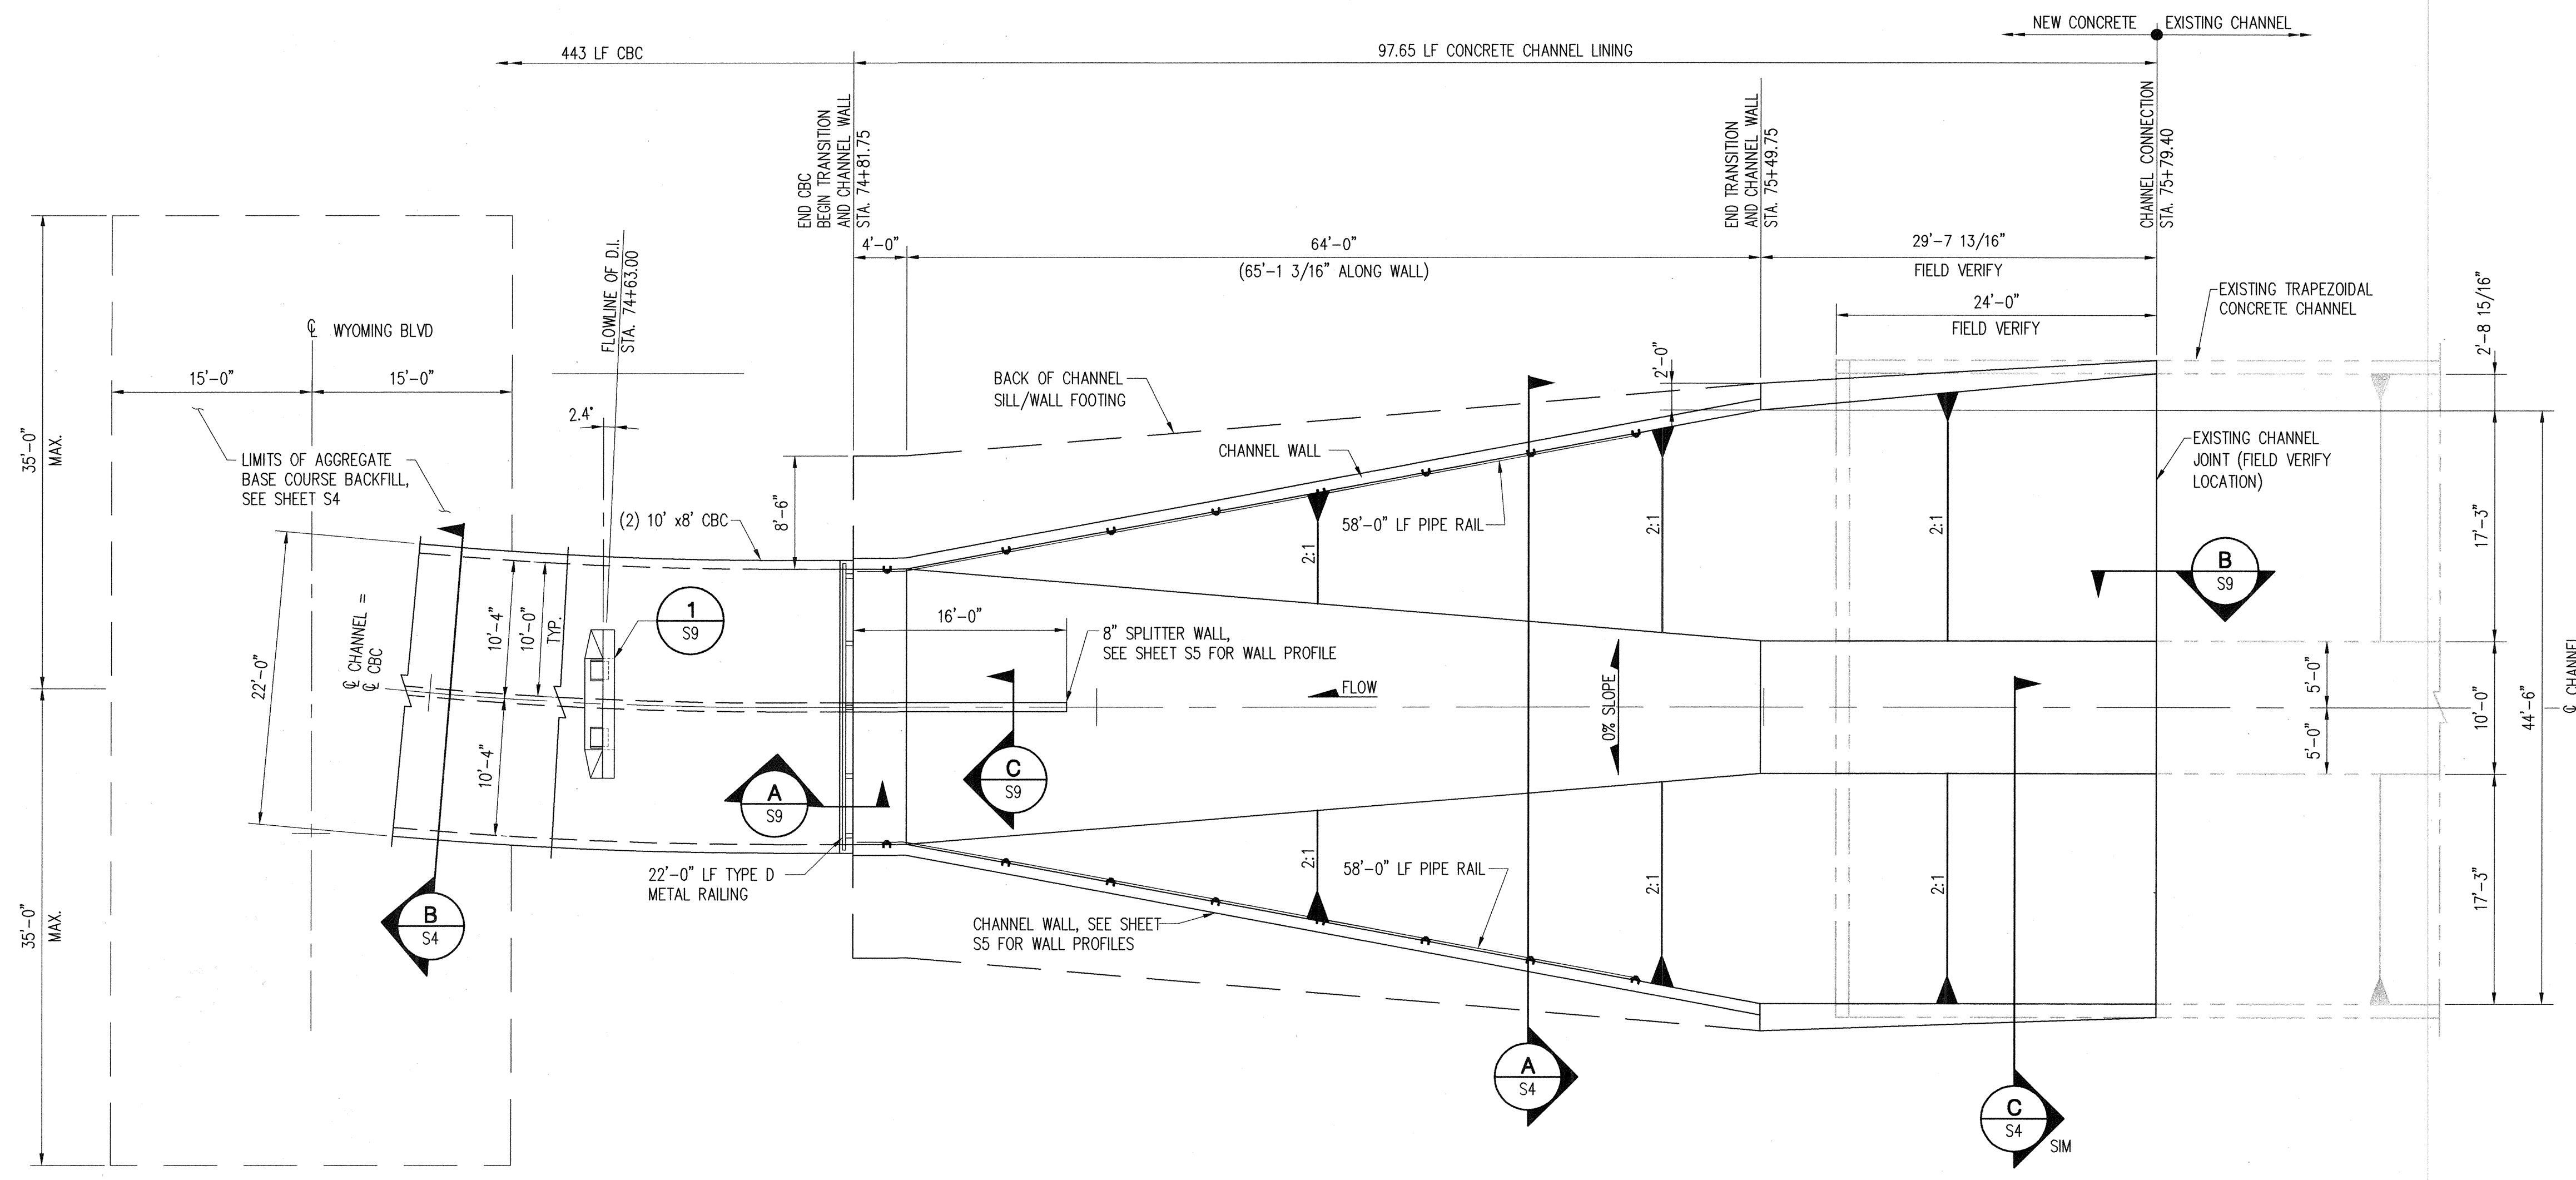

TRANSITION PLAN
SCALE: 1/8" = 1'-0"

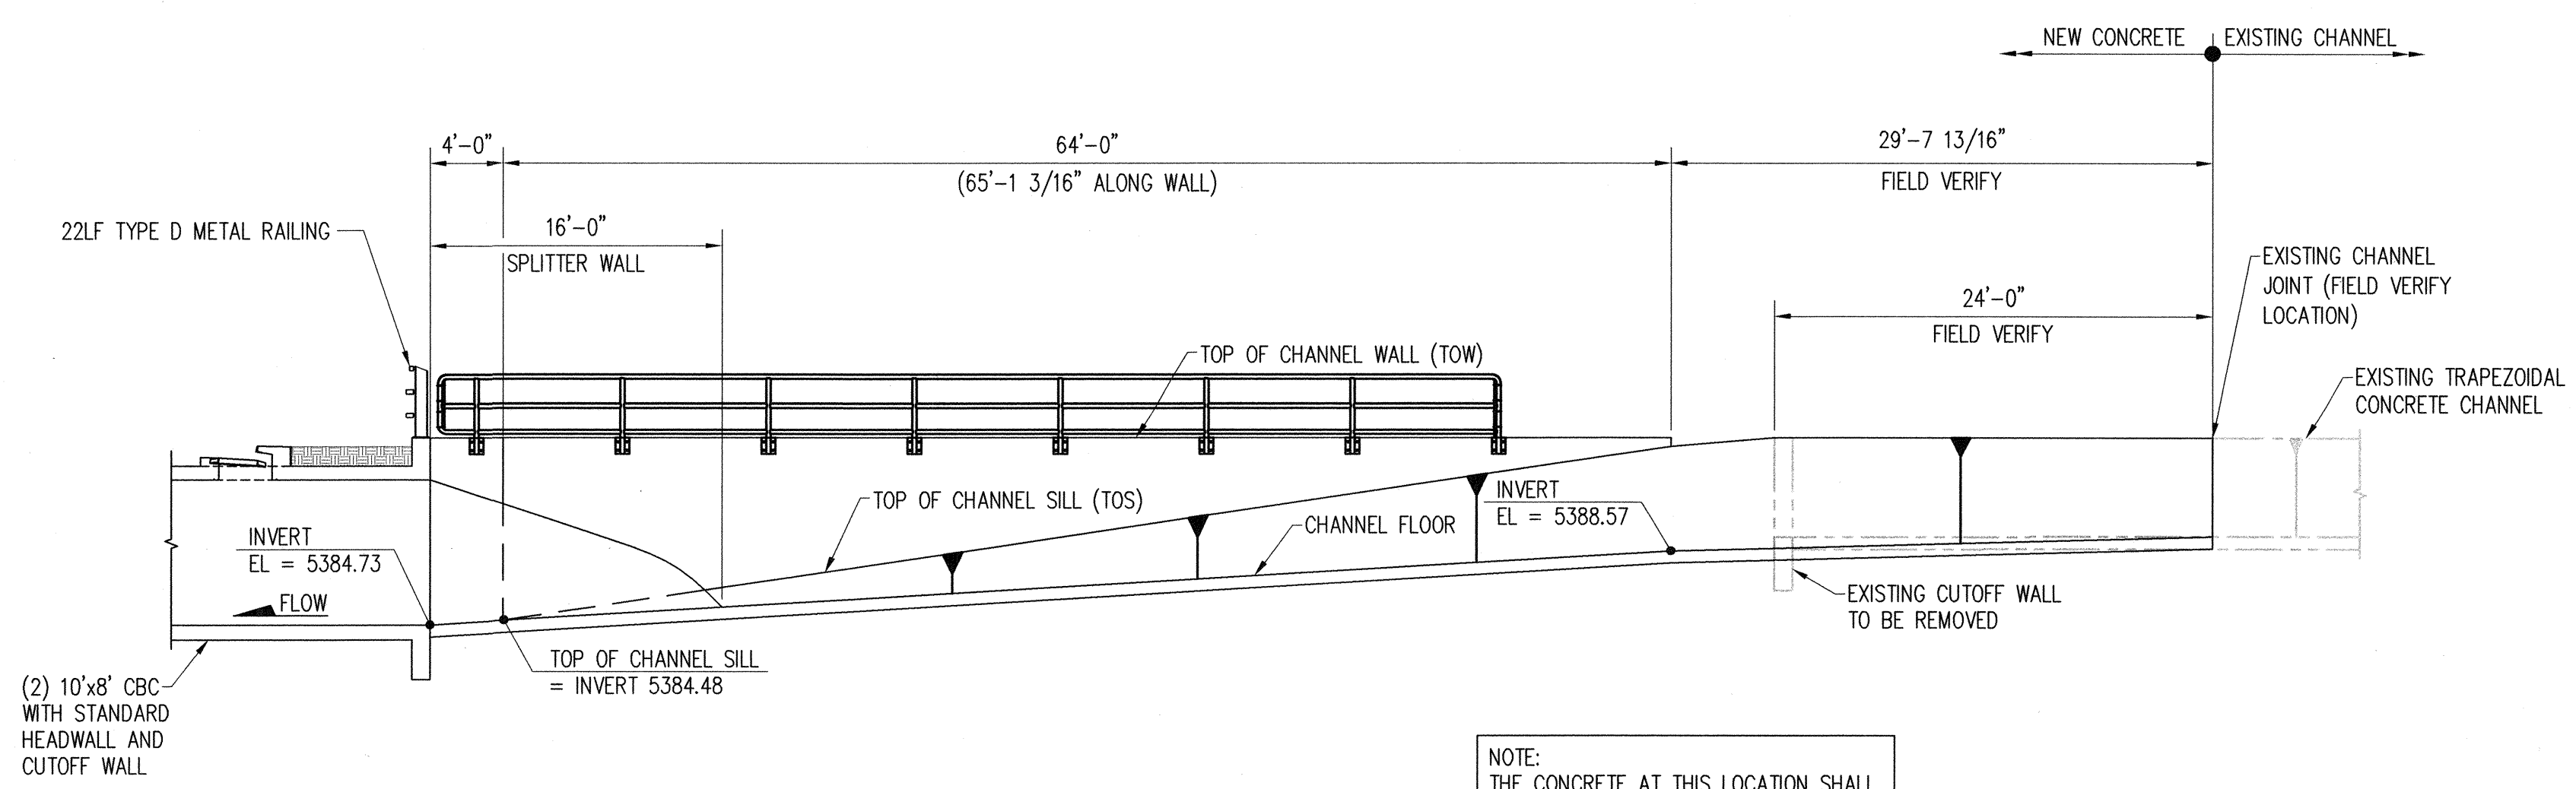

TRANSITION PROFILE AT CLC OF CONSTRUCTION
SCALE: 1/8" = 1'-0"

NOTE:
AS-BUILT INFORMATION SHOWN HEREIN IS
BASED UPON INFORMATION PROVIDED BY THE
CONTRACTOR AFTER COMPLETION OF THE
PROJECT. NO ADDITIONAL MEASUREMENTS OR
VERIFICATIONS WERE PERFORMED, AND NO
CERTIFICATION IS MADE AS TO THE ACCURACY
OR COMPLETENESS OF THAT INFORMATION.
8/15/07 DATE: 1-9-09

Bohannon & Huston, Inc.
Courtney I 7600 Jefferson St. NE Albuquerque, NM 87109-4335
ENGINEERING • SPATIAL DATA • ADVANCED TECHNOLOGIES

Resource Technology, Inc.
Civil Engineering 5501 Jefferson Blvd. NE, Suite 200
Environmental Sciences Albuquerque, New Mexico 87109
Water Resources E-mail: rti@nm.net
Landscape Architecture Telephone: (505) 243-7300
Planning Facsimile: (505) 243-7400

**CITY OF ALBUQUERQUE
DEPARTMENT OF MUNICIPAL DEVELOPMENT**

**LA CUEVA ARROYO DIP REPLACEMENT
WYOMING TRANSITION STRUCTURE PLAN AND PROFILE**

Design Review Committee	City Engineer Approval	Mo./Day/Yr.	Mo./Day/Yr.
APPROVED OCT 17 2007 DESIGN REVIEW COMMITTEE	APPROVED OCT 17 2007 CITY ENGINEER		
City Project No.	Zone Map No.	Sheet	Of
7848.02	C-19	S3	25