




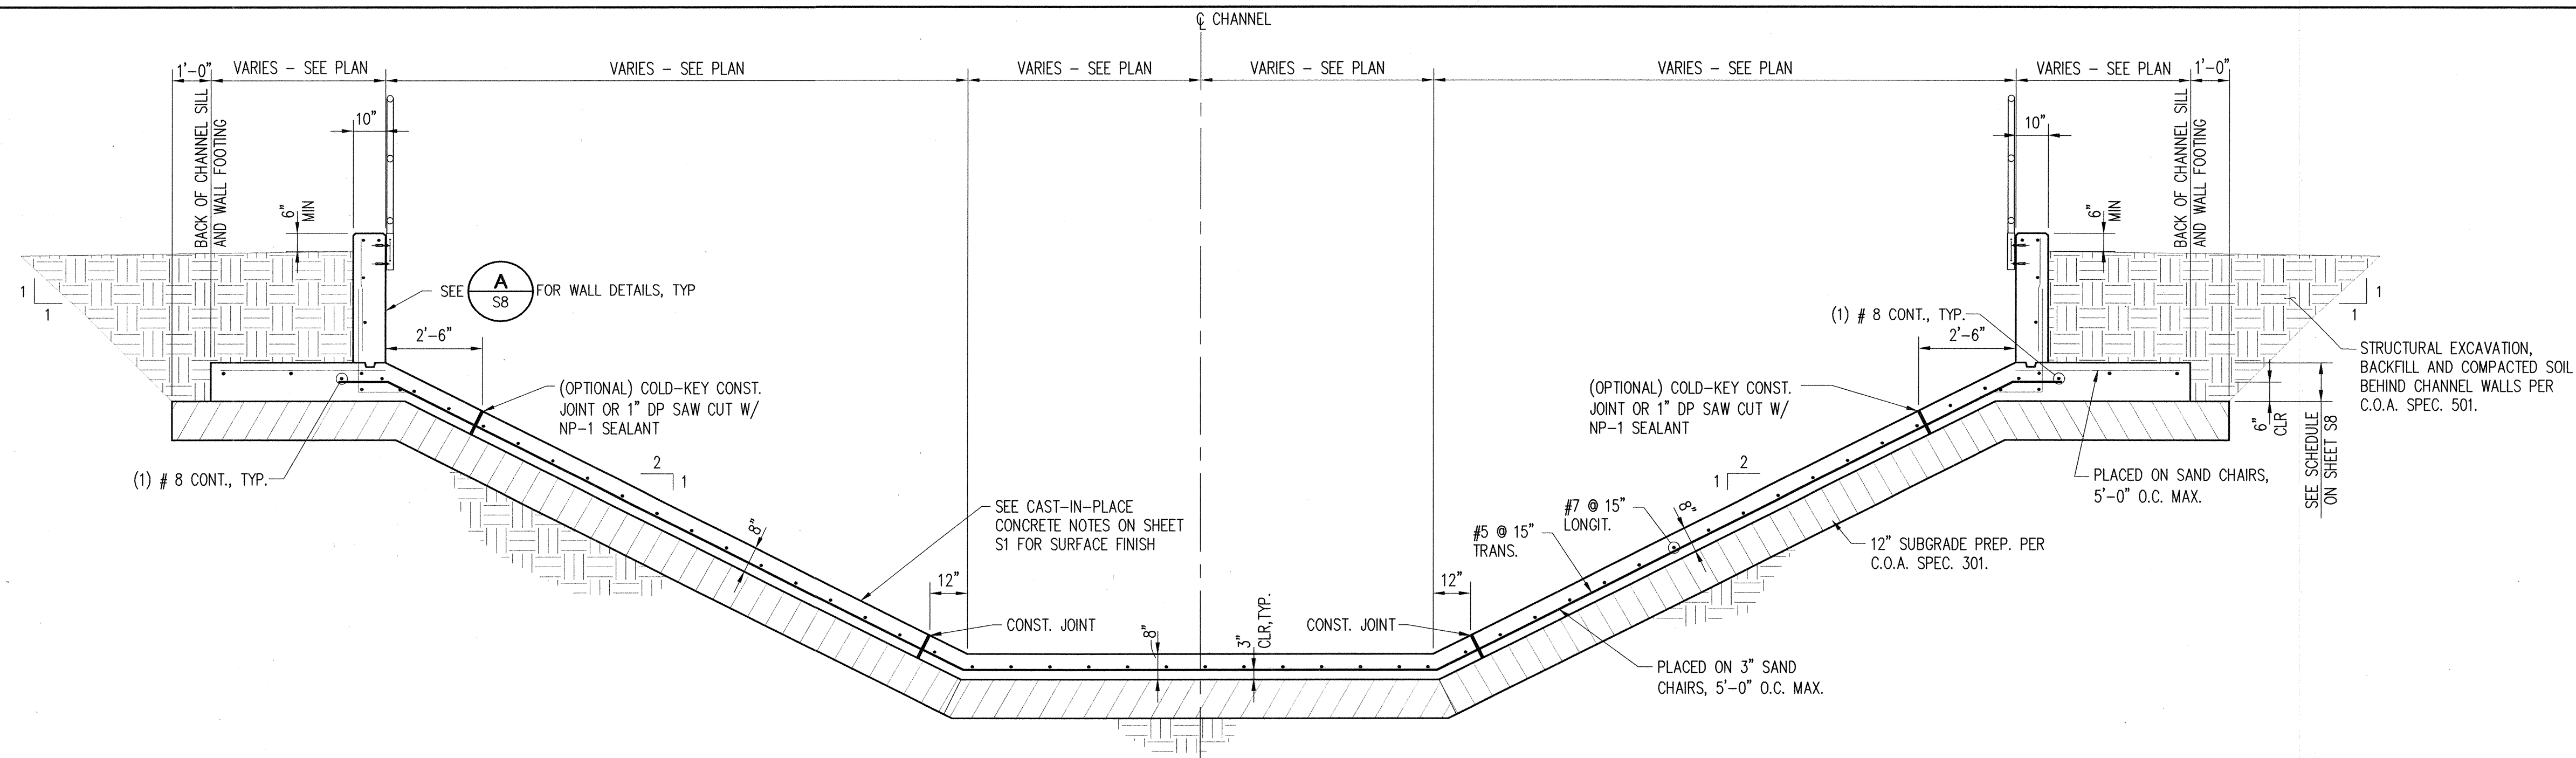

A
S4
TRANSVERSE SECTION THRU CHANNEL TRANSITION

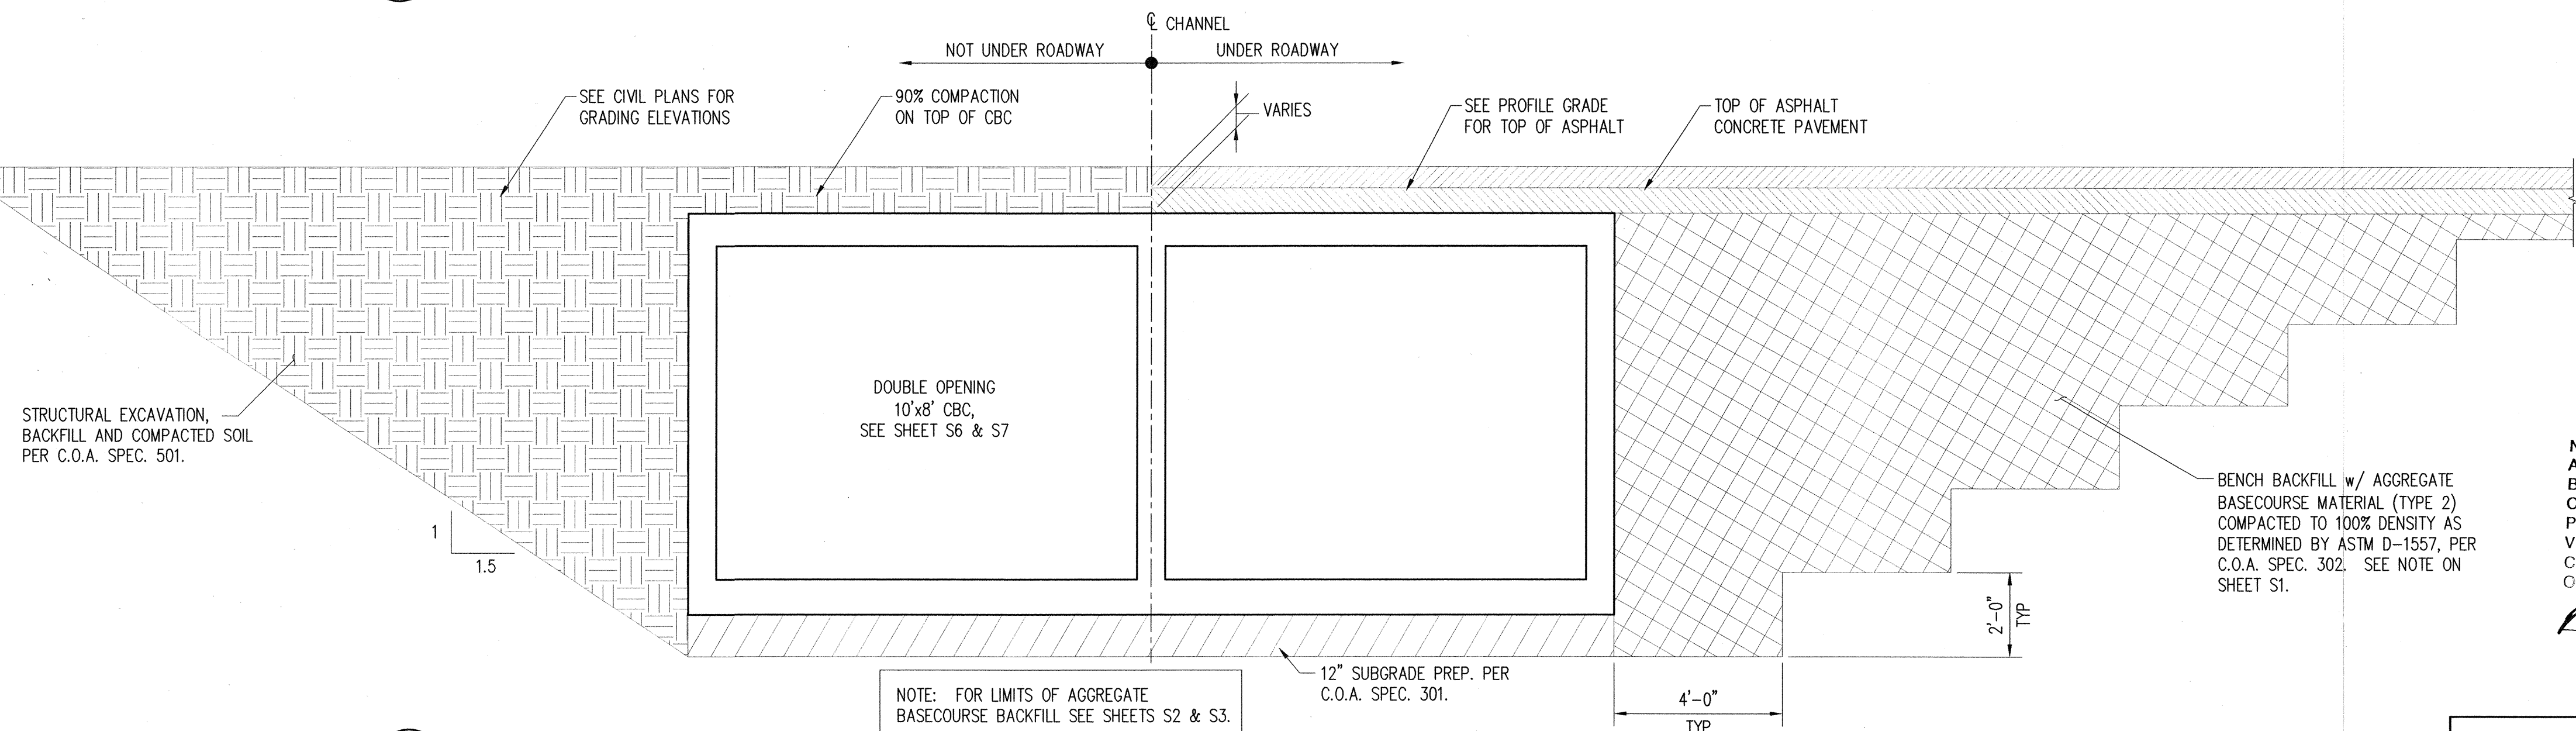

B
S4
TRANSVERSE SECTION THRU CBC

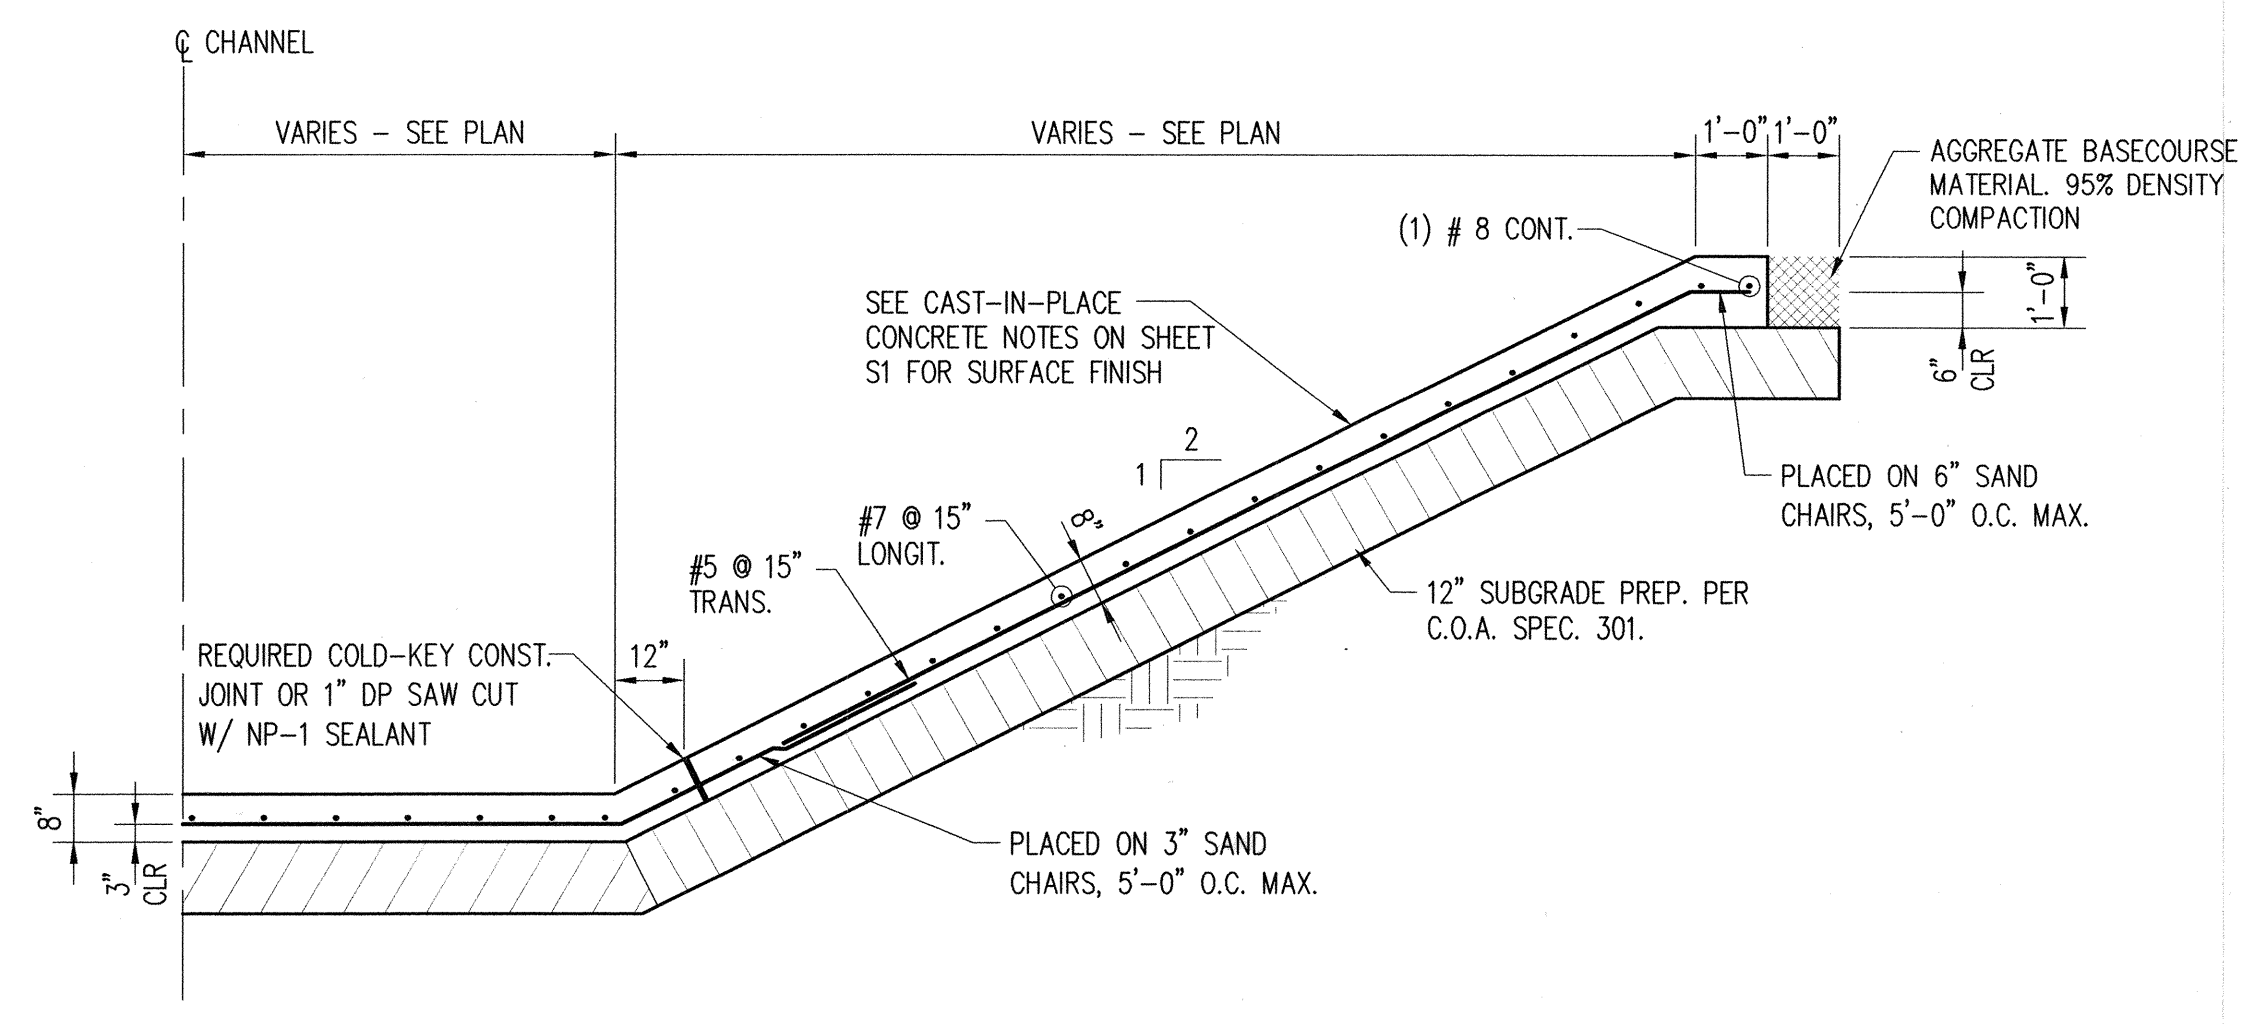

C
S4
TYPICAL CHANNEL SECTION

NOTE:
AS-BUILT INFORMATION SHOWN HEREIN IS
BASED UPON INFORMATION PROVIDED BY THE
CONTRACTOR AFTER COMPLETION OF THE
PROJECT. NO ADDITIONAL MEASUREMENTS OR
VERIFICATIONS WERE PERFORMED, AND NO
CERTIFICATION IS MADE AS TO THE ACCURACY
OR COMPLETENESS OF THAT INFORMATION.

M. J. H. DATE: 1-9-09

Bohannon & Huston
Courtney I 7600 Jefferson St. NE Albuquerque, NM 87109-4336
ENGINEERING • SPATIAL DATA • ADVANCED TECHNOLOGIES

Resource Technology, Inc.
Civil Engineering 5501 Jefferson Blvd. NE, Suite 200
Environmental Sciences Albuquerque, New Mexico 87109
Water Resources E-mail: rti@nm.net
Landscape Architecture Telephone: (505) 243-7300
Planning Facsimile: (505) 243-7400

		CITY OF ALBUQUERQUE DEPARTMENT OF MUNICIPAL DEVELOPMENT	
LA CUEVA ARROYO DIP REPLACEMENT STRUCTURE SECTIONS AND DETAILS			
Design Review Committee OCT 17 2007 DESIGN REVIEW COMMITTEE	City Engineer Approval OCT 17 2007 CITY ENGINEER	Mo./Day/Yr. _____	Mo./Day/Yr. _____
City Project No. 7848.02	Zone Map No. C-19	Sheet S4	Of 25