



EAGLE ROCK TRANSITION WALL PROFILE

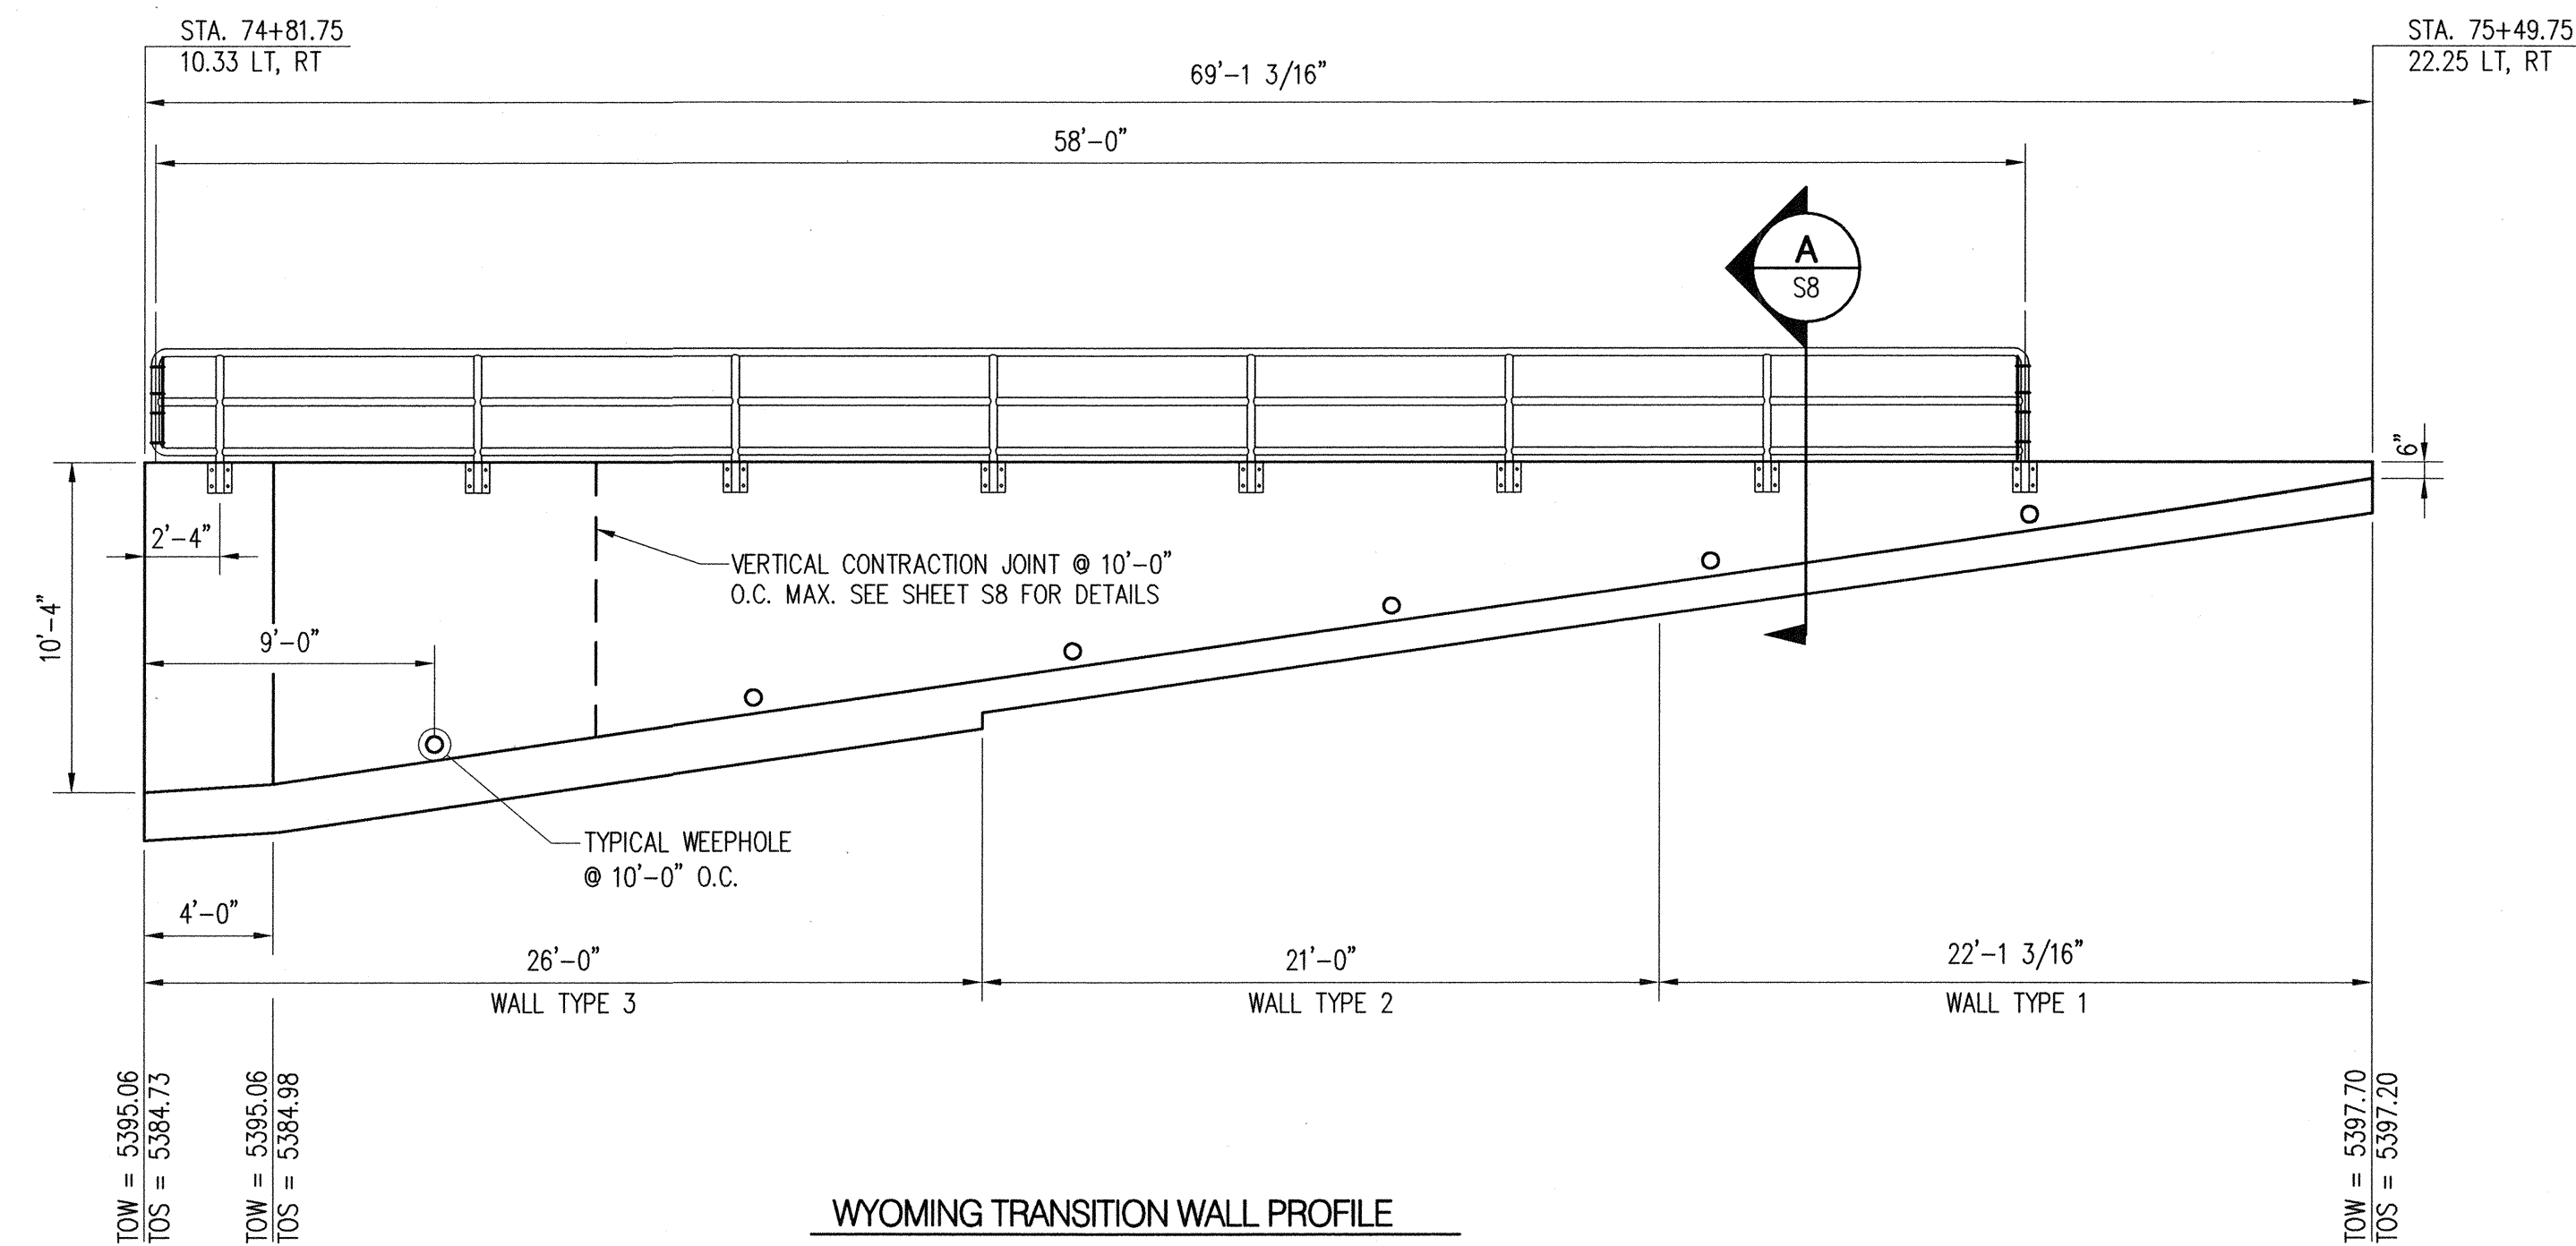

WYOMING TRANSITION WALL PROFILE

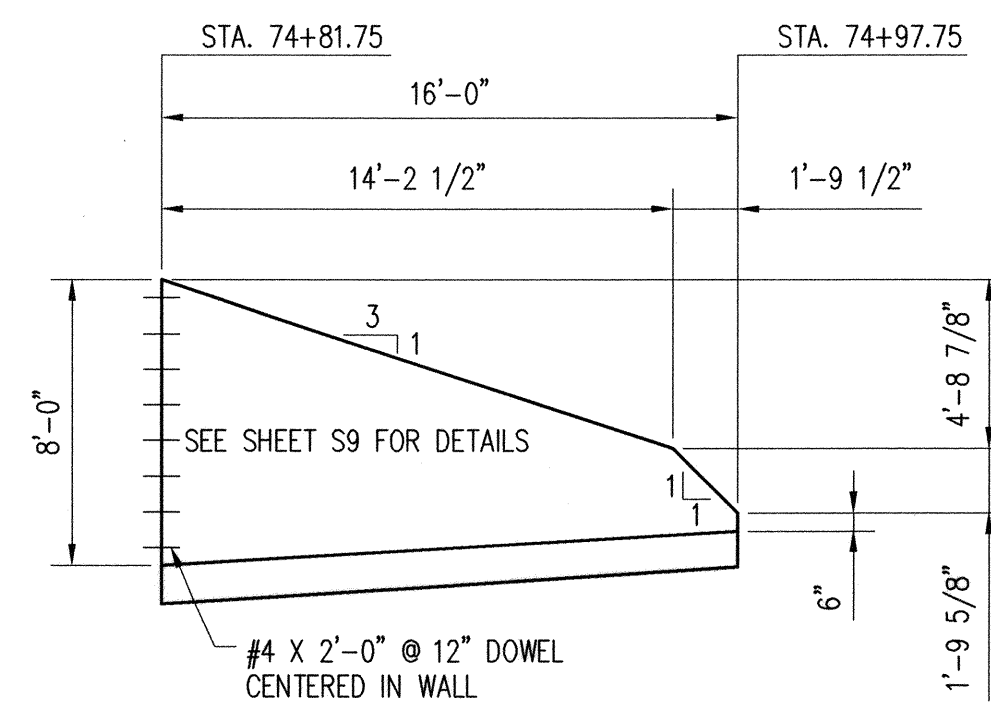

SPLITTER WALL PROFILE

NOTE:
AS-BUILT INFORMATION SHOWN HEREIN IS
BASED UPON INFORMATION PROVIDED BY THE
CONTRACTOR AFTER COMPLETION OF THE
PROJECT. NO ADDITIONAL MEASUREMENTS OR
VERIFICATIONS WERE PERFORMED, AND NO
CERTIFICATION IS MADE AS TO THE ACCURACY
OR COMPLETENESS OF THAT INFORMATION.

11-9-09 DATE: 1-9-09

NOTE:
DIMENSIONS, STATIONS, AND OFFSETS
ARE MEASURED TO FACE OF WALL.

Bohannon & Huston
 Courtyard I 7600 Jefferson St. NE Albuquerque, NM 87109-4336
 ENGINEERING • SPATIAL DATA • ADVANCED TECHNOLOGIES

Resource Technology, Inc.
 Civil Engineering 5501 Jefferson Blvd. NE, Suite 200
 Environmental Sciences Albuquerque, New Mexico 87109
 Water Resources E-mail: rti@nm.net
 Landscape Architecture Telephone: (505) 243-7300
 Planning Facsimile: (505) 243-7400

CITY OF ALBUQUERQUE
DEPARTMENT OF MUNICIPAL DEVELOPMENT

LA CUEVA ARROYO DIP REPLACEMENT
EAGLE ROCK AND WYOMING WALL PROFILES

Design Review Committee	City Engineer Approval	Mo./Day/Yr.	Mo./Day/Yr.
APPROVED OCT 17 2007 DESIGN REVIEW COMMITTEE	APPROVED OCT 17 2007 CITY ENGINEER		
City Project No.	Zone Map No.	Sheet	Of
		S5	25