

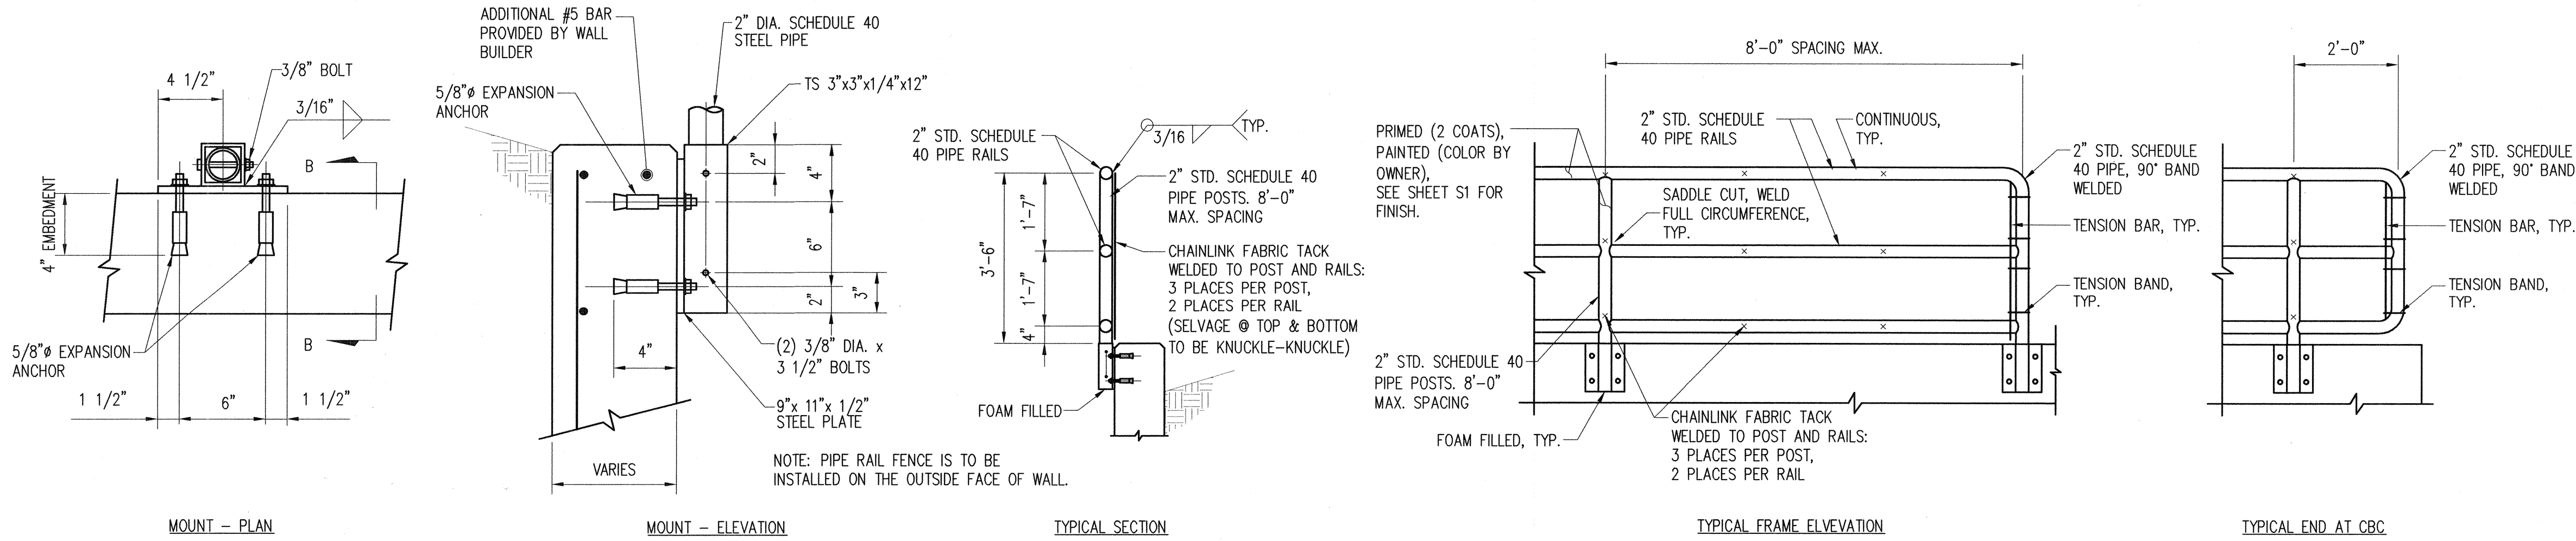
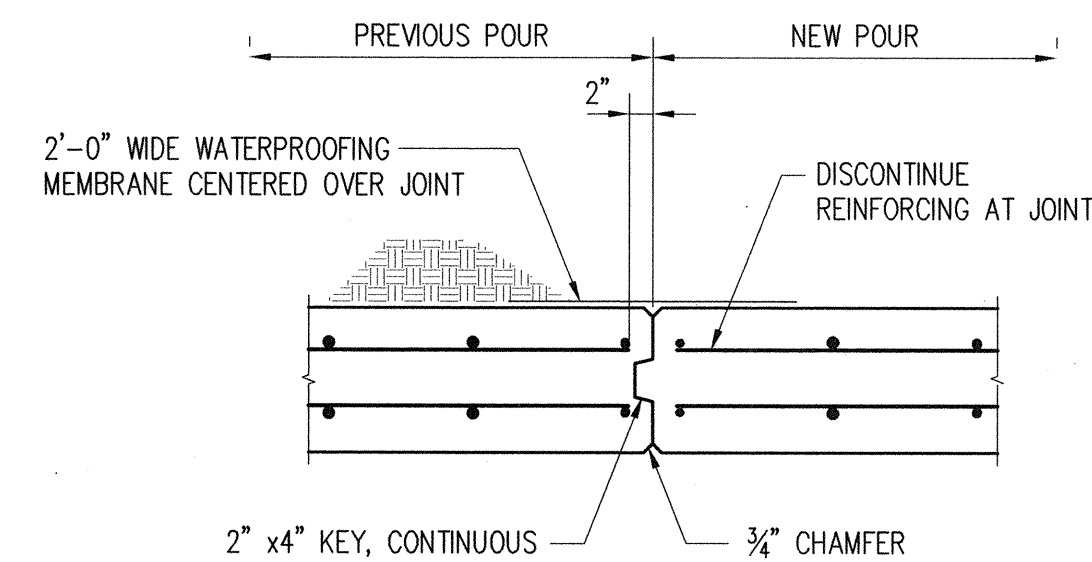
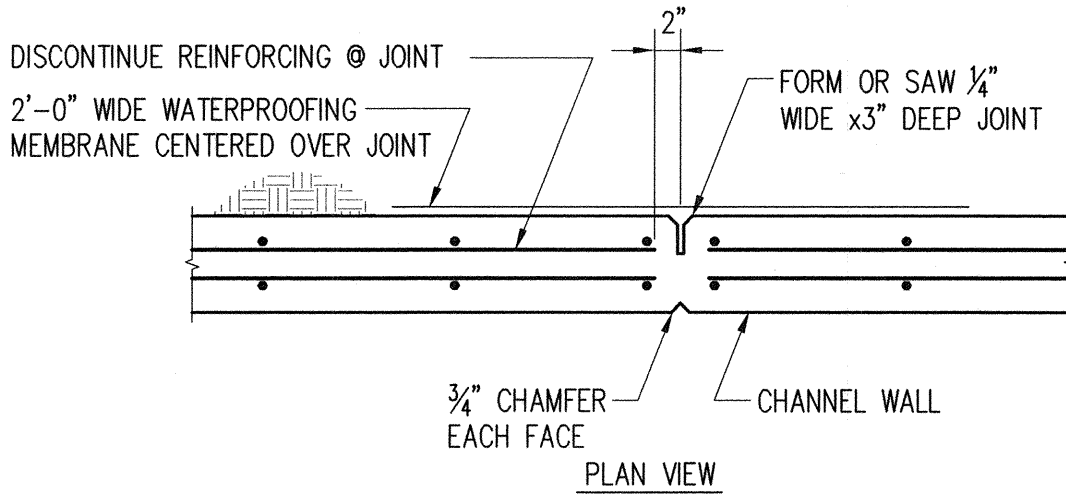
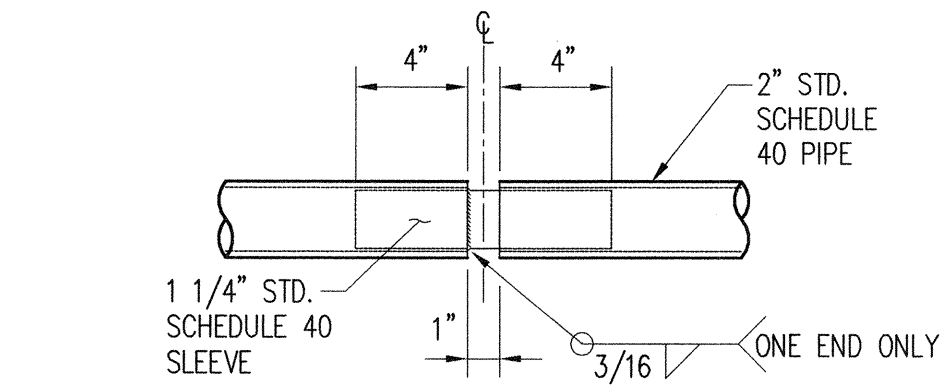


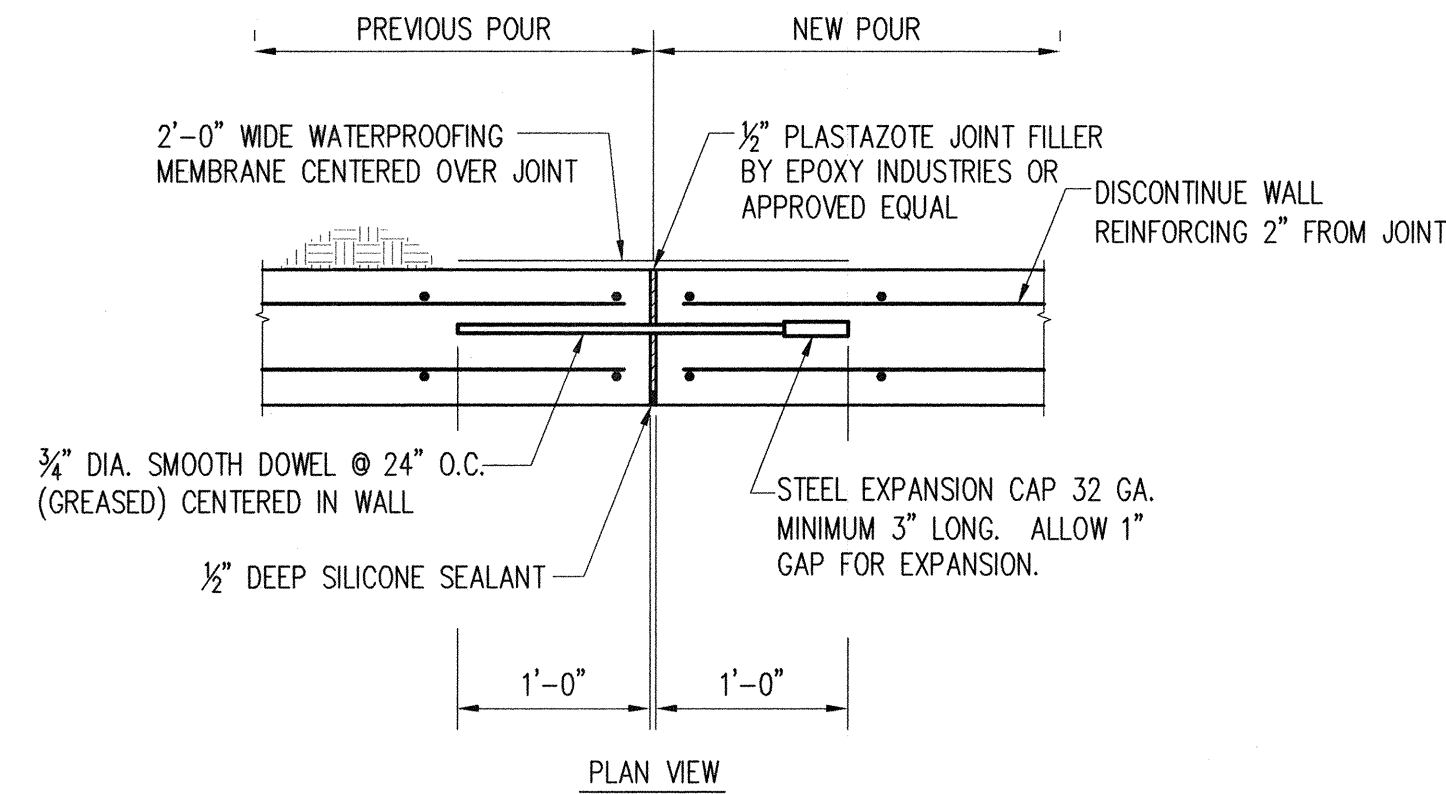

B TYPICAL PIPE RAIL W/ CHAINLINK FENCE MOUNTED ON CONCRETE WALL

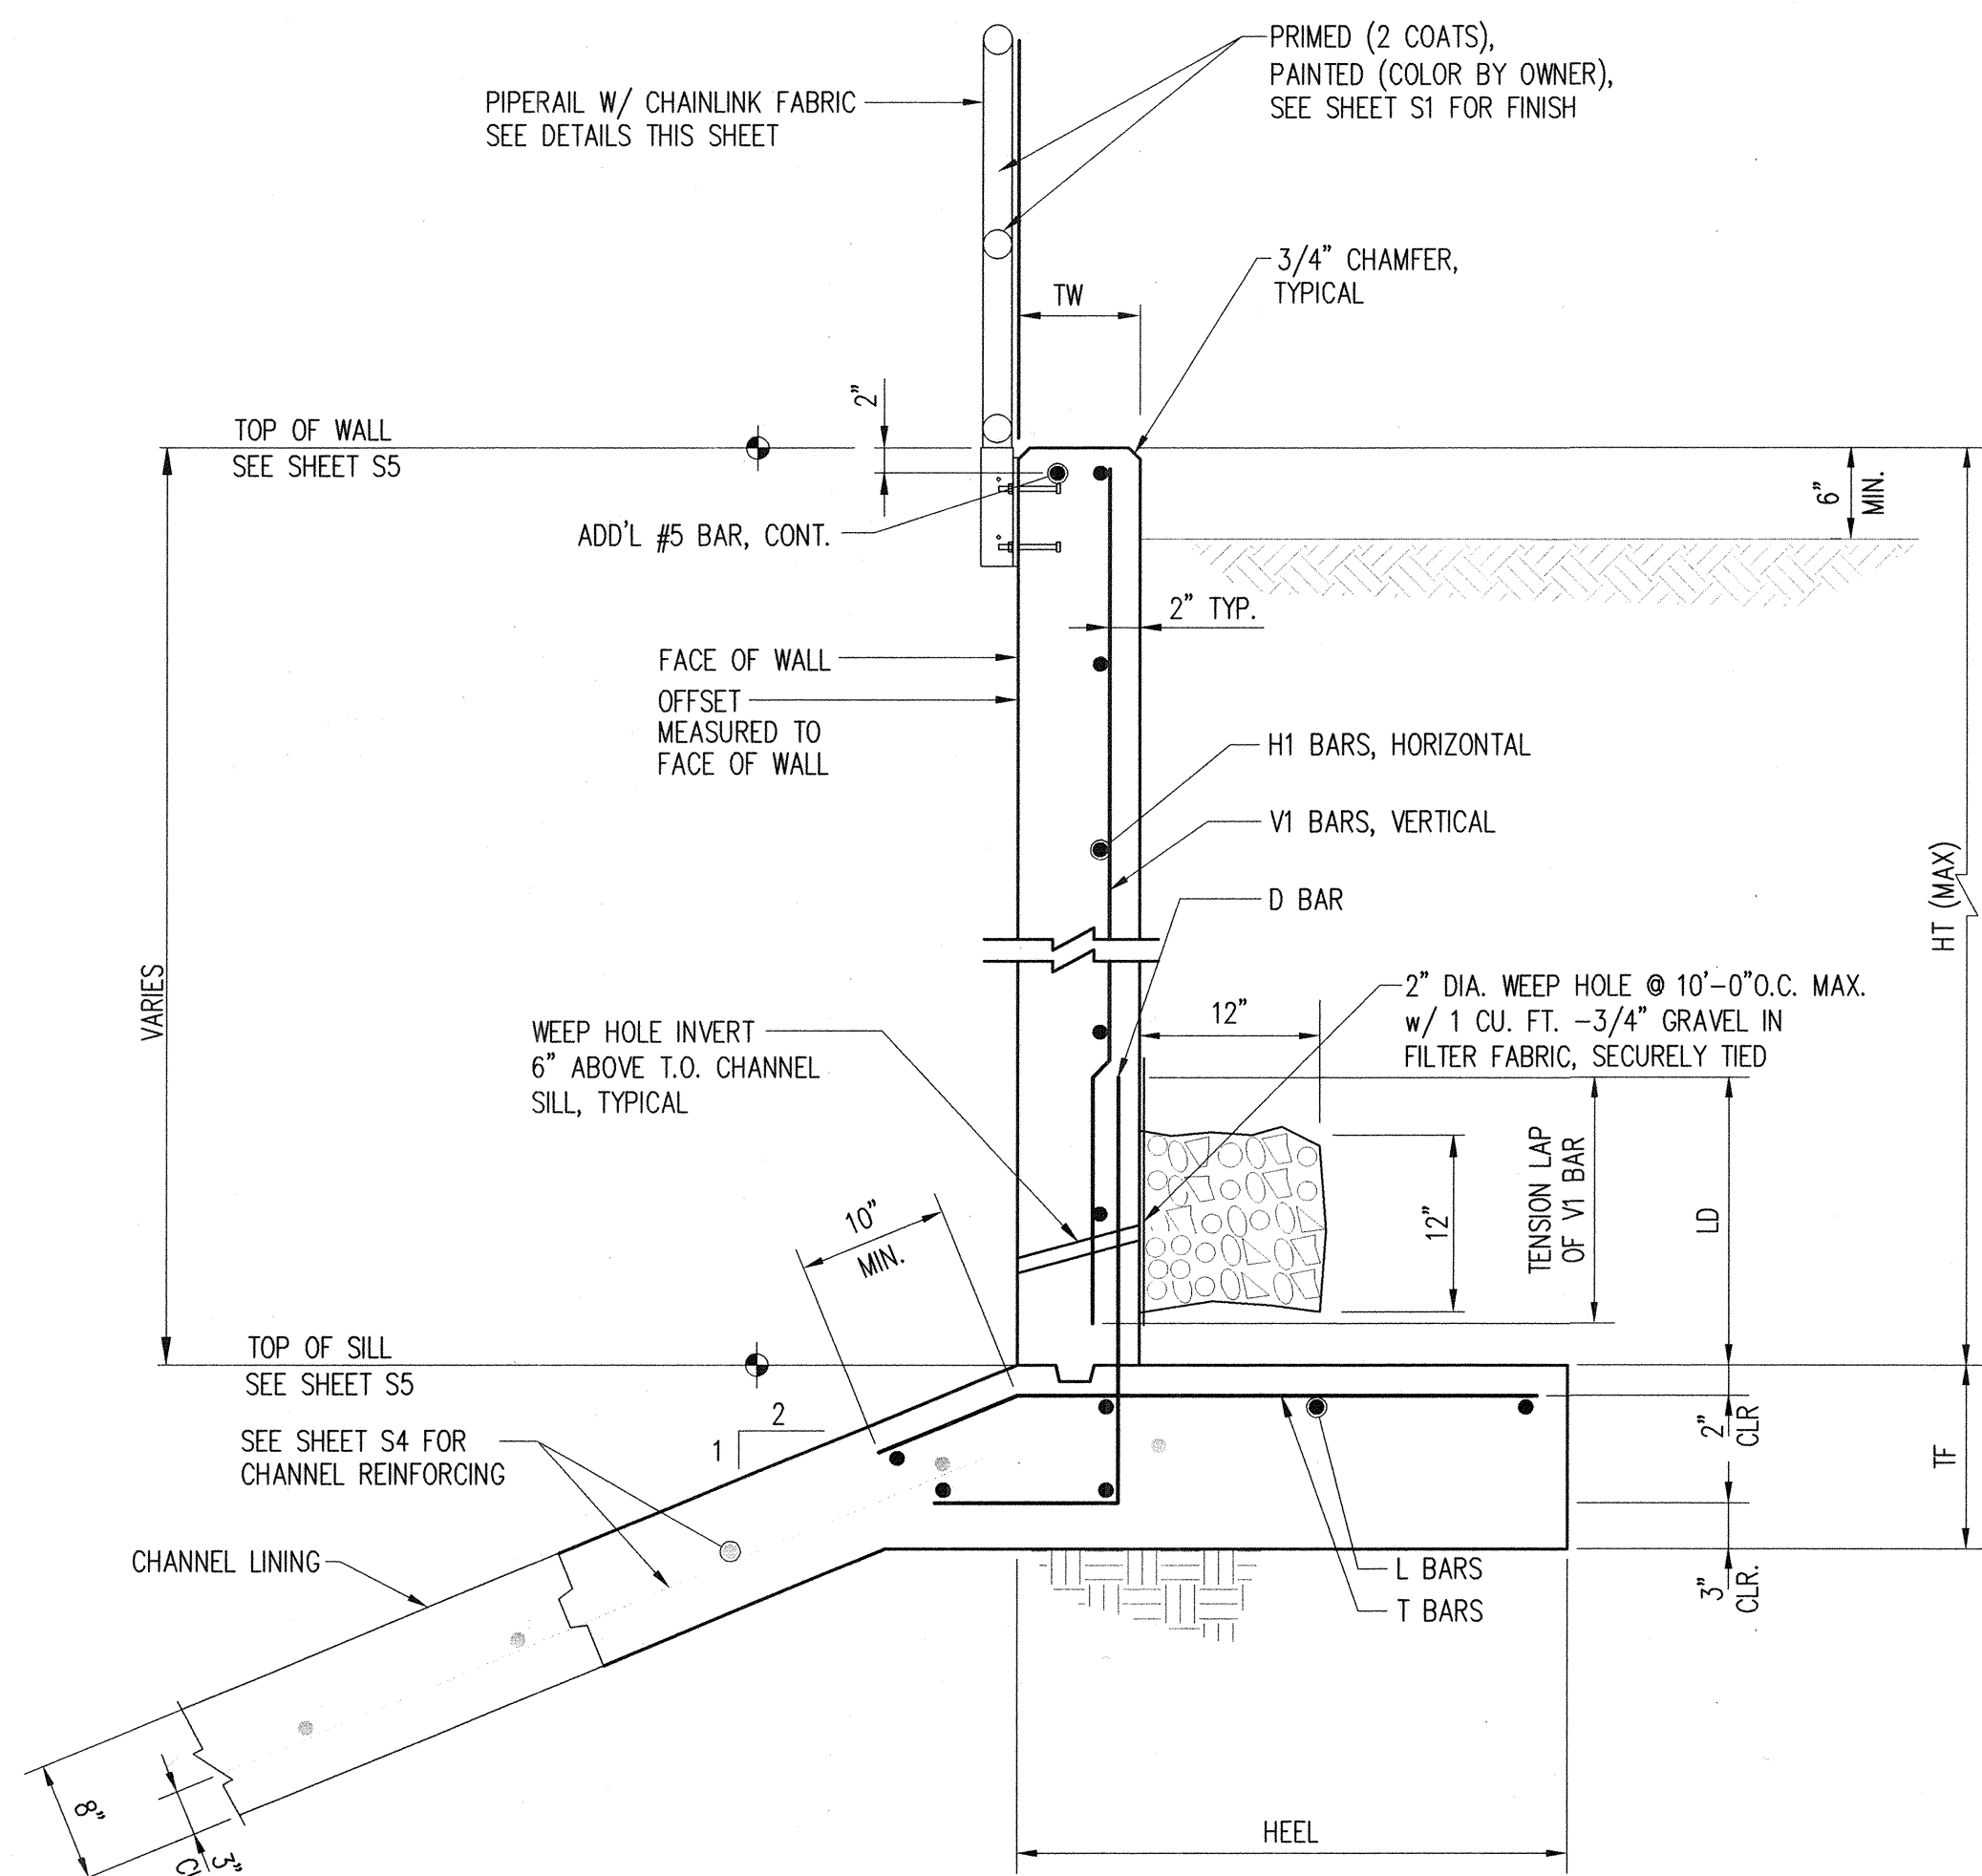

NOTE: AS-BUILT INFORMATION SHOWN HEREIN IS BASED UPON INFORMATION PROVIDED BY THE CONTRACTOR AFTER COMPLETION OF THE PROJECT. NO ADDITIONAL MEASUREMENTS OR VERIFICATIONS WERE PERFORMED, AND NO VERIFICATION IS MADE AS TO THE ACCURACY OR COMPLETENESS OF THAT INFORMATION.

DATE: 1-9-09

TENSION LAP SPLICES	
BAR	LENGTH (IN)
4	18
5	22
6	26
7	43
8	54

DIMENSIONS					
WALL TYPE	HT (MAX)	TF (IN)	HEEL (IN)	TW (IN)	LD (IN)
1	3'-6"	12	24	10	-
2	6'-11"	12	42	10	36
3	10'-4"	18	102	10	36

REINFORCING									
WALL TYPE	D		V1		H1		L		T
	SIZE	SPACE	SIZE	SPACE	SIZE	SPACE	NO. REQ'D	SIZE	
1	4	18	-	-	4	10	5	4	-
2	5	12	5	12	4	10	6	4	5
3	5	6	5	12	4	10	12	5	6

WALL SCHEDULE

Bohannon & Huston
 Courtyard I 7600 Jefferson St. NE Albuquerque, NM 87109-4395
 ENGINEERING • SPATIAL DATA • ADVANCED TECHNOLOGIES

Resource Technology, Inc.
 Civil Engineering 5501 Jefferson Blvd. NE, Suite 200
 Environmental Sciences Albuquerque, New Mexico 87109
 Water Resources E-mail: rti@rm.net
 Landscape Architecture Telephone: (505) 243-7300
 Planning Facsimile: (505) 243-7400

CITY OF ALBUQUERQUE
DEPARTMENT OF MUNICIPAL DEVELOPMENT

LA CUEVA ARROYO DIP REPLACEMENT
RETAINING WALL SCHEDULE AND DETAILS

Design Review Committee	City Engineer Approval	Mo./Day/Yr.	Mo./Day/Yr.
APPROVED OCT 17 2007 DESIGN REVIEW COMMITTEE	APPROVED OCT 17 2007 CITY ENGINEER		
City Project No.	Zone Map No.	Sheet	Of
7848.02	C-19	S8	25