

CITY OF ALBUQUERQUE



February 6, 2018

J. Graeme Means, P.E.
High Mesa Consulting Group
6010 B Midway Park Blvd NE
Albuquerque, NM 87109

**RE: Mark 3S Holly Development
9300 Holly NE
Grading and Drainage Plan
Engineer's Stamp Date 1/30/18 (File: C20D062)**

Dear Mr. Means:

Based on the information provided in your submittal received on 1/31/18, this plan cannot be approved until the following are corrected:

PO Box 1293

Prior to Grading Permit:

Albuquerque

NM 87103


www.cabq.gov

1. Provide a subbasin delineation map showing the area draining to each first flush pond. Quantify impervious v. pervious area.
2. Each pond needs to be sized for the impervious area draining to it.
3. For redevelopment, the first flush requirement is calculated as: $\text{Volume} = 0.26'' \times \text{Rebuilt Impervious Area}$. The rebuilt impervious area is the impervious area for the new school expansion, plus the impervious area of repaved parking lot/play area at the existing school.
4. The storm drain connection in the Public ROW needs to be 18" min. RCP class 3. Also add a Public/Private divide line at the new private manhole.
5. Provide a detail for the new retaining wall adjacent to Paseo del Norte ROW. Demonstrate that the adjacent ROW is not damaged or constrained in its use by the new wall.

Prior to Building Permit:

6. A Private Facility Drainage Covenant is required for the stormwater quality ponds. The original notarized form, exhibit A (legible on 8.5x11 paper), and recording fee (\$25, payable to City of Albuquerque) must be turned into DRC (4th, Plaza del Sol) for routing. Please contact Charlotte LaBadie (clabadie@cabq.gov, 924-3996) or Madeline Carruthers (mtafoya@cabq.gov, 924-3997) regarding the routing and recording process for covenants.
7. Correct the depth of gravel under the perforated pipe (1' vs 1").

CITY OF ALBUQUERQUE

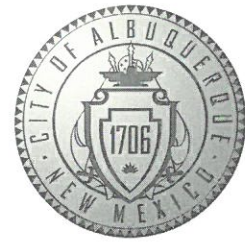

Prior to Certificate of Occupancy:

8. The Private Facility Drainage Covenant must be recorded with Bernalillo County and a copy included with the drainage certification.
9. Either a recorded SIA with financial guarantee or City acceptance and close-out of the public Work Order is required.

If you have any questions, please contact me at 924-3695 or dpeterson@cabq.gov.

Sincerely,

A handwritten signature in dark ink, appearing to read 'D. Peterson', is written over a faint, large watermark of the state of New Mexico.

Dana Peterson, P.E.
Senior Engineer, Planning Dept.
Development Review Services

PO Box 1293

Albuquerque

NM 87103

www.cabq.gov



City of Albuquerque

Planning Department

Development & Building Services Division

DRAINAGE AND TRANSPORTATION INFORMATION SHEET (REV 09/2015)

Project Title: _____ **Building Permit #:** _____ **City Drainage #:** _____
DRB#: _____ **EPC#:** _____ **Work Order#:** _____
Legal Description: _____
City Address: _____

Engineering Firm: _____ **Contact:** _____
Address: _____
Phone#: _____ **Fax#:** _____ **E-mail:** _____

Owner: _____ **Contact:** _____
Address: _____
Phone#: _____ **Fax#:** _____ **E-mail:** _____

Architect: _____ **Contact:** _____
Address: _____
Phone#: _____ **Fax#:** _____ **E-mail:** _____

Other Contact: _____ **Contact:** _____
Address: _____
Phone#: _____ **Fax#:** _____ **E-mail:** _____

Check all that Apply:

DEPARTMENT:

☐ HYDROLOGY/ DRAINAGE
☐ TRAFFIC/ TRANSPORTATION
☐ MS4/ EROSION & SEDIMENT CONTROL

TYPE OF SUBMITTAL:

☐ ENGINEER/ ARCHITECT CERTIFICATION
☐ CONCEPTUAL G & D PLAN
☐ GRADING PLAN
☐ DRAINAGE MASTER PLAN
☐ DRAINAGE REPORT
☐ CLOMR/LOMR
☐ TRAFFIC CIRCULATION LAYOUT (TCL)
☐ TRAFFIC IMPACT STUDY (TIS-NIA)
☐ EROSION & SEDIMENT CONTROL PLAN (ESC)
☐ OTHER (SPECIFY) _____

CHECK TYPE OF APPROVAL/ACCEPTANCE SOUGHT:

☐ BUILDING PERMIT APPROVAL
☐ CERTIFICATE OF OCCUPANCY
☐ PRELIMINARY PLAT APPROVAL
☐ SITE PLAN FOR SUB'D APPROVAL
☐ SITE PLAN FOR BLDG. PERMIT APPROVAL
☐ FINAL PLAT APPROVAL
☐ SIA/ RELEASE OF FINANCIAL GUARANTEE
☐ FOUNDATION PERMIT APPROVAL
☐ GRADING PERMIT APPROVAL
☐ SO-19 APPROVAL
☐ PAVING PERMIT APPROVAL
☐ GRADING/ PAD CERTIFICATION
☐ WORK ORDER APPROVAL
☐ CLOMR/LOMR
☐ PRE-DESIGN MEETING
☐ OTHER (SPECIFY) _____

IS THIS A RESUBMITTAL?: ☐ Yes ☐ No

DATE SUBMITTED: _____ By: _____

COA STAFF: _____ ELECTRONIC SUBMITTAL RECEIVED: _____

File Path: P:\DATA\2017\20170144\DWG\ [Plot Date: 01-30-2018]
File Name: 170144_C-100.DWG [Plot Time: 09:43 am]

DRAINAGE PLAN

I. EXECUTIVE SUMMARY AND INTRODUCTION

THE PROPOSED MARK 3S HOLLY EXPANSION DEVELOPMENT IS LOCATED WITHIN THE LA CUEVA SECTOR PLAN AREA OF NORTH ALBUQUERQUE ACRES. THE EXPANSION INCORPORATES ADDITIONAL PROPERTY WEST OF THE EXISTING DEVELOPMENT TO EXPAND THE EXISTING SCHOOL CAMPUS. THE SITE DEVELOPMENT PLANS FOR THE PROPOSED EXPANSION WERE APPROVED THROUGH EPC AND DRB AS AN AMENDMENT TO A PREVIOUSLY APPROVED PLAN. A CONCEPTUAL GRADING PLAN WAS INCLUDED IN THE EPC SET AND THIS SUBMITTAL IS CONSISTENT WITH THAT PLAN. MOST OF THE REQUIRED PUBLIC INFRASTRUCTURE IN HOLLY AVENUE NE HAS BEEN CONSTRUCTED BY PREVIOUS PROJECTS DESIGNED AND INSPECTED BY THIS ENGINEER (LOS VIGILS, VINEYARD COURT ESTATES, MARK 3S HOLLY IMPROVEMENTS). THE REMAINING PORTIONS REQUIRED FOR THIS PROJECT ARE THE PERMANENT HALF-WIDTH PAVING AND THE CONSTRUCTION OF TWO STORM INLETS. THE SITE DISCHARGES FREELY TO PUBLIC DRAINAGE IMPROVEMENTS IN HOLLY THAT WERE DESIGNED AND SIZED FOR THIS DISCHARGE. SITE RUNOFF WILL BE DIRECTED TO DEPRESSED WATER QUALITY AREAS PRIOR TO DISCHARGING TO HOLLY. CONCURRENT WITH THE DRB SITE PLAN APPROVALS, A PLATING ACTION WAS ALSO DONE TO SUPPORT THE LOT LINE. ELIMINATIONS, NEW LOTS LINES AND VACATION OF 2 FEET OF HOLLY RIGHT-OF-WAY BEING INCORPORATED INTO THE SITE. THE PURPOSE OF THIS PLAN IS TO OBTAIN BUILDING PERMIT APPROVAL.

II. PROJECT DESCRIPTION:

AS SHOWN BY VICINITY MAP C-20 LOCATED HEREON, THE SITE IS LOCATED IN THE NORTH ALBUQUERQUE ACRES SECTION OF ALBUQUERQUE, ON HOLLY AVE NE BETWEEN VENTURA ST. N.E. AND HOLBROOK STREET N.E. THE EXISTING LEGAL DESCRIPTION IS TRACT A-1 MARK 3S HOLLY DEVELOPMENT. THE SITE IS ZONED SU-2/MIXED USE AND THE PROPOSED DEVELOPMENT IS CONSISTENT WITH THE ZONING AND THE APPROVED SITE DEVELOPMENT PLANS.

AS SHOWN BY PANEL 141 OF 825 OF THE NATIONAL FLOOD INSURANCE PROGRAM FLOOD INSURANCE RATE MAPS, BERNALILLO COUNTY, NEW MEXICO, AND INCORPORATED AREAS, DATED SEPTEMBER 26, 2008, THE SITE DOES NOT LIE WITHIN THE VICINITY OF ANY DESIGNATED FLOOD HAZARD ZONES.

III. BACKGROUND DOCUMENTS

THE FOLLOWING IS A LIST OF DOCUMENTS RELATED TO THE SITE AND SURROUNDING AREA. THIS LIST MAY NOT BE INCLUSIVE, HOWEVER, REPRESENTS A SUMMARY OF RELEVANT PLANS AND DOCUMENTS WHICH ARE KNOWN TO THE ENGINEER AT THE TIME OF PLAN PREPARATION.

- A. THE "NORTH AND SOUTH DOMINGO BACA ARROYO AND PASEO DEL NORTE CORRIDOR DRAINAGE MANAGEMENT PLAN" PREPARED FOR AMAFCA BY RESOURCE TECHNOLOGY, INC. (RTI) DATED DECEMBER, 1991. THIS PLAN HAS BEEN ADOPTED BY AMAFCA AS A GUIDELINE FOR DRAINAGE MANAGEMENT WITHIN THIS AREA WHICH INCLUDES THE NORTH DOMINGO BACA ARROYO (NDBA). AMAFCA RESOLUTION 1992-3 DATED JANUARY 03, 1992 FORMALLY ADOPTED THIS PLAN WHICH IDENTIFIES THE EXTENSION OF PERMANENT DRAINAGE IMPROVEMENTS WITHIN THE NDBA CORRIDOR, AND ESTABLISHED DEVELOPED DRAINAGE BASIN BOUNDARIES WITHIN THE PLAN AREAS. AS SHOWN BY THIS PLAN, THIS SITE IS IDENTIFIED TO DRAIN TO PUBLIC STORM DRAIN IMPROVEMENTS CONSTRUCTED WITHIN THE HOLLY RIGHT-OF-WAY.
- B. REQUEST FOR LETTER OF MAP REVISION (LOMR) FOR THE NORTH DOMINGO BACA ARROYO CARMEL AVENUE STORM DRAIN EXTENSION PREPARED BY JMA DATED 12/08/2003 AND APPROVED BY FEMA 03/23/2004 (FEMA CASE NUMBER 04-06-671P). THIS LOMR SUPPORTS THE COMPLETED NORTH DOMINGO BACA ARROYO CARMEL AVENUE STORM DRAIN EXTENSION COST SHARE PROJECT BY AMAFCA. UPON FEMA APPROVAL, AND IT REMOVED THE ASSOCIATED FLOODPLAIN DESIGNATION FROM THE NDBA WEST OF A POINT MIDBLOCK BETWEEN HOLBROOK STREET AND EUBANK.
- C. DRAINAGE REPORT FOR "LOS VIGILS SUBDIVISION" BY HIGH MESA CONSULTING GROUP FORMERLY KNOWN AS JEFF MORTENSEN & ASSOCIATES, INC. DATED 12/31/2002, HYDROLOGY FILE C20/D41. THIS PLAN THE CONSTRUCTION OF A 45 LOT RESIDENTIAL SUBDIVISION LOCATED TO THE NORTH OF THIS PROJECT ON THE NORTH SIDE OF HOLLY. THE LOS VIGILS PROJECT EXTENDED THE HOLLY STORM DRAIN ACROSS THE FRONTAGE OF THIS SITE AND DESIGNED THE REQUIRED INLETS ON THE SOUTH SIDE WHICH MUST NOW BE CONSTRUCTED. A BASIN MAP, STREET HYDRAULICS AND STORM DRAIN HYDRAULICS ANALYSIS WERE INCLUDED IN THIS SUBMITTAL TO ADDRESS THE EXTENSION OF HOLLY TO HOLBROOK ALL DEVELOPMENT ON HOLLY, INCLUDING THIS SITE.
- D. GRADING PLAN FOR "DESERT RIDGE OFFICE PARK" BY JMA, HYDROLOGY FILE C20/D51. THIS PLAN WAS APPROVED FOR THE UPSTREAM SITE IMMEDIATELY TO THE EAST (PROJECT # 1003277).
- E. DRAINAGE REPORT FOR "VINEYARD COURT ESTATES" BY HIGH MESA CONSULTING GROUP FORMERLY KNOWN AS JEFF MORTENSEN & ASSOCIATES, INC. DATED 08/21/2003. THIS PLAN WAS FOR THE CONSTRUCTION OF A 45 LOT RESIDENTIAL SUBDIVISION LOCATED TO THE NORTHEAST OF THIS PROJECT ON THE NORTH SIDE OF HOLLY. THE VINEYARD COURT ESTATES PROJECT EXTENDED THE HOLLY STORM DRAIN AND STREET IMPROVEMENTS ACROSS ITS FRONTAGE. A BASIN MAP, STREET HYDRAULICS AND STORM DRAIN HYDRAULICS ANALYSIS WERE INCLUDED IN THIS SUBMITTAL TO ADDRESS THE EXTENSION OF HOLLY TO HOLBROOK AND ALL DEVELOPMENT ON HOLLY, INCLUDING THIS SITE.
- F. GRADING AND DRAINAGE PLANS FOR MARK 3S HOLLY DEVELOPMENT BY HIGH MESA CONSULTING GROUP FORMERLY KNOWN AS JEFF MORTENSEN & ASSOCIATES, INC. DATED 05/11/2015. THIS PLAN FOLLOWED THE DRAINAGE OF FREE DISCHARGE TO THE PERMANENT FULLY HOLLY PAVING AND STORM DRAINAGE IMPROVEMENTS WHICH IS CONSISTENT WITH PREVIOUSLY APPROVED PLANS FOR NDBA DEVELOPMENT WHICH INCLUDES THIS SITE. THE DRAINAGE CONCEPTS PRESENTED THEREIN WILL BE CONSISTENT WITH THOSE NOW PROPOSED.

THE PROPOSED CONSTRUCTION DRAINING DIRECTLY AND FREELY TO PERMANENT HOLLY AVENUE NE DRAINAGE IMPROVEMENTS AS PROPOSED AND DESCRIBED HEREIN IS IN ACCORDANCE WITH THE POLICIES AND REQUIREMENTS OF THE ABOVE LISTED DOCUMENTS, AND IS CONSISTENT WITH THE CONCEPTS PREVIOUSLY ESTABLISHED BY THE CITY AND AMAFCA FOR NDBA DEVELOPMENT.

IV. EXISTING CONDITIONS:

THE DEVELOPMENT TO BE EXPANDED IS CURRENTLY DEVELOPED AS A MONTESSORI SCHOOL WITH PAVED PARKING, UTILITY AND LANDSCAPING IMPROVEMENTS. THE ADJACENT LOT TO BE EXPANDED INTO WAS PREVIOUSLY DEVELOPED INTO A LANDSCAPING BUSINESS. EXISTING RUNOFF FOR BOTH SITES DRAIN TO HOLLY AVE NE TO EXISTING DOWNSTREAM PUBLIC STORM DRAIN FACILITIES THAT WERE CONSTRUCTED BY LOS VIGILS AND THE PREVIOUS MARK 3S HOLLY DEVELOPMENT (REF. C & H). HOLLY AVE NE TO THE NORTH IS A PUBLIC STREET WITH HALF-WIDTH (NORTH) PERMANENT PAVING IMPROVEMENTS. THE UPSTREAM SECTION OF HOLLY HAS PERMANENT FULL WIDTH IMPROVEMENTS. CONSTRUCTED BY VINEYARD COURT ESTATES, CPN 718781. PASEO DEL NORTE TO THE SOUTH IS A FULLY DEVELOPED PUBLIC STREET WITH A DRAINAGE DITCH, PUBLIC STORM DRAIN, AND PAVED ASPHALT TRAIL.

OFFSITE FLOWS DO NOT ENTER THE SITE FROM THE DEVELOPED SITE TO THE EAST OR FROM THE PUBLIC STREETS TO THE NORTH AND SOUTH WHICH EXHIBIT PARALLEL TOPOGRAPHY. THE UNDEVELOPED SITE TO THE WEST IS TOPOGRAPHICALLY LOWER AND INCAPABLE OF CONTRIBUTING OFFSITE FLOWS.

V. DEVELOPED CONDITIONS

THE PROPOSED IMPROVEMENTS CONSIST OF DEMOLITION AND REMOVAL OF EXISTING LANDSCAPING BUSINESS TO ALLOW FOR EXPANSION OF CURRENT MONTESSORI SCHOOL CAMPUS. THE EXPANSION WILL INCLUDE A NEW INFANT DAYCARE BUILDING WITH PAVED PARKING, UTILITY, AND LANDSCAPING IMPROVEMENTS. THE SITE WILL CONTINUE TO DISCHARGE FREELY INTO HOLLY AVE NE. PRIOR TO DISCHARGING OFF SITE, RUNOFF WILL BE DIRECTED TO LANDSCAPED AREAS DEPRESSED TO THE MAXIMUM EXTENT POSSIBLE TO RETAIN 670 CF OF THE 1020 CF OF REQUIRED FOR THE 80TH PERCENTILE FIRST FLUSH FOR WATER QUALITY AND ROOF DRAINAGE WILL BE PIPED TO A DIRECT STORM DRAIN CONNECTION BUT WILL FIRST BE ROUTED THROUGH A STORM WATER QUALITY MANHOLE TO TREAT FIRST FLUSH.

AS DEMONSTRATED BY THE STREET HYDRAULIC, STORM DRAIN AND INLET CALCULATIONS AND ANALYSIS CONTAINED WITHIN THE DRAINAGE REPORTS FOR LOS VIGILS AND VINEYARD COURT ESTATES, THE HOLLY STORM DRAIN AND STREET IS DESIGNED TO ACCEPT THE FREE DISCHARGE OF FULLY DEVELOPED RUNOFF FROM THE PROPERTIES FRONTING ON HOLLY, INCLUDING THIS SITE. ALL IMPROVEMENTS PROPOSED HEREIN ARE CONSISTENT WITH THE PREVIOUSLY APPROVED DEVELOPMENT PLANS FOR THIS SECTION OF HOLLY.

VI. GRADING PLAN

THE GRADING PLAN SHOWS: 1) EXISTING GRADES INDICATED BY SPOT ELEVATIONS AND CONTOURS AT 1 FT INTERVALS FROM THE HMCG TOPO SURVEY DATED 01/10/2017 & 05/16/2017, 2) PROPOSED GRADES INDICATED BY FINISHED FLOOR ELEVATIONS, SPOT ELEVATIONS, AND CONTOURS AT 1 FT INTERVALS, 3) THE LIMIT AND CHARACTER OF THE EXISTING IMPROVEMENTS, 4) THE LIMIT AND CHARACTER OF THE PROPOSED IMPROVEMENTS, AND 5) CONTINUITY BETWEEN EXISTING AND PROPOSED GRADES.

VII. CALCULATIONS

THE CALCULATIONS, REPRODUCED FORM THE APPROVED CONCEPTUAL GRADING PLAN AND WHICH APPEAR HEREON, ANALYZE BOTH THE EXISTING AND DEVELOPED CONDITIONS FOR THE 100-YEAR, 6-HOUR RAINFALL EVENT. THE PROCEDURE FOR 40-ACRE AND SMALLER BASINS, AS SET FORTH IN THE REVISION OF SECTION 22.2, HYDROLOGY OF THE DEVELOPMENT PROCESS MANUAL, VOLUME 2, DESIGN CRITERIA, DATED JANUARY, 1993, HAS BEEN USED TO QUANTIFY THE PEAK RATE OF DISCHARGE AND VOLUME OF RUNOFF GENERATED. AS DEMONSTRATED BY THE LOMR AND APPROVED DRAINAGE REPORTS PREPARED BY THIS OFFICE TO SUPPORT THE CONSTRUCTED AMAFCA NDBA PROJECT AND FOR LOS VIGILS, VINEYARD COURT ESTATES, AND THE DESERT RIDGE OFFICE PARK PROJECT (SEE REFERENCES), THE PUBLIC STORM DRAIN IN HOLLY IS SIZED FOR FREE DISCHARGE OF FULLY DEVELOPED RUNOFF FROM THIS SITE.

IX. CONCLUSION

1) THE PROPOSED SITE IMPROVEMENTS AND DRAINAGE CONCEPT ARE CONSISTENT WITH THE DEVELOPMENT CRITERIA ESTABLISHED BY PREVIOUSLY APPROVED PLANS FOR NDBA DEVELOPMENT AND THIS SPECIFIC PROJECT. 2) DEVELOPED RUNOFF FROM THIS SITE WILL DRAIN FREELY TO PERMANENT PUBLIC HOLLY PAVING AND STORM DRAINAGE IMPROVEMENTS, WHICH WERE CONSTRUCTED FOR LOS VIGILS AND VINEYARD COURT ESTATES. 3) THERE ARE NO DPM DESIGN VARIANCES, DRAINAGE EASEMENTS OR DRAINAGE COVENANTS ANTICIPATED AT THIS TIME.

CALCULATIONS

I. SITE CHARACTERISTICS

A. PRECIPITATION ZONE = 3
B. $P_{0.100} = P_{300} = 2.60$

C. TOTAL PROJECT AREA (A_T) = 108,525 SF
2.49 AC

D. LAND TREATMENTS

1. EXISTING LAND TREATMENT

a. BASIN A	AREA (SF/AC)	
Total Area	57,025	1.31 %
Treatment A Area		
Treatment B Area		
Treatment C Area	42,769	0.98 75
Treatment D Area	14,256	0.33 25

b. BASIN B	AREA (SF/AC)	
Total Area	51,500	1.18 %
Treatment A Area		
Treatment B Area	5,150	0.12 10
Treatment C Area	5,150	0.12 10
Treatment D Area	41,200	0.95 80

2. DEVELOPED LAND TREATMENT

a. BASIN A	AREA (SF/AC)	
Total Area	57,025	1.31 %
Treatment A Area		
Treatment B Area		
Treatment C Area	5,703	0.13 10
Treatment D Area	51,323	1.18 90

b. BASIN B	AREA (SF/AC)	
Total Area	51,500	1.18 %
Treatment A Area		
Treatment B Area		
Treatment C Area	15,450	0.35 30
Treatment D Area	36,050	0.83 70

II. HYDROLOGY

A. EXISTING CONDITION

1. BASIN A

a. VOLUME

$$E_w = (E_A A_A + E_B A_B + E_C A_C + E_D A_D) / A_T$$
$$E_w = ((0.00*0.66) + (0.00*0.92) + (0.98*1.29) + (0.33*2.36)) / 1.31 = 1.56 \text{ IN}$$
$$V_{100} = (E_w / 12) A_T = (1.56 / 12) 1.31 = 0.1703 \text{ AC-FT} = 7,420 \text{ CF}$$

b. PEAK DISCHARGE

$$Q_p = Q_{pA} A_A + Q_{pB} A_B + Q_{pC} A_C + Q_{pD} A_D$$
$$Q_p = Q_{100} = ((0.00*1.87) + (0.00*2.6) + (0.98*3.45) + (0.33*5.02)) = 5.0 \text{ CFS}$$

2. BASIN B

a. VOLUME

$$E_w = (E_A A_A + E_B A_B + E_C A_C + E_D A_D) / A_T$$
$$E_w = ((0.00*0.66) + (0.12*0.92) + (0.12*1.29) + (0.95*2.36)) / 1.18 = 2.11 \text{ IN}$$
$$V_{100} = (E_w / 12) A_T = (2.11 / 12) 1.18 = 0.2075 \text{ AC-FT} = 9,040 \text{ CF}$$

b. PEAK DISCHARGE

$$Q_p = Q_{pA} A_A + Q_{pB} A_B + Q_{pC} A_C + Q_{pD} A_D$$
$$Q_p = Q_{100} = ((0.00*1.87) + (0.12*2.6) + (0.12*3.45) + (0.95*5.02)) = 5.5 \text{ CFS}$$

B. DEVELOPED CONDITION

1. BASIN A

a. VOLUME

$$E_w = (E_A A_A + E_B A_B + E_C A_C + E_D A_D) / A_T$$
$$E_w = ((0.00*0.66) + (0.00*0.92) + (0.13*1.29) + (1.18*2.36)) / 1.31 = 2.25 \text{ IN}$$
$$V_{100} = (E_w / 12) A_T = (2.25 / 12) 1.31 = 0.2456 \text{ AC-FT} = 10,700 \text{ CF}$$

b. PEAK DISCHARGE

$$Q_p = Q_{pA} A_A + Q_{pB} A_B + Q_{pC} A_C + Q_{pD} A_D$$
$$Q_p = Q_{100} = ((0.00*1.87) + (0.00*2.6) + (0.13*3.45) + (1.18*5.02)) = 6.4 \text{ CFS}$$

2. BASIN B

a. VOLUME

$$E_w = (E_A A_A + E_B A_B + E_C A_C + E_D A_D) / A_T$$
$$E_w = ((0.00*0.66) + (0.00*0.92) + (0.35*1.29) + (0.83*2.36)) / 1.18 = 2.04 \text{ IN}$$
$$V_{100} = (E_w / 12) A_T = (2.04 / 12) 1.18 = 0.2006 \text{ AC-FT} = 8,740 \text{ CF}$$

b. PEAK DISCHARGE

$$Q_p = Q_{pA} A_A + Q_{pB} A_B + Q_{pC} A_C + Q_{pD} A_D$$
$$Q_p = Q_{100} = ((0.00*1.87) + (0.00*2.6) + (0.35*3.45) + (0.83*5.02)) = 5.4 \text{ CFS}$$

C. COMPARISON

1. BASIN A

a. VOLUME

$$\Delta V_{100} = 10,700 - 7,420 = 3280.00 \text{ CF}$$
$$\Delta Q_{100} = 6.4 - 5.0 = 1.40 \text{ CFS}$$

b. PEAK DISCHARGE

$$\Delta Q_{100} = 6.4 - 5.0 = 1.40 \text{ CFS}$$
$$\Delta Q_{100} = 6.4 - 5.0 = 1.40 \text{ CFS}$$

2. BASIN B

a. VOLUME

$$\Delta V_{100} = 8,740 - 9,040 = -300.00 \text{ CF}$$
$$\Delta Q_{100} = 5.4 - 5.5 = -0.10 \text{ CFS}$$

b. PEAK DISCHARGE

$$\Delta Q_{100} = 5.4 - 5.5 = -0.10 \text{ CFS}$$
$$\Delta Q_{100} = 5.4 - 5.5 = -0.10 \text{ CFS}$$

D. FIRST FLUSH CALCULATIONS

1. BASIN A RETENTION REQUIREMENT

a. VOLUME

$$V_{REQ} = ((P_{FF} - I_A) / 12) A_D$$
$$V_{REQ} = ((0.26 - 0.10) / 12) (40262.5) = 540 \text{ CF}$$

2. BASIN B RETENTION REQUIREMENT

$$V_{REQ} = ((P_{FF} - I_A) / 12) A_D$$
$$V_{REQ} = ((0.26 - 0.10) / 12) (36050.00) = 480 \text{ CF}$$

3. WATER QUALITY PONDING PROVIDED ONSITE (BASED ON AVERAGE END AREA METHOD)

$$BASIN A V_{CAP} = 565 \text{ CF}$$

$$BASIN B V_{CAP} = 105 \text{ CF}$$

E. BASIN A RUNDOWN OVERFLOW CALCULATIONS

$$Q_{REQ} = 6.4 \text{ CFS}$$
$$Q_{CAP} = C^* L^* H^{3/2}$$
$$C = 3.0, L = 4 \text{ FT}, H = 0.67 \text{ FT (8" CURB)}$$
$$Q_{CAP} = 3.0 * 4 * 0.67^{3/2}$$
$$Q_{CAP} = 6.58 \text{ CFS} > Q_{REQ} = 6.4 \text{ CFS}$$

LEGEND

AC	ASPHALT CURB	FL	FLOWLINE
AL	AREA LIGHT	INV	INVERT
BBC	BRICK BUILDING COLUMN	MC	MOTORCYCLE SPACES
BCSW	BURIED CONCRETE SIDEWALK	TA	TOP OF ASPHALT PAVEMENT
BTM	BOTTOM	TC	TOP OF CURB
C&G	CURBS AND CUTTER	TG	TOP OF GRATE
CF	LANDSCAPING CRUSHER FINES	+ 95.05	EXISTING SPOT ELEVATION
CM	POURED CONCRETE MOUND	89.00	PROPOSED SPOT ELEVATION
CMU	CONCRETE MASONRY UNIT WALL	...	EXISTING FLOWLINE
CND	ELECTRIC CONDUIT	...	PROPOSED FLOWLINE
CNC	CONCRETE	-5590-	EXISTING CONTOUR
CRW	CMU RETAINING WALL	-92-	PROPOSED CONTOUR
CSW	CONCRETE SIDEWALK	←	EXISTING DIRECTION OF FLOW
DYS	PAINTED DOUBLE YELLOW TRAFFIC STRIPE	←	PROPOSED DIRECTION OF FLOW
E/PM	ELECTRIC LINE BY PAINT MARK	---	RIGHT OF WAY LINE
EM	EDGE OF ASPHALT	---	PUBLIC EASEMENT LINE
EA	ELECTRIC METER	↑ ↓	HIGH POINT / DIVIDE
EO	ELECTRIC OUTLET	○	EXISTING STORM DRAIN MANHOLE
FH	FIRE HYDRANT	●	EXISTING FIRE HYDRANT
FL	FLOWLINE	○	EXISTING SANITARY SEWER MAN HOLE
G/PM	GAS LINE BY PAINT MARK	○	SANITARY SEWER MAN HOLE
GA	GATE	×	EXISTING VALVE BOX
GRV	LANDSCAPING GRAVEL	×	PROPOSED VALVE BOX
GTS	GATE STOP POST	---	EXISTING DOUBLE CLEANOUT
GW	GUY WIRE ANCHOR	---	PROPOSED DOUBLE CLEANOUT
GWAP	GUY WIRE ANCHOR POLE	---	EXISTING SINGLE CLEANOUT
INV	PIPE INVERT	---	PROPOSED SINGLE CLEANOUT
IVB	IRRIGATION VALVE BOX	---	EXISTING WATER SERVICE
KSW	KEYSTONE WALL	---	PROPOSED WATER SERVICE
LS	LANDSCAPING IMPROVEMENTS	---	EXISTING WATER LINE
LSD	LANDSCAPING DIVIDER	---	PROPOSED WATER LINE
MED	MEDIAN	---	EXISTING SANITARY SEWER LINE
MH	MANHOLE	---	PROPOSED SANITARY SEWER LINE
MLP	METAL LIGHT POLE	---	EXISTING FIRE LINE
OHC(1)	OVERHEAD COMMUNICATION (# OF LINES)	---	PROPOSED FIRE LINE
OHE(1)	OVERHEAD ELECTRIC (3 OF LINES)	---	EXISTING POST INDICATOR VALVE
OHO(2)	OVERHEAD GUY WIRE (# OF LINES)	---	PROPOSED POST INDICATOR VALVE
PG	PIPE GATE	---	LOT LINE
PS	PAINTED PARKING STALL STRIPE	---	PROPOSED BASIN BOUNDARY
PVC	POLYVINYL CHLORIDE PIPE	---	PROPOSED CONCRETE
RF	REINFORCED CONCRETE PIPE	---	PROPOSED ASPHALT PAVING
ROO	ROOF OVERHANG	---	
RR	LANDSCAPING RIVER ROCK	---	
RRT	LANDSCAPING RAILROAD TIES	---	
SAS	SANITARY SEWER	---	
SAS/PM	SANITARY SEWER BY PAINT MARK	---	
SB	PAINTED TRAFFIC STOP BAR	---	
SD/PM	STORM DRAIN BY PAINT MARK	---	
SDI	STORM DRAIN INLET	---	
SDMH	STORM DRAIN MANHOLE	---	
SOP	SERVICE DROP POLE	---	
SF	SILT FENCE (IN POOR CONDITION)	---	
SGN	CMU SIGN	---	
SLGT	SLIDING GATE	---	
SLP	STEEL POLE	---	
SP	SEPTIC TANK COVER	---	
STC	STONE SIGN ON STUCCO WALL	---	
STW	STUCCO WALL	---	
SWS	PAINTED SOLID WHITE TRAFFIC STRIPE	---	
SYD	PAINTED SOLID YELLOW TRAFFIC STRIPE	---	
TA	TOP OF ASPHALT	---	
TC	TOP OF CURB	---	
TCO	TOP OF CONCRETE	---	
TG	TOP OF GRATE	---	
TW	TOP OF WALL	---	
TYP	TYPICAL	---	
UPT	POSSIBLE UNDERGROUND PROPANE TANK	---	
VG	CONCRETE VALLEY GUTTER	---	
W/PM	WATER LINE BY PAINT MARK	---	
WCR	CONCRETE WHEELCHAIR RAMP	---	
WLF	WOOD LIGHT POLE	---	
WLP	WOOD METER BOX	---	
WPP	WOOD POWER POLE	---	
WVB	WATER VALVE BOX	---	
WVC	WOOD VALVE BOX	---	
XC	EXTRUDED CONCRETE CURB	---	
1.0" Ø	TREE TRUNK DIAMETER	---	

CONIFEROUS TREE

SMALL CONIFEROUS TREE

DECIDUOUS TREE

SMALL DECIDUOUS TREE

SHRUB

SMALL SHRUB


YUCCA

LANDSCAPING BOULDER

PAINTED UTILITY LINE MARK

INDEX OF DRAWINGS

SHEET	DESCRIPTION
C-100	DRAINAGE PLAN, CALCULATIONS, VICINITY MAP, LEGEND AND INDEX OF DRAWINGS
C003	PREVIOUSLY CERTIFIED GRADING PLAN (FOR INFORMATION ONLY)
CG-101	GRADING AND DRAINAGE PLAN
CU-101	WATER AND SANITARY SEWER PLAN
CP-501	PAVING SECTIONS AND DETAILS
CU-501	WATER AND SANITARY SECTIONS AND DETAILS
ESC-101	EROSION AND SEDIMENT CONTROL PLAN
ESC-102	EROSION AND SEDIMENT CONTROL NOTES AND DETAILS

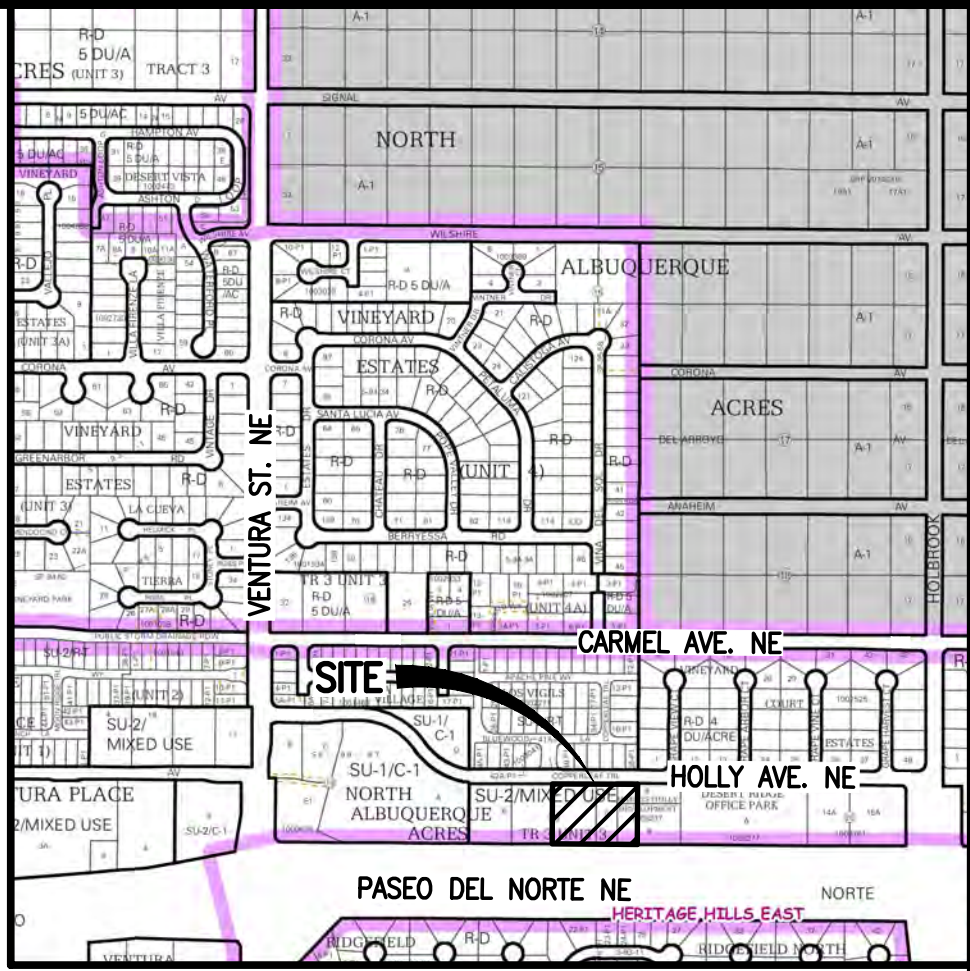

VICINITY MAP C-20
SCALE: 1" = 500'



F.I.R.M. 141 OF 825
SCALE: 1" = 500'

LEGAL DESCRIPTION

TRACT A-1, HOLLY MARK3S DEVELOPMENT FILED 12/18/2017 (2017C-0146)

TEMPORARY BENCHMARK #1 (T.B.M.)

A #5 REBAR W/CAP STAMPED "HMCG CONTROL NMP5 11184" SET IN DIRT, NEAR THE NORTHWEST CORNER OF LOT 7 IN THE NORTHWEST PORTION OF THE SITE, NOT SHOWN. ELEVATION = 5578.05 FEET (NAVD 88)

TEMPORARY BENCHMARK #2 (T.B.M.)

THIS IS NOT A BOUNDARY SURVEY; DATA IS SHOWN FOR ORIENTATION ONLY. THE BOUNDARY INFORMATION DEPICTED BY THIS PLAN IS BASED UPON THE BOUNDARY SURVEY PREPARED BY JMA, NMPS NO. 11184, DATED 10/24/2006. TOPOGRAPHIC SURVEY INFORMATION IS BASED UPON A TOPOGRAPHIC SURVEY PREPARED BY JMA, ON 10/24/2006, NMPS NO.11184.



JEFF MORTENSEN & ASSOCIATES, INC.
600-B MIDWAY PARK BLVD. N.E.
ALBUQUERQUE, N.M. 87109
ENGINEERS & SURVEYORS (505) 345-4250
FAX: 505 345-4254 (ESTABLISHED 1977)

GRADING PLAN (FOR INFORMATION ONLY) MARK 3S HOLLY DEVELOPMENT

LEGEND (EXISTING)

ASPH	ASPHALT
B	BOULDER
C	COMMUNICATION
C&G	CURB AND GUTTER
CMU	CONCRETE MASONRY UNIT
CO	SANITARY SEWER CLEANOUT
CONC	CONCRETE
EA	EDGE OF ASPHALT
ET	ELECTRIC TRANSFORMER
FH	FIRE HYDRANT
FL	FLOWLINE
INV	INVERT ELEVATION
MH	MANHOLE
OHE(1)	OVERHEAD ELECTRIC (# OF LINES)
PVC	POLYVINYL CHLORIDE
RCP	REINFORCED CONCRETE PIPE
SAS	SANITARY SEWER
SD	STORM DRAIN
SI	STORM INLET
STD	STANDARD
TA	TOP OF ASPHALT
TC	TOP OF CURB
TCO	TOP OF CONCRETE
TG	TOP OF GRATE
TR	TELEPHONE RISER
WL	WATERLINE
WPP	WOOD POWER POLE
WS	WOOD SIGN
*	DECIDUOUS TREE
*	SHRUB
*	UTILITY MARKER

LEGEND (PROPOSED)

	PROPOSE SPOT ELEVATION
	DIRECTION OF FLOW
	FLOWLINE
	HANDICAPPED PARKING
	MOTORCYCLE PARKING
	PROPOSED CONCRETE
	PROPOSED ASPHALT PAVING
	PROPOSED RETAINING WALL
	ROOF DRAIN

RECORD INFORMATION


- 4.78 RECORD INFORMATION
- RECORD INFORMATION = AS-DESIGNED
- 28-66 RECORD INFORMATION
- 9.16 RECORD INFORMATION

BOUNDARY TABLES

LINE	DIRECTION	DISTANCE
L1	S 00°06'45" W	236.26'
L2	N 89°38'16" W	165.00'
L3	S 00°06'45" W	234.14'
L4	S 89°39'42" E	165.00'
L5	N 89°38'16" W	82.50'
L6	N 00°06'45" E	236.16'
L7	S 89°39'42" E	82.50'

KEYED NOTES

- HOLLY AVENUE N.E. IMPROVEMENTS TO BE CONSTRUCTED BY CITY WORK ORDER
- CONSTRUCT 12" SIDEWALK CULVERT PER COA STD DWG 2236
- INSTALL COMBINATION WYE/BEND W/ CLEANOUT TO GRADE INV 91.13
- 24" SIDEWALK CULVERT BY CITY WORK ORDER
- CONNECTION TO STORM INLET STUB, INV 86.75
- INSTALL 8" HDPE (SMOOTH INTERIOR) STORM DRAIN @ S = 0.02 (2%) SIZE 8" OR 10" AS NOTED
- INSTALL 8" HDPE WYE W/ CLEANOUT, INV 90.00
- INSTALL 8" HDPE BEND/WYE W/ CLEANOUT TO GRADE, WITH 8"x10" SIZE INCREASE INV 92.50
- INSTALL 8" WYE, CONNECT TO ROOF DRAIN
- INSTALL HDPE (SMOOTH INTERIOR) STORM DRAIN @ S = 0.0300 (3%), SIZE 8" OR 10" AS NOTED
- INSTALL CLEANOUT TO GRADE
- INSTALL 8" HDPE (SMOOTH INTERIOR) STORM DRAIN @ S = 0.0100 (1%)

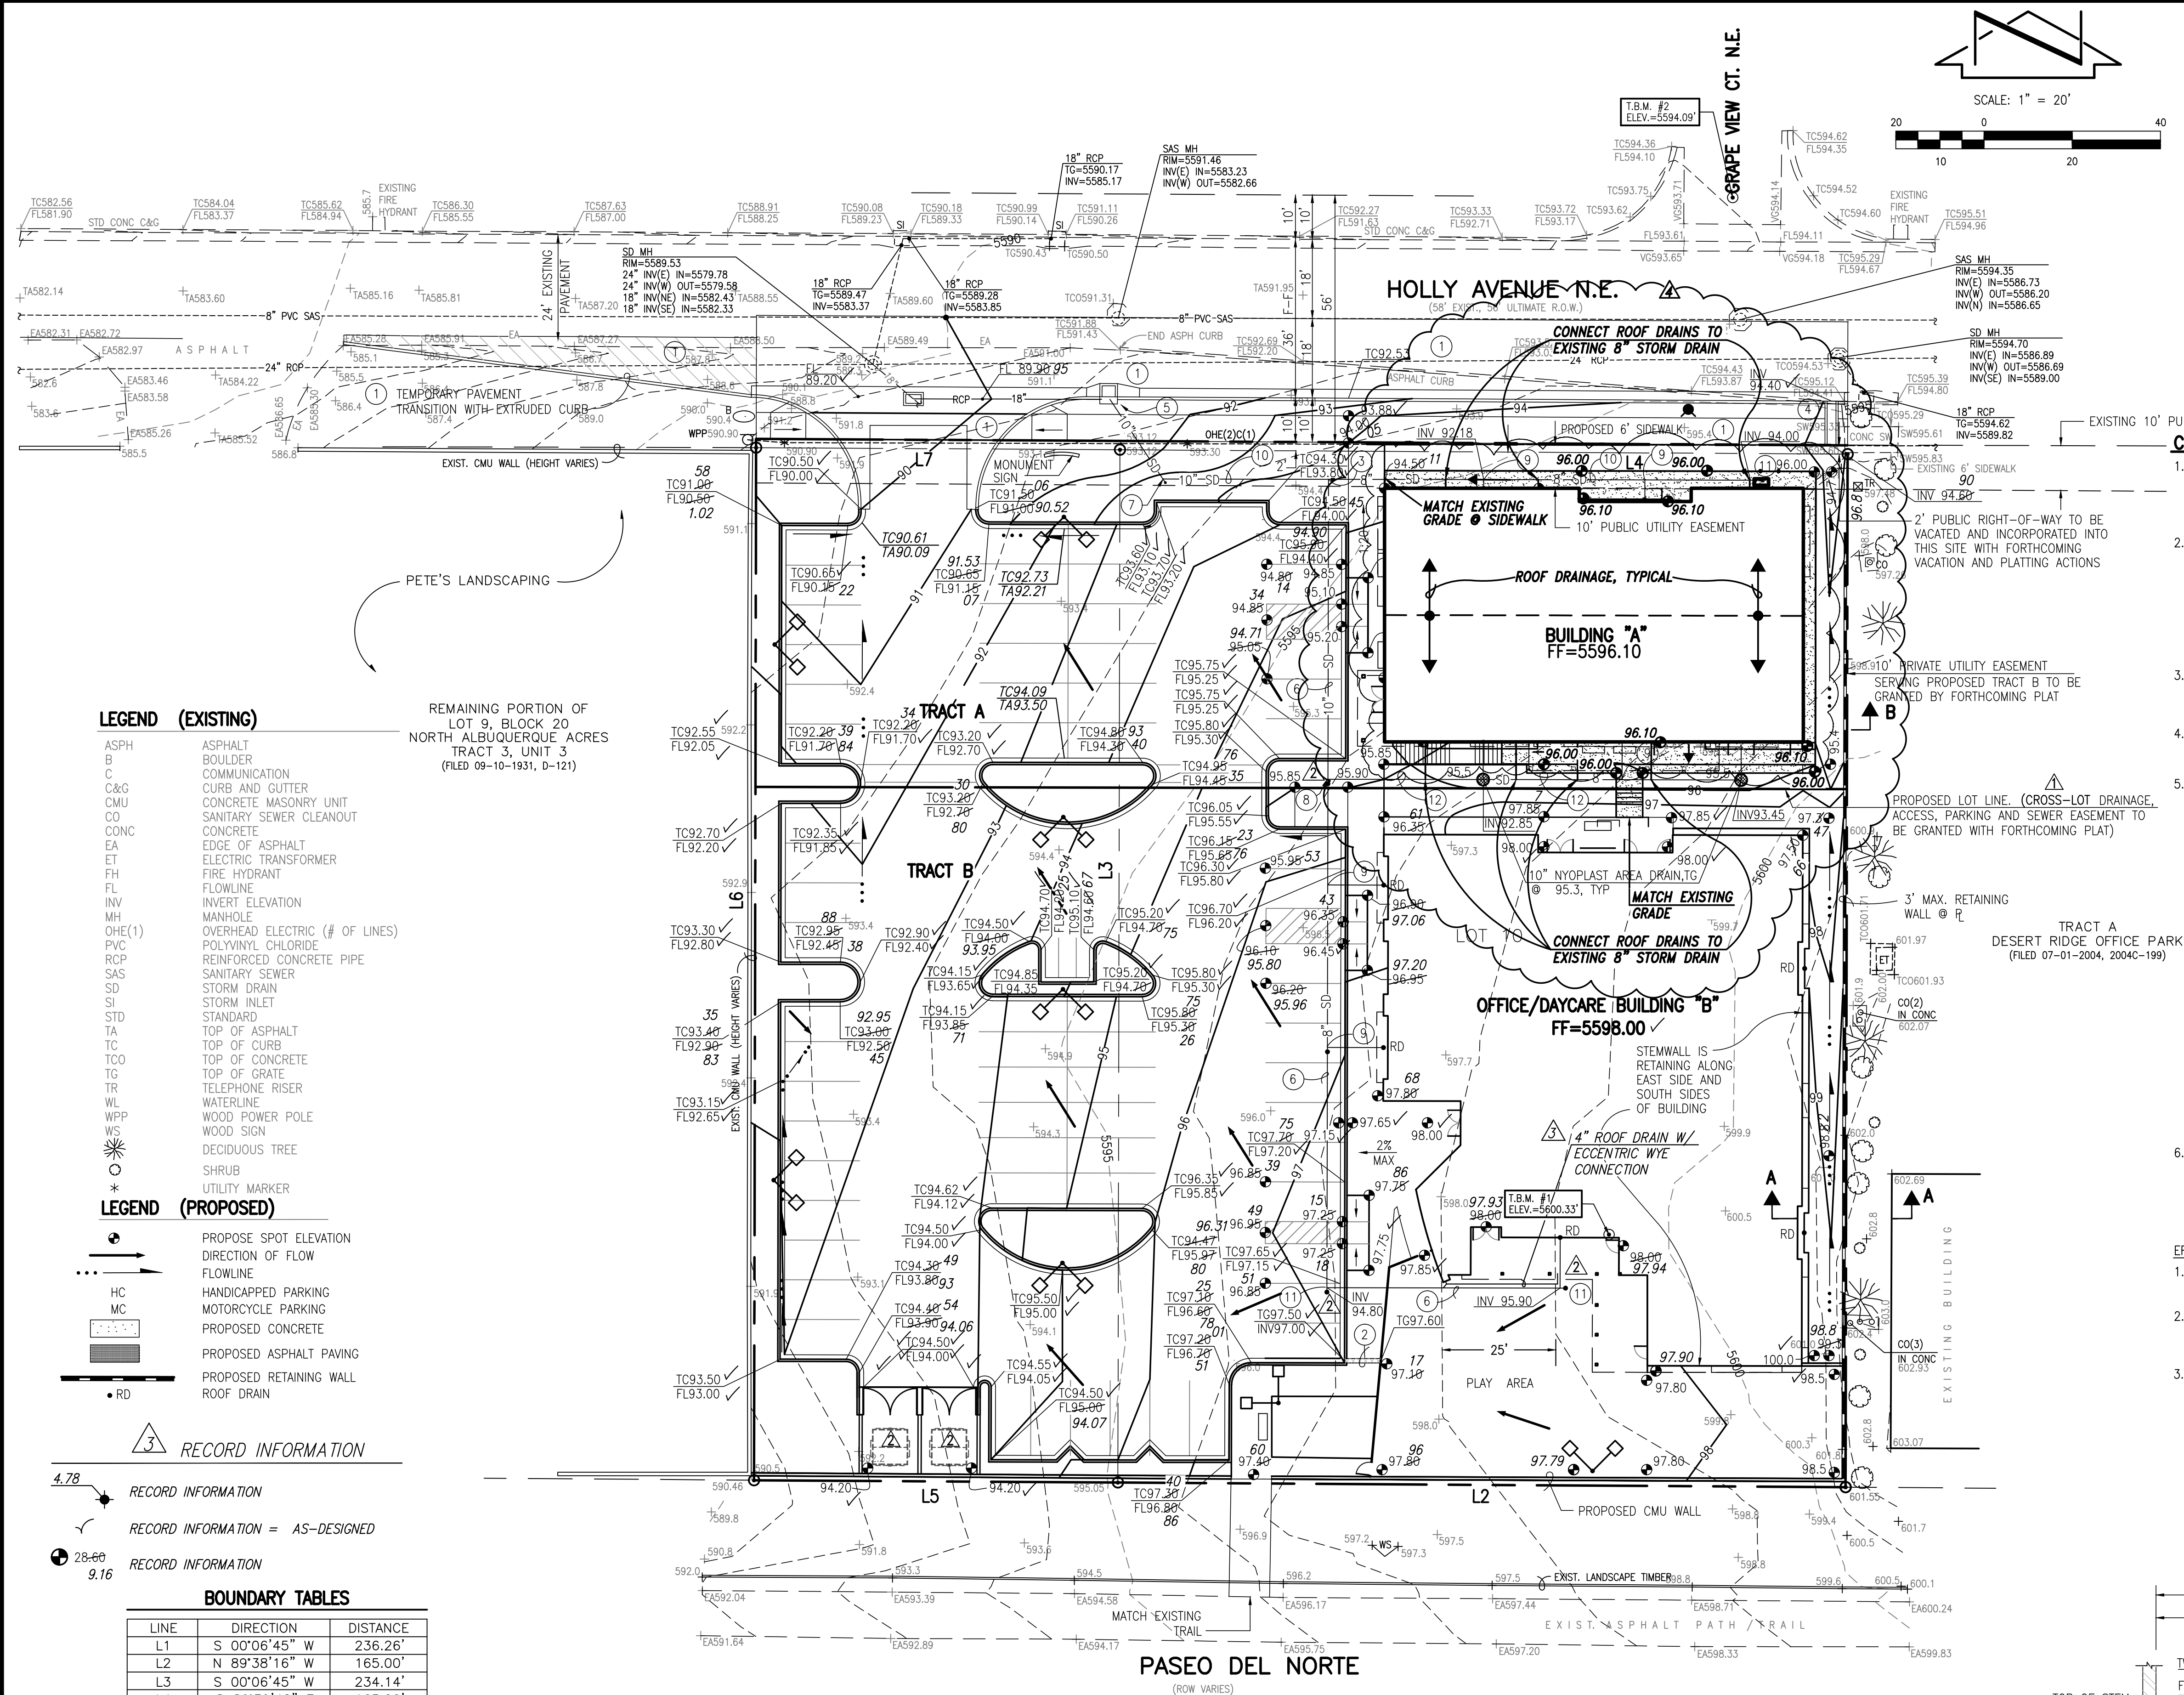

LEGAL DESCRIPTION:

LOT 10 AND THE EAST HALF OF LOT 9, BLOCK 20, NORTH ALBUQUERQUE ACRES, TRACT 3, UNIT 3, ALBUQUERQUE, NEW MEXICO, AS THE SAME IS SHOWN AND DESIGNATED ON THE PLAT FILED IN THE OFFICE OF THE COUNTY CLERK OF BERNALILLO COUNTY, NEW MEXICO ON SEPTEMBER 10, 1931, BOOK D, PAGE 121.

PROJECT BENCHMARK

STANDARD ACS BRASS TABLET STAMPED, "1-B20", SET IN TOP OF A CONCRETE POST, AT THE NORTHEAST INTERSECTION OF BARSTOW STREET AND MODESTO AVENUE. ELEVATION = 5474.51 FEET (NGVD 1929)

T.B.M. #1

REBAR #5 WITH CAP STAMPED, "JMA CONTROL NMPS 11184", AS SHOWN ON THIS SHEET. ELEVATION = 5600.33 FEET (NGVD 1929)

T.B.M. #2


ALUMINUM CAP STAMPED, "PLS #11184", AS SHOWN ON THIS SHEET. ELEVATION = 5594.09 FEET (NGVD 1929)

CONSTRUCTION NOTES:

- TWO (2) WORKING DAYS PRIOR TO ANY EXCAVATION, CONTRACTOR MUST CONTACT NEW MEXICO ONE CALL SYSTEM 260-1990 (ALBUQUERQUE AREA), 1-800-321-ALERT(2537) (STATEWIDE), FOR LOCATION OF EXISTING UTILITIES.
- PRIOR TO CONSTRUCTION, THE CONTRACTOR SHALL EXCAVATE AND VERIFY THE HORIZONTAL AND VERTICAL LOCATION OF ALL POTENTIAL OBSTRUCTIONS. SHOULD A CONFLICT EXIST, THE CONTRACTOR SHALL NOTIFY THE ENGINEER IN WRITING SO THAT THE CONFLICT CAN BE RESOLVED WITH A MINIMUM AMOUNT OF DELAY. THE CONTRACTOR SHALL BE RESPONSIBLE FOR ALL INTERPRETATIONS IT MAKES WITHOUT FIRST CONTACTING THE ENGINEER AS REQUIRED ABOVE.
- ALL WORK ON THIS PROJECT SHALL BE PERFORMED IN ACCORDANCE WITH APPLICABLE FEDERAL, STATE AND LOCAL LAWS, RULES AND REGULATIONS CONCERNING CONSTRUCTION SAFETY AND HEALTH.
- ALL CONSTRUCTION WITHIN PUBLIC RIGHT-OF-WAY SHALL BE PERFORMED IN ACCORDANCE WITH APPLICABLE CITY OF ALBUQUERQUE STANDARDS AND PROCEDURES.
- IF ANY UTILITY LINES, PIPELINES, OR UNDERGROUND UTILITY LINES ARE SHOWN ON THESE DRAWINGS, THEY ARE SHOWN IN AN APPROXIMATE MANNER ONLY, AND SUCH LINES MAY EXIST WHERE NONE ARE SHOWN. IF ANY SUCH EXISTING LINES ARE SHOWN, THE LOCATION IS BASED UPON INFORMATION PROVIDED BY THE OWNER OF SAID UTILITY, AND THE INFORMATION MAY BE INCOMPLETE, OR MAY BE OBSOLETE BY THE TIME CONSTRUCTION COMMENCES. THE ENGINEER HAS CONDUCTED ONLY PRELIMINARY INVESTIGATION OF THE LOCATION, DEPTH, SIZE, OR TYPE OF EXISTING UTILITY LINES, PIPELINES, OR UNDERGROUND UTILITY LINES. THIS INVESTIGATION IS NOT CONCLUSIVE, AND MAY NOT BE COMPLETE, THEREFORE, MAKES NO REPRESENTATION PERTAINING THERETO, AND ASSUMES NO RESPONSIBILITY OR LIABILITY THEREFOR. THE CONTRACTOR SHALL INFORM ITSELF OF THE LOCATION OF ANY UTILITY LINE, PIPELINE, OR UNDERGROUND UTILITY LINE IN OR NEAR THE AREA OF THE WORK IN ADVANCE OF AND DURING EXCAVATION WORK. THE CONTRACTOR IS FULLY RESPONSIBLE FOR ANY AND ALL DAMAGE CAUSED BY ITS FAILURE TO LOCATE, IDENTIFY AND PRESERVE ANY AND ALL EXISTING UTILITIES, PIPELINES, AND UNDERGROUND UTILITY LINES. IN PLANNING AND CONDUCTING EXCAVATION, THE CONTRACTOR SHALL COMPLY WITH STATE STATUTES, MUNICIPAL AND LOCAL ORDINANCES, RULES AND REGULATIONS, IF ANY, PERTAINING TO THE LOCATION OF THESE LINES AND FACILITIES.
- THE DESIGN OF PLANTERS AND LANDSCAPED AREAS IS NOT PART OF THIS PLAN. ALL PLANTERS AND LANDSCAPED AREAS ADJACENT TO THE BUILDING(S) SHALL BE PROVIDED WITH POSITIVE DRAINAGE TO AVOID ANY PONDING ADJACENT TO THE STRUCTURE. FOR CONSTRUCTION DETAILS, REFER TO LANDSCAPING PLAN.

EROSION CONTROL MEASURES:


- THE CONTRACTOR SHALL ENSURE THAT NO SOIL ERODES FROM THE SITE INTO PUBLIC RIGHT-OF-WAY OR ONTO PRIVATE PROPERTY.
- THE CONTRACTOR SHALL PROMPTLY CLEAN UP ANY MATERIAL EXCAVATED WITHIN THE PUBLIC RIGHT-OF-WAY SO THAT THE EXCAVATED MATERIAL IS NOT SUSCEPTIBLE TO BEING WASHED DOWN THE STREET.
- WHEN APPLICABLE, CONTRACTOR SHALL SECURE "TOPSOIL DISTURBANCE PERMIT" FROM THE CITY AND/OR FILE A NOTICE OF INTENT (N.O.I.) WITH THE EPA PRIOR TO BEGINNING CONSTRUCTION.

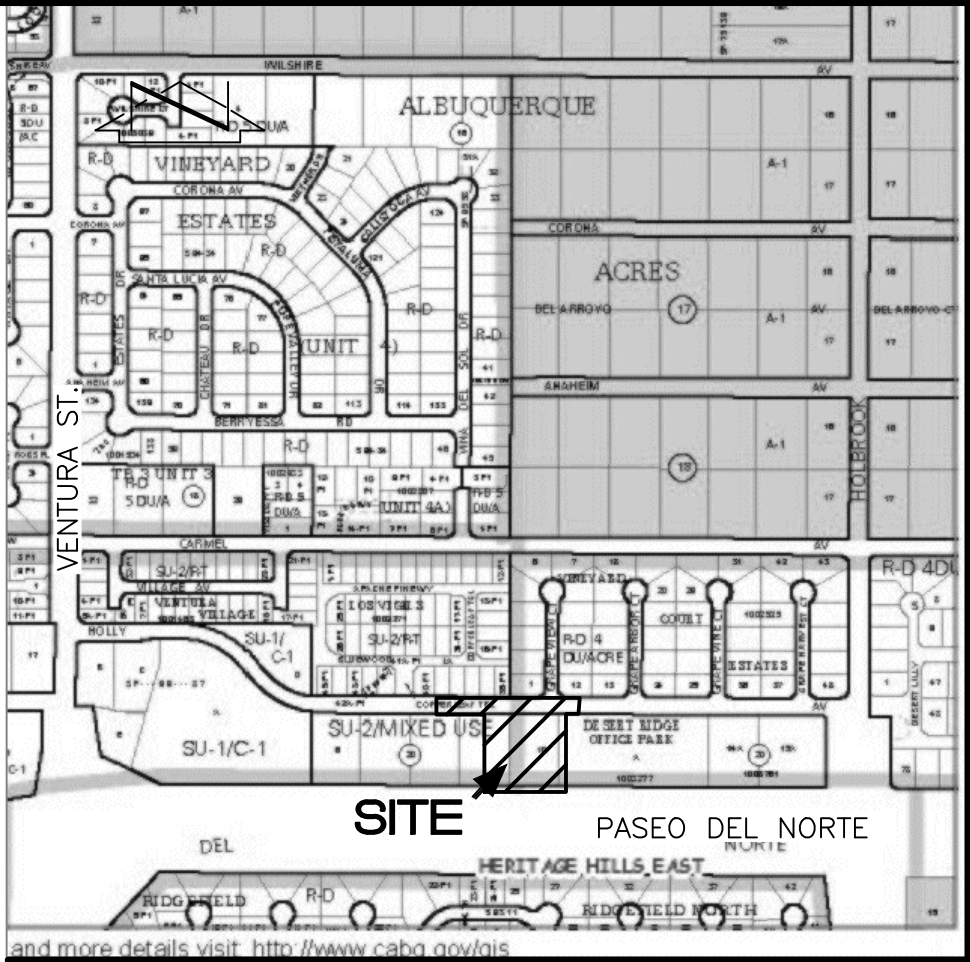

VICINITY MAP

SCALE: 1" = 750'

C-20

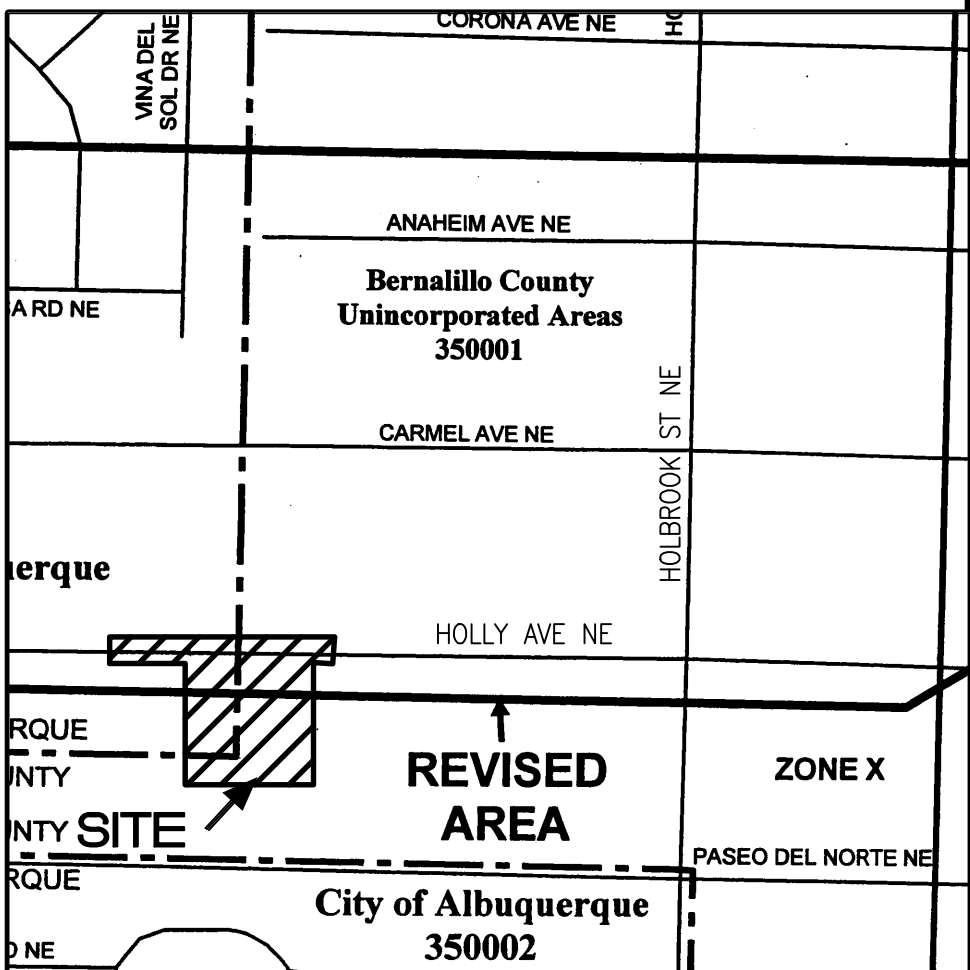


F.I.R.M.

SCALE: 1" = 500'


PANEL 142 OF 825

REVISED 3/23/2004

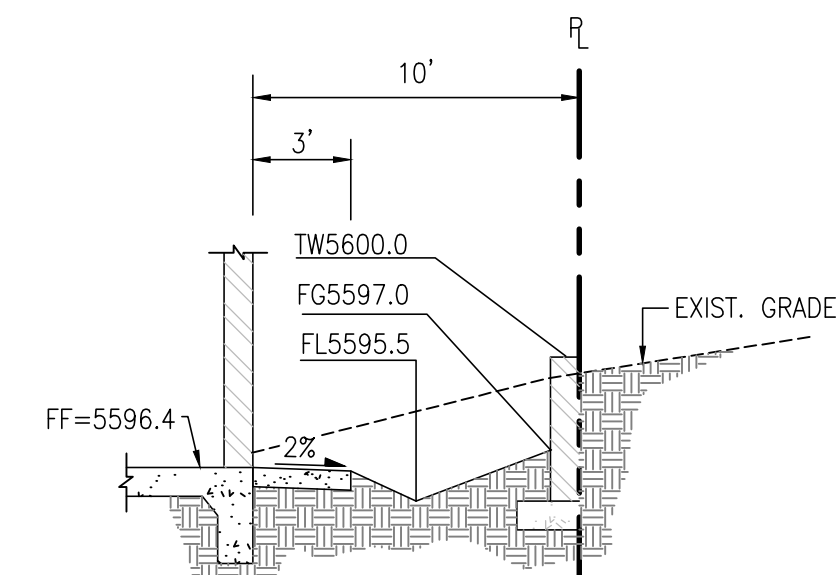

SECTION B-B

SCALE: 1" = 6'

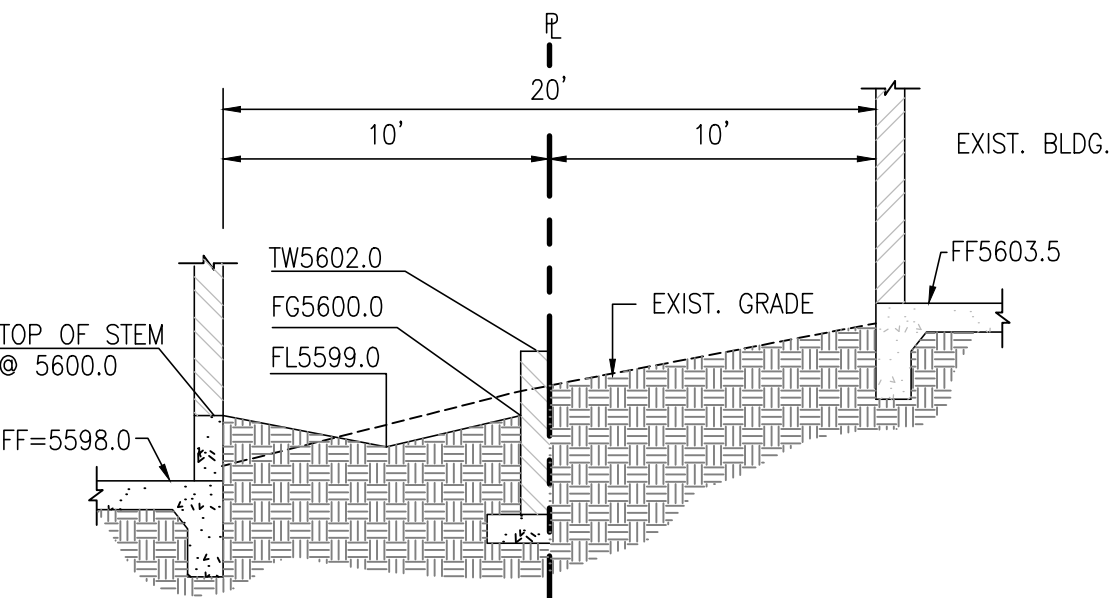

SECTION A-A


SCALE: 1" = 6'



02/05/07 10/05/07
03/28/07 5/11/2015

DESIGNED BY	NO.	DATE	BY	REVISIONS	JOB NO.
G.M.	1	01/07	G.M.	ADDRESS EPC COMMENTS, ADDED DETAIL FOR CONSTRUCTION	2015.0121g
J.Y.R.	2	03/07	G.M.	REVISE ROOF DRAIN, DELETE SEWER DRAINS	2006.0703
J.L.P.	3	10/07	G.M.	ENGINEER'S CERTIFICATION - BUILDING "B"	
G.M.	4	05/15	G.M.	BUILDING "A" CONSTRUCTION	
DRAWN BY					DATE
G.M.					10-2006
APPROVED BY					SHEET
G.M.					OF
					C003

COPPERLEAF
TRAIL N.E.

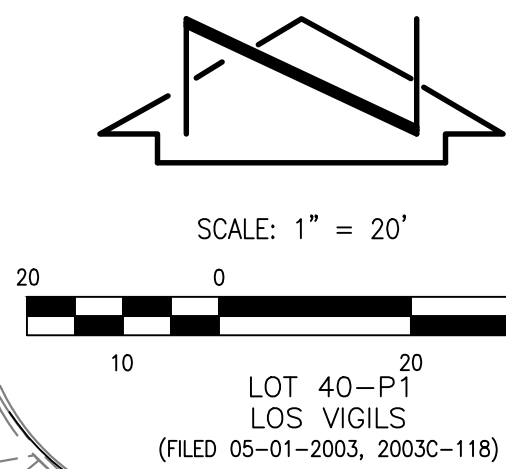

LOT 39-P1
LOS VIGILS
(FILED 05-01-2003, 2003C-118)

LOT 38-P1
LOS VIGILS
(FILED 05-01-2003, 2003C-118)

LOT 37-P1
LOS VIGILS
(FILED 05-01-2003, 2003C-118)

LOT 36-P1
LOS VIGILS
(FILED 05-01-2003, 2003C-118)

LOT 35-P1
LOS VIGILS
(FILED 05-01-2003, 2003C-118)

EXISTING INFORMATION FROM
REFERENCED SURVEY

EXISTING FROM
RECORD PLAN
(2006.070.9)



LO-
NEYARD CO
(FILED 11-14-20)

KEYED NOTES:

- HOLLY IMPROVEMENTS TO BE CONSTRUCTED BY CITY WORK ORDER.
- 2-24" SIDEWALK CULVERTS BY SEPARATE PERMIT (WORK ORDER).
- INSTALL 8" HDPE (SMOOTH INTERIOR) STORM DRAIN.
- INSTALL 12" HDPE (SMOOTH INTERIOR) STORM DRAIN.
- INSTALL WYE/BEND COMBINATION WITH CLEANOUT AND CONCRETE COLLAR TO GRADE.
- INSTALL DOUBLE CLEANOUT AT BUILDING CONNECTION REFER TO PLUMBING PLANS FOR CONTINUATION.
- DEPRESSED LANDSCAPING FOR WATER QUALITY.
- INSTALL PERFORATED PIPE WRAPPED WITH FILTER FABRIC.
- INSTALL 18" NYLOPLAST STORM INLET
- CONSTRUCT 12" CURB OPENING
- NEW STORM DRAIN MANHOLE BY SEPARATE PERMIT (WORK ORDER)
- REMOVE AND DISPOSE OF 12" PLUG; BEGIN NEW PRIVATE STORM DRAIN LINE.
- INSTALL 30" ADS NYLOPLAST STORM INLET WITH OIL/DEBRIS/WATER SEPARATOR (ENVIROHOOD OR APPROVED SUBSTITUTE)
- INSTALL CLEANOUT WITH CONCRETE COLLAR TO GRADE.
- CONSTRUCT 4'-6" RUNDOWN PER DETAIL, SHEET CP-501

CONSTRUCTION NOTES:

- TWO (2) WORKING DAYS PRIOR TO ANY EXCAVATION, CONTRACTOR MUST CONTACT NEW MEXICO ONE CALL SYSTEM, 811, FOR DESIGNATION (LINE-SPOTTING) OF EXISTING UTILITIES.
- PRIOR TO CONSTRUCTION, THE CONTRACTOR SHALL EXCAVATE AND VERIFY THE HORIZONTAL AND VERTICAL LOCATION OF ALL POTENTIAL OBSTRUCTIONS. SHOULD A CONFLICT EXIST, THE CONTRACTOR SHALL NOTIFY THE ENGINEER IN WRITING SO THAT THE CONFLICT CAN BE RESOLVED WITH A MINIMUM AMOUNT OF DELAY. THE CONTRACTOR SHALL BE RESPONSIBLE FOR ALL INTERPRETATIONS IT MAKES WITHOUT FIRST CONTACTING THE ENGINEER AS REQUIRED ABOVE.
- ALL WORK ON THIS PROJECT SHALL BE PERFORMED IN ACCORDANCE WITH APPLICABLE FEDERAL, STATE AND LOCAL LAWS, RULES AND REGULATIONS CONCERNING CONSTRUCTION SAFETY AND HEALTH.
- ALL CONSTRUCTION WITHIN PUBLIC RIGHT-OF-WAY SHALL BE PERFORMED IN ACCORDANCE WITH APPLICABLE CITY OF ALBUQUERQUE STANDARDS AND PROCEDURES.
- UTILITY INFORMATION SHOWN HEREON IS BASED UPON ONSITE SURFACE EVIDENCE, REVIEW OF AVAILABLE AERIALS AND CITY OF ALBUQUERQUE RECORD DRAWINGS AND DISTRIBUTION MAPS AND UTILITY LINE-SPOTS PROVIDED BY HIGH MESA CONSULTING GROUP (2016.059.1 AND 2016.059.2). IN ADDITION, UTILITY LINE-SPOTS WERE REQUESTED VIA THE NEW MEXICO ONE CALL SERVICE (TICKET NOS. 16DE20007 AND 17AP210205). UTILITY LINES THAT APPEAR ON THESE DRAWINGS ARE SHOWN IN AN APPROXIMATE MANNER ONLY, AND SUCH LINES MAY EXIST WHERE NONE ARE SHOWN. IF ANY SUCH EXISTING LINES ARE SHOWN, THE LOCATION IS BASED UPON INFORMATION PROVIDED BY THE OWNER OF SAID UTILITY, AND THE INFORMATION MAY BE INCOMPLETE, OR MAY BE OBSOLETE BY THE TIME CONSTRUCTION COMMENCES. THE ENGINEER HAS CONDUCTED ONLY PRELIMINARY INVESTIGATION OF THE LOCATION, DEPTH, SIZE, OR TYPE OF EXISTING UTILITY LINES, PIPELINES, OR UNDERGROUND UTILITY LINES. THIS INVESTIGATION IS NOT CONCLUSIVE, AND MAY NOT BE COMPLETE. THEREFORE, MAKES NO REPRESENTATION PERTAINING THERETO, AND ASSUMES NO RESPONSIBILITY OR LIABILITY THEREFOR. THE CONTRACTOR SHALL INFORM ITSELF OF THE LOCATION OF ANY UTILITY LINE, PIPELINE, OR UNDERGROUND UTILITY LINE IN OR NEAR THE AREA OF THE WORK IN ADVANCE OF AND DURING EXCAVATION WORK. THE CONTRACTOR IS FULLY RESPONSIBLE FOR ANY AND ALL DAMAGE CAUSED BY ITS FAILURE TO LOCATE, IDENTIFY AND PRESERVE ANY AND ALL EXISTING UTILITIES, PIPELINES, AND UNDERGROUND UTILITY LINES. IN PLANNING AND CONDUCTING EXCAVATION, THE CONTRACTOR SHALL COMPLY WITH STATE, MUNICIPAL AND LOCAL ORDINANCES, RULES AND REGULATIONS, IF ANY, PERTAINING TO THE LOCATION OF THESE LINES AND FACILITIES.
- THE DESIGN OF PLANTERS AND LANDSCAPED AREAS IS NOT PART OF THIS PLAN. ALL PLANTERS AND LANDSCAPED AREAS ADJACENT TO THE BUILDING(S) SHALL BE PROVIDED WITH POSITIVE DRAINAGE TO AVOID ANY PONDING ADJACENT TO THE STRUCTURE. FOR CONSTRUCTION DETAILS, REFER TO LANDSCAPING PLAN.
- THE GRADES INDICATED ON THIS PLAN ARE FINISHED GRADES UNLESS OTHERWISE INDICATED. THE CONTRACTOR SHALL BE RESPONSIBLE FOR LEAVING SUBGRADE AT ELEVATIONS THAT SHALL ACCOMMODATE PROPOSED IMPROVEMENTS AS INDICATED ON THE PLANS INCLUDING, BUT NOT LIMITED TO, SURFACE DRAINAGE STRUCTURES, PAVING AND LANDSCAPING SURFACING.
- AN EXCAVATION/CONSTRUCTION PERMIT WILL BE REQUIRED BEFORE BEGINNING ANY WORK WITHIN CITY RIGHT-OF-WAY. AN APPROVED COPY OF THESE PLANS MUST BE SUBMITTED AT THE TIME OF APPLICATION FOR THIS PERMIT.
- BACKFILL COMPACTION SHALL BE ACCORDING TO MAJOR LOCAL STREET USE.
- CONTRACTOR SHALL REFER TO GEOTECHNICAL REPORT FOR EARTHWORK REQUIREMENTS, AS APPLICABLE.

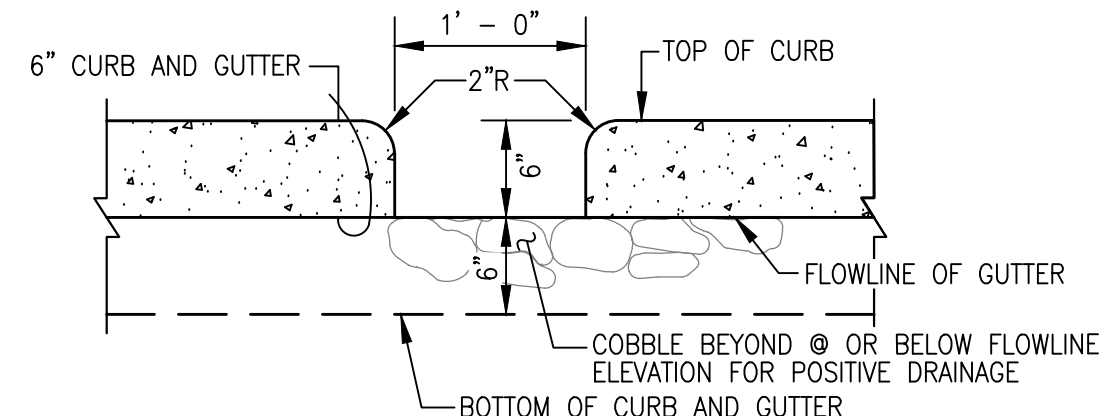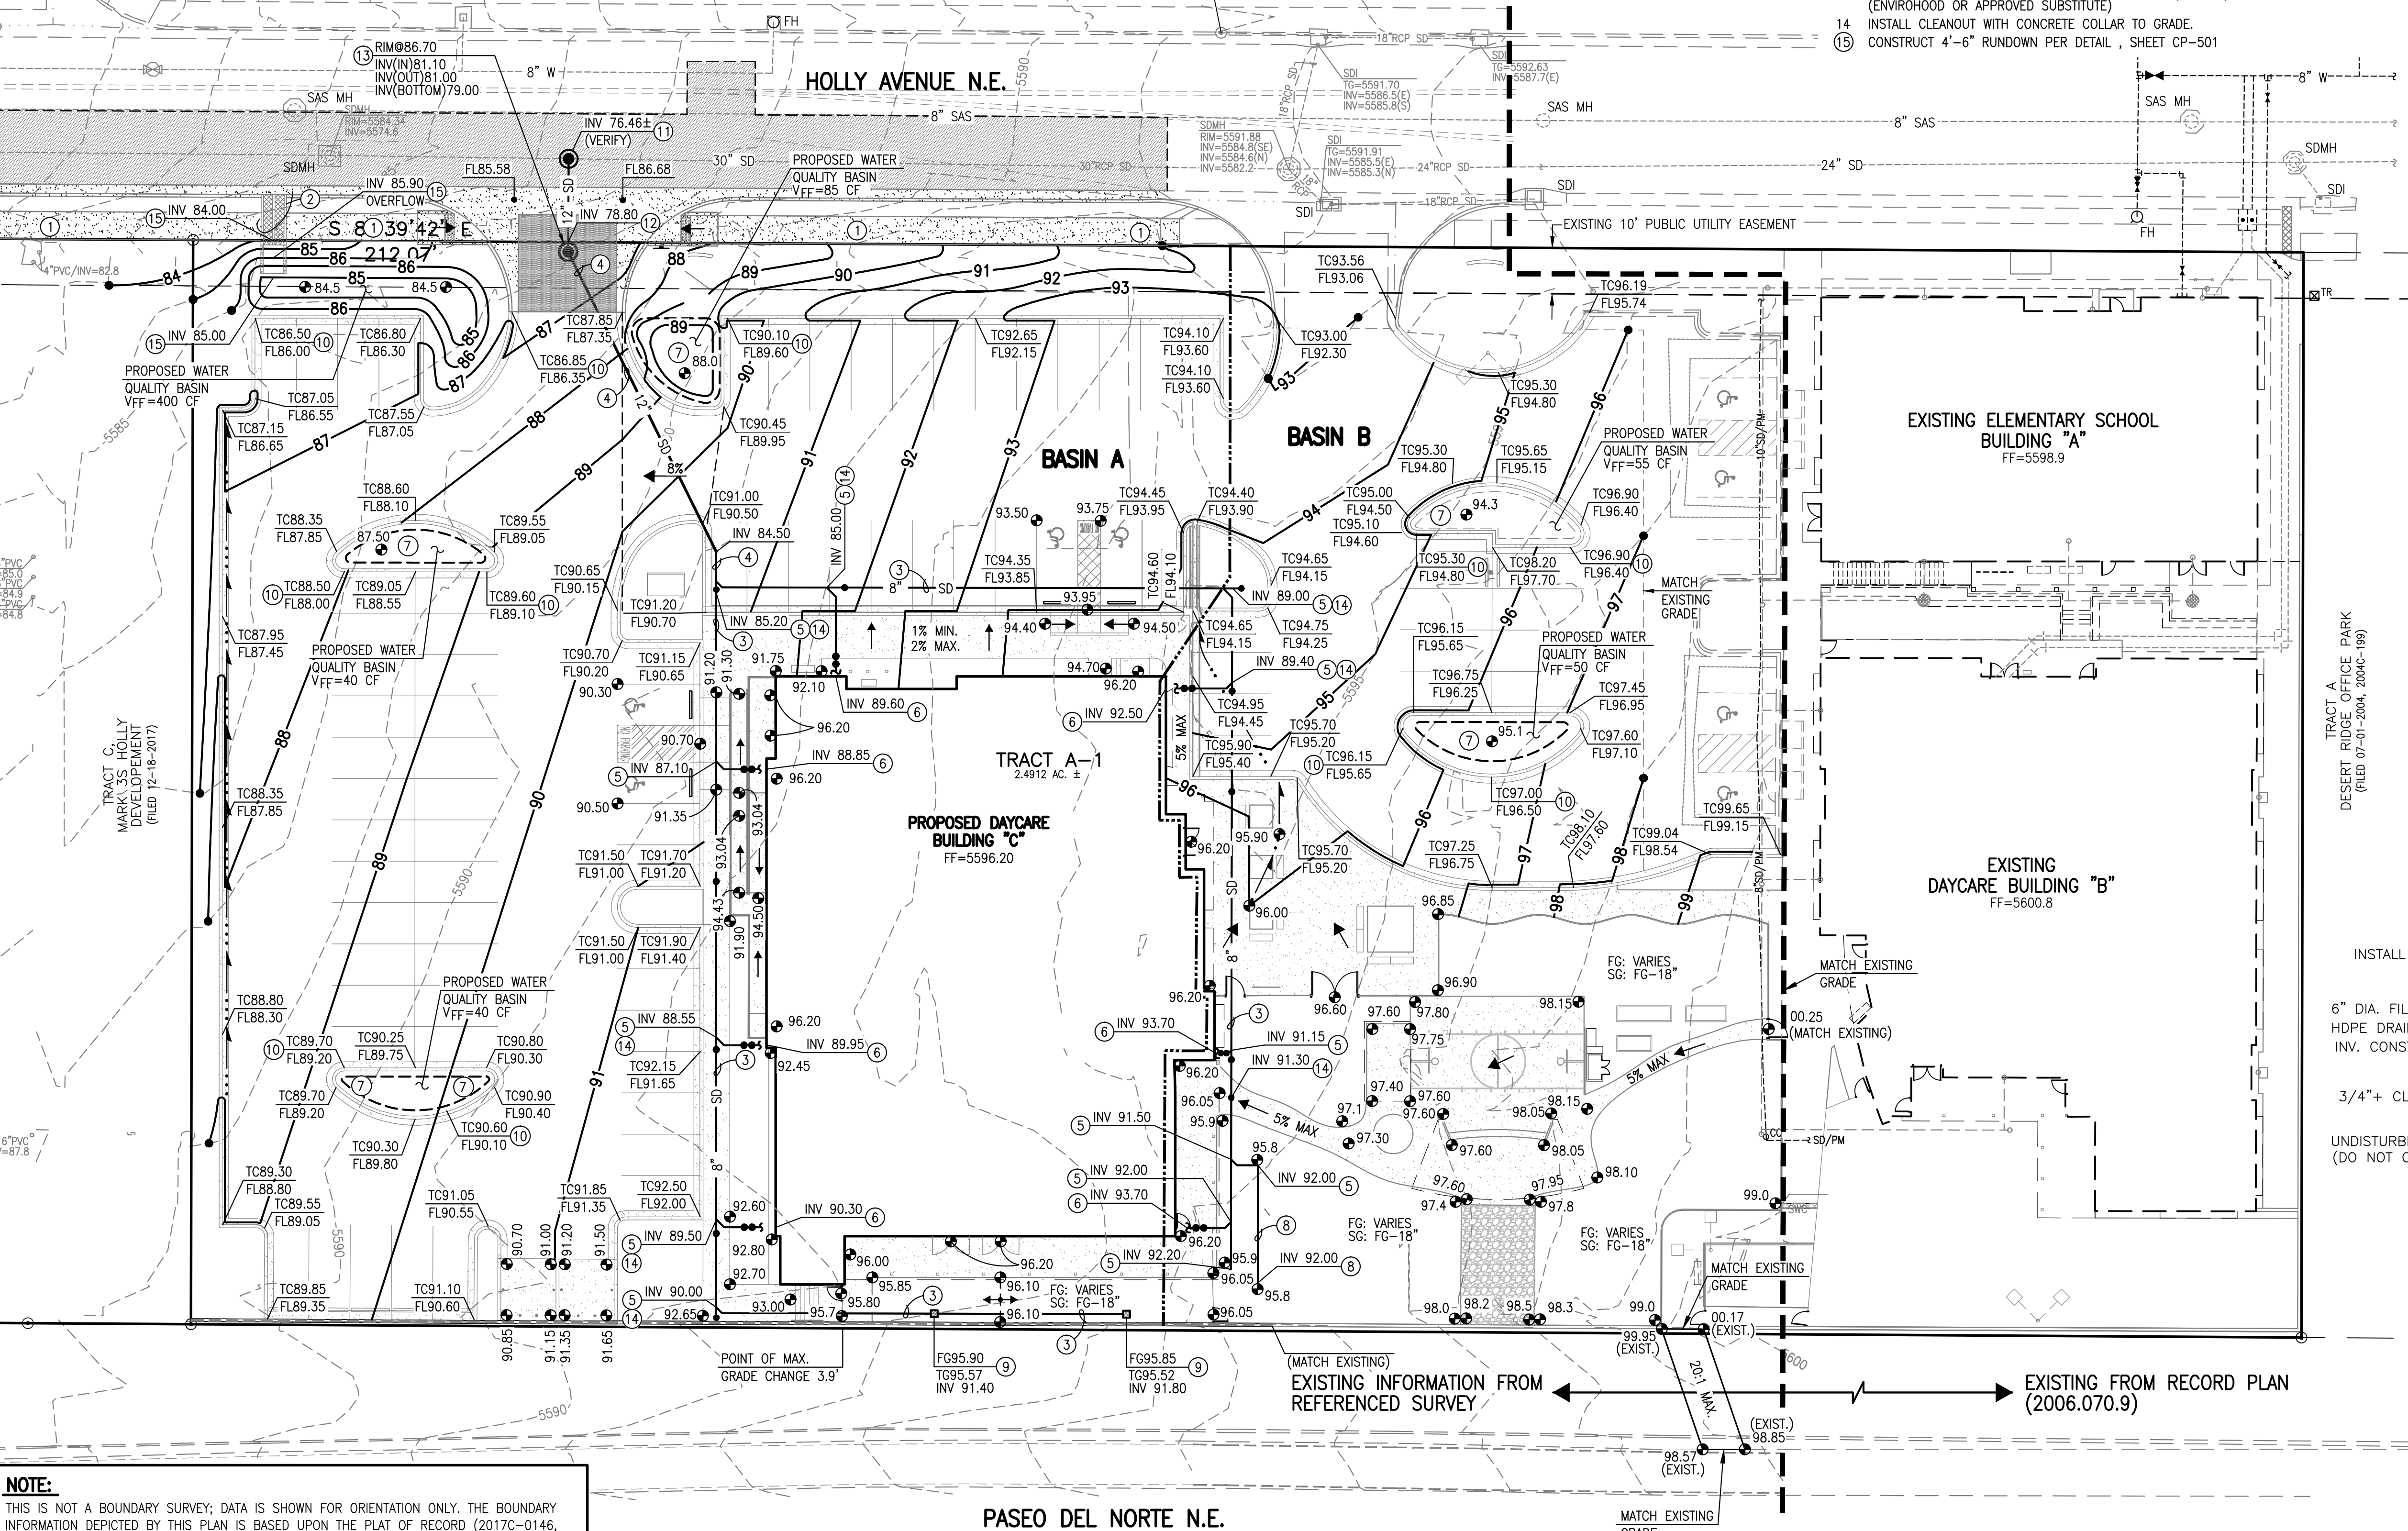


CURB CUT SECTION

SCALE: 1" = 1'-0"

TRACT A
DESERT RIDGE OFFICE PARK
(FILED 07-01-2004, 2004C-199)

INSTALL FILTER FABRIC
6" DIA. FILTER WRAPPED PERFORATED
HDPE DRAIN PIPE (HOLES DOWN)
INV. CONSTANT @ 92.00
3/4" + CLEAN GRAVEL
FILL
UNDISTURBED SOIL
(DO NOT COMPACT)

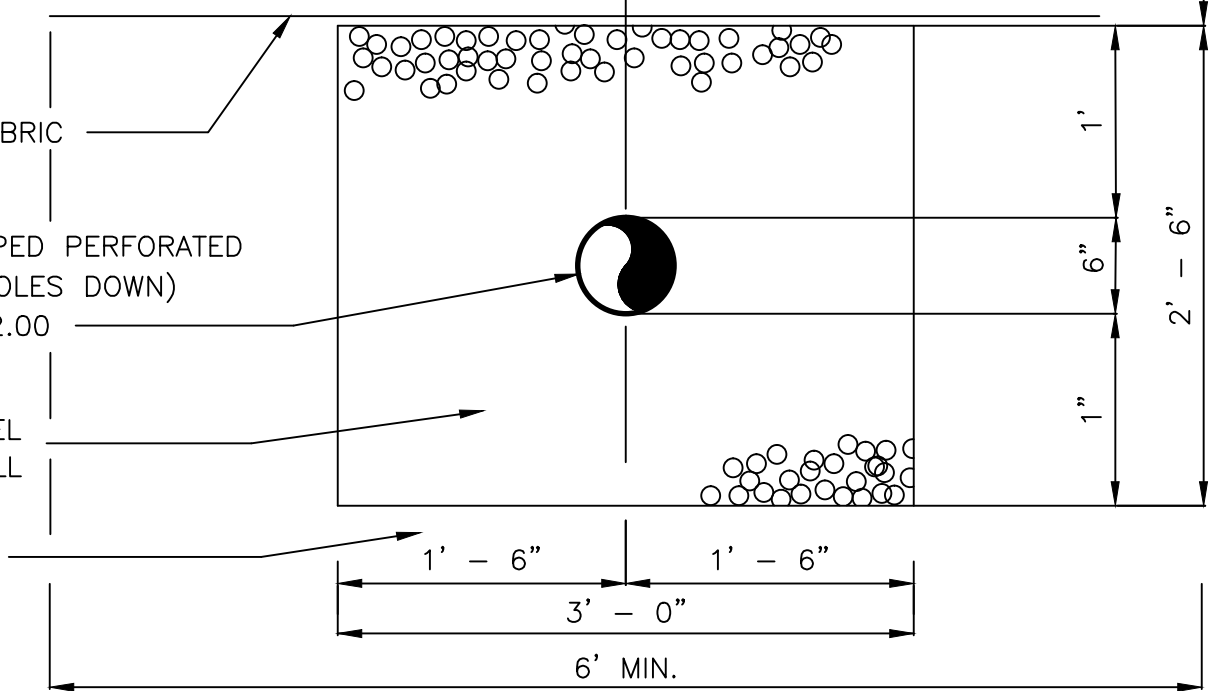

TYPICAL PERFORATED PIPE SECTION

SCALE: 1" = 1'

NOTE:
THIS IS NOT A BOUNDARY SURVEY; DATA IS SHOWN FOR ORIENTATION ONLY. THE BOUNDARY INFORMATION DEPICTED BY THIS PLAN IS BASED UPON THE PLAT OF RECORD (2017C-0146, RECORDED 12-18-2017).
UNLESS OTHERWISE NOTED THE TOPOGRAPHIC AND UTILITY INFORMATION DEPICTED HEREON IS BASED UPON THE EXISTING TOPOGRAPHIC AND UTILITY SURVEY PREPARED BY THIS FIRM, NMPS NO. 11184, DATED 01/10/2017 (2016.059.1), ALSO A PARTIAL TOPOGRAPHIC AND UTILITY SURVEY PREPARED BY THIS FIRM, NMPS NO. 11184, DATED 05/16/2017 (2016.059.2), AND ALSO A TOPOGRAPHIC SURVEY PREPARED BY THIS FIRM, NMPS NO. 11184, DATED 10/24/2006 (2006.070.1), AND ALSO THE RECORD DRAWINGS PREPARED BY THIS FIRM, NMPE 13676, DATED 09/27/2007 (2006.070.9).

HIGH MESA Consulting Group
Engineers, Surveyors & Information Utility Consultants

6010-B Midway Park Blvd. NE • Albuquerque, New Mexico 87109
Phone: 505.345.4250 • Fax: 505.345.4254 • www.highmesacg.com

GRADING AND DRAINAGE PLAN MARK 3S HOLLY DEVELOPMENT

DESIGNED BY	NO.	DATE	BY	REVISIONS	JOB NO.
R.J.C.					2017.014.4
DRAWN BY					DATE
S.C.C./J.Y.R.					01-2018
APPROVED BY					SHEET
G.M.					CG-101



01-30-2018