
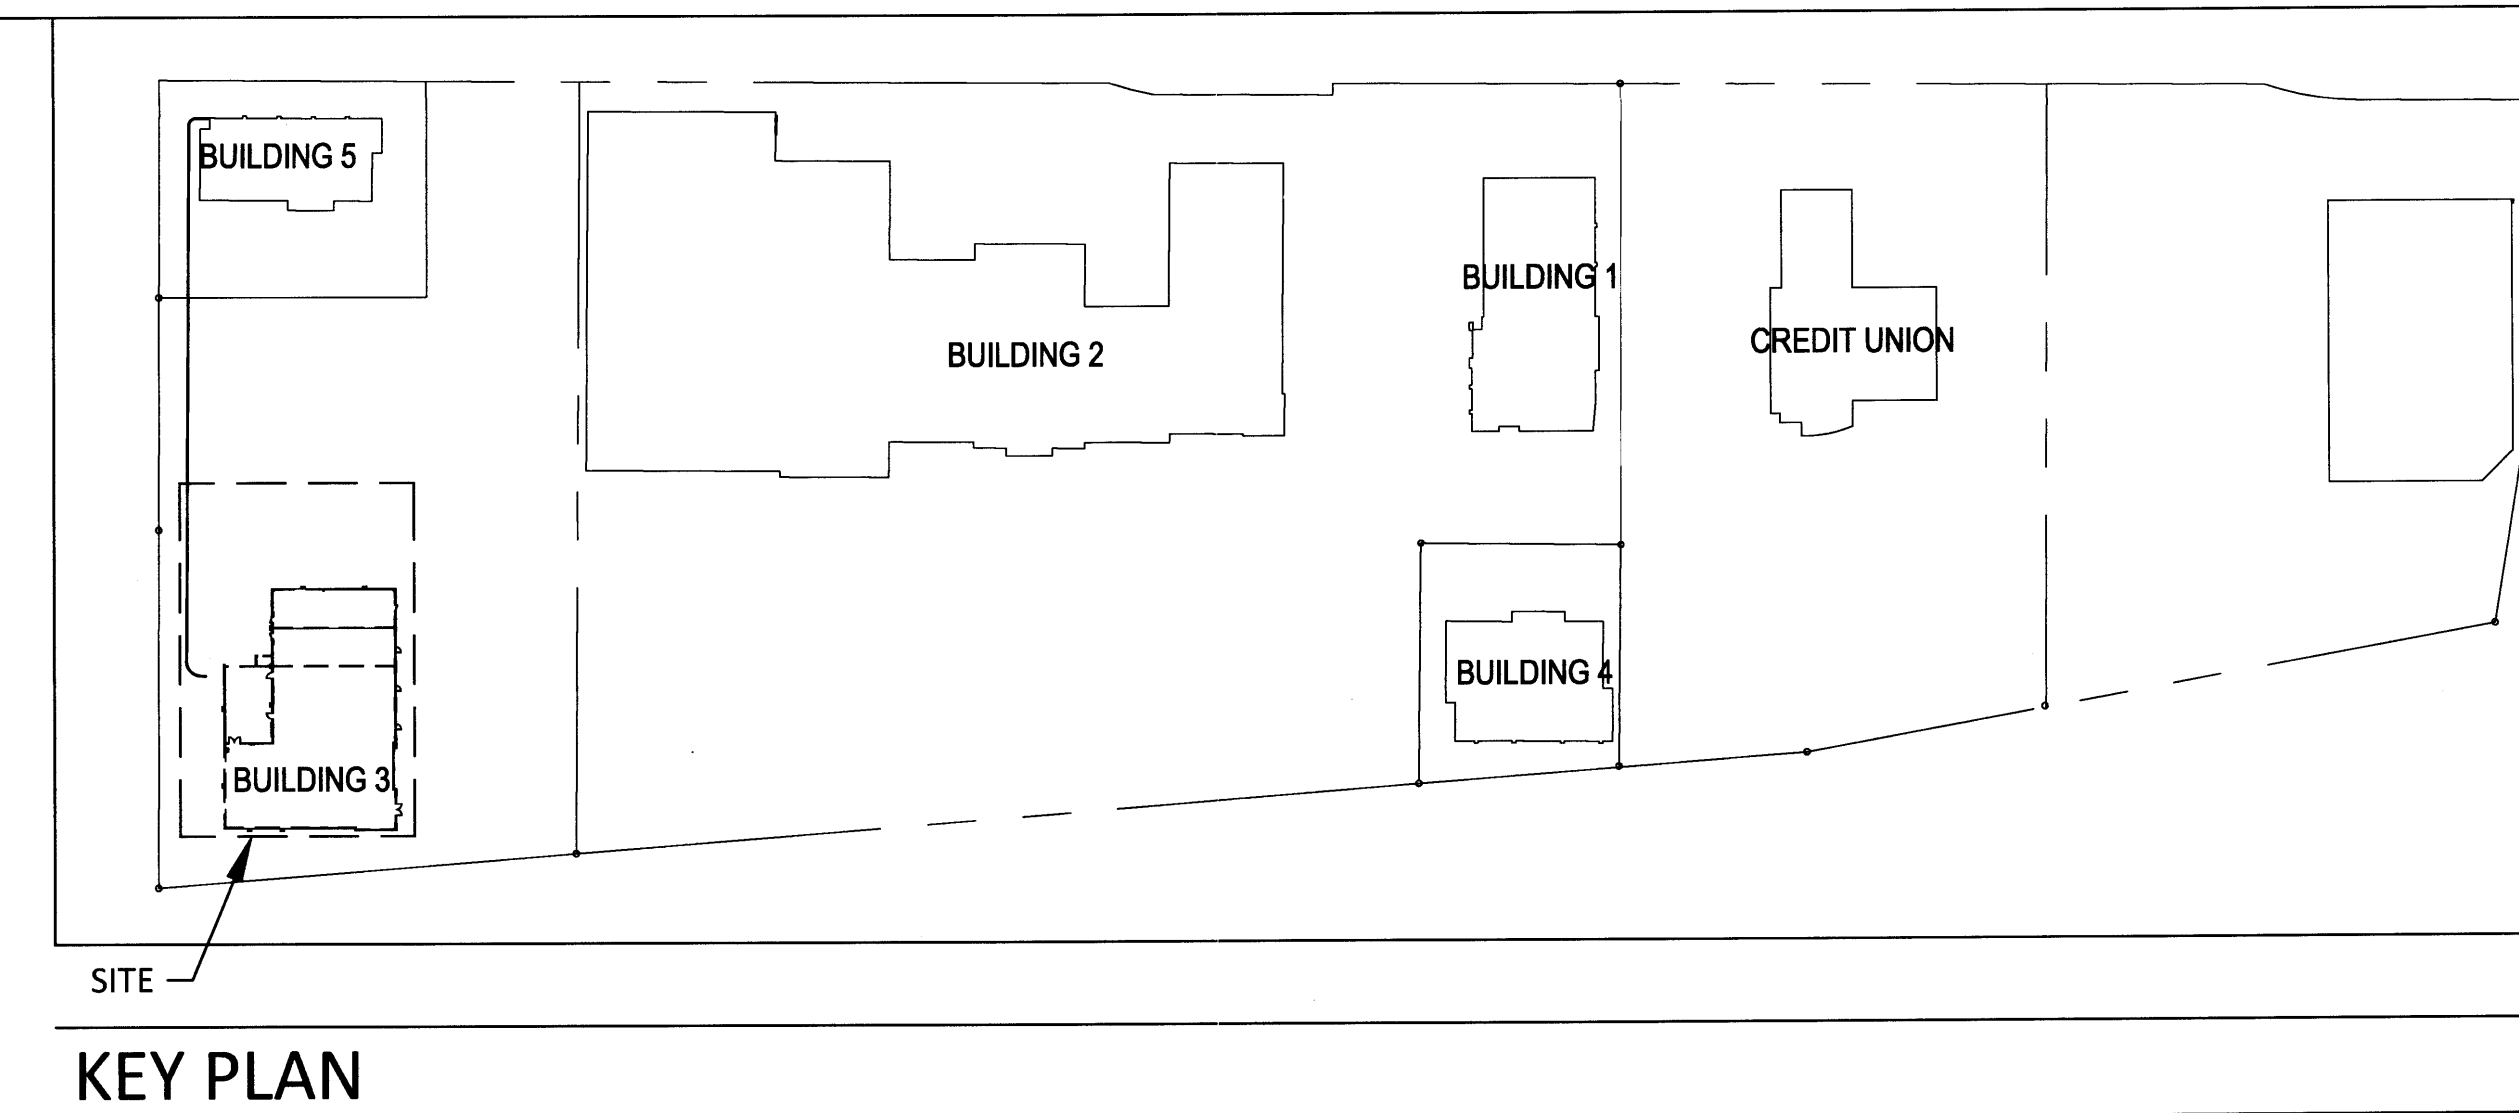


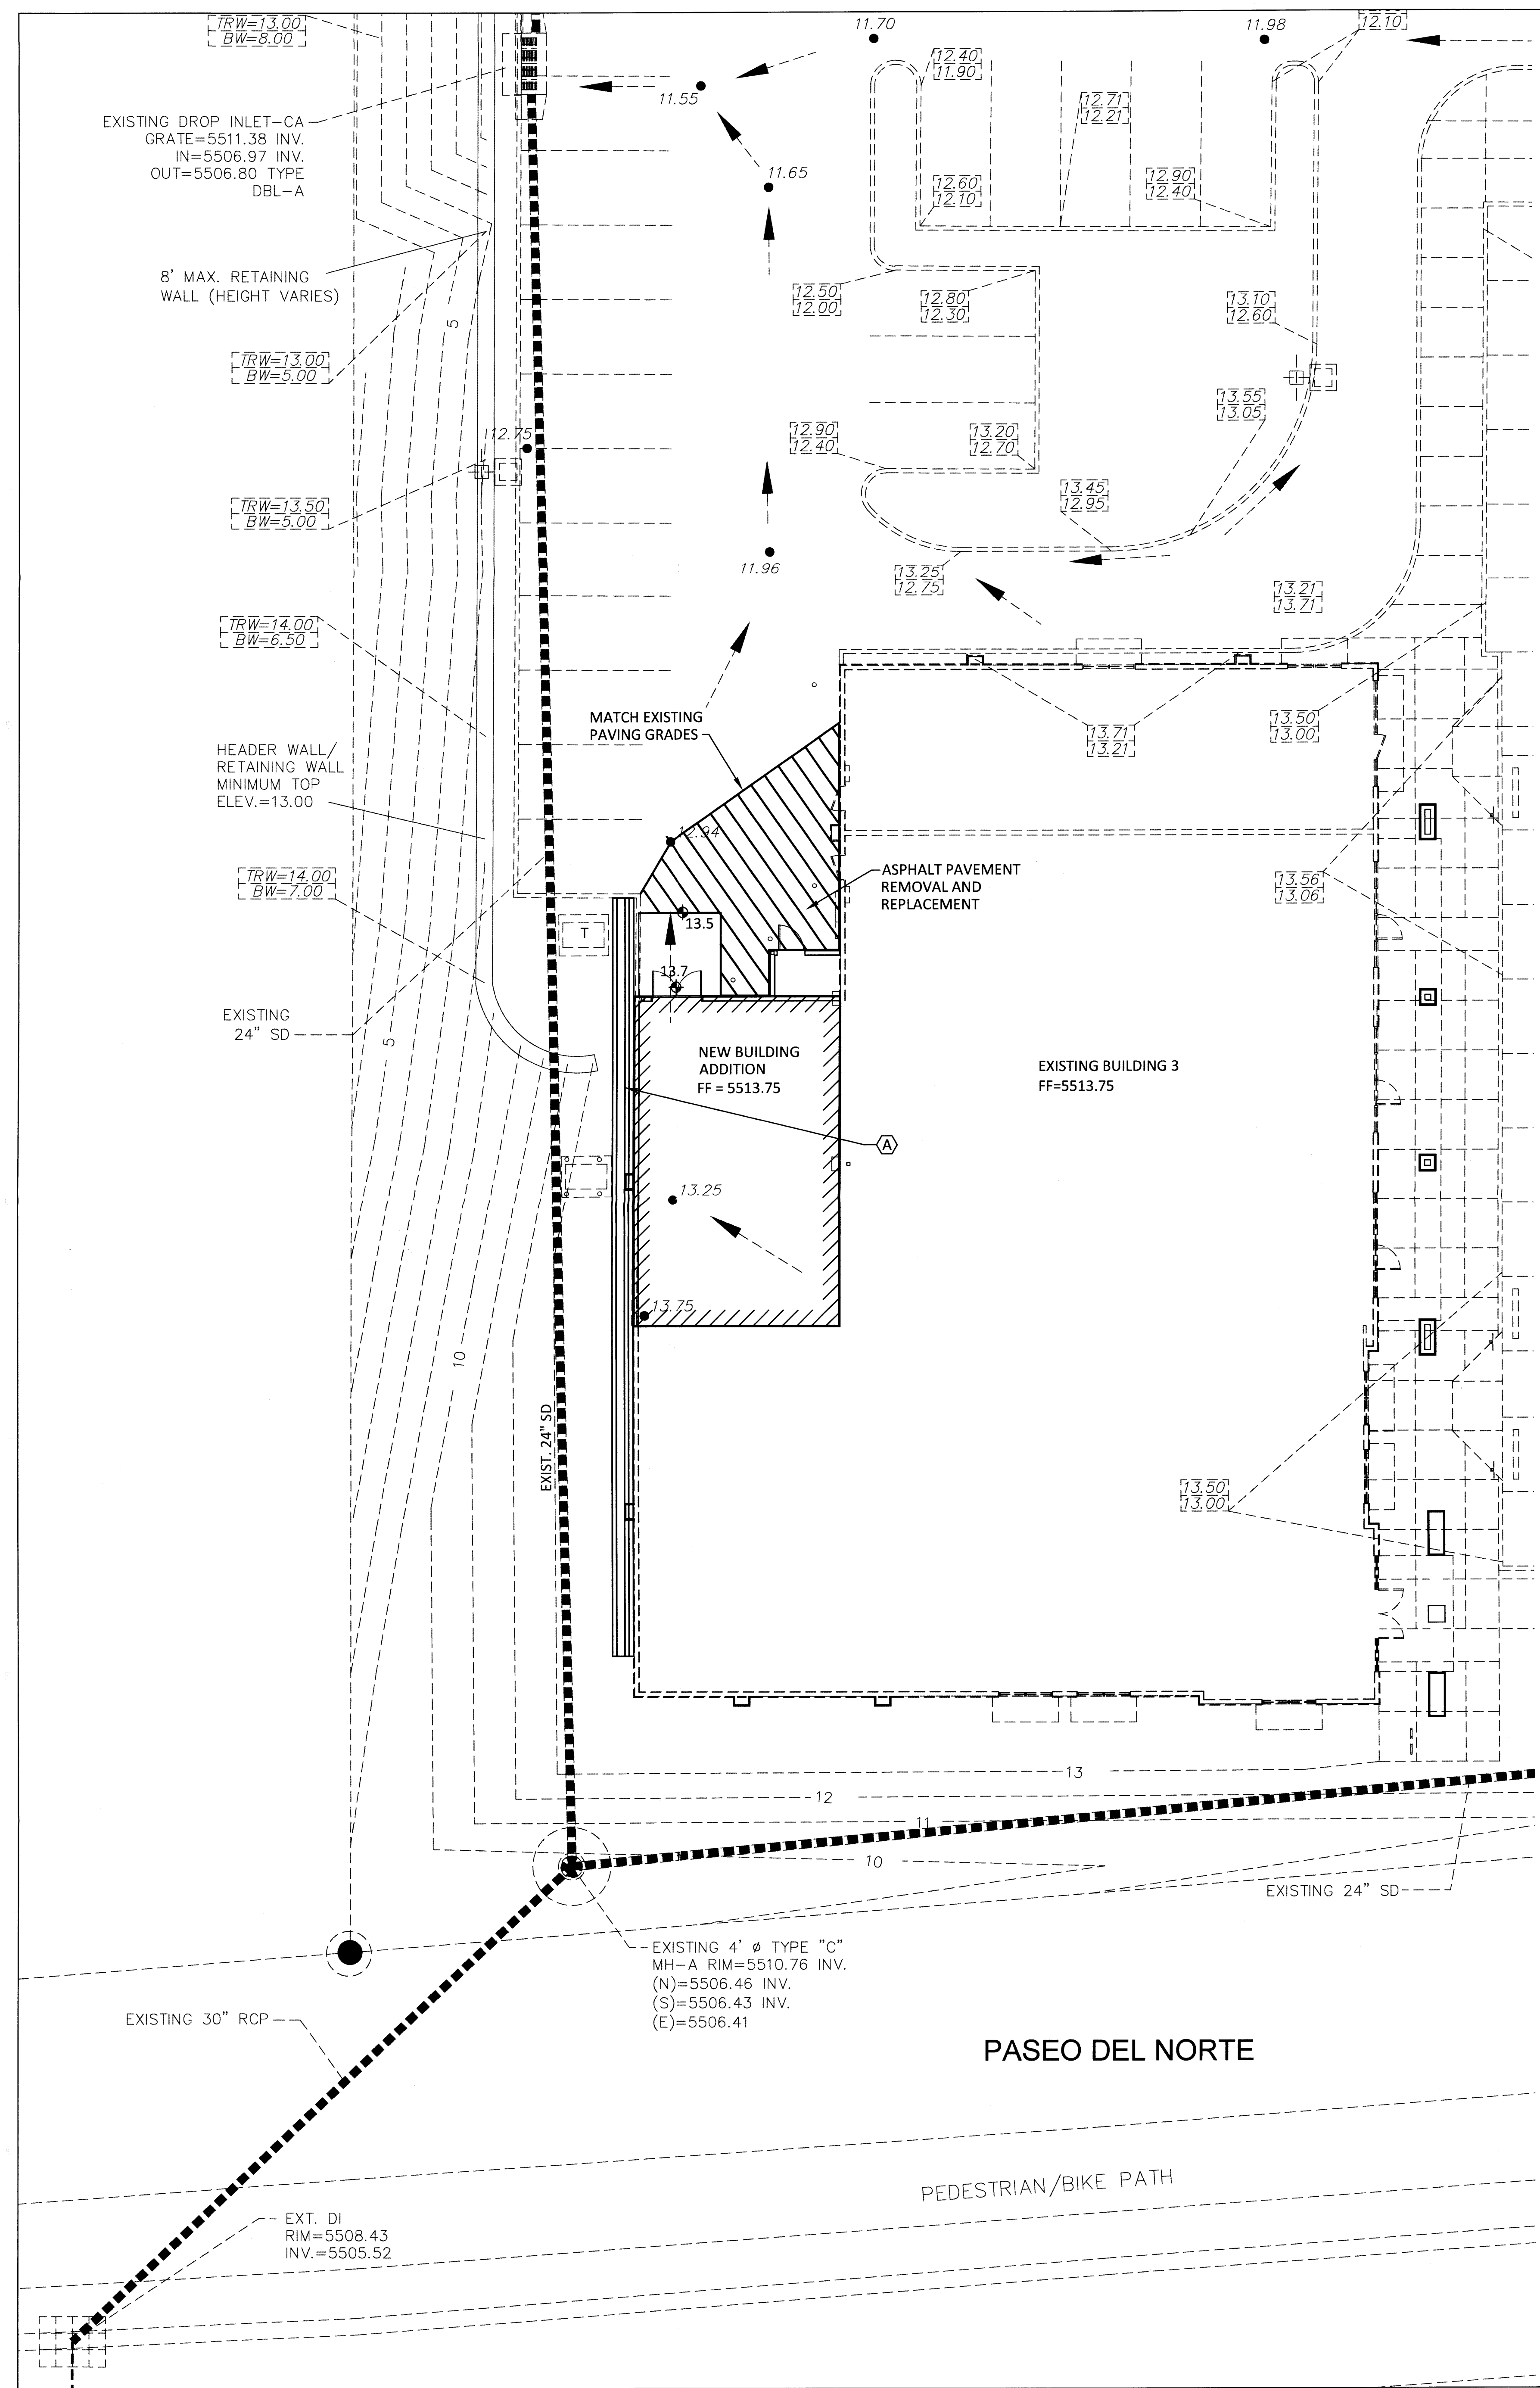


LEGEND

[13.71]	EXISTING TC
[13.21]	EXISTING FL
---	EXISTING CONSTRUCTION
---	NEW CONTOUR
◆ 71.1	NEW SPOT ELEVATION
FF	FINISH FLOOR ELEV

KEYED NOTES

(A) BUILD 92 LF U-SHAPED CHANNEL. REMOVE EXISTING CURB AS NEEDED TO ALLOW CHANNEL TO DISCHARGE FLOW TO NORTH.

U-SHAPED CHANNEL

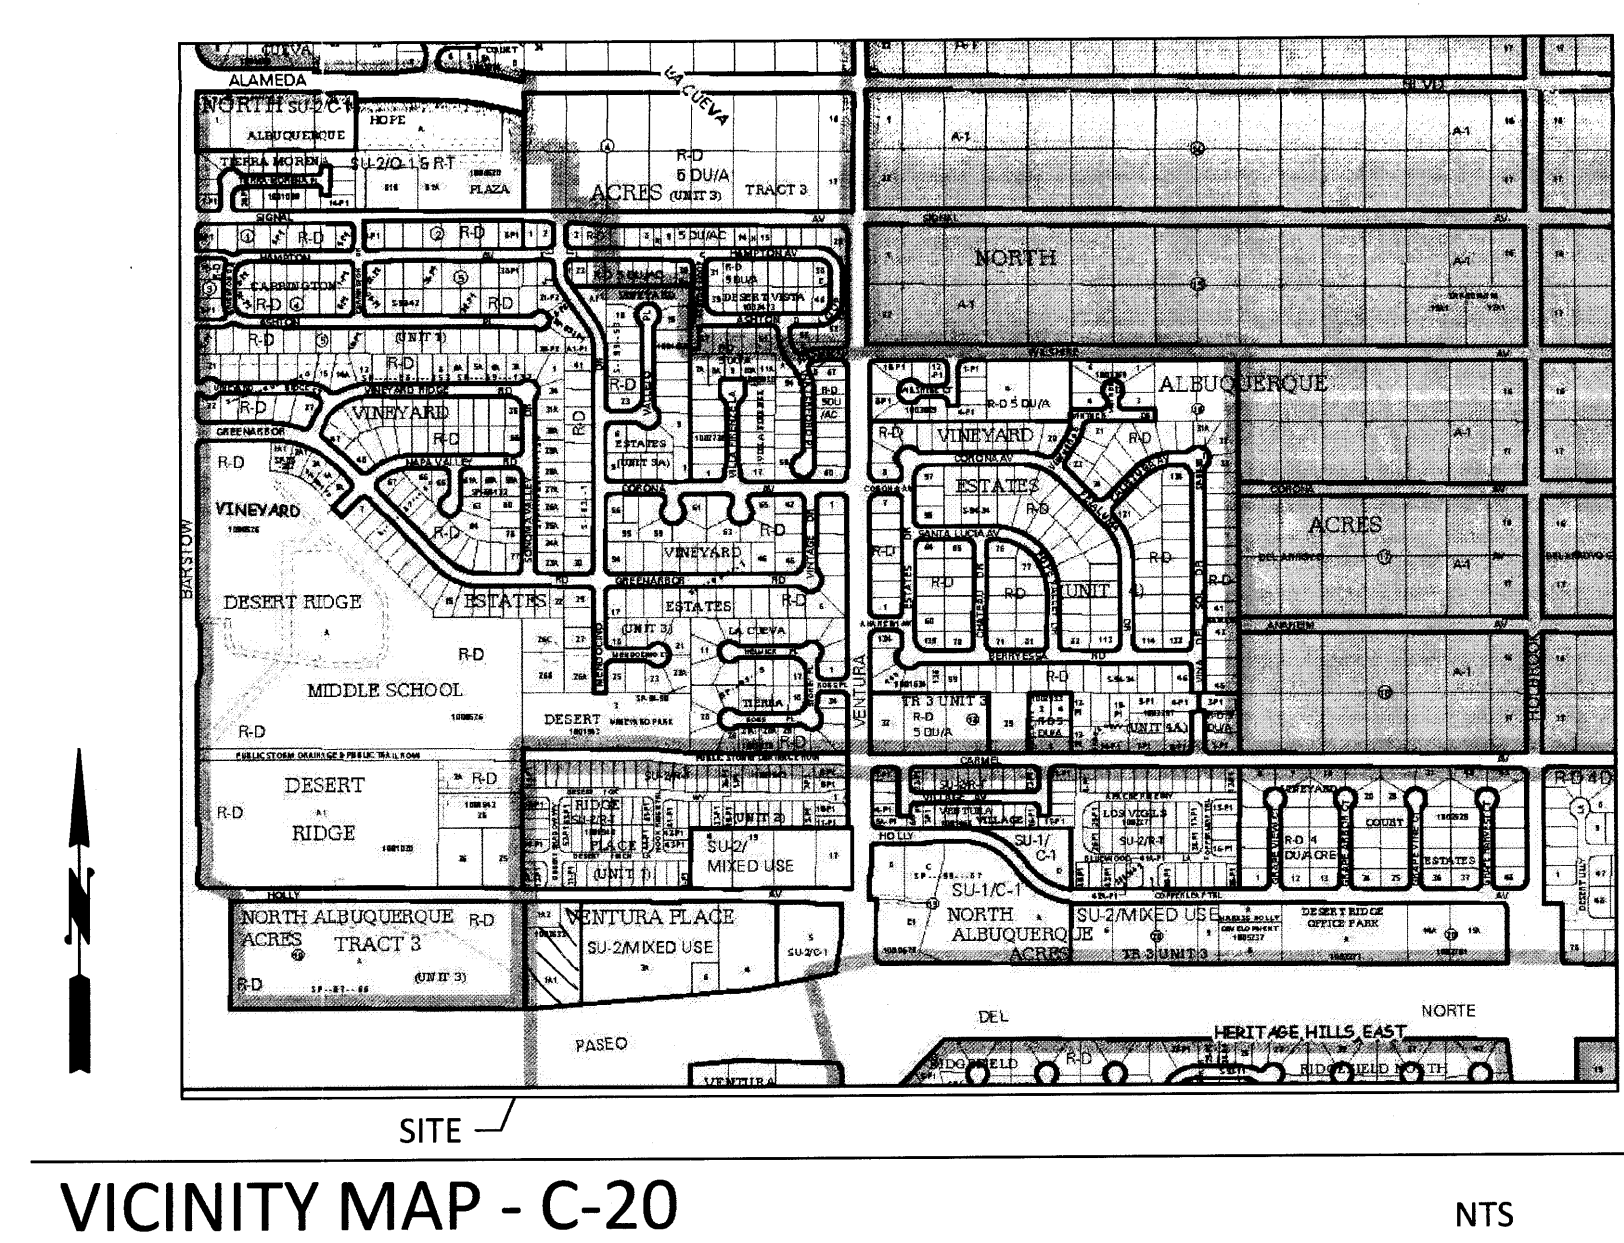

DRAINAGE

LEGAL: Lot 1 A 1, VENTURA PLACE

AREA: 1,000 SF (0.023 acre) Overall site area is 1.75 acres.

TBM: Finish Floor elevation of existing building as shown on plan
FF ELEVATION = 5513.75

PRECIPITATION ZONE: 3

FLOOD HAZARD: From FEMA Panel 35001C0141G (dated 9/26/2008), this site is identified as being within Zone 'X' which is located outside the 0.2% annual chance floodplain.

FIRST FLUSH: This site was developed prior to the requirement to address the first flush volume. The runoff is carried on existing paved surfaces and existing storm drain lines to the R/W of Paseo del Norte which is then maintained by the NMDOT. *DO NOT ALLOW RUNOFF DISCHARGED TO SE*

EXISTING CONDITIONS: The existing site is the western portion of a developed commercial shopping center with multiple buildings and paved parking. It is located on the west side of Ventura Street between Paseo del Norte and Holly Avenue NE. The site slopes down from the east to west at 2-4%. Site drainage is directed via existing drop inlets and storm drain lines to the Paseo del Norte R/W.

PROPOSED IMPROVEMENTS: The proposed 1,000 SF building addition is located over an existing paved service area. Runoff from the new roof area will be discharged north onto existing paving.

DRAINAGE APPROACH: The drainage plan will follow historic drainage patterns. The runoff will not be increased.

Existing land treatment: 100% D A=0.023 acres
 $Q = (0.023)(5.02) = 0.1 \text{ CFS}$
 $V = (0.197)(1000) = 197 \text{ CF}$
Proposed land treatment: 100% D
 $Q = (0.023)(5.02) = 0.1 \text{ CFS}$
 $V = (0.197)(1000) = 197 \text{ CF}$

No additional runoff volume will be created by this addition. Therefore no adverse impact to downstream drainage facilities will occur.

ARCHITECTURE / DESIGN / INSPIRATION

DEKKER PERICH SABATINI

7601 JEFFERSON NE, SUITE 100
ALBUQUERQUE, NM 87109

505.761.9700 / DPSDESIGN.ORG

ARCHITECT

ISSUED FOR PERMIT

ENGINEER

PROJECT

VICINITY MAP - C-20

NTS

VENTURA PLACE
Building 3
8810 Holly Avenue NE
Albuquerque, New Mexico 87122

REVISIONS

△

△

DRAWN BY

REVIEWED BY

DATE 10/24/2014

PROJECT NO. 14-0068.001



DRAWING NAME

GRADING PLAN
BUILDING 3

SHEET NO.

C-101

OF

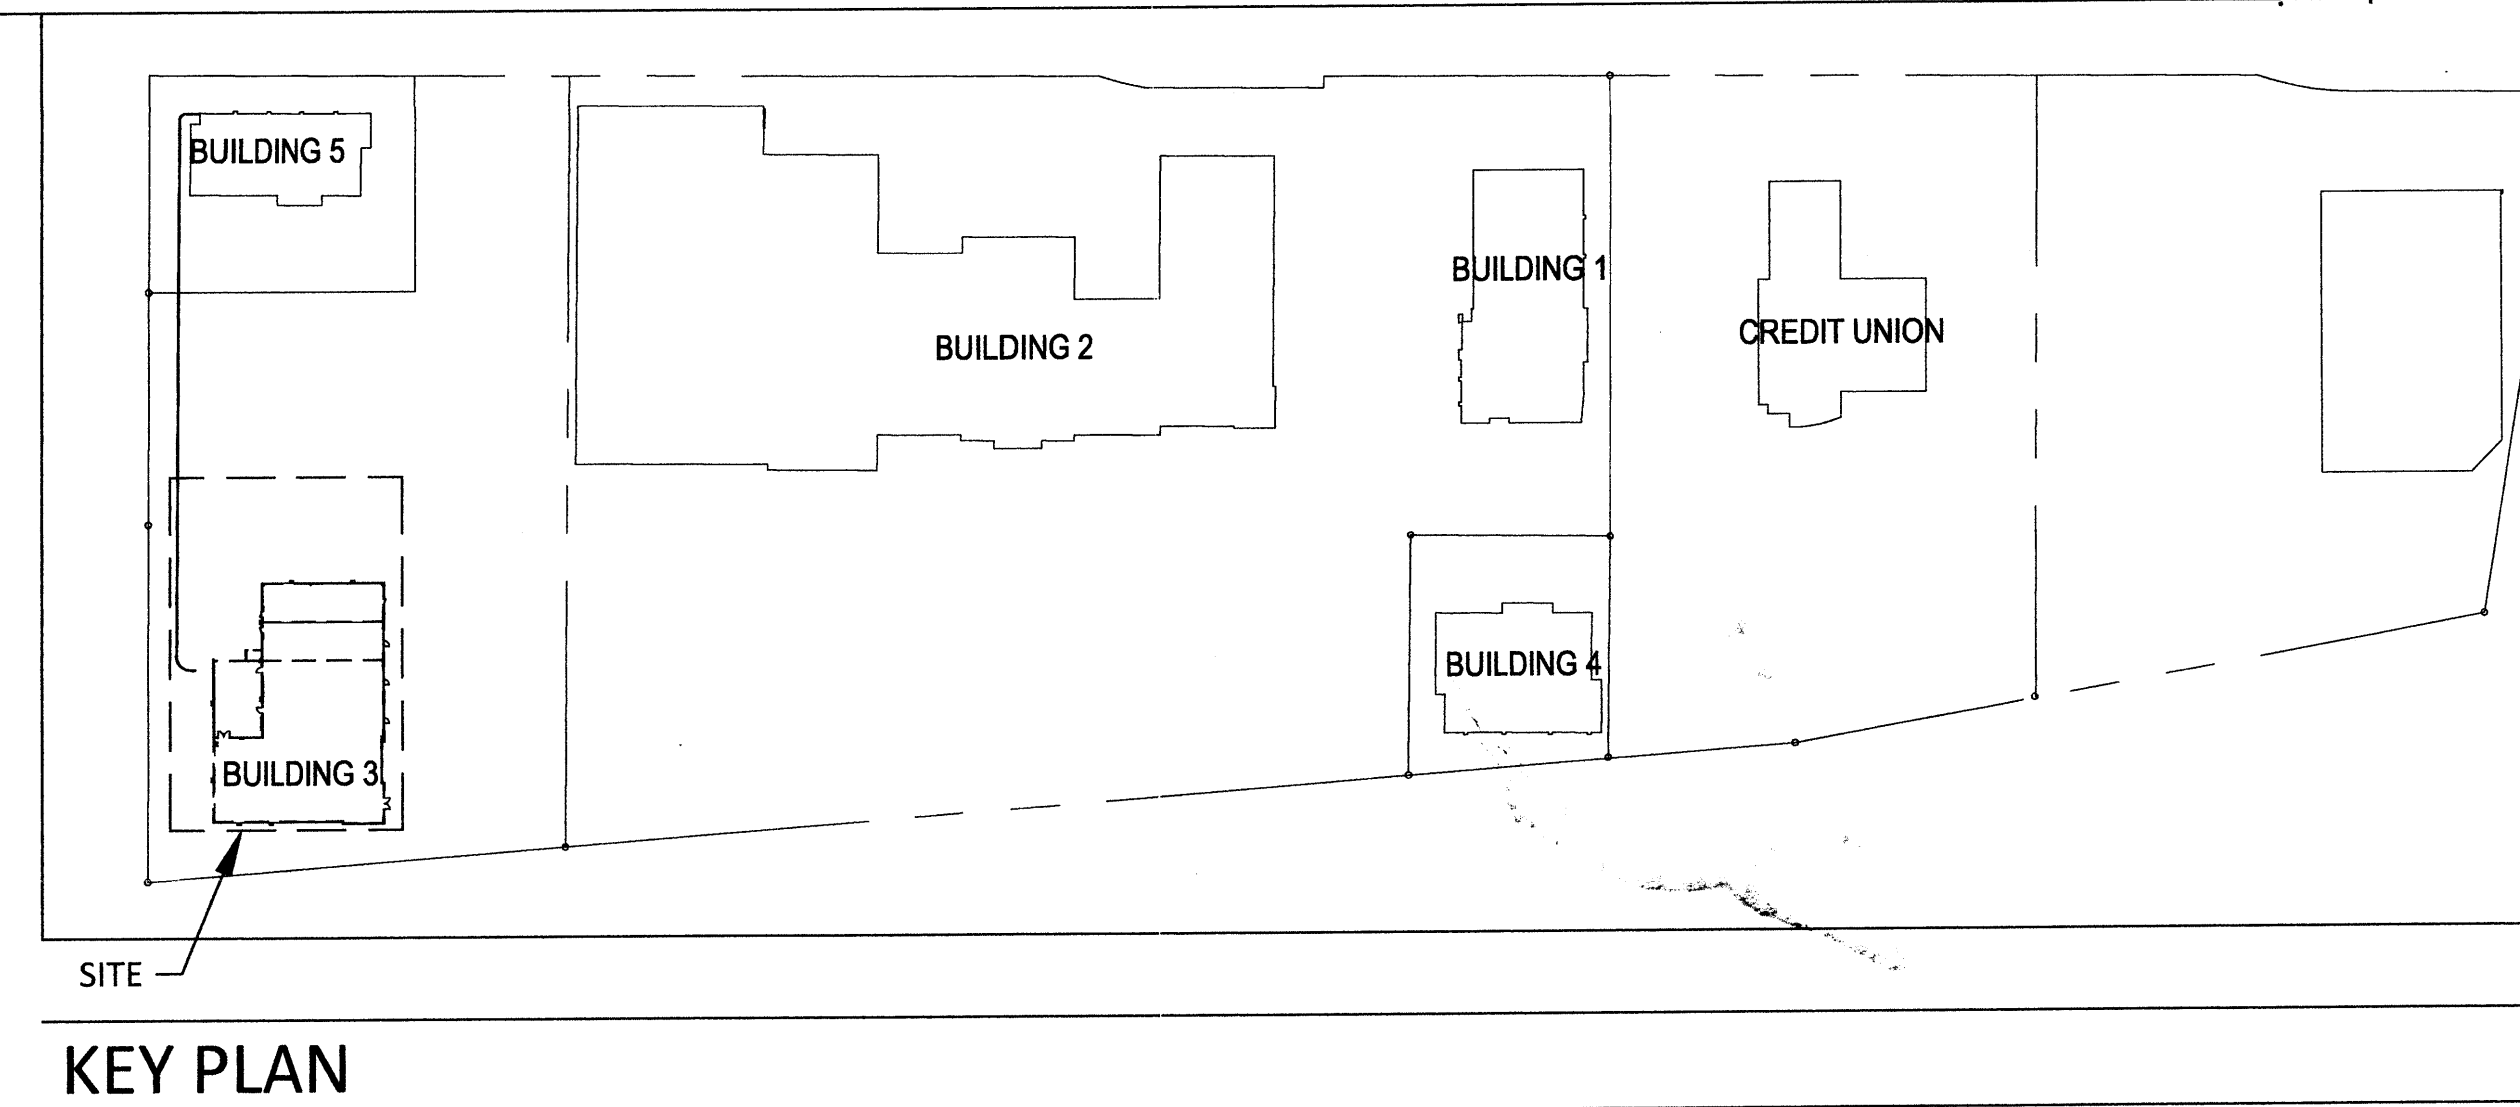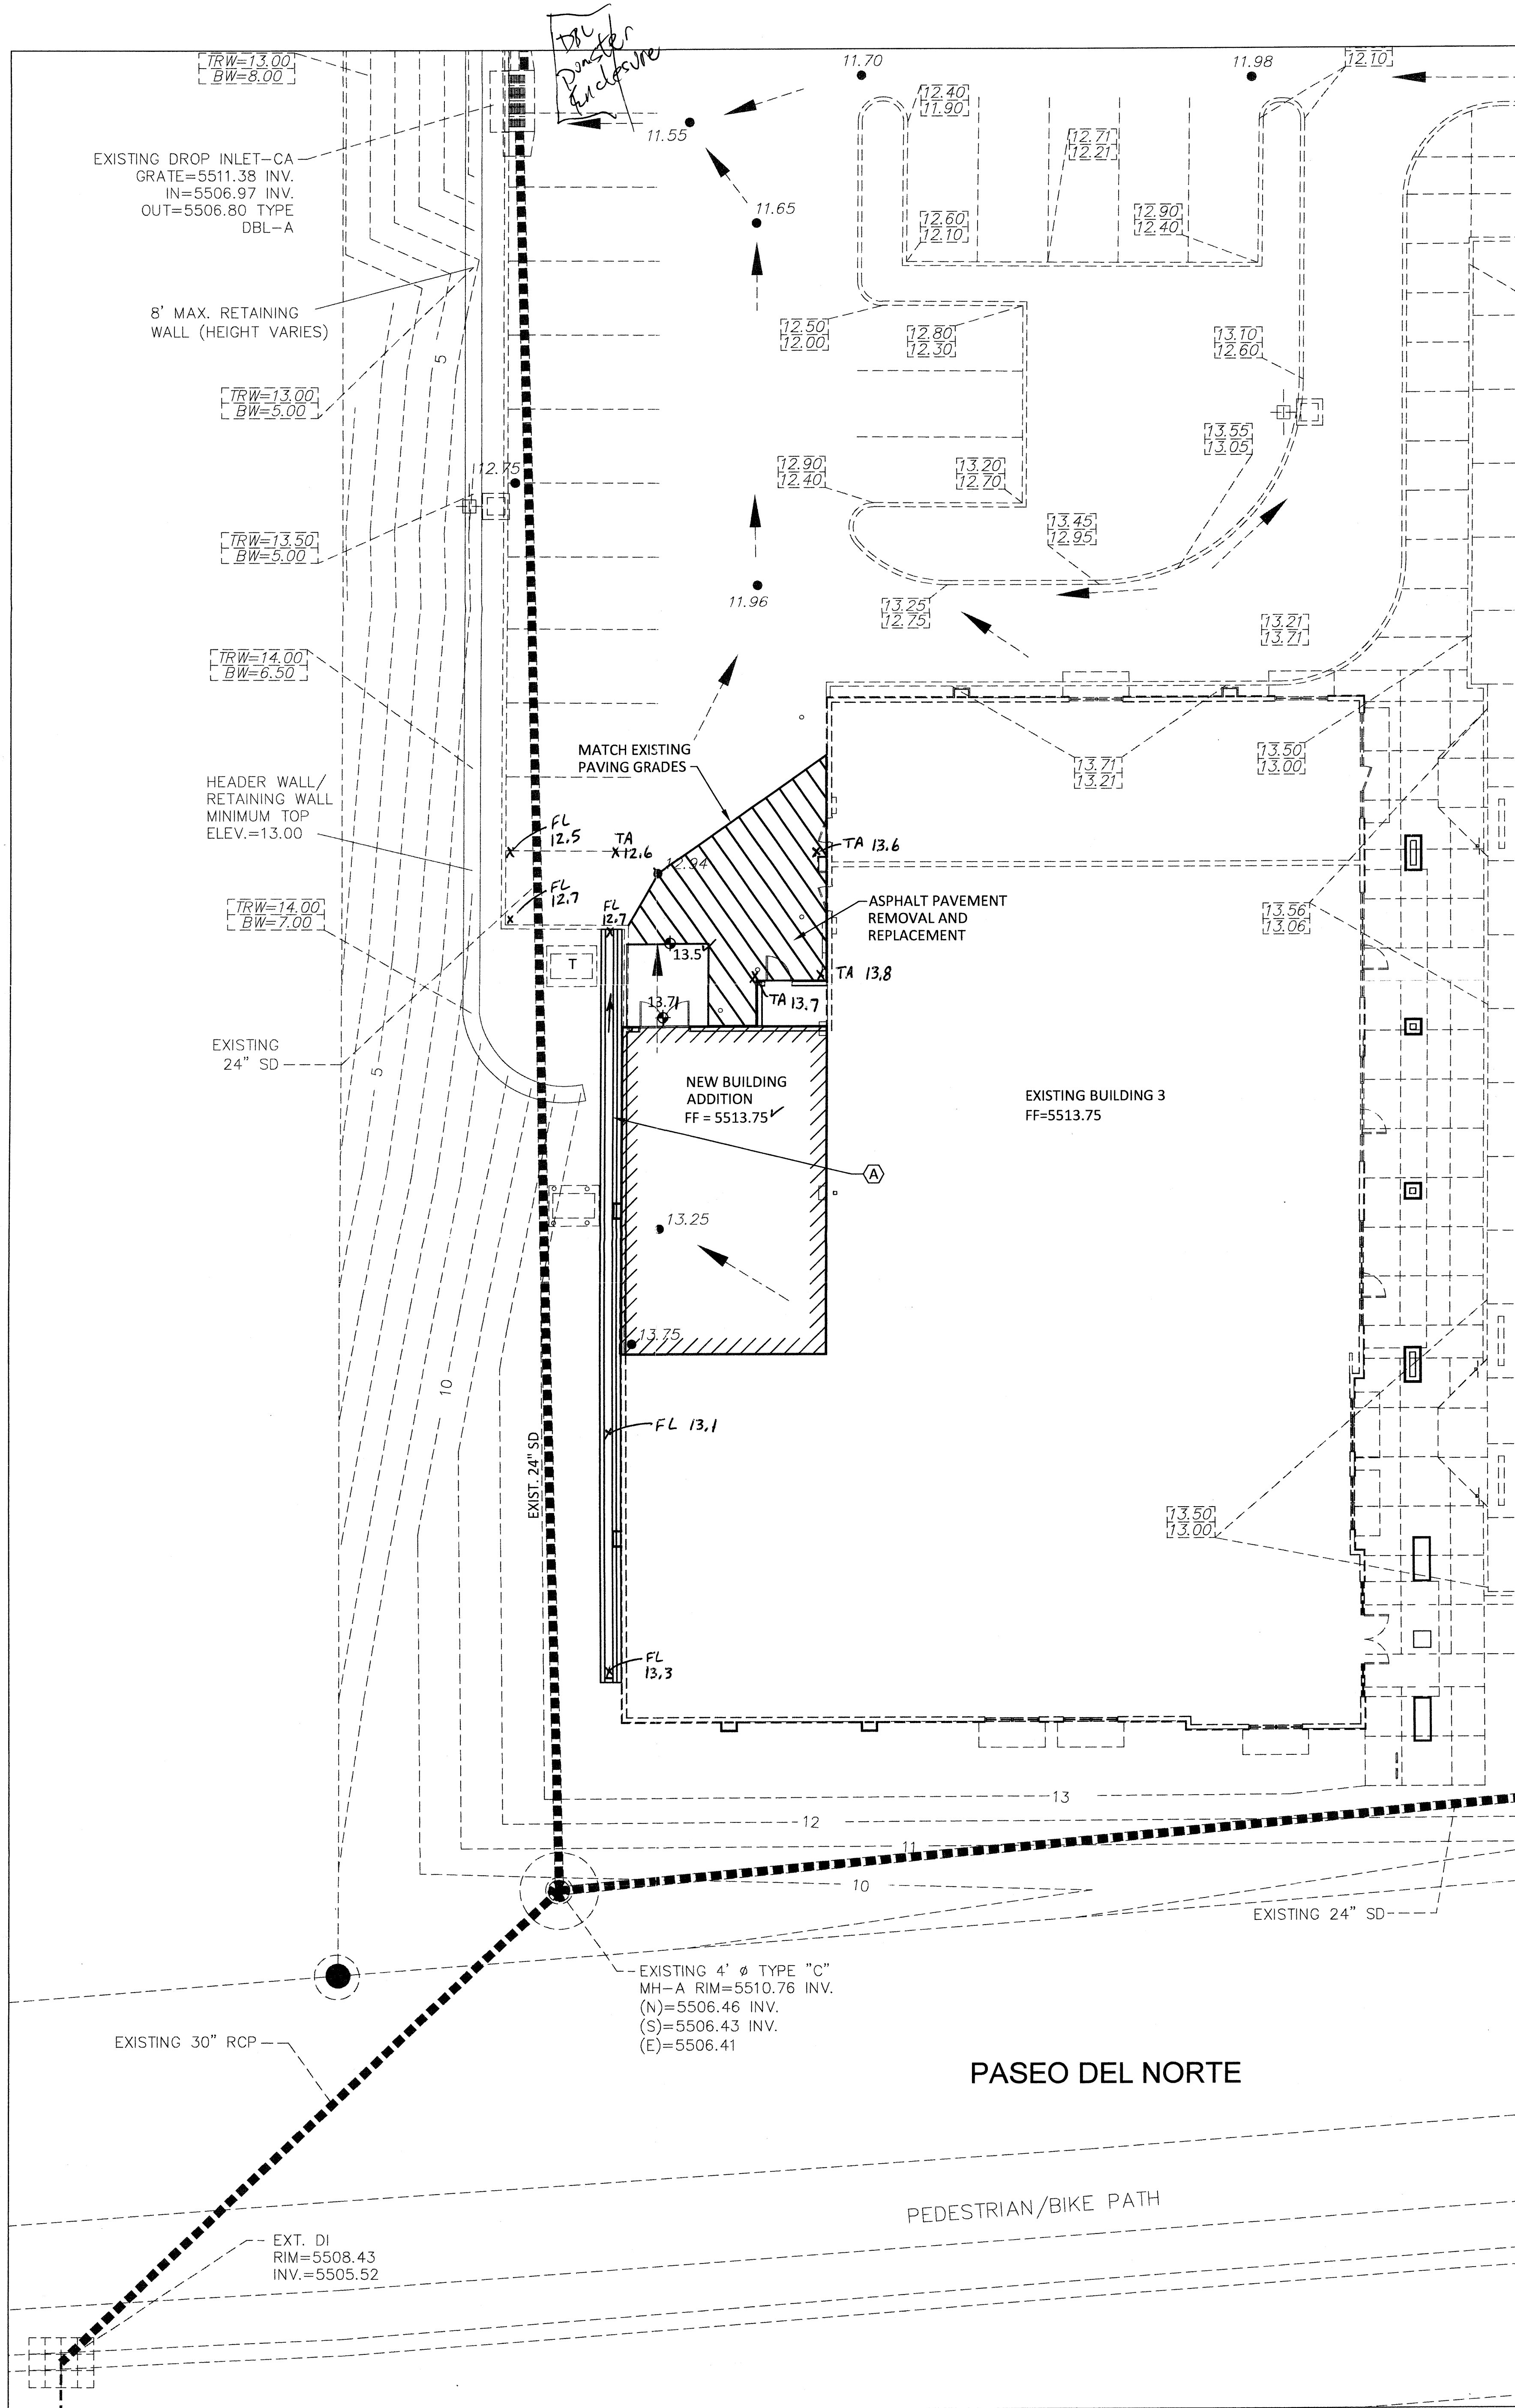


LEGEND	
	EXISTING TC
	EXISTING FL
	EXISTING CONSTRUCTION
	NEW CONTOUR
	NEW SPOT ELEVATION
	FINISH FLOOR ELEV
	TOP OF ASPHALT ELEV
	FLOW LINE ELEV
	AS-BUILT ELEV

KEYED NOTES

(A) BUILD 92 LF U-SHAPED CHANNEL. REMOVE EXISTING CURB AS NEEDED TO ALLOW CHANNEL TO DISCHARGE FLOW TO NORTH.

U-SHAPED CHANNEL

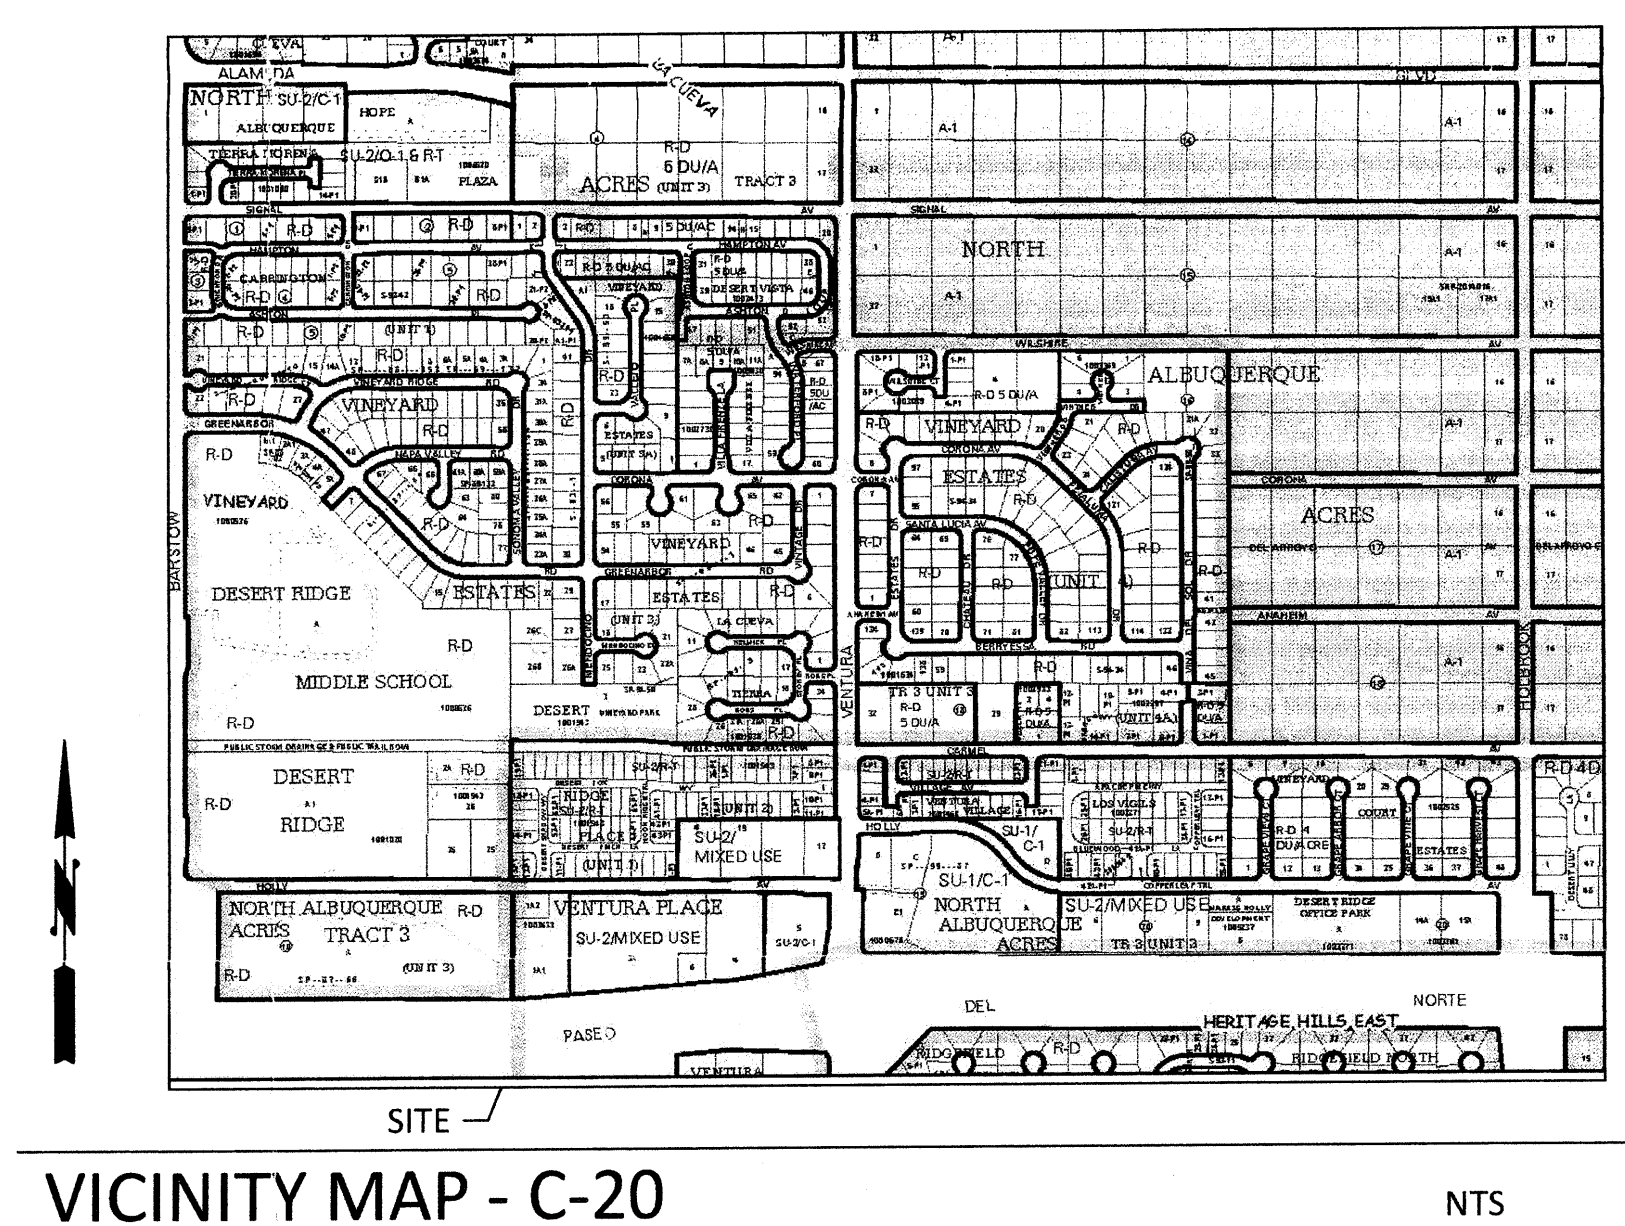

DRAINAGE

LEGAL: Lot 1 A 1, VENTURA PLACE

AREA: 1,000 SF (0.023 acre) Overall site area is 1.75 acres.

TBM: Finish Floor elevation of existing building as shown on plan
FF ELEVATION = 5513.75

PRECIPITATION ZONE: 3

FLOOD HAZARD: From FEMA Panel 35001C0141G (dated 9/26/2008), this site is identified as being within Zone 'X' which is located outside the 0.2% annual chance floodplain.

FIRST FLUSH: This site was developed prior to the requirement to address the first flush volume. The runoff is carried on existing paved surfaces and existing storm drain lines to the R/W of Paseo del Norte which is then maintained by the NMDOT.

EXISTING CONDITIONS: The existing site is the western portion of a developed commercial shopping center with multiple buildings and paved parking. It is located on the west side of Ventura Street between Paseo del Norte and Holly Avenue NE. The site slopes down from the east to west at 2-4%. Site drainage is directed via existing drop inlets and storm drain lines to the Paseo del Norte R/W.

PROPOSED IMPROVEMENTS: The proposed 1,000 SF building addition is located over an existing paved service area. Runoff from the new roof area will be discharged north onto existing paving.

DRAINAGE APPROACH: The drainage plan will follow historic drainage patterns. The runoff will not be increased.

Existing land treatment: 100% D A=0.023 acres
 $Q = (0.023)(5.02) = 0.1 \text{ CFS}$
 $V = (0.197)(1000) = 197 \text{ CF}$
Proposed land treatment: 100% D
 $Q = (0.023)(5.02) = 0.1 \text{ CFS}$
 $V = (0.197)(1000) = 197 \text{ CF}$

No additional runoff volume will be created by this addition. Therefore no adverse impact to downstream drainage facilities will occur.

DRAINAGE CERTIFICATION

I, SCOTT M MCGEE, NMPE 10519, OF THE FIRM SCOTT M MCGEE PE, LLC, HEREBY CERTIFY THAT THIS SITE HAS BEEN GRADED AND WILL DRAIN IN SUBSTANTIAL COMPLIANCE WITH AND IN ACCORDANCE WITH THE DESIGN INTENT OF THE APPROVED PLAN DATED 10/22/14. THE RECORD INFORMATION EDITED ONTO THE ORIGINAL DESIGN DOCUMENT HAS BEEN OBTAINED BY ANDREW S. MEDINA, NMPS 12649, OF THE FIRM SANDIA LAND SURVEYING LLC. I FURTHER CERTIFY THAT I PERSONALLY VISITED THE PROJECT SITE ON 3/30/15 AND HAVE DETERMINED BY VISUAL INSPECTION THAT THE SURVEY DATA PROVIDED IS REPRESENTATIVE OF ACTUAL SITE CONDITIONS AND IS TRUE AND CORRECT TO THE BEST OF MY KNOWLEDGE AND BELIEF. THIS CERTIFICATION IS SUBMITTED IN SUPPORT OF A REQUEST FOR CERTIFICATE OF OCCUPANCY.

THE RECORD INFORMATION SHOWN HEREON IS NOT NECESSARILY COMPLETE AND IS ONLY INTENDED TO VERIFY SUBSTANTIAL COMPLIANCE OF THE GRADING/DRAINAGE ASPECTS OF THIS PROJECT. THOSE RELYING ON THIS RECORD DOCUMENT ARE ADVISED TO OBTAIN INDEPENDENT ACCURACY VERIFICATION BEFORE USING IT FOR ANY PURPOSE.

Scott M McGee 3/30/15
SCOTT M MCGEE, NMPE 10519