CITY OF ALBUQUERQUE



January 12, 2017

Richard J. Berry, Mayor

Ron Hensley, P.E. The Group. 300 Branding Iron Rd. SE, Rio Rancho, NM, 87124

RE: Carmel Ridge Subdivision Grading and Drainage Plan Engineer's Stamp Date 12-16-2016 (File: C20D075)

Dear Mr. Hensley:

Based upon the information provided in your submittal received 12-16-2016, the above referenced Grading Plan is approved for Preliminary Plat action by the DRB.

When submitting for Grading approval please address the following comments:

PO Box 1293

Albuquerque

- 1. Provide a retaining wall on the north of lot 3 and lot 4, where difference between existing and proposed grades is 2 feet or greater.
- 2. Provide FG grades in the south east area of lot 4. There are TW grades, but no BW/FG grades
- 3. Please check the grade elevation between the flow line and back of side walk, as it seems to not meet the city standard; curb height plus 2% from top of curb to back of sidewalk.

New Mexico 87103

If you have any questions, you can contact me at 924-3999.

www.cabq.gov

Sincerely.

Shahab Biazar, P.E. City Engineer, Planning Dept. Development Review Services

MA/SB

Albuquerque - Making History 1706-2006



City of Albuquerque

Planning Department

Development & Building Services Division

DRAINAGE AND TRANSPORTATION INFORMATION SHEET

(REV 02/2013)

Project Title:	Building Permit #:	City Drainage #:
DRB#: EPC#:		Work Order#:
Legal Description:		
City Address:		
Engineering Firm:		Contact:
Address:		
Phone#: Fax#:		E-mail:
Owner:		Contact:
Address:		
Phone#: Fax#:		E-mail:
Architect:		Contact:
Address:		
Phone#: Fax#:		E-mail:
Surveyor:		Contact:
Address:		
Phone#: Fax#:		E-mail:
Contractor:		Contact:
Address:		
Phone#: Fax#:		E-mail:
TYPE OF SUBMITTAL:	CHECK TYPE OF APPROV	AL/ACCEPTANCE SOUGHT:
DRAINAGE REPORT	SIA/FINANCIAL GUARAN	TEE RELEASE
DRAINAGE PLAN 1st SUBMITTAL	PRELIMINARY PLAT APPI	ROVAL
DRAINAGE PLAN RESUBMITTAL	S. DEV. PLAN FOR SUB'D	APPROVAL
CONCEPTUAL G & D PLAN	S. DEV. FOR BLDG. PERMI	IT APPROVAL
GRADING PLAN	SECTOR PLAN APPROVAL	_
EROSION & SEDIMENT CONTROL PLAN (ESC)	FINAL PLAT APPROVAL	
ENGINEER'S CERT (HYDROLOGY)	CERTIFICATE OF OCCUPA	ANCY (PERM)
CLOMR/LOMR	CERTIFICATE OF OCCUPA	ANCY (TCL TEMP)
TRAFFIC CIRCULATION LAYOUT (TCL)	FOUNDATION PERMIT AP	PROVAL
ENGINEER'S CERT (TCL)	BUILDING PERMIT APPRO	DVAL
ENGINEER'S CERT (DRB SITE PLAN)	GRADING PERMIT APPRO	VAL SO-19 APPROVAL
ENGINEER'S CERT (ESC)	PAVING PERMIT APPROV	AL ESC PERMIT APPROVAL
SO-19	WORK ORDER APPROVAL	ESC CERT. ACCEPTANCE
OTHER (SPECIFY)	GRADING CERTIFICATION	N OTHER (SPECIFY)
WAS A PRE-DESIGN CONFERENCE ATTENDED:	Yes No Co	ppy Provided
DATE SUBMITTED:	By:	

Requests for approvals of Site Development Plans and/or Subdivision Plats shall be accompanied by a drainage submittal. The particular nature, location, and scope to the proposed development defines the degree of drainage detail. One or more of the following levels of submittal may be required based on the following

1. Conceptual Grading and Drainage Plan: Required for approval of Site Development Plans greater than five (5) acres and Sector Plans

2. Drainage Plans: Required for building permits, grading permits, paving permits and site plans less than five (5) acres

3. **Drainage Report**: Required for subdivision containing more than ten (10) lots or constituting five (5) acres or more

4. Erosion and Sediment Control Plan: Required for any new development and redevelopment site with 1-acre or more of land disturbing area, including project less than 1-acre than are part of a larger common plan of development



December 15, 2016

Hydrology Development City of Albuquerque PO Box 1293 Albuquerque, NM 87103


Re: Carmel Ridge Subdivision - Grading Plan

We are requesting a review of the attached plan in support of the Preliminary Plat and Grading Permit of Carmel Ridge Subdivision. The subdivision is a replat of "Lot 29 Block 3 Unit 3 Tract 2 of North Albuquerque Acres" and is located at 9154 Carmel Ave. east of Ventura. The plan covers the impact of the development on existing drainage infrastructure. We are requesting a review for compliance with City requirements.

Please contact me at 410-1622 or via email if you have any questions or comments.

Sincerely,

Ron E. Hensley P.E. ron@thegroup.cc

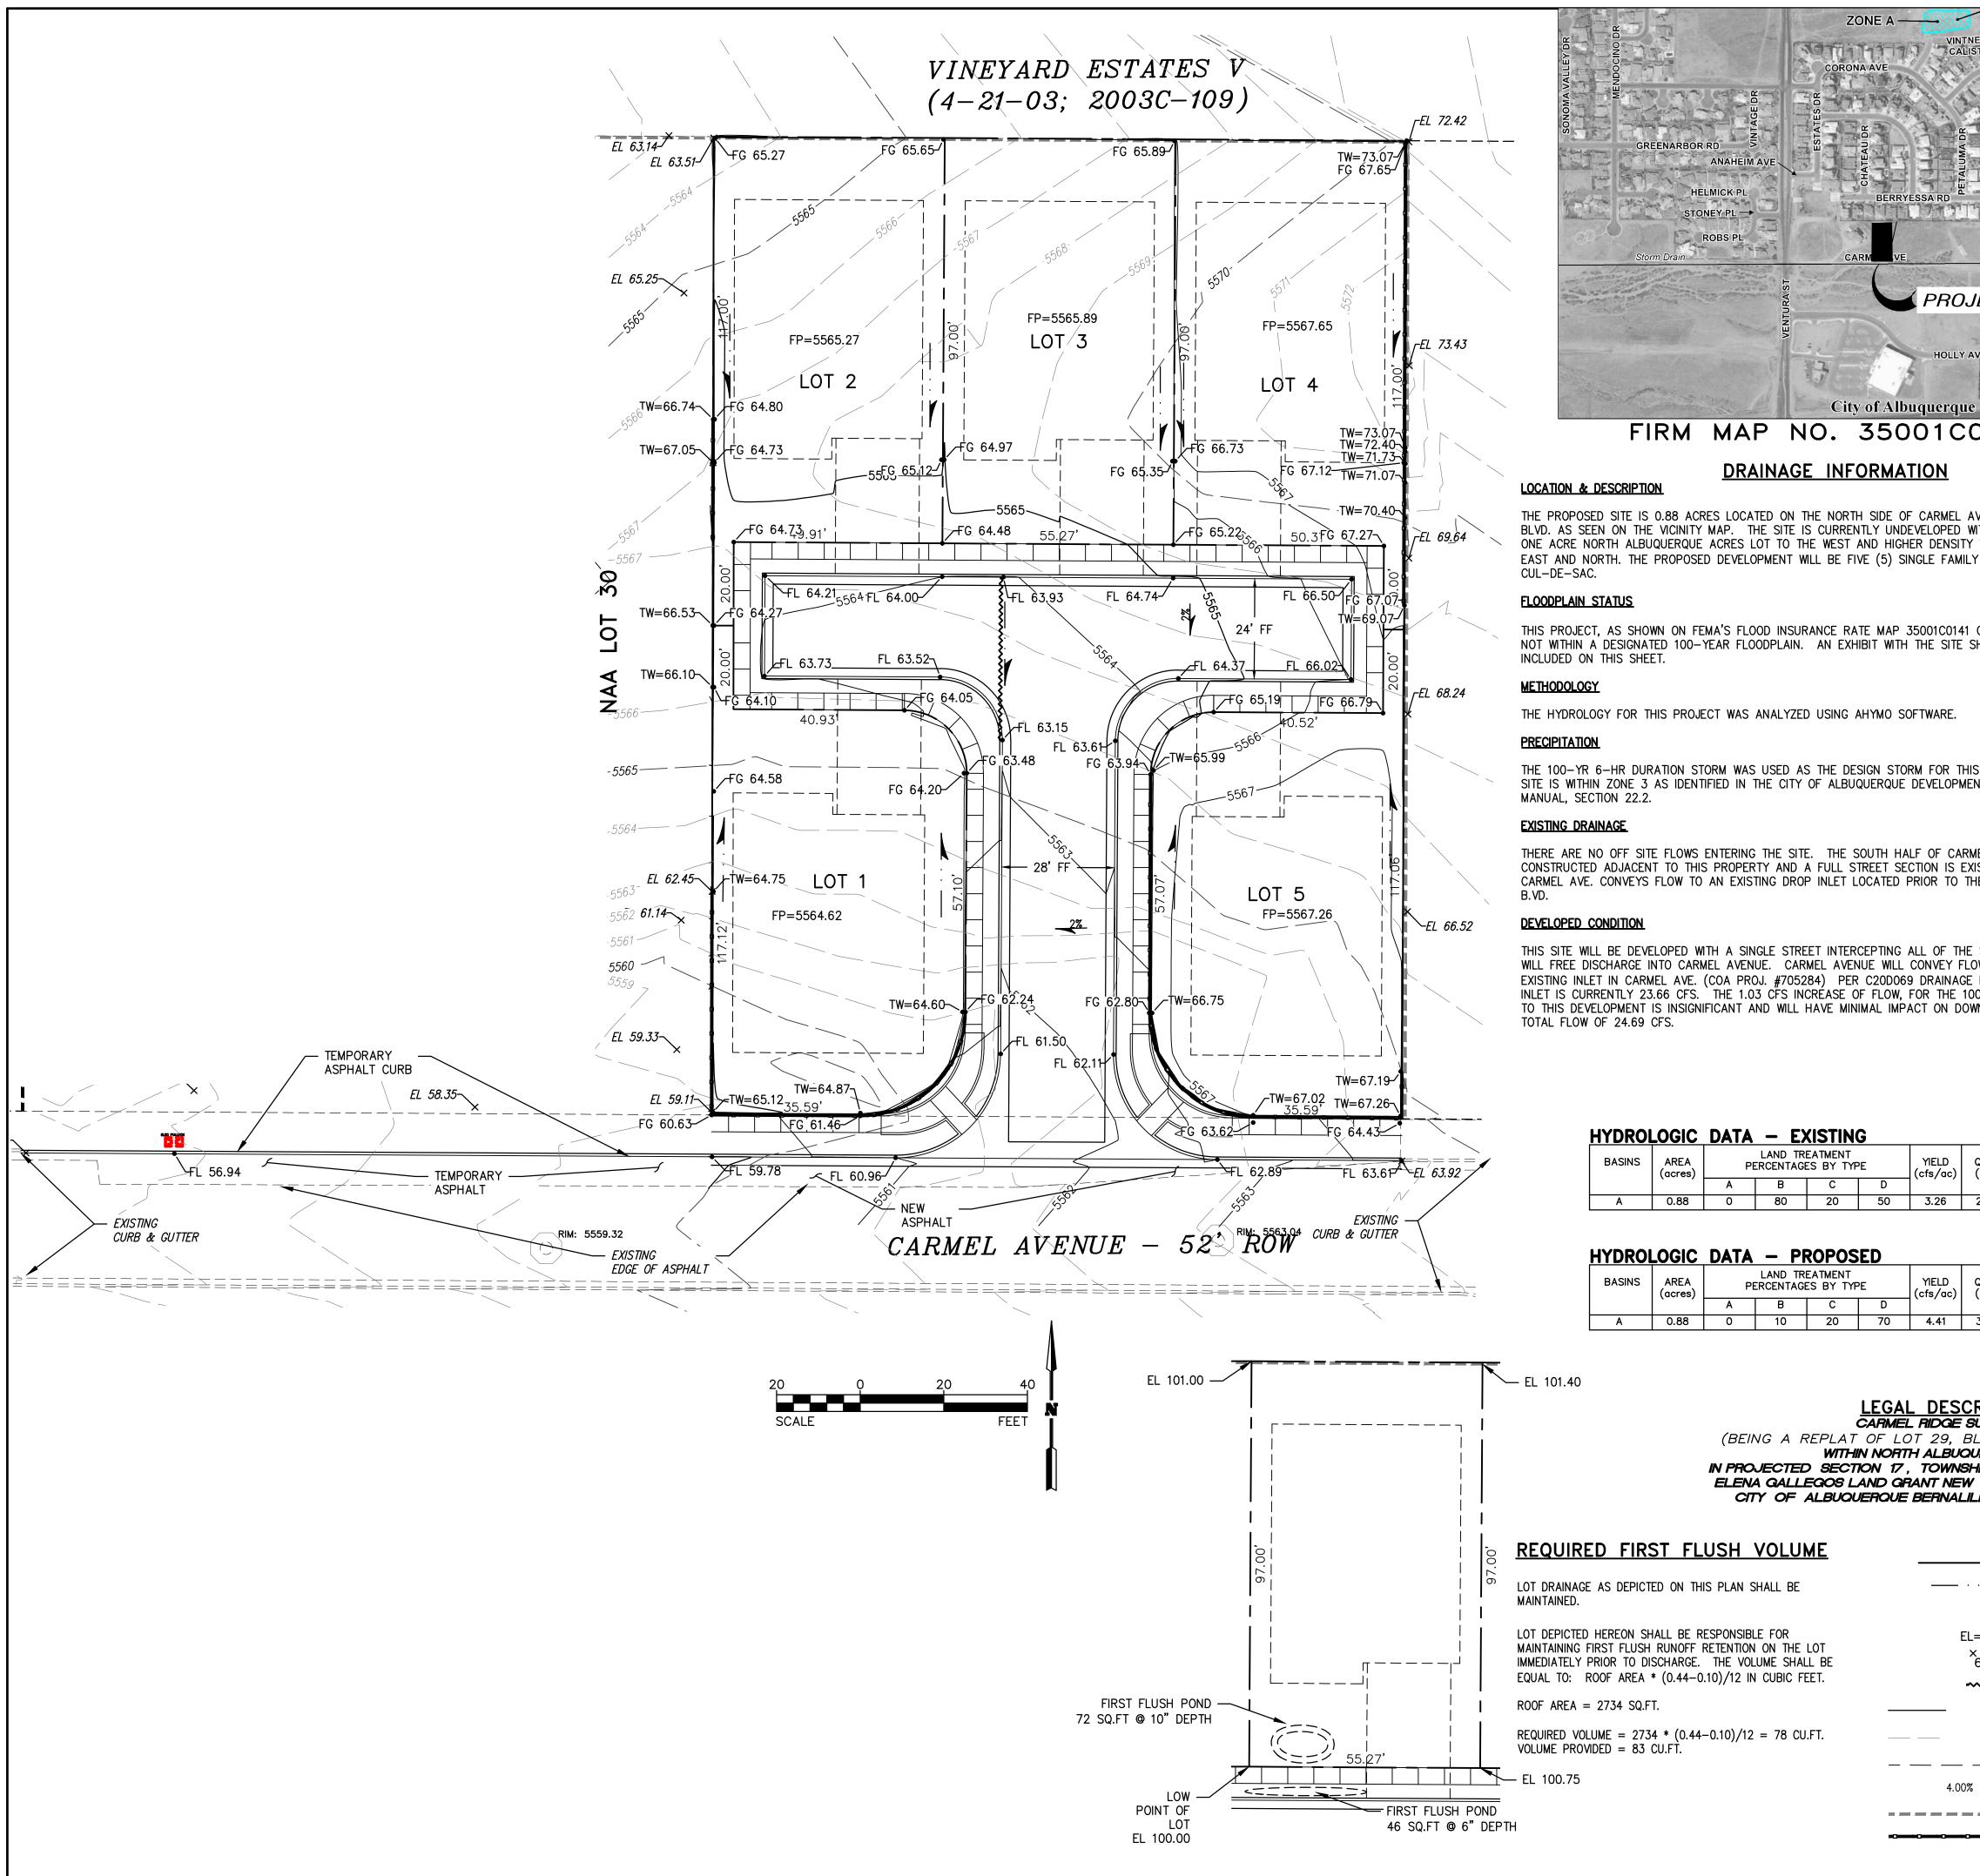

BASINS	AREA (acres)	PE	YIELD (cfs/ac)				
	. ,	Α	В	С	D		
A	0.88	0	80	20	50	3.26	Γ

BASINS	AREA (acres)	PE	YIELD (cfs/ac)			
		A	В	С	D	
A	0.88	0	10	20	70	4.41

(BEING A REPLAT OF LOT 29, BI WITHIN NORTH ALBUQU

	R-D 5 DU/A (UNIT 3) TRACT 3 ¹⁷	32 (14)		17 17	2				NO			٦
	9 5 DU/AC 14 15 20 0 0 16 HAMPION AV 38 5 0 0 31 R-D 38 6 16 10 0 0 DESERTIVISTA 46 9 16 15 ASHION 0 15 ASHION 0 15	1 NORTH		A-1 ¹⁶ 16	A TIO		DATE	DATE	A 7/	DATE		
	7 5 DU/A 11 A 10 52 53 53 54 57 R.D 51 51 52 53 57 7 R.D 51 51 52 53 55 57 52 53 56 57 57 56 57 57 57 57 57 57 57 57 57 57 57 57 57		ERQUE	AV	ORM				IFORM.			
	$\begin{array}{c ccccccccccccccccccccccccccccccccccc$	R+D VINE YARD 21 RD 21/7 22 COROMA AV 12	CORONA	A-1 17 17	T INF				N N			
	VINEYARD 46 45	96 \$34044 From \$2,217 From \$2,	ACRES	A-1 16 18 A-1 17 DEL ARROYO C	BUIL	ъ		i i c	$\frac{1}{2}$	BY		
	ESTATES 1- 6 3/ LA CJEWA 221 11 HELMICK R 222 4 5 5 17 4 R R85 R	AVAHEMIAV 134 134 139 139 130 134 134 134 134 134 134 134 134	ANAHEIM	AV AV	AS	CONTRACTO	K KED BY ECTOR'S	D FICATION WINGS		ECORDED 1		
	20 11 ERRA 18 28 20 20 20 20 20 20 20 20 20 20	TR 3 UNIT 3 PO 3 4 P P 4P 3P 4P 3P 4P 3P 3P 3P 4P 3P 4P 3P 4P 3P 4P 4P 3P 4P 4P 3P 4P	6 7 18	17 I7 I7		CON	STAK INSPI	VERIFI DRAWI		REC	NO.	
IECT SITE AL CHA	WY a b b b b b b c b c b c b c b c c b c <thc< th=""> c <thc< th=""> <thc< th=""></thc<></thc<></thc<>			31 42 43 1008555 12 8-D 4D 51 8 9 51 8 9 1008555 12 9 1008555 12 1008555 12 10085555 12 1008555 12 1008555 12 10085555 12 100855555 12 100855555 1008555555 1008555555 1008555555 10085555555 1008555555 10085555555 10085555555 1008555555 10085555555 100855555555555555555555555555555555555		LEFT	0	OF	· OF A			
R-D VENTU	RA PLACE	SU-1/C-1 SU-1/C-1 SU-1/C-1 SU-2/MIXED USE ALBUQUERQUE ACRES TR SUNITI 3 BUNITI 3	DESERT RIDGE OFFICE PARK A 1002277	AV 1 1 47 144 200 15A 10002781 78		-	MILES	T BACK OF	NORTHWEST		(NAD 83)	
0) 3A 1002533 PASEO	6 4		TAGE HILLS EAST			Ч. ИЦ	1.0	HE A	NOR	BM	88	
D141G	VENTURA	NITY MAP C-20		37 TH 15	IRKS	BOULEVARD	Boulevard Hmark is A	L L L L		D "ACS	547745.	
	<u>NOTES</u>				H MA		一六	E TOP OI	\square	STAMPED	Υ=1	
VENUE EAST OF VENTURA	LOCATION, DEF LINES, MAKES	R HAS UNDERTAKEN LIMITED FIELD PTH, SIZE, OR TYPE OF EXISTING UNO REPRESENTATION PERTAINING Y OR LIABILITY THEREFORE. THE	JNDERGROUN THERETO ANI		ENC	WYOMING	처럼	D TO THE	TO AVENUE	LID,	7745.03	1988)
ITH A TYPICAL DEVELOPED WALLED COMMUNITIES TO THE Y RESIDENTIAL LOTS ON A	ITSELF OF THE THE WORK IN CONTRACTOR I	E LOCATION OF ANY UTILITY LINE I ADVANCE OF AND DURING EXCAVA IS FULLY RESPONSIBLE FOR ANY A	N OR NEAR TION WORK. AND ALL DAM	IAGE CAUSED			TH ON NE.	DISK EPOXIED WYOMING BOUL	NE OF MODEST	NHOLE		, UAVD
T RESIDENTIAL LOTS ON A	EXISTING UTILI STATUTES, M	RE TO LOCATE, IDENTIFY, AND PRE TIES. THE CONTRACTOR SHALL CO UNICIPAL AND LOCAL ORDINANCES, D THE LOCATION OF THESE LINES	OMPLY WITH RULES AND	STATE REGULATIONS		20-C18"	TRAVEL NORTH STO AVENUE NI	VYOMIN	E OF M	SEWER M/	89"	48
G, DATED APRIL 2, 2002 IS	PLANNING AND) CONDUCTING EXCAVATION, WHETH E UTILITIES, COMPLYING WITH "BLUE	ER BY CALLI	NG OR		S BM 2	TRAVE ESTO /	METALLIC DIS CURB OF WY	TERLINE	RM SEV	-C18".19	ELEV=5393.
SHOWN ON THE FIRM PANEL IS		NGS DO NOT INCLUDE NECESSARY N SAFETY WHICH SHALL REMAIN TH					E AND MOD	MET, CURI	CEN	STO	20-	
	THIS DOCUMEN ARE INTENDED	NT, AND THE IDEAS AND DESIGNS) FOR USE ON THIS PROJECT AND	IS NOT TO	BE USED, IN			DATE					
	AUTHORIZATION	PART, FOR ANY OTHER PROJECT N OF GND ENGINEERING, LLC IN TI) USE, THE USER ASSUMES ALL R TS	HE EVENT OF	.	NOIT \							
S ANALYSIS. THIS NT PROCESS	<u>GENERAL</u>		O BE PERF	ORMED	ORMA	OTES						
	UNDER THIS PROVIDED HE	CONTRACT SHALL, EXCEPT AS EREIN, BE CONSTRUCTED IN AC UQUERQUE STANDARD SPECIFIC	OTHERWISE CORDANCE	STATED OR WITH THE	INF(Z	≻ m					
MEL AVE. HAS BEEN SISTING EAST OF THE SITE.	WORKS CONS	STRUCTION, 1986 EDITION, UPD	ATE NO 8.		PEY							
HE INTERSECTION OF VENTURA	MINIMUM REC	COMMENDED. THE OWNER IS EN E EROSION RESISTANT LANDSC.	COURAGED APING ON A	TO AREAS WHERE	SUR							
SITE RUNOFF. THE RUNOFF	IS RESPONSIE EROSION CON	Y OCCUR SUCH AS SLOPES AN BLE FOR THE INSTALLATION AN NTROL FEATURES NECESSARY	ID MAINTEN	ANCE OF ALL			Ö N N		6			
DW ALONG THE CURB TO A PLAN, THE FLOW TO THE DO-YEAR PEAK RUNOFF, DUE	3. THE DRAIN	NT OF THE GRADING PLAN. NAGE INFRASTRUCTURE SHOWN	ON THIS F	PLAN IS THE	AL				Play		•	
WNSTREAM FACILITIES WITH A	4. ALL DISTU	TY OF THE PROPERTY OWNER. JRBED AREAS OUTSIDE THE BU	ILDING PAD	MUST BE	S SE		(SI	Y + CO + NO	10 DEFE	AL N	1 V	017
		R LANDSCAPED WORKING DAYS PRIOR TO ANY	FXCAVATION	۷.	<u>`</u>		I (5	ž (20	N)	L'un	N 19	
	CONTRACTOR	MUST CONTACT LINE LOCATING N OF EXISTING UTILITIES.		(260–1990)	ENGINEER		10	NNN	K	\$ 5]		•
	AND VERIFY	CONSTRUCTION, THE CONTRACT THE HORIZONTAL AND VERTICAL	LOCATION	S OF ALL	E			<u>v</u>	X			
Q100 V100-24 (cfs) (acft)	EXIST, THE C SURVEYOR S	NS AND EXISTING PAVEMENT. SHOULD A CONFLICT CONTRACTOR SHALL NOTIFY THE ENGINEER OR SO THAT THE CONFLICT CAN BE RESOLVED WITH A						B		2016	2016	016
2.87 0.089		N CONTROL NOTES								EC. 2(ن	ن
	DISTURBA	TOR IS RESPONSIBLE FOR OBTAIN NCE PERMIT PRIOR TO BEGINNI	NG WORK.							\Box		DATE DE
Q100 V100-24 (cfs) (acft)		TOR IS RESPONSIBLE FOR MAIN ING CONSTRUCTION.	ITAINING RU	JN-OFF ON						D/	D	D
3.90 0.147		TOR IS RESPONSIBLE FOR CLEA S INTO EXISTING RIGHT-OF-W		SEDIMENT				NKS NKS				
4. REPAIR OF DAMAGED FACILITIES AND CLEANUP ACCUMULATIONS ON ADJACENT PROPERTIES AN FACILITES IS THE RESPONSIBILITY OF THE CON			TIES AND IN	N PUBLIC				<u>REMARKS</u>	SIGN			
RIPTION SUBDIVISION	5. ALL EXPO	SED EARTH SURFACES MUST E	BE PROTECT	TED FROM				RF VI	DE			
LOCK 3, UNIT 3, TRACT 2) U ERQUE ACRES HIP 11 NORTH , RANGE 4 EAST	OF ANY F) WATER EROSION PRIOR TO FI PROJECT.	NAL (CITT)	ACCEPTANCE								
' MEXICO PRINCIPAL MERIDIAN LLO COUNTY, NEW MEXICO		Γ								REH	REH	REH
LEGEND		THE G 300 Branding	-	SF				DATE		D BY		ΒY
FLOW ARROW		Rio Rancho, New	Mexico 8					NO.		Щ	DRAWN	CHECKED
SLOPE ARROW	Phone:(505)514-0995 CITY OF ALBUQUEF PUBLIC WORKS DEPA									ī	Ō	Ō
=11.28 PROPOSED ELEVATION	PUBLIC WORKS DEPA ENGINEERING DEVELOPME CARMEL RIDGE SUB BEING A REPLAT OF LOT 29, BLOCK 3 GRADING & DRAINAG				١T	GR	DUP					\square
GRADE BREAK					U	NIT	3,	TRAC	T 2	2, N		۷
				EER APPROVAL			No./DA	Y/YR.	м	o./D/	4Y/Y	ſR.
						IGN UPDATE						
EXISTING WALL						AST DESIGN						
DRB No.		CITY PROJECT No.		ZONE MAP I	10.		SHEE	T 1	0	F	1	\neg
I				C - 20 -	- /			L			L	