

CITY OF ALBUQUERQUE

Planning Department
Brennon Williams, Director



Mayor Timothy M. Keller

March 29, 2021

Graeme Means, P.E.
High Mesa Consulting Group
6010-B Midway Park Blvd.
Albuquerque, NM 87109

RE: Amaran Senior Living
9100 Holly Ave. NE
Permanent C.O. - Approved
Engineer's Certification Date: 3/23/21
Engineer's Stamp Date: 4/15/19
Hydrology File: C20D079

Dear Mr. Means:

PO Box 1293

Based on the certification received 3/25/21 and a site visit on 3/26/21, this certification is approved for Permanent Certificate of Occupancy by Hydrology.

Albuquerque

If you have any questions, please contact me at 924-3986 or earmijo@cabq.gov.

NM 87103

Sincerely,

www.cabq.gov

Ernest Armijo, P.E.
Principal Engineer, Planning Dept.
Development Review Services



City of Albuquerque

Planning Department
Development & Building Services Division

DRAINAGE AND TRANSPORTATION INFORMATION SHEET (REV 6/2018)

Project Title: _____ **Building Permit #:** _____ **Hydrology File #:** _____

DRB#: _____ **EPC#:** _____ **Work Order#:** _____

Legal Description: _____

City Address: _____

Applicant: _____ **Contact:** _____

Address: _____

Phone#: _____ **Fax#:** _____ **E-mail:** _____

Other Contact: _____ **Contact:** _____

Address: _____

Phone#: _____ **Fax#:** _____ **E-mail:** _____

TYPE OF DEVELOPMENT: _____ PLAT (# of lots) _____ RESIDENCE _____ DRB SITE _____ ADMIN SITE

IS THIS A RESUBMITTAL? _____ Yes _____ No

DEPARTMENT _____ TRANSPORTATION _____ HYDROLOGY/DRAINAGE

Check all that Apply:

TYPE OF SUBMITTAL:

- _____ ENGINEER/ARCHITECT CERTIFICATION
- _____ PAD CERTIFICATION
- _____ CONCEPTUAL G & D PLAN
- _____ GRADING PLAN
- _____ DRAINAGE REPORT
- _____ DRAINAGE MASTER PLAN
- _____ FLOODPLAIN DEVELOPMENT PERMIT APPLIC
- _____ ELEVATION CERTIFICATE
- _____ CLOMR/LOMR
- _____ TRAFFIC CIRCULATION LAYOUT (TCL)
- _____ TRAFFIC IMPACT STUDY (TIS)
- _____ STREET LIGHT LAYOUT
- _____ OTHER (SPECIFY) _____
- _____ PRE-DESIGN MEETING?

TYPE OF APPROVAL/ACCEPTANCE SOUGHT:

- _____ BUILDING PERMIT APPROVAL
- _____ CERTIFICATE OF OCCUPANCY
- _____ PRELIMINARY PLAT APPROVAL
- _____ SITE PLAN FOR SUB'D APPROVAL
- _____ SITE PLAN FOR BLDG. PERMIT APPROVAL
- _____ FINAL PLAT APPROVAL
- _____ SIA/ RELEASE OF FINANCIAL GUARANTEE
- _____ FOUNDATION PERMIT APPROVAL
- _____ GRADING PERMIT APPROVAL
- _____ SO-19 APPROVAL
- _____ PAVING PERMIT APPROVAL
- _____ GRADING/ PAD CERTIFICATION
- _____ WORK ORDER APPROVAL
- _____ CLOMR/LOMR
- _____ FLOODPLAIN DEVELOPMENT PERMIT
- _____ OTHER (SPECIFY) _____

DATE SUBMITTED: _____ **By:** _____

COA STAFF:

ELECTRONIC SUBMITTAL RECEIVED: _____

FEE PAID: _____

**DEKKER
PERICH
SABATINI**

7601 JEFFERSON NE, SUITE 100
ALBUQUERQUE, NM 87109

505.761.9700 / DPSDESIGN.ORG

ARCHITECT

CONSTRUCTION NOTES:

- TWO (2) WORKING DAYS PRIOR TO ANY EXCAVATION, CONTRACTOR MUST CONTACT NEW MEXICO ONE CALL SYSTEM, 811, FOR DESIGNATION (LINE-SPOTTING) OF EXISTING UTILITIES.
- PRIOR TO CONSTRUCTION, THE CONTRACTOR SHALL EXCAVATE AND VERIFY THE HORIZONTAL AND VERTICAL LOCATION OF ALL POTENTIAL OBSTRUCTIONS. SHOULD A CONFLICT EXIST, THE CONTRACTOR SHALL NOTIFY THE ENGINEER IN WRITING SO THAT THE CONFLICT CAN BE RESOLVED WITH A MINIMUM AMOUNT OF DELAY. THE CONTRACTOR SHALL BE RESPONSIBLE FOR ALL INTERPRETATIONS IT MAKES WITHOUT FIRST CONTACTING THE ENGINEER AS REQUIRED ABOVE.
- ALL WORK ON THIS PROJECT SHALL BE PERFORMED IN ACCORDANCE WITH APPLICABLE FEDERAL, STATE AND LOCAL LAWS, RULES AND REGULATIONS CONCERNING CONSTRUCTION SAFETY AND HEALTH.
- ALL CONSTRUCTION WITHIN PUBLIC RIGHT-OF-WAY SHALL BE PERFORMED IN ACCORDANCE WITH APPLICABLE CITY OF ALBUQUERQUE STANDARDS AND PROCEDURES.
- UTILITY INFORMATION SHOWN HEREON IS BASED UPON ONSITE SURFACE EVIDENCE, REVIEW OF AVAILABLE ABCWUA AND CITY OF ALBUQUERQUE RECORD DRAWINGS AND DISTRIBUTION MAPS AND UTILITY LINE-SPOTS PROVIDED BY HIGH MESA CONSULTING GROUP (2016.059.1 AND 2016.059.2). IN ADDITION, UTILITY LINE-SPOTS WERE REQUESTED VIA THE NEW MEXICO ONE CALL SERVICE (TICKET NOS. 16DE200007 AND 17AP210205). UTILITY LINES THAT APPEAR ON THESE DRAWINGS ARE SHOWN IN AN APPROXIMATE MANNER AND SUCH LINES MAY EXIST WHERE NONE ARE SHOWN. IF ANY SUCH EXISTING LINES ARE SHOWN, THE LOCATION IS BASED UPON INFORMATION PROVIDED BY THE OWNER OF SAID UTILITY, AND THE INFORMATION MAY BE INCOMPLETE, OR MAY BE OBSOLETE BY THE TIME CONSTRUCTION COMMENCES. THE ENGINEER HAS CONDUCTED ONLY A PRELIMINARY INVESTIGATION OF THE LOCATION, DEPTH, SIZE, OR TYPE OF EXISTING UTILITY LINES, PIPELINES, OR UNDERGROUND UTILITY LINES. THIS INVESTIGATION IS NOT CONCLUSIVE, AND MAY NOT BE COMPLETE, THEREFORE, MAKES NO REPRESENTATION PERTAINING THERETO, AND ASSUMES NO RESPONSIBILITY OR LIABILITY THEREFOR. THE CONTRACTOR SHALL INFORM ITSELF OF THE LOCATION OF ANY UTILITY LINE, PIPELINE, OR UNDERGROUND UTILITY LINE IN OR NEAR THE AREA OF THE WORK IN ADVANCE OF AND DURING EXCAVATION WORK. THE CONTRACTOR IS FULLY RESPONSIBLE FOR ANY AND ALL DAMAGE CAUSED BY ITS FAILURE TO LOCATE, IDENTIFY AND PRESERVE ANY AND ALL EXISTING UTILITIES, PIPELINES, AND UNDERGROUND UTILITY LINES. IN PLANNING AND CONDUCTING EXCAVATION, THE CONTRACTOR SHALL COMPLY WITH STATE STATUTES, MUNICIPAL AND LOCAL ORDINANCES, RULES AND REGULATIONS, IF ANY, PERTAINING TO THE LOCATION OF THESE LINES AND FACILITIES.
- THE DESIGN OF PLANTERS AND LANDSCAPED AREAS IS NOT PART OF THIS PLAN. ALL PLANTERS AND LANDSCAPED AREAS ADJACENT TO THE BUILDING(S) SHALL BE PROVIDED WITH POSITIVE DRAINAGE TO AVOID ANY PONDING ADJACENT TO THE STRUCTURE. FOR CONSTRUCTION DETAILS, REFER TO LANDSCAPING PLAN.
- THE GRADES INDICATED ON THIS PLAN ARE FINISHED GRADES UNLESS OTHERWISE INDICATED. THE CONTRACTOR SHALL BE RESPONSIBLE FOR LEAVING SUBGRADE AT ELEVATIONS THAT SHALL ACCOMMODATE PROPOSED IMPROVEMENTS AS INDICATED ON THE PLANS INCLUDING, BUT NOT LIMITED TO, SURFACE DRAINAGE STRUCTURES, PAVING AND LANDSCAPING SURFACING.
- CONTRACTOR SHALL REFER TO GEOTECHNICAL REPORT FOR EARTHWORK REQUIREMENTS, AS APPLICABLE.

KEYED NOTES:

- CONSTRUCT 4' DIA. STORM DRAIN MANHOLE
- CONSTRUCT SINGLE 'D' STORM DRAIN INLET
- CONSTRUCT SINGLE TYPE 'C' STORM DRAIN INLET
- CONSTRUCT 24"x24" STORM DRAIN INLET
- INSTALL 8" HDPE STORM DRAIN
- INSTALL 12" HDPE STORM DRAIN
- INSTALL 18" HDPE STORM DRAIN
- NEW 2'-0" CURB CUT PER STANDARD SECTION, CP501
- CONSTRUCT 16" WIDE CONCRETE RUNDOWN
- DEPRESSED LANDSCAPING FOR WATER QUALITY
- NEW REFUSE DRAIN. SEE CONCEPTUAL UTILITY PLAN
- HOLLY IMPROVEMENTS TO BE CONSTRUCTED BY WORK ORDER
- NEW 4" WALL OPENING. ALIGN OPENING WITH SIDEWALK CULVERT
- NEW SCREEN WALL
- NEW REFUSE WALL
- NEW RETAINING WALL
- INSTALL SIDEWALK CULVERT. INVERT TO MATCH ROOF DRAIN DOWN SPOUT OR WALL OPENING
- NEW COBBLES FOR SLOPE PROTECTION
- EXTEND 3" STORM DRAIN LINE FROM HYDRODUCT COIL SYSTEM TO INLET
- INSTALL 12" HEAVY DUTY DRAIN, SEE SHEET CU101 FOR CONTINUATION
- INSTALL 15" HDPE STORM DRAIN
- INSTALL NEW SIDEWALK CULVERT WITH DECORATIVE GRATED LID. ALIGN WITH WALL OPENING.

NOTE:

THIS IS NOT A BOUNDARY SURVEY OR RIGHT-OF-WAY SURVEY. APPARENT PROPERTY CORNERS, RIGHT-OF-WAY LINES OR PROPERTY LINES AS SHOWN ARE DERIVED FROM THE PLAT OF RECORD (2018C-0148, #2018103144, RECORDED 11-29-2018) PREPARED BY HIGH MESA CONSULTING GROUP, NMPS 11184, DATED 11/06/2018 (2016.059.5) AND IS NOT GUARANTEED OR TO BE RELIED ON FOR THE ESTABLISHMENT OF PROPERTY LINES.

THE TOPOGRAPHIC AND UTILITY INFORMATION DEPICTED HEREON IS BASED UPON THE EXISTING TOPOGRAPHIC AND UTILITY SURVEY PREPARED BY THIS FIRM, NMPS NO. 11184, DATED 01/10/2017 (2016.059.1).

2018.027.1

**HIGH
MESA Consulting Group**

6010-B MIDWAY PARK BLVD. NE • ALBUQUERQUE, NEW MEXICO 87109
PHONE: 505.345.4250 • FAX: 505.345.4254 • www.highmesacg.com

ENGINEER



2/15/2019 4/15/2019
PROJECT 03-23-2021

AMARAN SENIOR LIVING
9100 HOLLY AVENUE NE
ALBUQUERQUE, NM 87122

PERMIT SET

REVISIONS

△ COA HYDROLOGY COMMENTS
△ RECORD DRAWING

DRAWN BY	J.Y.R.
REVIEWED BY	G.M.
DATE	02.15.2019
PROJECT NO.	18-0038
DRAWING NAME	

GRADING AND DRAINAGE PLAN

SHEET NO.

CG101
OF

FIRST FLUSH POND GRATE CAPACITY:

HEC-22, EQUATION 4-27; $Q = CA(2GD)^{0.5}$
 $C = 0.67$, $G = 32.2$, $D = \text{DEPTH (FT)}$, $A = \text{CLEAR OPENING AREA}$
 CITY GRATE AREA = 3.72 SF (CLEAR)
 ASSUME 50% CLOGGED; NET AREA = 1.86 SF;
 USE 1.86
 $D_{MAX} = T.O.P. = 76.00 - TG 75.30 = 0.7\text{FT}$
 $Q_{CAP} = 8.36 \text{ CFS}$
 BASIN A = 9,290 SF
 $Q_{REQ} = Q_{AA} + Q_{AB} + Q_{AC} + Q_{AD}$
 $Q_{REQ} = (1.87 \times 0.00) + (2.60 \times 0.00) + (3.45 \times 0.00) + (5.02 \times 2.1) = 1.1 \text{ cfs}$
 $D_{REQ} = \left(\frac{Q}{CA} \right)^2 = 0.012 \text{ FT FOR 1.1 cfs}$
 $Q_{CAP} > Q_{REQ}$
 $D_{MAX} > D_{REQ}$

POND AS-BUILT SURVEY DETAIL

SCALE: 1" = 10'

SECTION A-A

SCALE: 1" = 5'

ENGINEER'S CERTIFICATION- PERMANENT CO

I, J. GRAEME MEANS, NMPE 13676, OF THE FIRM HIGH MESA CONSULTING GROUP HEREBY CERTIFY THAT THIS PROJECT HAS BEEN CONSTRUCTED, GRADED AND WILL DRAIN SUBSTANTIAL COMPLIANCE WITH AND IN ACCORDANCE WITH THE DESIGN INTENT OF THE APPROVED PLAN DATED 04/15/2019 WITH THE NOTED EXCEPTION OF NOT MEETING THE WATER QUALITY VOLUME SHOWN ON THE APPROVED PLANS. THE DESIGNED WATER QUALITY VOLUME TO BE RETAINED ON SITE TOTALLED TO 230 CF. AS-BUILT VOLUMES RETAINED TOTALLED TO 0 CF. DESIGNED VOLUME 230 CF - VOLUME RETAINED 0 CF = 230 CF BYPASS. A PAYMENT IN LIEU TO ADDRESS THE DIFFERENCE BETWEEN THE REQUIRED VOLUME AND THE AS-BUILT VOLUME WILL BE MADE.

THE SUPPLEMENTAL RECORD SURVEY AS-BUILT INFORMATION EDITED ONTO THE ORIGINAL DESIGN DOCUMENTS WAS OBTAINED 12/10/2020 AND 03/11/2021 BY HIGH MESA CONSULTING GROUP UNDER THE DIRECTION OF CHARLES G. CALA, JR., NMPS 11186, SUBMITTED TO SUPPORT A PERMANENT CERTIFICATE OF OCCUPANCY.

THE RECORD INFORMATION PRESENTED HEREON IS NOT NECESSARILY COMPLETE AND INTENDED ONLY TO VERIFY SUBSTANTIAL COMPLIANCE OF THE GRADING AND DRAINAGE ASPECTS OF THIS PROJECT. THIS CERTIFICATION DOES NOT ADDRESS ADA COMPLIANCE WHICH IS BEYOND THE SCOPE OF GRADING AND DRAINAGE. THOSE RELYING ON THIS RECORD DOCUMENT ARE ADVISED TO OBTAIN INDEPENDENT VERIFICATION OF ITS ACCURACY BEFORE USING IT FOR ANY OTHER PURPOSE.

J. Graeme Means
J. GRAEME MEANS, NMPE NO. 13676



03-23-2021
DATE

RECORD DRAWING LEGEND

CONSTRUCT
 RECORD INFORMATION (VERIFIED BY ENGINEER)
 AS-CONSTRUCTED = AS-DESIGNED
 (VERIFIED BY AS-BUILT SURVEY)
 RECORD INFORMATION FROM AS-BUILT SURVEY
 RECORD INFORMATION FROM AS-BUILT SURVEY
 RECORD INFORMATION FROM AS-BUILT SURVEY
 REVISION (NOT SURVEYED)

NOTE: COORDINATE STORM DRAIN INLET. CONSTRUCTION AND LAYOUT WITH WALL FOOTING CONSTRUCTION AND LAYOUT.

NOTE: COORDINATE STORM DRAIN INLET. CONSTRUCTION AND LAYOUT WITH WALL FOOTING CONSTRUCTION AND LAYOUT.


BASIN B $Q_{REQ} = 1.6 \text{ CFS}$
 DOWN STREAM $Q 12" \text{ SD } @$
 $S = 0.011 \text{ PIPE CAPACITY} = 3.7 \text{ CFS}$

NOTE: COORDINATE STORM DRAIN INLET. CONSTRUCTION AND LAYOUT WITH WALL FOOTING CONSTRUCTION AND LAYOUT.

MATCH EXISTING PAVEMENT GRADE

OVERFLOW
 OUT 87.20

SCALE: 1" = 20'

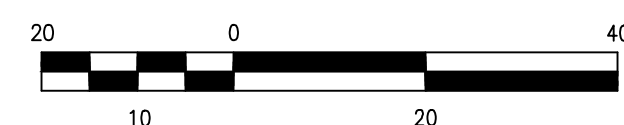

RECORD DRAWING