CITY OF ALBUQUERQUE

Planning Department Brennon Williams, Director



Mayor Timothy M. Keller

March 29, 2021

Ronald Witherspoon, R.A. Dekker/Perich/Sabatini 7601 Jefferson NE, Suite 100 Albuquerque, NM 87109

Re: Amaran Holley Senior Living 9300 Holley Ave Request for Certificate of Occupancy Transportation Development Final Inspection Engineer's/Architect's Stamp dated 2-14-19 (DRB) (C20D079) Certification dated 3-19-21

Dear Mr. Witherspoon,

- PO Box 1293 Based upon the information provided in your submittal received 3-22-21, Transportation Development has no objection to the issuance of a <u>Permanent Certificate of Occupancy</u>. This letter serves as a "green tag" from Transportation Development for a <u>Permanent Certificate of</u> <u>Occupancy</u> to be issued by the Building and Safety Division.
- Albuquerque If you have any questions, please contact Ernie Gomez at (505) 924-3981.

NM 87103

Jeanne Wolfenbarger


www.cabq.gov Jeanne \ Traffic E

Sincerely,

Jeanne Wolfenbarger, P.E. Traffic Engineer, Planning Dept. Development Review Services

Ernie Gomez Plan Checker, Planning Dept. Development Review Services

EG via: email C: CO Clerk, File

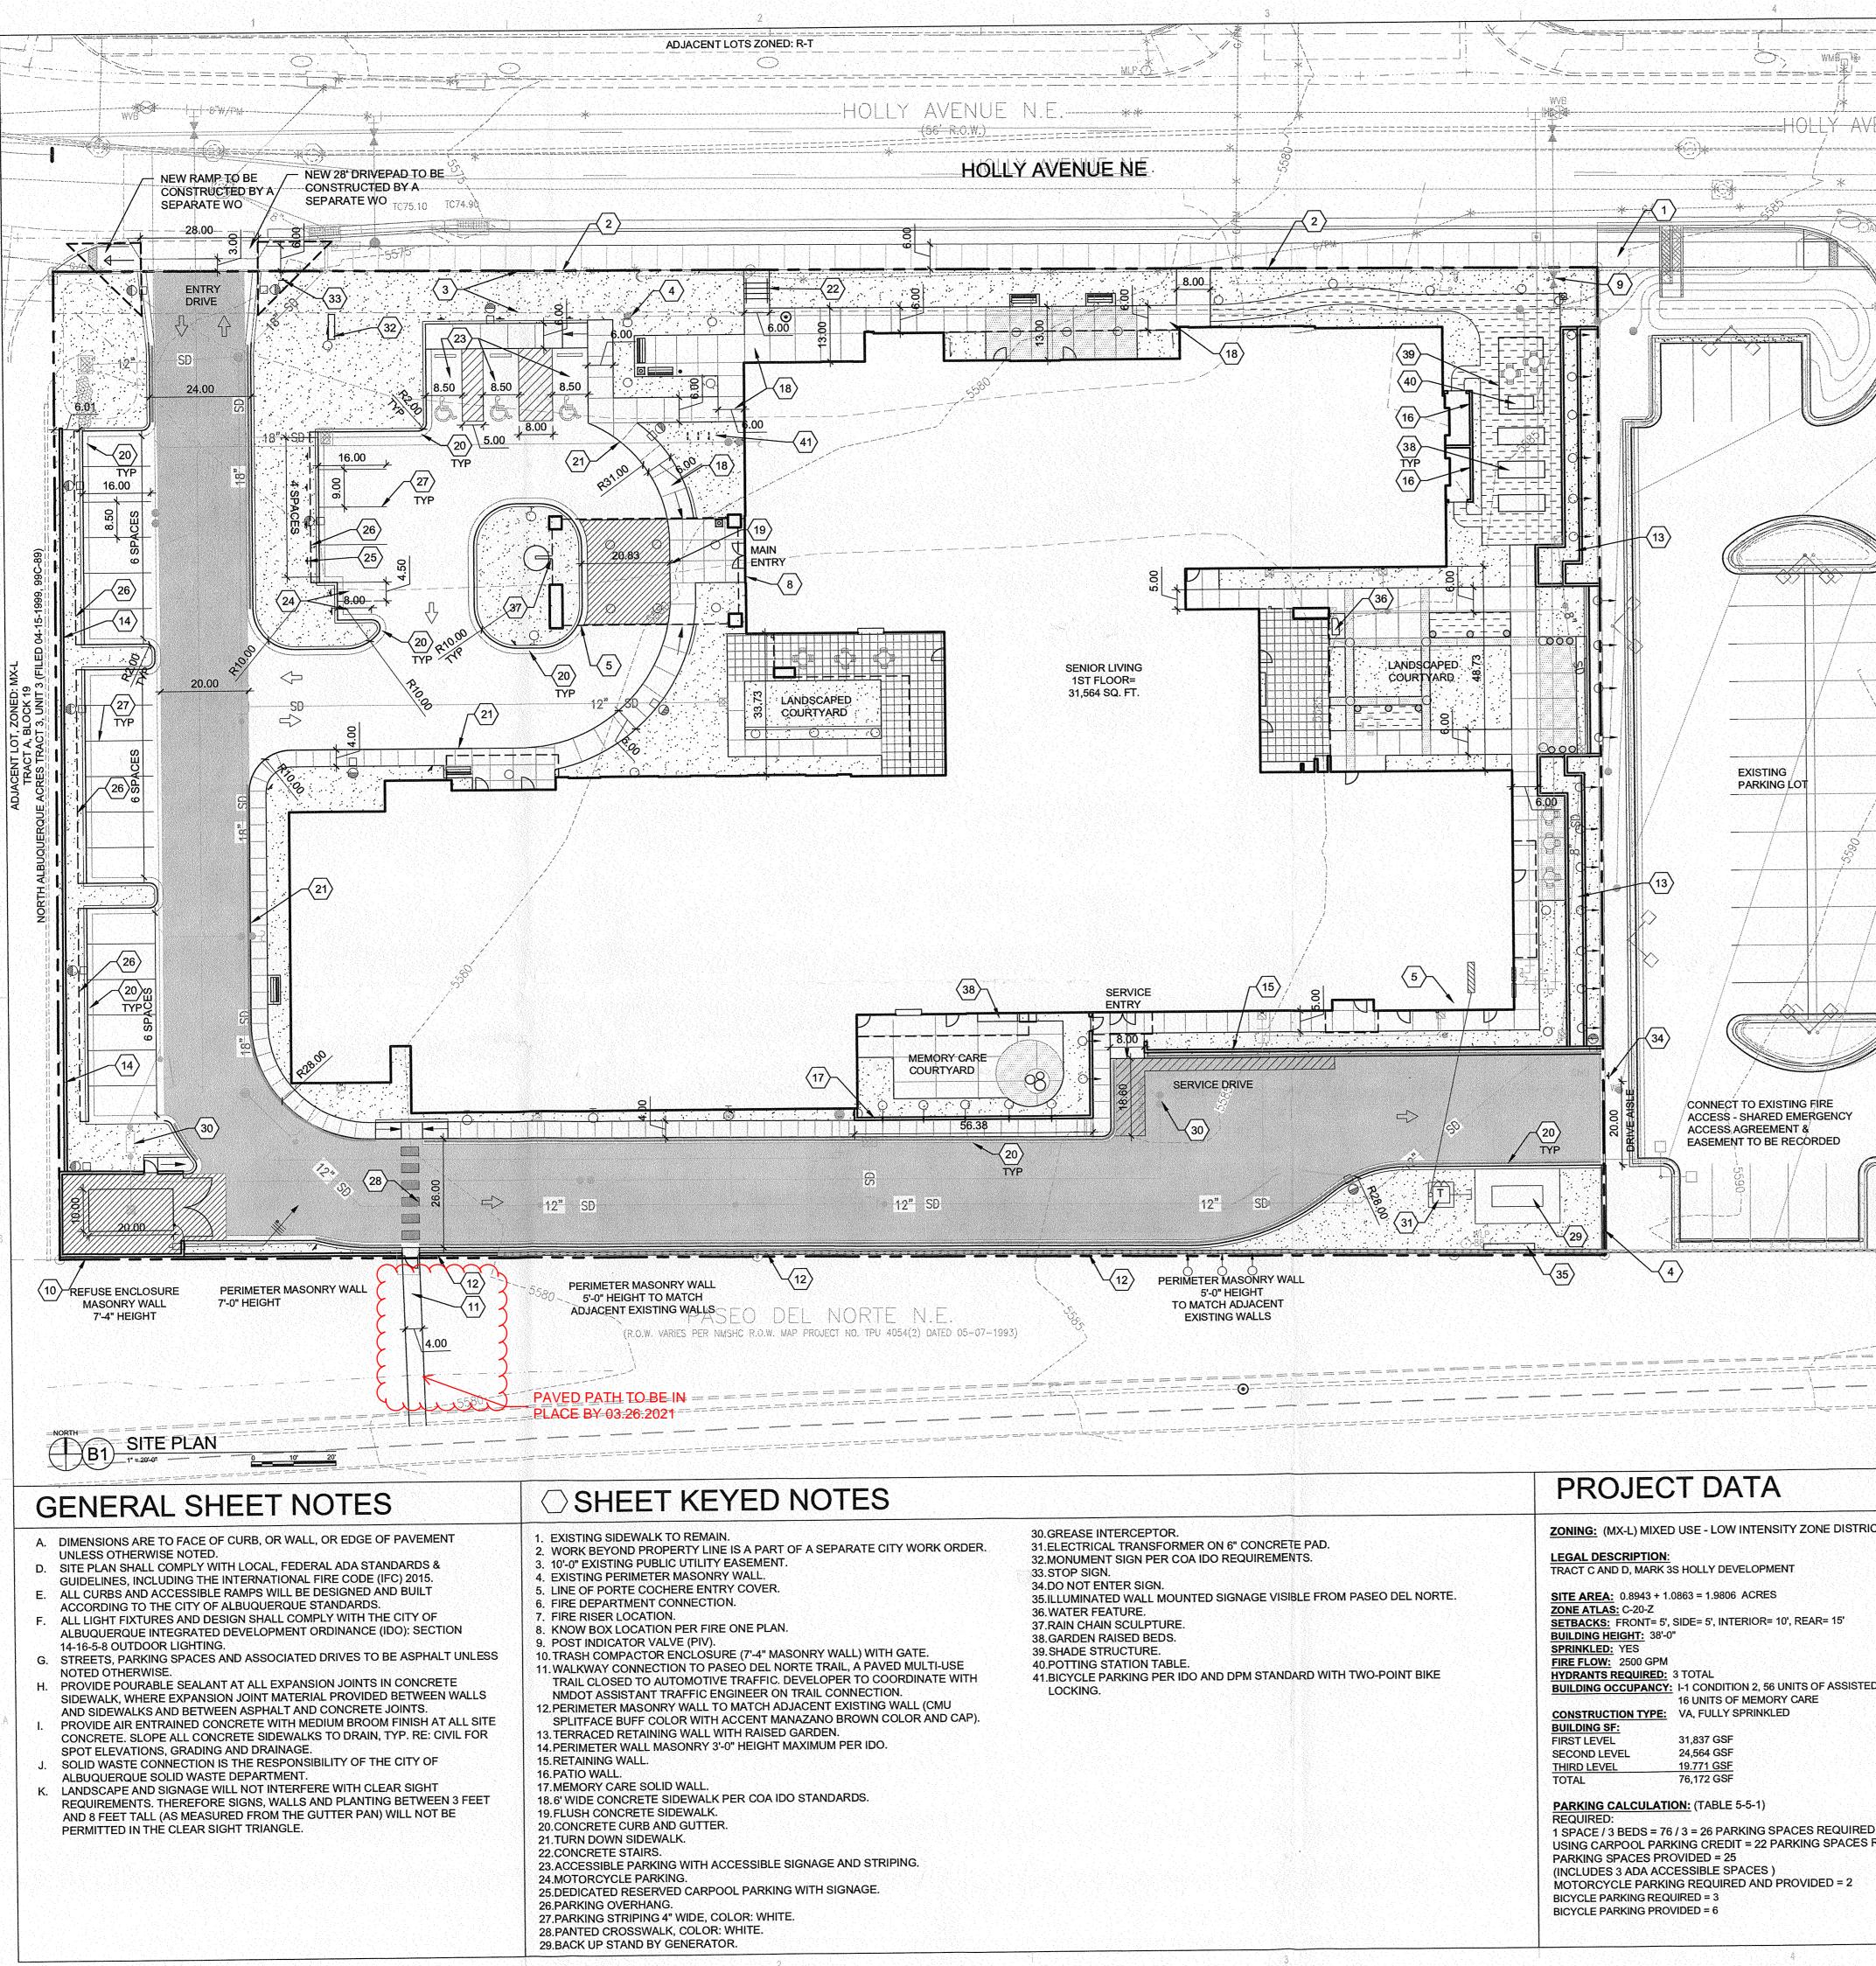

| | PD = G CARMEL | ARCHITECTURE / DESIGN / INSPIRATION |
|--|--|--|
| | $\begin{array}{c c c c c c c c c c c c c c c c c c c $ | |
| VENUE N <u>E</u> | HOLLY MX-L MX-L BUEWOOD ATAPI LA SET C R-1C R-1C R-1C R-1C R-1C R-1C R-1C R- | DEKKER |
| | AL BUOLEBOILE WARES HOLY DEVELOPMENT DESERT RIDGE | |
| | ACRES A MX-L TR 3 UNIT 3 | PERICH |
| | SITE | SABATINI |
| | DEL R-1B 22.P1 5 5 25 27 32 R-1B 37 32 R-1B 37 | |
| | REDGENELD OF RED NOS | ማረ በ1 JEFFERSON NE, SUITE 100 |
| | VICINITY MAP | 7601 JEFFERSON NE, SUITE 100 ALBUQUERQUE, NM 87109 |
| | PROJECT NO. PP- 2018.001632 | 505.761.9700 / DPSDESIGN.ORG |
| | APPLICATION NO. 91. 918.00176 | ARCHITECT |
| | IS AN APPROVED INFRASTRUCTURE LIST REQUIRED? []YES []NO. IF YES, THEN A SET OF APPROVED DRC PLANS WITH A WORK ORDER IS REQUIRED FOR ANY | |
| | CONSTRUCTION WITHIN PUBLIC RIGHT OF WAY OR FOR CONSTRUCTION OF PUBLIC IMPROVEMENTS. | |
| | DRB SITE DEVELOPMENT PLAN APPROVAL: | |
| | Rminb 2/14/19 | |
| | TRAFFIC ENGINEERING, DATE: DAT | ENGINEER |
| ADJACENT LOT ZONED: MX-L TRACT A-1 | 1/11/418 | |
| 2.4912 AC. ± | ABCWUA DATE: | |
| | NIA PARKS & RECREATION DEPARTMENT DATE: | |
| | ath 11/14/18 | PROJECT |
| $\frac{1}{5}$ | CITY ENGINEER/HYDROLOGY DATE: | |
| | NA ENVIRONMENTAL HEALTH (CONDITIONAL) DATE: | |
| | NA | |
| | SOLID WASTE MANAGEMENT DATE: 2.14.209 | Ċ |
| | DRB CHAIRPERSON, PLANNING DEPT. DATE: | UN N N N N N N N N N N N N N N N N N N |
| | 22 11/14/18 | |
| | CODE ENFORCEMENT DATE: | A S S S S S S S S S S S S S S S S S S S |
| | | N S S |
| RADIUS | | R S S S S |
| | | ALB(ALBU |
| | LEGEND | Ĕ |
| | | |
| | | |
| | | |
| | STABILIZED CRUSHER FINES, | |
| | DAVIS COLORS: SPANISH GOLD 5084 | REVISIONS |
| | REINFORCED CONCRETE PAVING | $ $ $\overline{\bigwedge}$ |
| DICT | HEAVY DUTY ASPHALT CAPABLE TO SUPPORT 75,000 LBS | $ \upharpoonright $ |
| RICT | FIRELANE STRIPING MARKING FIRE ACCESS LANE | |
| | PROPERTY LINE | DRAWN BY JE |
| | FIRE HYDRANT FIRE DEPARTMENT CONNECTION (F.D.C.) | REVIEWED BY D/P/S |
| TED LIVING | | PROJECT NO. 18-0038 |
| TED LIVING, | PLANTING POT TOURNESOL, URBAN COLLECTION MAGLIN BENCH MLB400-M-L1, COLOR BRONZE 14, SURFACE MOUNT | |
| | SEE SPECIFICATIONS MAGLIN TRASH RECEPTACLE MLWR400-25-M, COLOR BRONZE 14, OUDEACE MOUNT, SEE SPECIFICATIONS | PLAN |
| | SURFACE MOUNT, SEE SPECIFICATIONS MAGLIN ASH RECEPTACLE MLAU300-B3, COLOR BRONZE 14, OUDEACE MOUNT, SEE SPECIFICATIONS | |
| RED ES REQUIRED | SURFACE MOUNT, SEE SPECIFICATIONS MAGLIN BIKE RACKS MBR150-2, COLOR BRONZE 14, DIRECT BURY, SEE BEASERS AND SPECIFICATIONS | |
| | III DIRECT BURY, SEE B5/AS502 AND SPECIFICATIONS PET WASTE STATION MDF - 395 SM, SURFACE MOUNT, PET WASTE STATION MDF - 395 SM, SURFACE MOUNT, | SHEET NO. |
| | COLOR TBD, SEE SPECIFICATIONS OUTDOOR SEATING WITH TABLES | SDP1. |
| | | J OF |
| | | |

| S A B 7601 ^{jef} | ICH ATINI BATINI FERSON NE, SUITE 100 UQUERQUE, NM 87109 O / DPSDESIGN.ORG |
|-------------------------------------|---|
| ENGINEER | L |
| | |
| PROJECT | |
| | |
| | IOR LIVING Y AVE NE RQUE, NM |
| | SEN |
| | HOLLY 9100 ALBU |
| | |
| REVISIONS | 18 DRB RE-SUBMITTAL |
| | |
| | |
| DRAWN BY | JD |
| DRAWN BY REVIEWED E DATE | |

SDP1.1

March 19,2021 City Of Albuquerque Planning Department DEKKER PERICH SABATINI

TRAFFIC CERTIFICATION

I Ron Witherspoon_ OF THE FIRM Dekker/ Perich Sabatini, HEREBY CERTIFY THAT THIS PROJECT IS IN SUBSTANTIAL COMPLIANCE WITH AND IN ACCORDANCE WITH THE DESIGN INTENT OF THE APPROVED PLAN DATED 10.019.018 THE RECORD INFORMATION EDITED ONTO THE ORIGINAL DESIGN DOCUMENT HAS BEEN OBTAINED BY Jennifer Facio Maddox OF THE FIRM Dekker/ Perich/ Sabatini PROJECT SITE ON 9100Holly AVE. AND HAVE DETERMINED BY VISUAL INSPECTION THAT THE SURVEY DATA PROVIDED IS REPRESENTATIVE OF ACTUAL SITE CONDITIONS AND IS TRUE AND CORRECT TO THE BEST OF MY KNOWLEDGE AND BELIEF. THIS CERTIFICATION IS SUBMITTED IN SUPPORT OF A REQUEST FOR approval of TCL for Holly Avenue .

The following items are noted to differ from the approved site plan:

1. The Asphalt paved path connecting to the Paseo del Norte Trail is planned to be completed by the end of this week.

THE RECORD INFORMATION PRESENTED HEREON IS NOT NECESSARILY COMPLETE AND INTENDED ONLY TO VERIFY SUBSTANTIAL COMPLIANCE OF THE TRAFFIC ASPECTS OF THIS PROJECT. THOSE RELYING ON THE RECORD DOCUMENT ARE ADVISED TO OBTAIN INDEPENDENT VERIFICATION OF ITS ACCURACY BEFORE USING IT FOR ANY OTHER PURPOSE.

Signature of Engineer or Architect

ENGINEER'S OR ARCHITECT'S STAMP

03.19.2021 Date

THIS CERTIFICATION MUST BE SUBMITTED ON EITHER 1) COMPANY LETTERHEAD, WITH AN ORIGINAL STAMP AND SIGNATURE or

2) ON THE ORIGINAL APPROVED PLAN WITH EITHER TCL STAMP OR DRB SIGNATUERE BLOCK

Very truly yours,

Dekker/Perich/Sabatini Ltd.



Ronald A. Witherspoon Principal/Architect

7601 JEFFERSON NE, SUITE 100 ALBUQUERQUE, NM 87109

) 505.761.9700 DPSDESIGN.ORG

ARCHITECTURE / DESIGN / INSPIRATION



City of Albuquerque

Planning Department Development & Building Services Division DRAINAGE AND TRANSPORTATION INFORMATION SHEET (REV 6/2018)

| Project Title: Amaran | Building Permit #: | 2019-12761 | Hydrology File #: C20D079 |
|---|--|---|--|
| DRB#: 2018-001632 | EPC#: | | Work Order#: |
| DRB#: 2018-001632 Legal Description: Tracts C and D Mark3S Holly Developmen Bernalillo County, NM Plat Block 2017C, P | t, Albuquerque, New Mexico, as age 146, Doc #2017119919 | the same is shown and designa | ited on the plat filed in the office of the County Clerk of |
| City Address: 9300 Holly Avenue Albuquerqu | | | |
| Applicant: Dekker / Perich / Sabatini | | | Contact: Jennifer Facio Maddox |
| Address: 7601 Jefferson NE Suite 100 Albuque Phone#: 505-301-1681 | • | | |
| Phone#: <u>505-301-1681</u> | Гах# | | E-man: <u>jenniern@dpsdesign.o</u> rg |
| | | | Contact: Amit Patel |
| Address: 6501 Wyoming Blvd. NE Albuquerqu | e, NM 87109 | | |
| Phone#: <u>505-220-7625</u> | Fax#: | | E-mail: <u>amit@paarugroup.com</u> |
| TYPE OF DEVELOPMENT: PLAT (# | # of lots) RE | SIDENCE X | DRB SITE ADMIN SITE |
| IS THIS A RESUBMITTAL? Yes | X No | | |
| DEPARTMENT X TRANSPORTATION | HYDROLO | OGY/DRAINAGE | |
| Check all that Apply: | | YPE OF APPROVA BUILDING PER | AL/ACCEPTANCE SOUGHT: |
| TYPE OF SUBMITTAL: ENGINEER/ARCHITECT CERTIFICATION PAD CERTIFICATION CONCEPTUAL G & D PLAN GRADING PLAN DRAINAGE REPORT DRAINAGE MASTER PLAN FLOODPLAIN DEVELOPMENT PERMIT A ELEVATION CERTIFICATE CLOMR/LOMR TRAFFIC CIRCULATION LAYOUT (TCL) TRAFFIC IMPACT STUDY (TIS) OTHER (SPECIFY) PRE-DESIGN MEETING? | PPLIC | X CERTIFICATE C PRELIMINARY SITE PLAN FOF SITE PLAN FOF FINAL PLAT AN SIA/ RELEASE FOUNDATION I GRADING PERI SO-19 APPROV PAVING PERMI GRADING/ PAD WORK ORDER A CLOMR/LOMR FLOODPLAIN D | DF OCCUPANCY PLAT APPROVAL R SUB'D APPROVAL R BLDG. PERMIT APPROVAL PPROVAL OF FINANCIAL GUARANTEE PERMIT APPROVAL MIT APPROVAL AL IT APPROVAL O CERTIFICATION |
| DATE SUBMITTED: 03.19.2021 | | | |
| COA STAFF: | ELECTRONIC SUBMI | ITAL RECEIVED: | |