CITY OF ALBUQUERQUE



November 20, 2020

John Douglas Heller, RA Mullen Heller Architecture, PC 1718 Central Ave SW, Suite D Albuquerque, NM 87104

Re: Dr. Fanning Orthodontics

8130 Ventura St. NE

90-Day Temporary Certificate of Occupancy Transportation Development Final Inspection

Engineer's/Architect's Stamp dated 7-31-19 (C20D084)

Certification dated 10-28-20

Dear Mr. Heller.

Based upon the information provided in your submittal received 11-18-20, Transportation Development has no objection to a <u>90-day Temporary Certificate of Occupancy</u> based. This letter serves as a "green tag" from Transportation Development for a <u>90-day Temporary Certificate of Occupancy</u> to be issued by the Building and Safety Division.

PO Box 1293

Prior to the issuance of a permanent Certificate of Occupancy, the following items must be addressed:

Albuquerque

 Prior to release of Final CO a roadway easement is required for future roundabout. Please contact The Traffic Engineer Jeanne Wolfenbarger @ 505-924-3991 or at www.iwolfenbarger@cabq.gov for questions.

NM 87103

If you have any questions, please contact me at (505) 924-3981.


www.cabq.gov


Sincerely,

Ernie Gomez.

Plan Checker, Planning Dept. Development Review Services

EG via: email C: CO Clerk, File

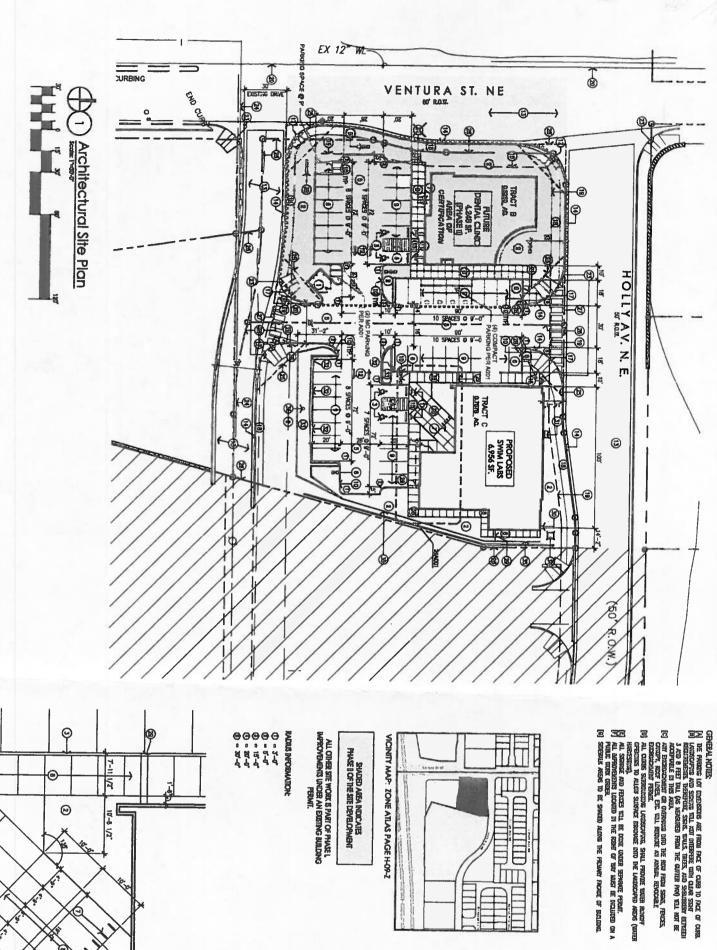

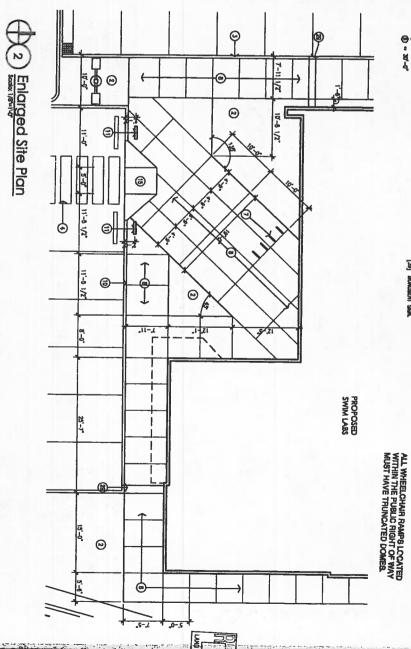

AUG - 1 2019 いにして元

ALL OTHER SITE WORK IS PART OF PHASE L WPROVEMENTS UNDER AN EXISTING BUILDING PERMIT. TICINITY MAP: ZONE ATLAS PAGE H-09-Z SHADED AREA INDICATES
PHASE II OF THE SITE DEVELOPMENT eeee eeee mee

FRENCH DRAM, REFER TO CYAL. PROPOSED CONCRETE SIDESMUK, SEE 2/MOIT. MONAMENT SIGN. DOSINO PROPERTY LAE.
EST PARTIS STREPHAL
EST SUESHLY CALVERT.
EST SUESHLY CALVERT.
EST SUESHLY CALVERT.
EST SUEL LALVEID STREGATION CONTROL BO MINISAPE.

MINISAPE. STANLE, REFER TO CAR.

ONE PORTION OF EXISTING CURB TO AUGN WITH MER.

APPROVED LAYOUT

J DISTING ASTINALT ROAD.

J CASTING CONSTRUCT CARES TO RELAYA,

J FARTPORSE HE MATCHET TO RELAYA,

J FARTPORSE HE MATCHET TO RELAYA,

J DISTING COTT STANDARD HE RAMP. RESPALL TRIANCATED

DORSES FERS COA STANDARDS.

J DISTING COTT STANDARD SIZEBALK.

J DISTING COTT STANDARD SIZEBALK.

J DISTING COTT PAREL WITLING ESSEMENT.

J FARTPORSE OF MATCHING SIZEBALK CONGESTION TO PAREL

RESPONSE OF MATCHING TORS WITNING

J DISTING CARES CAT TO REMAIN. BOX, REFER TO 圓

JOHTING SHALL BE FULLY SHIELDED, HIGH-PRESSURE SCOULM LICHTING AND HIELDED UPLICHTING SHALL BE BITED AT <u>20. FEEL MAXIMAIN</u> BE PROVIDED ON COMMERCIAL ADES SHALL BE MOUNTED AT E) AL SSANZE NO PROZES VIL EE DUNE VOURS SEMANTE PROVI.
F) ALL ANTHREADRIS VOURDE IN THE RESHT OF SVY MAST EE NOLLINGS ON PER PROJECT EN DESCRIPTION OF ENLING.
F) STEERMA AREAS TO EE SAMEDI ALDING THE PROJECT FROM F BOLLING.) ALLOS CUSTOS CHANGE OND THE LANGECASTS WERS (MAID) SUMMULADO LANGECASTA, SHALL PROVIDE WITH MAIDS NO PECES WILL BE DONE UNDER SEPARATE PERVIT.

TON (E) [12] PROP ĒE NOTES PARITID PARRONS STREPAIL
ADVESS PARITID PARRONS SE GRUUNS & INVANAS
ADVESS DOMUREU CURR. SEE GRUUNS & INVANAS
ANT TO SE MATEUR PARRONS SCH. "AM" WESSE MOTES.
"MALAURISS ANT SUBJECT TO A FISE MAP/UR TURNOF".
SEE 8/1002.
"MARTINI DISECTIONAL ARRONAL SCHARES CHI T. 2-0, YAO DEMARCHA TONIE DEBL. 50,-0, 26E TONIE COUNTEEL STEEMA WILL SOURCE TONIES TONIES DEEL RAY, BLI 7 SANSE 2EE 10/VOOT DEED SUE TONIES 2EE SOURCE VOLLES TONIES DEEL TONIES 2EE SOURCE SOURCE TONIES SUE TONIES 2EE SOURCE SOURCE TONIES SUE TONIES 2EE SOURCE SOURCE TONIES SUE TONIES 2EE SOURCE SOURC

CONTINUE STOKES SKORK

(3 SPACES /1000 SF) = 25 SPACES RED. TENNET B: 1,024 SF - FUTURE REJUL.

(4 SPACES/1000 SF) = 4 SPACES REQ. IDANI K 5,922 SF - IRADONG FACULTY
(2.5 SPACES/1000 SF) = 15 SPACES RED 20kS # =

PROPORES PRIME PRIME PRIME T/MOZ

| PROPORES PRIME PRIME PRIME TO LARGOLAPRIC
| PRIME PRIME PRIME PRIME TO LARGOLAPRIC
| PRIME PRIME PRIME TO LARGOLAPRIC
| PRIME PRIME PRIME TO PRIME

PROJECT **SwimLabs** 8120 Ventura St. NE Albuquerque, NM 87122

TCL


TITLE Traffic Circulation Layout









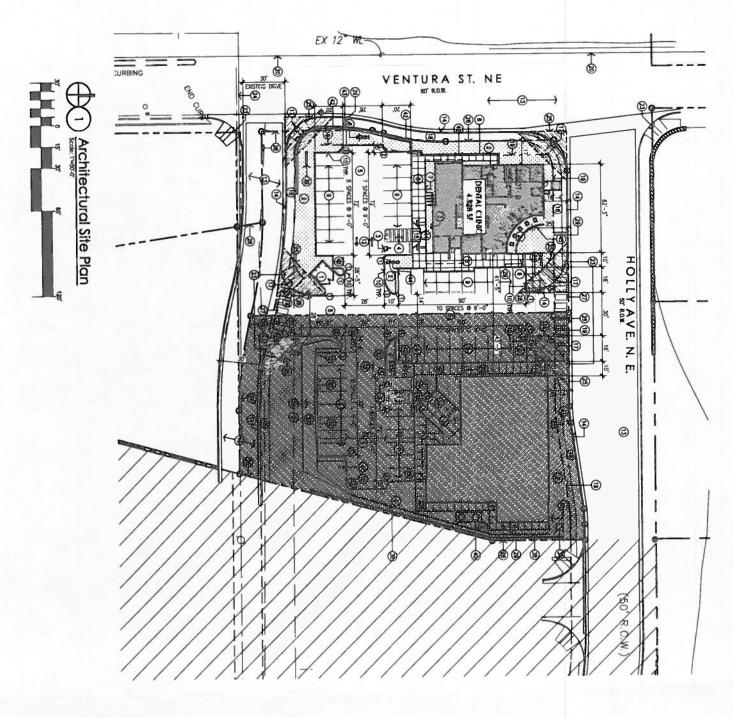

RADRIS INFORMATION:

(i) = 5'-0"
(i) = 5'-0"
(ii) = 15'-0"
(ii) = 20'-0"
(iii) = 20'-0"

SHADED AREA BIDICARD MENT

HIS PROJECT IS PHASE 2 OF THE DEVELOPMENT

VICINITY MAP: ZONE ATLAS PAGE H-09-Z

ETER FREE SEET E

<u> 333</u> areas to be swoed along the product facade of Buldakg. AND FENCES WILL BE DONE UNDER SEPARATE PERMIT. MENTS LOCATED IN THE RIGHT OF WAY MUST BE INCLUDED ON A

E E

OSED HARDICAP PARODIG SIGN. "VAN" WHETE NOTED. TO BE HOTED PER 68-7-3524C NASA 1978. TURIS ARE SUBJECT TO A FIRE AND/OR TOWNING". ISED PAINTED PARRONG STREPING. ISED CONCRETE CURB. SEE GRADING & DRANAGE

> = 1 REQUIRED = 1 REQUIRED

GENERAL NOTES:

(A) THE PHAGNAG LOT DILLISONS ARE TROLE FACE OF CURB.

(B) THE PHAGNAG LOT DILLISONS ARE TROLE FACE OF CURB.

(C) ARE DILLISONS THEOTORE, SAGE, WILLS, TREES, AND SERVISION GENERAL

3 AND 8 FEET THAL (S) GENERAL BOOK THE CUTTER THAN) WILL HOT BE
ACCEPTABLE IN THIS TREE.

(C) ARE DILLISONS UNITS, TELL, WILL REQUIRE AN ANNUM, REPOCUBLE

DICTURED TO DILLISONS

(C) ARE DILLISONS THEORY OF THE COURTE WITH REPOCUBLE

DICTURED TO DILLISONS

(C) ARE DILLISONS THEORY OF THE COURTE WITH REPOCUBLE

DICTURED TO DILLISONS

(C) ARE DILLIS SURBOUNDING LANDSCHPING, SHALL PROVIDE WATER RUNGEF TO ALLOW SURFACE DRIVINGE INTO THE LANDSCHPED AREAS (WATER

豆

(EYED NOTES:

(1) PROPOSED RETUSE ENGLISHE: 1/4002.

(2) PROPOSED RETUSE ENGLISHE: 1/4002.

(3) PROPOSED HANDLOF PAREABIT SIGH SEE 6/4002.

(4) PROPOSED STREED HANDLOF ASE, MITH 12 HERY HANDLOF DREED HANDLOF ASE, MITH 12 HERY HERY SEE 5/4002.

(5) PROPOSED METHOD HANDLOF FOR 68-1-4.1.8 HASA HERY SEE 5/4002.

(6) PROPOSED DEFE BACK WITH 3 SAMCES SEE 10/4002.

(7) PROPOSED OMNOBET SIGNAMA. OMNTS CHEM'S 20'-0". SEE 7/4002.

(8) PROPOSED OMNOBET SIGNAMA.

mullen heller architecture

DATE

DATE

= 25 SPACES - 25 SPACES REQ.

OF WALL
SHOCK ALL WOLL & 4.0, TONG MOLDHOLKTE
SHOWE YE WAS X 4.0, TONG MOLDHOLKTE
SHOWE YE WAS X 4.0, TONG MOLDHOLKTE HADDEN CARE RECEPT TO CARL PRODUCT SANCES MILH HADDEN CARE ROCK RETURNS OF LETTER CHARE THROUGH CHARE THROUGH CHARE TO CARL PRODUCT SANCES MILH RECTURN CHARE THROUGH CHAR

LINGUICH CTER & THOSE SOEMAN (NETER 10

NCH GOUN, REFER TO CAN.

NORSED CHACKETT SOCKHUL SEE 2/4001.

PORSED 30 SF. IMPRILEDET SON.

TO NIEUCEPTOR. REFER TO PLIMEBRIC.

B. AREA CONSOC STOREHROM AND LANDSCAPE WILL.

BETTARDADE MILL!

WE PORTION OF EXISTING CLASS TO ALLOW WITH NEW STRUCK, REFER TO CAN'L.

EFEES E HEE E EFEES IN

S' Curb O'Pomen, refer 10 cml. Storm Water Pomo , refer 10 cml. Comprete Pad for Transformer, refer 10

INTON BACKSLOW PREVENTOR IN HOT BOX. HOX, REFER TO

PROJECT Fanning Orthodontics 8130 Ventura Street NE Albuquerque, NM 87122

A001

Architectural Site Plan

DRAWN BY SEJ | AV PROJECT MCR JOB NUMBER SHELL PERMIT 02-11-2020 18-15 ğ



MULLENIELLER ARCHITECTURE, P.C.

October 28, 2020

Jeanne Wolfenbarger, P.E., Transportation Development Planning Department Development and Building Services Division City of Albuquerque 600 2nd Street NW. Albuquerque, NM 87102

Re:

Permanent Certificate of Occupancy for Dr. Fanning Orthodontics 8130 Ventura St NE Albuquerque, NM 87122

Dear Ms. Wolfenbarger:

I, Doug Heller, NMRA with Mullen Heller Architecture P.C., hereby certify that this project is in substantial compliance with and in accordance with the design intent of the Approved Traffic Control Layout (Permit #BP-2020-05944). The attached Traffic Control Layout shows "redlined" revisions made to the site plan per construction coordination.

This certification only pertains to Tract B of the development. I further certify that I have personally visited the project site on October 23, 2020, and have determined by visual inspection that the survey data provided is representative of actual site conditions and is true and correct to the best of my knowledge and belief.

The construction of the sitework matches the approved permit drawings with a few minor exceptions, which include:

- Given the dramatic slope of the site, it was determined that an accessible sidewalk connection to the public sidewalk would not be possible on the west side of the parking lot. Connection to the public sidewalk is still available at the northeast corner of the property.
- In the approved Architectural Site Plan, four parking spaces were updated to be "compact" to make room for a more generous sidewalk
- The motorcycle parking moved next to the trash enclosure for a more efficient use of space.

This certification is submitted in support for Permanent Certificate of Occupancy.

The record information presented herein is not necessarily complete and intended only to verify substantial compliance of the traffic aspects of this project. Those relying on the record document are advised to obtain independent verification of its accuracy before using it for any other purpose.

Please feel free to contact me if you have any questions.

Sincerely,

Mullen Heller Architecture, PC

Doug Heller, AIA, LEED AP

Attachments:

Site Photographs from Visits Conducted on 10/23/2020

Approved TCL for Permit dated 08/02/2019

Approved Architectural Site Plan for Permit dated 02/20/2020

