

BOARD OF COUNTY COMMISSIONERS ALBERT "AL" VALDEZ, CHAIRMAN DISTRICT 2 KEN SANCHEZ, VICE CHAIR DISTRICT 1

KEN SANCHEZ, VICE CHAIR
DISTRICT 1
EUGENE M. GILBERT, MEMBER
DISTRICT 3
BARBARA J. SEWARD, MEMBER
DISTRICT 4
LES HOUSTON, MEMBER
DISTRICT 5

JUAN R. VIGIL, COUNTY MANAGER

County of Bernalillo

State of New Mexico

2400 BROADWAY, S.E. ALBUQUERQUE, NEW MEXICO 87102 PUBLIC WORKS (505) 848-1500 DAVID K. ANDERSON, ASSESSOR
JUDY D. WOODWARD, CLERK
THOMAS J. MESCALL, PROBATE JUDGE
JOE BOWDICH, SHERIFF
H. R. FINE, TREASURER

December 22, 1995

Don Dixon Resource Technology, Inc. 2129 Osuna NE, Suite 200 Albuquerque, New Mexico 87113

RE: ENGINEER'S CERTIFICATION FOR LOTS 23 AND 24, BLOCK 14, TRACT 2, UNIT 1,

NAA, (C22/D34) (PWD 93-69) ENGINEER'S STAMP DATED 2/4/94 AND 9/12/94.

Dear Mr. Dixon:

The Engineer's Certification for the above referenced Lots are acceptable for Certificate of Occupancy Release. Thank you for providing this information for my files.

If you have any questions, or if I may be of further assistance to you, please call me.

Sincerely,

Susan M. Calongne, P.E.

City/County Floodplain Administrator

c: Roger Paul, County Public Works
File



BOARD OF COUNTY COMMISSIONERS

PATRICK J. BACA, CHAIRMAN DISTRICT 1

JACQUELYN SCHAEFER, VICE CHAIR DISTRICT 5

ALBERT "AL" VALDEZ, MEMBER

EUGENE M. GILBERT, MEMBER DISTRICT 3

BARBARA J. SEWARD, MEMBER

JUAN R. VIGIL, COUNTY MANAGER

County of Bernalillo

State of New Mexico

ONE CIVIC PLAZA, N.W. ALBUQUERQUE, NEW MEXICO 87102

ADMINISTRATION (505) 768-4000 COMMISSION (505) 768-4217 FAX (505) 768-4329

April 21, 1993

MARK J. CARRILLO, ASSESSOR JUDY D. WOODWARD, CLERK THOMAS J. MESCALL, PROBATE JUDGE BAY GALLAGHER, SHERIEF H. R. FINE, TREASURER

Don Dixon, P.E. Resource Technology Inc. 2129 Osuna NE Albuquerque, NM 87113

> DRAINAGE REPORT FOR LOTS 7, 23 AND 24, TRACT 2, UNIT 1, N.A.A. (C22-D34), ENGINEER'S STAMP DATED APRIL 12, 1993

Dear Mr. Dixon:

Based on the information provided on the referenced submittal received April 14, 1993, the plan is acceptable for Building Permit release.

Please be advised that due to the complexity on the construction of the foundation system, an Engineer's Certification that the site was built in substantial compliance with the approved plan must be submitted and approved by this office prior to the County Building Department performing their foundation inspection.

If you should have any questions, please do not hesitate to contact me.

Cordially.

Gilbert Aldaz, P.E. & P.S.


County Floodplain Administrator


xc: Clifford E. Anderson, AMAFCA Bob Foglesong, County PWD


Tom Burlison, County Building Dept.

Rogan Thompson, Owner

File

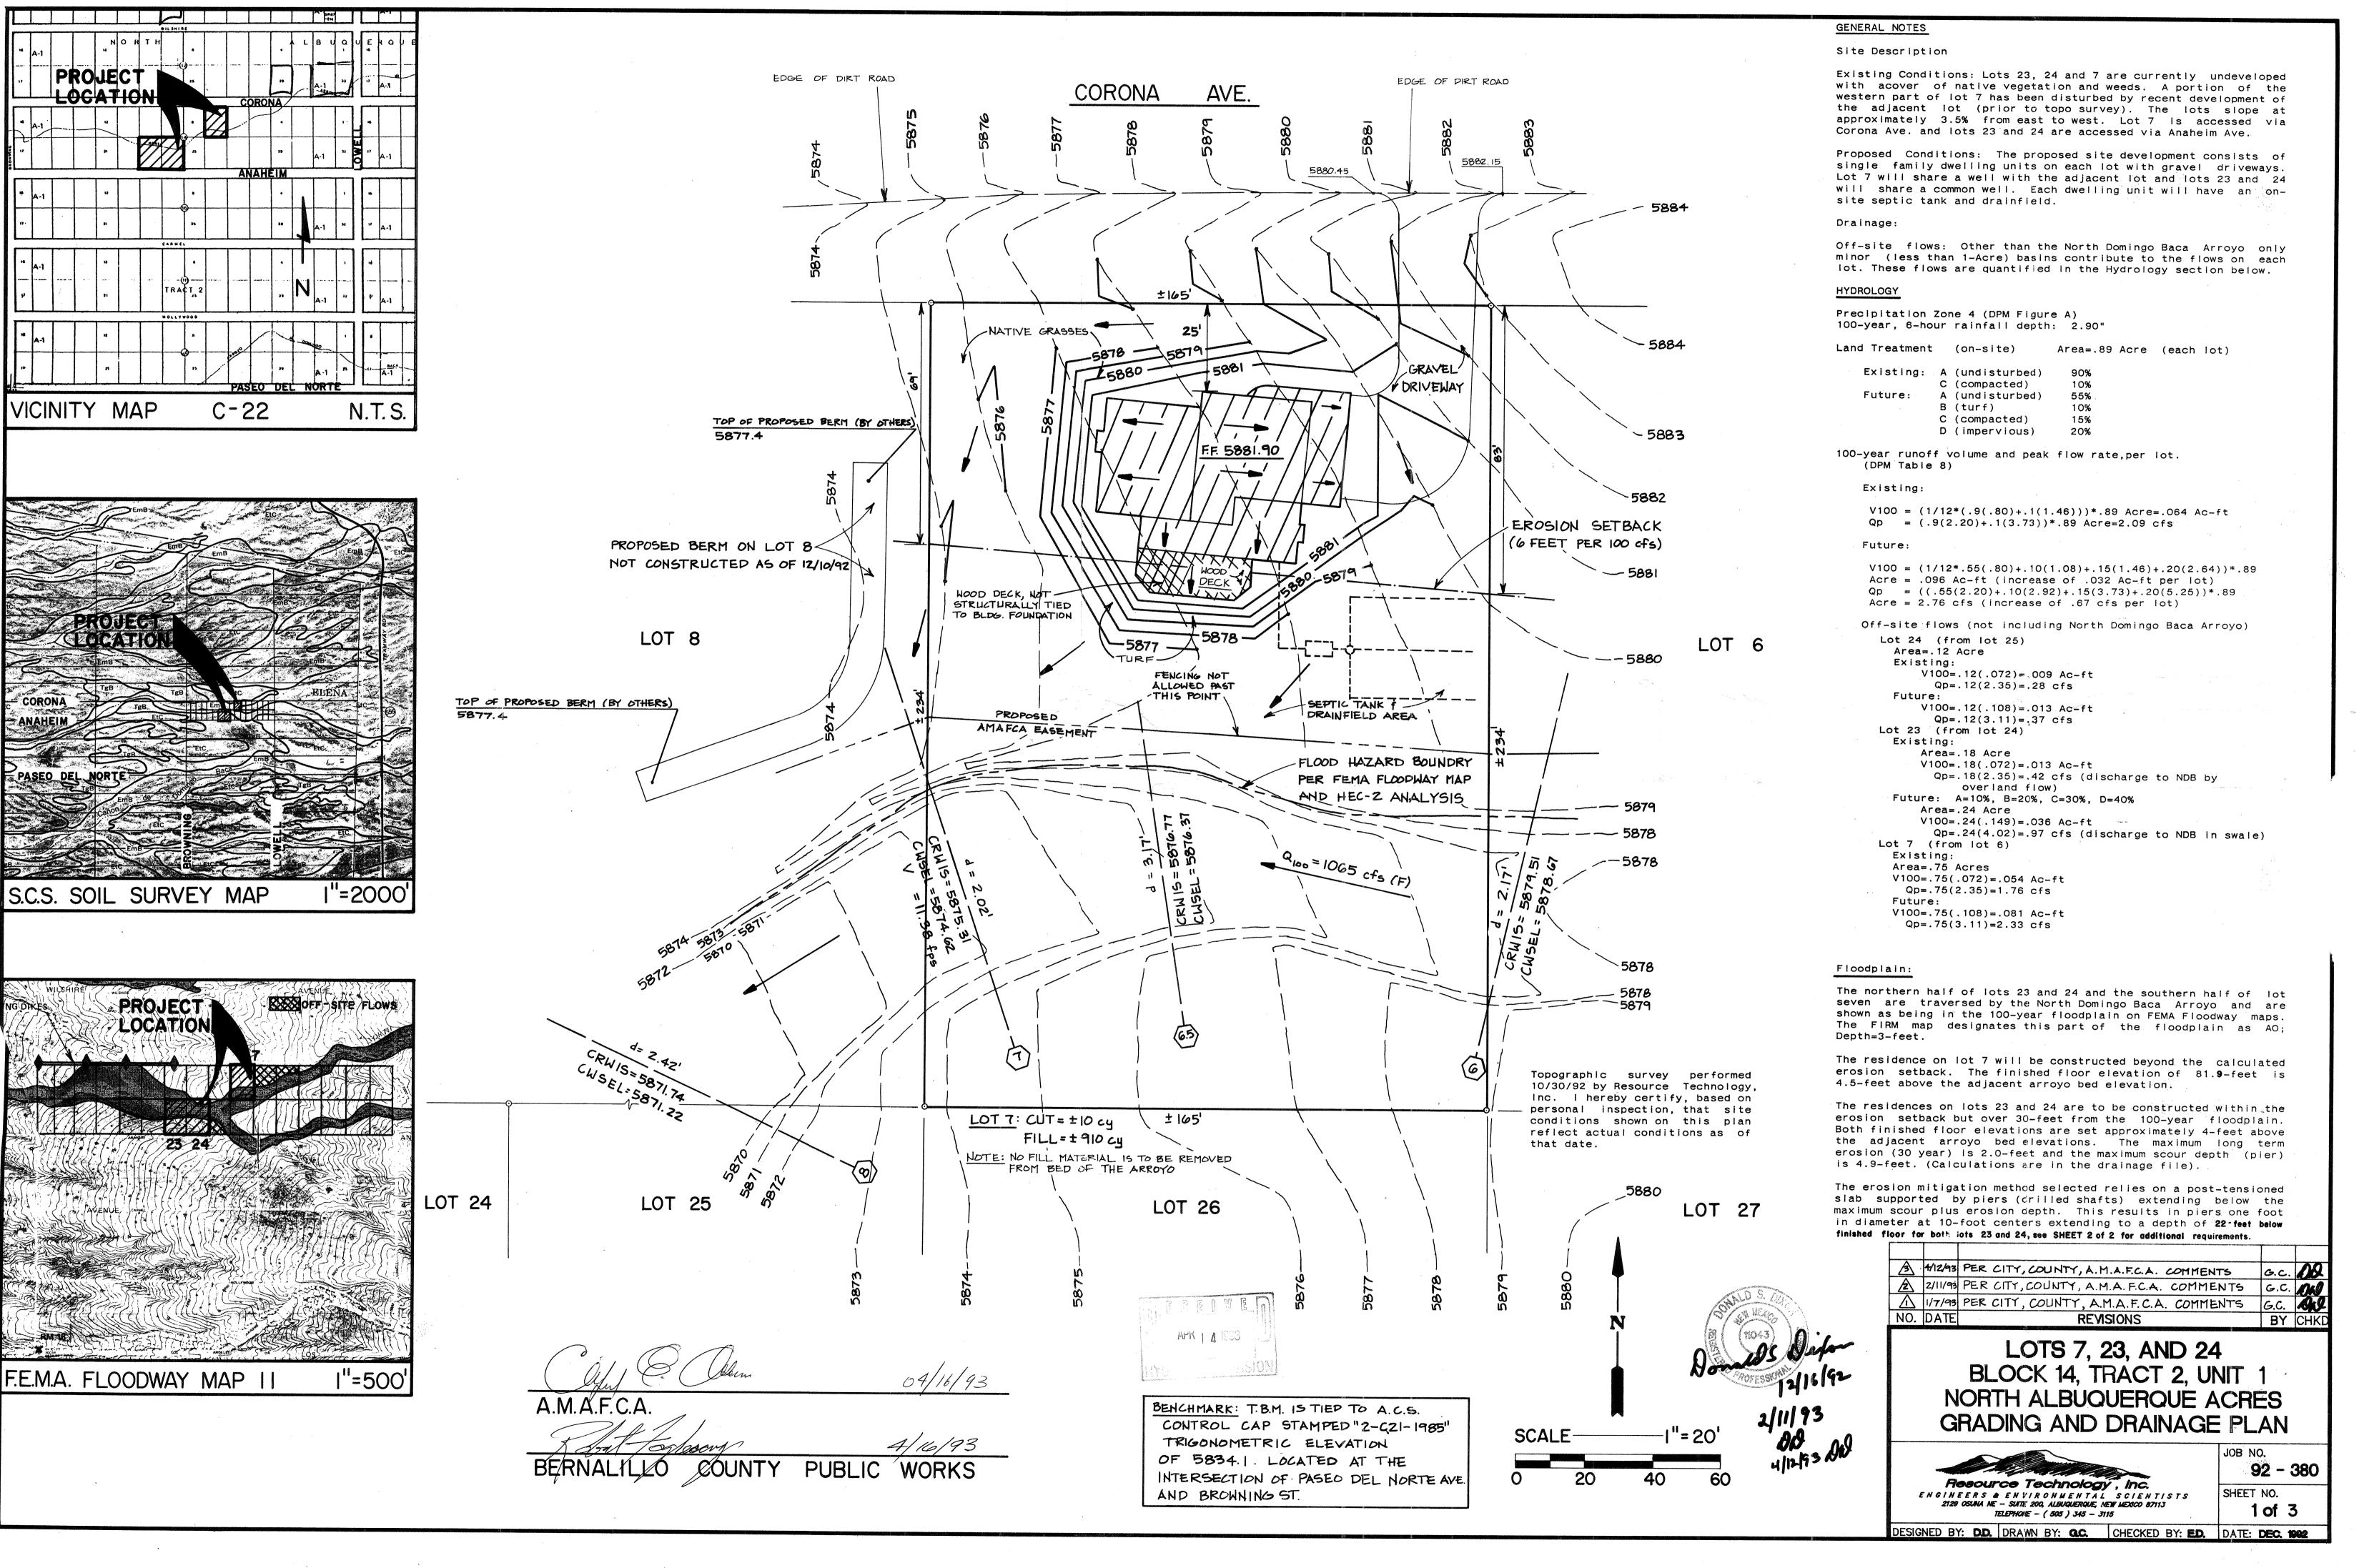

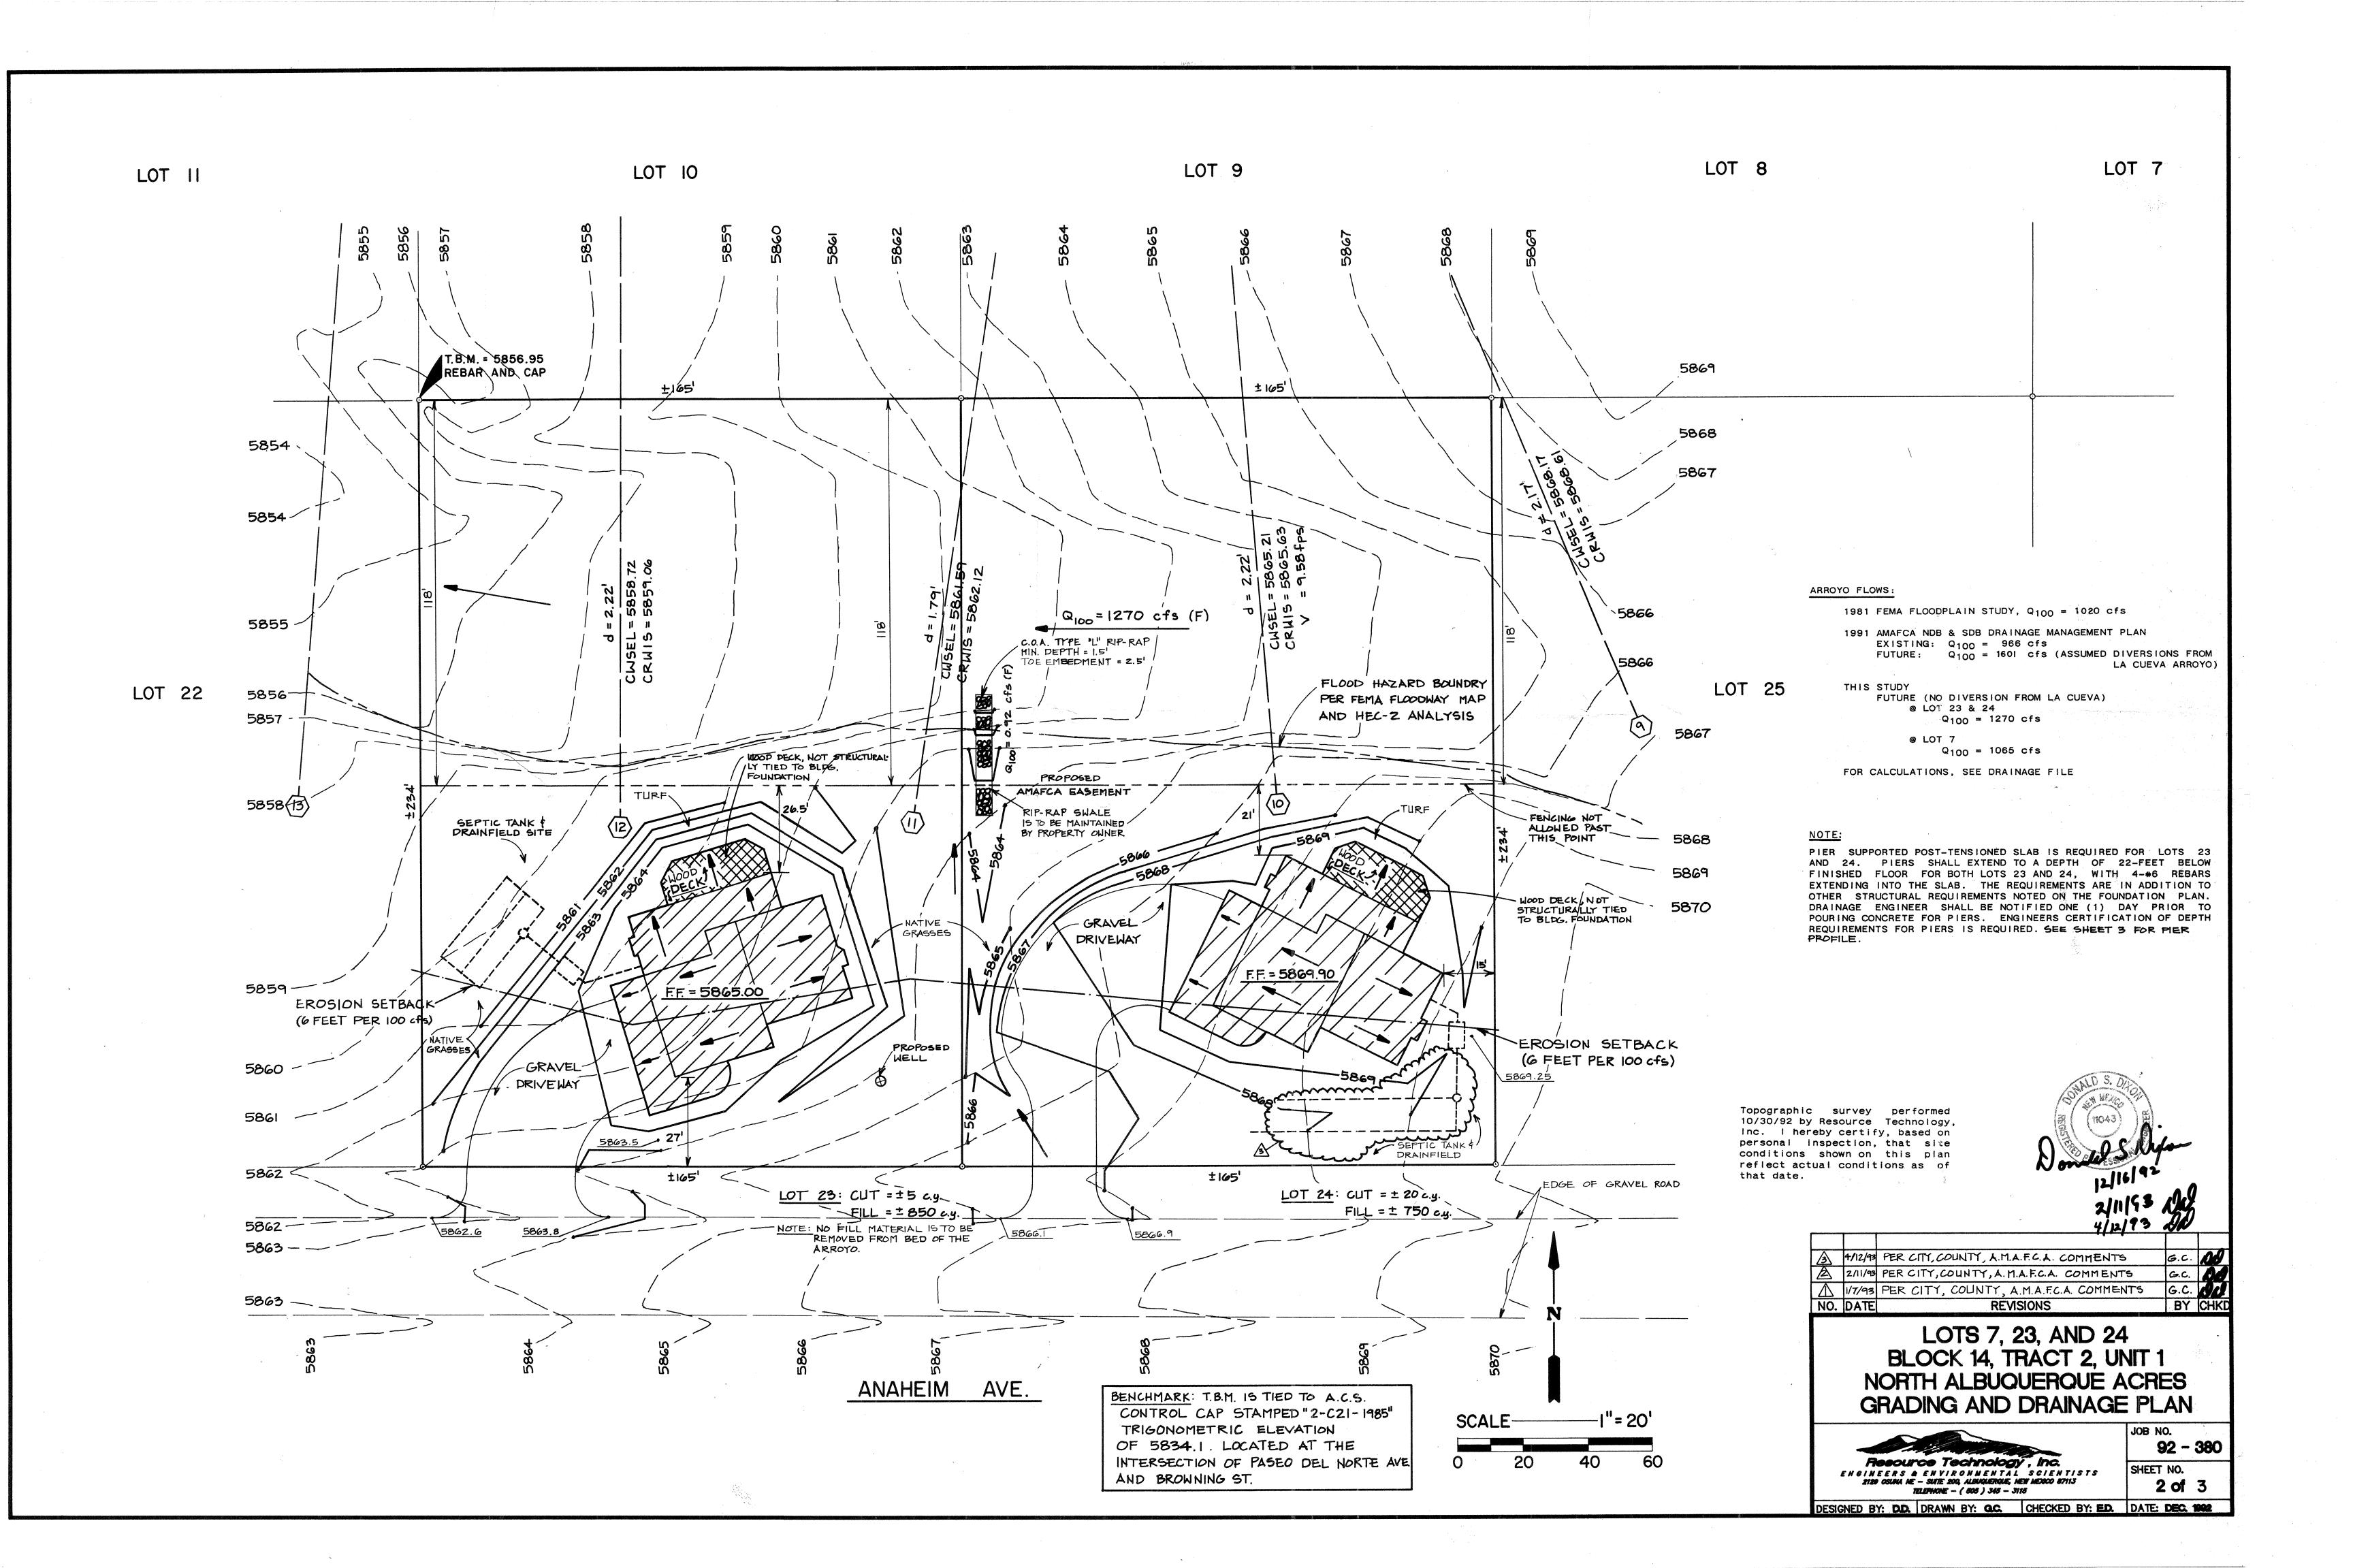

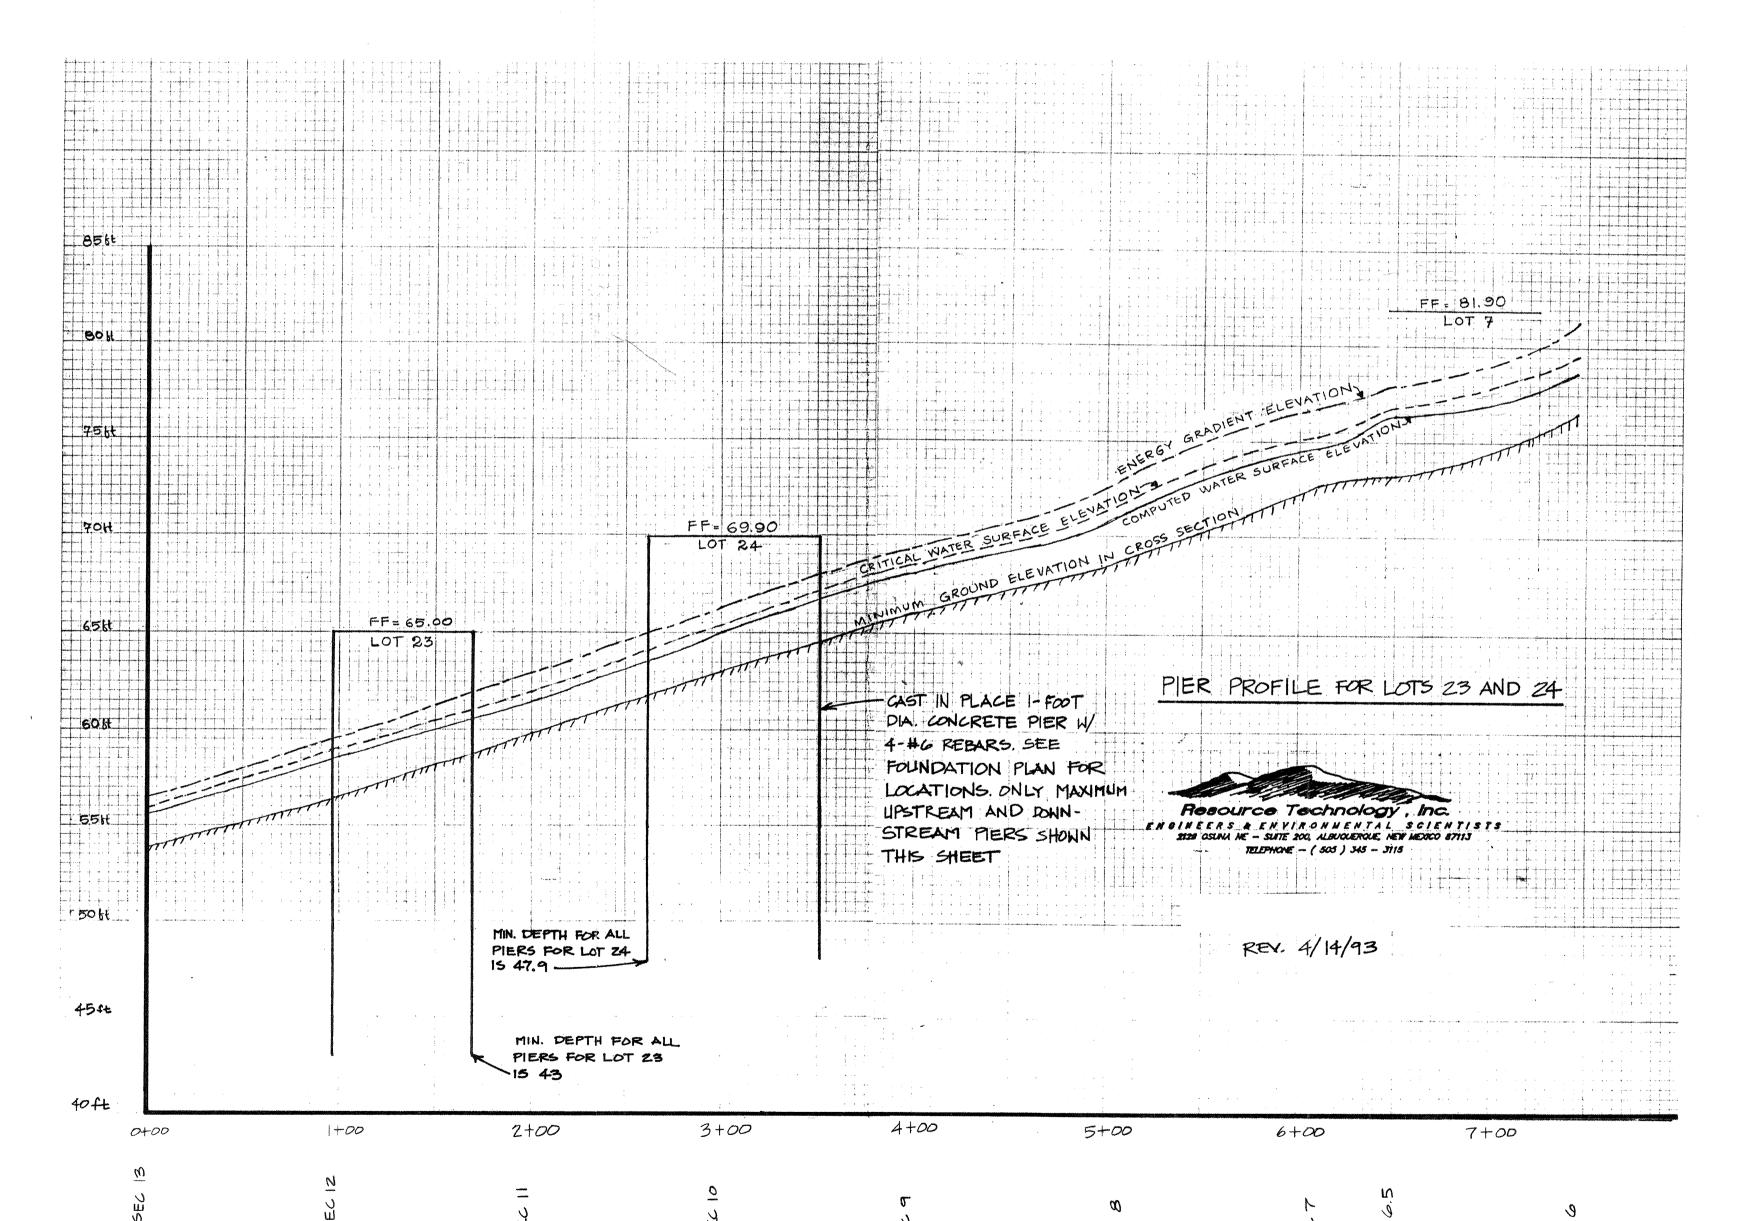

1) 10 A 411413

PIER PROFILE FOR LOTS 23 AND 24

|"=5' \

NO. DATE REVISIONS BY CHKD

LOTS 7, 23, AND 24
BLOCK 14, TRACT 2, UNIT 1
NORTH ALBUQUERQUE ACRES
GRADING AND DRAINAGE PLAN

Resource Technology, Inc.

ENGINEERS & ENVIRONMENTAL SCIENTISTS
2129 OSUNA NE - SUITE 200, ALBUQUERQUE, NEW MEXICO 87113

TELEPHONE - (505) 345 - 3115

JOB NO.
92 - 380
SHEET NO.
3 of 3

DESIGNED BY: D.D. DRAWN BY: Q.C. CHECKED BY: E.D. DATE: DEC. 1992



BOARD OF COUNTY COMMISSIONERS PATRICK J. BACA, CHAIRMAN

JACQUELYN SCHAEFER, VICE CHAIR DISTRICT 5

ALBERT "AL" VALDEZ, MEMBER DISTRICT 2

EUGENE M. GILBERT, MEMBER DISTRICT 3

PATRICIA "PAT" CASSIDY, MEMBER

JUAN R. VIGIL, COUNTY MANAGER

County of Bernalillo

State of New Mexico

ONE CIVIC PLAZA, N.W. ALBUQUERQUE, NEW MEXICO 87102

ADMINISTRATION (505) 768-4000 COMMISSION (505) 768-4217 FAX (505) 768-4329

February 23, 1993

RAY GALLAGHER, SHERIFE PATRICK J. PADILLA. TREASURER GLADYS M. DAVIS, CLERK MARK J. CARRILLO, ASSESSOR THOMAS J. MESCALL, PROBATE JUDGE

Don Dixon, P.E. Resource Technology Inc. 2129 Osuna NE Albuquerque, NM 87113

> DRAINAGE REPORT FOR LOTS 7, 23 AND 24, TRACT 2, UNIT 1, N.A.A., (C22-D34) RECEIVED FEBRUARY 12, 1993 FOR BUILDING PERMIT APPROVAL

Dear Mr. Dixon:

Based on the information provided, kindly submit the following prior to release of Building Permit by this office:

- It appears that the profile provided shows that the piers do not 1. have enough depth for lateral and vertical structural stability ONCE SCOUR HAS OCCURRED, particularly for the piers along the west end of the structure.
- Berms along the south side of lots 23 and 24 remain on the plan. 2. The berms are not allowed because they block historic flows and create diversions. Are the pads high enough that they will not be impacted from street flooding during a 100-year storm, particularly the pad on lot 23?
- On your response regarding the deck for lot 7, you need to include a note on this plan that the deck will not be structurally connected to the main portion of the house. This should also be reflected on the Building Permit plans.

Don Dixon Page 2

These comments include AMAFCA's and County Public Works review. If you should have any questions, please do not hesitate to contact me.

Cordially,

Gilbert Aldaz, P.E. & P.S.

County Floodplain Administrator

Clifford E. Anderson, AMAFCA Bob Foglesong, County PWD

Tom Burlison, County Building Dept.

wp+7420



BOARD OF COUNTY COMMISSIONERS

PATRICK J. BACA, CHAIRMAN DISTRICT 1

JACQUELYN SCHAEFER, VICE CHAIR DISTRICT 5

ALBERT "AL" VALDEZ, MEMBER DISTRICT 2

EUGENE M. GILBERT, MEMBER DISTRICT 3

PATRICIA "PAT" CASSIDY, MEMBER DISTRICT 4

JUAN R. VIGIL, COUNTY MANAGER

County of Bernalillo

State of New Mexico

ONE CIVIC PLAZA, N.W. ALBUQUERQUE, NEW MEXICO 87102

ADMINISTRATION (505) 768-4000 COMMISSION (505) 768-4217 FAX (505) 768-4329

February 5, 1993

RAY GALLAGHER SHERIEF PATRICK J. PADILLA, TREASURER GLADYS M. DAVIS, CLERK MARK J. CARRILLO, ASSESSOR THOMAS J. MESCALL, PROBATE JUDGE

Don Dixon, P.E. Resource Technology Inc. 2129 Osuna NE Albuquerque, NM 87113

Block 14

DRAINAGE REPORT FOR LOTS 7, 23 AND 24, TRACT 2, UNIT 1, N.A.A., RECEIVED JANUARY 8, 1993 FOR BUILDING PERMIT APPROVAL

Dear Mr. Dixon:

Based on the information provided, kindly submit the following prior to release of Building Permits by this office:

- It appears that the profile provided shows that the piers do not 1. have enough depth for lateral and vertical structural stability once scour has occurred, particularly for the piers along the west end of the structure.
- Is the ground elevation profile along the center of the channel? 2. so, please label.
- If you are proposing not using culverts for the roadside ditches, 3. keep in mind that if the design storm presently enters this property, it must continue to be accepted onto this property.
- The septic system does not appear to meet the 25 foot setback 4. requirement from the arroyo as required by the liquid waste ordinance for lot 23.

Don Dixon, P.E. Page 2

> 5. It appears that a portion of the structure in lot 7 is within the erosion limit, We don't believe that turf will provide the erosion stabilization for this structure.

These comments include AMAFCA's and County Public Works review. If you should have any questions, please do not hesitate to contact me.

Cordially,

Gilbert Aldaz, P.E. & P.S.

County Floodplain Administrator

xc: Clifford E. Anderson, AMAFCA

Bob Foglesong, County PWD

Jeffrey L. Peterson, Environmental Health

Tom Burlison, County Building Dept. file

wp+7420



BOARD OF COUNTY COMMISSIONERS
PATRICK J. BACA, CHAIRMAN
DISTRICT 1
JACQUELYN SCHAEFER, VICE CHAIR
DISTRICT 5
ALBERT "AL" VALDEZ, MEMBER
DISTRICT 2
EUGENE M. GILBERT, MEMBER
DISTRICT 3
PATRICIA "PAT" CASSIDY, MEMBER
DISTRICT 4

JUAN R. VIGIL, COUNTY MANAGER

County of Bernalillo

State of New Mexico

ONE CIVIC PLAZA, N.W.
ALBUQUERQUE, NEW MEXICO 87102
ADMINISTRATION (505) 768-4000
COMMISSION (505) 768-4217
FAX (505) 768-4329

January 4, 1992

RAY GALLAGHER, SHERIFF
PATRICK J. PADILLA, TREASURER
GLADYS M. DAVIS, CLERK
MARK J. CARRILLO, ASSESSOR
THOMAS J. MESCALL, PROBATE JUDGE

Don Dixon, P.E. Resource Technology Inc. 2129 Osuna NE Albuquerque, NM 87113

RE: DRAINAGE REPORT FOR LOTS 7, 23 AND 24, TRACT 2, UNIT 1, N.A.A., RECEIVED DECEMBER 16, 1992 FOR BUILDING PERMIT APPROVAL

Dear Mr. Dixon:

Based on the information provided, kindly submit the following prior to release of Building Permits by this office:

- 1. This is an area with high sheetflow potential. Are the buildings of sufficient elevation to protect from this hazard?
- 2. How will slopes be protected adjacent to the building pads?
- 3. Where will the fill dirt be obtained to build up the pads?
- 4. Who will maintain the riprap swales between the lot lines? If the riprap swale is to be placed between lots than a private drainage easement should be provided for the benefit of both private property owners.
- 5. Will flows be concentrated in the southwest corner of lot 23 and discharged onto lot 22?
- 6. Show a profile of the arroyo that includes the channel water surface, critical depth, energy grade, finish floor, depth of piers and etc.
- 7. Include foundation plans for the piers, these plans should be certified by an Engineer.

Ron Dixon, P.E. Resource Technology, Inc. 2129 Osuna NE Albuquerque, NM 87113 Page 2

- 8. Show edge of maintained roadway on the plan.
- 9. Extend driveway to edge of roadway and show the connection.
- 10. Will a culvert be required for the swale along the roadway? If so, then provide hydrology and hydraulics with details of the culvert layout.
- 11. Show layout of septic tank and leach field on the plan.
- 12. Submit copy of approved variance for front yard setback of Lot 7.

These comments include AMAFCA's and County Public Works review. If you should have any questions, please do not hesitate to contact me.

Cordially,

Gilbert Aldaz, P.E. & P.S.

County Floodplain Administrator

xc: Clifford E. Anderson, AMAFCA Bob Foglesong, County PWD

wp+7420