County of Bernalillo

State of New Mexico

BOARD OF COUNTY COMMISSIONERS

TOM RUTHERFORD, CHAIR
DISTRICT 3

BARBARA J. SEWARB, VICE CHAIR
DISTRICT 4

KEN SANCHEZ, MEMBER
DISTRICT 1

STEVE D. GALLEGOS, MEMBER
DISTRICT 2

LES HOUSTON, MEMBER
DISTRICT 5

2400 E

2400 BROADWAY, S.E. ALBUQUERQUE, NEW MEXICO 87102 PUBLIC WORKS (505) 848-1500 DAVID K. ANDERSON, ASSESSOR JUDY D. WOODWARD, CLERK THOMAS J. MESCALL, PROBATE JUDGE JOE BOWDICH, SHERIFF ORLANDO VIGIL, TREASURER

February 28, 1997

Marvin R. Kortum, P.E. 1605 Speakman Drive SE Albuquerque, New Mexico 87123

RE: Engineer's Certification For Lot 201A Big Horn Ridge Dr., Sandia Heights South, Unit 2, (C23/D49)(PWD 95-107), Engineer's Stamp Dated 2/20/97.

Dear Mr. Kortum:

JUAN R. VIGIL, COUNTY MANAGER

Based on the information provided in the submittal of February 25, 1997, the above referenced Engineer's Certification is adequate for Certificate of Occupancy release.

If you should have any questions, or if I may be of further assistance to you, please do not hesitate to call me at 924-3982.

Sincerely,

Susan M. Calongne, P.E.

City/County Floodplain Administrator

c: Roger Paul, County Public Works Kurt Browning, AMAFCA

File

LOT 201A, SANDIA HEIGHTS NORTH, UNIT 2, BERNALILLO COUNTY, NEW MEXICO BENCHMARK: Station 1-C24, located about 226 feet south of Big Horn Ridge Drive right-of-way centerline, and .4 miles south of the White oak intersection with Big Horn Ridge Drive. The station is a standard ACS brass cap stamped 1-C24, 1985, set on a concrete post. Elevation is 6353. 1"=20" TBM TOP OF STAKE 201 A -- +354 -- --------R = 358' L = 44.94' -6336 42469 - -----/ 139 140 FLOOD EASEMENT BASIN A ELEYATIONS (1) 385 CFS "Palma" PONDING LIMIT MANON ____ N N 0 MARKINGS /FROM BIG BASIN B I 48 CF\$ I certify that the construction required by the Grading and Drainnge Plan for 201 Big Horn Ridge (Lot 201A, Sandia Heights South, Unit 2, PWD 95-107, C23/D49) (for a building addition, Bernalillo County Building Permit #95-149) has been completed and is in substantial compliance with the approved design. The as-built construction does not infringe on the floodplain or easement. Marvin R Kortum February 20, 1997 NMPE 6519 DISCUSSION: Approved by letter, City of Albuquerque/County of Bernalillo Floodplain Administrator, (C23/D49)(PWD 95-107), August 10,

I certify that I have personally inspected the Lot 201A, Sandia Heights South, Unit 2, site and the surrounding terrain. The representation of the land and the contours are as presented on these drawings and the accompanying text as of June 1995.

Marvin R Kortum

Spirit Level Topography by Marvin R Kortum

A. Items marked existing are as found on-site in June 1995. Items marked proposed are additions proposed for construction after June 1995.

B. Existing topography ---6342--is topography copied from reference H. The aerial photography was made prior to any building development, but after some earthwork on the roads.

C. Proposed grading -72 includes that which has been done for existing structures, as well as that required for the proposed

D. Differences in elevations on undisturbed areas between the spirit elevations and the aerial photography are due to differences in registration of the topographic data.

E. Existing buildings to remain.

F. Proposed building additions.

G. Existing asphalt surface to remain.

H Additional asphalt surface to be placed.

J Existing patio and ground surface to remain.

Existing garden terrace to remain.

L Existing portland cement concrete tank (16" deep) to remain.

100 year flood plan boundary and proposed drainage easement, if

N. Landscaped, garden or orchard area.

P. General location of septic tank drain field. Size and depth as required by County of Bernalillo permit.

Q. For detailed house dimensions see architectual drawings.

R. Quantitative earthwork estimates should be based on more detailed topographic cross sections of the work area.

S. No solid walls or other structures, berms or swales shall be constructed on the lot property lines which will obstruct cross flow of sheet flow runoff from the adjacent property to the east. Buildings and partial yard fencing and walls as shown on this plan are permitted. Future buildings, landscaping, or other treatment interior to the lot must provide for cross flow of runoff from adjacent property.

T. All berms and earthwork supporting structures must be compacted to 95% of maximum dry density (Modified Proctor Test).

U. All cut and fill slopes and constructed drainage swales are to be provided with an erosion control surface by developer/owner. Coverings may be turf, rock, terraced with garden walls or timbers or similar according to the landscape plan. Erosion control is for protection and ease of maintenance. To prevent damage to downstream property, erosion control must be placed within six months of completion of the building, or one year from the issuing of the building permit. Erosion control may be provided by seeding with a native grass mixture as follows:

Common name

Genus-species Pounds/Acre

Oryzopis Indian rice grass Hymenoides "Viva" Galleta grass Hilaria Jasmesii "Niner" Sideoates Gramma Bouteloua curti Pedula 2.0 "Hatchita" Blue Gramma Bouteloua Gracilis Sand dropseed (NM Region)Sporbolus Cryptandrus Four-wing Saltbrush Atriplel Canesoens 1.0

The seed will be spread on loose surface soil, raked or worked into the soil about one/half inch, and a straw mulch or a mulch mat placed over the seed to prevent erosion. The seeded area is to be watered daily until a turf is established.

V. Additional fill may be placed around the perimeter foundation wall. All wall materials below the finished exterior grade shall be approved for direct contact with the earth. All fill so placed shall have a minimum slope of 5% away from the building.

W. Footings for foundation walls may be stepped. See architectual drawings for details on footings.


X. Undisturbed area.

Y. Erosion limit for 100 year flood plain based on 385 CFS peak flow for a 6 hour storm (reference E).

The purpose of this grading and drainage plan is to obtain approval for a building permit for an addition to a residential house on lot 201A.

Soils on lot are 30 identified by reference C as Tesajo-Millet sandy loams. The Milletsoil is on ridges of alluvial fans. The Tesajo soil is in swales adjacent to and parallel to the intermittent streams and is subject to flooding. Incuded in this mapping unit are arroyo channels and Rock outcrop, which makes up about 20 percentof the unit. About 20 percent of the surface is covered with granite stones and boulders 1 foot to 15 feet in diamentr. On all soils, runoff is medium and the hazard of water erosion is moderate. The soil is suited for residential buildings and septic drain fields, except where flooding may occur. Soils may be susceptible to consolidation, particularly when wetted, so care must be taken to direct runoff and landscape watering away from building foundations.

A. The proposed construction is to be located on an existing natural ridge adjacent to and north of a tributary to the South Domingo de Baca Arroyo (SDdB arroyo). The .836 acre site (lot 201A) is to be developed with a single family residence. The increase in runoff due to the development is shown in Table A. The runoff after development will follow the same flow pattern that presently exists, with all of the runoff flowing into the SDdB tributary arroyo and 100 year floodplain that crosses the south portion of the lot. Some of the runoff will flow out the driveway, then along the street, then flowing then along the arroyo. No flows from the development are directed to other drainage basins, nor are any increased flows a hazard to downstream property.

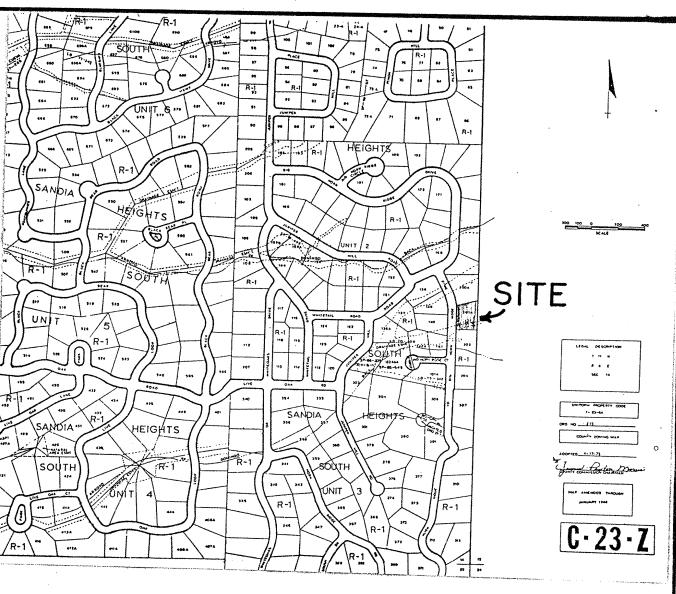

B. The lot is partially within the flood plain of the South Domingo de Baca Arroyo. The floodway insurance map shows a zone AO for the adjacent floodplain, with a depth of 1 feet. Due to the present road embankment and the 24" and 48" culverts which cross through the embankment, a possibility exists for a greater depth of flooding if the culverts where to clog. On sheet 2, the cross section of the embankment shows that overflow would start over the road at an elevation of about 6318.2. At an elevation of one foot, the width of the overflow would be greater than 100 feet, with a capacity that greatly exceeds the storm runoff. A maximum depth of ponding would be about 12 feet, to an elevation of 6319. The lowest natural elevation around the house is about 6324, and lowest elevation of the building pad is 6328. Ponding within the entrapment area will not be a hazard to the existing or proposed structures.

C. The floodplain and drainage basin as presently exists shows little change from that shown on the 1973 aerial topography. The drainage basins are shown on sheet 2, and consist of basin A, 95 acres, with the channel crossing the south part of lot 201A, and basin B, 12 acres, from which the runoff will feed into the same pond as basin A.

D. The estimated flow in the SDdB tributary arroyo is obtained from reference D as follows:

1. For adjacent drainage basins on the North Domingo de Baca arroyo, unit runoffs of between 1136 (for NB 14) to 2586 (for NB15) CFS/ square mile (SM) are estimated. Using the largest of these factors on basins A and B results in the following:

Basin A: 95 acres/640 acres/SM x 2586= 385 CFS.

Basin B: 12 acres/640 acres/SM x 2568= 48 CFS

E. From the above references, it is concluded that the runoff flow due to the 100 year hour storm is less than 400 CFS.

F. Reference F states that an erosion limit of 6 feet per 100 CFS, or an alternative erosion protection be provided. The 24 feet of erosion limit would not impinge on proposed structures. If necessary, the erosion limit can be reduced, based on the following observations:

1. The floodplain in this vicinity is poorly mapped. The floodplain depth is designated as 1 foot, but the map is outlined to a depth of about 5 feet.

2. The flood plain mapping does not exclude the boulder and earth mound that projects into the channel in the vicinity of the tank.

3. Erosion is severely limited by the natural armoring of the channel which occurs due to the presence of very large boulders and

4. Channel flow is limited to the capacity of the culverts downstream, about 125 CFS. Greater flows will result in detention, and a stilling of the velocity of flow, at least until such time that the road embankment washes away, which is a remote event.


A. The proposed construction is not within a designated 100 year floodplain.

B. Construction as proposed will not increase the hazard from flooding to downstream properties.

C. The proposed grading and construction will protect the property from reasonable changes in the flood plain as designated on the current floodway map.

D. This Grading and Drainage Plan does not propose changes to the FLOODWAY or FIRM maps. REVISED EASEMENT JULY 19 1995

APPROVALS, REVISIONS CERTIFICATION FEB 20 1997

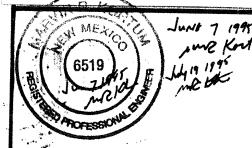

Preliminary

MARVIN R. KORTUM, P.E. Civil Engineering NM PE 6519

1605 Speakman Drive, S.E. Albuquerque, New Mexico 87123 (505) 299-0774

GRADING AND DRAINAGE PLAN LOT 201A. SANDIA HEIGHTS SOUTH, UNIT 2 201 BIG HORN RIDGE DRIVE


MRK

C23/D49

C-23

June 7, 1995

DATE

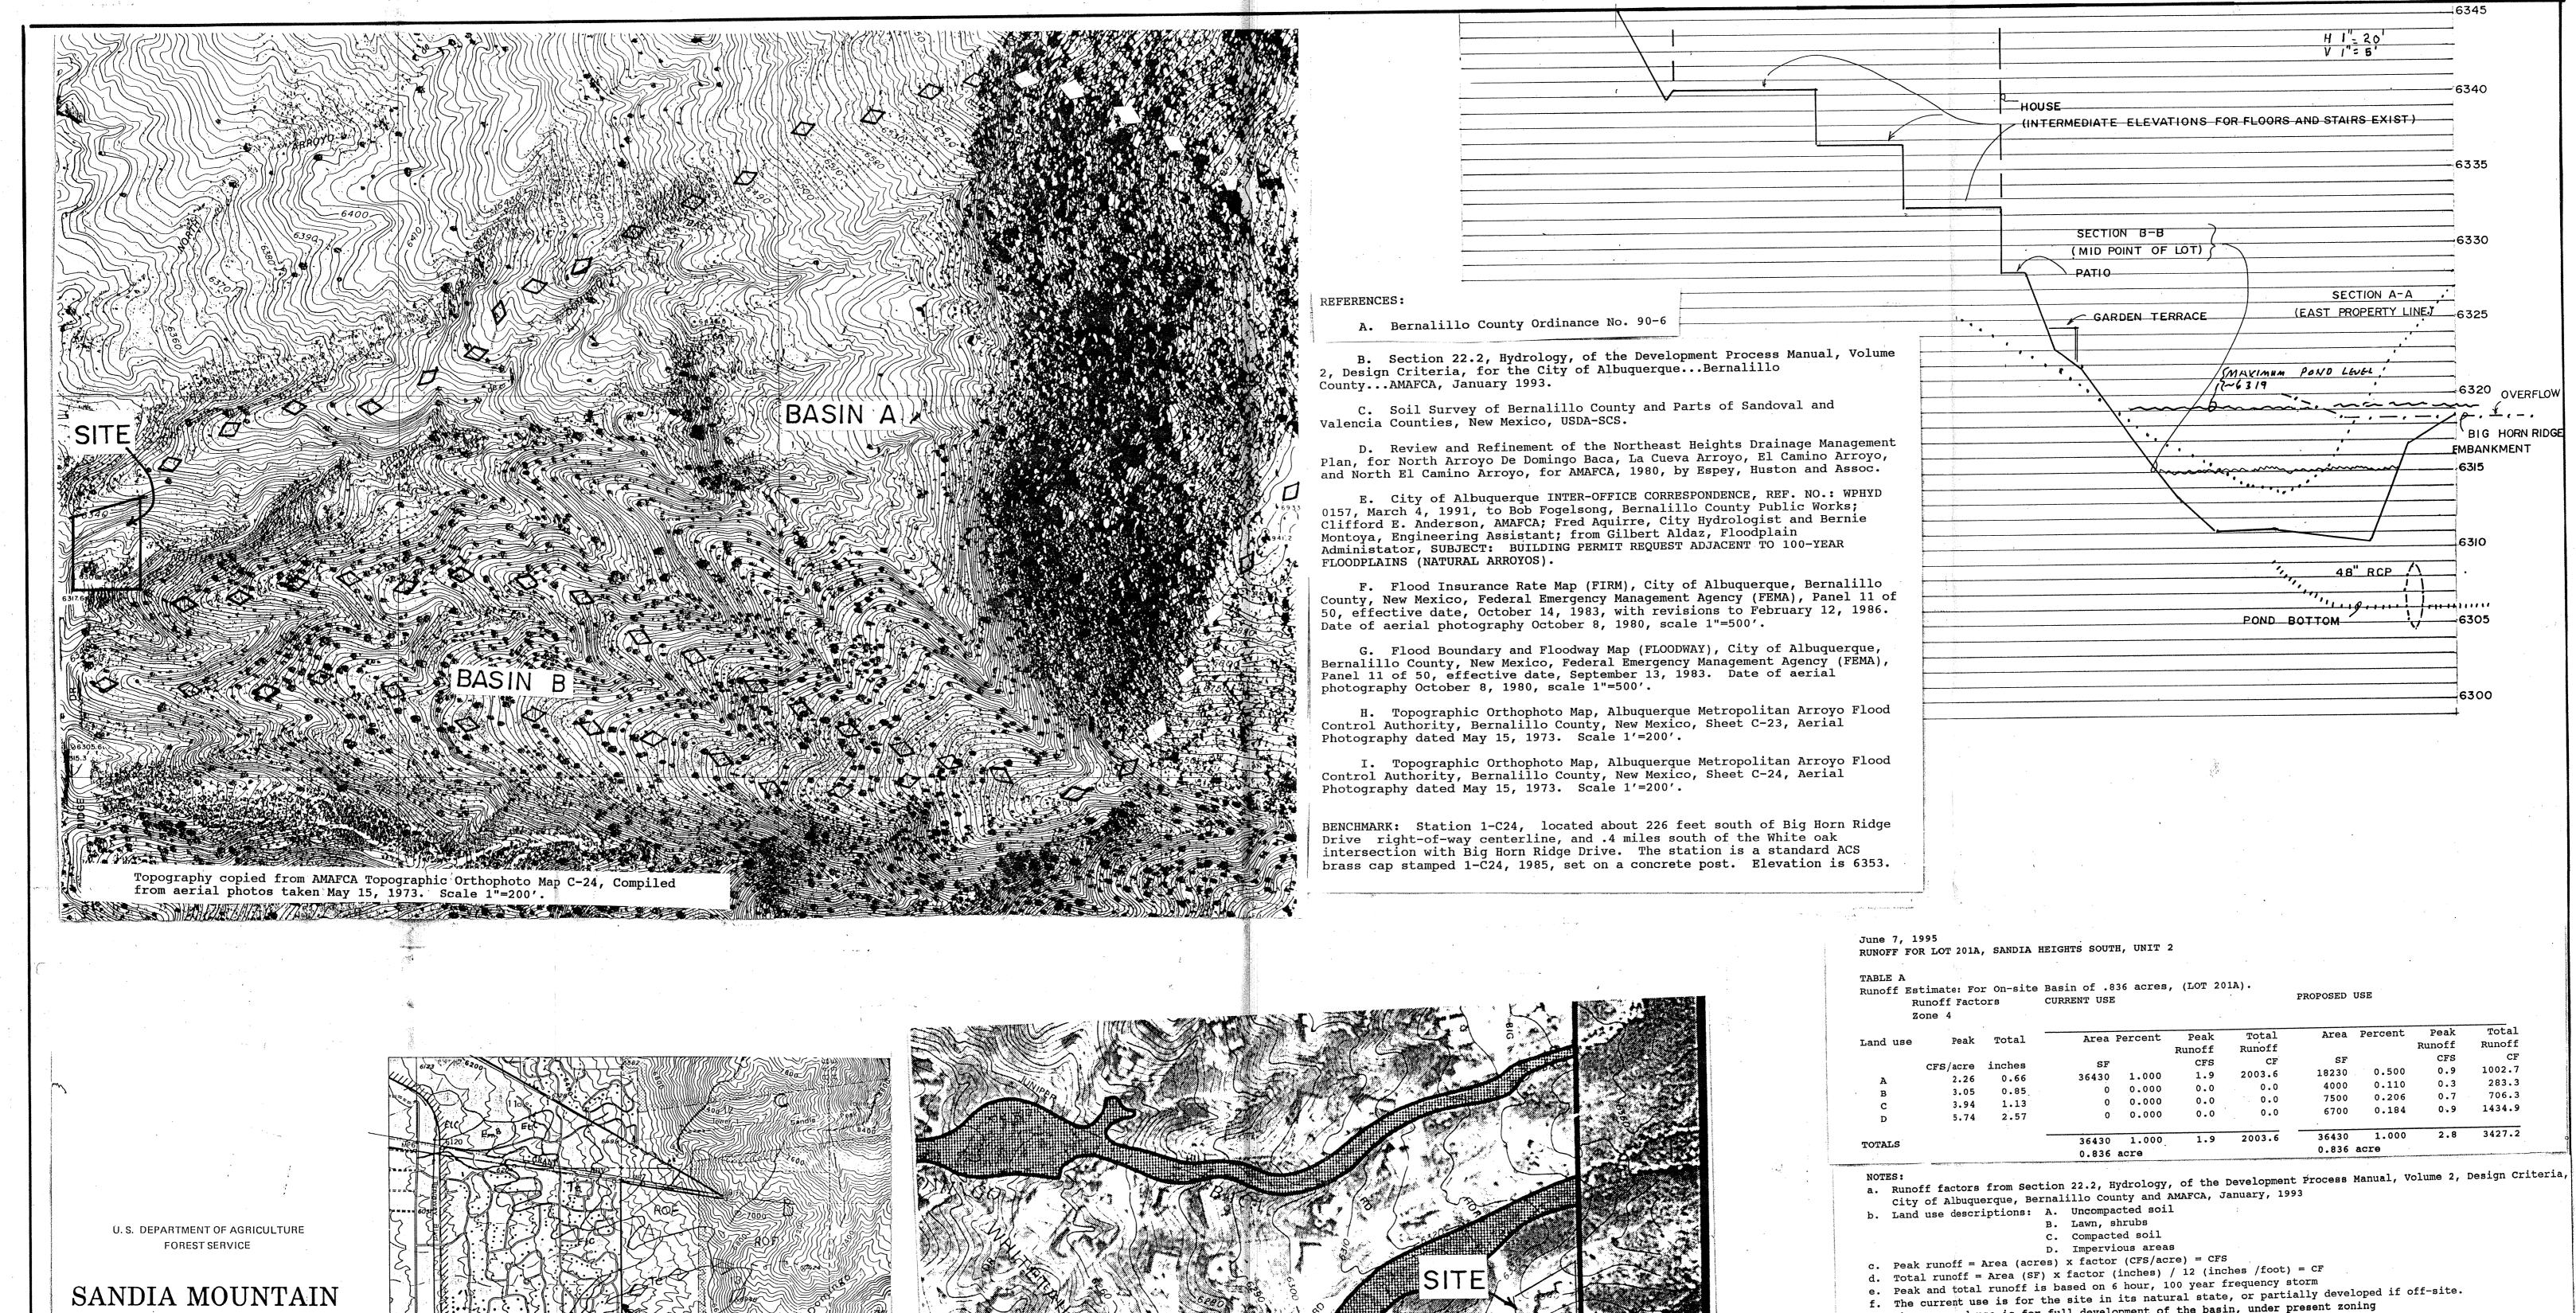

Topography copied from Floodway Flood Boundary and Floodway Map, City of Albuquerque, New Mexico, Panel 11 of 50. Compiled from aerial photos taken

October 8, 1980. Scale 1"=200'.

SANDIA MOUNTAIN

WILDERNESS

Cibola National Forest

NEW MEXICO

Contour Interval = 40 Feet

MAP LEGEND

June 7, 1995 DATE MARVIN R. KORTUM, P.E.

Civil Engineering NM PE 6519

1605 Speakman Drive, S.E. Albuquerque, New Mexico 87123 (505) 299-0774

GRADING AND DRAINAGE PLAN LOT 201A, SANDIA HEIGHTS SOUTH, UNIT 2 201 BIG HORN RIDGE DRIVE

PROJECT NO. C23/D49 C-23

Approved by letter, City of Albuquerque/County of Bernalillo Floodplain Administrator, (C23/D49)(PWD 95-107), August 10,

The proposed use is for full development of the basin, under present zoning

Preliminary

APPROVALS, REVISIONS

SHEET OF