
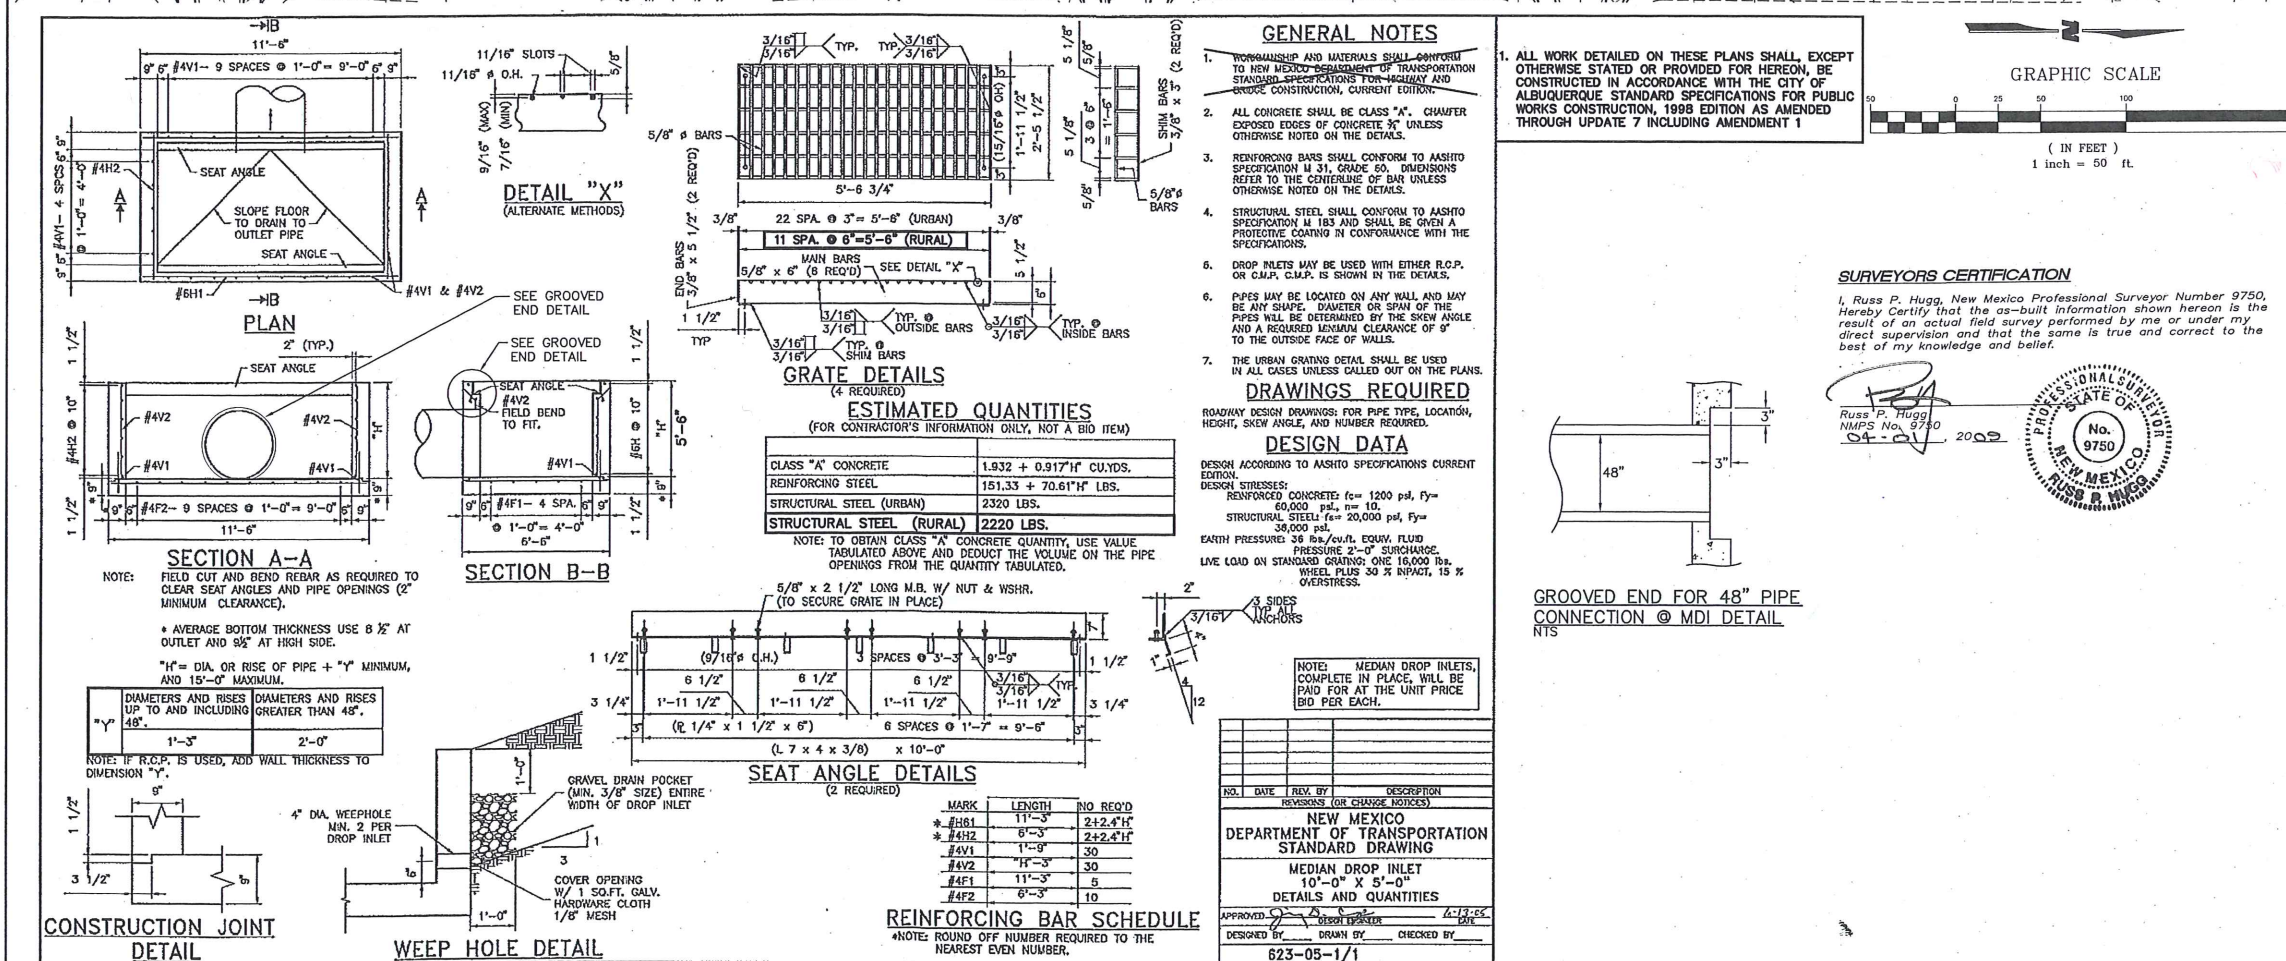


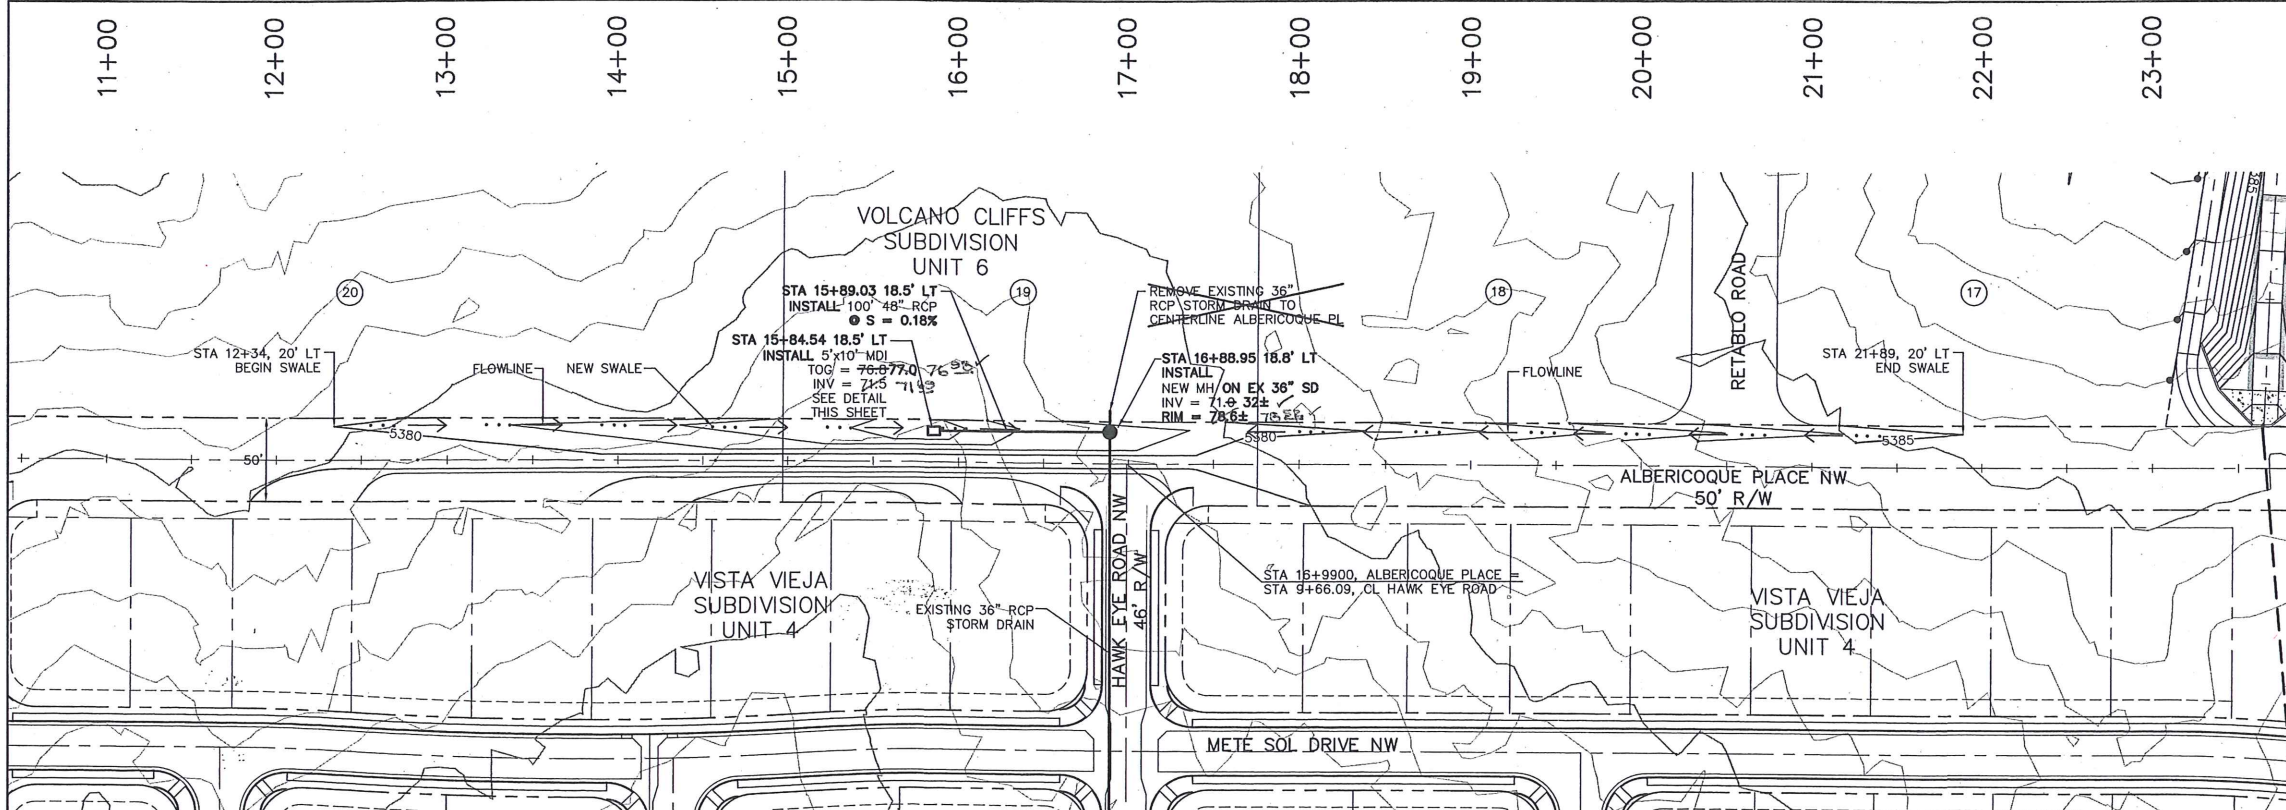

| AS-BUILT INFORMATION |                                     | BENCH MARKS                               |      | SURVEY INFORMATION |    | ENGINEER'S SEAL |    |
|----------------------|-------------------------------------|-------------------------------------------|------|--------------------|----|-----------------|----|
| CONTRACTOR           | SALES ENGINEERING CONSULTANTS, INC. | THE STATION IS A 3 1/2" ALUMINUM CAP SET  | DATE | NO.                | BY | WCI             | BY |
| DESIGNED BY          | SALES ENGINEERING CONSULTANTS, INC. | FLUSH IN THE LAVA OUTCROP, AND IS STAMPED |      |                    |    |                 |    |
| DRAWN BY             | SALES ENGINEERING CONSULTANTS, INC. | "ACS 8-C10, 1986". (NAD 1927).            |      |                    |    |                 |    |
| CHECKED BY           | SALES ENGINEERING CONSULTANTS, INC. | X= 361860.83, Y= 1521476.37               |      |                    |    |                 |    |
| RECORDED BY          | SALES ENGINEERING CONSULTANTS, INC. | ELEVATION = 5390.130 FT. (SLD 1929)       |      |                    |    |                 |    |

**WILSON & COMPANY**  
4900 LANG AVENUE NE  
ALBUQUERQUE, NM 87110  
(505) 348-4000

**CITY OF ALBUQUERQUE  
PUBLIC WORKS DEPARTMENT  
ENGINEERING GROUP**

**VISTA VIEJA SUBDIVISION  
36" INTAKE STRUCTURE**

| DESIGN REVIEW COMMITTEE | CITY ENGINEER APPROVAL | Mo./Day/Yr. | Mo./Day/Yr. |
|-------------------------|------------------------|-------------|-------------|
| APPROVE<br>DEC 23 2008  | APPROVE<br>DEC 23 2008 |             |             |

City Project No. 7633.84. Design Map No. D-9. Sheet 19A of 35.