


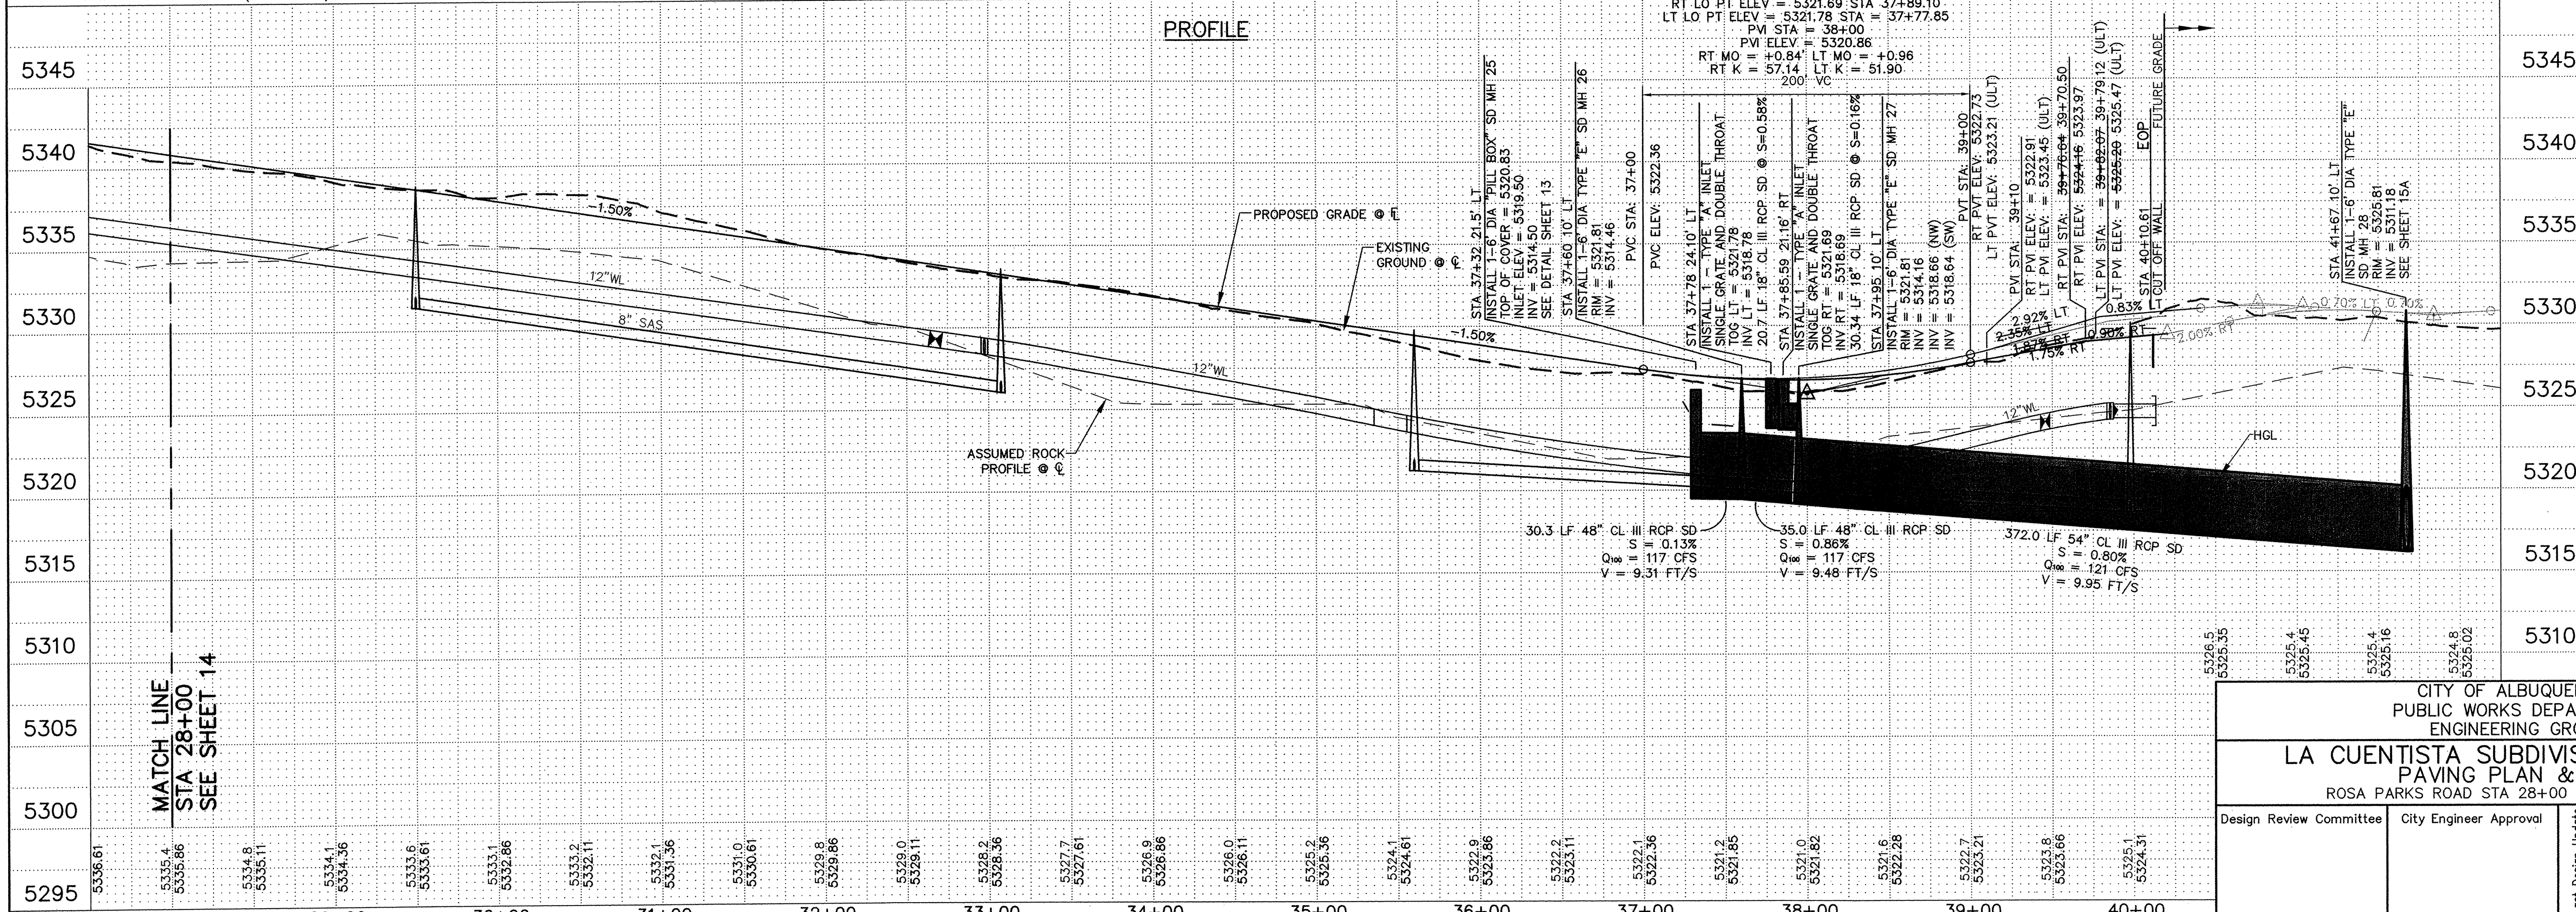

PROJECT LOCATION DATE		ENGINEER'S SEAL 		SURVEY INFORMATION FIELD NOTES NO. BY DATE AERIAL MAPPING, WCI 05/01 BOUNDARY, WCI 06/01 BOUNDARY, WCI 10/01		BENCH MARKS ACS 1 3/4" ALUMINUM DISK STAMPED "ACS BM 5-D11", LOCATED 72' ± ESE OF THE CENTER OF THE CUL-DE-SAC AT THE SOUTH END OF RIDGEWAY DR. NW. EXPOSED TO LAVA ROCK IN OUTCROPPING		AS-BUILT INFORMATION CONTRACTOR INSPECTOR'S STARTED BY DATE FIELD VERIFICATION BY DATE CORRECTED BY DATE MICRO-FILM INFORMATION RECORDED BY DATE NO.	
3-4-00 PMT TRANS FOR RED KIMMICK DR/AGUA PARKS RD NO. DATE REMARKS BY WILSON & COMPANY, ENGINEERS & ARCHITECTS DESIGNED BY KIS DATE DEC 2004 DRAWN BY WKL DATE DEC 2004 CHECKED BY DSA DATE DEC 2004		REVISIONS							