


\\USCAIRV2-SR011VOL_PD\XXXXXXXXX_LC306-CAD\02-SHEETS\XXXX - L2.101 - C - PLAN.DWG

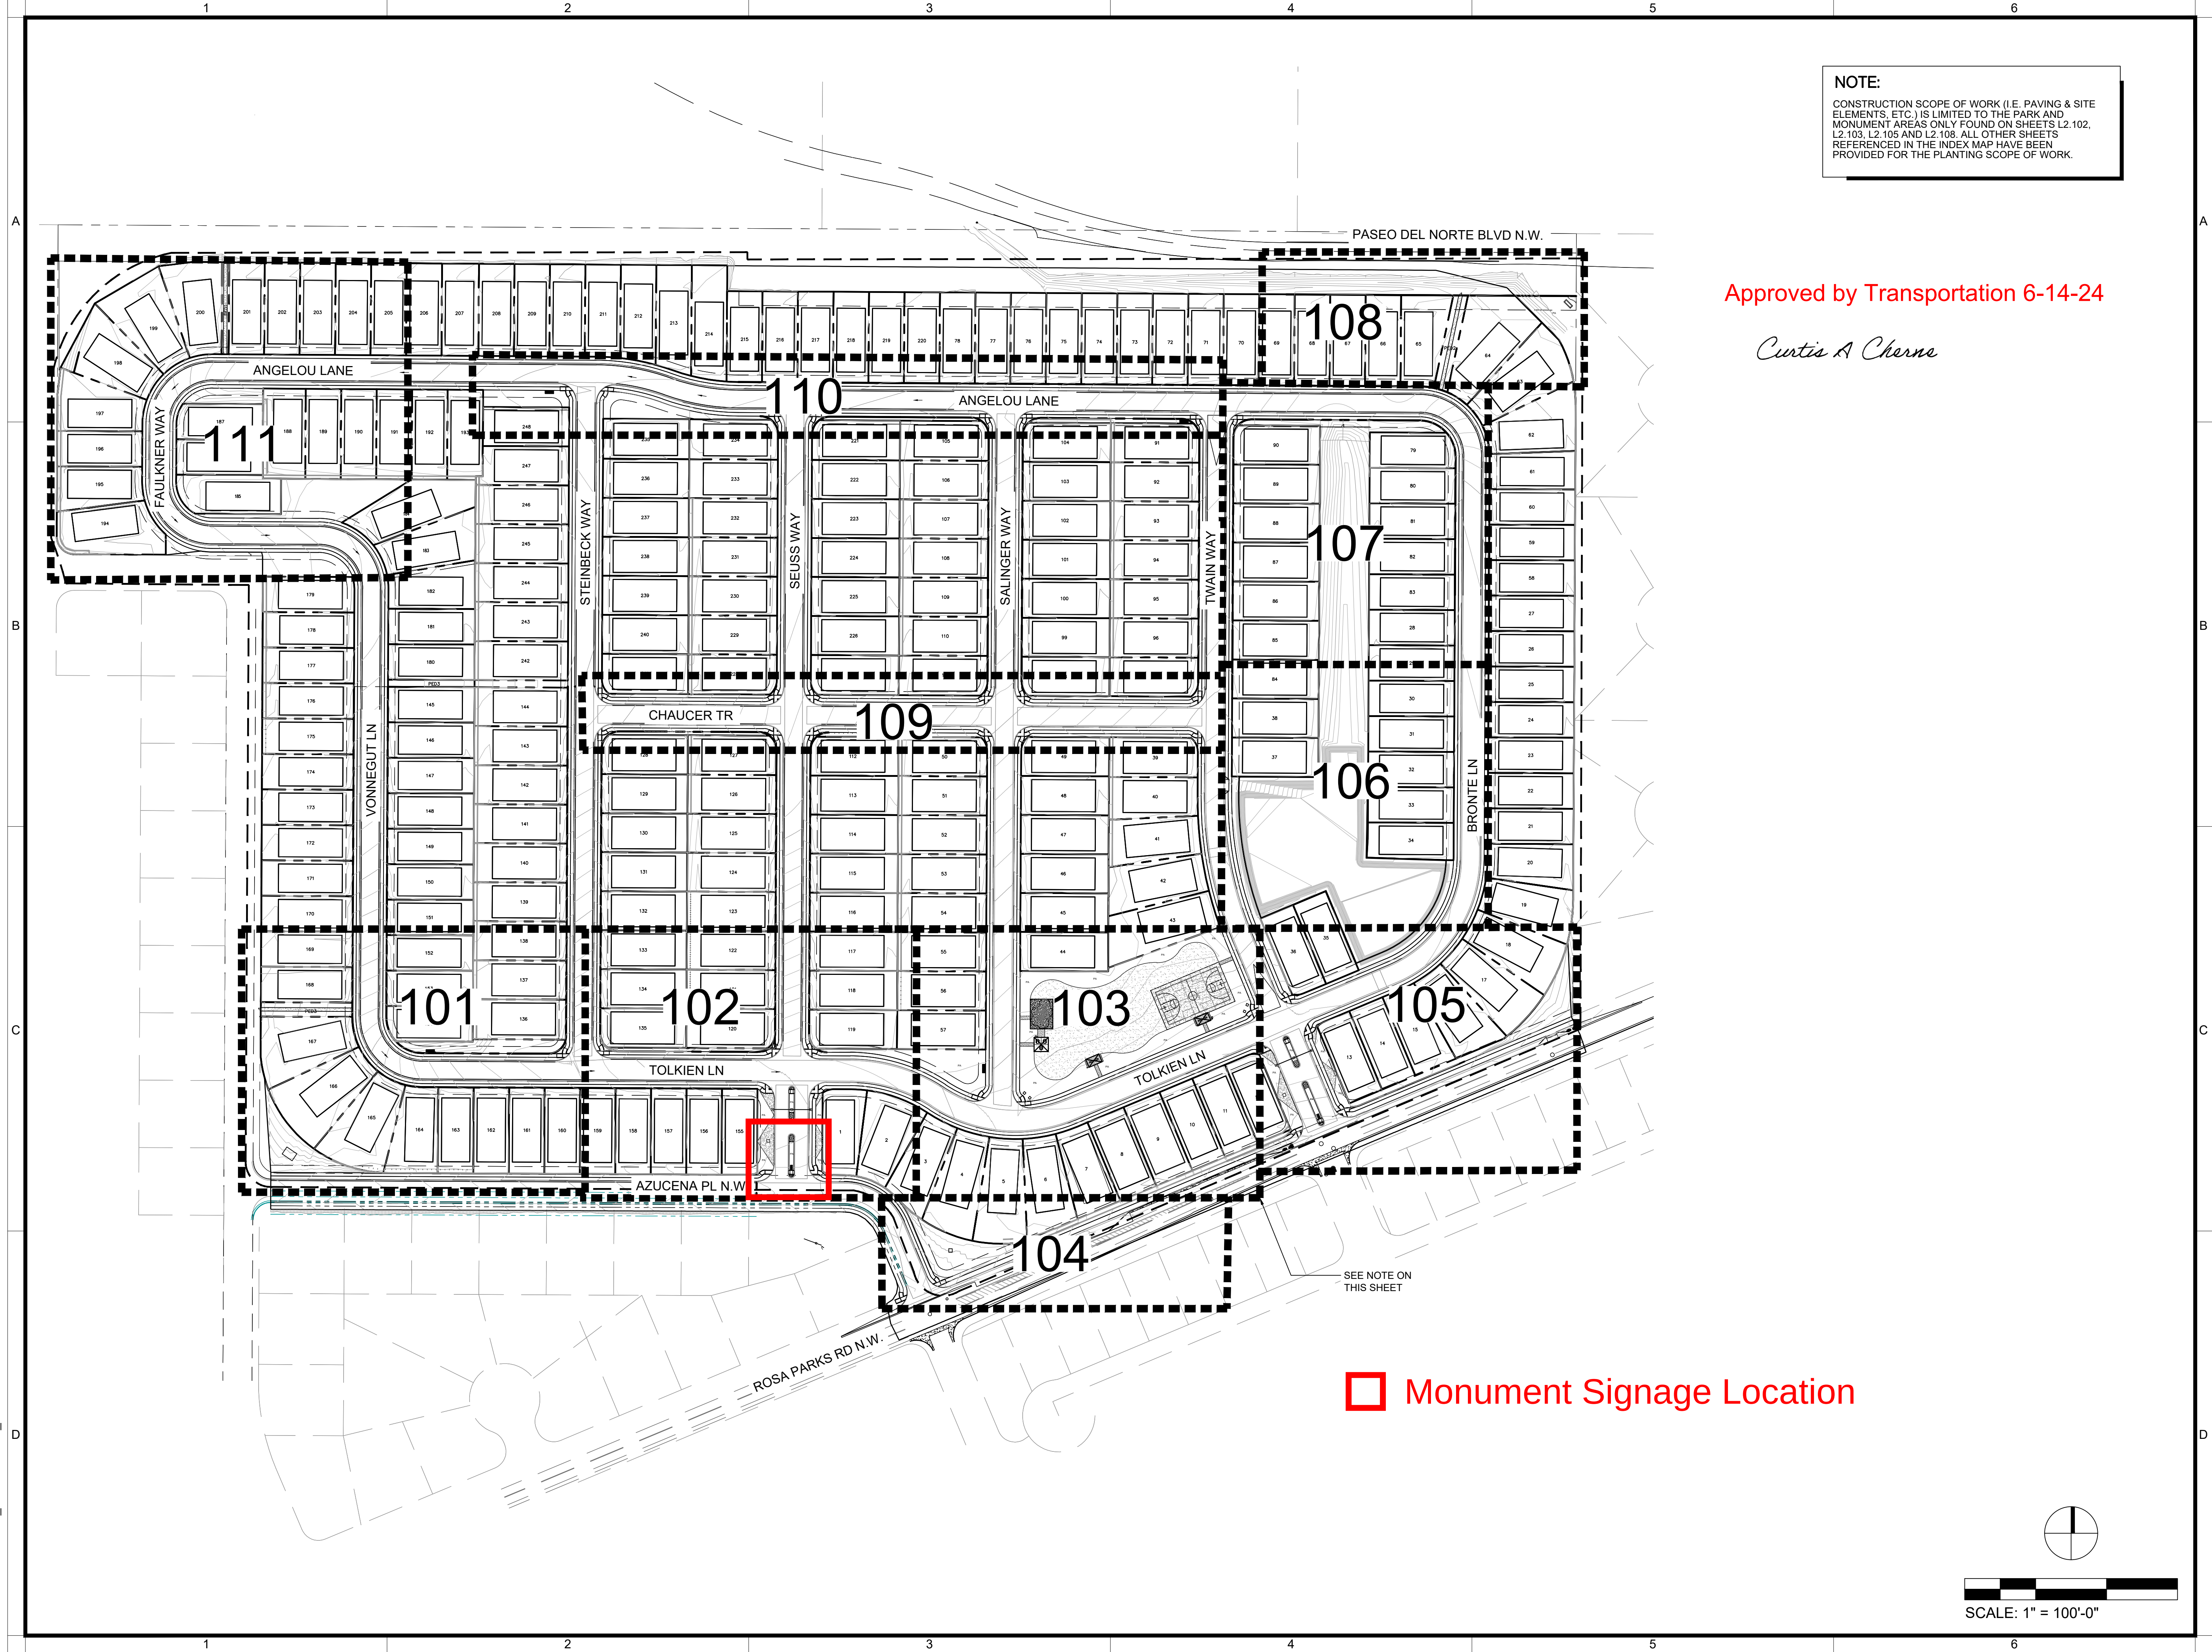

NOTE:
CONSTRUCTION SCOPE OF WORK (I.E. PAVING & SITE ELEMENTS, ETC.) IS LIMITED TO THE PARK AND MONUMENT AREAS ONLY FOUND ON SHEETS L2.102, L2.103, L2.105 AND L2.108. ALL OTHER SHEETS REFERENCED IN THE INDEX MAP HAVE BEEN PROVIDED FOR THE PLANTING SCOPE OF WORK.

Approved by Transportation 6-14-24

Curtis A. Chernes

BrightView
Design Group

PLANNING
LANDSCAPE ARCHITECTURE
URBAN DESIGN
8 HUGHES, SUITE 150
IRVINE, CALIFORNIA 92618
(949) 238-4900

BRIGHTVIEW DESIGN GROUP EXPRESSLY RESERVES ITS RIGHTS IN THESE PLANS. THESE PLANS ARE NOT TO BE REPRODUCED, COPIED, OR TRANSMITTED IN ANY FORM OR BY ANY MEANS, ELECTRONIC OR MECHANICAL, WITHOUT THE WRITTEN PERMISSION OF BRIGHTVIEW DESIGN GROUP.

PLAN REVISION DESCRIPTION

△

△

△

811

Know what's below.
Call 811 before you dig.

REFER TO THE SHEET INDEX ON SHEET L2.100 FOR A COMPLETE LIST OF DRAWINGS.

PULTE GROUP
LA CUENTISTA SUBDIVISION
PASEO DEL NORTE BLVD.
DESIGN DEVELOPMENT PLANS
ALBUQUERQUE, NEW MEXICO 87114

CONSTRUCTION DOCUMENTS

PLAN SET	ISSUE DATE	PROJECT STATUS LOG:
A	08/18/2023	DESIGN DEVELOPMENT
B	10/13/2023	DESIGN DEVELOPMENT
C	11/17/2023	CONSTRUCTION DOCUMENTS


BVDG JOB NUMBER: 1738111
DRAWN BY: CB

PLAN CHECK NO:
SHEET TITLE
OVERALL SITE
PLAN


SHEET NUMBER
L2.100

BRIGHTVIEW DESIGN GROUP

Monument Signage Location

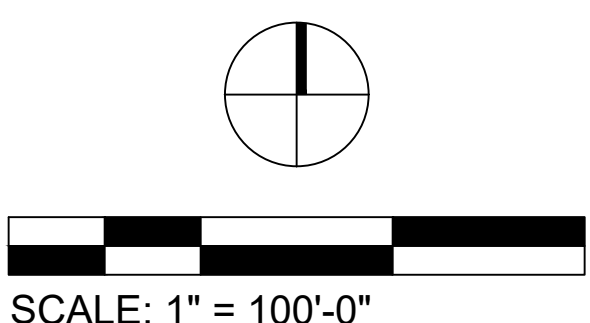

I:\USCAIRV2-SR01\VOL_PDI\XXXXXXX_LC306-CAD\02-SHEETS\XXXX - L2.101 - C - PLAN.DWG

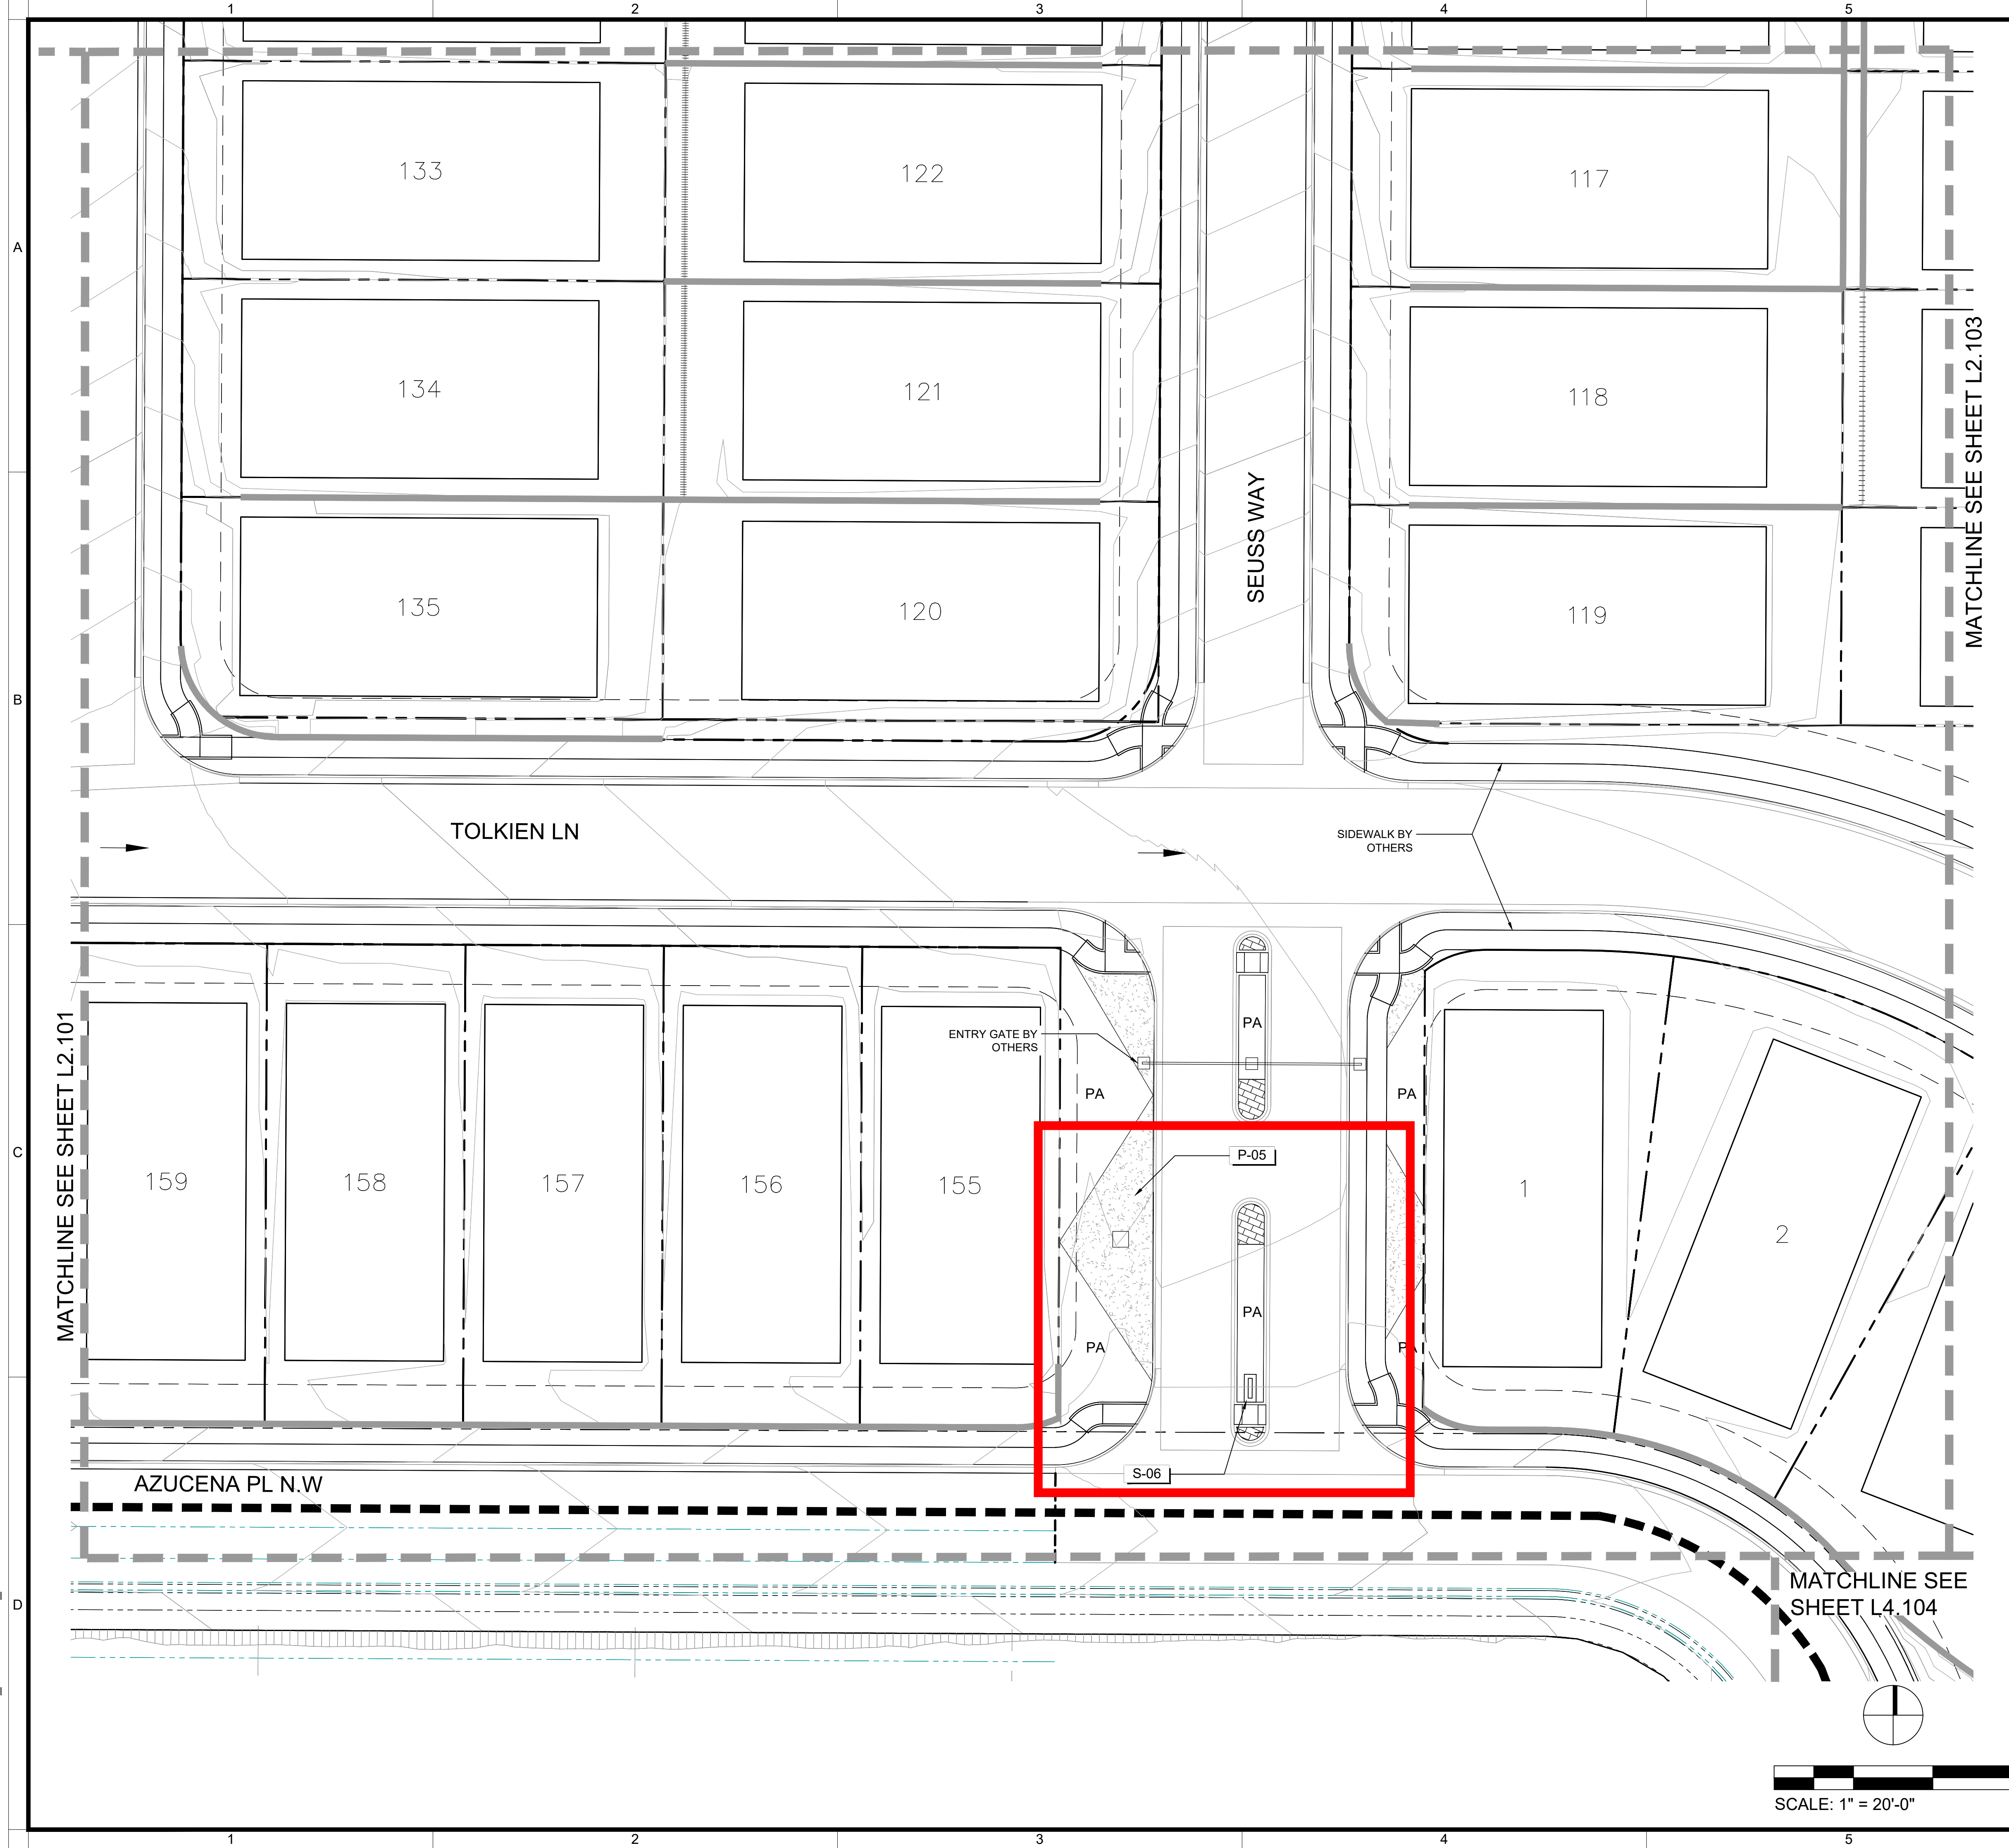

CONSTRUCTION LEGEND

PAVING LEGEND

CODE	DESCRIPTION	DETAIL
P-01	PEDESTRIAN CONCRETE PAVING	A,B / L2.401
P-02	STABILIZED DECOMPOSED GRANITE	C / L2.401
P-03	DEEPEENED CONCRETE CURB (AT TOT LOT)	D / L2.401
P-04	ENGINEERED WOOD FIBER	D / L2.401
P-05	ARTIFICIAL TURF	E / L2.401
P-06	BASKETBALL COURT CONCRETE PAVING	A / L2.402

WALL LEGEND

CODE	DESCRIPTION	DETAIL
W-01	STONE PILLAR	A-H / L2.406


SITE ELEMENT LEGEND

CODE	DESCRIPTION	DETAIL
S-01	BASKETBALL HOOP	B / L2.402
S-02	PLAYGROUND EQUIPMENT	D / L2.403
S-03	SHADE STRUCTURE 1	C / L2.402
S-04	SHADE STRUCTURE 2	F / L2.402
S-05	MONUMENT SIGNAGE	A / L2.405
S-06	NEIGHBORHOOD ENTRY SIGNAGE	A / L2.404
S-07	TRASH RECEPTACLE	E / L2.402
S-08	BENCH	B / L2.403
S-09	TRASH RECEPTACLE	E / L2.402

CONSTRUCTION NOTES

- THIS PLAN IS FOR THE PURPOSE OF HORIZONTAL CONTROL (STAKING) OF LANDSCAPE CONSTRUCTION FEATURES AND THE CONSTRUCTION REFERENCE OF SITE CONSTRUCTION FEATURES DETAILED HEREIN.
- REFER TO THE CIVIL ENGINEERING DRAWINGS FOR THE VERTICAL CONTROL OF ALL CONSTRUCTION FEATURES AND FOR THE HORIZONTAL CONTROL AND CONSTRUCTION REFERENCE OF FEATURES NOT DESCRIBED HEREIN.
- REFER TO THE CIVIL ENGINEERING DRAWINGS FOR ALL LANDSCAPE AREA DRAINS. LOCATE DRAINS A MINIMUM OF 2'-0" FROM HARDSCAPE.
- UTILITY LOCATIONS SHOWN FOR REFERENCE ONLY. REFER TO CIVIL ENGINEER'S PLAN FOR PRECISE LOCATIONS.
- ALL CALL OUTS AND DIMENSIONS ONCE TYPICAL PER SHEET.
- ALL DIMENSIONS ARE STAKED PERPENDICULAR OR PARALLEL TO ARCHITECTURE. ALL ANGLES SHALL BE 90 DEGREES UNLESS OTHERWISE NOTED.
- ALL WALKWAY FORMS SHALL SLOPE AS SHOWN ON THE CIVIL ENGINEERS PRECISE GRADING PLANS.
- CONTRACTOR TO PROVIDE ISOLATION JOINTS ADJACENT TO ARCHITECTURE AND HARDSCAPE FEATURES.

INDEX MAP

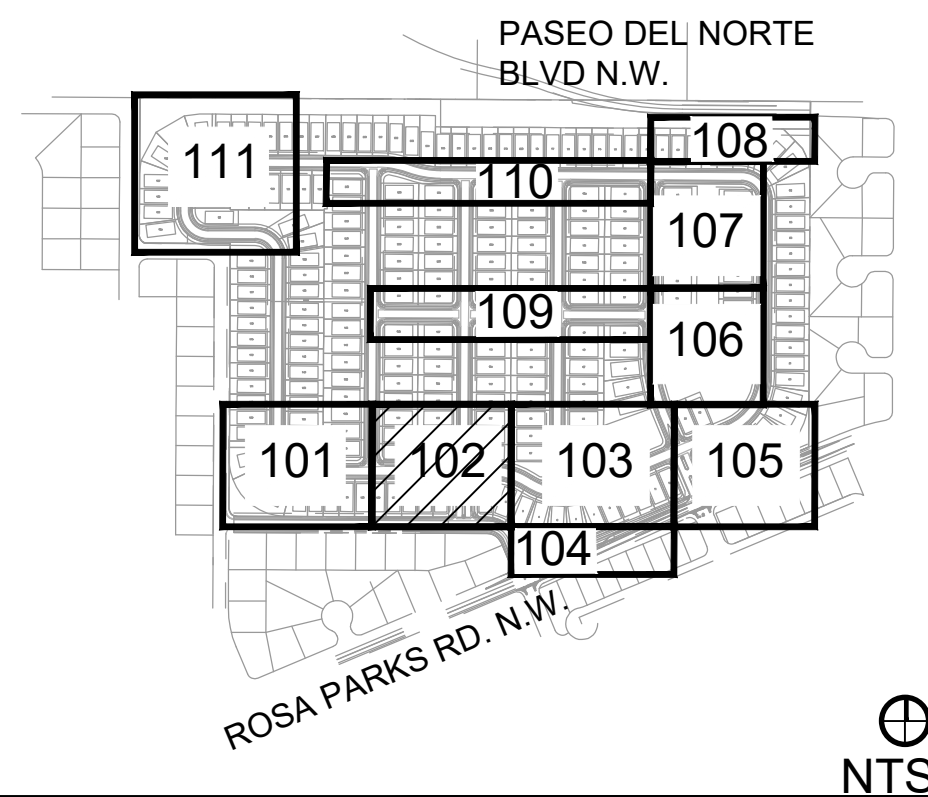

BrightView
Design Group

PLANNING
LANDSCAPE ARCHITECTURE
URBAN DESIGN

8 HUGHES, SUITE 150
IRVINE, CALIFORNIA 92618
(949) 238-4900

PLAN REVISION DESCRIPTION

△	
△	
△	

811

Know what's below.
Call 811 before you dig.

REFER TO THE SHEET INDEX ON SHEET L2.101 FOR A COMPLETE LIST OF DRAWINGS.

PULTE GROUP

LA CUENTISTA SUBDIVISION

PASEO DEL NORTE BLVD.

DESIGN DEVELOPMENT PLANS
ALBUQUERQUE, NEW MEXICO 87114

PLAN SET	ISSUE DATE	PROJECT STATUS LOG:
A	08/18/2023	DESIGN DEVELOPMENT
B	10/13/2023	DESIGN DEVELOPMENT
C	11/17/2023	CONSTRUCTION DOCUMENTS


BVDG JOB NUMBER: 1738111
DRAWN BY: CB
PLAN CHECK NO:
SHEET TITLE

CONSTRUCTION PLAN

SHEET NUMBER

L2.102

BRIGHTVIEW DESIGN GROUP

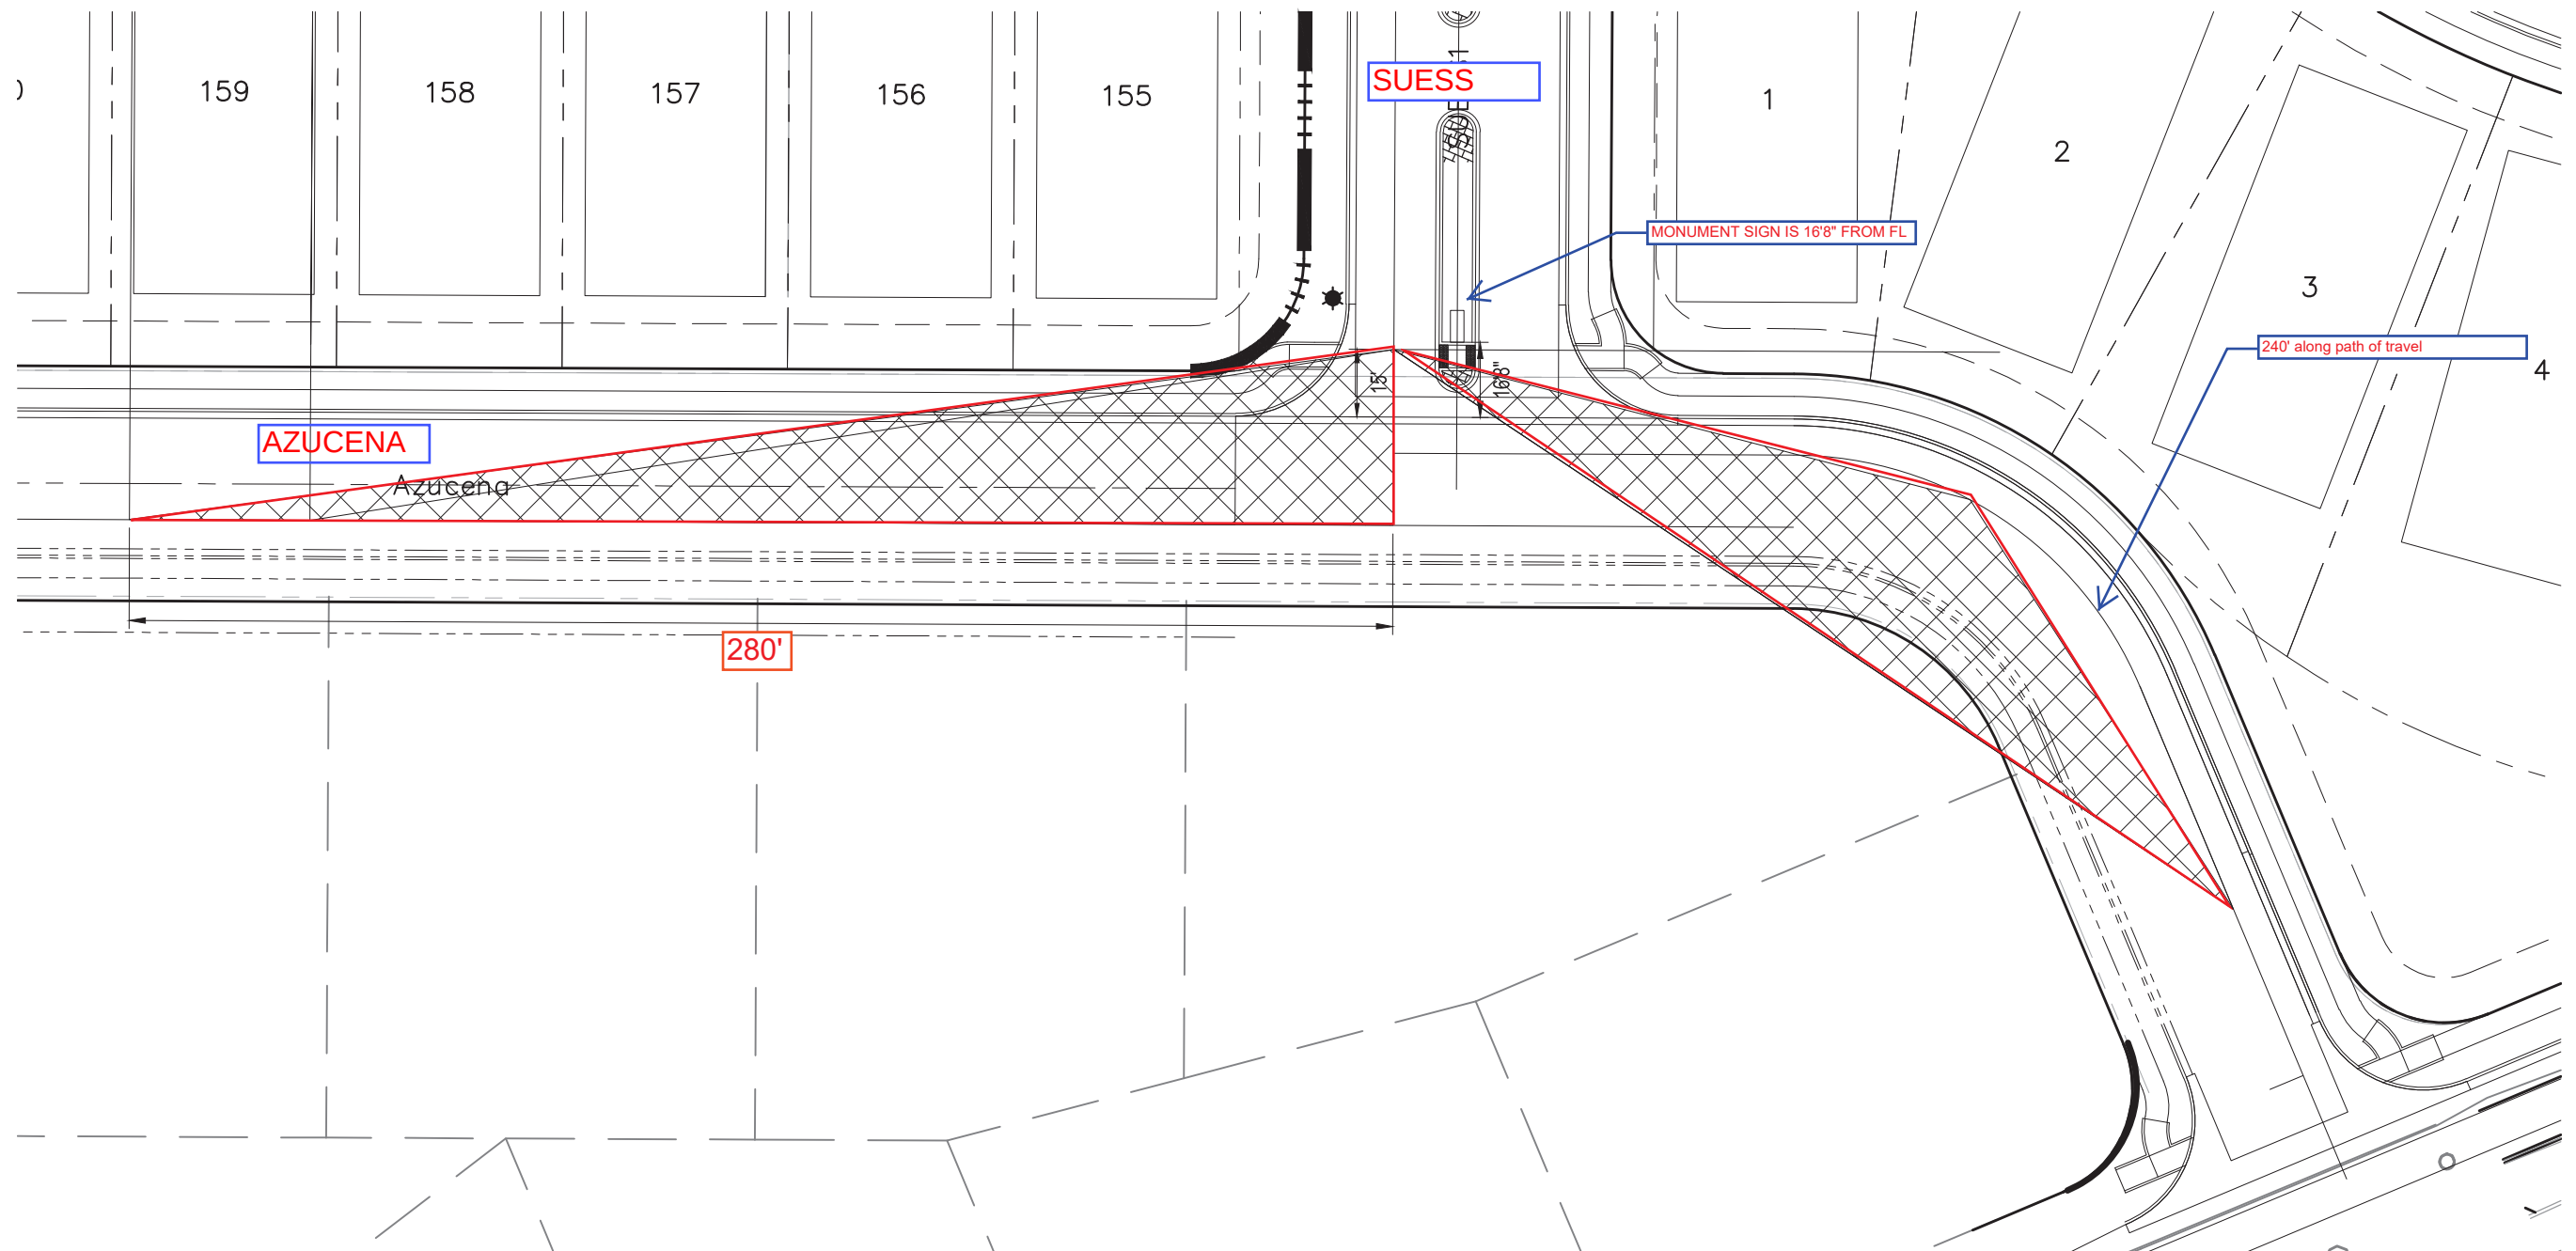

1"=40'
11X17

9

8

7

6

5

4

3

2

1

GENERAL STRUCTURAL NOTES

DESIGN CRITERIA

1. BUILDING CODE: NMCBC 2021

2. DEAD LOAD:

2.1. CONCRETE WALL = 150 PCF

2.2. ROCK IN GABION BASKETS = 110 PCF

3. WIND LOAD: $V_{ULT} = 104$ MPH (3 SECOND GUST), RISK CATEGORY II, EXPOSURE C

STRUCTURAL STEEL

4. DESIGN AND FABRICATION ACCORDING TO ANSI/AISC 360

5. ANGLE (L): ASTM A36, $F_y = 36$ KSI

6. STEEL PLATE (PL): ASTM A36

WELDING (STEEL)

7. DESIGN AND FABRICATION ACCORDING TO AWS D1.1.

8. WELDING SHALL BE BY WELDERS HOLDING VALID CERTIFICATES AND HAVING CURRENT EXPERIENCE IN THE TYPE OF WELD SHOWN ON THE DRAWINGS OR NOTES.

9. ALL FULL PENETRATION WELDS SHALL BE TESTED AND CERTIFIED BY AN INDEPENDENT TESTING LABORATORY

10. E70XX ELECTRODES FOR SMAW PROCESS

11. ER70S-X, E70C-XC ELECTRODES FOR GMAW PROCESSES

12. E7XT-X OR E7XT-XM ELECTRODES FOR FCAW PROCESSES

13. $\frac{3}{16}$ " MIN FILLET WELD UNLESS OTHERWISE NOTED

FOOTING NOTES

14. CONCRETE COMPRESSIVE STRENGTH, $f'_c = 3000$ PSI AT 28 DAYS MIN. DESIGN BASED ON $f'_c = 2500$ THEREFORE PER IBC SECTION 1705.3, EXCEPTION 2.3, NO SPECIAL INSPECTION REQUIRED.

15. CONCRETE PLACEMENT AND QUALITY SHALL BE PER RECOMMENDATIONS IN ACI 614, ACI 301 AND ACI 318. MECHANICALLY VIBRATE ALL CONCRETE WHEN PLACED, REMOVE ALL DEBRIS FROM FORMS BEFORE PLACING CONCRETE.

16. CONCRETE POURED AGAINST UNDISTURBED NATIVE SOILS

17. NATIVE SOILS ASSUMED TO BE IBC CLASS 5, WORST CASE PRESCRIPTIVE IBC 2021/CBC 2022 TABLE 1806.2

17.1. SOIL ALLOWABLE LATERAL BEARING CAPACITY = 100 PSF/FT

17.2. ALLOWABLE BEARING AT GRADE= 1500 PSF

POST INSTALLED ANCHORS IN CONCRETE

18. DESIGN AND INSTALLATION PER:

18.1. ICC-ES ESR-2713 FOR SIMPSON TITEN HD

SPECIAL INSPECTIONS

19. NOT REQUIRED

STRUCTURAL OBSERVATION

20. NOT REQUIRED

OTHER NOTES

21. REFER TO ART DRAWINGS FOR SIGN FINISHES, COLORS AND LIGHTING SPECIFICATIONS.

LA CUENSTISTA

(SIGN 2)

6401 AZUCENA PLACE NW. & 6301 ROSA PARKS DRIVE NW.

ALBUQUERQUE, NM 87120

SHEET INDEX

SHEET	DESCRIPTION
1	TITLE AND GENERAL NOTES
2	STRUCTURAL VIEWS

YESCO®

ENGINEERING

www.yesco.com

© 2022 YESCO LLC, All rights reserved

Revisions

No.	Date
Orig	8/15/2023
1	
2	
3	
4	
5	

Signed 10/16/2023

CARL R. MEYERS

NEW MEXICO

28105

PROFESSIONAL ENGINEER

Drawn by.....CARL MEYERS

Checked by.....

LA CUENTISTA

ROSA PARKS RD NW & REDROOT RD
ALBUQUERQUE, NM 87120


Account Exec.....DERRICK CAMPBELL
Designer.....LARRY COHEN

Date: 10/16/2023

Project No.
OPY-58013

S1 of 2

C:\Users\jcampbell\Documents\YESCO\Current\808023\LA Cuentista - Albuquerque, NM\DWG\OPY-58013\LA Cuentista - Albuquerque, NM.dwg (8/15/2023)

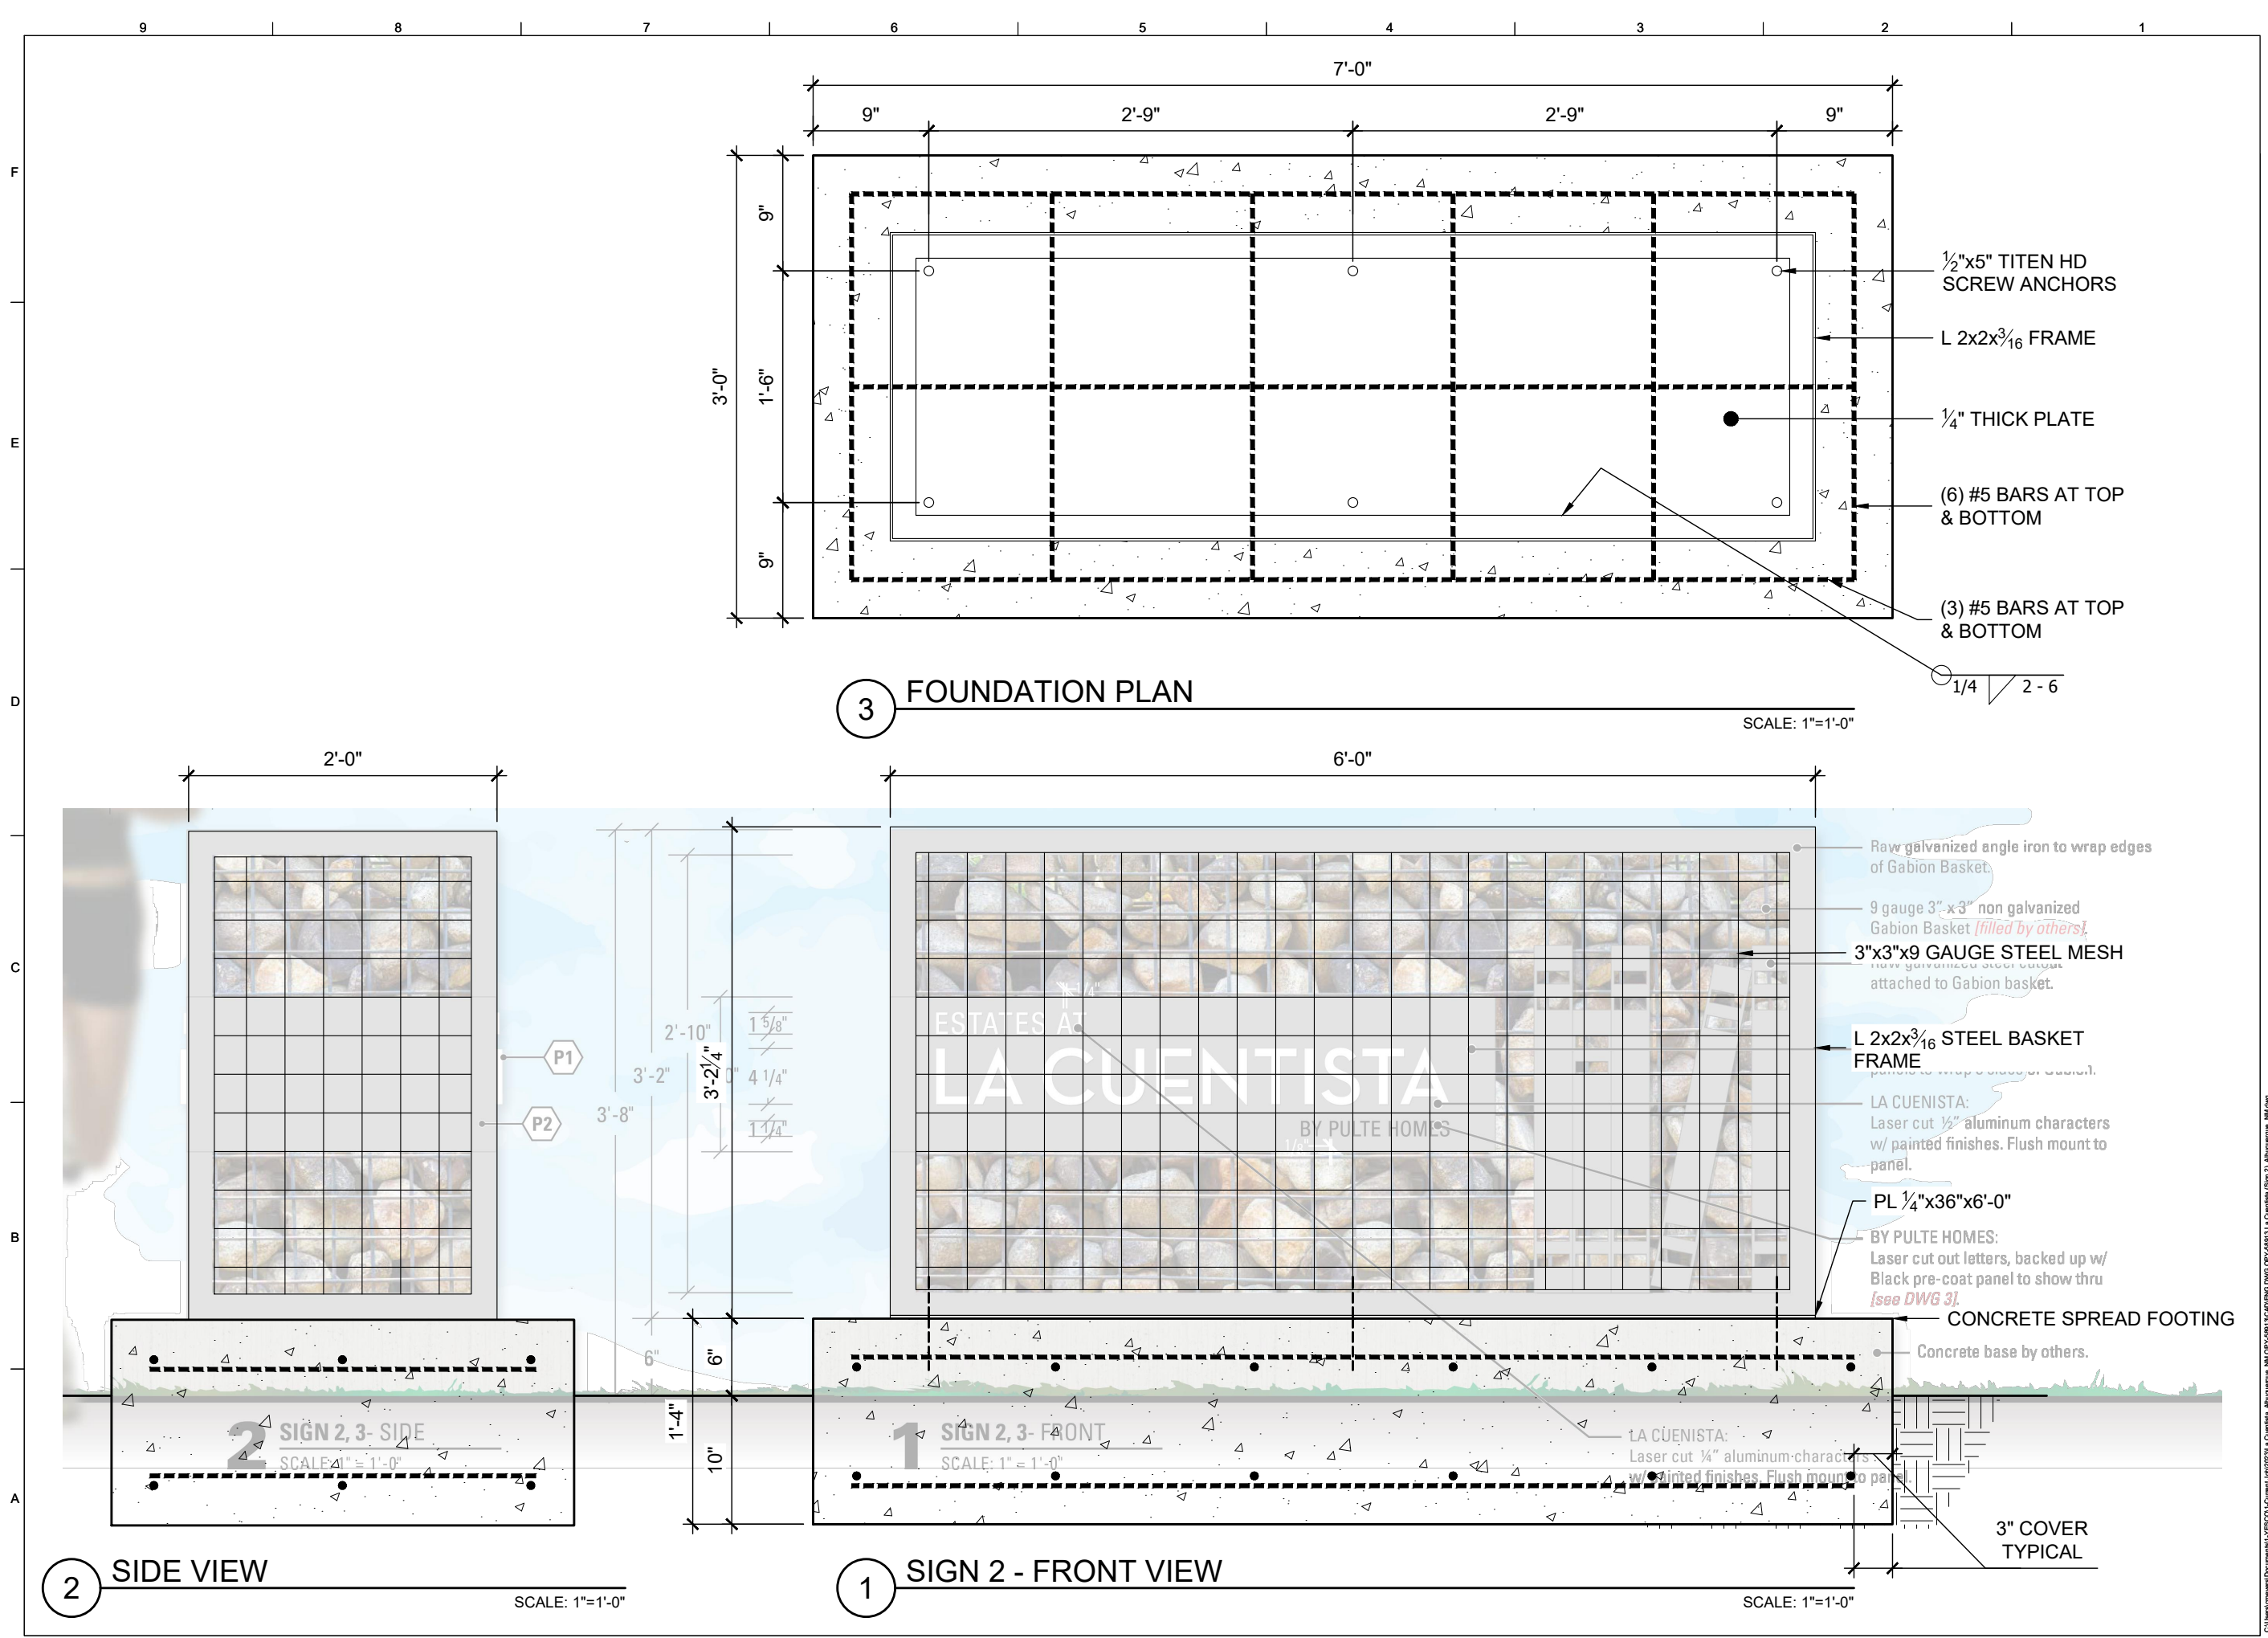



ENGINEERING

www.yesco.com

© 2022 YESCO LLC, All rights reserved

Revisions

No.	Date
Orig	8/15/2023
1	
2	
3	
4	
5	
6	
7	
8	
9	
10	

Signed 10/16/2023



Drawn by.....CARL MEYERS

Checked by.....

LA CUENTISTA

ROSA PARKS RD NW & REDROOT RD
ALBUQUERQUE, NM 87120

Account Exec.....DERRICK CAMPBELL
Designer.....LARRY COHEN

Date: 10/16/2023

Project No.
OPY-58013

S2 of 2