


CITY OF ALBUQUERQUE

Planning Department
Suzanne Lubar, Director

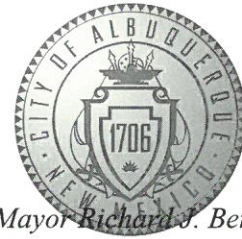

Mayor ~~Richard J.~~ Berry

November 21, 2017

David Soule, P.E.
Rio Grande Engineering
PO Box 93924
Albuquerque, New Mexico 87199

RE: **Lot 15 Block 4 SAD 228**
Volcano Cliffs Subdivision
6423 Canavio St NW
Grading and Drainage Plan
Engineers Stamp Date 4/27/17 (D10D003D15)
Pad Certification Date: 6/26/17

Dear Mr. Soule,

Based upon the information provided in your submittal received 11/17/17, this plan cannot be approved for Certificate of Occupancy until the following comments are addressed.

PO Box 1293

Albuquerque

NM 87103

www.cabq.gov

- The swale on the west side of the home is not in place. A retaining wall may need to be installed so a swale can be provided. All flows on this side of the home drain toward the lot to the south.
- A block wall is under construction and the turn blocks were not visible. Is there a permit for this wall? The small block walls coming from the home toward the property lines appear to be obstructing the flows of the swales.
- The pond on the SW corner of the property appears to back flow towards the property to the south, this area needs to be addressed.

If you have any questions, please contact me at 924-3695 or Rudy Rael at 924-3977.

Sincerely,

James D. Hughes, P.E.
Principal Engineer, Hydrology
Planning Department

RR/JDH
C: File



City of Albuquerque

Planning Department

Development & Building Services Division

DRAINAGE AND TRANSPORTATION INFORMATION SHEET (REV 09/2015)

Project Title: _____ **Building Permit #:** _____ **City Drainage #:** _____

DRB#: _____ **EPC#:** _____ **Work Order#:** _____

Legal Description: _____

City Address: _____

Engineering Firm: _____ **Contact:** _____

Address: _____

Phone#: _____ **Fax#:** _____ **E-mail:** _____

Owner: _____ **Contact:** _____

Address: _____

Phone#: _____ **Fax#:** _____ **E-mail:** _____

Architect: _____ **Contact:** _____

Address: _____

Phone#: _____ **Fax#:** _____ **E-mail:** _____

Other Contact: _____ **Contact:** _____

Address: _____

Phone#: _____ **Fax#:** _____ **E-mail:** _____

Check all that Apply:

DEPARTMENT:

- ☐ HYDROLOGY/ DRAINAGE
☐ TRAFFIC/ TRANSPORTATION
☐ MS4/ EROSION & SEDIMENT CONTROL

TYPE OF SUBMITTAL:

- ☐ ENGINEER/ ARCHITECT CERTIFICATION
- ☐ CONCEPTUAL G & D PLAN
☐ GRADING PLAN
☐ DRAINAGE MASTER PLAN
☐ DRAINAGE REPORT
☐ CLOMR/LOMR
- ☐ TRAFFIC CIRCULATION LAYOUT (TCL)
☐ TRAFFIC IMPACT STUDY (TIS)
☐ EROSION & SEDIMENT CONTROL PLAN (ESC)
- ☐ OTHER (SPECIFY) _____

CHECK TYPE OF APPROVAL/ACCEPTANCE SOUGHT:

- ☐ BUILDING PERMIT APPROVAL
☐ CERTIFICATE OF OCCUPANCY
- ☐ PRELIMINARY PLAT APPROVAL
☐ SITE PLAN FOR SUB'D APPROVAL
☐ SITE PLAN FOR BLDG. PERMIT APPROVAL
☐ FINAL PLAT APPROVAL
☐ SIA/ RELEASE OF FINANCIAL GUARANTEE
☐ FOUNDATION PERMIT APPROVAL
☐ GRADING PERMIT APPROVAL
☐ SO-19 APPROVAL
☐ PAVING PERMIT APPROVAL
☐ **GRADING** PAD CERTIFICATION
☐ WORK ORDER APPROVAL
☐ CLOMR/LOMR
- ☐ PRE-DESIGN MEETING
☐ OTHER (SPECIFY) _____

IS THIS A RESUBMITTAL?: ☐ Yes ☐ No

DATE SUBMITTED: _____ **By:** _____

COA STAFF: _____ ELECTRONIC SUBMITTAL RECEIVED: _____

Weighted E Method

Basin	Area (sf)	Area (acres)	Treatment A				Treatment B				Treatment C				Treatment D				Weighted (ac-ft)	Volume (ac-ft)	Flow cfs
			%	(acres)	%	(acres)	%	(acres)	%	(acres)	%	(acres)	%	(acres)	%	(acres)	%	(acres)			
UPLAND	13183.00	0.440	0%	0	10%	0.044	40%	0.1762	50%	0.220	1.448	0.053	1.56								
ALLOWED	13730.00	0.315	0%	0	10%	0.032	40%	0.1281	50%	0.158	1.448	0.038	1.11								
PROPOSED	13730.00	0.315	0%	0	30%	0.095	33%	0.104	37%	0.117	1.257	0.033	1.00								
total																					

Equations:

Weighted E = Ea*Aa + Eb*Ab + Ec*Ac + Ed*Ad / (Total Area)

Volume = Weighted D * Total Area

Flow = Qa * Aa + Qb * Ab + Qc * Ac + Qd * Ad

Where for 100-year, 6-hour storm- zone 1
Ea= 0.44 Qa= 1.29
Eb= 0.67 Qb= 2.03
Ec= 0.99 Qc= 2.87
Ed= 1.97 Qd= 4.37

ONSITE Conditions
FIRST FLUSH WATER QUALITY VOLUME
REQUIRED
(CF)
PR:
(CF)
WATER QUALITY
144
6:

Narrative

This site is within the SAD 228 Master Drainage plan boundary. The site is too low to drain to the street and but ponding and swale drainage plan. We are ponding the water harvest volume generated in shallow water harvest ponds in excess of the drainage regulations. This

TURNED BLOCKS

Weir Equation:

$$Q = CLH^{3/2}$$

wale thru wal

Q = 2.92 cfs
C = 2.95
H = 0.5 ft
L = Length of weir

$$Q = 2.95 * L^{3/2} * ((0.5)^{3/2})$$

Each opening is 6"x6"
Each block has two openings
Each opening has .52 cfs capacity.
Therefore each turned block has 1.04 cfs capacity

I, DAVID SOULE HAVE PERSONALLY IN
CERTIFY THE PAD HAS BEEN CONSTRUCTED
SUBSTANTIAL CONFORMANCE TO THE APPROVED
DRAINAGE PLAN DATED 4/27/17

E SITE. I HEREBY
THAT IT IS IN
DRAINAGE PLAN DATED 4/27/17




6/26/17

I David Soule, NMPE 14522, of the firm Rio Grande Engineering, hereby certify that this project has been graded and will drain in substantial compliance with and in accordance with the design intent of the approved plan dated 4/27/17. The record information edited on the original design document has been performed by me or under my direct supervision and is true and correct to the best of my knowledge and belief. The as-built survey was provided by THOMAS PATRICK NMPS 12651. The certification is submitted in support of a request for PERMANENT CERTIFICATE OF OCCUPANCY. The record information presented hereon is not necessarily complete and intended only to verify substantial compliance of the grading and drainage aspects of this project. Those relying on this record document are advised to obtain independent verification of its accuracy before using it for any other purpose.




11/17/17

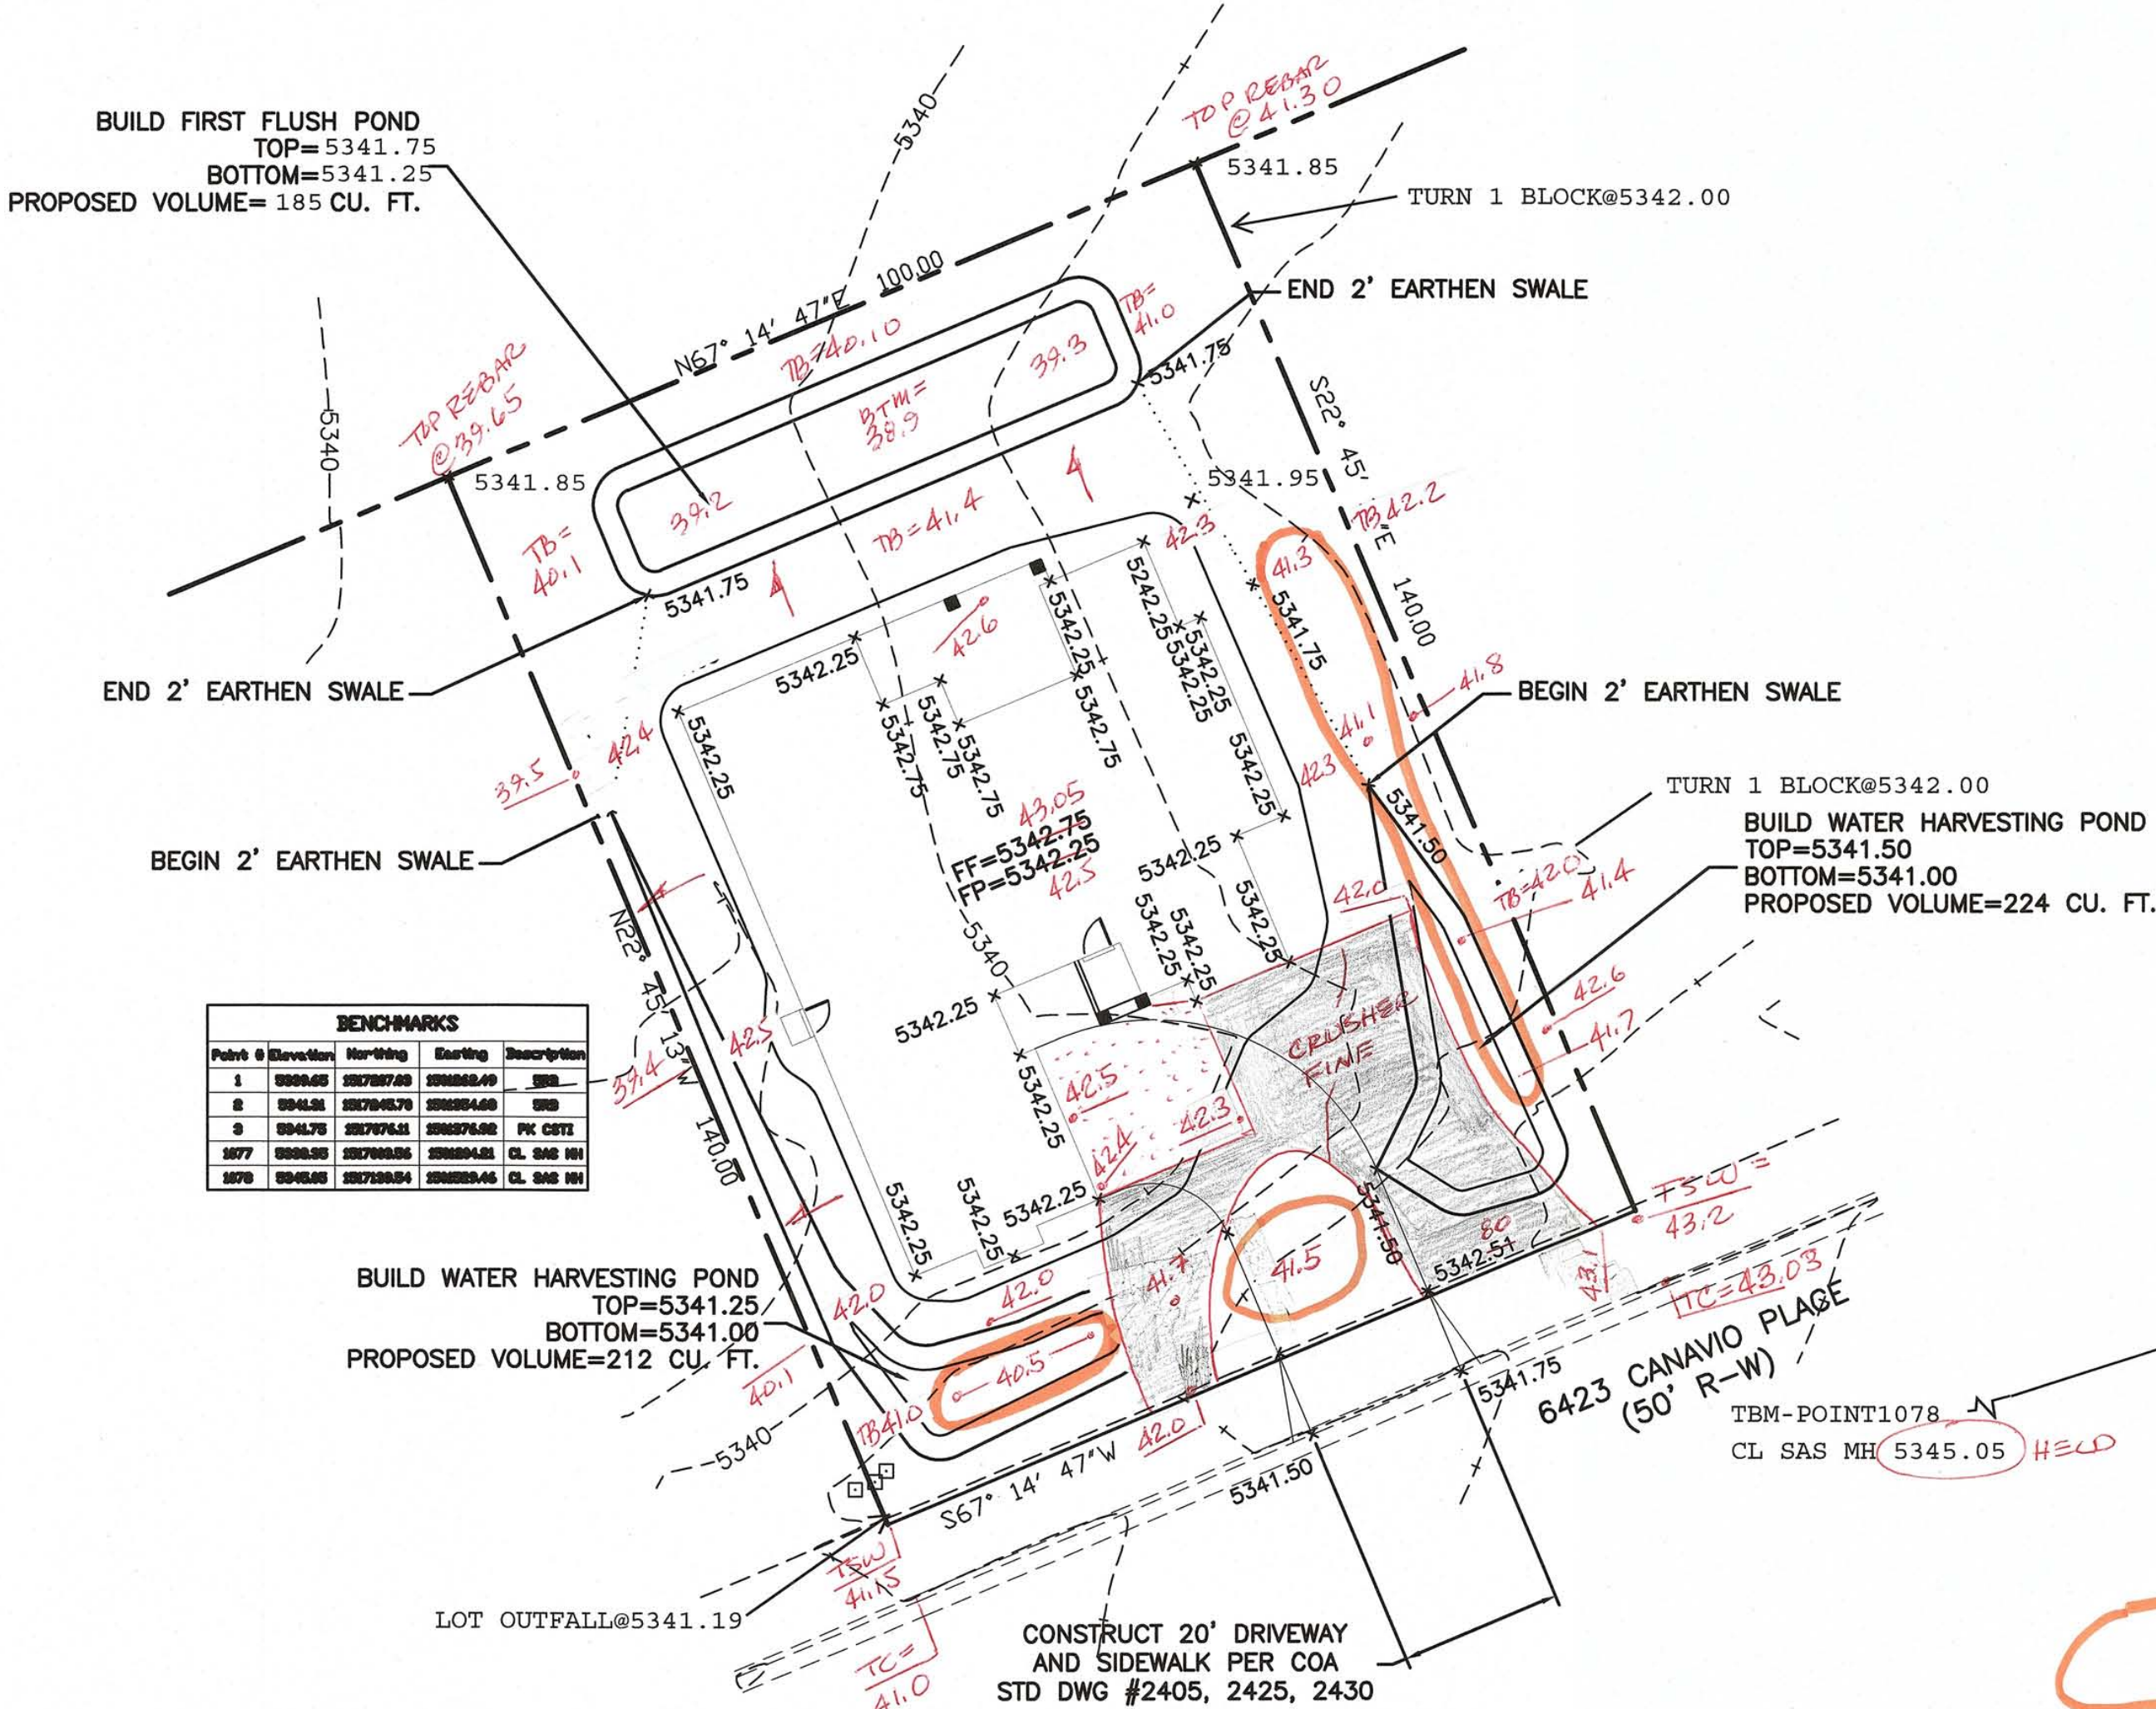

○ = BTM POND
TB = TOP OF BANK
BTM = BTM



11-17-17 TCY
AS-BUILTS

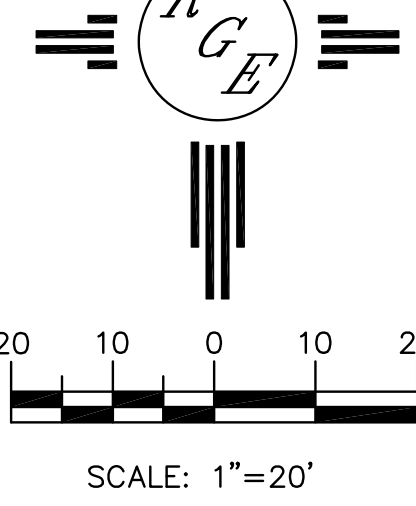

CAUTION:
EXISTING UTILITIES ARE NOT SHOWN.
IT SHALL BE THE SOLE RESPONSIBILITY
OF THE CONTRACTOR TO CONDUCT ALL
NECESSARY FIELD INVESTIGATIONS PRIOR
TO ANY EXCAVATION TO DETERMINE THE
ACTUAL LOCATION OF UTILITIES & OTHER
IMPROVEMENTS.

EROSION CONTROL NOTES:

1. CONTRACTOR IS RESPONSIBLE FOR OBTAINING A TOPSOIL DISTURBANCE PERMIT PRIOR TO BEGINNING WORK.
2. CONTRACTOR IS RESPONSIBLE FOR MAINTAINING RUN-OFF ON SITE DURING CONSTRUCTION.
3. CONTRACTOR IS RESPONSIBLE FOR CLEANING ALL SEDIMENT THAT GETS INTO EXISTING RIGHT-OF-WAY.
4. REPAIR OF DAMAGED FACILITIES AND CLEANUP OF SEDIMENT ACCUMULATIONS ON ADJACENT PROPERTIES AND IN PUBLIC FACILITIES IS THE RESPONSIBILITY OF THE CONTRACTOR.
5. ALL EXPOSED EARTH SURFACES MUST BE PROTECTED FROM WIND AND WATER EROSION PRIOR TO FINAL ACCEPTANCE OF ANY PROJECT.

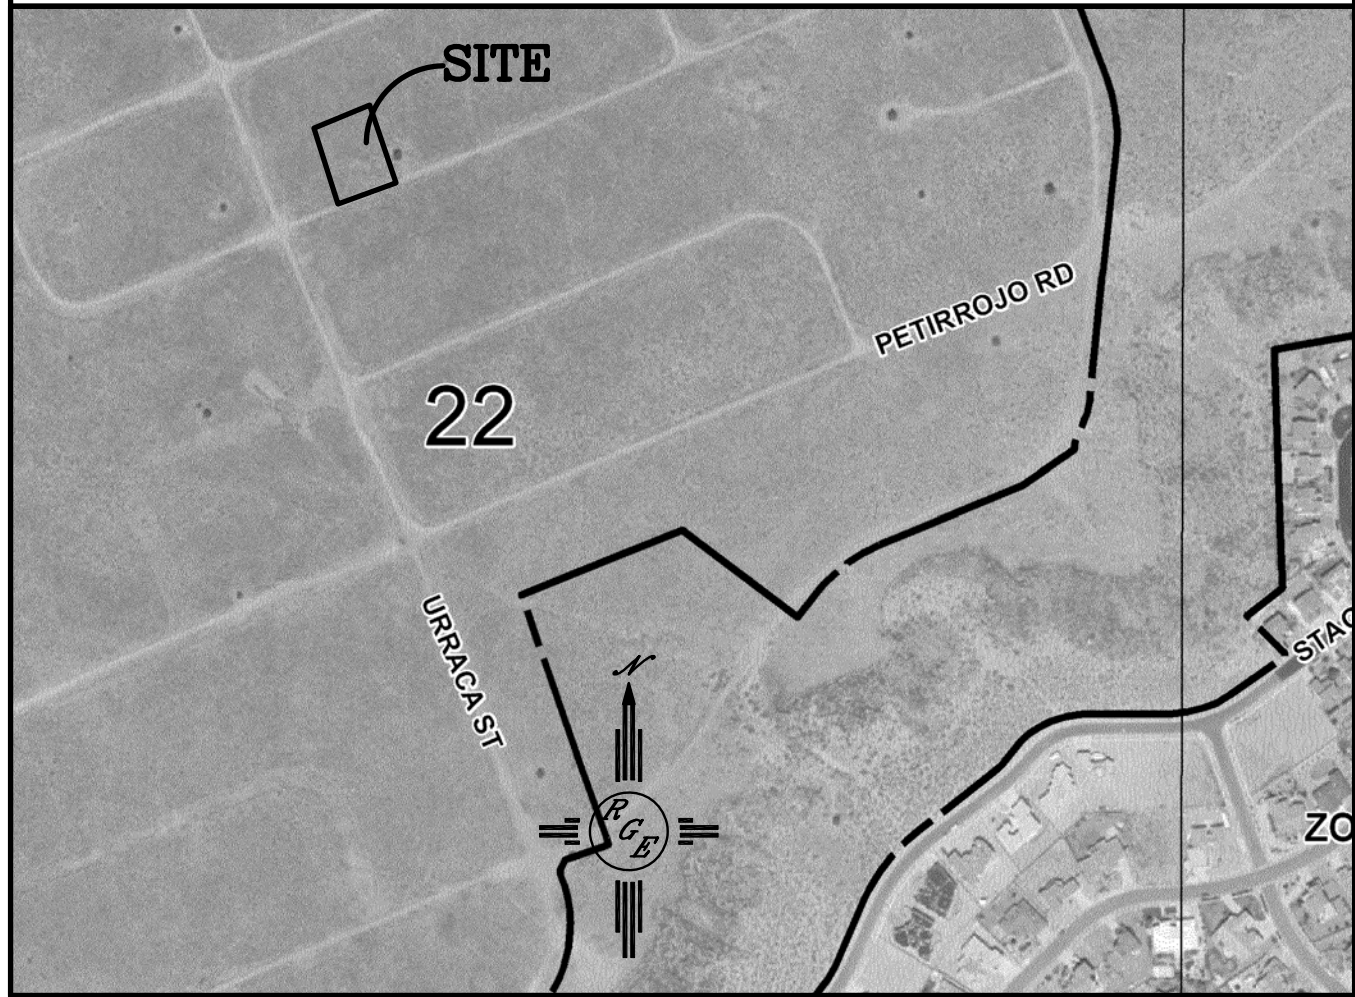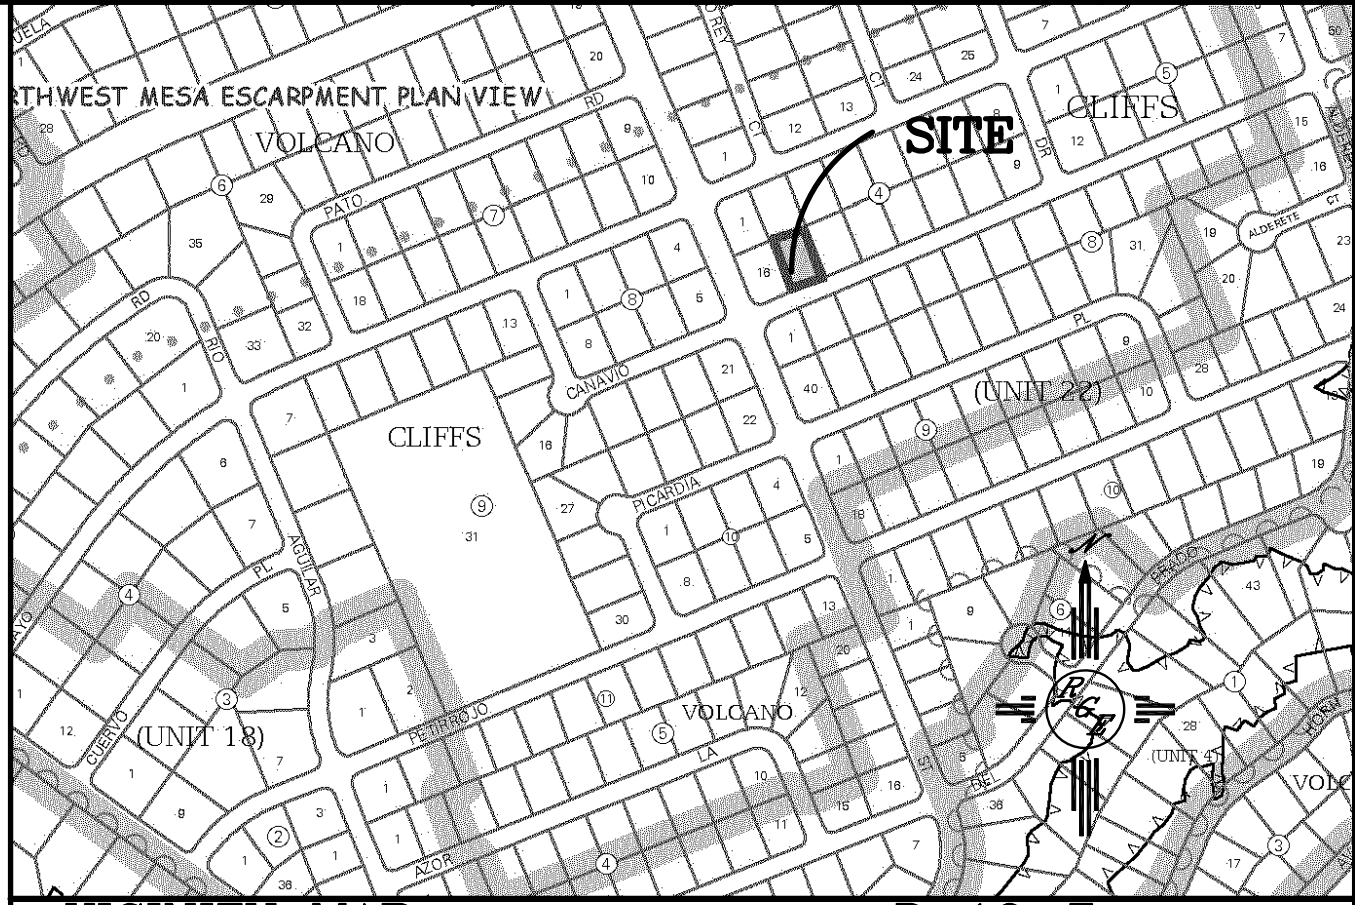

LEGAL DESCRIPTION:

LOT 15 BLOCK 4 UNIT NO. 22 VOLCANO CLIFFS SUBDIVISION

NOTES:

1. ALL SPOT ELEVATIONS REPRESENT FLOWLINE ELEVATION UNLESS OTHERWISE NOTED.
2. ALL SLOPES SHALL BE 3:1 MAX. AND GRAVEL OR NATIVE SEEDING PRIOR TO CO.
3. ANY PERIMETER WALLS MUST BE PERMITTED SEPARATELY. ALL RETAINING WALL DESIGN SHALL BE BY OTHERS.
4. A PAD CERTIFICATION IS REQUIRED PRIOR TO ISSUANCE OF BUILDING PERMIT

LEGEND

- - - - - EXISTING CONTOUR
- - - - - EXISTING INDEX CONTOUR
- - - - - PROPOSED CONTOUR
- - - - - PROPOSED INDEX CONTOUR
- - - - - SLOPE TIE
- • • • • EXISTING SPOT ELEVATION
- • • • • PROPOSED SPOT ELEVATION
- - - - - BOUNDARY
- - - - - CENTERLINE
- - - - - RIGHT-OF-WAY
- = = = = = EXISTING CURB AND GUTTER
- - - - - PROPOSED CMU SCREEN WALL
0'-3' MAX RETAINAGE (DESIGN BY OTHERS)

ENGINEER'S SEAL DAVID SOULE NEW MEXICO 14522 REGISTERED PROFESSIONAL ENGINEER 4/27/17 DAVID SOULE P.E. #14522	6423 CANAVIO PLACE	DRAWN BY WCWJ
	GRADING AND DRAINAGE PLAN	DATE 4-26-17
 Rio Grande Engineering 1606 CENTRAL AVENUE SE SUITE 201 ALBUQUERQUE, NM 87106 (505) 872-0999		21731-LAYOUT-4-26-17
		SHEET # —
		JOB # 21731