

# CITY OF ALBUQUERQUE

*Planning Department*  
Alan Varela, Director



*Mayor Timothy M. Keller*

September 30, 2022

Jackie McDowell, PE  
McDowell Engineering, Inc.  
7820 Beverly Hills Ave NE  
Albuquerque, NM 87121

**RE: Lots 16 Block 4 Volcano Cliffs Unit 22 SAD 228  
6427 Canavio Pl. NW.  
Grading and Drainage Plan  
Engineers Stamp Date; 12/2/2021 (D10D003D16)  
Pad Certification Date; 2/24/2022  
CO Certification Date; 9/28/2022**

PO Box 1293

Ms. McDowell,

Albuquerque

Based on the Certification received 9/29/2022, this site cannot be accepted for release of Certificate of Occupancy by Hydrology until the following comments are addressed.

NM 87103

- All construction material in and around the home needs to be removed including the port-a-potty.
- Block wall being placed from property line to home south side needs to have a turn block to allow for flows to exit to the front yard. If this is not the case, flows need to be shown as being retained in the rear yard and if pond has sufficient capacity.

[www.cabq.gov](http://www.cabq.gov)

If you have any questions, please contact me at 924-3986 or Rudy Rael at 924-3977.

Sincerely,

Shahab Biazar, P.E.  
City Engineer,  
Development Review Services

RR/SB  
File D10D003D16



# City of Albuquerque

Planning Department  
Development & Building Services Division

## DRAINAGE AND TRANSPORTATION INFORMATION SHEET (REV 6/2018)

**Project Title:** CANDELARIA - HASLAM LOT 16 **Building Permit #:** \_\_\_\_\_ **Hydrology File #:** D10D003D16  
**DRB#:** \_\_\_\_\_ **EPC#:** \_\_\_\_\_ **Work Order#:** \_\_\_\_\_  
**Legal Description:** 00160004VOLCANO CLIFFS SUBD UNIT 22  
**City Address:** 6427 CANAVIO RD NW ALBUQUERQUE NM 87120

**Applicant:** MCDOWELL ENGINEERING, INC. **Contact:** JACKIE MCDOWELL  
**Address:** 7820 BEVERLY HILLS AVE. NE, ALBUQUERQUE, NM 87122  
**Phone#:** 505-828-2430 **Fax#:** 505-821-4857 **E-mail:** jackmcdowell@comcast.net

**Other Contact:** DIEGO CANDELARIA **Contact:** DIEGO CANDELARIA  
**Address:** 1330 Crestview Dr. Los Lunas, NM 87035  
**Phone#:** 505-480-5608 **Fax#:** \_\_\_\_\_ **E-mail:** diego@candelariahomes.com

**TYPE OF DEVELOPMENT:** \_\_\_\_\_ PLAT (# of lots) ☒ RESIDENCE \_\_\_\_\_ DRB SITE \_\_\_\_\_ ADMIN SITE

IS THIS A RESUBMITTAL? \_\_\_\_\_ Yes ☒ No

**DEPARTMENT** \_\_\_\_\_ TRANSPORTATION ☒ HYDROLOGY/DRAINAGE

Check all that Apply:

### TYPE OF SUBMITTAL:

- ☒ ENGINEER/ARCHITECT CERTIFICATION  
☐ PAD CERTIFICATION  
☐ CONCEPTUAL G & D PLAN  
☐ GRADING PLAN  
☐ DRAINAGE REPORT  
☐ DRAINAGE MASTER PLAN  
☐ FLOODPLAIN DEVELOPMENT PERMIT APPLIC  
☐ ELEVATION CERTIFICATE  
☐ CLOMR/LOMR  
☐ TRAFFIC CIRCULATION LAYOUT (TCL)  
☐ TRAFFIC IMPACT STUDY (TIS)  
☐ STREET LIGHT LAYOUT  
☐ OTHER (SPECIFY) \_\_\_\_\_  
☐ PRE-DESIGN MEETING?

### TYPE OF APPROVAL/ACCEPTANCE SOUGHT:

- ☐ BUILDING PERMIT APPROVAL  
☒ CERTIFICATE OF OCCUPANCY  
☐ PRELIMINARY PLAT APPROVAL  
☐ SITE PLAN FOR SUB'D APPROVAL  
☐ SITE PLAN FOR BLDG. PERMIT APPROVAL  
☐ FINAL PLAT APPROVAL  
☐ SIA/ RELEASE OF FINANCIAL GUARANTEE  
☐ FOUNDATION PERMIT APPROVAL  
☐ GRADING PERMIT APPROVAL  
☐ SO-19 APPROVAL  
☐ PAVING PERMIT APPROVAL  
☐ GRADING/ PAD CERTIFICATION  
☐ WORK ORDER APPROVAL  
☐ CLOMR/LOMR  
☐ FLOODPLAIN DEVELOPMENT PERMIT  
☐ OTHER (SPECIFY) PAD CERTIFICATION

**DATE SUBMITTED:** 9-28-22 **By:** JACKIE MCDOWELL

COA STAFF:

ELECTRONIC SUBMITTAL RECEIVED: \_\_\_\_\_


FEE PAID: \_\_\_\_\_



Curve Table	Station	Grade	Length	Area
1	100.00	1.00	100.00	100.00
2	100.00	1.00	100.00	100.00

PROVIDE TURNED BLOCK OR NON-GROUTED CELLS, 3" ABOVE GRADE, FOR DRAINAGE AT ALL LOW WALL ELEVATIONS ON THE LOT, TYP.

POND VOL = 556 CF

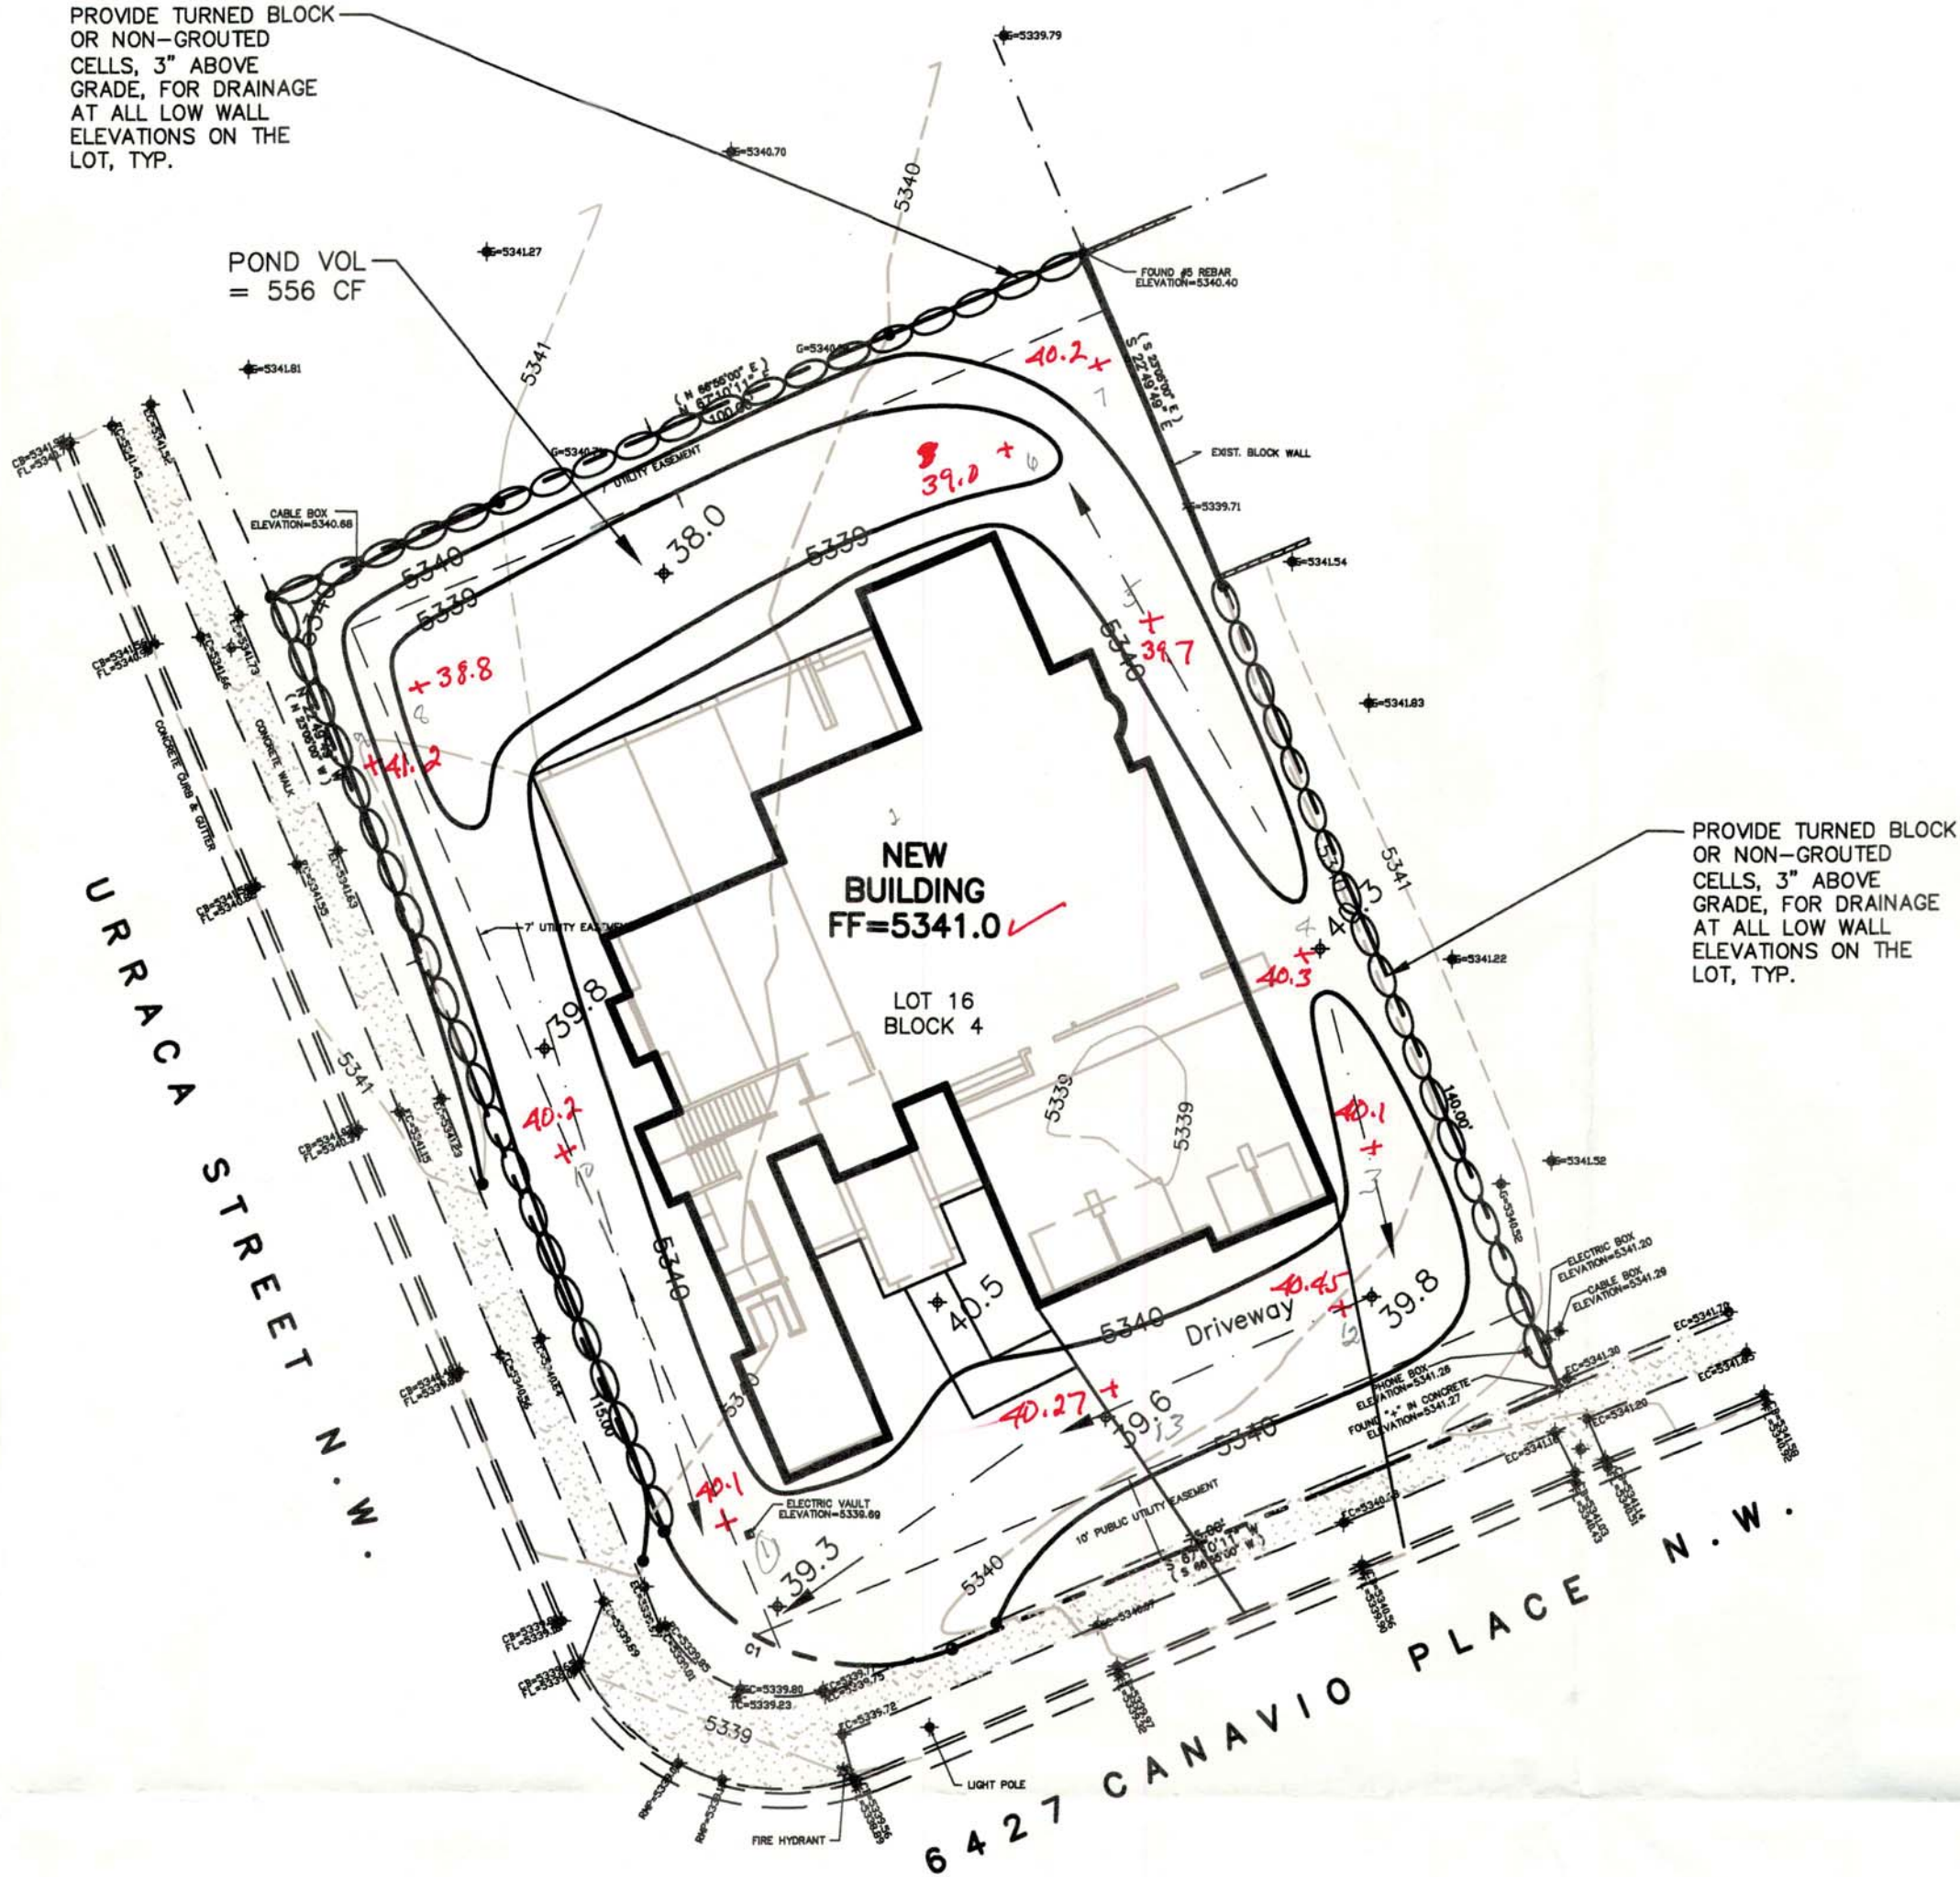


PROVIDE TURNED BLOCK OR NON-GROUTED CELLS, 3" ABOVE GRADE, FOR DRAINAGE AT ALL LOW WALL ELEVATIONS ON THE LOT, TYP.

City Note:  
Dirt is not allowed to climb the curb, use crusher fines or lumber for this purpose.

#### GENERAL DRAINAGE PLAN NOTES:

- It is recommended that the Owner obtain a Geotechnical Evaluation of the on-site soils prior to foundation/structural design.
- This plan recommends positive drainage away from all structures to prohibit ponding of runoff adjacent to the structure. Future alterations of the grades next to the structures are not recommended.
- Irrigation within 10 feet of any proposed structure is not recommended. Irrigation water adjacent to the structures could cause settlement.
- This plan establishes on-site drainage and assumes no responsibility for subsurface analysis, foundation or structural design, or utility design.
- Local codes may require all footings to be placed in natural undisturbed soil. If the contractor plans to place footings on engineered fill, a certification by a registered Professional Engineer is recommended.
- It is recommended that the Owner obtain the services of a Geotechnical Engineer to test and inspect all earthwork aspects of the project.
- The property boundary shown on this plan is given for information only to describe the project limits. Property boundary information shown hereon does not constitute a boundary survey.
- All work shall be constructed in accordance with the City of Albuquerque Standard Specifications for Public Works Construction with updates.
- All work on this project shall be performed in accordance with applicable Federal, State, and Local laws, rules, and regulations concerning construction safety and health.
- Contactar shall ensure that no site soils/sediment or silt enters the high-of-ways during construction.
- Areas disturbed due to construction shall be restored per City of Albuquerque Spec. 1012 native seed mix.

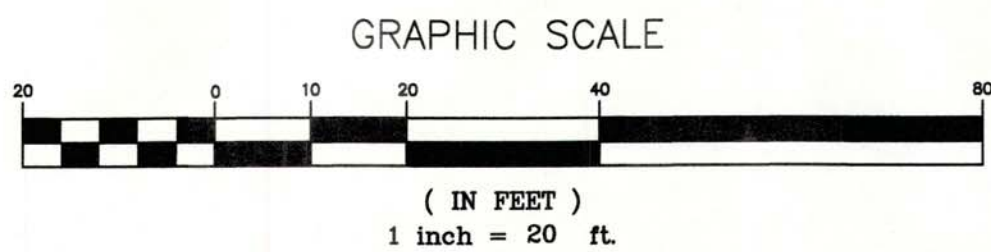

This is the plan to be used for any garden walls and any openings in the walls shall be placed 3" above final grade in the rear yard to allow for cross lot drainage from west to east (upstream to downstream).


PROPERTY LINE WALLS AND GARDEN WALLS SHALL HAVE TURNED BLOCKS OR WEEP HOLES FOR DRAINAGE.  
ALL OPENINGS IN THE WALLS SHALL BE 3" ABOVE GRADE.

STANDARD GRADING NOTE: THE MAXIMUM GRADED SIDE SLOPE SHALL NOT EXCEED 3 FEET (HORIZONTALLY) TO 1 FOOT (VERTICALLY). AREAS DISTURBED BY GRADING WHICH WILL NOT BE TREATED WITH LANDSCAPING SHALL BE SEEDDED.

#### STANDARD WALL AND PAD CERTIFICATION NOTES:

ALL PERMITER GARDEN WALLS SHALL BE PERMITTED SEPARATELY.

A PAD CERTIFICATION IS REQUIRED BEFORE THE BUILDING PERMIT IS RELEASED.

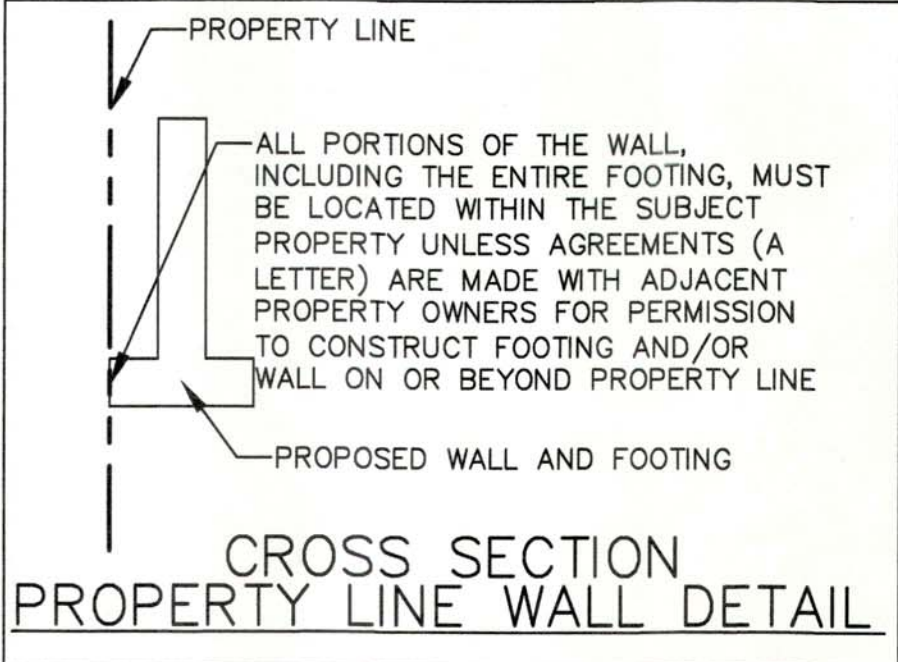

#### DRAINAGE PLAN

##### SCOPE:

Pursuant to the latest City of Albuquerque and Bernalillo County Ordinances, the Drainage Plan shown hereon outlines the drainage management criteria for controlling developed runoff on and exiting the project site. A single family home is proposed for the site with associated parking, access, landscaping, and utility improvements.

##### EXISTING CONDITIONS:

Presently, the 0.32 acre site is undeveloped. The site is bounded on the north, and east by private property, on the west by Uraca Street, and on the south by Canavio Pl. NW. The site is level. As shown on FEMA Panel #112G, the site is not located in a 100 year flood plain.

##### PROPOSED CONDITIONS:

Per the SAD 227 and 228 Drainage Reports by Wilson & Company, drainage from the lots have been master planned to be intercepted by drainage features downstream of the properties. First flush ponding is required on all developments. As shown by the plan, the building is located in the center of the lot. Negligible off-site flows enter the site due to existing grades from the north and east, and will continue to be allowed to historically flow through the site. On site flows will drain around the structure to new grades and flow to the ponding area and street. All roof drainage will discharge from the roof to the lot and be directed around the structure to the drainage paths.

Supplemental calculations are shown as part of this Grading and Drainage plan.

##### CALCULATIONS:

The calculations shown hereon define the 100 year-6 hour design storm falling within the project area under existing and developed conditions. The Hydrology is per "Section 22.2, Hydrology of the Development Process Manual, Volume 2, Design Criteria, for the City of Albuquerque, New Mexico in cooperation with Bernalillo County, New Mexico and the Albuquerque Metropolitan Arroyo Flood Control Authority.

##### PROPERTY ADDRESS:

6427 CANAVIO RD NW ALBUQUERQUE NM 87120


Areas: (acres)	Existing	Proposed
Treatment A	0.32	0.00
Treatment B	0.00	0.12
Treatment C	0.00	0.06
Treatment D	0.00	0.14
Total (acres) =	0.32	0.32

POND VOLUME PROVIDED:		
ELEV.	AREA	VOL. (CF)
5339	1112	
5338	0	556
SUB-TOTAL		556

Volume	100 year Existing	100 year Proposed	10 year Existing	10 year Proposed	2 year Existing	2 year Proposed
Volume (acre-feet) =	0.012	0.035	0.002	0.019	0.000	0.009
Volume (cubic feet) =	511	1,509	93	822	0	396

FIRST FLUSH REQUIRED POND VOL = 0.34"/(12"/FT)\*(0.32 AC \* 43560 SF/AC) = 395 CF

Total Q(p), cfs:	100 year Existing Q(p)*A	100 year Proposed Q(p)*A	10 year Existing Q(p)*A	10 year Proposed Q(p)*A	2 year Existing Q(p)*A	2 year Proposed Q(p)*A
Treatment A	0.41	0.00	0.08	0.00	0.00	0.00
Treatment B	0.00	0.24	0.00	0.09	0.00	0.00
Treatment C	0.00	0.17	0.00	0.09	0.00	0.03
Treatment D	0.00	0.61	0.00	0.40	0.00	0.24
Total Q (cfs) =	0.41	1.03	0.08	0.59	0.00	0.27

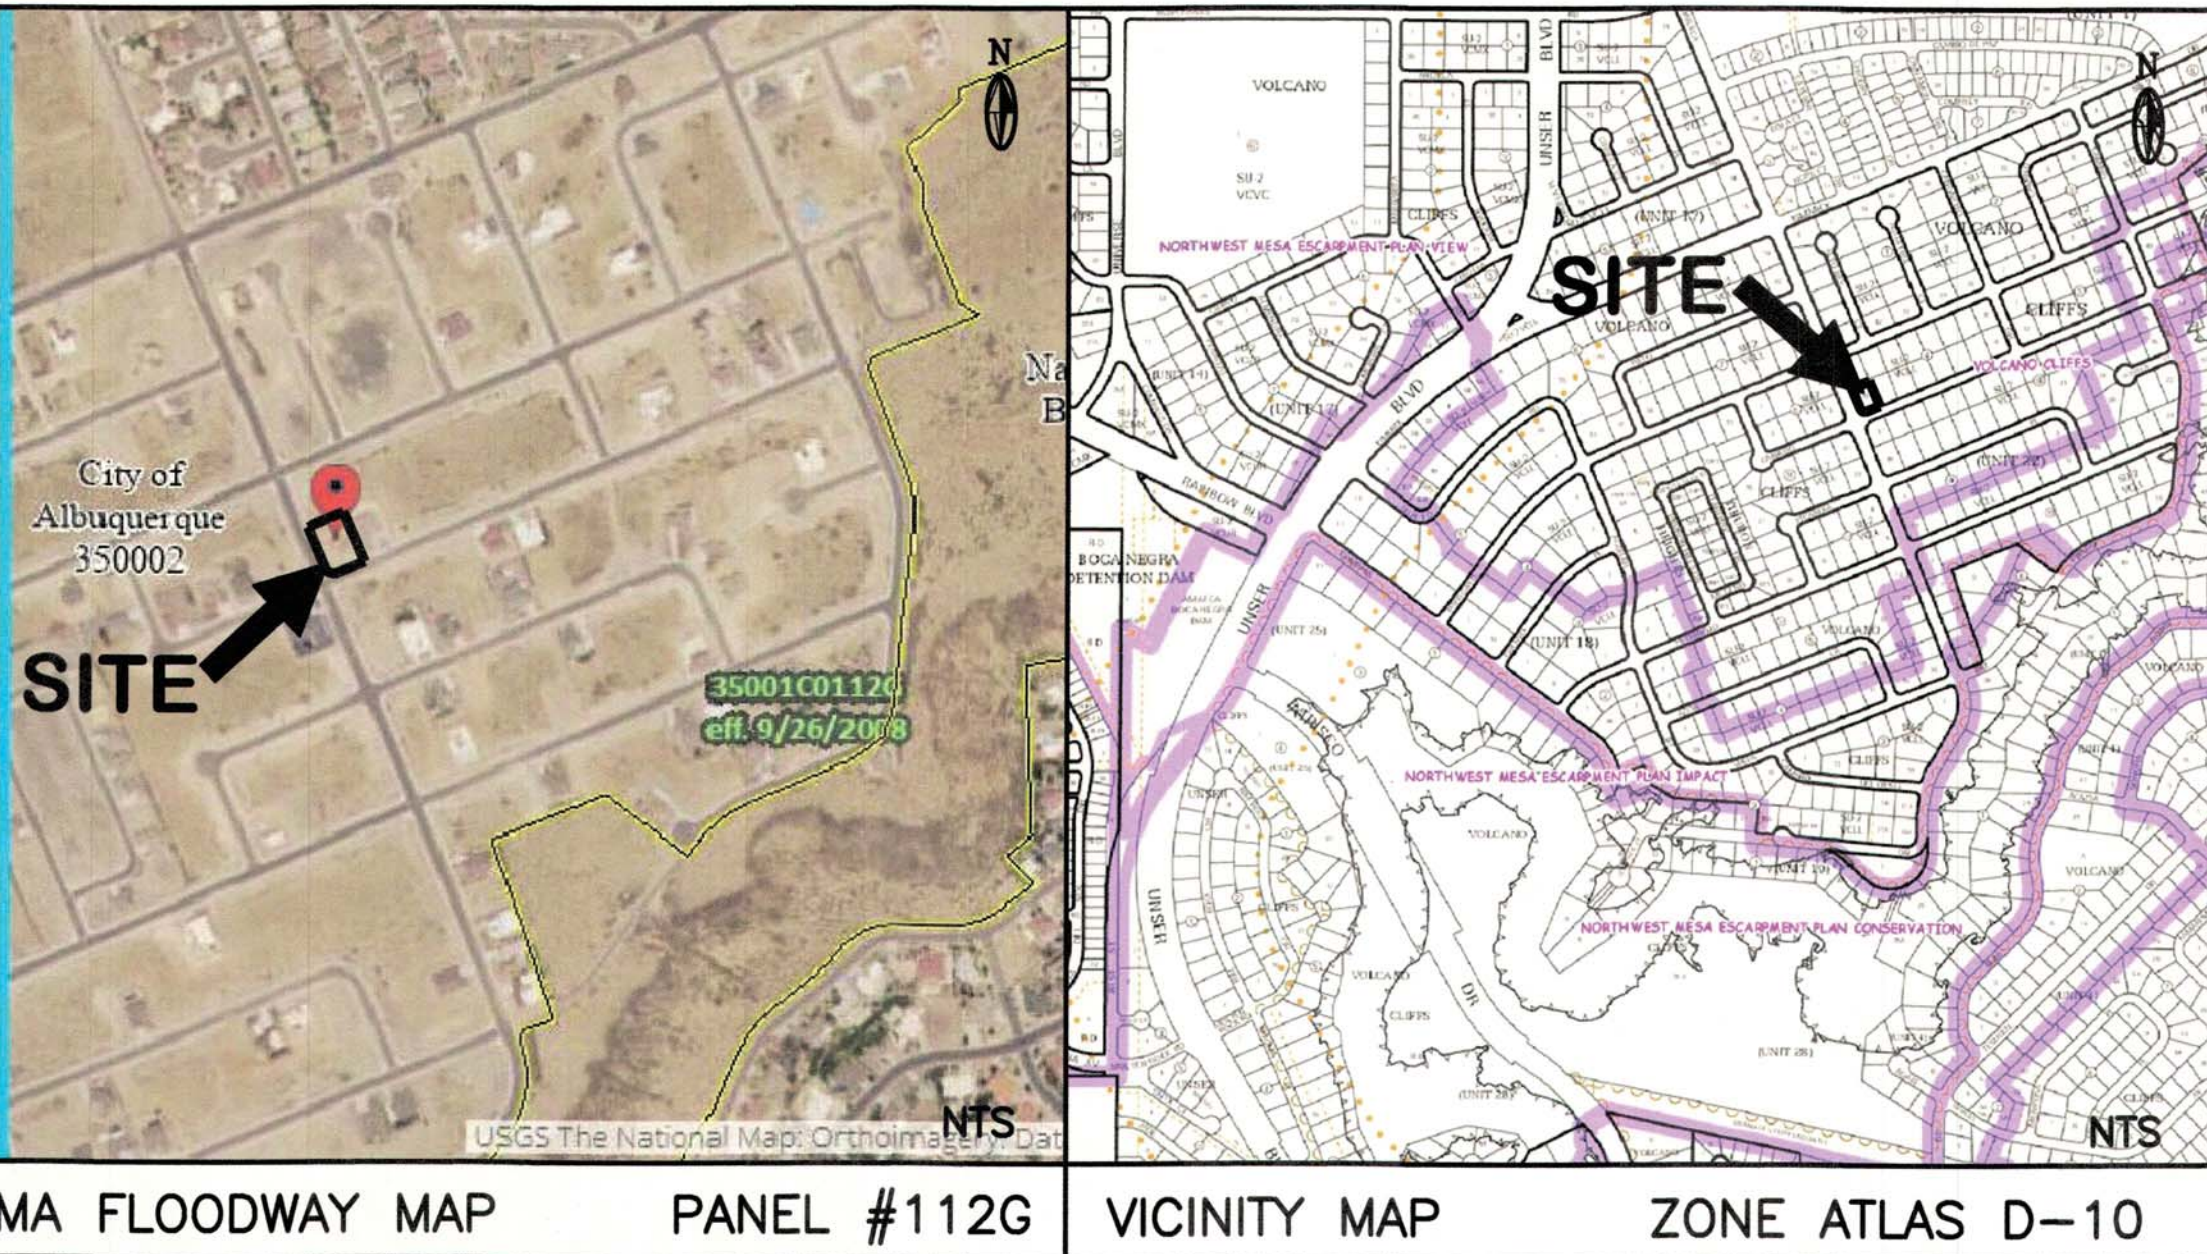

**SURVEY LEGEND**  
 CB = CURB  
 EC = EDGE OF CONCRETE  
 FL = FLOWLINE  
 G = GROUND  
 TC = TOP OF CONCRETE

#### SURVEY GENERAL NOTES:

- CONTOUR INTERVAL IS ONE (1) FOOT.
- ELEVATIONS ARE BASED ON READINGS TAKEN WITH A GPS UNIT STONEX SIDA ELEVATIONS SHOWN ARE NAVD 1988
- UTILITIES SHOWN HEREON ARE IN THEIR APPROXIMATE LOCATION BASED ONLY ON ABOVE GROUND EVIDENCE FOUND IN THE FIELD AND AS-BUILT INFORMATION PROVIDED BY THE CLIENT. UTILITIES SHOWN HEREON, WHETHER INDICATED AS ABANDONED OR NOT, SHALL BE VERIFIED BY OTHERS FOR EXACT LOCATION AND/OR DEPTH PRIOR TO EXCAVATION OR DESIGN CON-SIDERATIONS.
- THIS IS NOT A BOUNDARY SURVEY. APPARENT PROPERTY CORNERS AND PROPERTY LINES ARE SHOWN FOR INFORMATION ONLY. BOUNDARY DATA SHOWN IS FROM PREVIOUS SURVEY REFERENCE HEREON.

LEGEND	
EXISTING	PROPOSED
CONTOUR	6045
PROPERTY LINE	
ROAD	
SETBACK	
RETAINING WALL/WALL	
SPOT ELEVATION	604542

Elevations shown on based on field information taken on September 26, 2022  
 Anthony L. Harris  
 9-28-22

**DRAINAGE CERTIFICATION WITH SURVEY WORK BY PROFESSIONAL SURVEYOR**  
 I, Jackie McDowell, NMPE #10903, of the firm McDowell Engineering, Inc., hereby certify that this project has been graded and will drain in substantial compliance with and in accordance with the design intent of the approved plan dated 2-24-22. The record information edited onto the original design document has been obtained by Anthony Harris, NMPS #11463. I further certify that I have personally visited the project site on September 27, 2022 and have determined by visual inspection that the survey data provided is representative of actual site conditions and is true and correct to the best of my knowledge and belief. This certification is submitted in support of a request for Certificate of Occupancy. The record information presented hereon is not necessarily complete and intended only to verify substantial compliance of the grading and drainage aspects of this project. Those relying on the record document are advised to obtain independent verification of its accuracy before using it for any other purpose.

#### ENGINEER'S CERTIFICATION:

I, Jackie S. McDowell, hereby certify that I personally inspected the site shown on this plan on November 22, 2021 and as of that date it appeared that no filling, grading, or excavation had occurred thereon since completion of the topographic survey used to prepare this plan.

6427 CANAVIO RD NW ALBUQUERQUE NM 87120  
 CITY OF ALBUQUERQUE, BERNALILLO COUNTY NEW MEXICO

**LOT 16, BLOCK 4, UNIT 22**  
**VOLCANO CLIFFS SUBDIVISION**

HASLAM, VINCENT (CANDELARIA HOMES) - G & D PLAN

**McDowell Engineering, Inc.**  
 7820 BEVERLY HILLS AVE. NE • ALBUQUERQUE, NM 87122  
 TELE: 505-828-2430 • FAX: 505-821-4857

Designed JSM Drawn STAFF Checked JSM Sheet of  
 File HASO121L Date NOVEMBER, 2021 1 1