CITY OF ALBUQUERQUE

Planning Department Alan Varela, Director



November 14, 2023

David Soule, PE Rio Grande Engineering PO Box 93924 Albuquerque, NM 87199

RE: Lot 22 Block 8 Unit 22 SAD 228

6304 Alderete Ct. NW Volcano Cliffs Subdivision Grading and Drainage Plan

Engineers Stamp Date 3/30/2022 (D10D003E22)

Pad Certificate Date: 2/2/2022 CO Certification Date: 11/1/2023

PO Box 1293 Mr. Soule,

Based on the Certification received on 11/8/2023, the site is acceptable for release of Certificate of Occupancy by Hydrology.

If you have any questions, you can contact me at 924-3695 or Rudy Rael at 924-3977.

NM 87103

Albuquerque

Sincerely,

www.cabq.gov

Tiequan Chen, P.E.

Principal Engineer, Hydrology

Planning Department, Development Review Services

RR/TC

C: File D10D003E22



City of Albuquerque

Planning Department

Development & Building Services Division

DRAINAGE AND TRANSPORTATION INFORMATION SHEET (REV 6/2018)

6304 ALDERETE COURT Project Title:	Building Permit #:	Hydrology File #:
DRB#:	EPC#:	Work Order#:
DRB#: LOT 22, Block	8 VOLCANO CLIFFS UN	IT 22
City Address: 6304 ALDERRETE CO	URT	
Applicant:		Contact:
Address:		
Phone#:		E-mail:
Other Contact: RIO GRANDE ENGINE		
Address: PO BOX 93924 ALB NM		
		E-mail: david@riograndeengineering.com
TYPE OF DEVELOPMENT: PLAT		
Check all that Apply:		
DEPARTMENT: X HYDROLOGY/ DRAINAGE TRAFFIC/ TRANSPORTATION	BUILDING	OVAL/ACCEPTANCE SOUGHT: PERMIT APPROVAL
	CERTIFICA	TE OF OCCUPANCY
TYPE OF SUBMITTAL: X ENGINEER/ARCHITECT CERTIFICATION PAD CERTIFICATION CONCEPTUAL G & D PLAN GRADING PLAN DRAINAGE REPORT DRAINAGE MASTER PLAN FLOODPLAIN DEVELOPMENT PERMIT A ELEVATION CERTIFICATE CLOMR/LOMR	SITE PLAN SITE PLAN SITE PLAN FINAL PLA SIA/ RELEA APPLIC FOUNDAT	ASE OF FINANCIAL GUARANTEE ION PERMIT APPROVAL PERMIT APPROVAL
TRAFFIC CIRCULATION LAYOUT (TCL) TRAFFIC IMPACT STUDY (TIS) STREET LIGHT LAYOUT OTHER (SPECIFY) PRE-DESIGN MEETING? IS THIS A RESUBMITTAL?: YesX _No	PAVING PI GRADING/ WORK ORD CLOMR/LO FLOODPLA OTHER (SI	ERMIT APPROVAL PAD CERTIFICATION DER APPROVAL
DATE SUBMITTED:		
COA STAFF:	ELECTRONIC SUBMITTAL RECEIVED:	

100-Year, 6-hr. Area | Area | Treatment A | Treatment B | Treatment C | Treatment D | Weighted E | Volume (acres) % (acres) % (acres) % (acres) % (acres) 17447.00 0.401 0% 0 24% 0.096 40% 0.1602 36% 0.144 1.362 0.045 17447.00 0.401 0% 0 24% 0.096 34% 0.1362 42% 0.168 1.439 0.048 PROPOSED COMPARISON 0.004

Weighted E Method

I, DAVID SOULE HAVE PERSONALLY INPECTED THE SITE. I HEREBY CERTIFY THE PAD HAS BEEN CONSTRUCTED SUCH THAT IT IS IN SUBSTANTIAL CONFORMANCE TO THE APPROVED GRADING PLAN DATED 3/30/22

INSTALL 21 LF OF 3" PVC

DRAIN THROUGH CURB

INV. IN = 29.25

INV. OUT= 28.85

PER COA STD DWG 2235

EROSION CONTROL NOTES:

1. CONTRACTOR IS RESPONSIBLE FOR OBTAINING A TOPSOIL DISTURBANCE PERMIT PRIOR TO BEGINNING WORK.

2. CONTRACTOR IS RESPONSIBLE FOR MAINTAINING RUN-OFF ON SITE DURING CONSTRUCTION.

3. CONTRACTOR IS RESPONSIBLE FOR CLEANING ALL SEDIMENT THAT GETS INTO EXISTING RIGHT-OF-WAY.

4. REPAIR OF DAMAGED FACILITIES AND CLEANUP OF SEDIMENT ACCUMULATIONS ON ADJACENT PROPERTIES AND IN PUBLIC FACILITIES IS THE RESPONSIBILITY OF THE CONTRACTOR.

5. ALL EXPOSED EARTH SURFACES MUST BE PROTECTED FROM WIND AND WATER EROSION PRIOR TO FINAL ACCEPTANCE OF ANY PROJECT.

-TOP BACK OF CURB

I David Soule, NMPE 14522, of the firm Rio Grande Engineering, hereby certify that this project has been graded and will drain in substantial compliance with and in accordance with the design intend of the approved plan dated 3/30/22 The certification is submitted in support of a request for <u>CERTIFICATE OR OCCUPANCY</u>. The record information presented heron is not necessarily complete and intended only to verify substantial compliance of the grading and drainage aspects of this project.



PROVIDED **REQUIRED** (CF) 1033 (CF) WATER QUALITY 182 FLOOD CONTROL 1033

This site is within the SAD 228 Master Drainage plan boundaries. The site is to maintain existing patterns and drain to the adjacent roadway per the master drainage plan. The site does exceed the SAD 228 developed conditions assumptions, therefore ponding of 182 cf is required. No upland flow impact the site. We are ponding the water harvest volume generated by the site. This plan is in conformance to the master drainage plan INV. IN = 29.25 INV. OUT = 29.00 **BENCH MARK** CHISELED X ELEVATION=5330.68

> "AS-BUILT" 10/30/2023 DATE:

CAUTION:

Equations:

ONSITE Conditions

Narrative

Volume = Weighted D * Total Area

Flow = Qa * Aa + Qb * Ab + Qc * Ac + Qd * Ad

Where for 100-year, 6-hour storm-zone 1

FIRST FLUSH WATER QUALITY VOLUME

Weighted E = Ea*Aa + Eb*Ab + Ec*Ac + Ed*Ad / (Total Area)

Eb= 0.73

Ec= 0.95

Ed= 2.24


Qa= 1.54


Qb= 2.16

Qc= 2.87

Qd = 4.12

EXISTING UTILITIES ARE NOT SHOWN. IT SHALL BE THE SOLE RESPONSIBILITY OF THE CONTRACTOR TO CONDUCT ALL NECESSARY FIELD INVESTIGATIONS PRIOR TO ANY EXCAVATION TO DETERMINE THE **ACTUAL LOCATION OF UTILITIES & OTHER** IMPROVEMENTS.

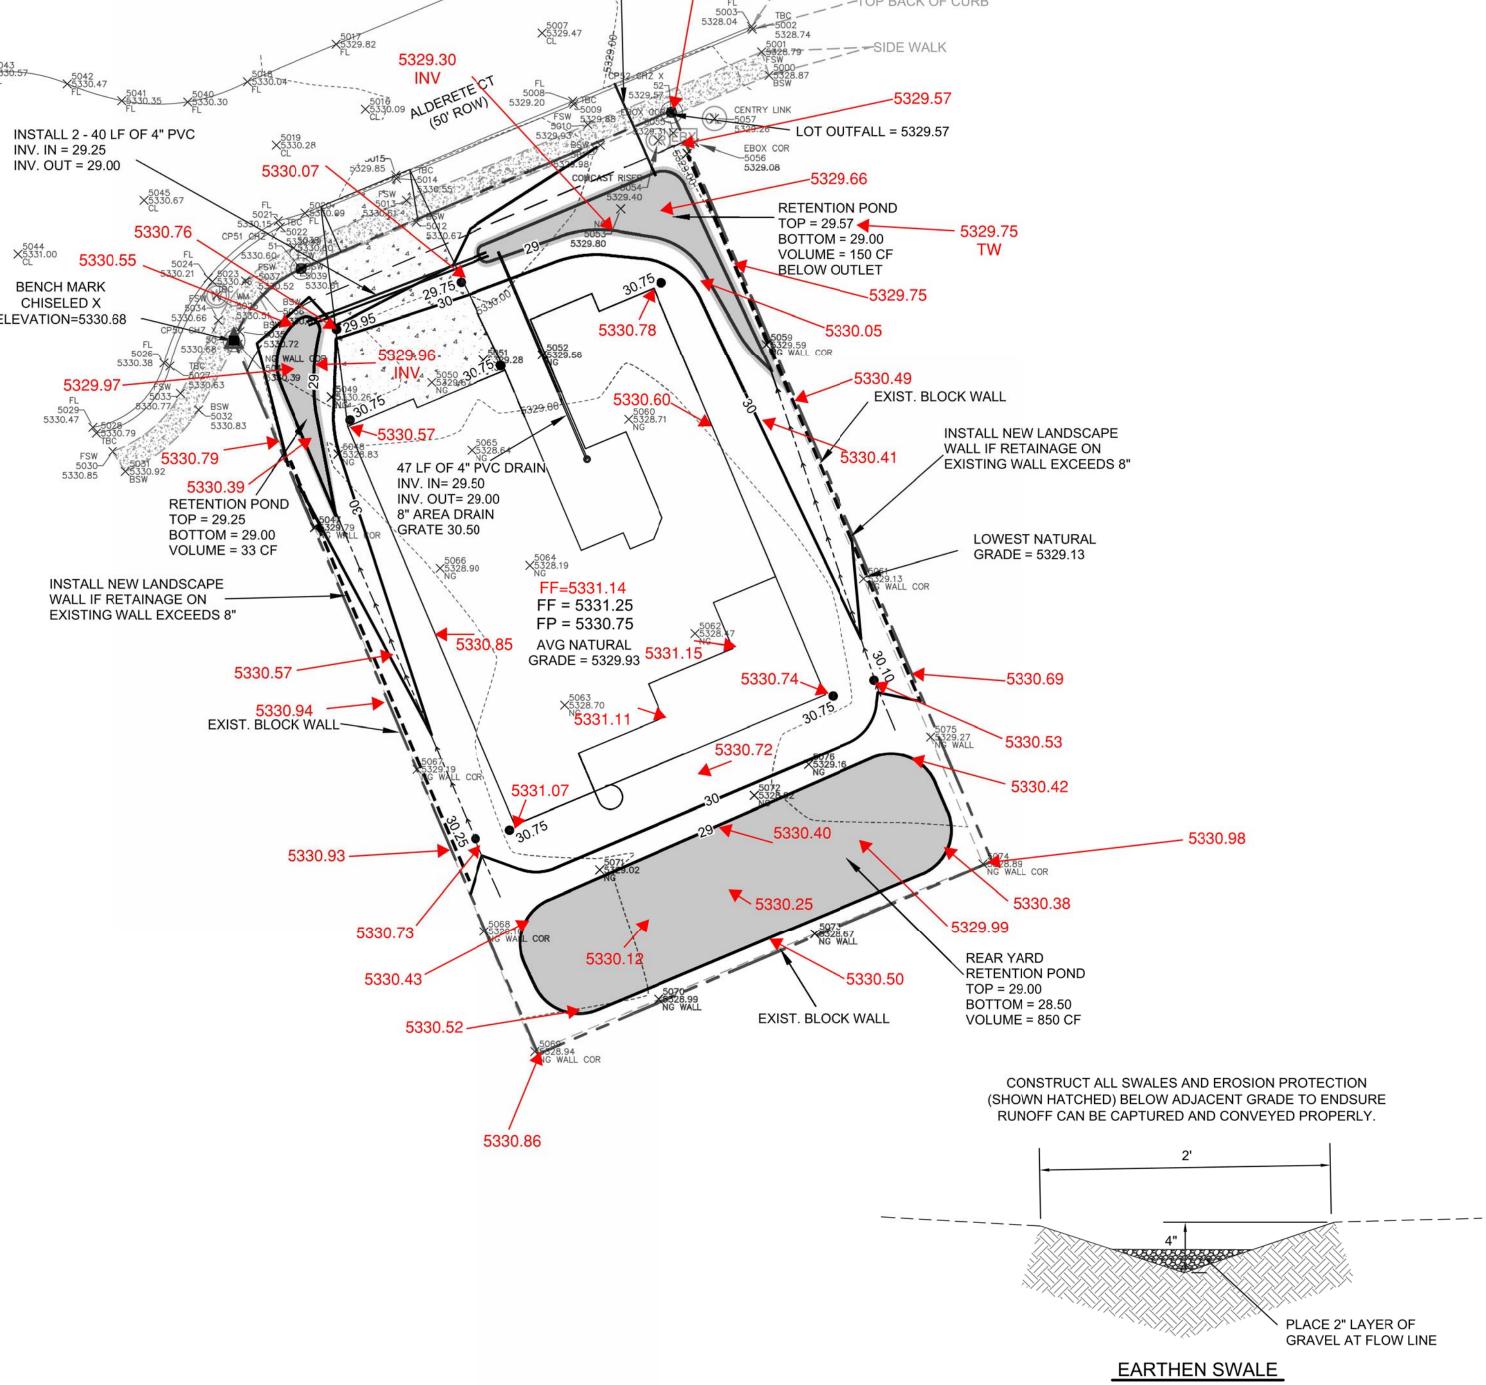

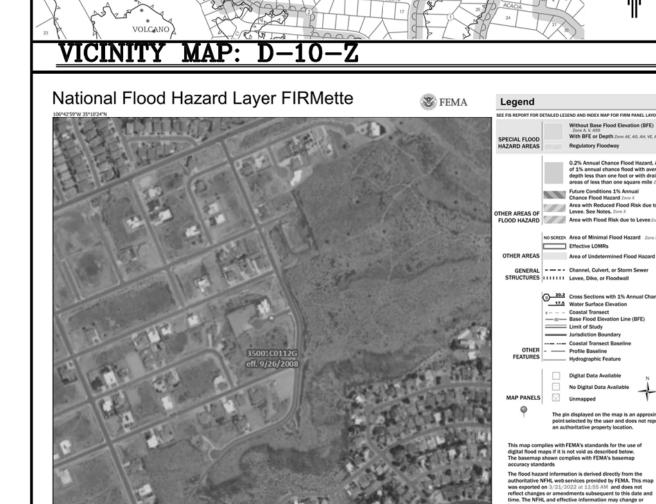

FIRM MAP:

LEGAL DESCRIPTION: LOT 22 BLOCK 8 UNIT 22 VOLCANO CLIFFS SUBDIVSION CITY OF ALBUQUERQUE, BERNALILLO COUNTY, NEW MEXICO

NOTES:

1. ALL SPOT ELEVATIONS REPRESENT FLOWLINE ELEVATION UNLESS OTHERWISE NOTED.

2,000
Basemap: USGS National Map: Orthoimagery: Data refreshed October, 2020

ALL SLOPES SHALL BE 3:1 MAX. AND GRAVEL OR NATIVE SEEDING PRIOR TO CO.

3. ANY PERIMETER WALLS MUST BE PERMITED SEPARATELY ALL RETAINING WALL DESIGN SHALL BE BY OTHERS.


4. SURVEY INFORMATION PROVIDED BY COMMUNITY SCIENCES CORPORATION USING NAVD DATUM 1988.

5. A PAD ELEVATION CERTIFICATION SHALL BE REQUIRED PRIOR TO RELEASE OF BUILDING

LEGEND

EXISTING CONTOUR -----XXXX---------- EXISTING INDEX CONTOUR PROPOSED CONTOUR PROPOSED INDEX CONTOUR EXISTING SPOT ELEVATION × XXXX XXXX PROPOSED SPOT ELEVATION BOUNDARY ----- ADJACENT BOUNDARY ≡≡≡≡≡≡≡≡≡≡ EXISTING CURB AND GUTTER ──── PROPOSED EARTHEN SWALE PROPOSED RETAINING WALL 4 4 PROPOSED CONCRETE



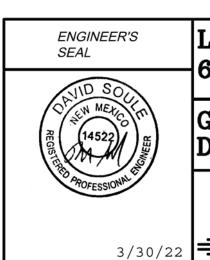

LOT 22 BLK 8 U 22 VC 6304 ALDERETE CT. GRADING AND

DRAINAGE PLAN

6304 ALDERETE CT.DWG Rio Grande Engineering . PO BOX 93924 ALBUQUERQUE, NM 87199 (505) 321-9099

DAVID SOULE P.E. #14522

SHEET# C1 JOB#

DRAWN

 BY $_{DEM}$

DATE 3-30-22