

Weighted E Method													
Basin	Area (sf)	Area (acres)	Treatment A (% (acres))	Treatment B (% (acres))	Treatment C (% (acres))	Treatment D (% (acres))	Weighted E (ac-ft)	100 Year EIR Volume (ac-ft)	Flow cfs				
UPLAND	1100	0.025	0%	0%	10%	0.000	0.000	0.000	0.000	0.00			
NATIVE	16402.00	0.377	80%	0.3012	10%	0.038	10%	0.03785	0%	0.000	0.518	0.016	0.57
ALLOWED	16402.00	0.377	0%	0	10%	0.038	40%	0.15062	50%	0.188	1.448	0.045	1.33
PROPOSED	22593.00	0.519	0%	0	31%	0.161	39%	0.20228	30%	0.158	1.185	0.051	1.59
INCREASE													
total													0.035

Equations:

Weighted E = Ea**A*a + Eb**A*b + Ec**A*c + Ed**A*d / (Total Area)

Volume = Weighted D * Total Area

Flow = Qa * *A*a + Qb * *A*b + Qc * *A*c + Qd * *A*d


Where for 100-year, 6-hour storm-zone 1
Ea= 0.44 Qa= 1.28
Eb= 0.67 Qb= 2.03
Ec= 0.89 Qc= 2.87
Ed= 1.97 Qd= 4.37

ONSITE Conditions

FIRST FLUSH WATER QUALITY VOLUME REQUIRED (CF)	PROVIDED (CF)
192	772
INCREASE FROM NATIVE 1523	1535


Narrative

This site is within the SAD 228 Master Drainage plan boundaries. The site is to drain to the adjacent lot per the master drainage plan. We are ponding the water harvest volume generated by the site we are ponding the increased volume and flow and allowing access to discharge the site at historical location. This plan has a shallow water harvest pond per the drainage regulations. This plan is in conformance to the masterplan

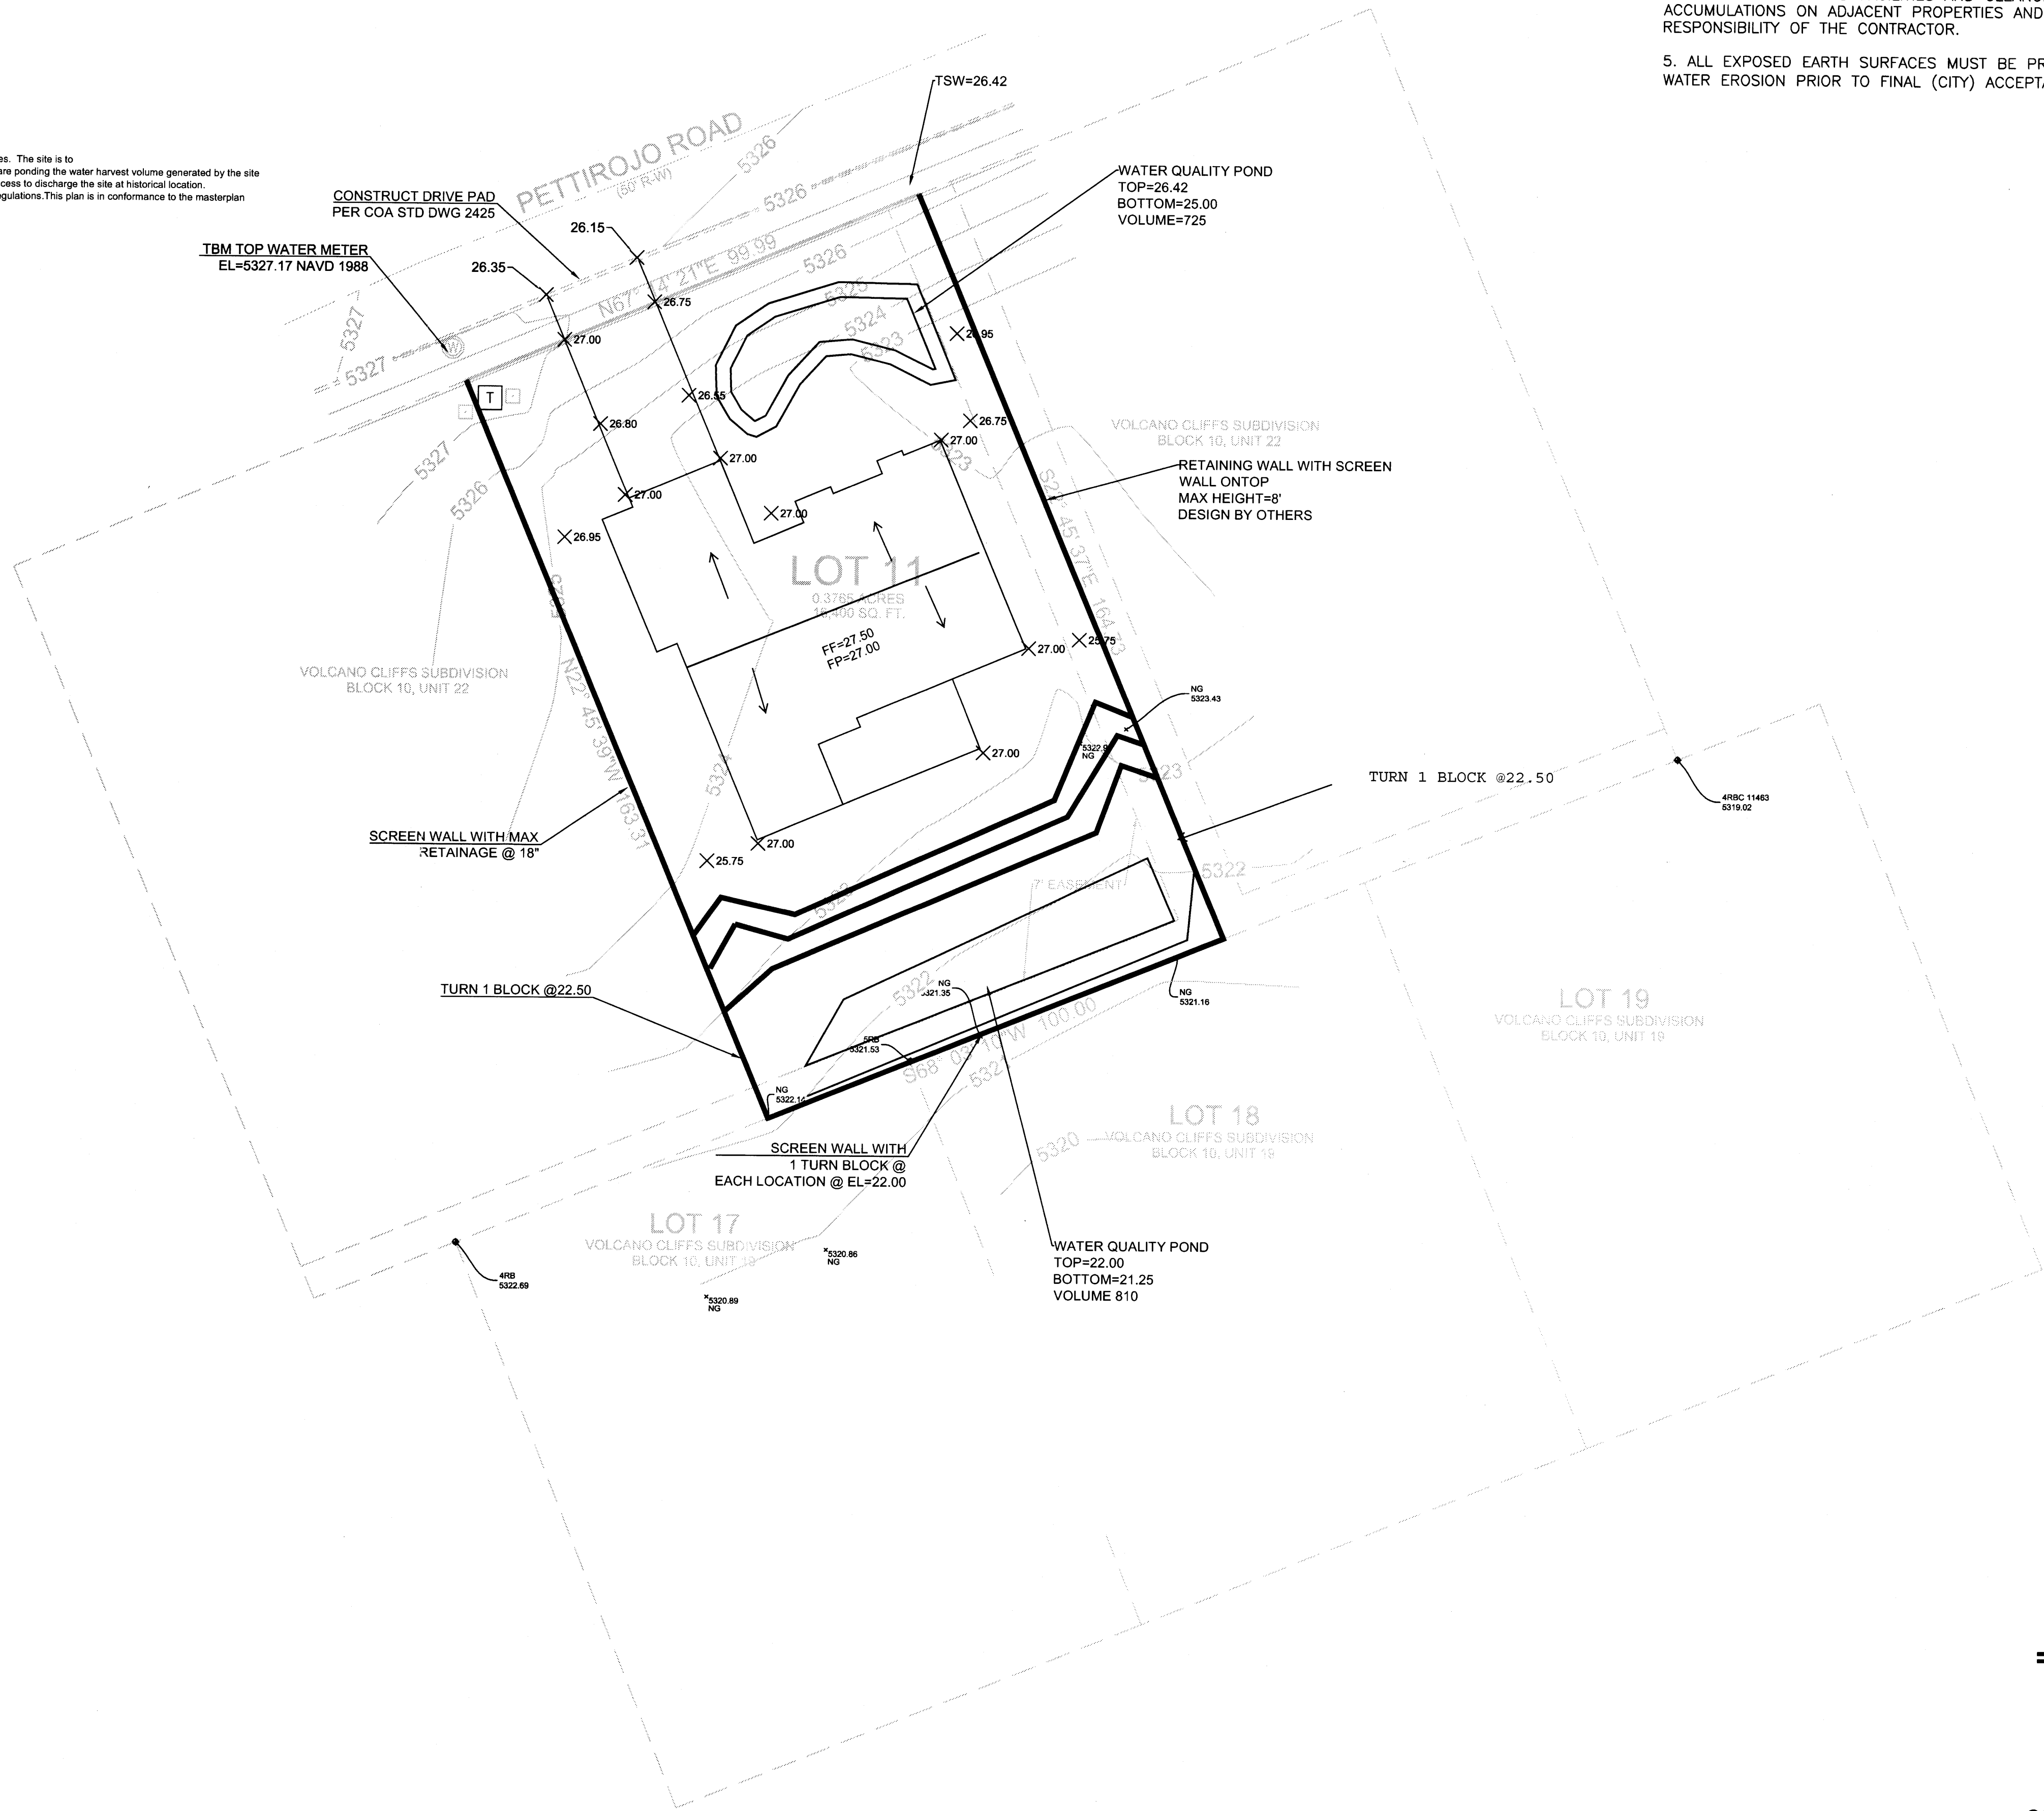


EROSION CONTROL NOTES:

1. CONTRACTOR IS RESPONSIBLE FOR OBTAINING A TOPSOIL DISTURBANCE PERMIT PRIOR TO BEGINNING WORK.
2. CONTRACTOR IS RESPONSIBLE FOR MAINTAINING RUN-OFF ON SITE DURING CONSTRUCTION.
3. CONTRACTOR IS RESPONSIBLE FOR CLEANING ALL SEDIMENT THAT GETS INTO EXISTING RIGHT-OF-WAY.
4. REPAIR OF DAMAGED FACILITIES AND CLEANUP OF SEDIMENT ACCUMULATIONS ON ADJACENT PROPERTIES AND IN PUBLIC FACILITIES IS THE RESPONSIBILITY OF THE CONTRACTOR.
5. ALL EXPOSED EARTH SURFACES MUST BE PROTECTED FROM WIND AND WATER EROSION PRIOR TO FINAL (CITY) ACCEPTANCE OF ANY PROJECT.

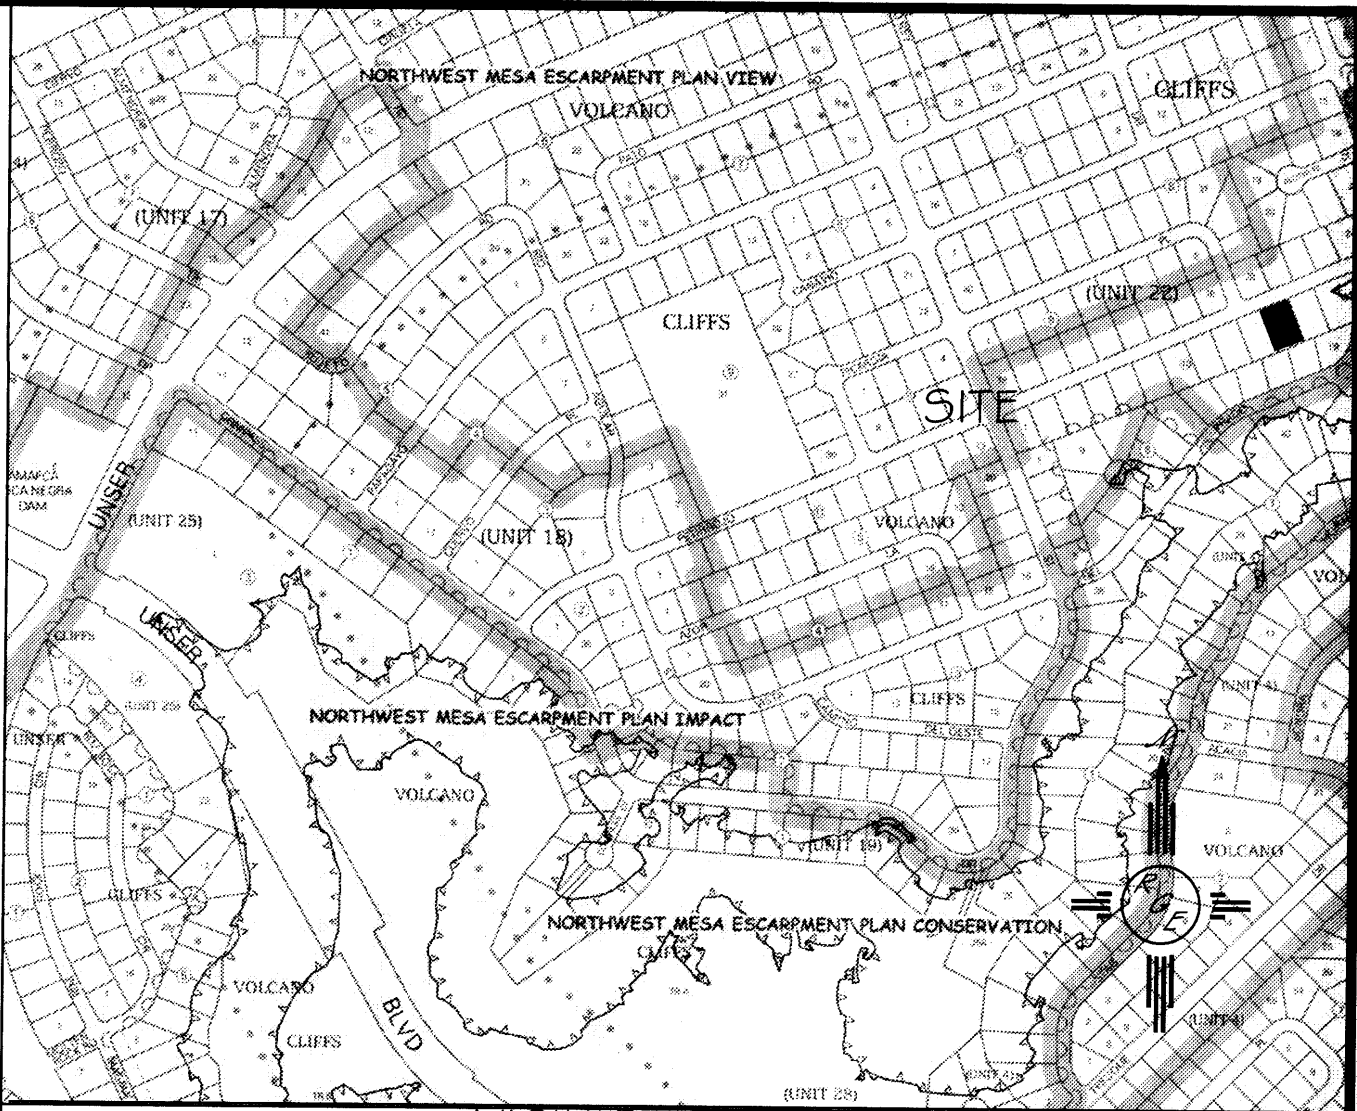

VICINITY MAP:

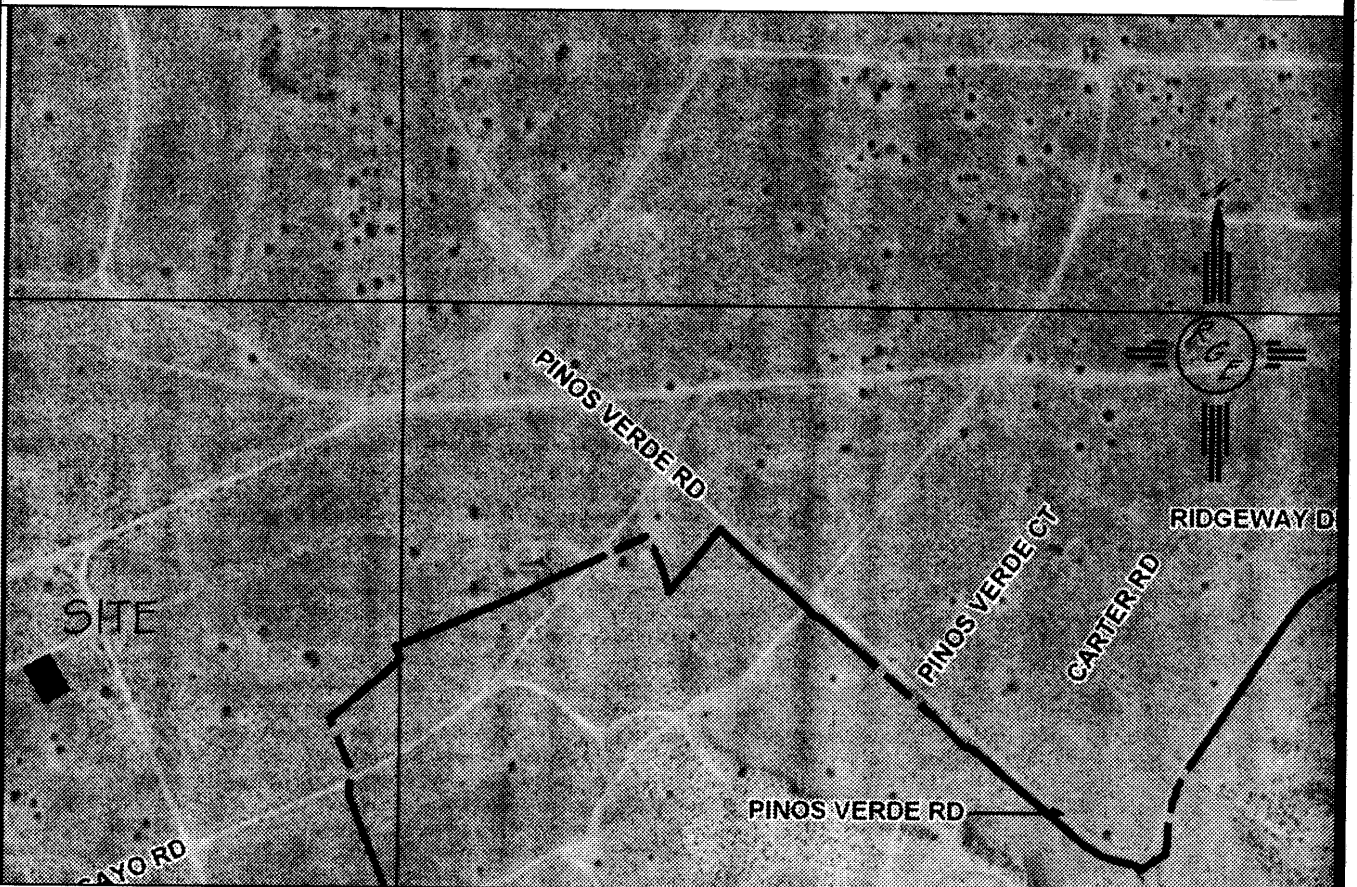

FIRM MAP:

FM35001C0112G

LEGAL DESCRIPTION:


LOT 11, BLOCK 10, UNIT 22, VOLCANO CLIFFS

NOTES:

1. ALL SPOT ELEVATIONS REPRESENT FLOWLINE ELEVATION UNLESS OTHERWISE NOTED.
2. TOPOGRAPHIC SURVEY INFORMATION SHOWN ON THIS PLAN WAS OBTAINED BY CONSTRUCTION SURVEY TECHNOLOGIES, DAVID ACOSTA PLS 2081, DATED DECEMBER 2015

LEGEND

- 5411 --- EXISTING CONTOUR
- 5410 --- EXISTING INDEX CONTOUR
- 5411 --- PROPOSED CONTOUR
- 5410 --- PROPOSED INDEX CONTOUR
- FLOW DIRECTION-SWALE
- PROPOSED SPOT (FLOW-LINE)

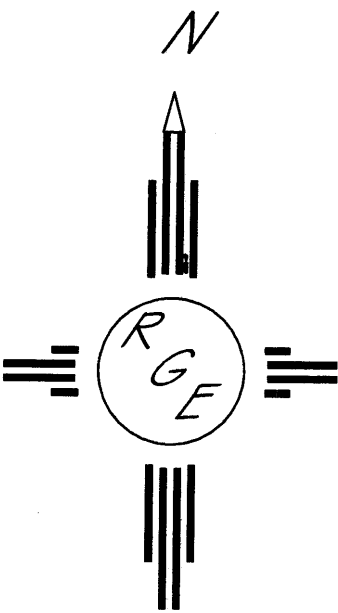

GRAPHIC SCALE

0 10 20

SCALE: 1"=30'



ENGINEER'S SEAL	LOT 11, BLOCK 10, UNIT 22 VOLCANO CLIFFS SUBDIVISION	DRAWN BY JDG
DAVID SOULE NEW MEXICO REGISTERED PROFESSIONAL ENGINEER 14522	GRADING AND DRAINAGE PLAN	DATE 12-14-2015
12/14/15	Rio Grande Engineering 1806 CENTRAL AVENUE SE SUITE 201 ALBUQUERQUE, NM 87106 (505) 872-0999	SHEET # 1 OF 1
DAVID SOULE P.E. #14522		JOB #


I David Soule, NMPE 14522, of the firm Rio Grande Engineering, hereby certify that this project has been graded and will drain in substantial compliance with and in accordance with the design intend of the approved plan dated 12/23/15. The record information edited on the original design document has performed by me or under my direct supervision and is true and correct to the best of my knowledge and belief. The as-built survey was provided DAVID ACOSTA NMPS 21082. The certification is submitted in support of a request for PERMANENT CERTIFICATE OF OCCUPANCY. The record information presented heron is not necessarily complete and intended only to verify substantial compliance of the grading and drainage aspects of this project. Those relying on this record document are advised to obtain independent verification of its accuracy before using it for any other purpose.

EXCEPTIONS

1. THE SITE WAS GRADED SUCH THAT SLOPE TIES OCCUR ONSITE, NO WALLS ARE TO BE CONSTRUCTED. OWNER WILL PARTICIPATE IN WALL CONSTRUCTION WHEN ADJACENT LOTS DEVELOP (DUE TO ANTICIPATED FILL ON ADJOINERS)
2. PONDING OF 330 CF EXCEEDS REQUIRED WATER QUALITY OF 190CF




6/29/16

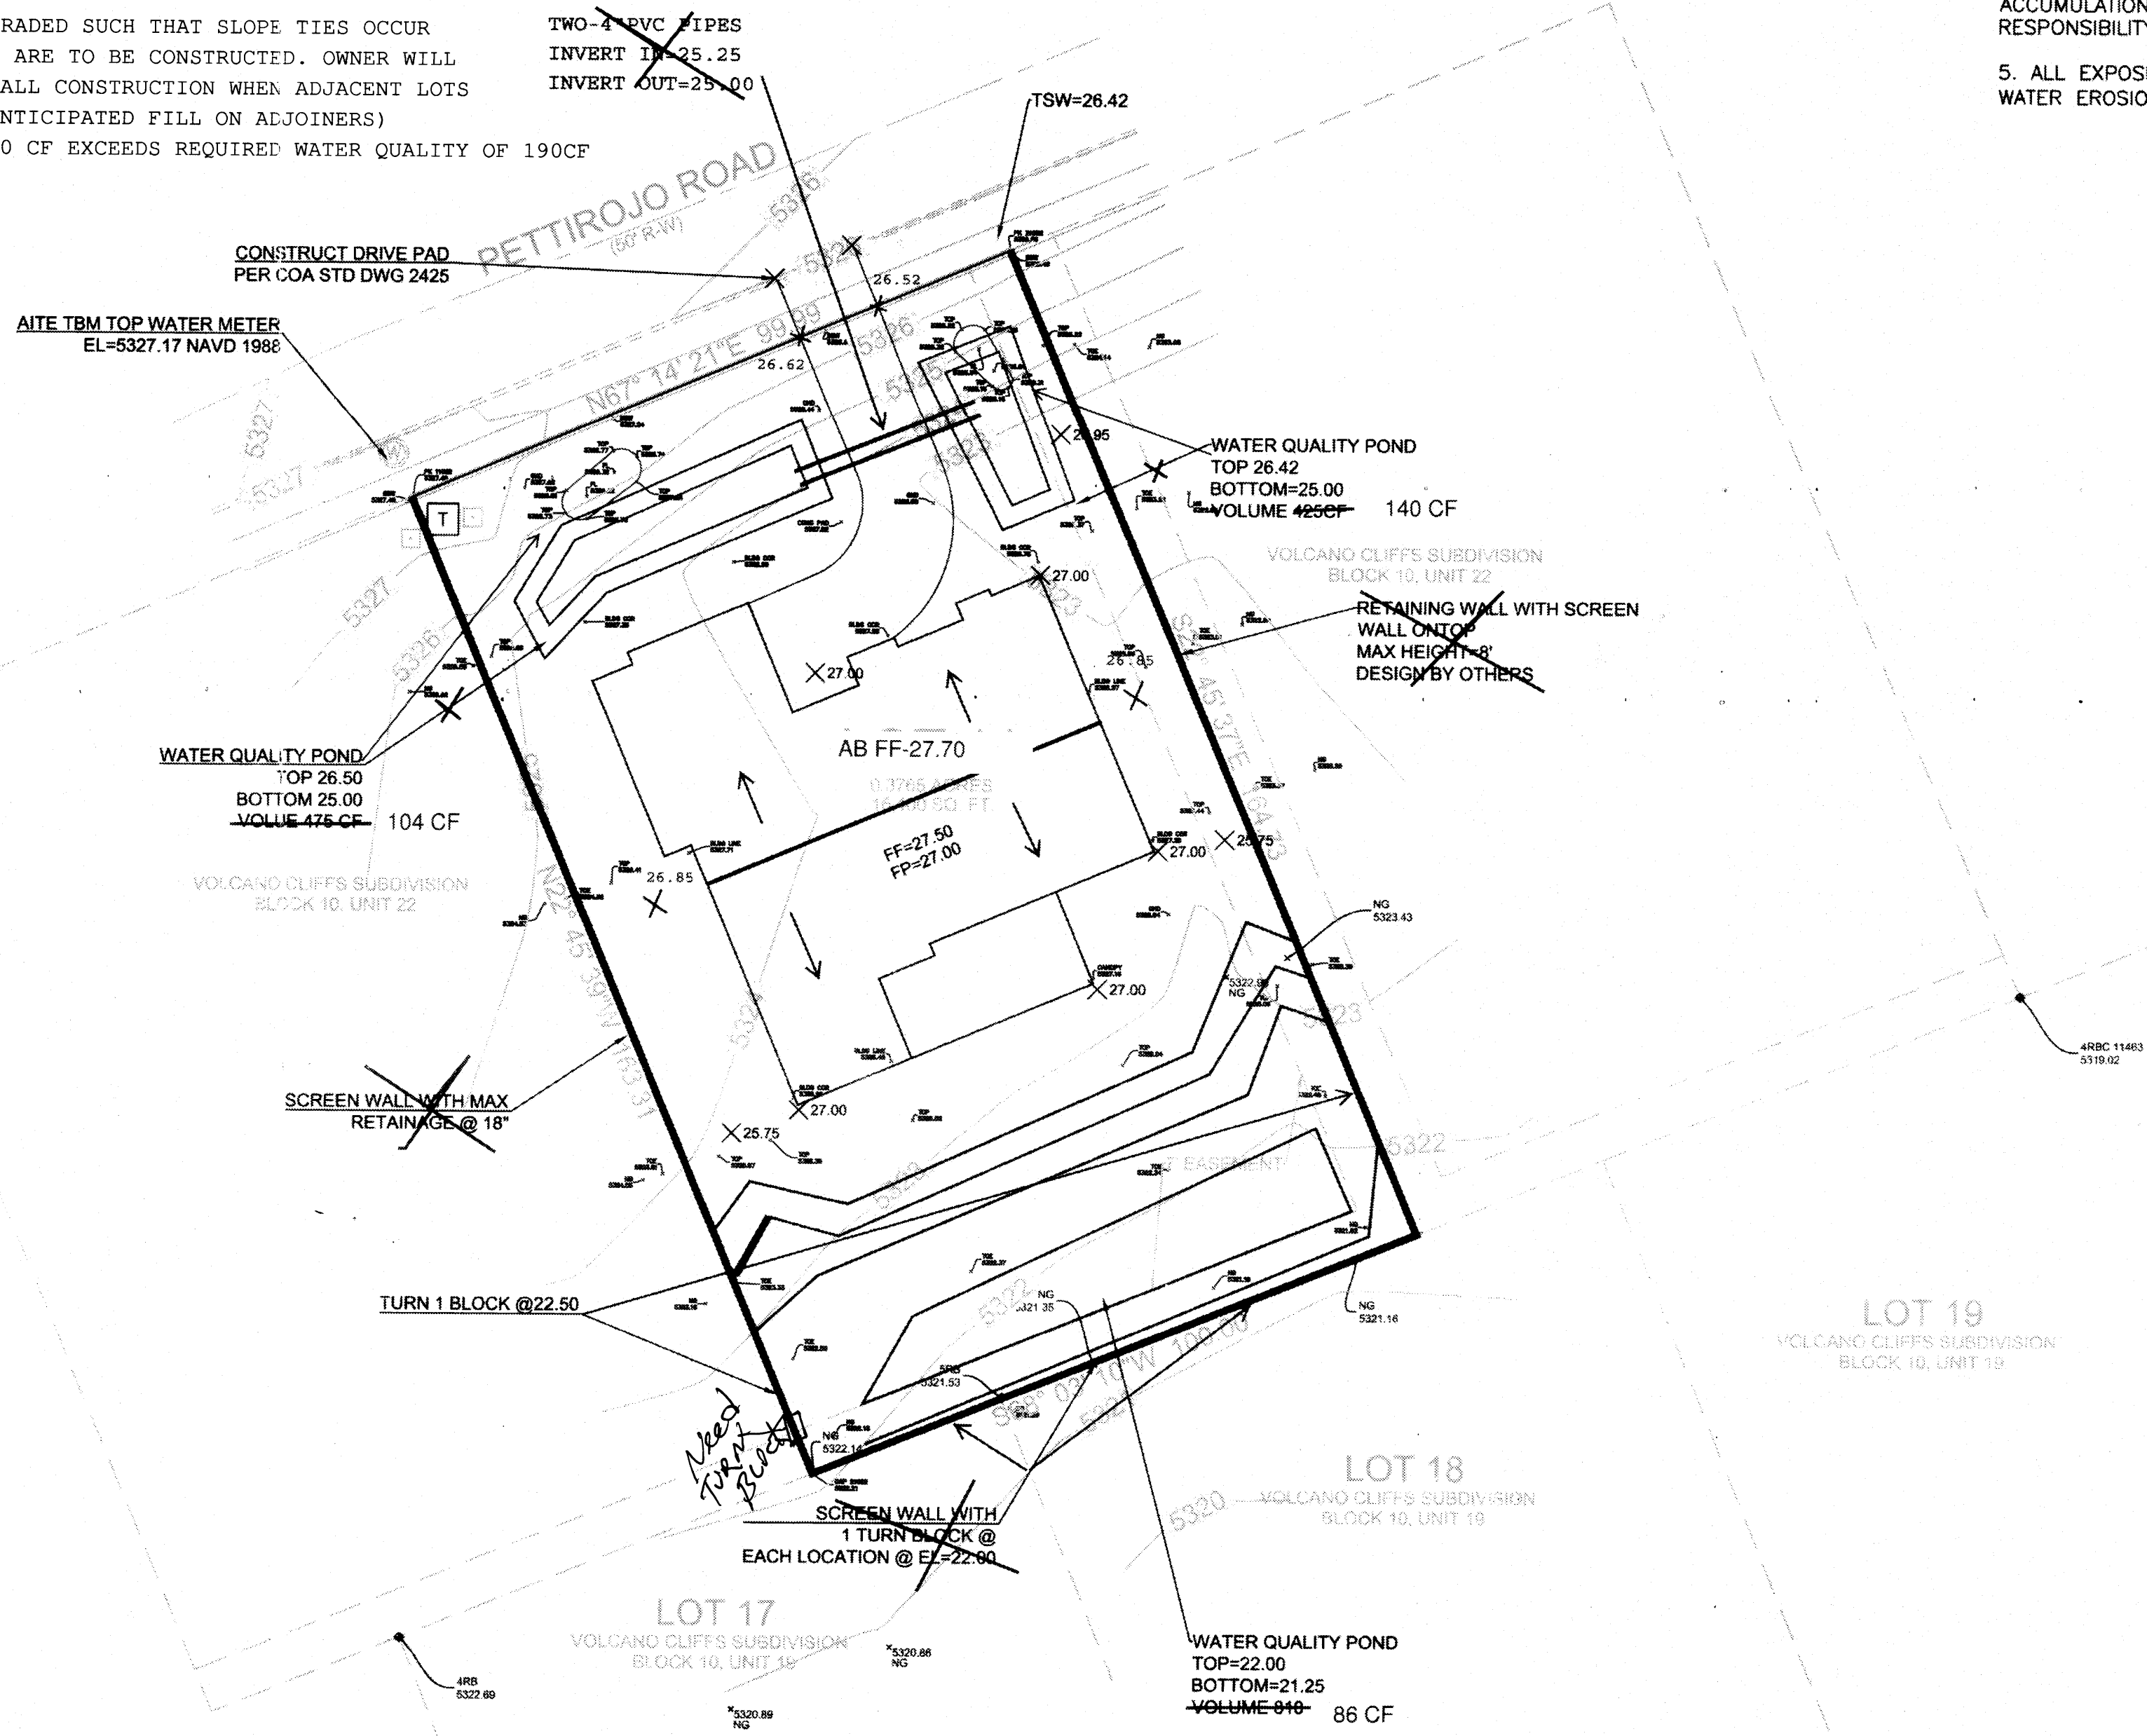


EROSION CONTROL NOTES:

1. CONTRACTOR IS RESPONSIBLE FOR OBTAINING A TOPSOIL DISTURBANCE PERMIT PRIOR TO BEGINNING WORK.
2. CONTRACTOR IS RESPONSIBLE FOR MAINTAINING RUN-OFF ON SITE DURING CONSTRUCTION.
3. CONTRACTOR IS RESPONSIBLE FOR CLEANING ALL SEDIMENT THAT GETS INTO EXISTING RIGHT-OF-WAY.
4. REPAIR OF DAMAGED FACILITIES AND CLEANUP OF SEDIMENT ACCUMULATIONS ON ADJACENT PROPERTIES AND IN PUBLIC FACILITIES IS THE RESPONSIBILITY OF THE CONTRACTOR.
5. ALL EXPOSED EARTH SURFACES MUST BE PROTECTED FROM WIND AND WATER EROSION PRIOR TO FINAL (CITY) ACCEPTANCE OF ANY PROJECT.

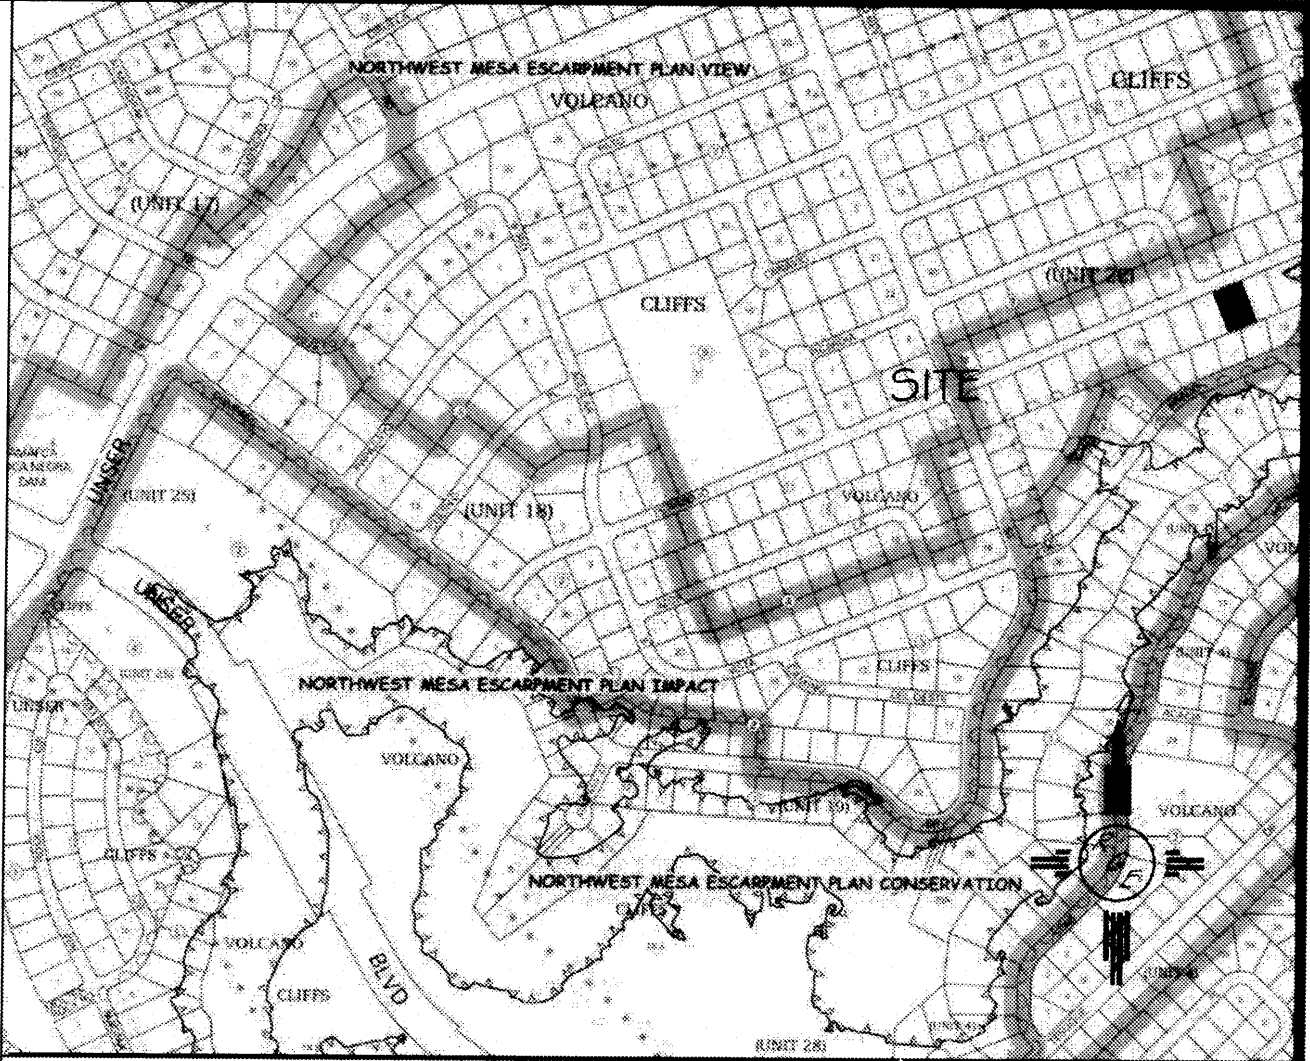

VICINITY MAP:

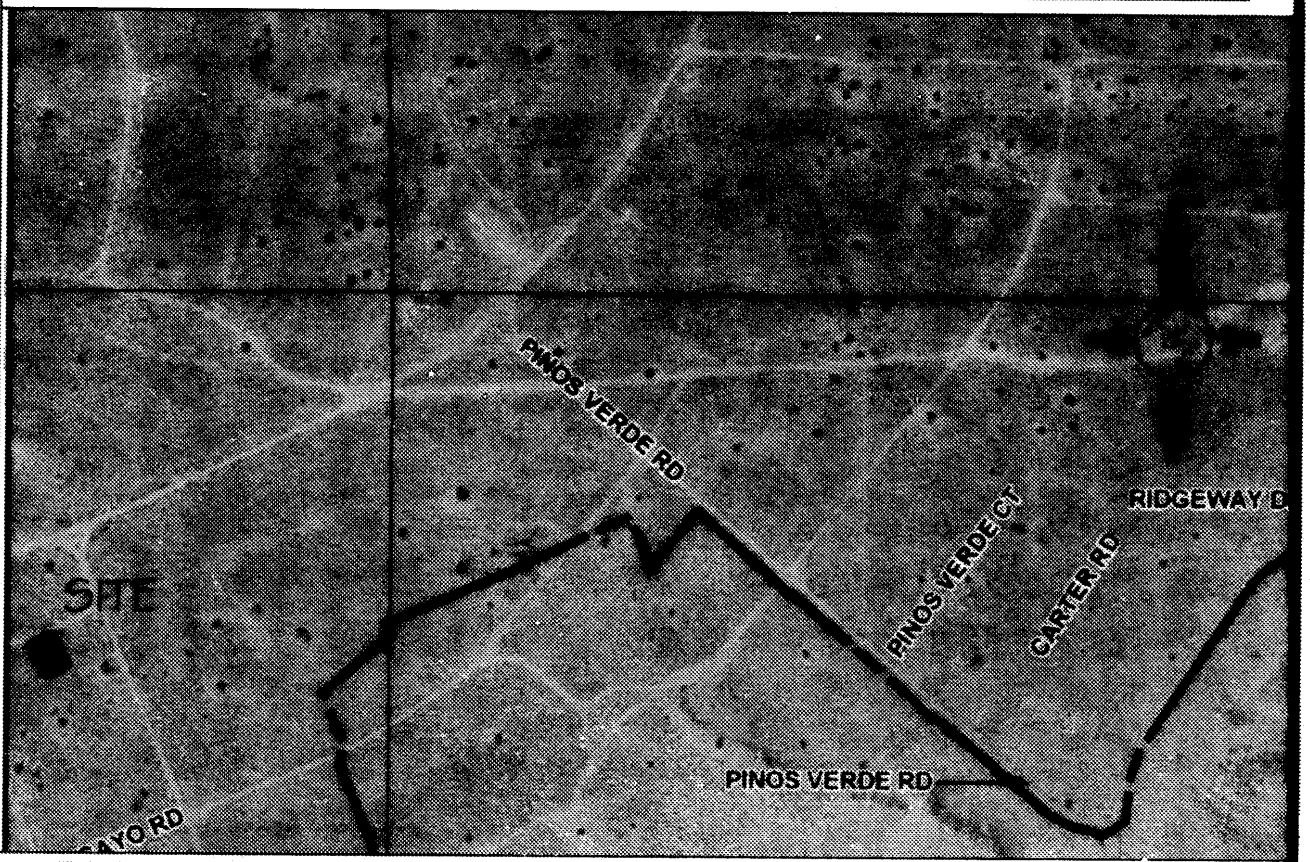

FIRM MAP:

FM35001C0112G

LEGAL DESCRIPTION:


LOT 11, BLOCK 10, UNIT 22, VOLCANO CLIFFS

NOTES:

1. ALL SPOT ELEVATIONS REPRESENT FLOWLINE ELEVATION UNLESS OTHERWISE NOTED.
2. TOPOGRAPHIC SURVEY INFORMATION SHOWN ON THIS PLAN WAS OBTAINED BY CONSTRUCTION SURVEY TECHNOLOGIES, DAVID ACOSTA PLS 2081, DATED DECEMBER 2015

LEGEND

- 5411 --- EXISTING CONTOUR
- 5410 --- EXISTING INDEX CONTOUR
- 5411 --- PROPOSED CONTOUR
- 5410 --- PROPOSED INDEX CONTOUR
- 5410 --- FLOW DIRECTION-SWALE
- 5410 --- PROPOSED SPOT (FLOW-LINE)

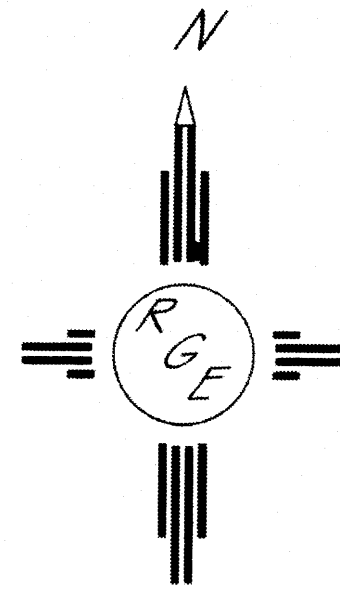


GRAPHIC SCALE

SCALE: 1"=20'

ENGINEER'S SEAL	LOT 11, BLOCK 10, UNIT 22 VOLCANO CLIFFS SUBDIVISION	DRAWN BY JDG
	GRADING AND DRAINAGE PLAN	DATE 12-23-2015
12/23/15	 Rio Grande Engineering 1606 CENTRAL AVENUE SE SUITE 201 ALBUQUERQUE, NM 87106 (505) 872-0999	SHEET # 1 OF 1
DAVID SOULE P.E. #14522		JOB #

1. CONTRACTOR IS RESPONSIBLE FOR OBTAINING A TOPSOIL DISTURBANCE PERMIT PRIOR TO BEGINNING WORK.
2. CONTRACTOR IS RESPONSIBLE FOR MAINTAINING RUN-OFF ON SITE DURING CONSTRUCTION.
3. CONTRACTOR IS RESPONSIBLE FOR CLEANING ALL SEDIMENT THAT GETS INTO EXISTING RIGHT-OF-WAY.
4. REPAIR OF DAMAGED FACILITIES AND CLEANUP OF SEDIMENT ACCUMULATIONS ON ADJACENT PROPERTIES AND IN PUBLIC FACILITIES IS THE RESPONSIBILITY OF THE CONTRACTOR.
5. ALL EXPOSED EARTH SURFACES MUST BE PROTECTED FROM WIND AND WATER EROSION PRIOR TO FINAL (CITY) ACCEPTANCE OF ANY PROJECT.

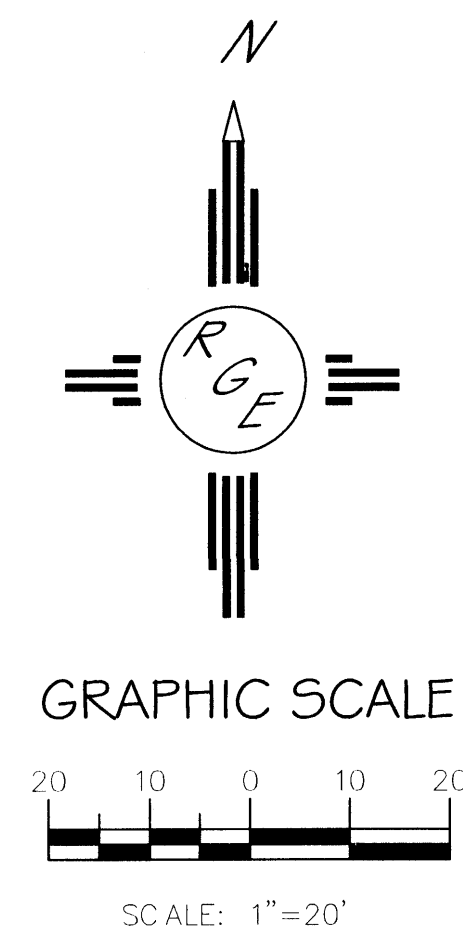



LOT 11, BLOCK 10, UNIT 22, VOLCANO CLIFFS

NOTES:

1. ALL SPOT ELEVATIONS REPRESENT FLOWLINE ELEVATION UNLESS OTHERWISE NOTED.
2. TOPOGRAPHIC SURVEY INFORMATION SHOWN ON THIS PLAN WAS OBTAINED BY CONSTRUCTION SURVEY TECHNOLOGIES, DAVID ACOSTA PLS 2081, DATED DECEMBER 2015

Diagram illustrating the relationship between existing and proposed contours and index contours for a spot elevation:

- EXISTING CONTOUR: 5411 (dashed line)
- EXISTING INDEX CONTOUR: 5410 (solid line)
- PROPOSED CONTOUR: 5411 (solid line)
- PROPOSED INDEX CONTOUR: 5410 (solid line)
- FLOW DIRECTION—SWALE (indicated by an arrow pointing left)
- PROPOSED SPOT (FLOW—LINE) (indicated by a spot symbol)
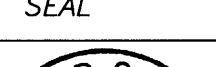
<p>ENGINEER'S SEAL</p> 	<p>LOT 11, BLOCK 10, UNIT 22 VOLCANO CLIFFS SUBDIVISION</p>	<p>DRAWN BY JDC</p>
<p>12/23/15</p>	<p>GRADING AND DRAINAGE PLAN</p>	<p>DATE 12-23-2015</p>
<p>DAVID SOULE P.E. #14522</p>	 <p><i>Rio Grande</i> <i>Engineering</i> 1606 CENTRAL AVENUE SE SUITE 201 ALBUQUERQUE, NM 87106 (505) 872-0999</p>	<p>SHEET # 1 OF 1</p>
<p>DAVID SOULE P.E. #14522</p>		<p>JOB #</p>