

CITY OF ALBUQUERQUE

Planning Department
David Campbell, Director



Mayor Timothy M. Keller

August 24, 2018

David Soule, P.E.
Rio Grande Engineering
PO Box 93924
Albuquerque, New Mexico 87199

RE: **Lot 9 Block 10 SAD 228**
Volcano Cliffs Subdivision
6400 Petirrojo NW
Grading and Drainage Plan
Engineers Stamp Date 12/7/14 (D10D003F9)
CO Certification Dated: Not Dated

Dear Mr. Soule,

Based upon the information provided in your submittal received 8/23/18, this plan cannot be approved for Certificate of Occupancy until the following comments are addressed.

- Sign and date the certification for C.O.
- Provide the opening for the atrium and show where the inlets flows are directed.
- The inlets in the atrium were not installed properly. They are 2 – 3 inches above the finished gravel landscaping. Provide the spot elevations for the inlets inverts in and out.

If you have any questions, please contact me at 924-3986 or Rudy Rael at 924-3977.

Sincerely,

James D. Hughes, P.E.
Principal Engineer, Hydrology
Planning Department

RR/JDH
C: File D10D003F9



City of Albuquerque

Planning Department
Development & Building Services Division

DRAINAGE AND TRANSPORTATION INFORMATION SHEET (REV 6/2018)

Project Title: 6400 PETIRROJO **Building Permit #:** _____ **Hydrology File #:** D10D003F9

DRB#: _____ **EPC#:** _____ **Work Order#:** _____

Legal Description: lot 9 block 10 volcano cliffs unit 22

City Address: 6400 PETIRROJO

Applicant: FRANK GONZALES

Contact: _____

Address: _____

Phone#: _____

Fax#: _____

E-mail: _____

Other Contact: RIO GRANDE ENGINEERING

Contact: DAVID SOULE

Address: PO BOX 93924 ALB NM 87199

Phone#: 505.321.9099

Fax#: 505.872.0999

E-mail: david@riograndeengineering.com

TYPE OF DEVELOPMENT: ☐ PLAT ☐ RESIDENCE ☐ DRB SITE ☐ ADMIN SITE

Check all that Apply:

DEPARTMENT:

☒ HYDROLOGY/ DRAINAGE
☐ TRAFFIC/ TRANSPORTATION

TYPE OF SUBMITTAL:

☒ ENGINEER/ARCHITECT CERTIFICATION
☐ PAD CERTIFICATION
☐ CONCEPTUAL G & D PLAN
☐ GRADING PLAN
☐ DRAINAGE REPORT
☐ DRAINAGE MASTER PLAN
☐ FLOODPLAIN DEVELOPMENT PERMIT APPLIC
☐ ELEVATION CERTIFICATE
☐ CLOMR/LOMR
☐ TRAFFIC CIRCULATION LAYOUT (TCL)
☐ TRAFFIC IMPACT STUDY (TIS)
☐ STREET LIGHT LAYOUT
☐ OTHER (SPECIFY) _____
☐ PRE-DESIGN MEETING?

IS THIS A RESUBMITTAL?: ☒ Yes ☐ No

TYPE OF APPROVAL/ACCEPTANCE SOUGHT:

☐ BUILDING PERMIT APPROVAL
☒ CERTIFICATE OF OCCUPANCY
☐ PRELIMINARY PLAT APPROVAL
☐ SITE PLAN FOR SUB'D APPROVAL
☐ SITE PLAN FOR BLDG. PERMIT APPROVAL
☐ FINAL PLAT APPROVAL
☐ SIA/ RELEASE OF FINANCIAL GUARANTEE
☐ FOUNDATION PERMIT APPROVAL
☐ GRADING PERMIT APPROVAL
☐ SO-19 APPROVAL
☐ PAVING PERMIT APPROVAL
☐ GRADING/ PAD CERTIFICATION
☐ WORK ORDER APPROVAL
☐ CLOMR/LOMR
☐ FLOODPLAIN DEVELOPMENT PERMIT
☐ OTHER (SPECIFY) _____

DATE SUBMITTED: _____ **By:** _____

COA STAFF:

ELECTRONIC SUBMITTAL RECEIVED: _____

FEE PAID: _____

Weighted E Method													
										100-Year, 6-hr.			
Basin	Area (sf)	Area (acres)	Treatment A		Treatment B		Treatment C		Treatment D	Weighted (ac-ft)	Volume (ac-ft)	Flow cfs	
			% (acres)	% (acres)	% (acres)	% (acres)	% (acres)	% (acres)	% (acres)				
UPLAND	48600.00	1.116	0%	0	10%	0.112	40%	0.4463	50%	0.558	1.448	0.135	3.95
ALLOWED	16203.00	0.372	0%	0	10%	0.037	40%	0.1488	50%	0.186	1.448	0.045	1.32
PROPOSED	16203.00	0.372	0%	0	20%	0.074	43%	0.1599	37%	0.138	1.289	0.040	1.21
total													

Equations:

Weighted E = Ea*Aa + Eb*Ab + Ec*Ac + Ed*Ad / (Total Area)

Volume = Weighted D * Total Area

Flow = Qa * Aa + Qb * Ab + Qc * Ac + Qd * Ad

Where for 100-year, 6-hour storm- zone 1

Ea= 0.44
Eb= 0.67
Ec= 0.99
Ed= 1.97

Qa= 1.29
Qb= 2.03
Qc= 2.87
Qd= 4.37

ONSITE Conditions

FIRST FLUSH WATER QUALITY VOLUME

REQUIRED (CF)

WATER QUALITY 170

PROVIDED (CF)

1269

Narrative

This site is within the SAD 228 Master Drainage plan boundaries. The site has hight restrictions, therefore the pad is lowered as much as practik maintaining existing patterns and in conformance to the master drainage plan. We are ponding the water harvest volume generated by the site we are allowing the negligible upland flow to pass thru the site. This plan has a shallow water harvest pond in excess of the drainage regulati This plan is in conformance to the master drainage plan

TURNUED BLOCKS

Weir Equation:

$$Q = CLH^{3/2}$$

wale thru walls

Q= 2.92 cfs
C = 2.95
H = 0.5 ft
L = Length of weir

$$Q = 2.95 * .5 * ((0.5)^{(3/2)})$$

Each opening is 6"x6"
Each block has two openings
Each opening has .52 cfs capacity,
Therefore each turned block has 1.04 cfs capacity

I David Soule, NMPE 14522 , of the firm Rio Grande Engineering, hereby certify that this project has been graded and will drain in substantial compliance with and in accordance with the design intend of the approved plan dated 12/7/17. The record information edited on the original design document has performed by me or under my direct supervision and is true and correct to the best of my knowledge and belief. The as-built survey was provided by THOMAS PATRICK NMPS 12651. The certification is submitted in support of a request for PERMANENT CERTIFICATE OF OCCUPANCY. The record information presented heron is not necessarily complete and intended only to verify substantial compliance of the grading and drainage aspects of this project. Those relying on this record document are advised to obtain independent verification of its accuracy before using it for any other purpose



8/23/18


CAUTION:

EXISTING UTILITIES ARE NOT SHOWN. IT SHALL BE THE SOLE RESPONSIBILITY OF THE CONTRACTOR TO CONDUCT ALL NECESSARY FIELD INVESTIGATIONS PRIOR TO ANY EXCAVATION TO DETERMINE THE ACTUAL LOCATION OF UTILITIES & OTHER IMPROVEMENTS.

I, DAVID SOULE HAVE PERSONALLY INPECTED THE SITE. I HEREBY CERTIFY THE PAD HAS BEEN CONSTRUCTED SUCH THAT IT IS IN SUBSTANTIAL CONFORMANCE TO THE APPROVED GRADING PLAN DATED 12/7/17




2/22/18

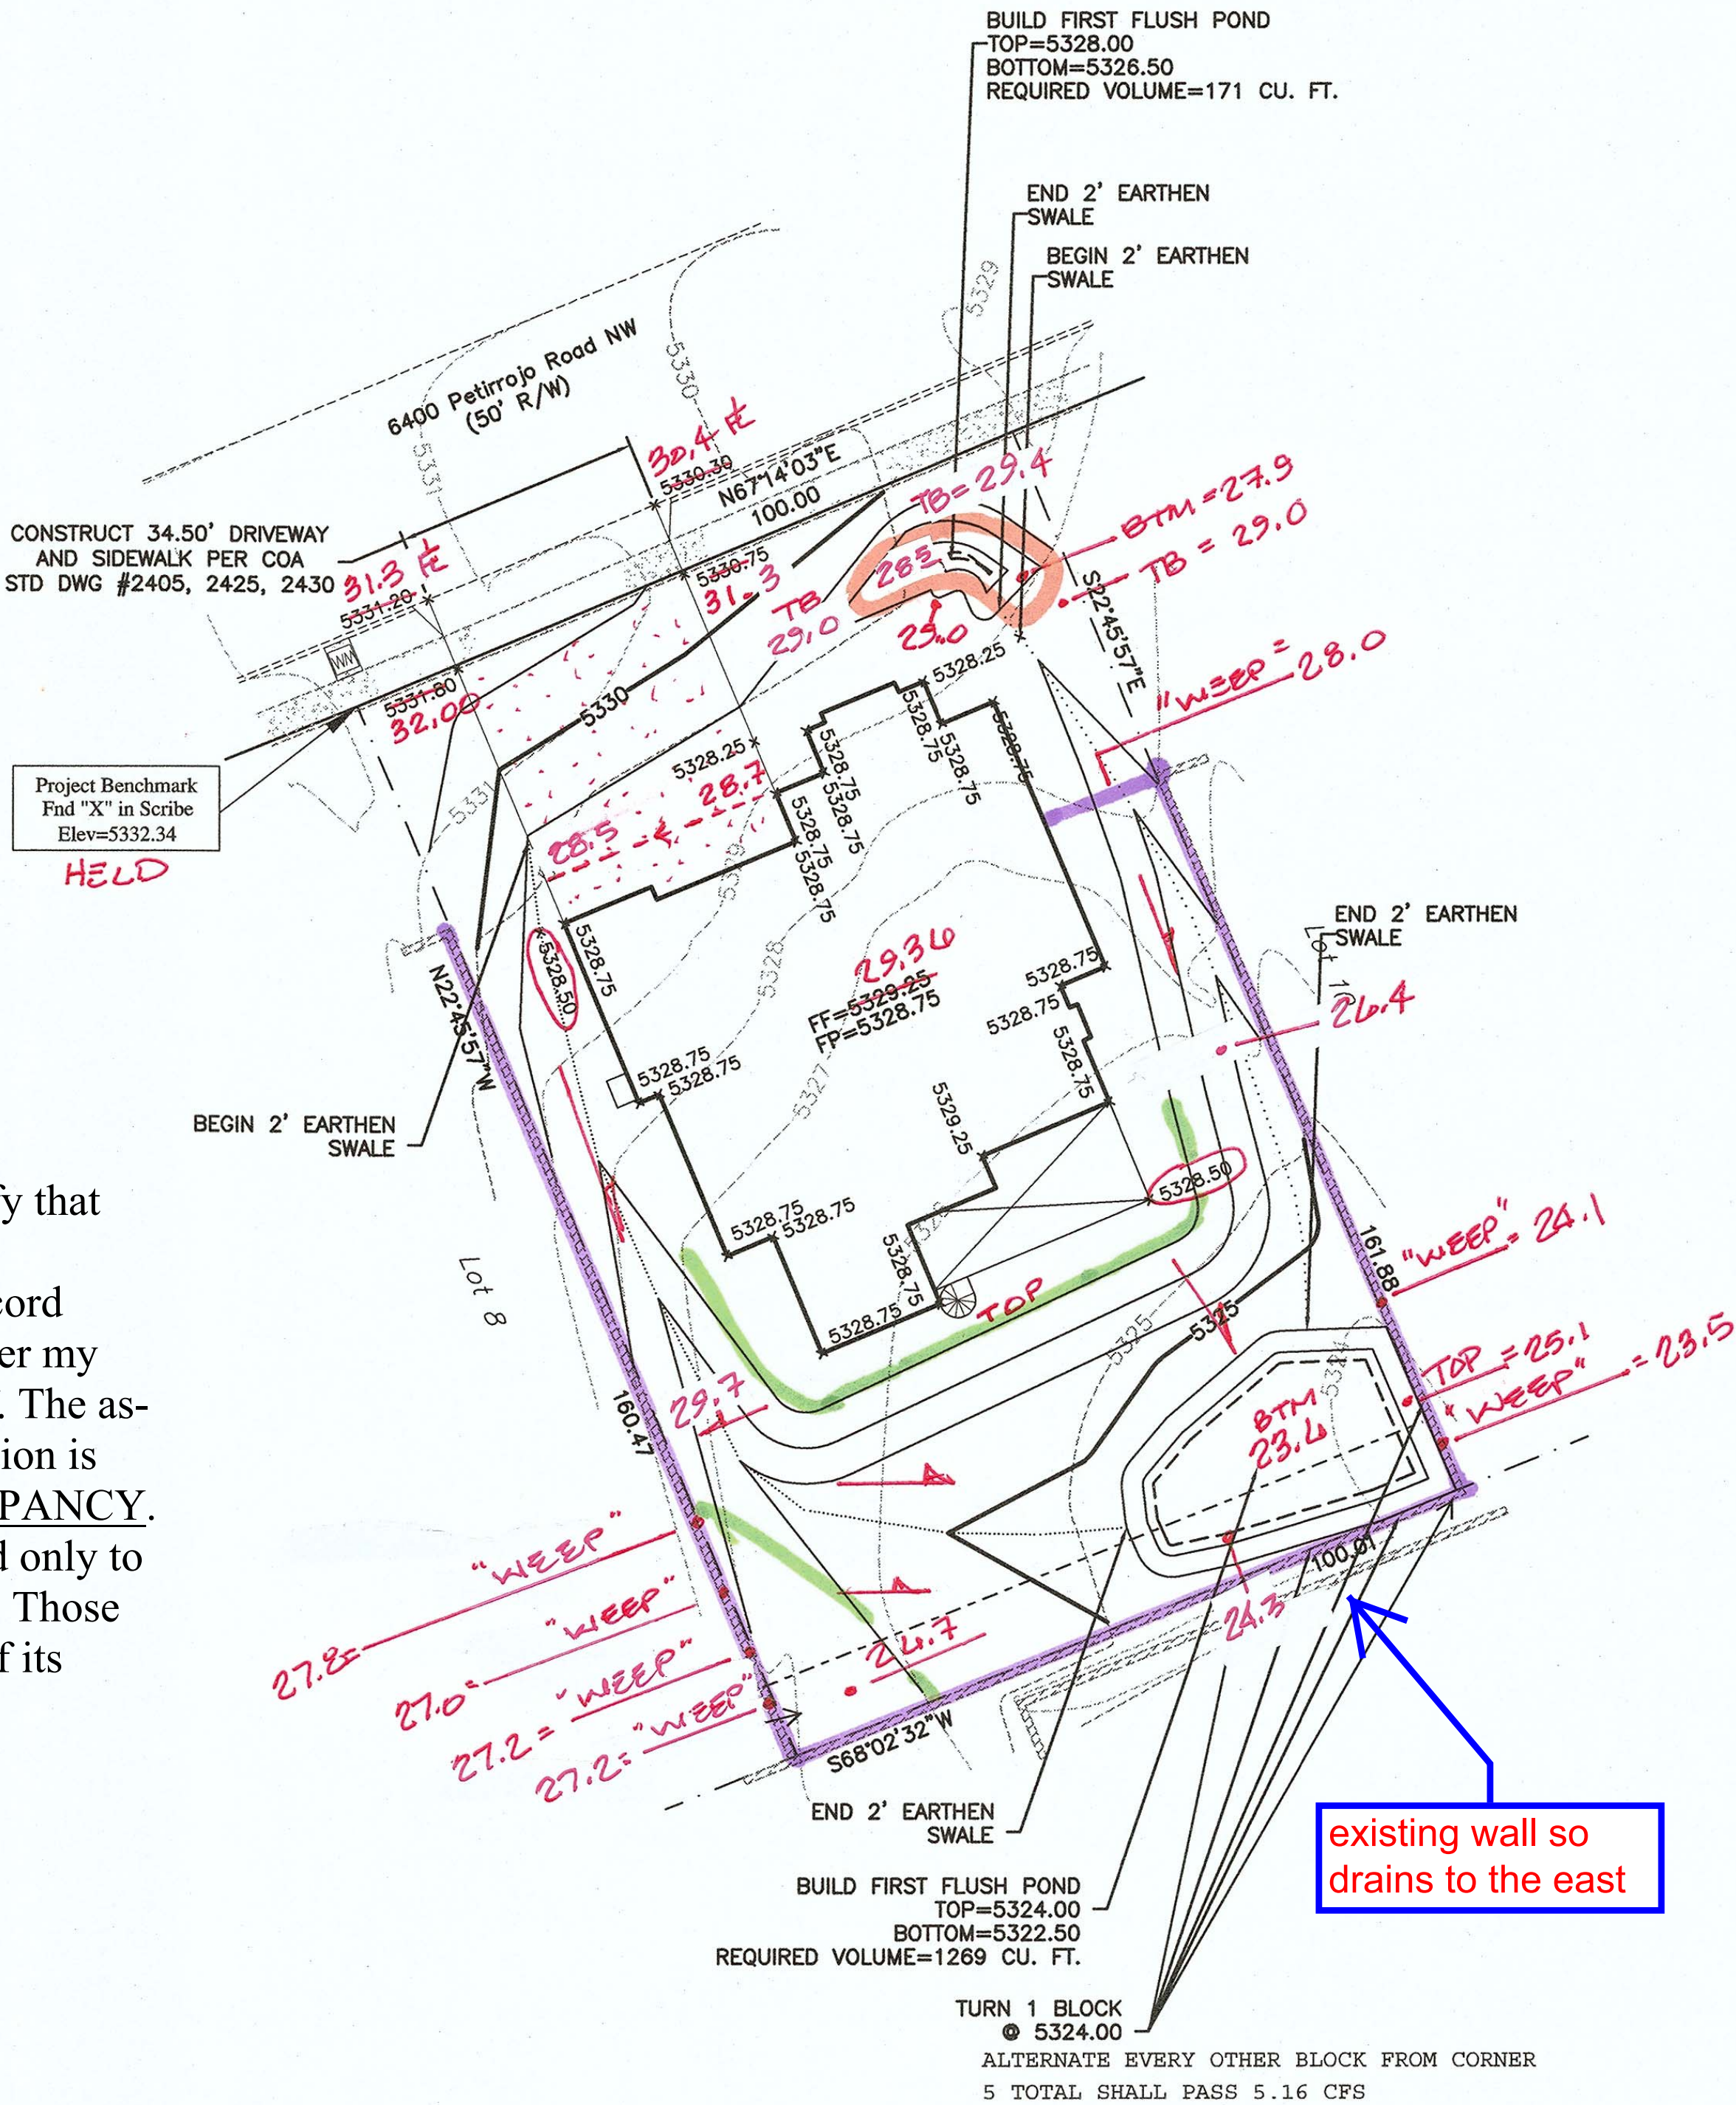

EROSION CONTROL NOTES:

1. CONTRACTOR IS RESPONSIBLE FOR OBTAINING A TOPSOIL DISTURBANCE PERMIT PRIOR TO BEGINNING WORK.
2. CONTRACTOR IS RESPONSIBLE FOR MAINTAINING RUN-OFF ON SITE DURING CONSTRUCTION.
3. CONTRACTOR IS RESPONSIBLE FOR CLEANING ALL SEDIMENT THAT GETS INTO EXISTING RIGHT-OF-WAY.
4. REPAIR OF DAMAGED FACILITIES AND CLEANUP OF SEDIMENT ACCUMULATIONS ON ADJACENT PROPERTIES AND IN PUBLIC FACILITIES IS THE RESPONSIBILITY OF THE CONTRACTOR.
5. ALL EXPOSED EARTH SURFACES MUST BE PROTECTED FROM WIND AND WATER EROSION PRIOR TO FINAL ACCEPTANCE OF ANY PROJECT.

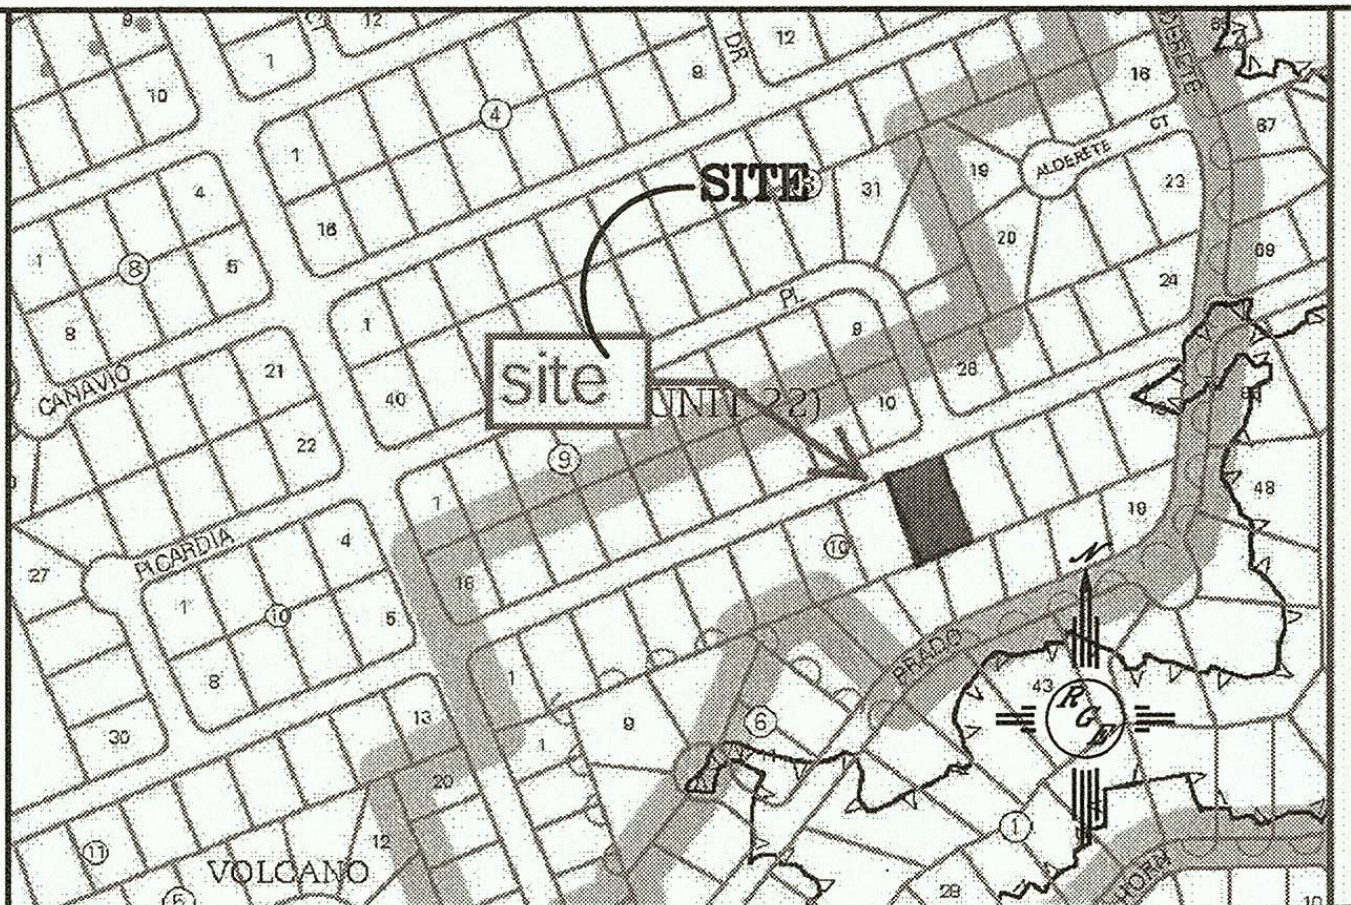

VICINITY MAP: D-10-Z



FIRM MAP: FM35001C0112G

LEGAL DESCRIPTION:



Lot 9, Block 10, Volcano Cliffs Unit 22

NOTES:

1. ALL SPOT ELEVATIONS REPRESENT FLOWLINE ELEVATION UNLESS OTHERWISE NOTED.
2. ALL SLOPES SHALL BE 3:1 MAX. AND GRAVEL OR NATIVE SEEDING PRIOR TO CO.

LEGEND

- X---X---X---X--- EXISTING CONTOUR
- X---X---X---X--- EXISTING INDEX CONTOUR
- X---X---X---X--- PROPOSED CONTOUR
- X---X---X---X--- PROPOSED INDEX CONTOUR
- X---X---X---X--- SLOPE TIE
- XXXX EXISTING SPOT ELEVATION
- XXXX PROPOSED SPOT ELEVATION
- BOUNDARY
- CENTERLINE
- RIGHT-OF-WAY
- ===== EXISTING CURB AND GUTTER
- ===== PROPOSED CMU SCREEN WALL

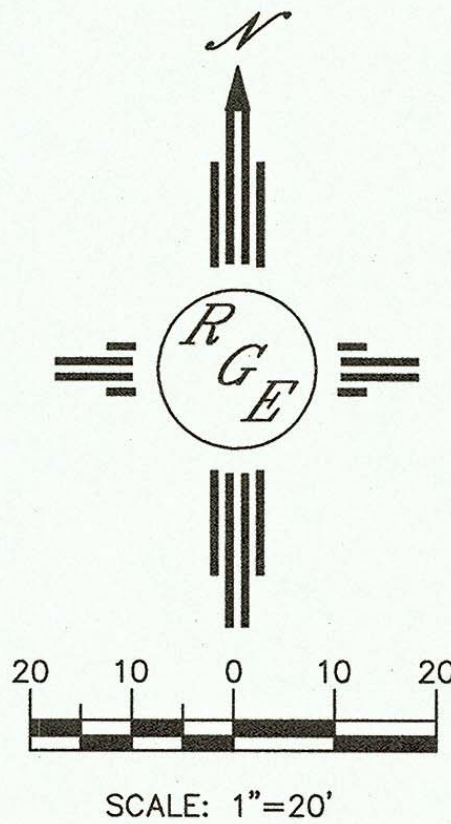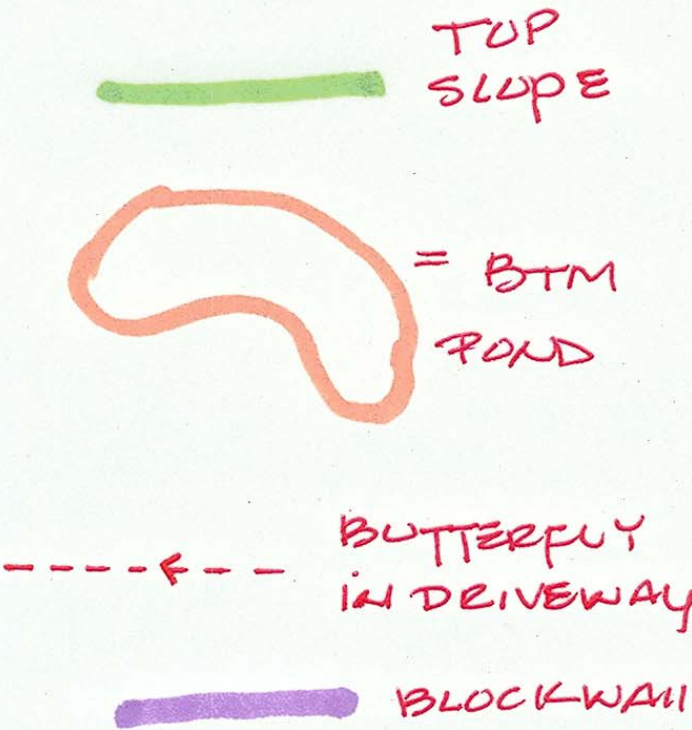

ENGINEER'S SEAL 12/7/17 12/4/17 DAVID SOULE P.E. #14522	6400 PETIRROJO NW	DRAWN BY WCWJ DATE 12-01-17 21827-LAYOUT-12-01-17
	GRADING AND DRAINAGE PLAN Rio Grande Engineering 1806 CENTRAL AVENUE SE SUITE 201 ALBUQUERQUE, NM 87106 (505) 872-0899	SHEET # — JOB # 21827