

Mayor Timothy M. Keller

April 12, 2022

David Soule, P.E. Rio Grande Engineering PO Box 93924 Albuquerque, New Mexico 87199

RE: RE: Lot 13 Block 5 Volcano Cliffs Unit 19 SAD 228

6509 Azor Ln. NW

**Grading and Drainage Plan** 

**Engineers Stamp Date 5/1/2021 (D10D003H13)** 

Pad Certification Date 4/8/2022

Mr. Soule,

Based upon the information provided in your submittal received 4/12/2022, this plan is approved for Building Permit.

PO Box 1293

Please inform the builder/owner to attach a copy of this approved plan and this letter to the construction sets in the permitting process prior to sign-off by Hydrology.

Albuquerque

Reiterate to the Owner/Contractor that a separate permit for a garden/retaining wall must be obtained, with the approved G&D plan and Pad Certification. Also, let the owner/contractor know that if a pool is to be added in the future the G&D plan will need to be modified showing the location of the pool and the land treatment differences. Also advise the owner & Contractor that dirt is not allowed in the public right of way to climb the curb. Crusher fines or lumber is allowed. If dirt is used this will delay going forward with the construction of the home.

www.cabq.gov

NM 87103

Prior to Certificate of Occupancy release, Engineer Certification per the DPM checklist of this plan will be required.

If you have any questions, please contact me at 924-3986 or Rudy Rael at 924-3977.

Sincerely,

Ernest Armijo, P.E.

Principal Engineer, Planning Dept. Development Review Services



# City of Albuquerque

### Planning Department

### Development & Building Services Division

### DRAINAGE AND TRANSPORTATION INFORMATION SHEET (REV 6/2018)

Project Title: 6509 Azor NW	Building Permit #:	Hydrology File #:						
DRB#:								
Legal Description: LOT 13, BLOCK								
City Address: 6509 Azor NW								
Applicant:		Contact:						
Address:								
Phone#:								
Other Contact: RIO GRANDE ENGIN								
Address: PO BOX 93924 ALB NM	87199	Condict.						
		E-mail: david@riograndeengineering.com						
TYPE OF DEVELOPMENT:PLAT								
Check all that Apply:								
DEPARTMENT:  X HYDROLOGY/ DRAINAGE  TRAFFIC/ TRANSPORTATION  TYPE OF SUBMITTAL:	_X_BUI	F APPROVAL/ACCEPTANCE SOUGHT: LDING PERMIT APPROVAL LTIFICATE OF OCCUPANCY						
ENGINEER/ARCHITECT CERTIFICATION	N PRE	LIMINARY PLAT APPROVAL						
X PAD CERTIFICATION	SITE	E PLAN FOR SUB'D APPROVAL						
CONCEPTUAL G & D PLAN	SITE	E PLAN FOR BLDG. PERMIT APPROVAL						
GRADING PLAN	FINA	AL PLAT APPROVAL						
DRAINAGE REPORT								
DRAINAGE MASTER PLAN		RELEASE OF FINANCIAL GUARANTEE						
FLOODPLAIN DEVELOPMENT PERMIT A		FOUNDATION PERMIT APPROVAL						
ELEVATION CERTIFICATE	<del></del>	ADING PERMIT APPROVAL						
CLOMR/LOMR		19 APPROVAL						
TRAFFIC CIRCULATION LAYOUT (TCL	,	ING PERMIT APPROVAL						
TRAFFIC IMPACT STUDY (TIS)		ADING/PAD CERTIFICATION						
STREET LIGHT LAYOUT		RK ORDER APPROVAL						
OTHER (SPECIFY) PRE-DESIGN MEETING?	<del>-</del>	OMR/LOMR ODPLAIN DEVELOPMENT PERMIT						
IS THIS A RESUBMITTAL?: X Yes N	OTH	IER (SPECIFY)						
DATE SUBMITTED:	By:							
COA STAFF:	ELECTRONIC SUBMITTAL REC	CEIVED:						

FEE PAID:\_\_\_\_\_

### Weighted E Method

										100-Year, 6-hr.				
	Basin	Area	Area	Treat	ment A	Treat	ment B	Treati	ment C	Treatr	ment D	Weighted E	Volume	Flow
		(sf)	(acres)	%	(acres)	%	(acres)	%	(acres)	%	(acres)	(ac-ft)	(ac-ft)	cfs
	ALLOWED	13330.00	0.306	0%	0	20%	0.061	46%	0.1408	34%	0.104	1.259	0.032	0.98
	PROPOSED	13330.00	0.306	0%	0	20%	0.061	29%	0.0887	51%	0.156	1.426	0.036	1.06
	COMPARISON												0.004	

### **Equations:**

Weighted E = Ea\*Aa + Eb\*Ab + Ec\*Ac + Ed\*Ad / (Total Area)

Volume = Weighted D \* Total Area

Flow = Qa \* Aa + Qb \* Ab + Qc \* Ac + Qd \* Ad

### Where for 100-year, 6-hour storm-zone 1

Qa- 1.29
Qb= 2.03
Qc= 2.87
Qd= 4.37

**ONSITE Conditions** FIRST FLUSH WATER QUALITY VOLUME

REQUIRED PROVIDED (CF) (CF)

WATER QUALITY FLOOD CONTROL

## Narrative

This site is within the SAD 226 Master Drainage plan boundaries. The site is to maintain existing patterns and drain to the the adjacent roadway lot to the south per the master drainage plan. We are ponding the water harvest volume generated by the site there is not measurable upland flow. This plan exceeds the allowed impervious area therefore we are required to retain the overage. This plan is in conformance to the master drainage plan


PROJECT BM

ELEV. = 5330.93'


I, DAVID SOULE HAVE PERSONALLY INPECTED THE SITE. I HEREBY CERTIFY THE PAD HAS BEEN CONSTRUCTED SUCH THAT IT IS IN SUBSTANTIAL CONFORMANCE TO THE APPROVED GRADING PLAN DATED 5/1/21





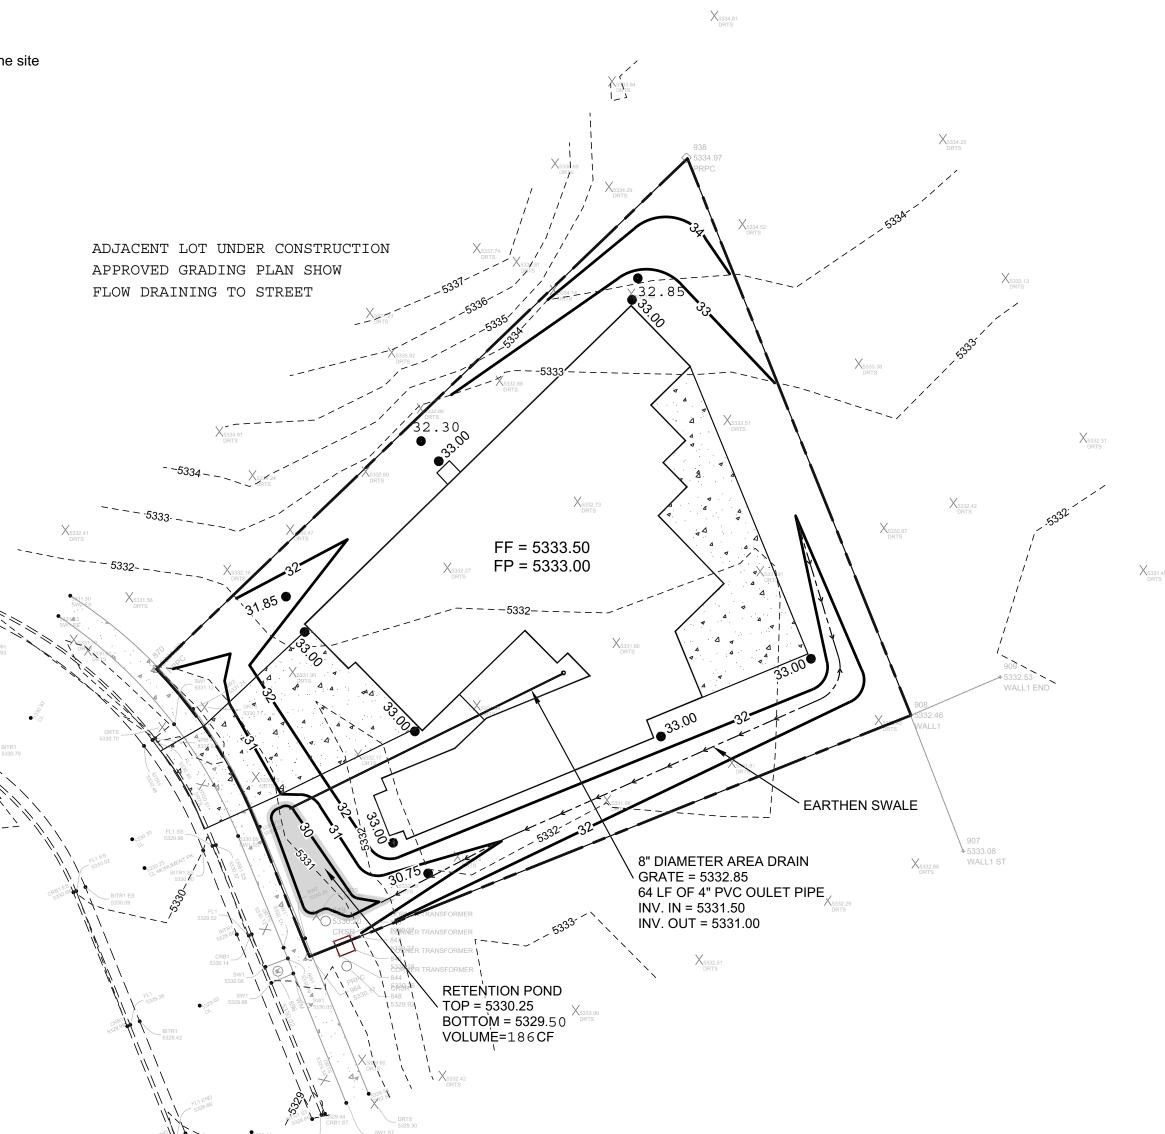

CONSTRUCT ALL SWALES AND EROSION PROTECTION (SHOWN HATCHED) BELOW ADJACENT GRADE TO ENDSURE RUNOFF CAN BE CAPTURED AND CONVEYED PROPERLY.

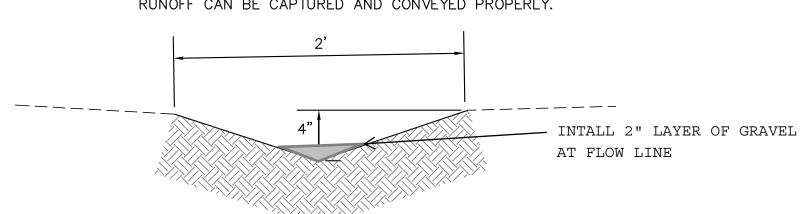


**EARTHEN SWALE** 


# SCALE: 1"=20'

# **EROSION CONTROL NOTES:**

- 1. CONTRACTOR IS RESPONSIBLE FOR OBTAINING A TOPSOIL DISTURBANCE PERMIT PRIOR TO BEGINNING WORK.
- 2. CONTRACTOR IS RESPONSIBLE FOR MAINTAINING RUN-OFF ON SITE DURING CONSTRUCTION.
- 3. CONTRACTOR IS RESPONSIBLE FOR CLEANING ALL SEDIMENT THAT GETS INTO EXISTING RIGHT-OF-WAY.
- 4. REPAIR OF DAMAGED FACILITIES AND CLEANUP OF SEDIMENT ACCUMULATIONS ON ADJACENT PROPERTIES AND IN PUBLIC FACILITIES IS THE RESPONSIBILITY OF THE CONTRACTOR.
- 5. ALL EXPOSED EARTH SURFACES MUST BE PROTECTED FROM WIND AND WATER EROSION PRIOR TO FINAL ACCEPTANCE OF ANY PROJECT.

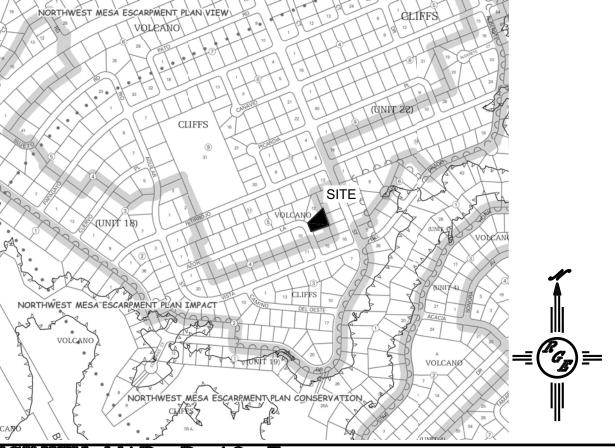

### VICINITY MAP: D-10-Z

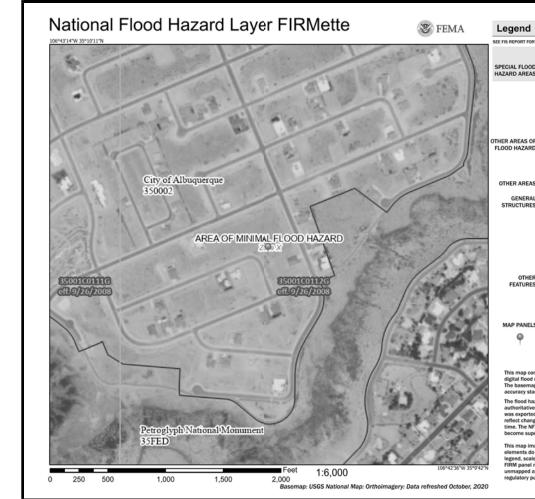

# **LEGAL DESCRIPTION:**

LOT 13 BLOCK 5 UNITI9 VOLCANO CLIFFS
CITY OF ALBUQUERQUE, BERNALILLO COUNTY, NEW MEXICO


# NOTES:


- 1. ALL SPOT ELEVATIONS REPRESENT FLOWLINE ELEVATION UNLESS OTHERWISE NOTED.
- 2. ALL SLOPES SHALL BE 3:1 MAX. AND GRAVEL OR NATIVE SEEDING PRIOR TO CO.
- 3. ANY PERIMETER WALLS MUST BE PERMITED SEPARATELY ALL RETAINING WALL DESIGN SHALL BE BY OTHERS.

4. SURVEY INFORMATION PROVIDED BY COMMUNITY SCIENCES CORPORATION USING NAVD

5. A PAD ELEVATION CERTIFICATION SHALL BE REQUIRED PRIOR TO RELEASE OF BUILDING

# **LEGEND**

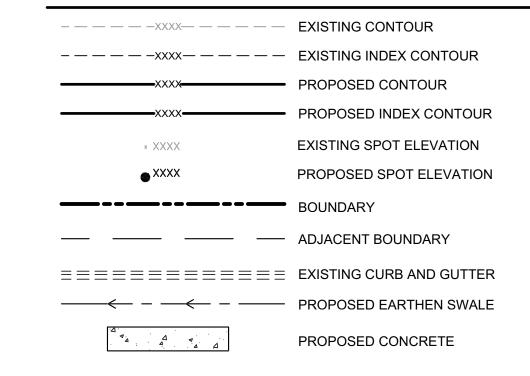

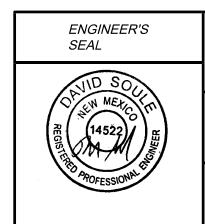

DAVID SOULE P.E. #14522

5/1/21

Lot 13 Blk 5 Un |9 VC 6509 AZOR LANE NW GRADING AND

DRAINAGE PLAN

Rio Grande Lingineering PO BOX 93924 ALBUQUERQUE, NM 87199 (505) 321-9099

DRAWN

 $^{BY}$  DEM

DATE 4-30-21

Lot 13 Blk 5 Un 9 VC.dwg

SHEET#

JOB#

C1

### EXISTING UTILITIES ARE NOT SHOWN. IT SHALL BE THE SOLE RESPONSIBILITY OF THE CONTRACTOR TO CONDUCT ALL NECESSARY FIELD INVESTIGATIONS PRIOR TO ANY EXCAVATION TO DETERMINE THE ACTUAL LOCATION OF UTILITIES & OTHER IMPROVEMENTS.

**CAUTION:** 

